

INDEX TO DRAWINGS	
SHT. NO.	DESCRIPTION
1	TITLE SHEET
2	STANDARD PLANS SUMMARY
3	GENERAL NOTES & ABBREVIATIONS
4-5	WATER POLLUTION AND EROSION CONTROL NOTES
6-7	TYPICAL SECTIONS
8	ALIGNMENT PLAN
9	ROADWAY PLAN
10	SPOT ELEVATION PLAN
11	MISCELLANEOUS DETAILS
12	GUARDRAIL DETAILS AND NOTES
13	STRONG POST W-BEAM GUARDRAIL
14	GUARDRAIL TERMINAL CONNECTORS AND END SECTIONS
15	GRADING PLAN
16-17	SIGNING AND PAVEMENT MARKING
18	EROSION CONTROL PLAN
19	WATER POLLUTION AND EROSION CONTROL DETAILS
20	TRAFFIC CONTROL NOTES
21	LOW SPEED UNDIVIDED HIGHWAY DETAILS
22-23	TRAFFIC CONTROL PLANS
24	STRUCTURAL NOTES
25	TYPICAL DETAILS
26-28 ①	UPPER ANCHORED WIRE MESH WALL ELEVATIONS
29-33	ANCHORED WIRE MESH WALL SYSTEM
34 ②	LOWER SHOTCRETE WALL SECTION
35	SOIL NAIL SHOTCRETE WALL SECTION AND DETAIL
36 ③	LOWER SHOTCRETE WALL ELEVATION WALL STA 0+00 TO 1+32.9

Sheet Nos. ① 285-1 to 285-3; ② 345-1 to 345-3; and ③ 365-1 are supplementary sheets to this project. Total sheet count after "AS-BUILT" posting 43 sheets.

DRAWING NAME: Z:\00 ONGOING\10-031-LUMAHAI EMER REPAIR SLOPE MITIGATION\10-17-11\FINAL\LSM-TITLE SHT.DWG PLOT TIME: 10-12-11, 8:31 AM

DESIGNED BY
KSF, INC.


MANAGED BY
HWY-K

PHONE
241-3023

DATE
OCT. 2011

STATE OF HAWAII
DEPARTMENT OF TRANSPORTATION
HIGHWAYS DIVISION
HONOLULU, HAWAII
"AS-BUILT"
PLANS FOR
**KUHIO HIGHWAY
EMERGENCY SLOPE REPAIRS
VICINITY OF LUMAHAI**
PROJECT NO. 560A-02-12


DISTRICT OF HANAIEI
ISLAND OF KAUAI

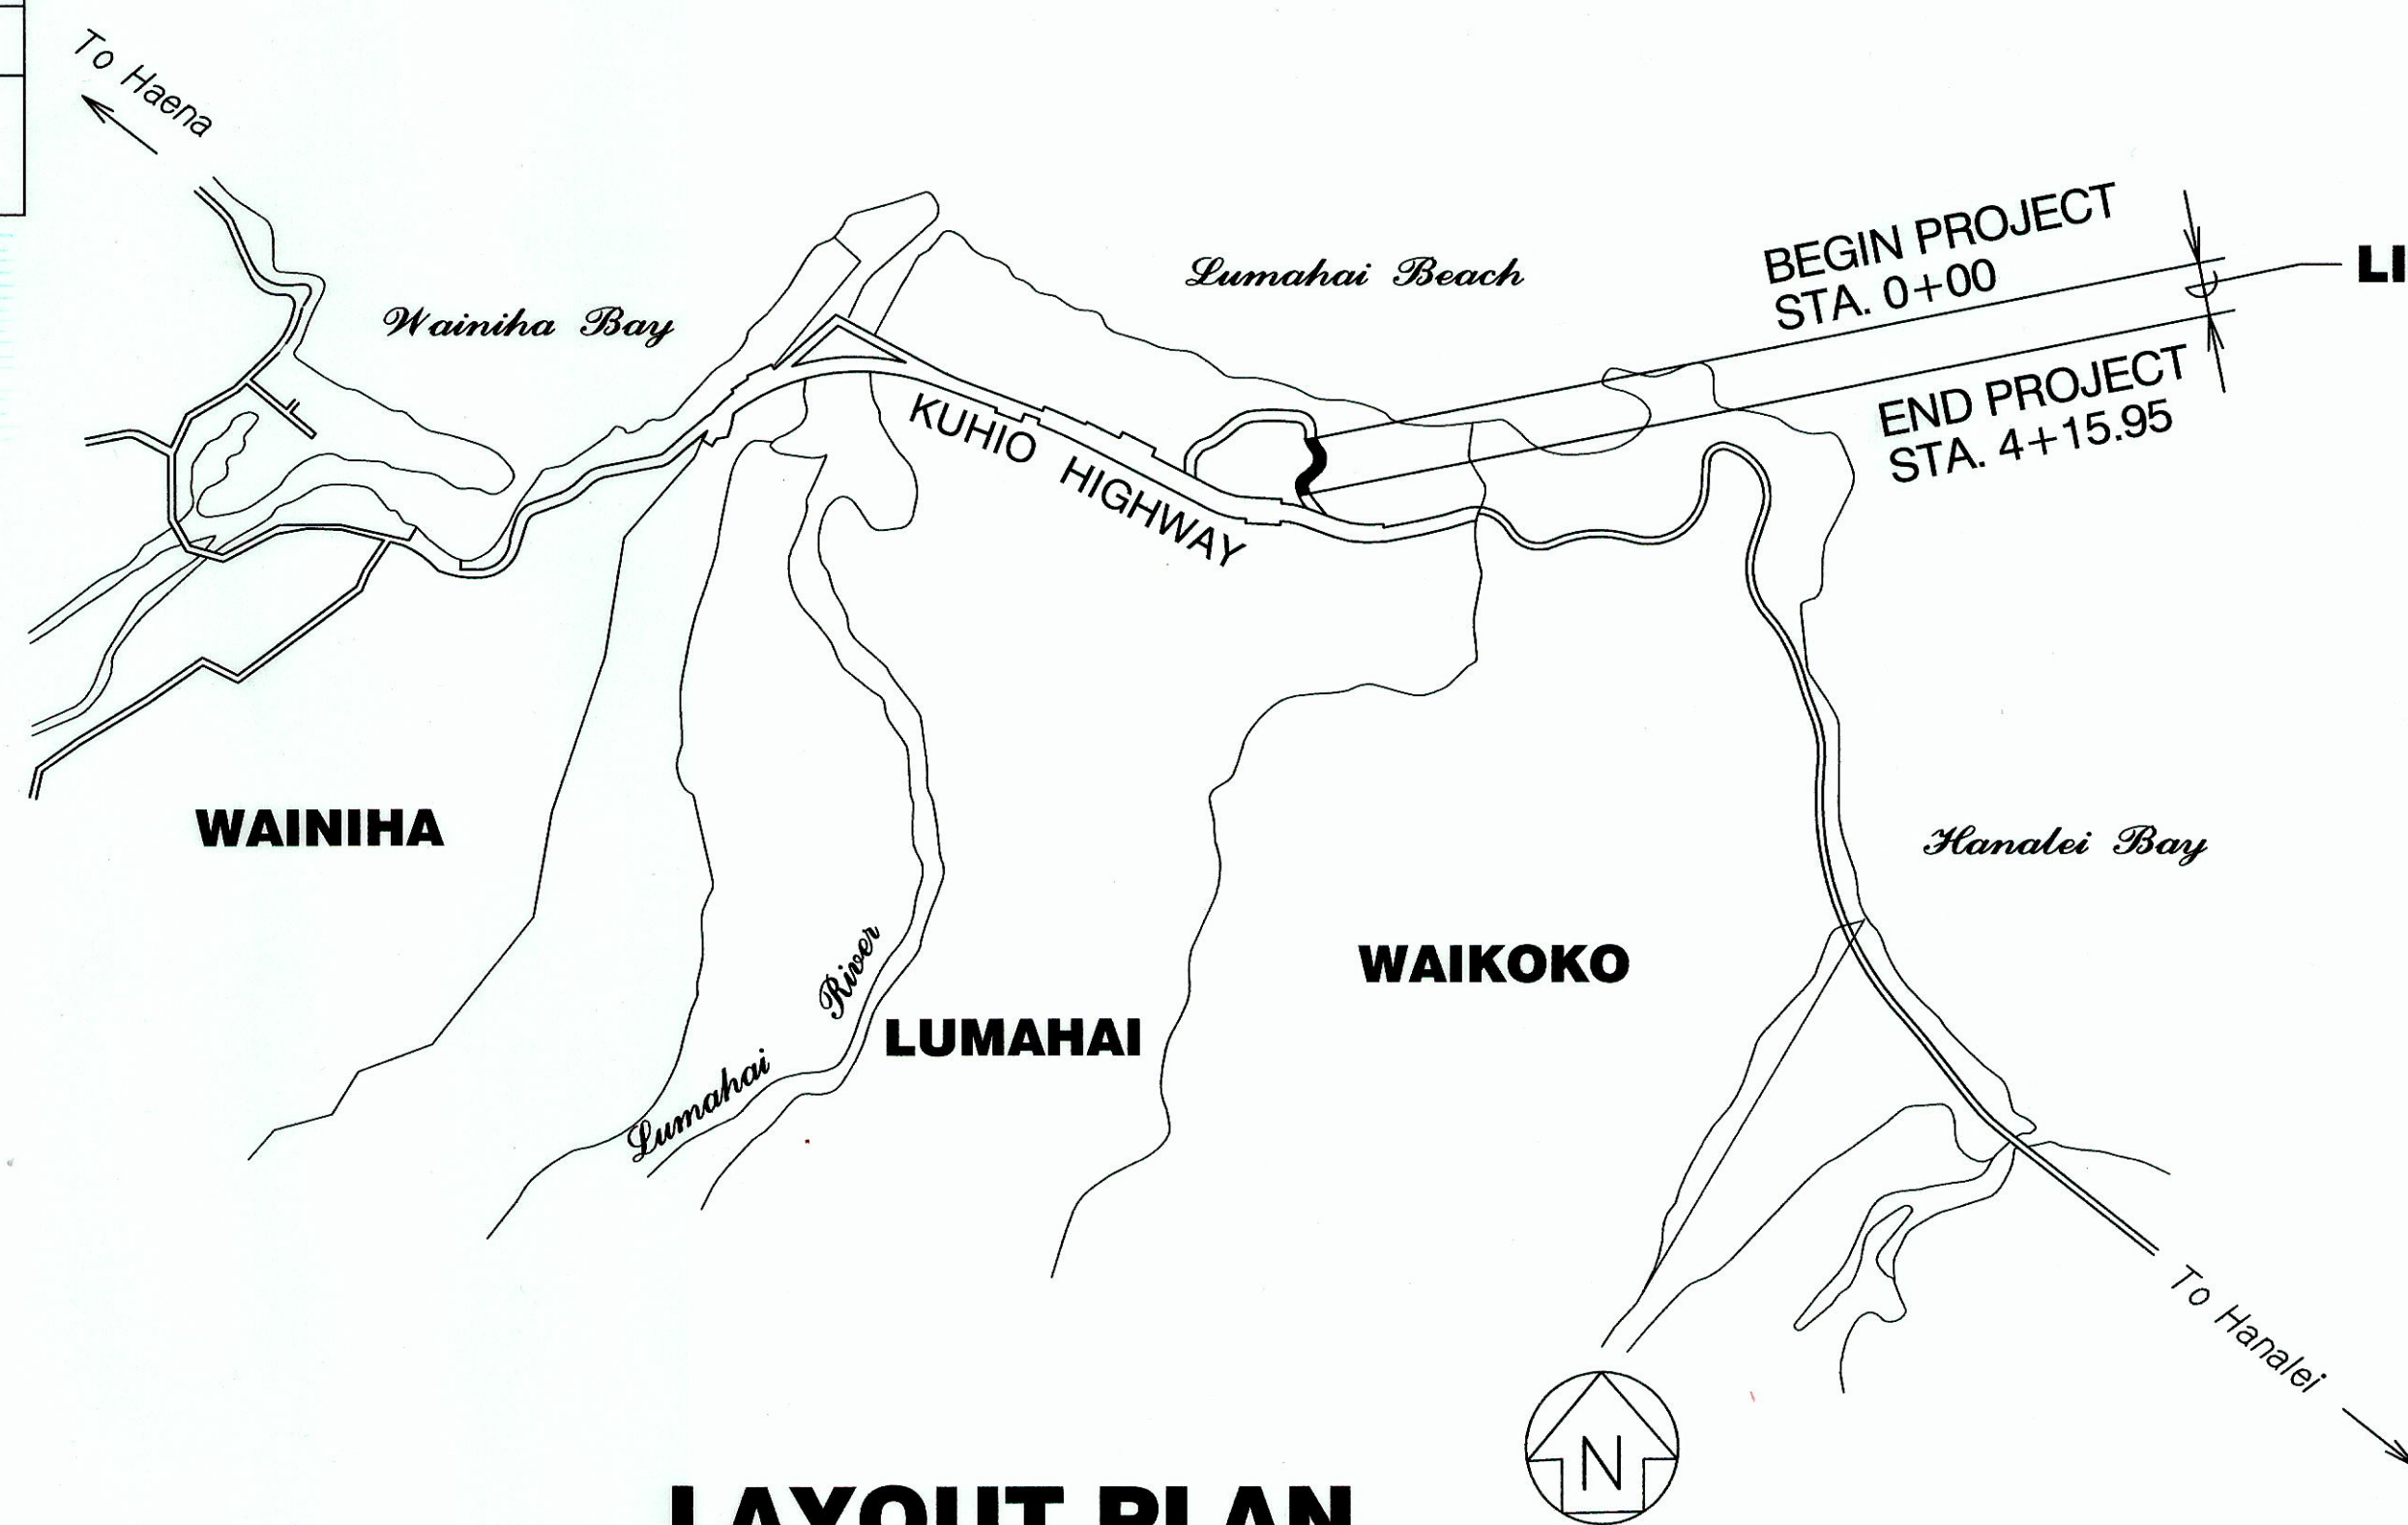



LAYOUT PLAN

GROSS LENGTH OF PROJECT.....0.08 MILES
NET LENGTH OF PROJECT.....0.08 MILES

FED. ROAD DIST. NO.	STATE	PROJ. NO.	FISCAL YEAR	SHEET NO.	TOTAL SHEETS
HAWAII	HAW.	560A-02-12	2012	1	36

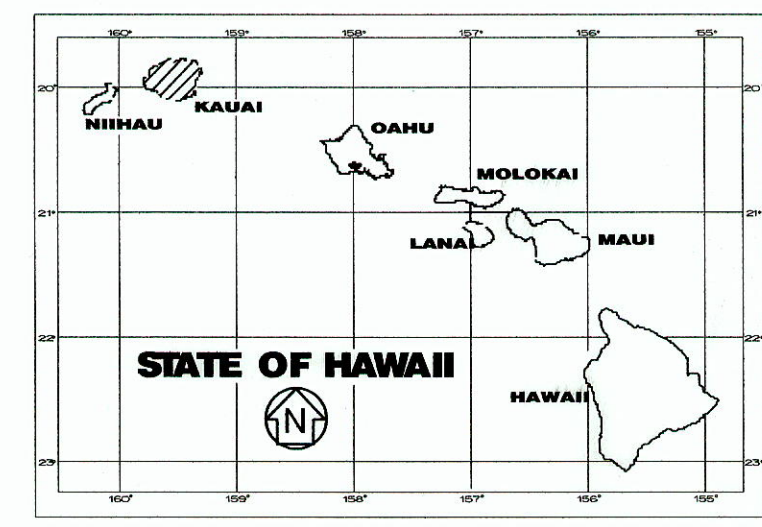

PROJECT LOCATION

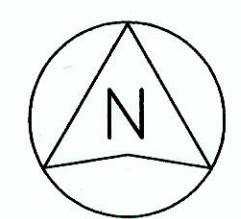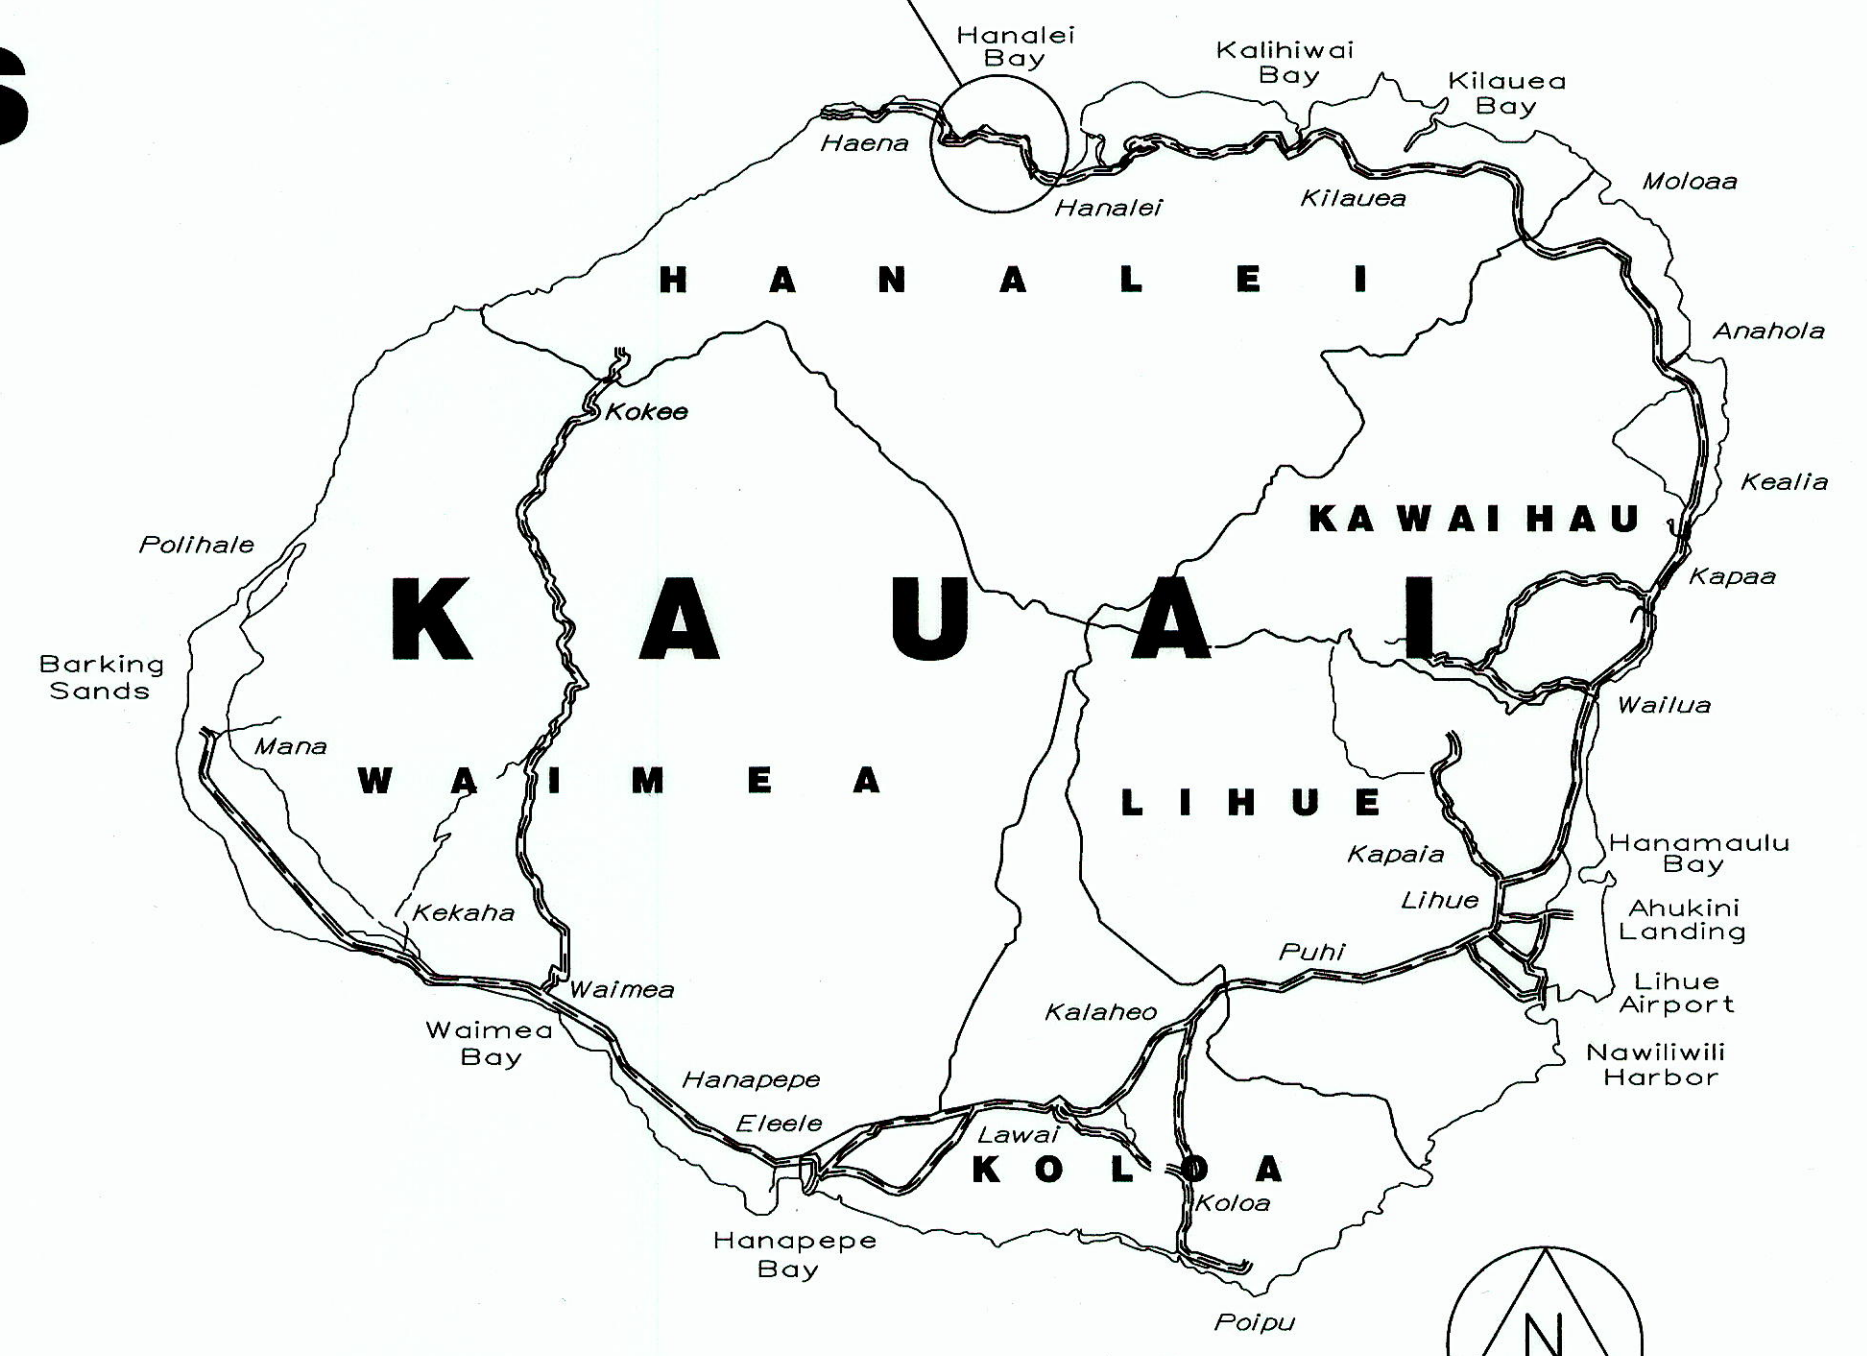

SCALE IN MILES

FEDERAL AID PROJECTS PREVIOUSLY CONSTRUCTED OR UNDER CONSTRUCTION

MILE POST 5.30 TO MILE POST 5.38

CHANGES MADE DURING CONSTRUCTION HAVE BEEN INCORPORATED ON THESE PLANS EXCEPT CHANGES IN THE ORIGINAL THEORETICAL QUANTITIES. FOR ACTUAL QUANTITIES, REFER TO PROJECT LEDGER AND/OR COMPUTATION BOOK.

RESIDENT ENGINEER
DATE 7.5.16

DEPARTMENT OF TRANSPORTATION
STATE OF HAWAII

APPROVED:
for DIR. OF TRANSPORTATION
DATE 10/14/11