

FED. ROAD DIST. NO. PROJ. NO. 560A-02-12 2012 25

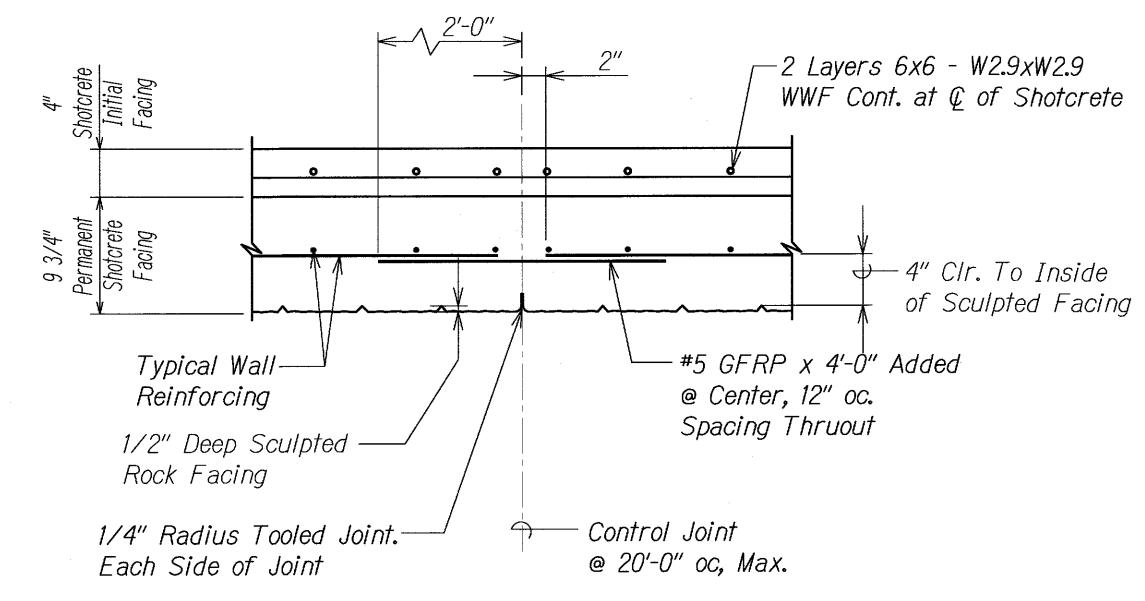

TYPICAL CONTROL JOINTS AT SHOTCRETE WALL Scale: 1 1/2" = 1'-0"

NOTE:

See Sheet No.s S3.1 and S4.1 for additional details.

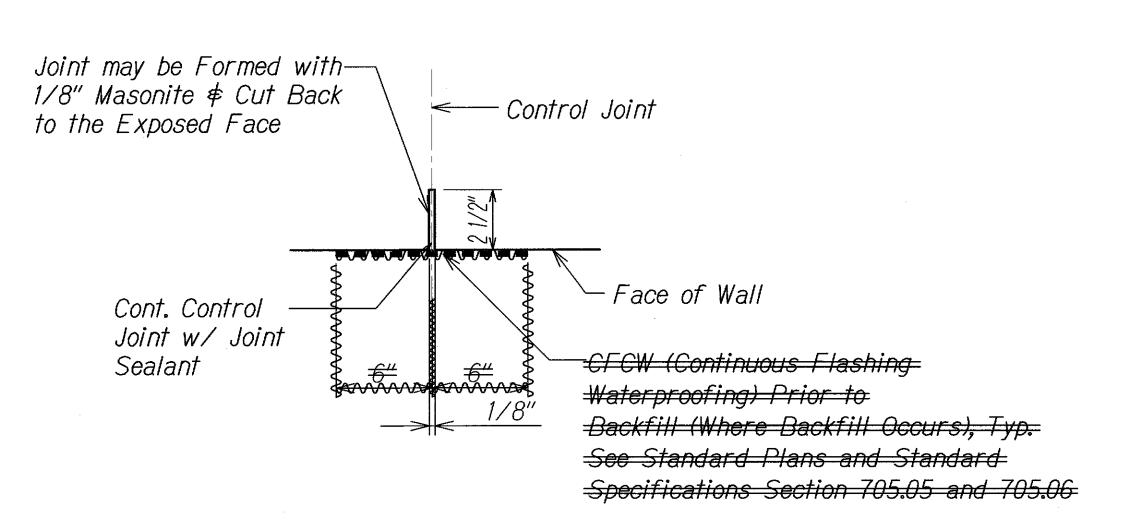

CONTROL JOINT DETAIL 2
SOL SOL SOL

Roadway

LEGEND FOR AS-BUILT POSTINGS

Squiggly line for as-built deletion **₩** Double line for as-built deletion 100.00

Text for as-built posting



THIS WORK WAS PREPARED BY ME OR UNDER MY SUPERVISION.

KUHIO HIGHWAY EMERGENCY SLOPE REPAIRS <u>Vicinity of Lumahai</u> Project No. 560A-02-12

Scale: As Shown Date: Oct. 17, 2011 SHEET No. SO.2 OF

STATE OF HAWAI'I
DEPARTMENT OF TRANSPORTATION

HIGHWAYS DIVISION

TYPICAL DETAILS

"AS-BUILT"

2 SHEETS

25