



FED. ROAD DIST. NO.	STATE	PROJ. NO.	FISCAL YEAR	SHEET NO.	TOTAL SHEETS
HAWAII	HAW.	560A-02-12	2012	6	36

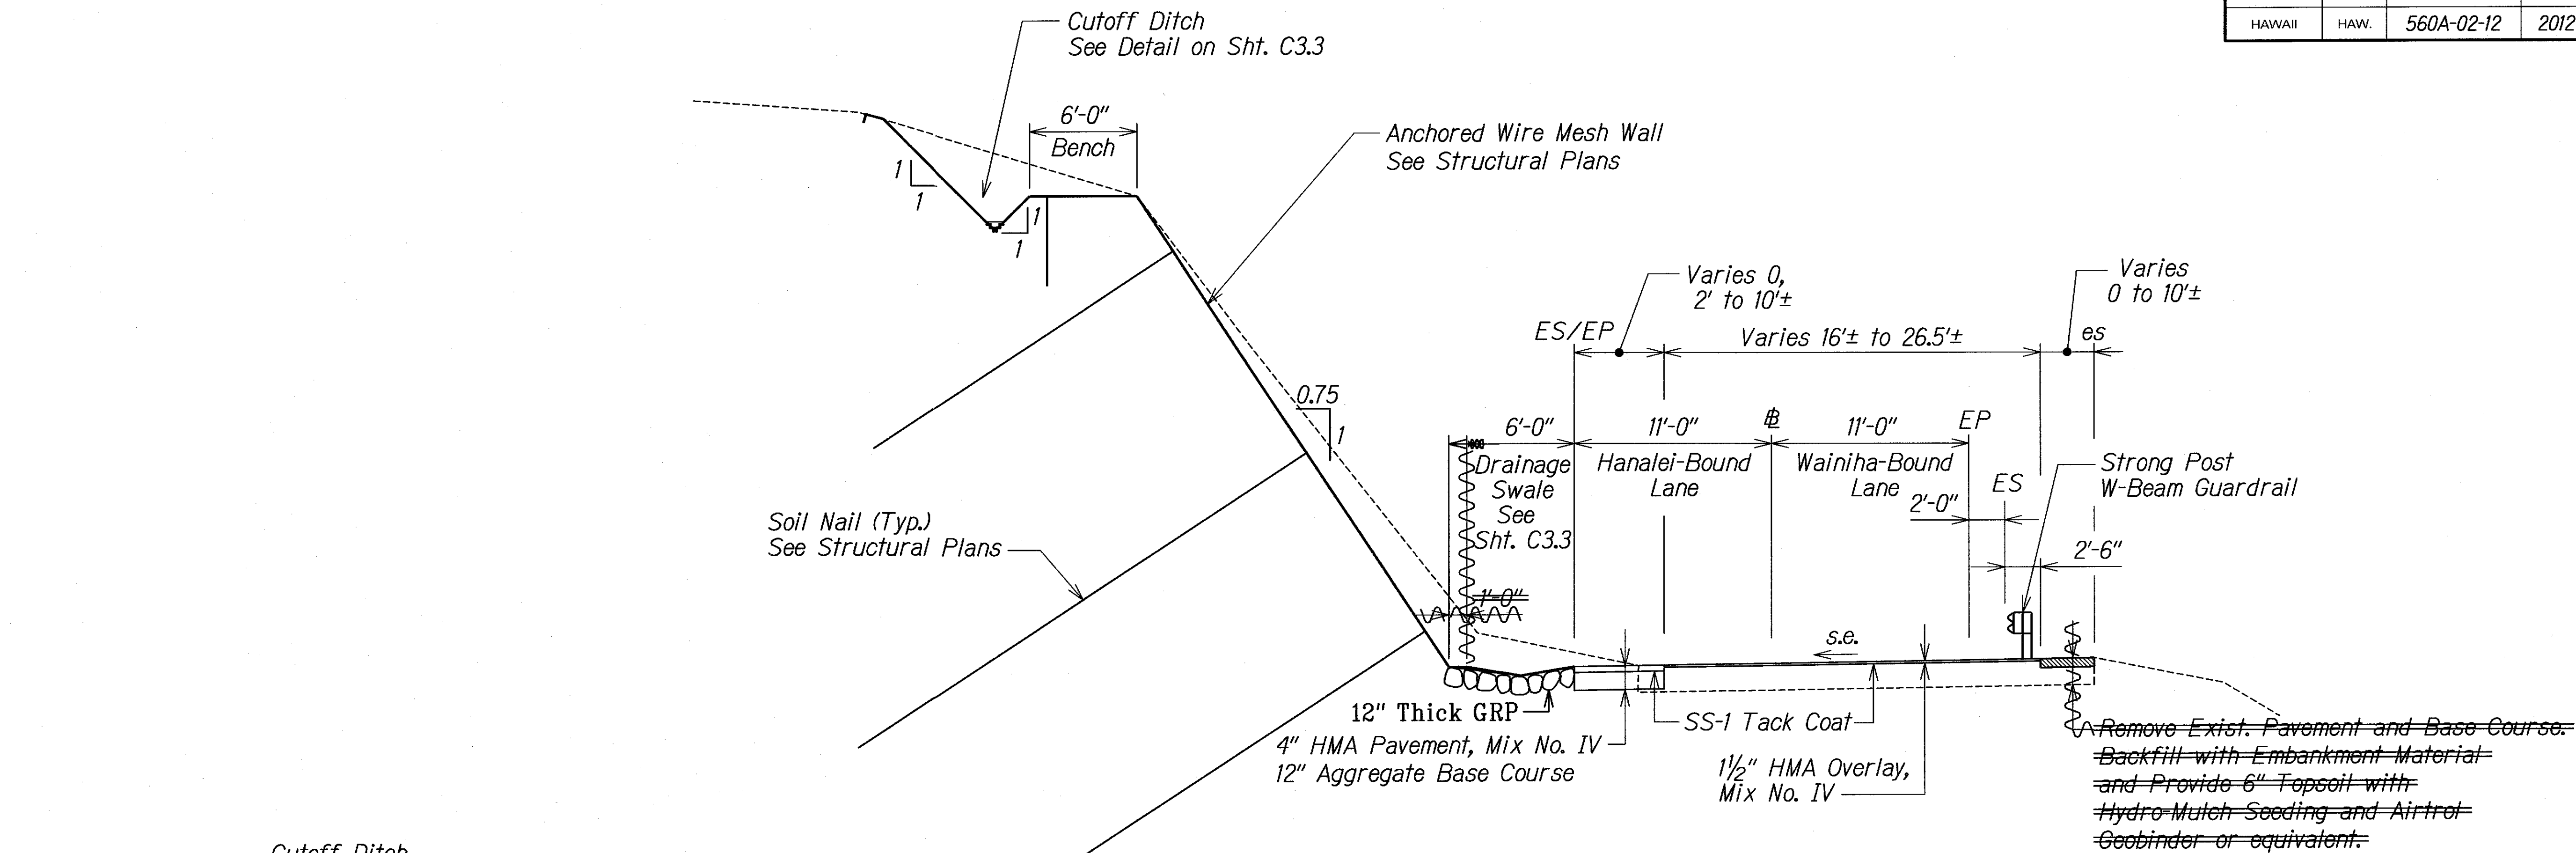


TYPICAL SECTION
KUHIO HWY @ STA. 0+00 TO @ STA. 0+70.76
(LOOKING DOWNSTATION)
Scale: 1" = 5'

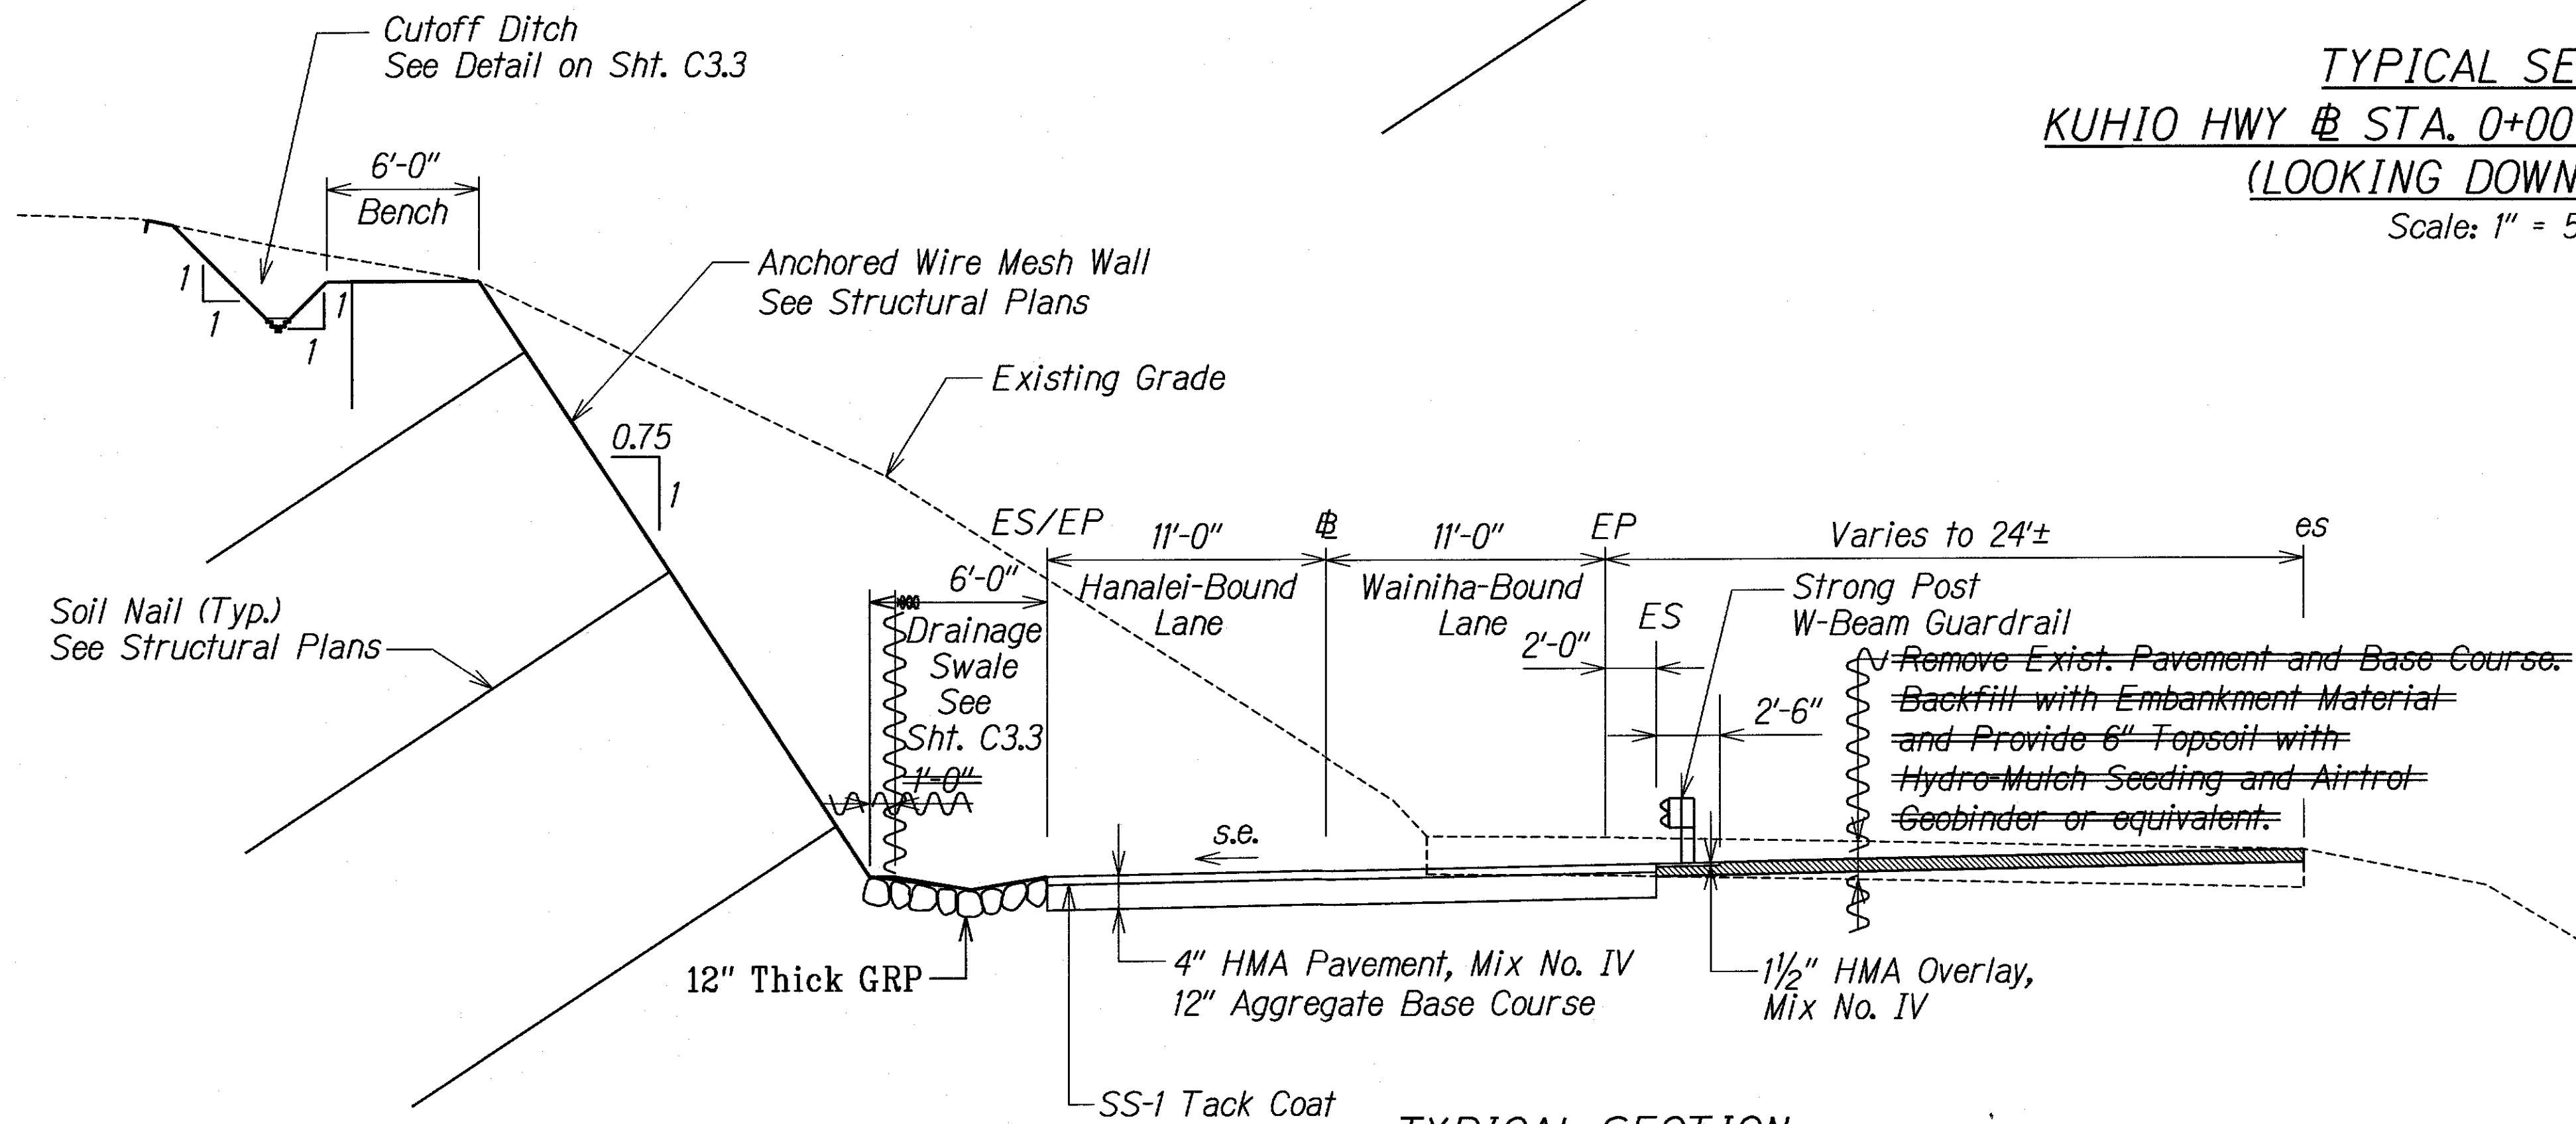

TYPICAL SECTION
KUHIO HWY @ STA. 0+70.76 TO @ STA. 1+60
(LOOKING DOWNSTATION)
Scale: 1" = 5'

LEGEND FOR
AS-BUILT POSTINGS

	Squiggly line for as-built deletion
	Double line for as-built deletion
Roadway	Text for as-built posting

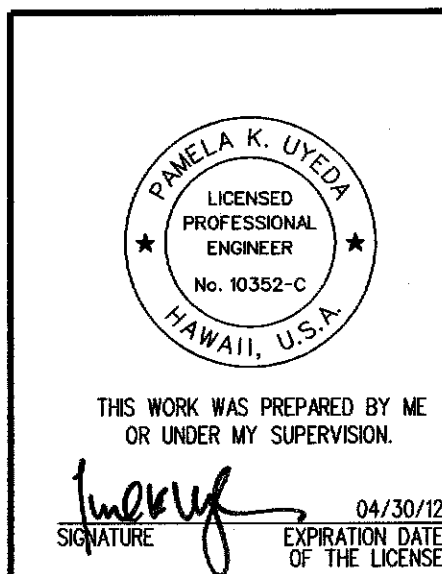

STATE OF HAWAII
DEPARTMENT OF TRANSPORTATION
HIGHWAYS DIVISION

TYPICAL SECTIONS - 1


KUHIO HIGHWAY EMERGENCY SLOPE REPAIRS

Vicinity of Lumahai
Project No. 560A-02-12
Scale: As Shown **Date: Oct. 17, 2011**


SHEET No. C1J OF 18 SHEETS

"AS-BUILT"

FED. ROAD DIST. NO.	STATE	PROJ. NO.	FISCAL YEAR	SHEET NO.	TOTAL SHEETS
HAWAII	HAW.	560A-02-12	2012	7	36

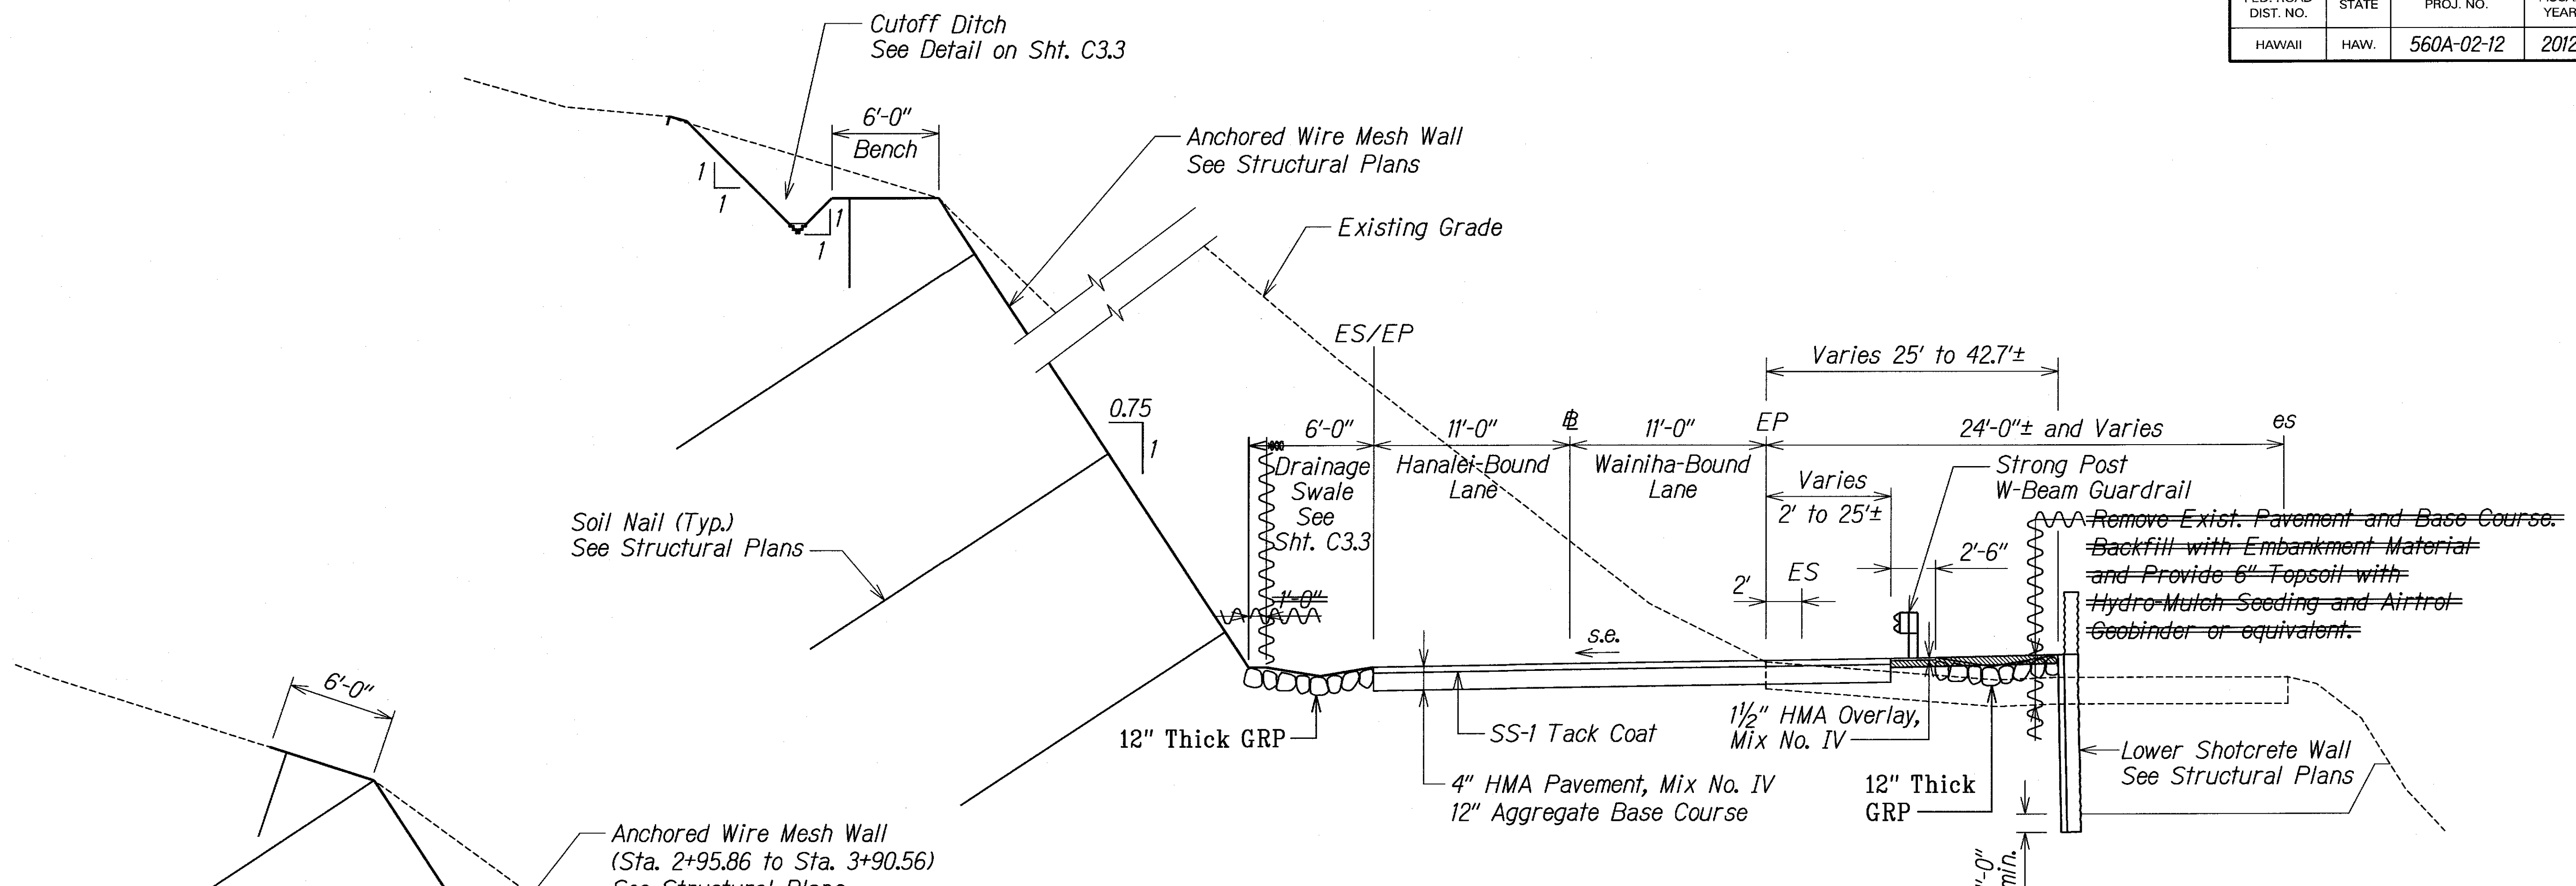

TYPICAL SECTION
KUHIO HWY # STA. 1+60 TO # STA. 2+68.96
(LOOKING DOWNSTATION)
 Scale: 1" = 5'

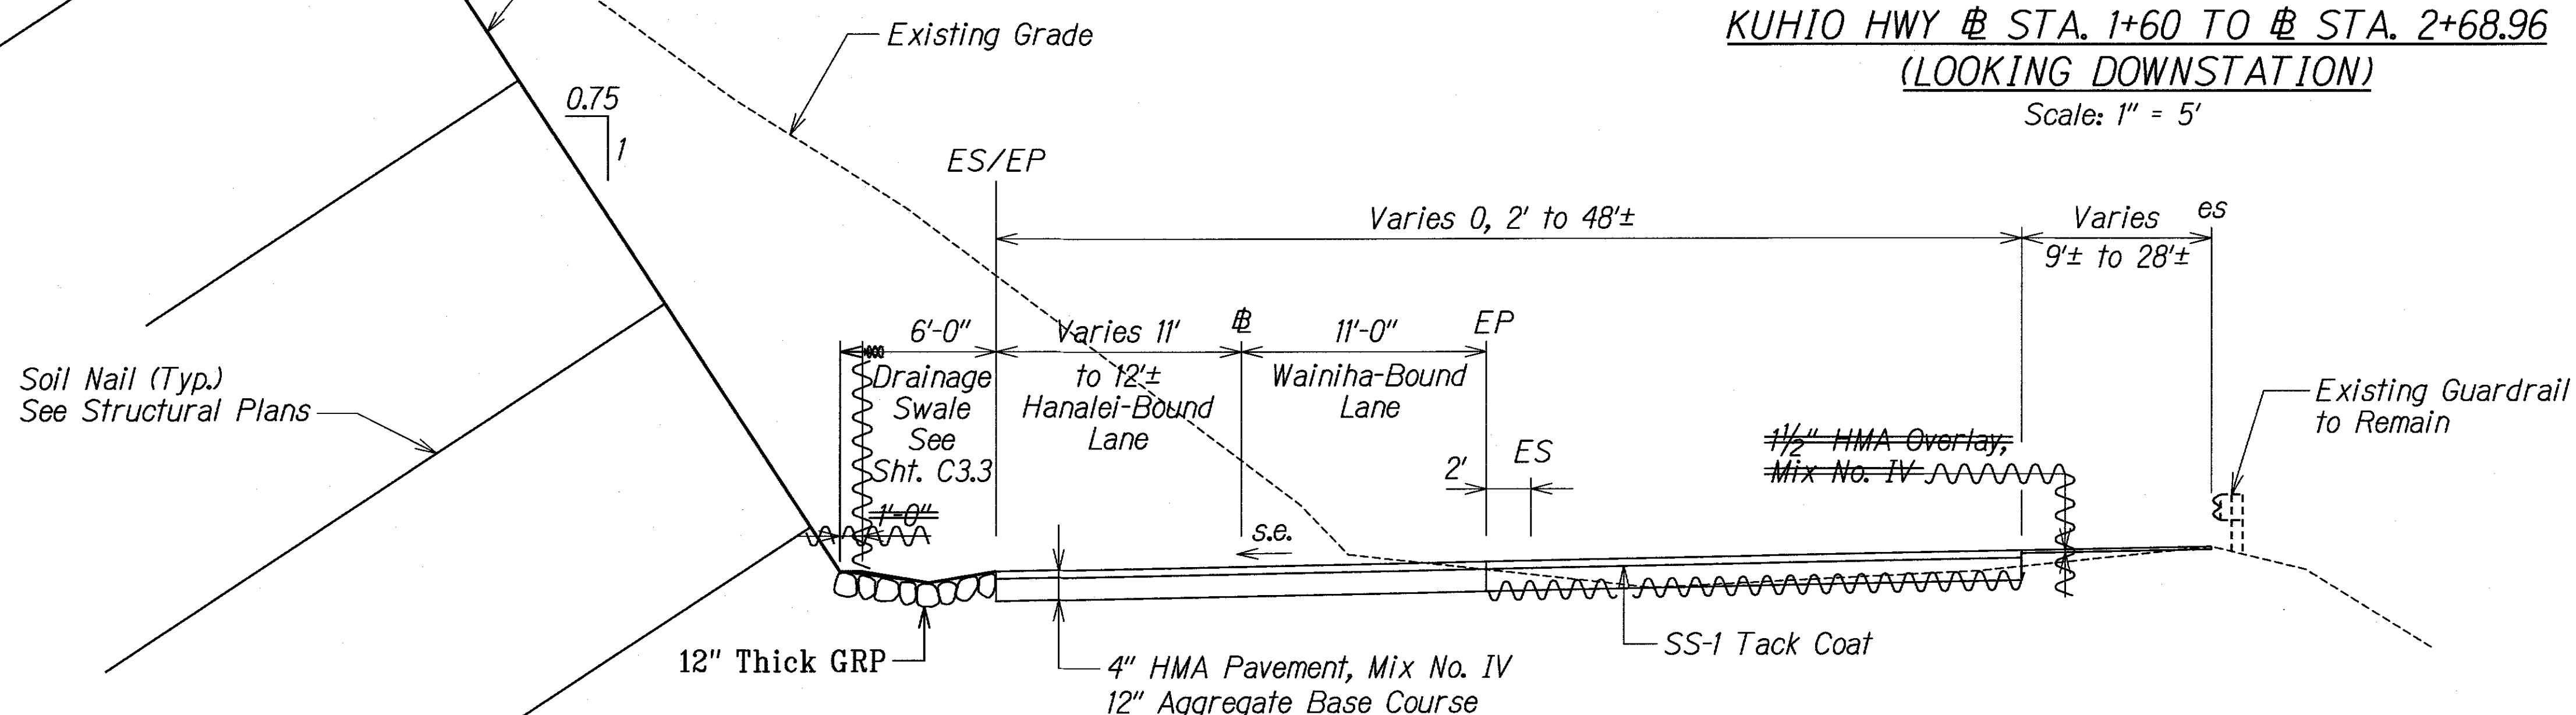

TYPICAL SECTION
KUHIO HWY # STA. 2+95.86 TO # STA. 4+15.95
(LOOKING DOWNSTATION)
 Scale: 1" = 5'

LEGEND FOR AS-BUILT POSTINGS

	Squiggly line for as-built deletion
	Double line for as-built deletion
Roadway	Text for as-built posting

DATE	_____
DESIGNED BY	_____
CHECKED BY	_____
NOTED BY	_____
NO.	_____

THIS WORK WAS PREPARED BY ME OR UNDER MY SUPERVISION.

[Signature] 04/30/12
 SIGNATURE EXPIRATION DATE OF THE LICENSE

STATE OF HAWAII
 DEPARTMENT OF TRANSPORTATION
 HIGHWAYS DIVISION

TYPICAL SECTIONS - 2

KUHIO HIGHWAY EMERGENCY SLOPE REPAIRS
Vicinity of Lumahai
Project No. 560A-02-12
 Scale: As Shown Date: Oct. 17, 2011

"AS-BUILT"