


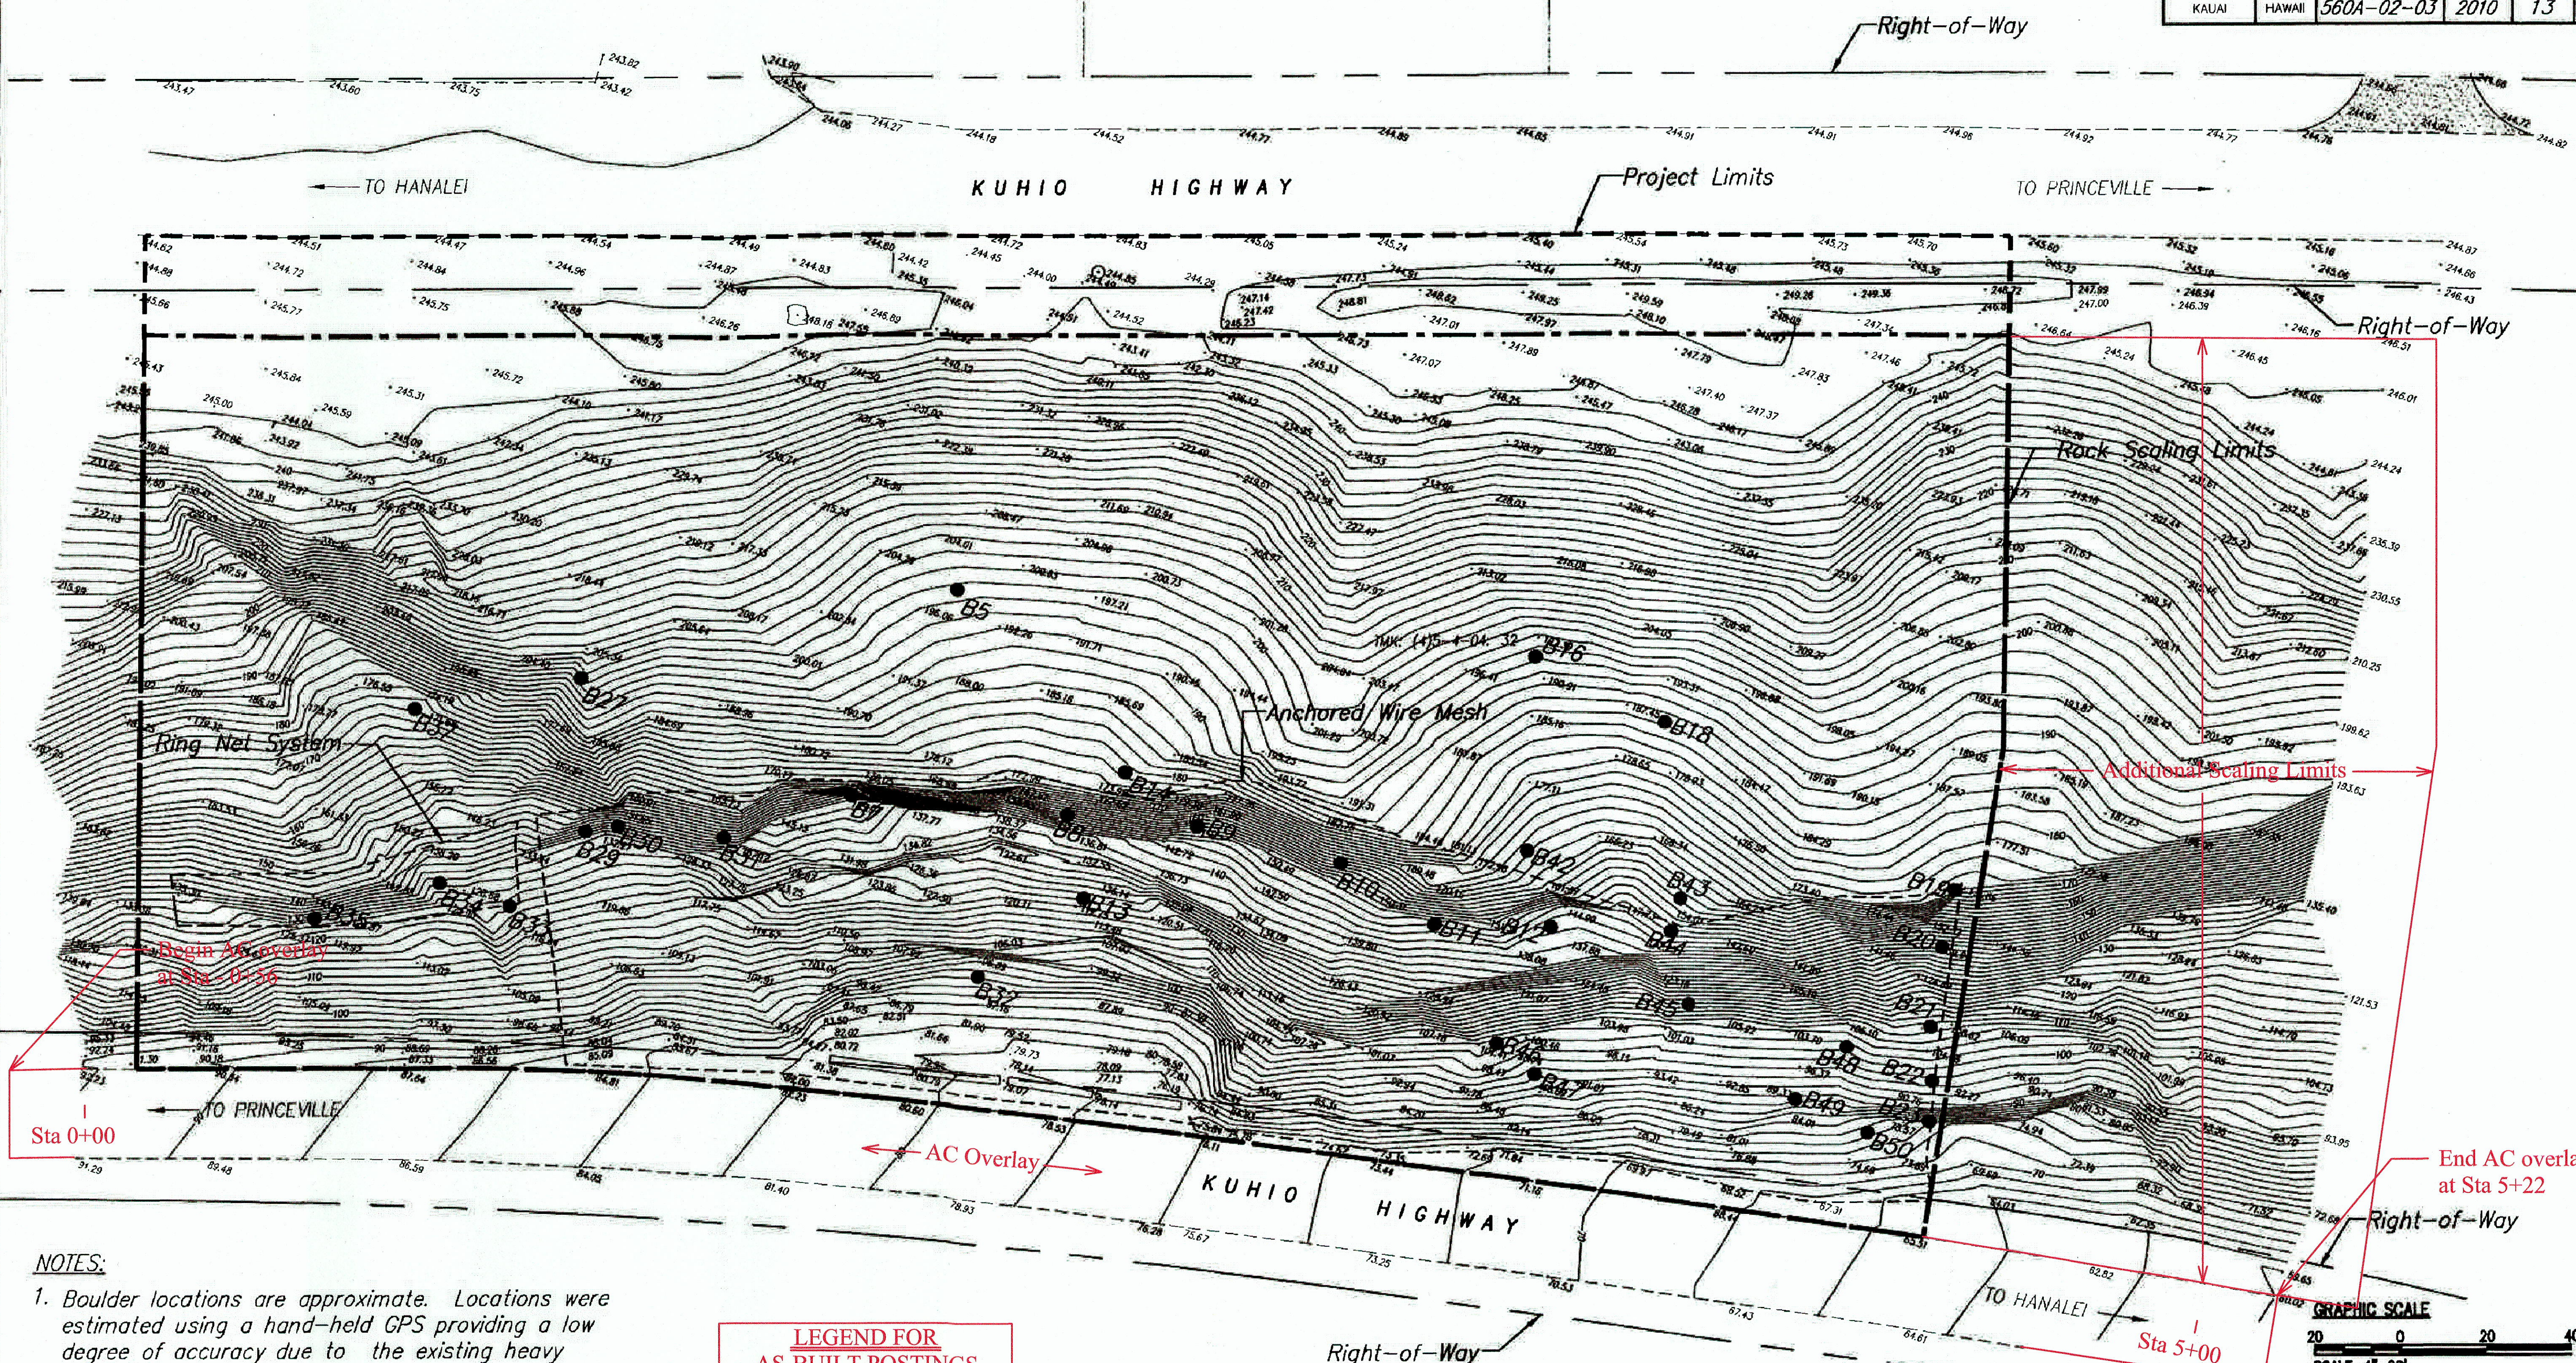


- NOTES:**
1. Boulder locations are approximate. Locations were estimated using a hand-held GPS providing a low degree of accuracy due to the existing heavy vegetative canopy.
 2. Contractor shall verify boulder locations requiring mitigation are within the project limits shown. Boulders located outside of the project limits are excluded from the scope of work for this project.

LEGEND FOR AS-BUILT POSTINGS

- Squiggly line for as-built deletion
- Double line for as-built deletion
- Text for as-built posting

BOULDER LOCATION SITE PLAN
SCALE: 1" = 20'

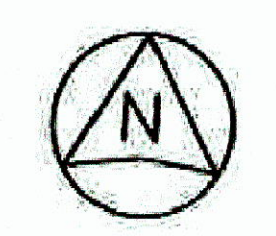

EARTH TECH | AECOM



STATE OF HAWAII
DEPARTMENT OF TRANSPORTATION
HIGHWAYS DIVISION

BOULDER LOCATION SITE PLAN

KUHIO HIGHWAY SLOPE STABILIZATION
VICINITY OF HANAIEI BRIDGE
PROJECT NO. 560A-02-03

Scale: As Noted Date: July 2009

SHEET No. 1 OF 1 SHEETS

DATE: _____
DESIGNED BY: _____
CHECKED BY: _____
NOTED BY: _____
ORIGINAL PLAN: _____

"AS-BUILT"