
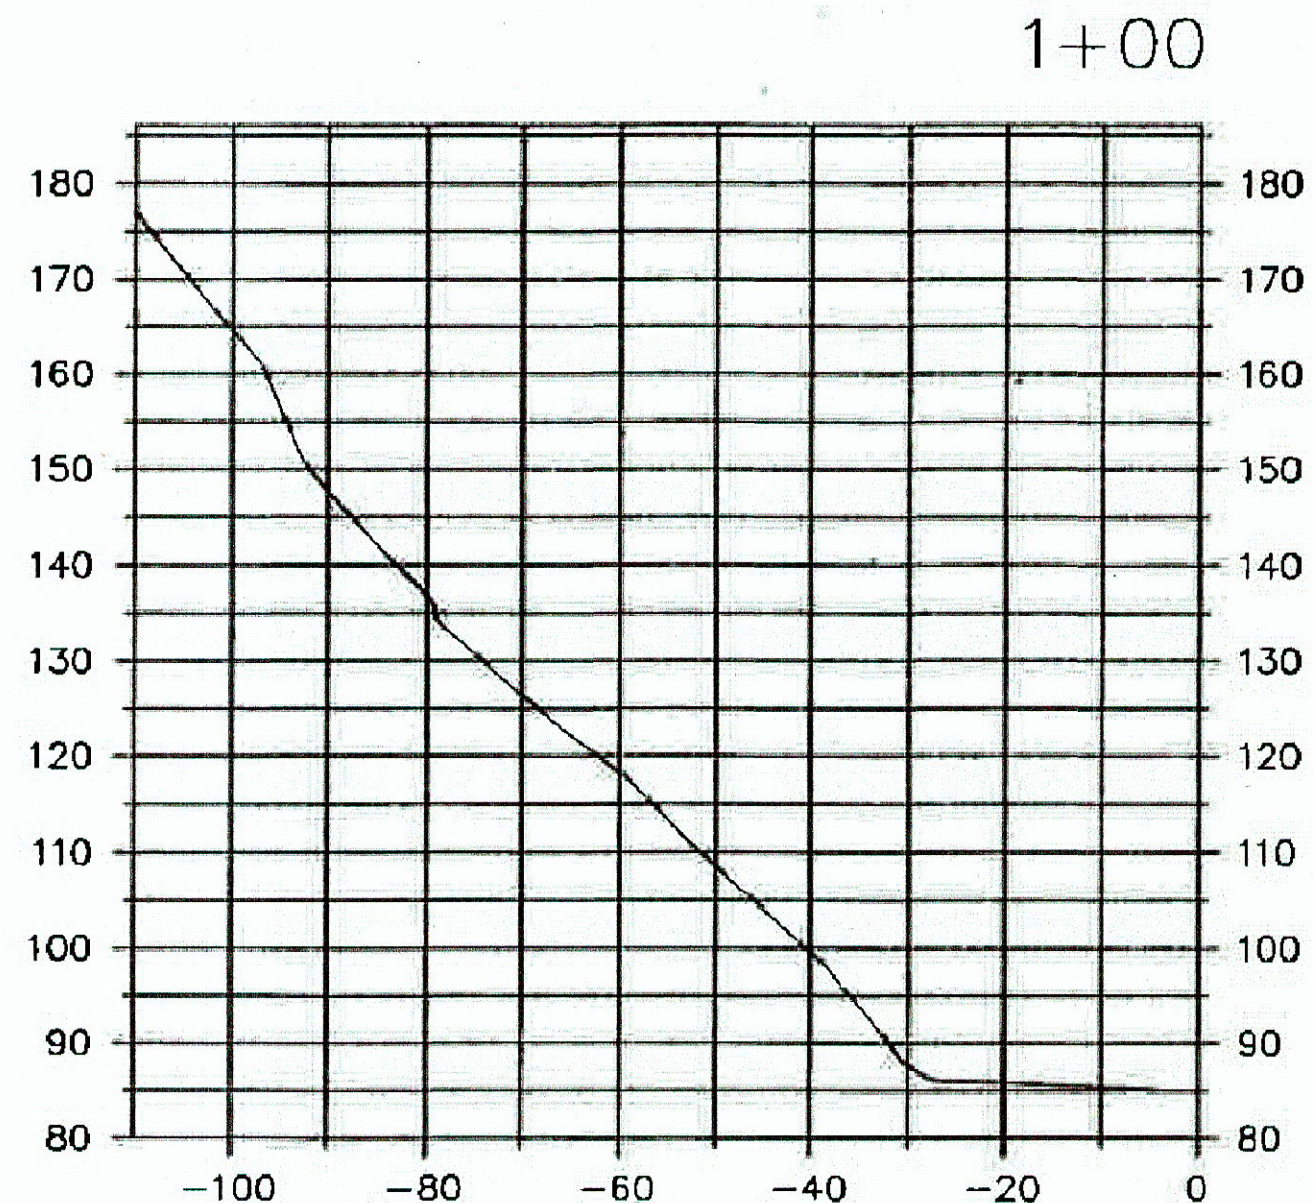
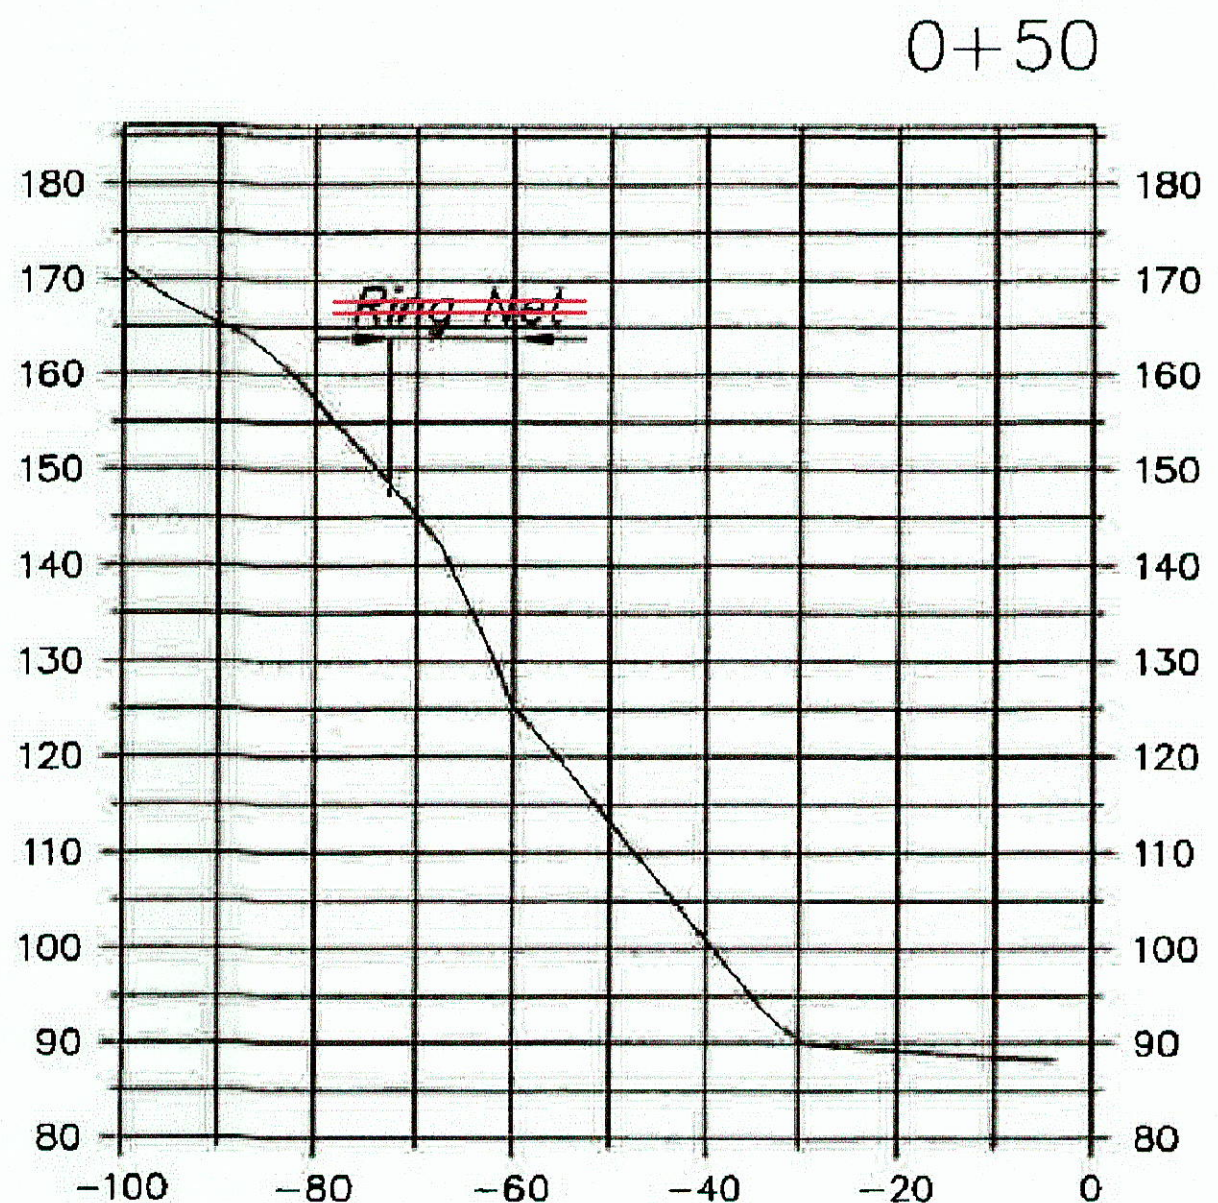
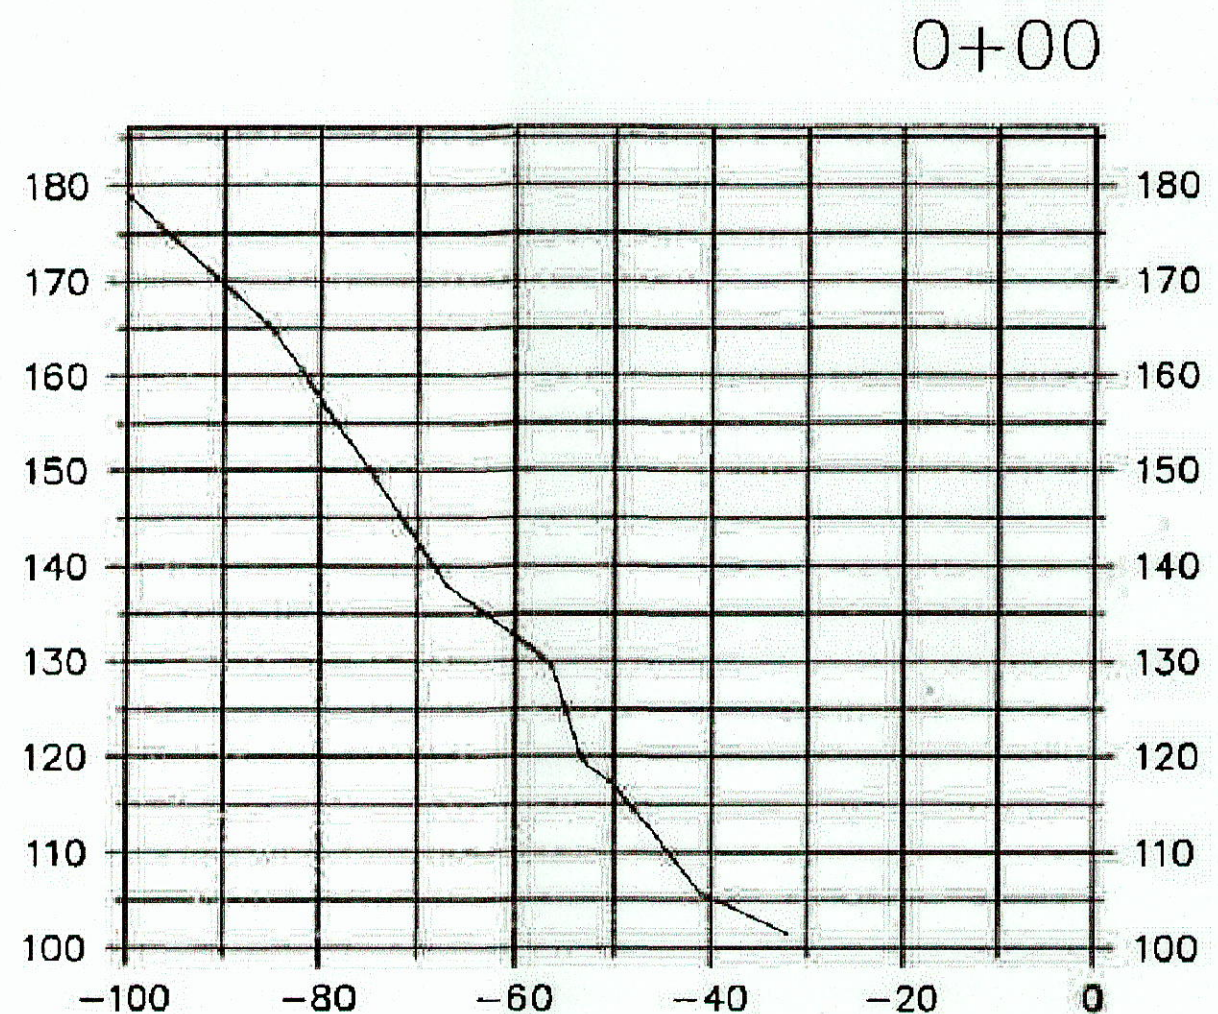
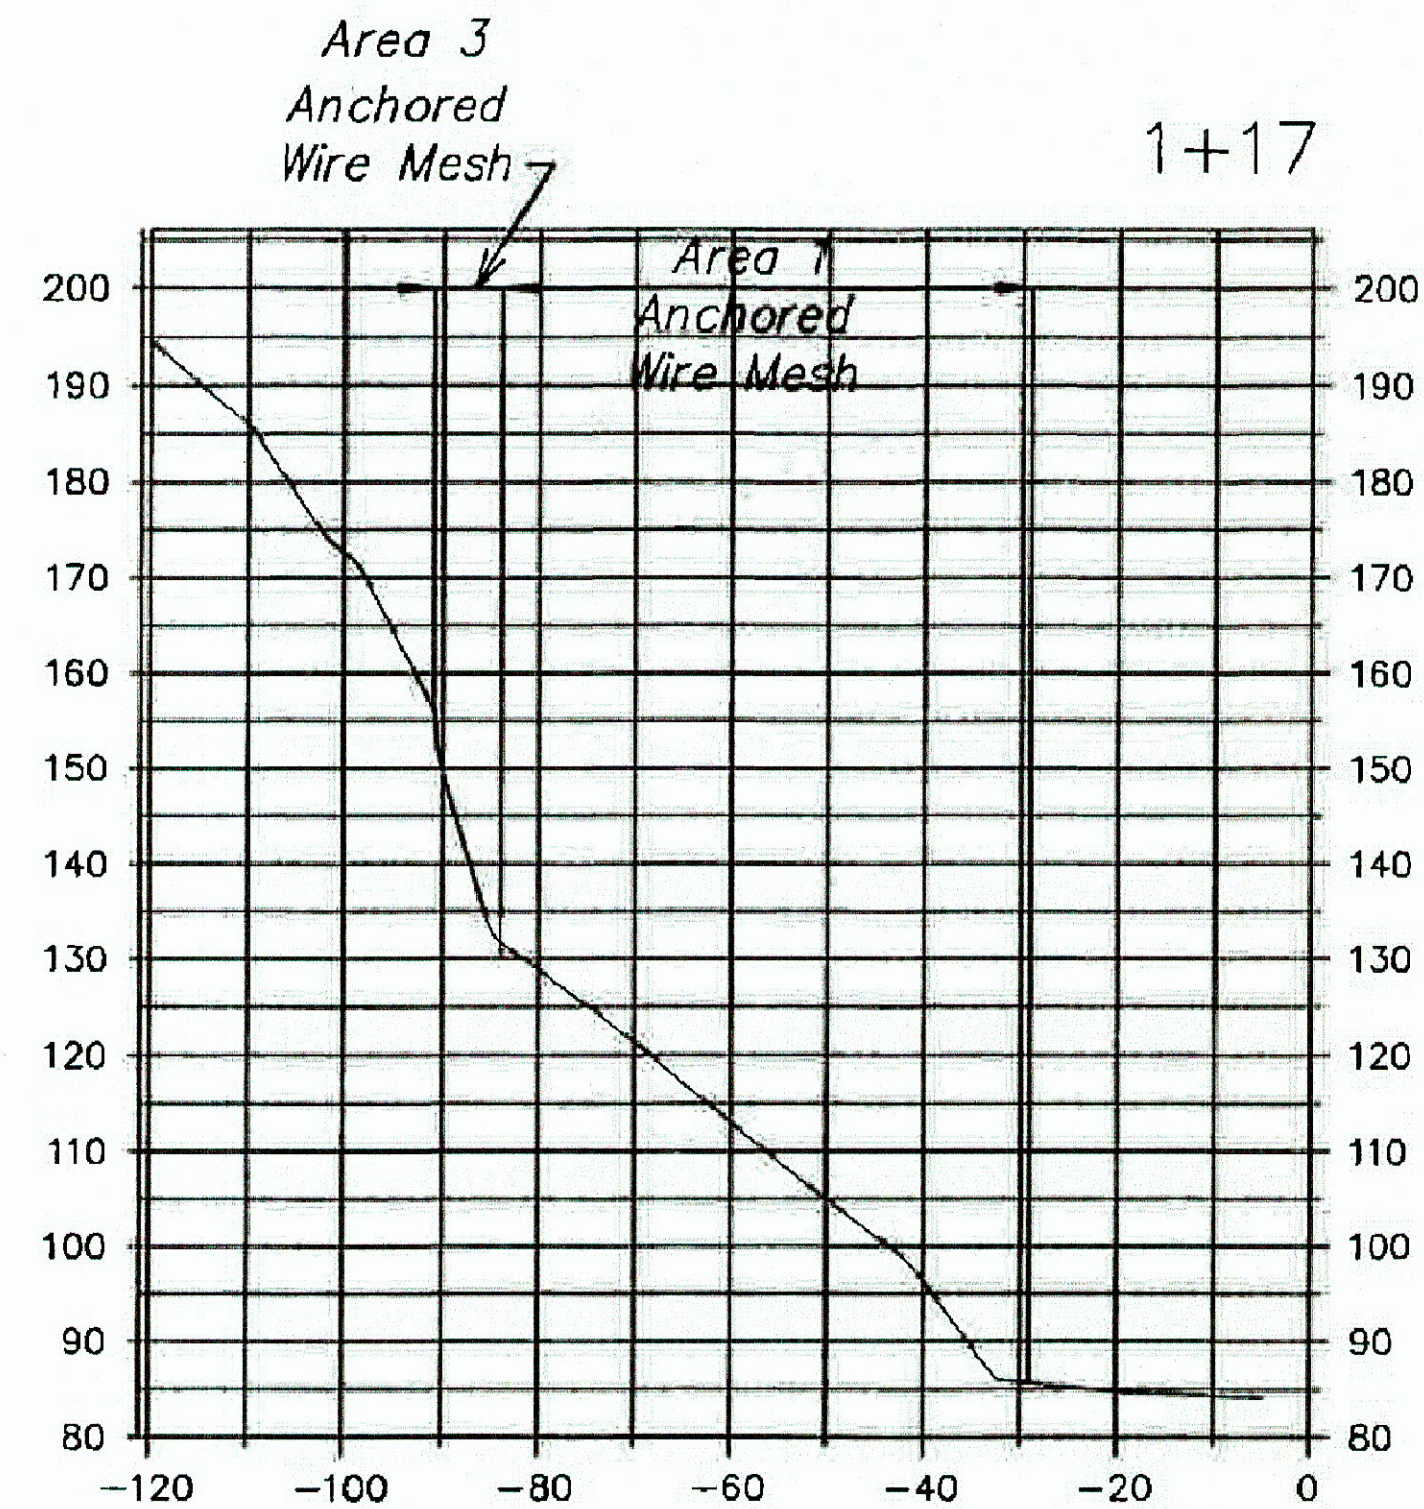
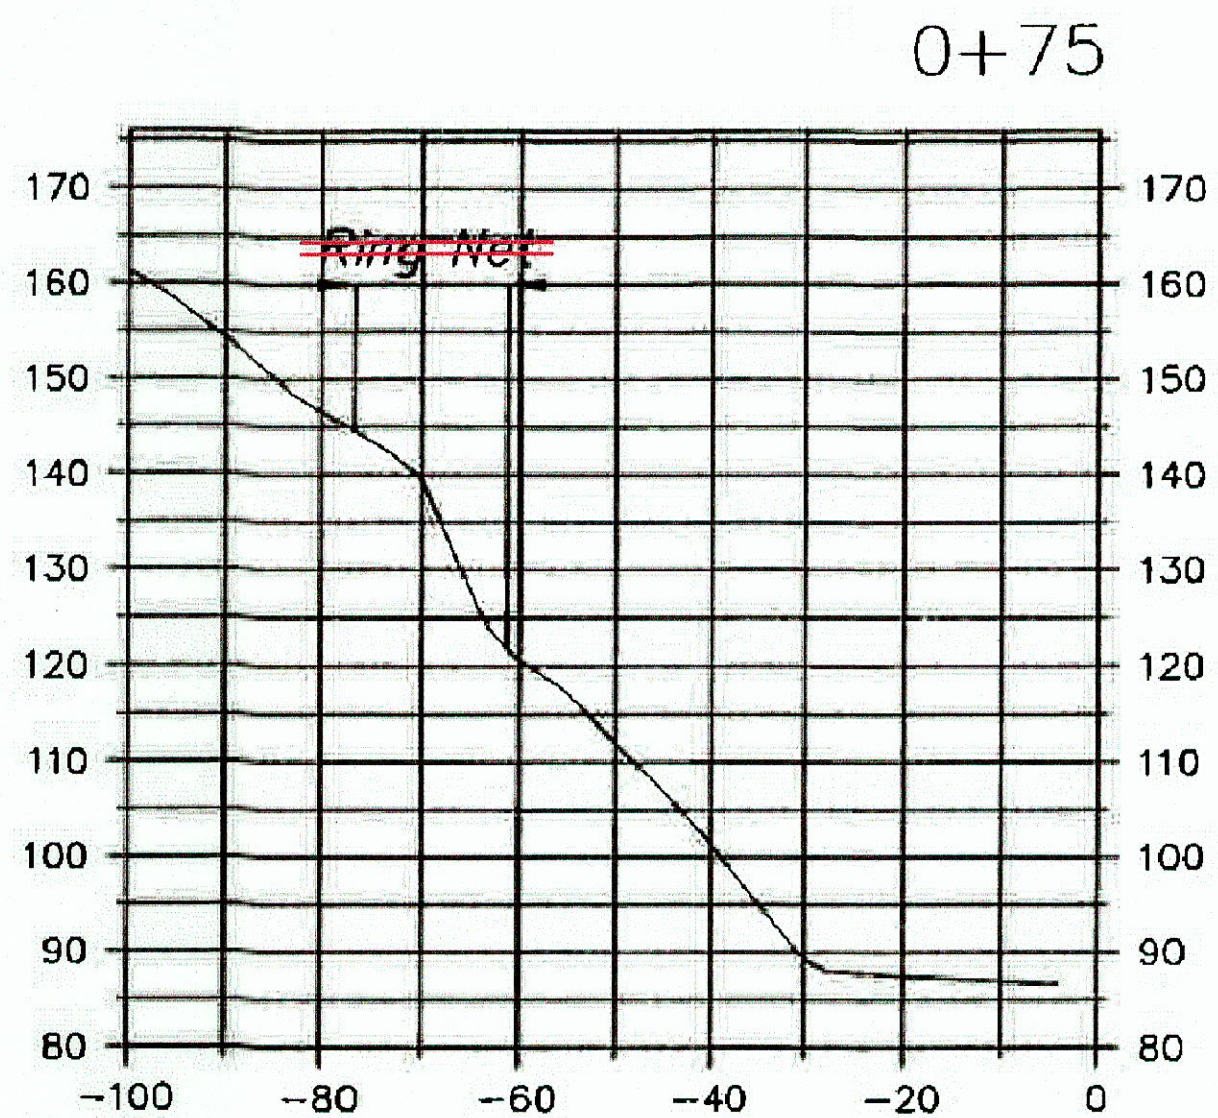


FED. ROAD DIST. NO.	STATE	PROJ. NO.	FISCAL YEAR	SHEET NO.	TOTAL SHEETS
KAUAI	HAWAII	560A-02-03	2010	28	32

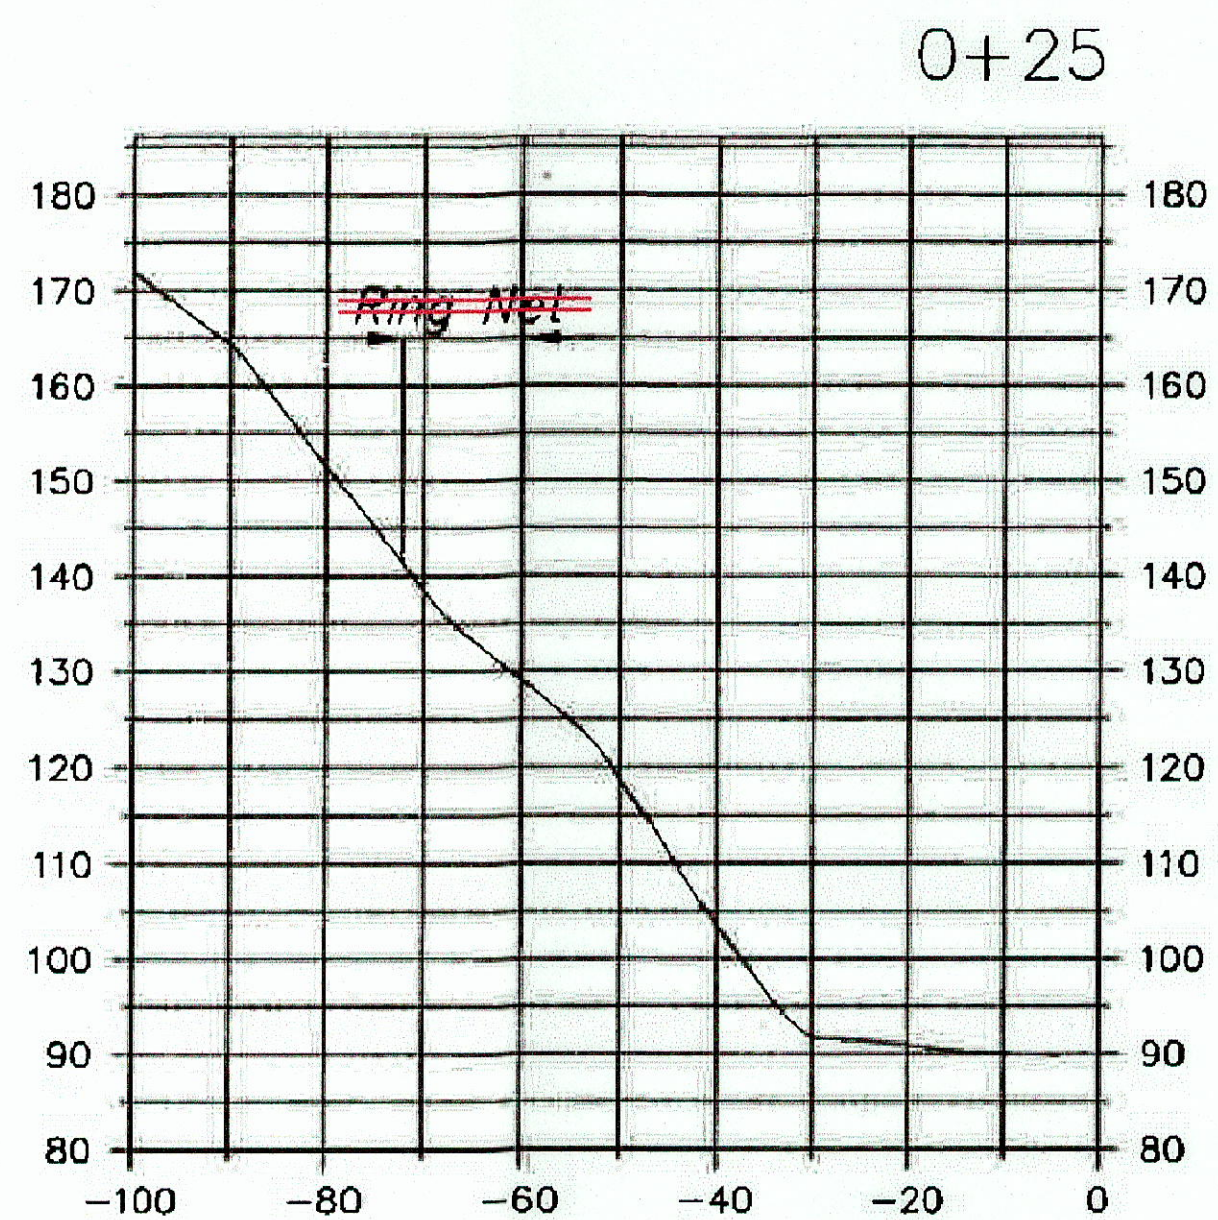

ORIGINAL PLAN	DATE
NOTED BY	DESIGNED BY
CHECKED BY	QUANTITIES BY

LEGEND FOR AS-BUILT POSTINGS

Squiggly line for as-built deletion

Double line for as-built deletion

Roadway Text for as-built posting

EARTH TECH | AECOM

GRAPHIC SCALE

SCALE: 1"=20'

STATE OF HAWAII

DEPARTMENT OF TRANSPORTATION

HIGHWAYS DIVISION

CROSS SECTIONS

KUHIO HIGHWAY SLOPE STABILIZATION

VICINITY OF HANAIEI BRIDGE

PROJECT NO. 560A-02-03







Scale: As Noted

Date: July 2009

SHEET No. 1 OF 5 SHEETS



"AS-BUILT"

FED. ROAD DIST. NO.	STATE	PROJ. NO.	FISCAL YEAR	SHEET NO.	TOTAL SHEETS
KAUAI	HAWAII	560A-02-03	2010	29	32

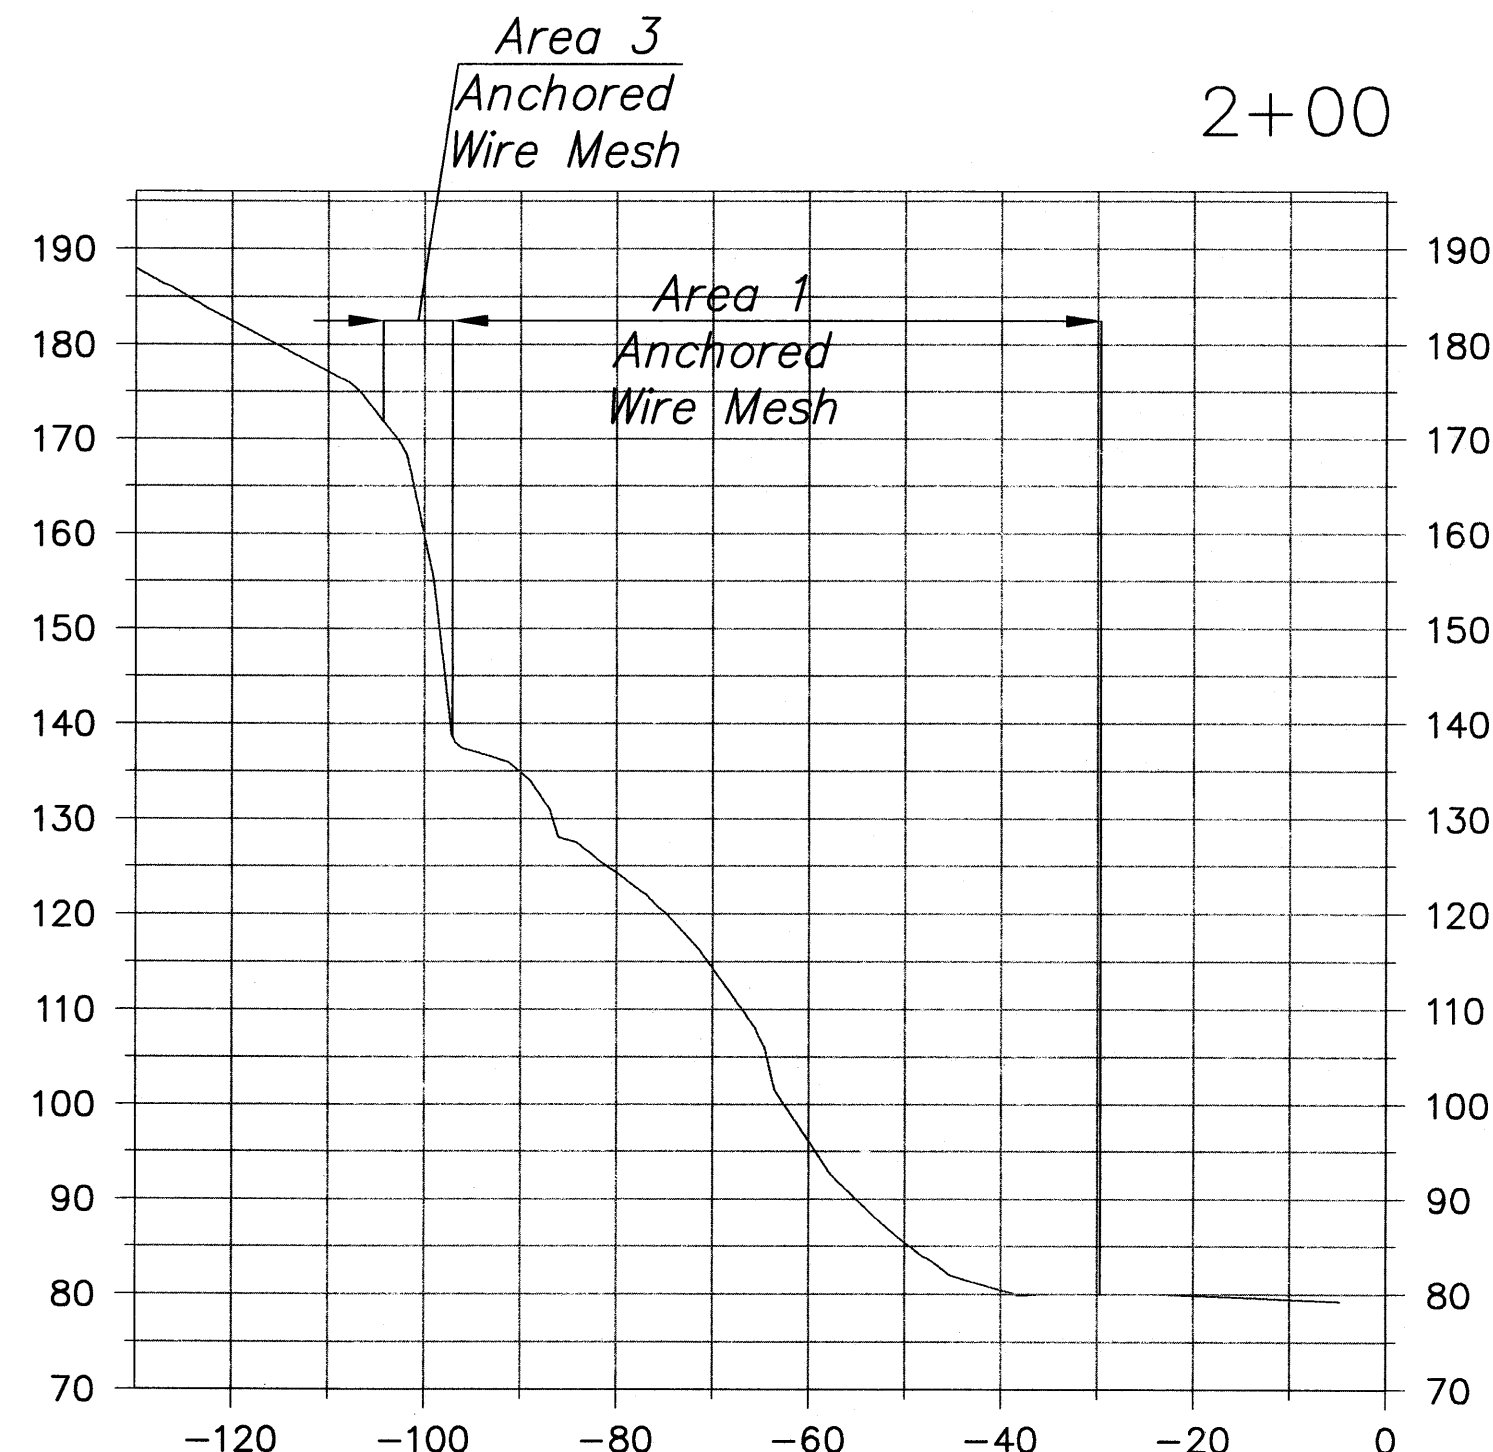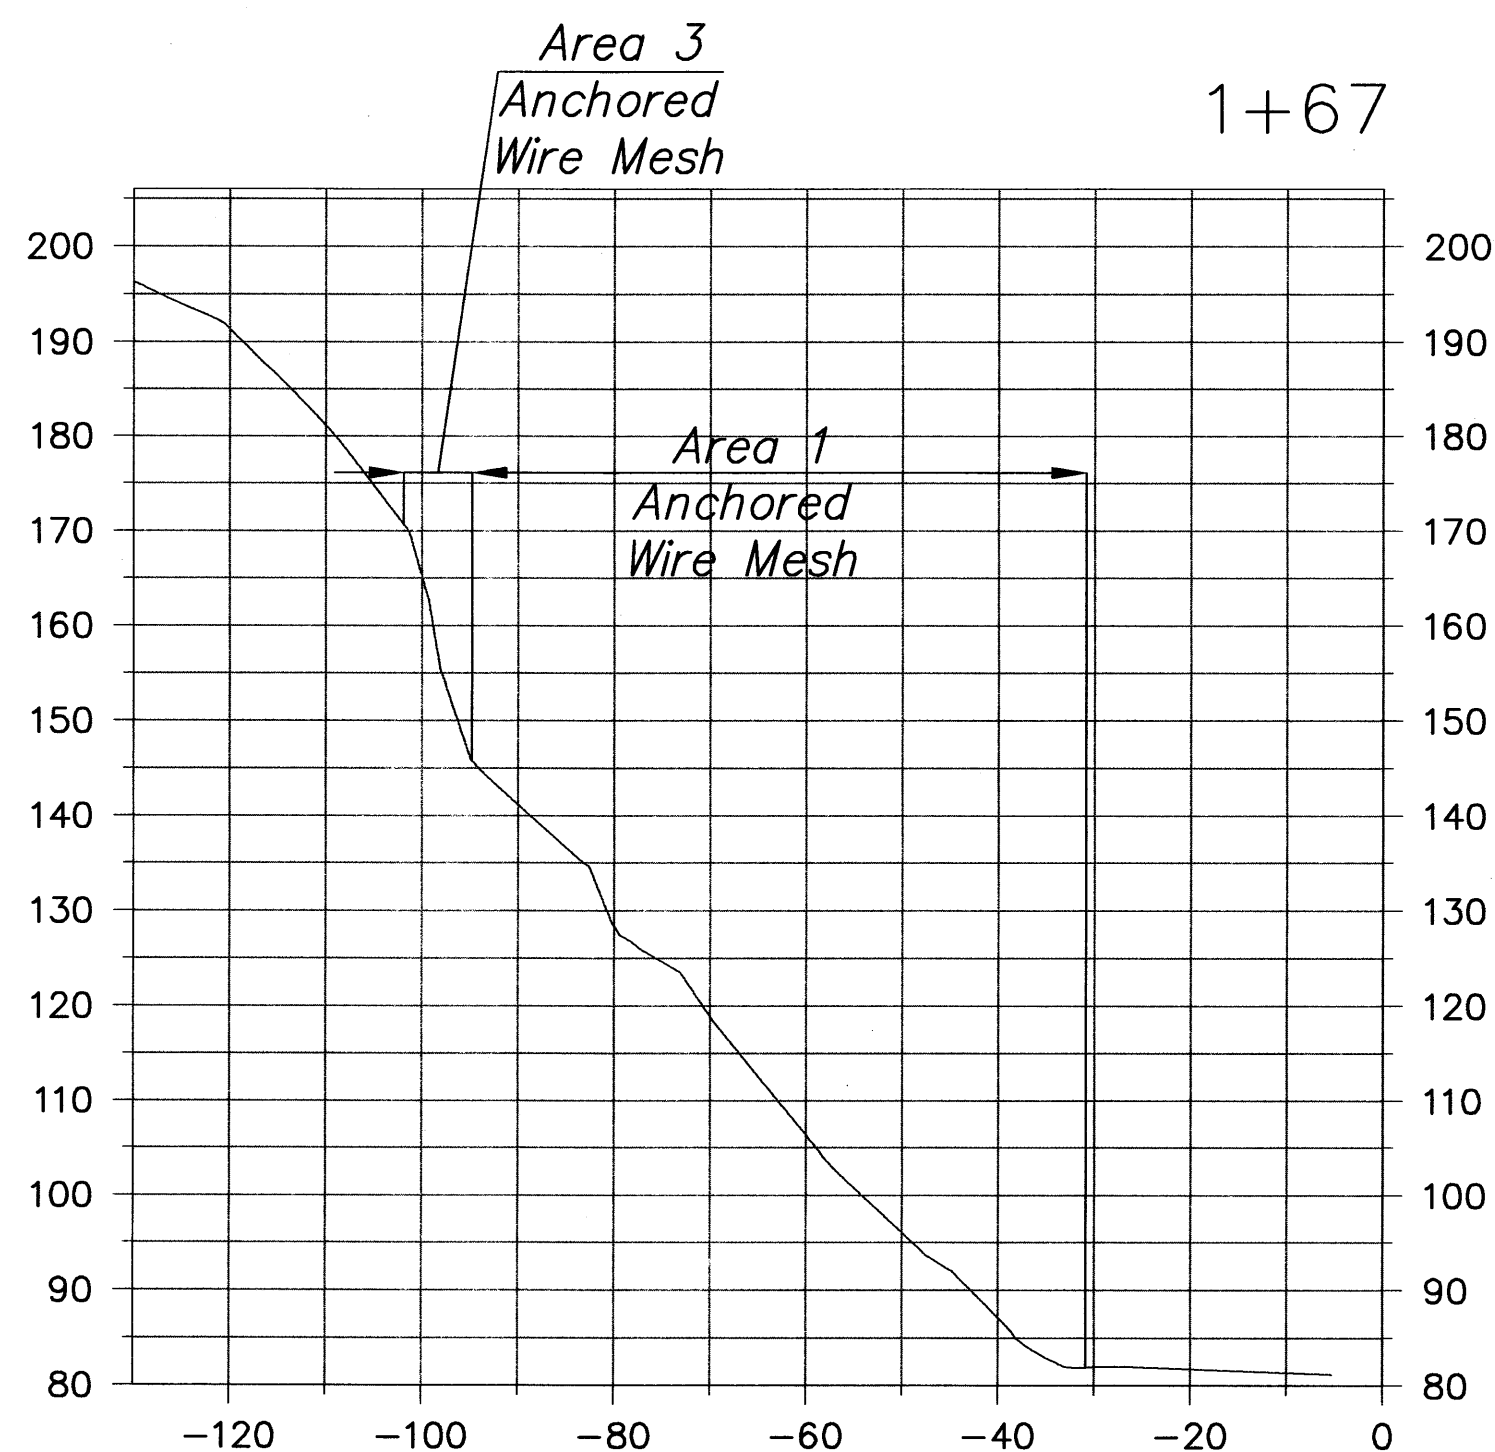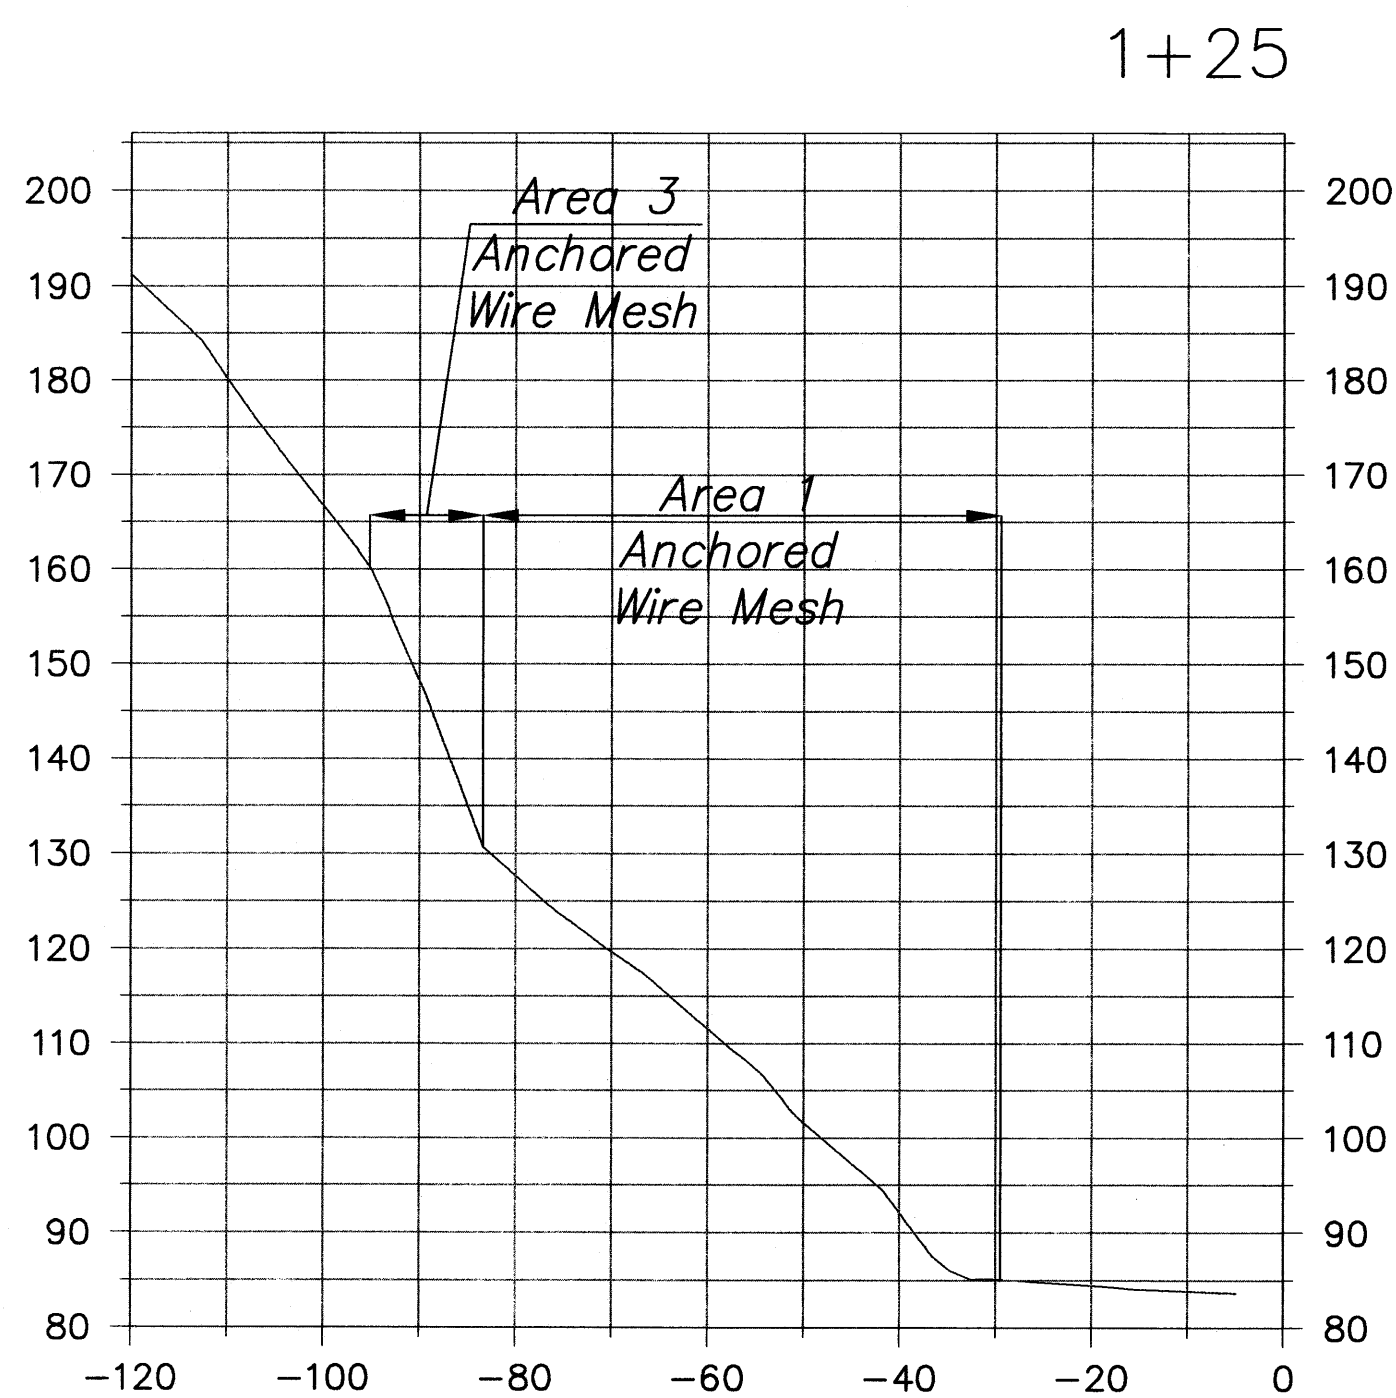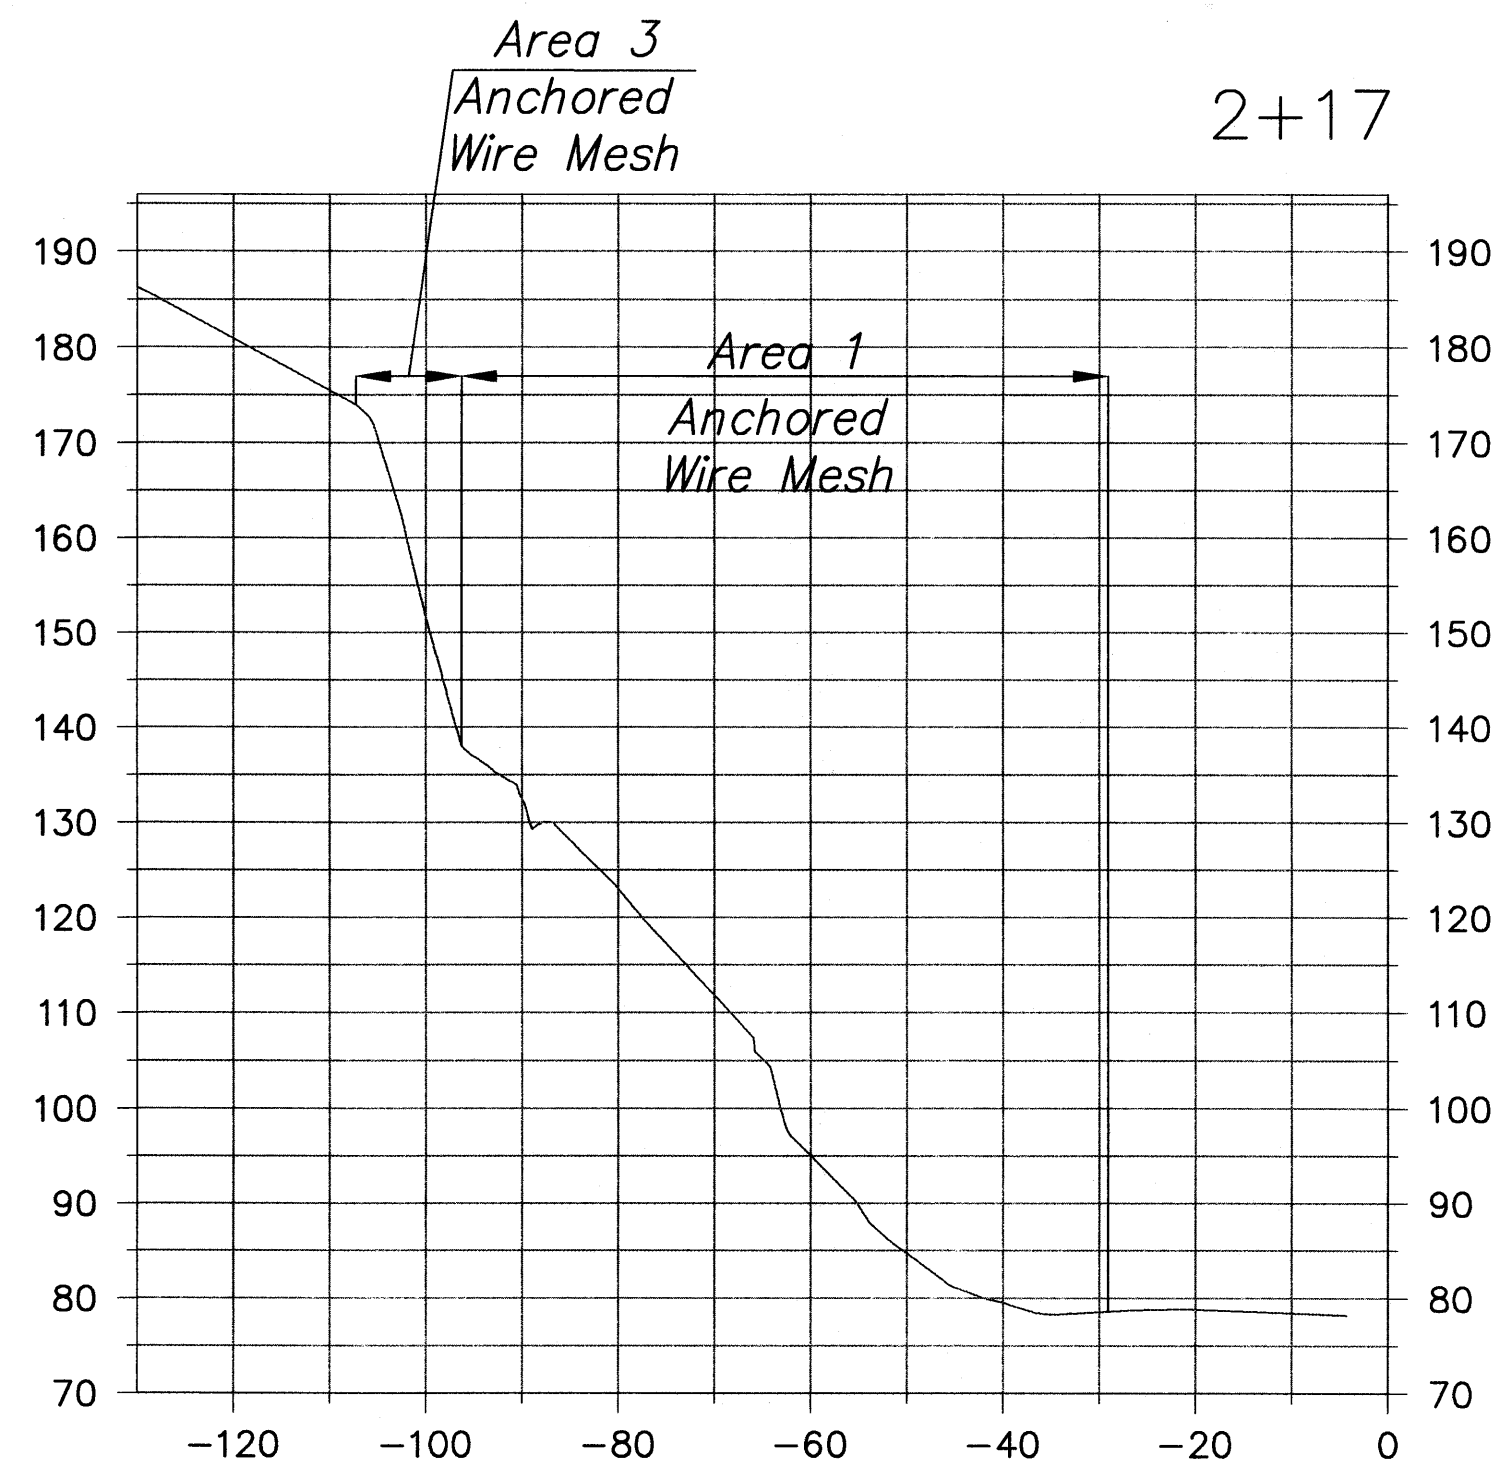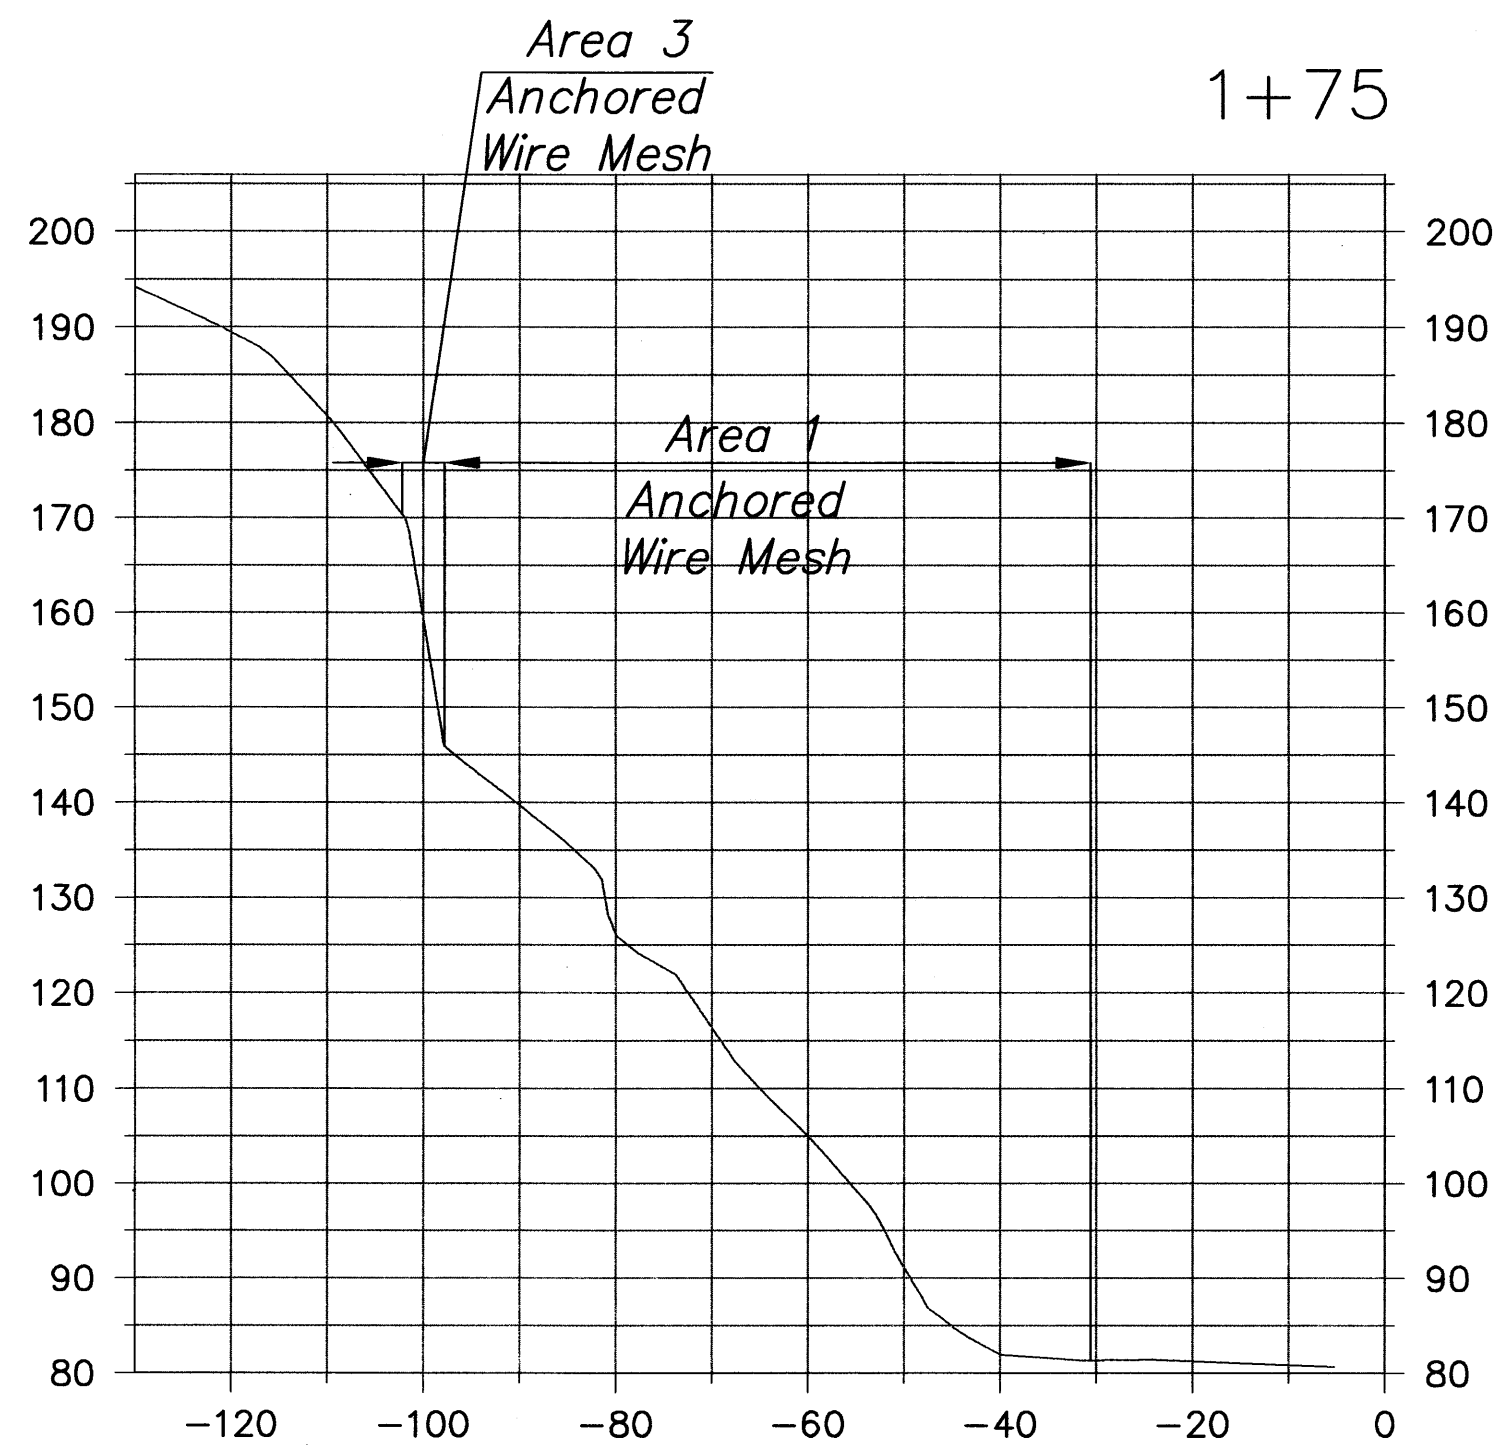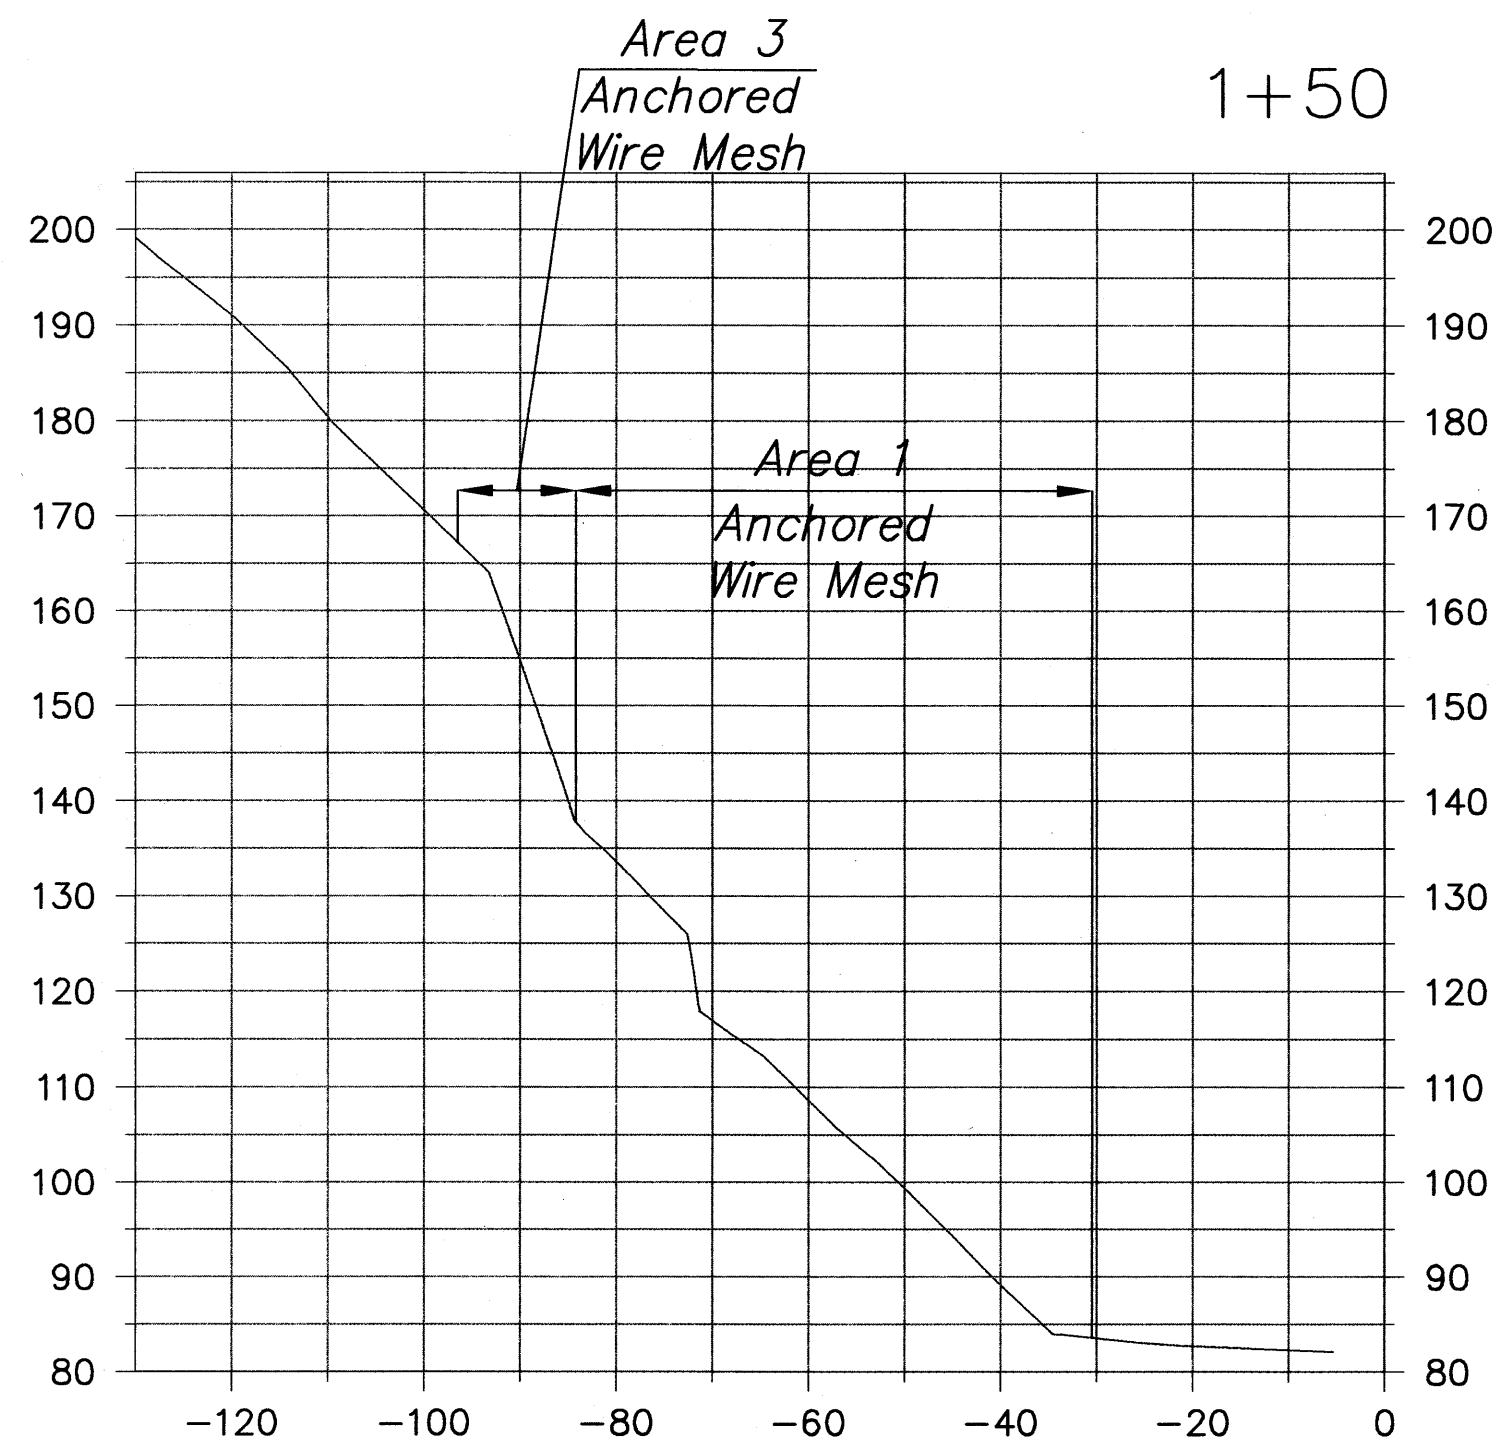


ORIGINAL PLAN	SURVEY PLOTTED BY	DATE
NOTE BOOK	DRAWN BY	
No.	DESIGNED BY	
	QUANTITIES BY	
	CHECKED BY	

P:\1\10077 Kulei Hwy Slope Stabilization\Drawings\29 Cross Sections.dwg 29/7/09 8:45 AM hromer

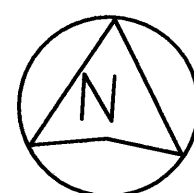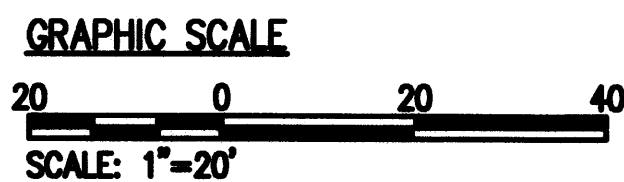

EARTH TECH | AECOM

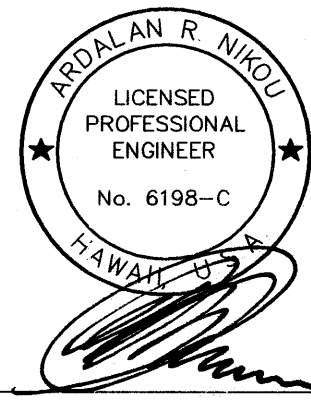

EXPIRATION DATE OF THE LICENSE 4/30/2010
THIS WORK WAS PREPARED BY
ME OR UNDER MY SUPERVISION.

STATE OF HAWAII
DEPARTMENT OF TRANSPORTATION
HIGHWAYS DIVISION







CROSS SECTIONS

KUHIO HIGHWAY SLOPE STABILIZATION
VICINITY OF HANALEI BRIDGE
PROJECT NO. 560A-02-03



Scale: As Noted Date: July 2009

SHEET No. 2 OF 5 SHEETS

FED. ROAD DIST. NO.	STATE	PROJ. NO.	FISCAL YEAR	SHEET NO.	TOTAL SHEETS
KAUAI	HAWAII	560A-02-03	2010	30	32

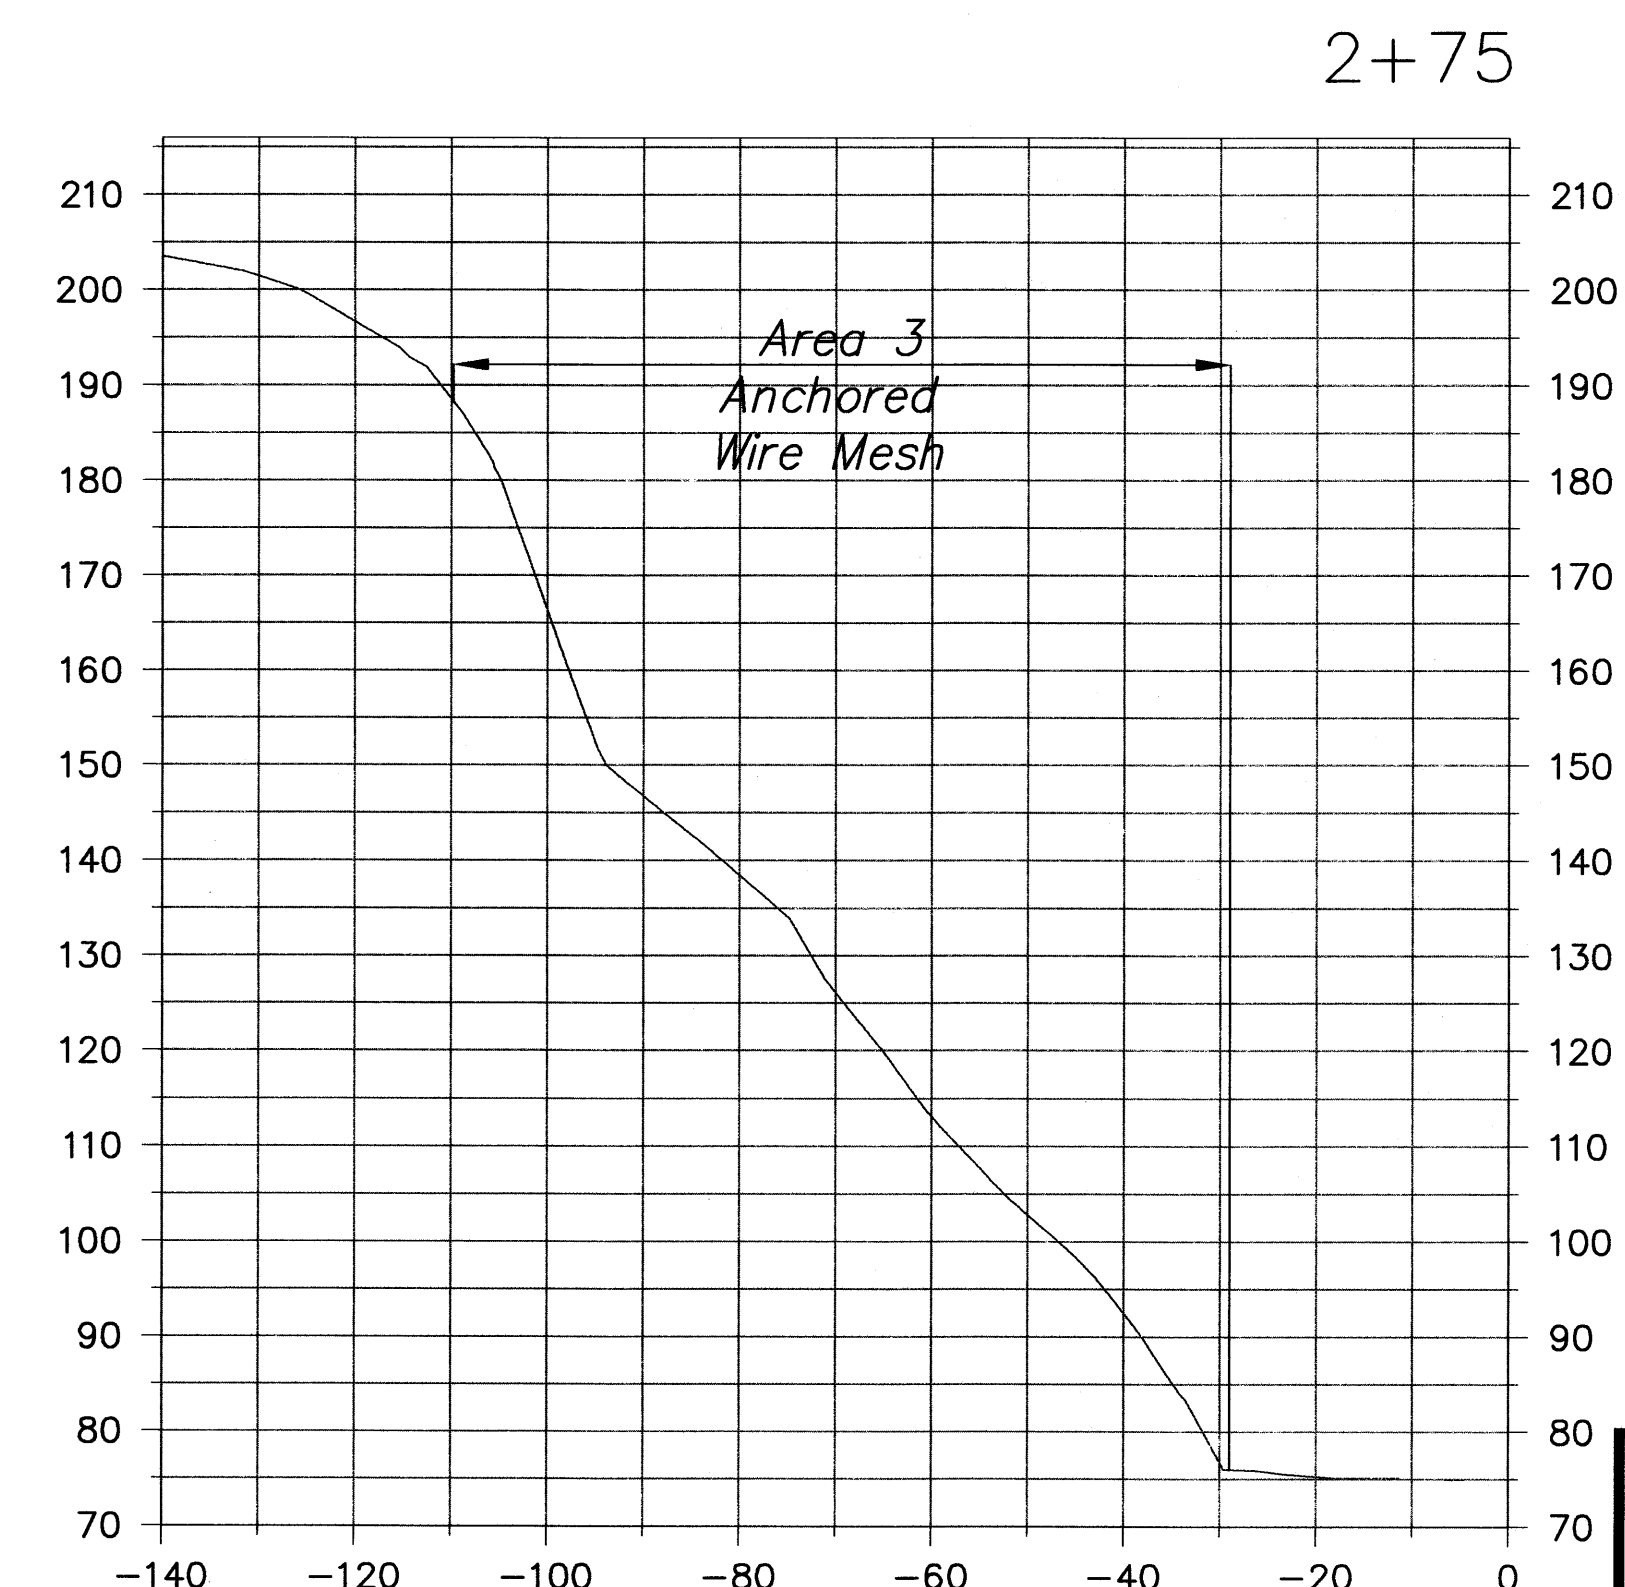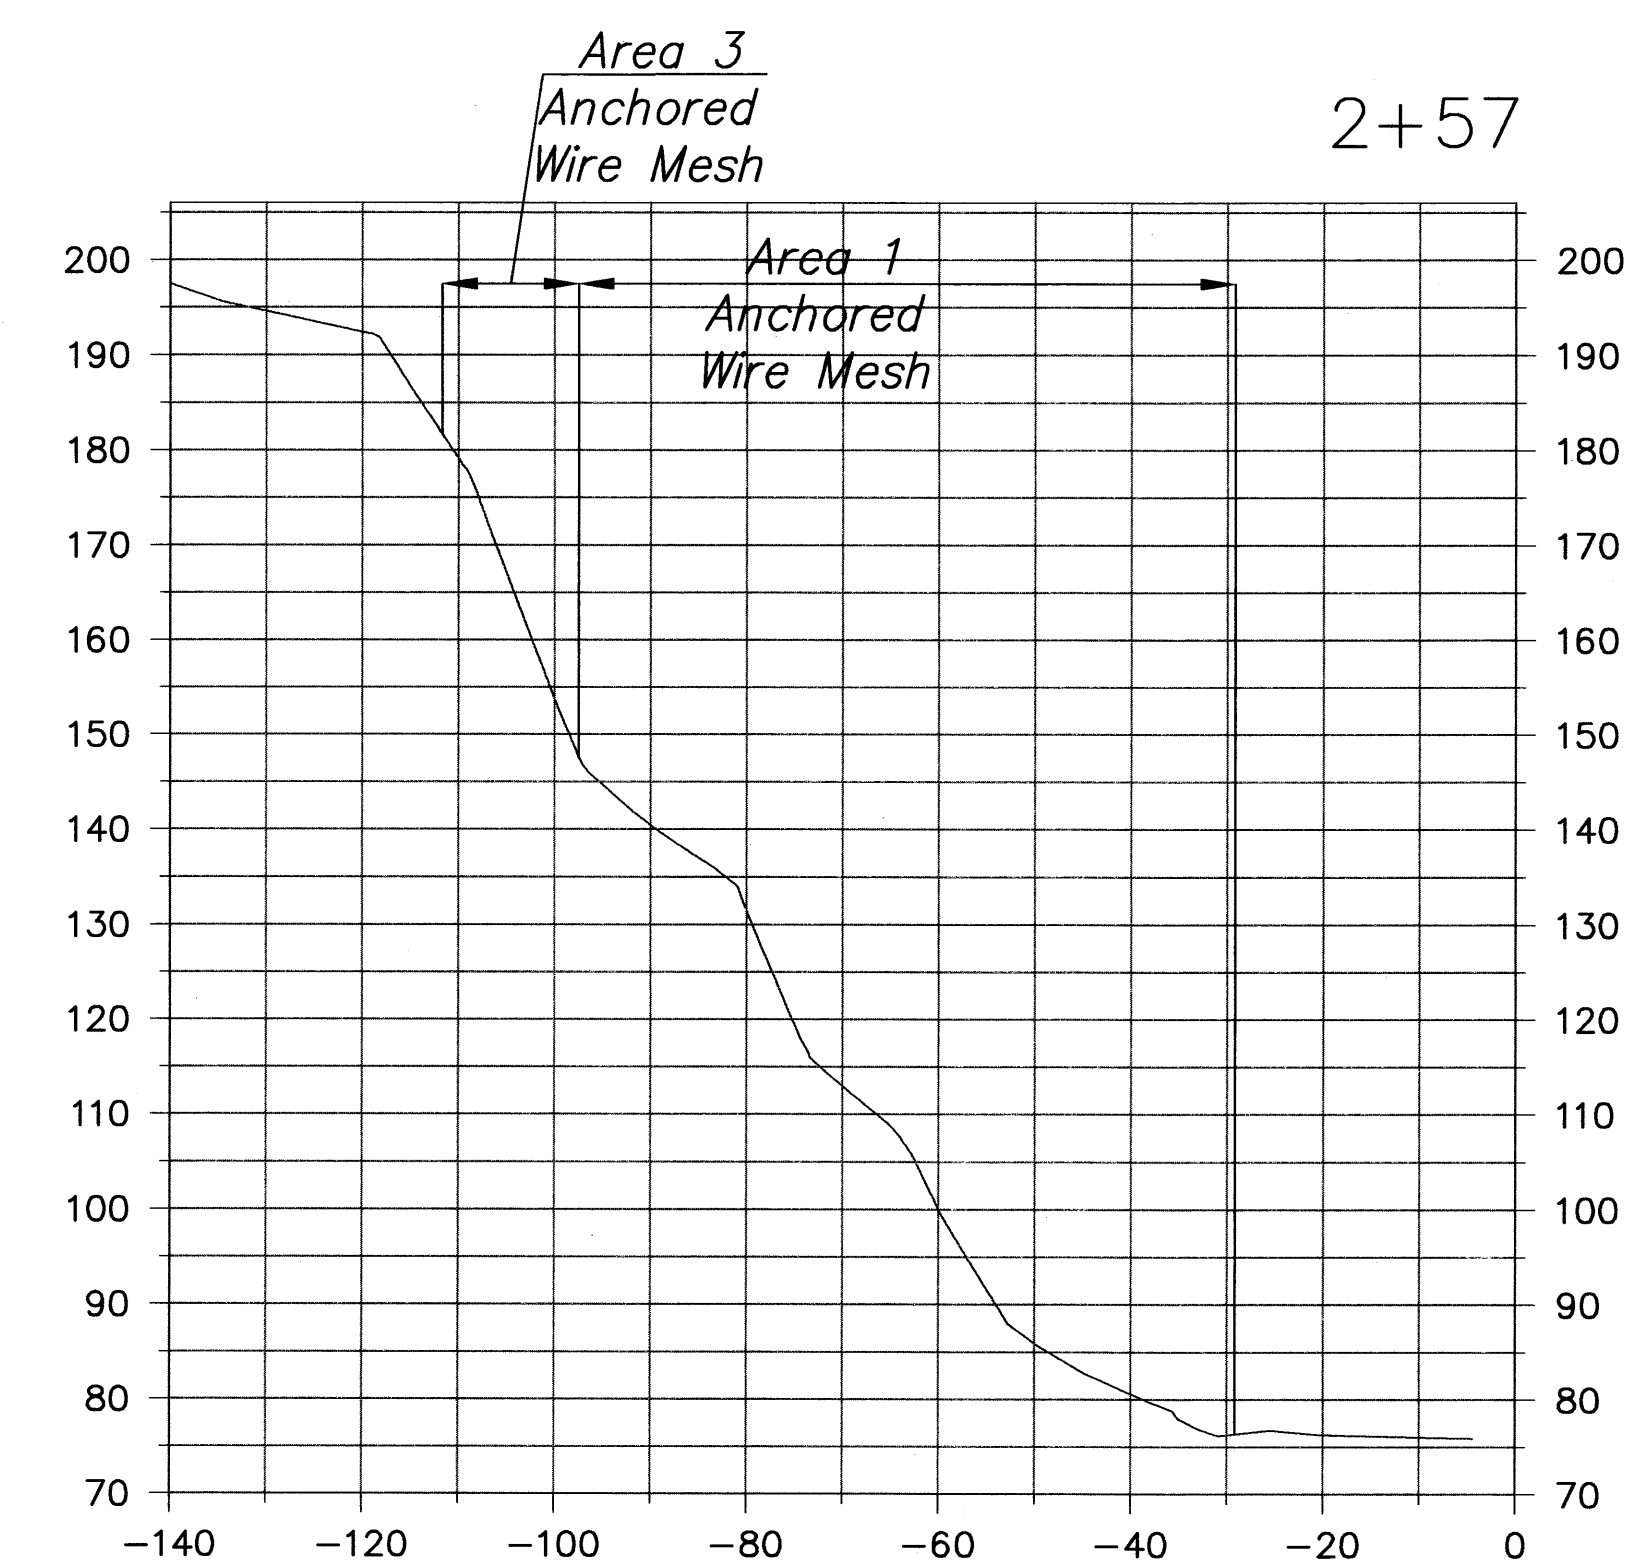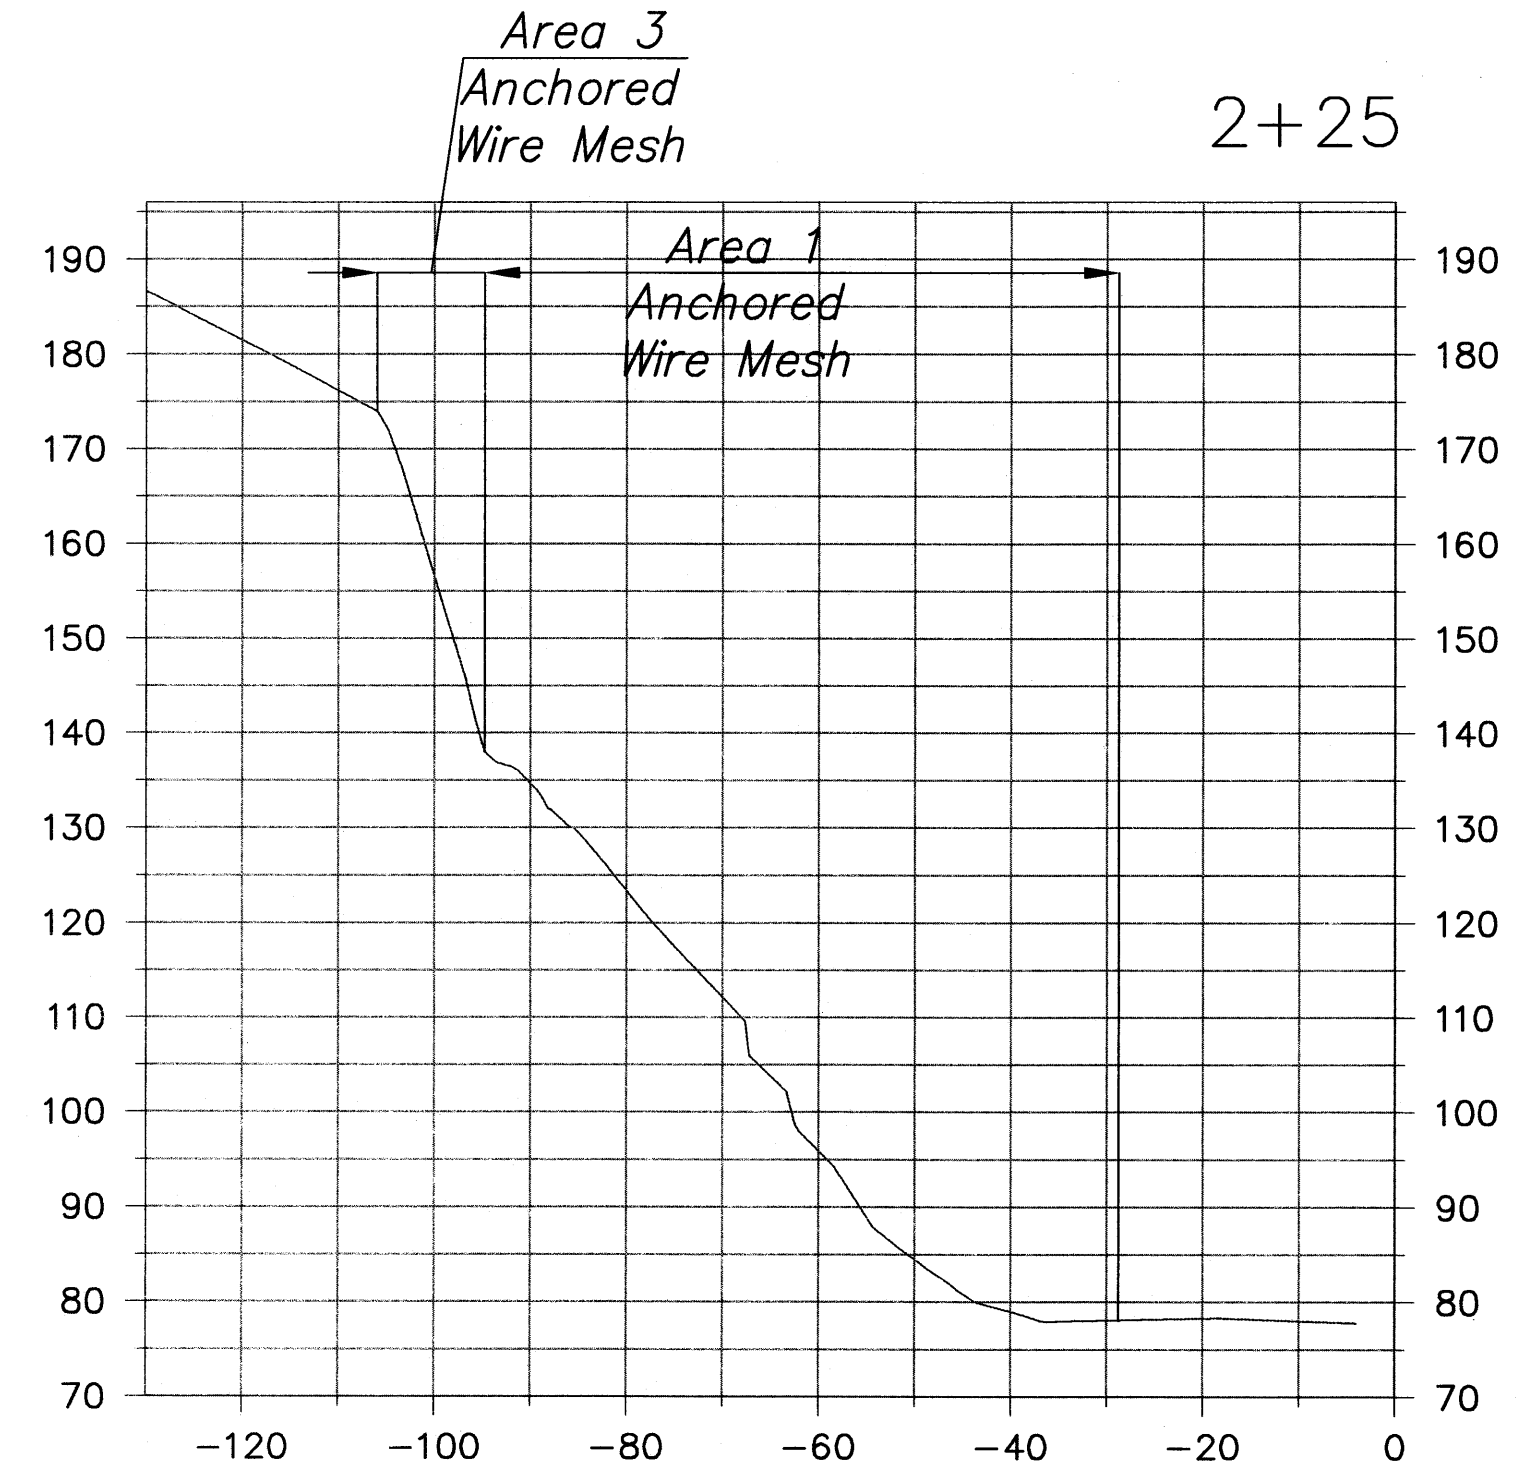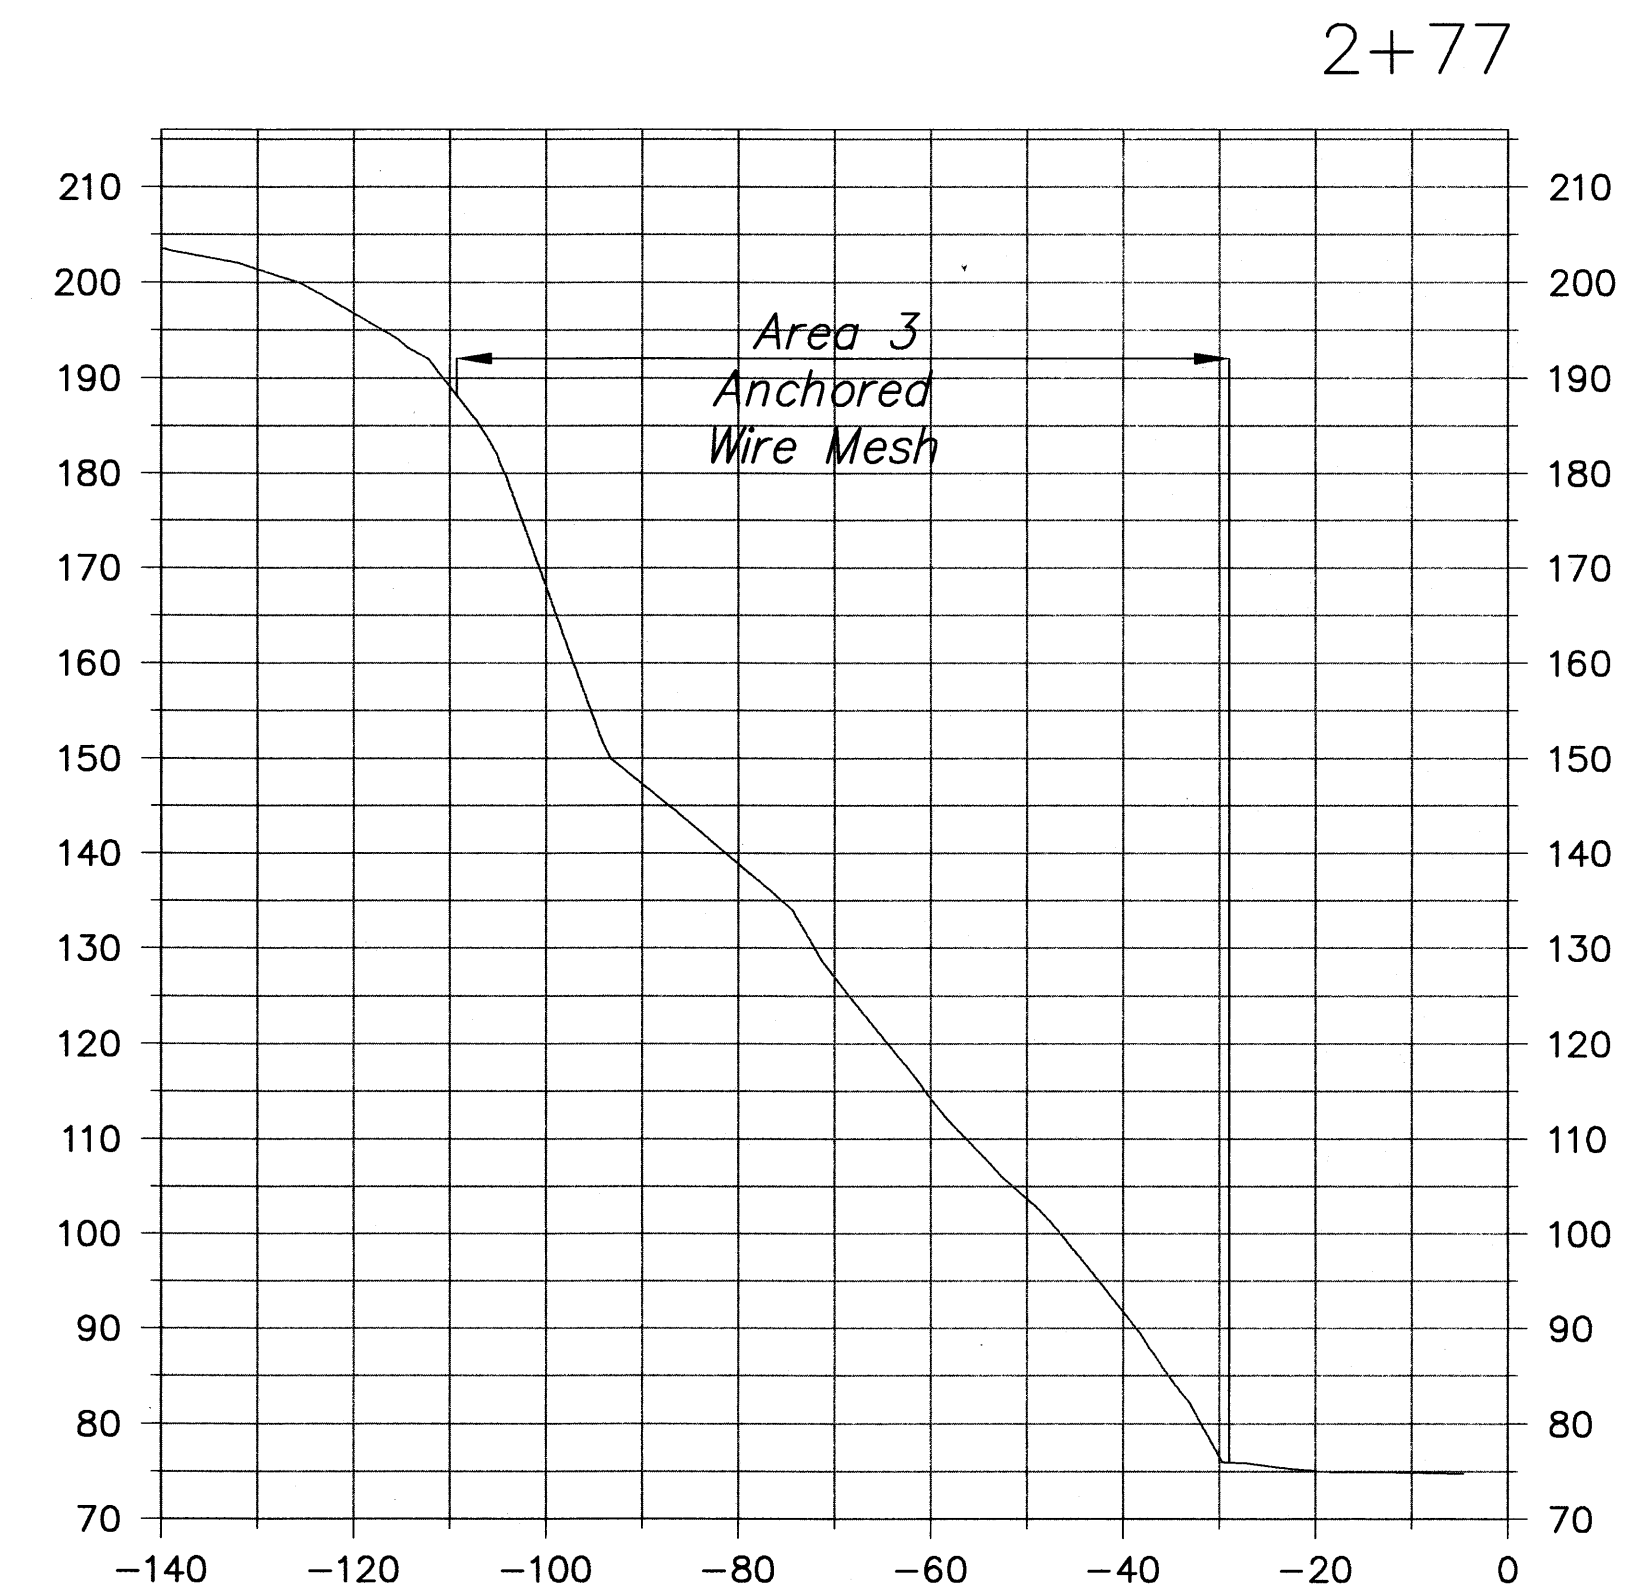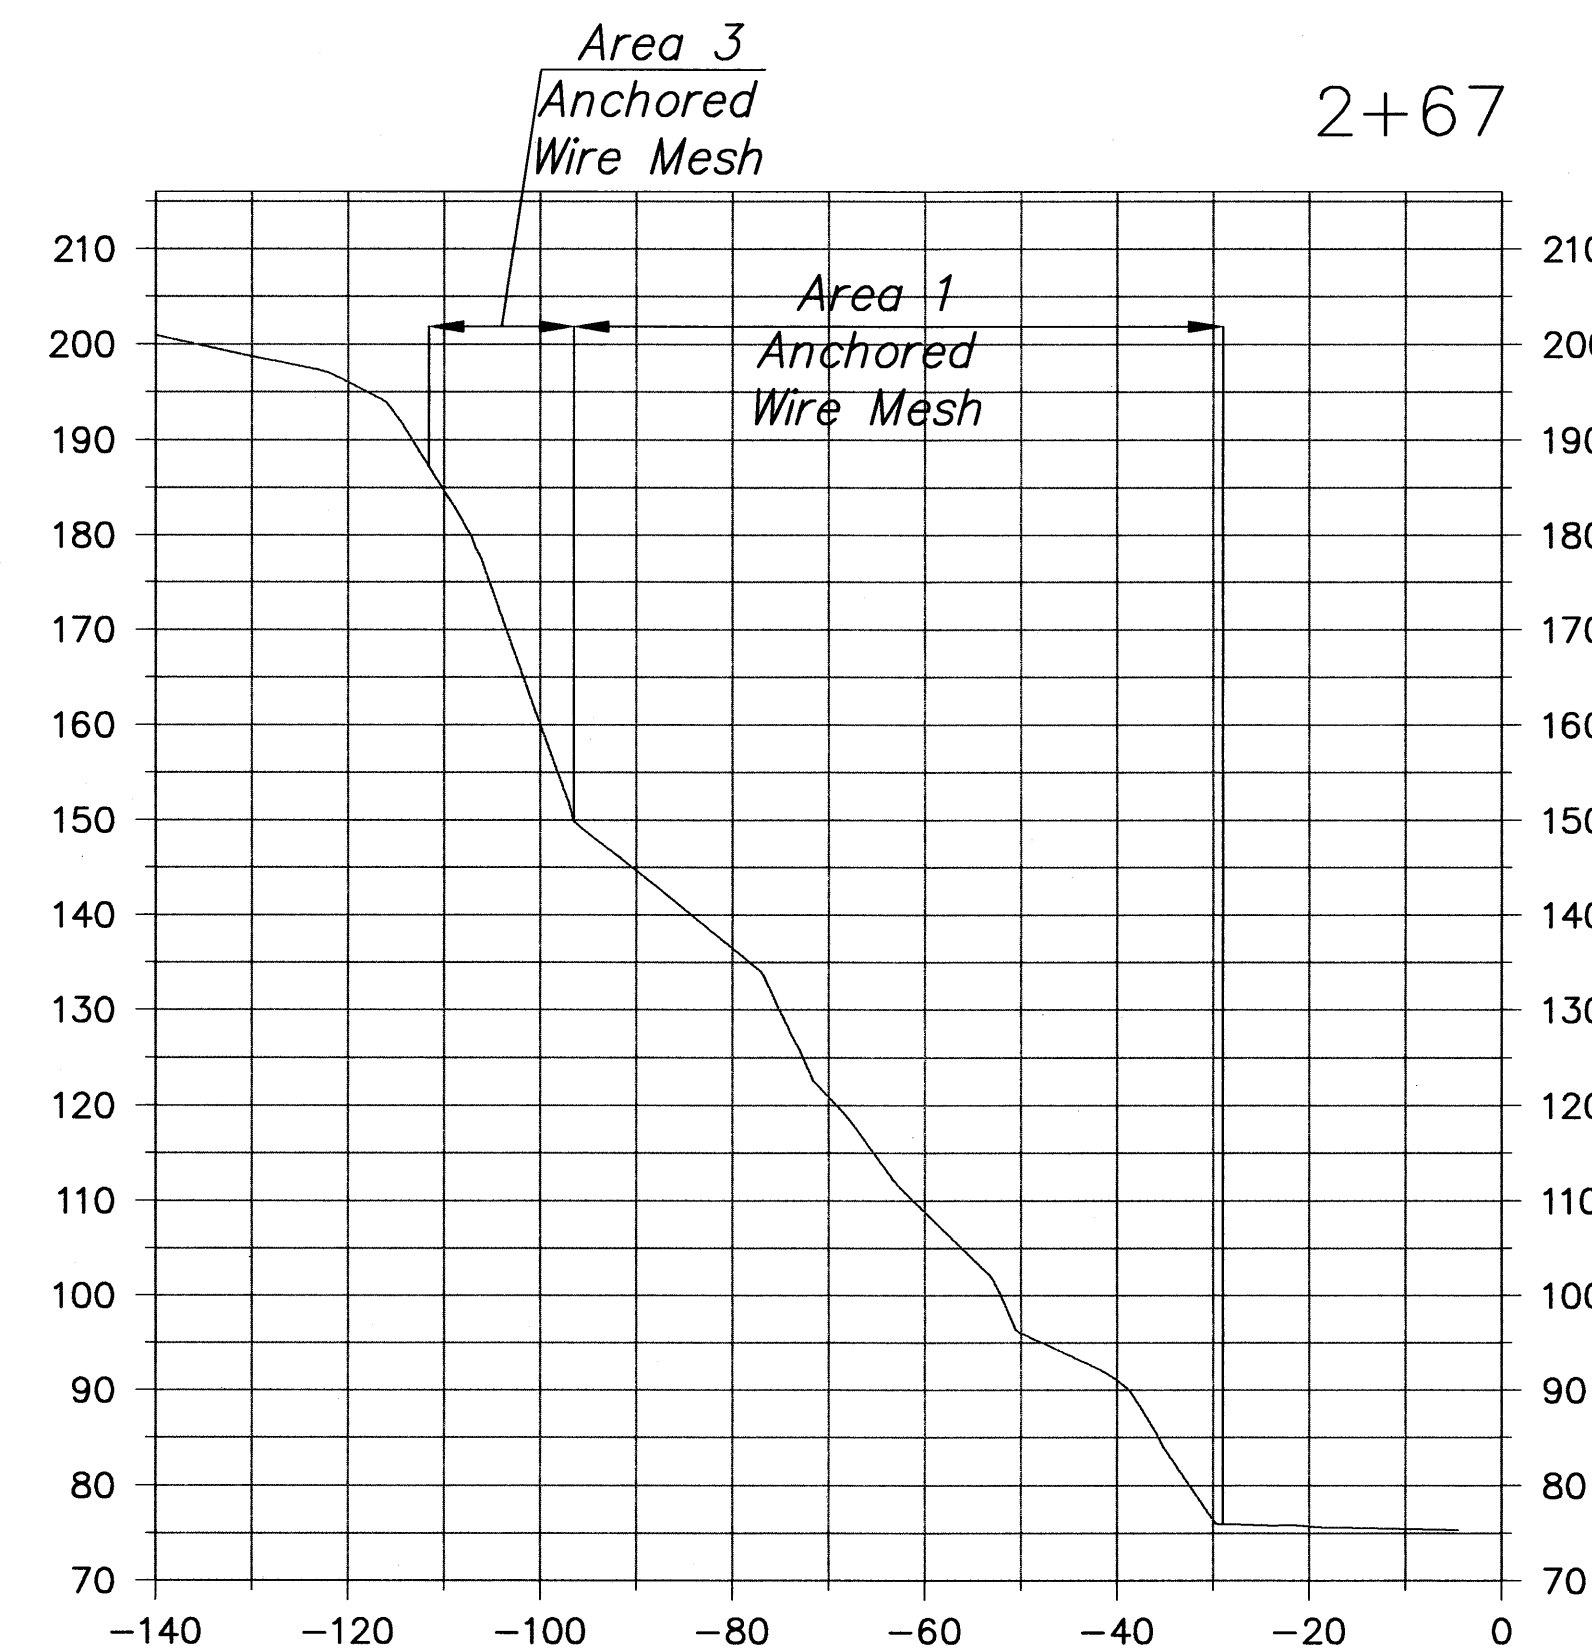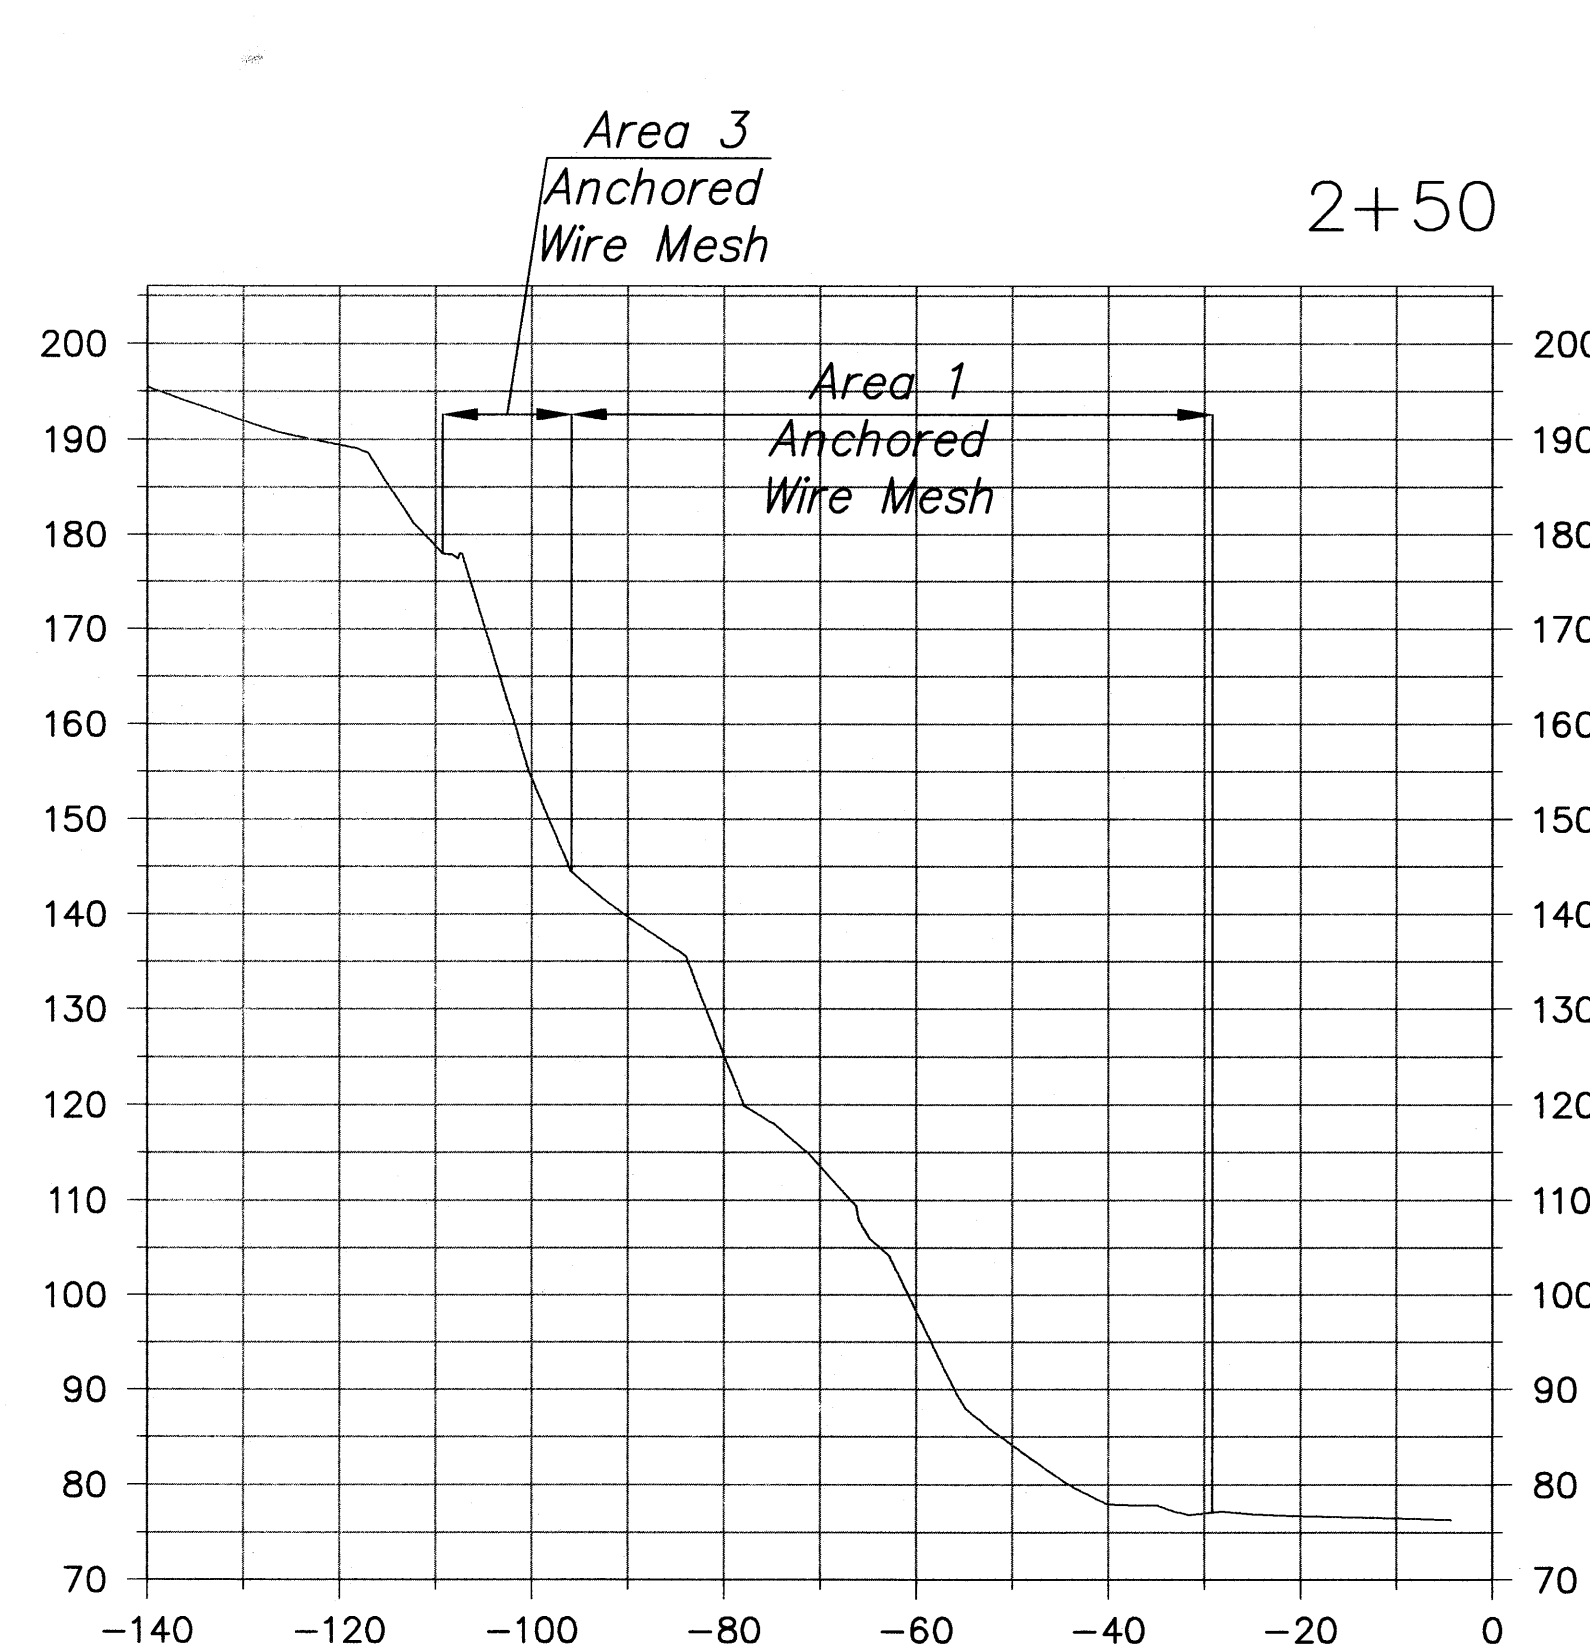

ORIGINAL PLAN	SURVEY PLOTTED BY	DATE
NOTE BOOK	DESIGNED BY	
	QUANTITIES BY	
	CHECKED BY	
No.		

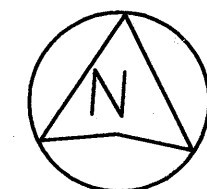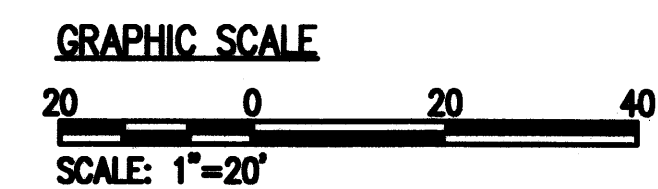

EARTH TECH

AECOM

STATE OF HAWAII

DEPARTMENT OF TRANSPORTATION

HIGHWAYS DIVISION

CROSS SECTIONS

KUHIO HIGHWAY SLOPE STABILIZATION

VICINITY OF HANAIEI BRIDGE







PROJECT NO. 560A-02-03

Scale: As Noted

Date: July 2009



SHEET No. 3 OF 5 SHEETS

FED. ROAD DIST. NO.	STATE	PROJ. NO.	FISCAL YEAR	SHEET NO.	TOTAL SHEETS
KAUAI	HAWAII	560A-02-03	2010	31	32

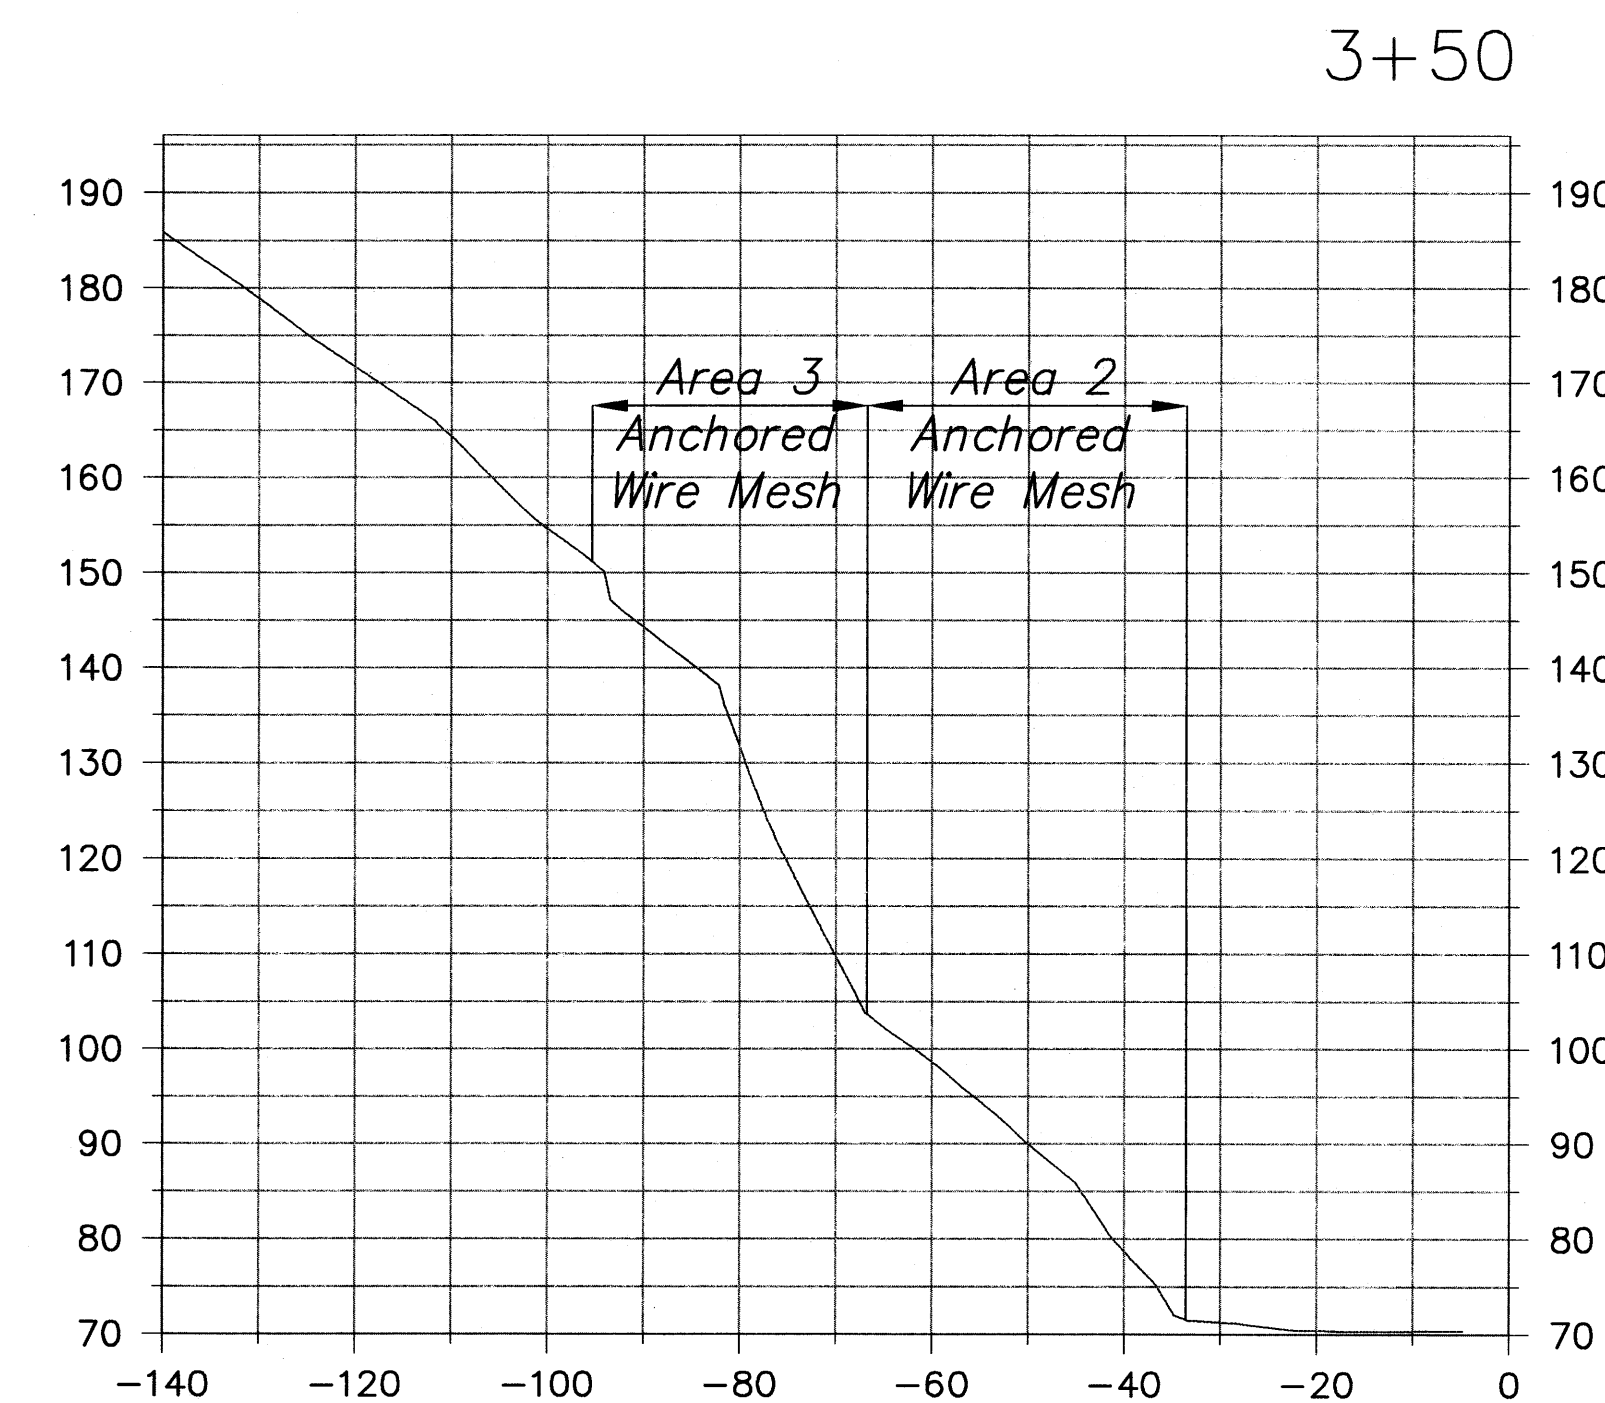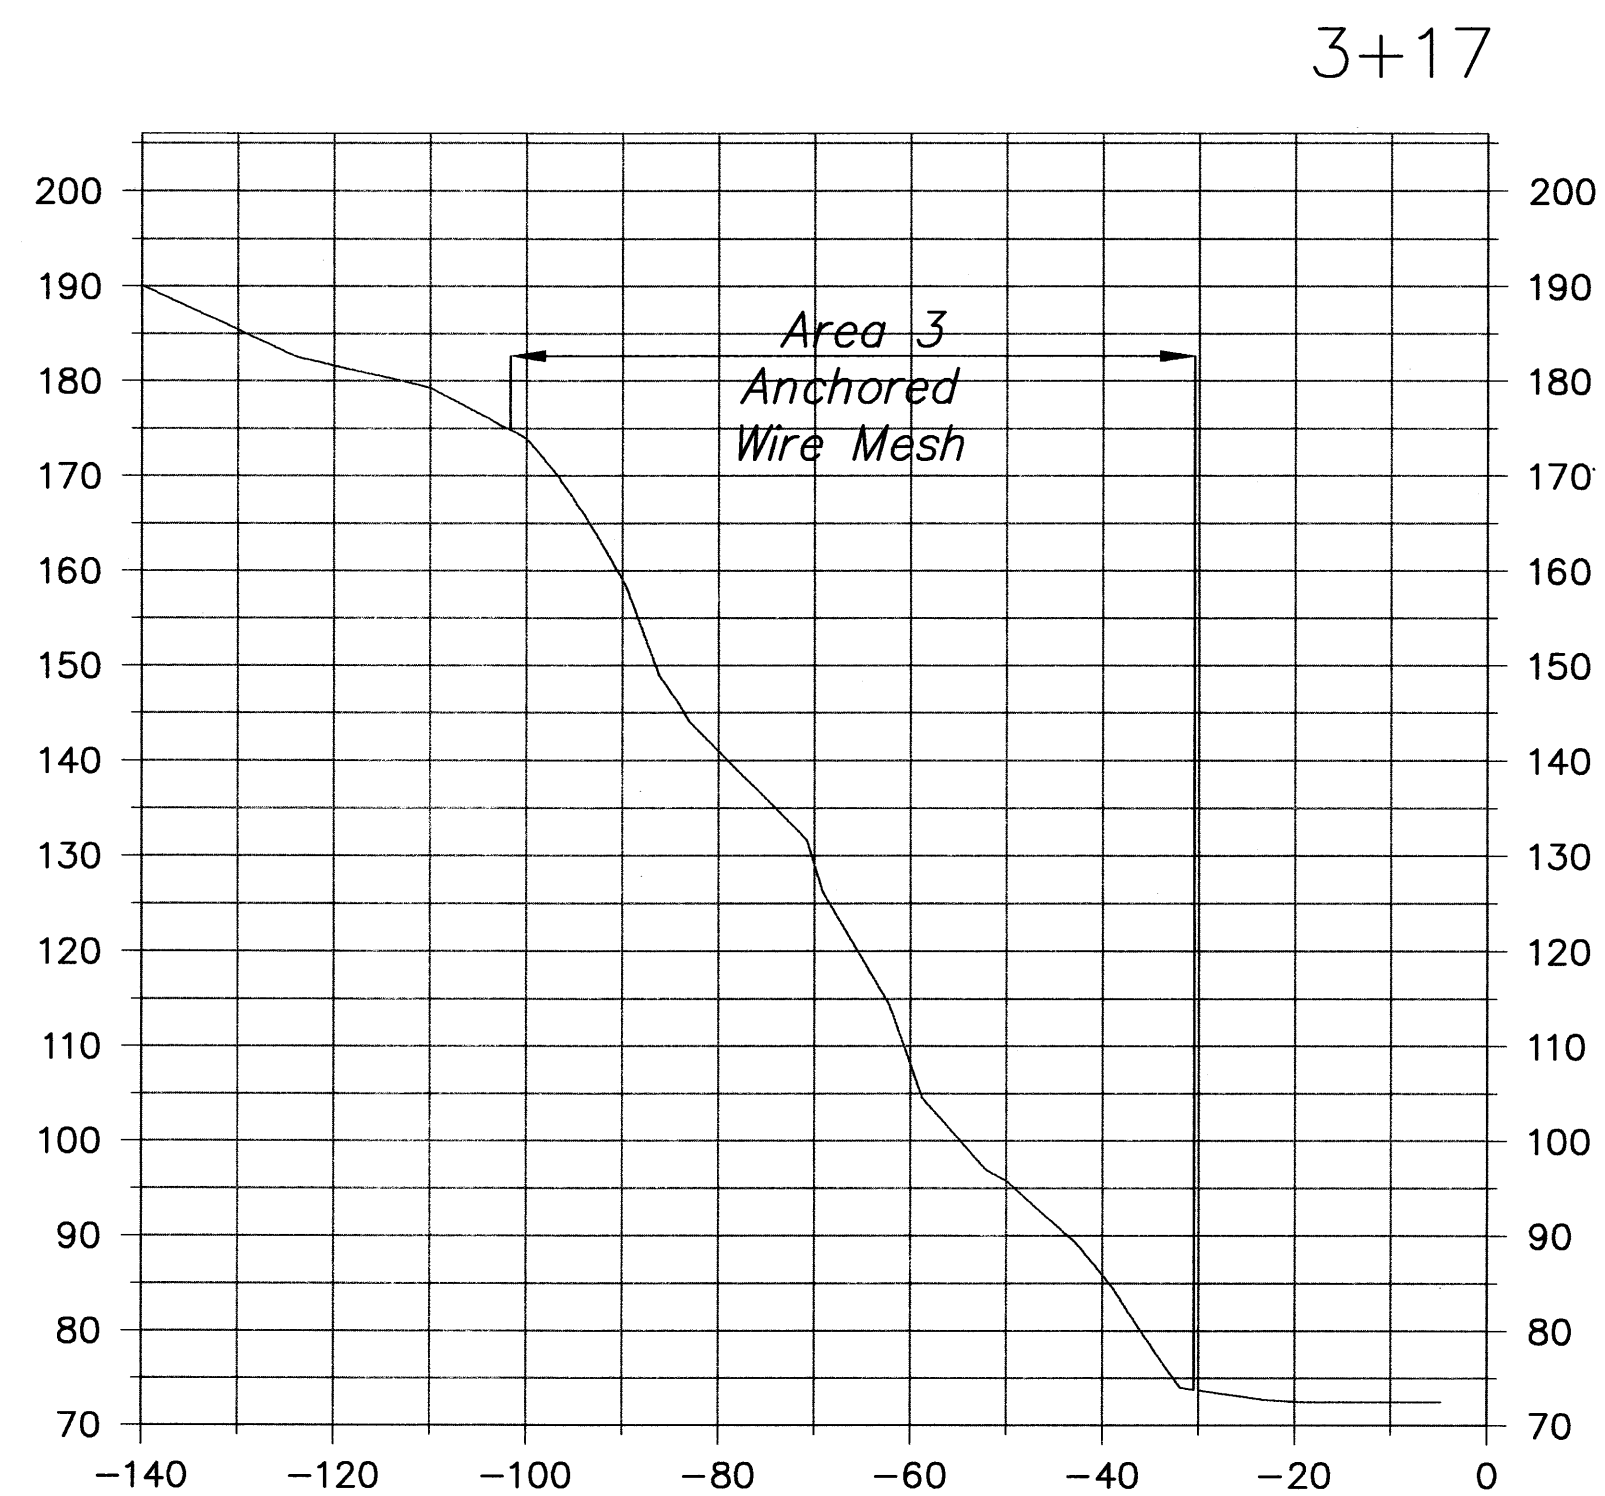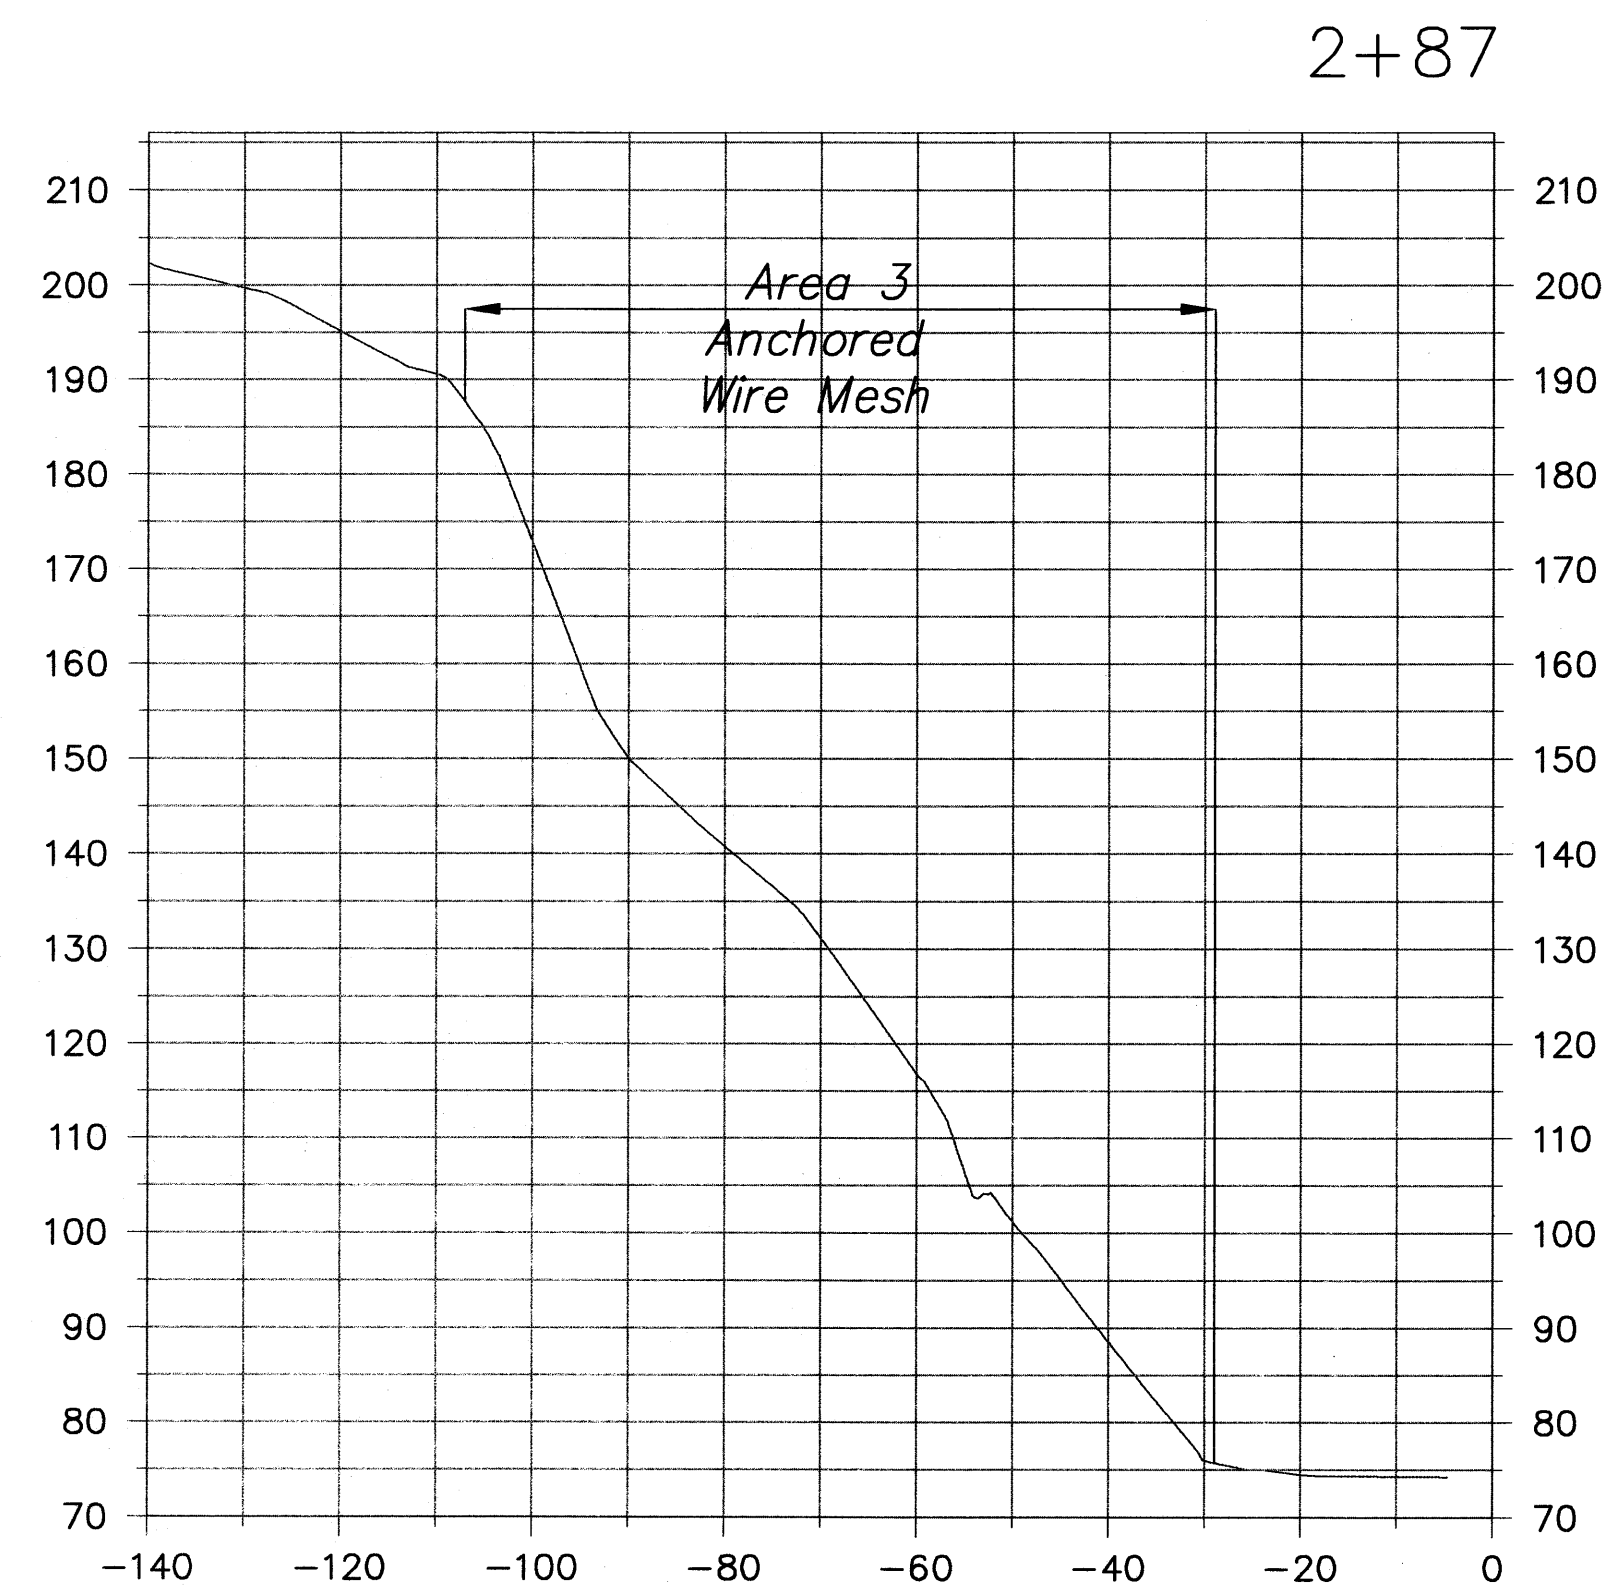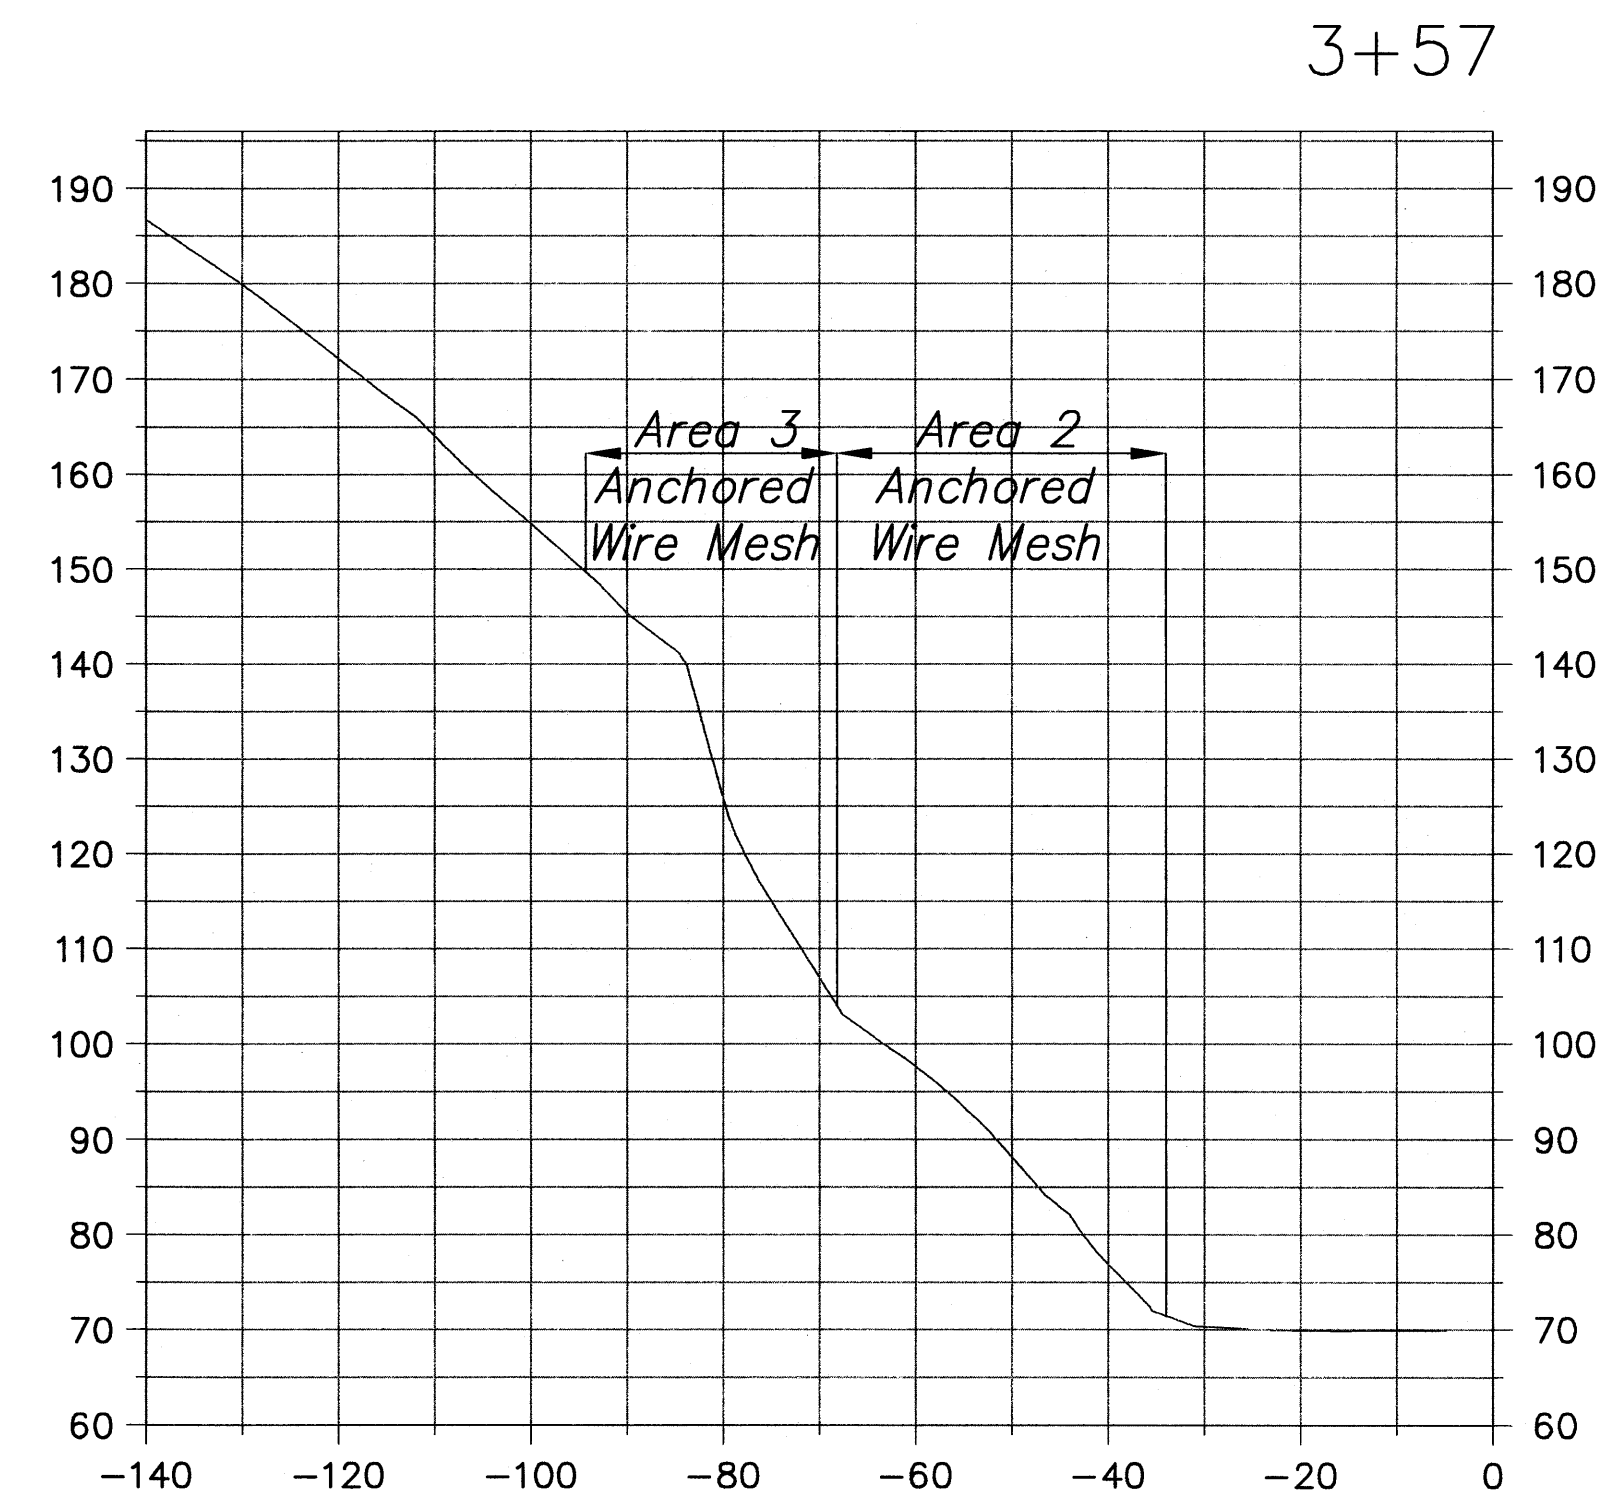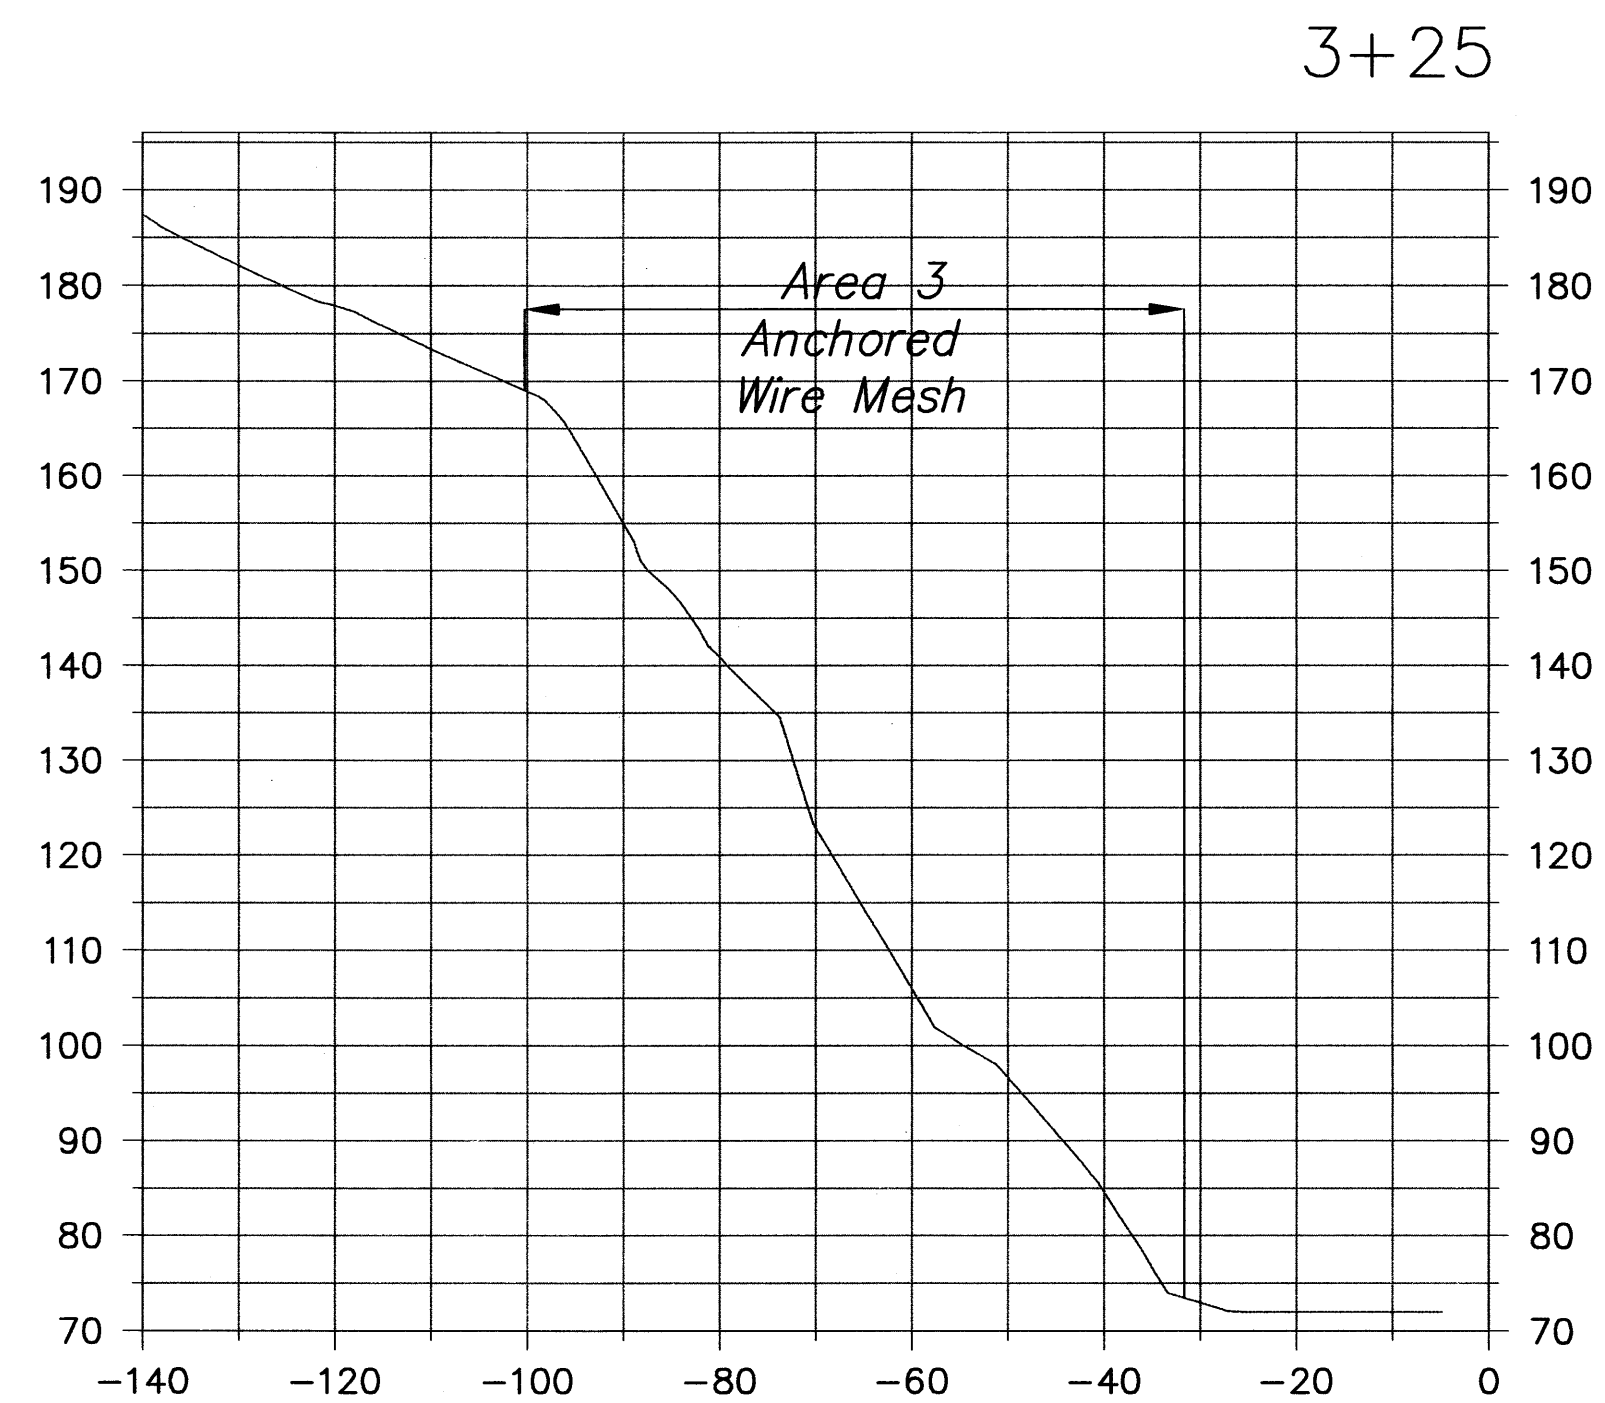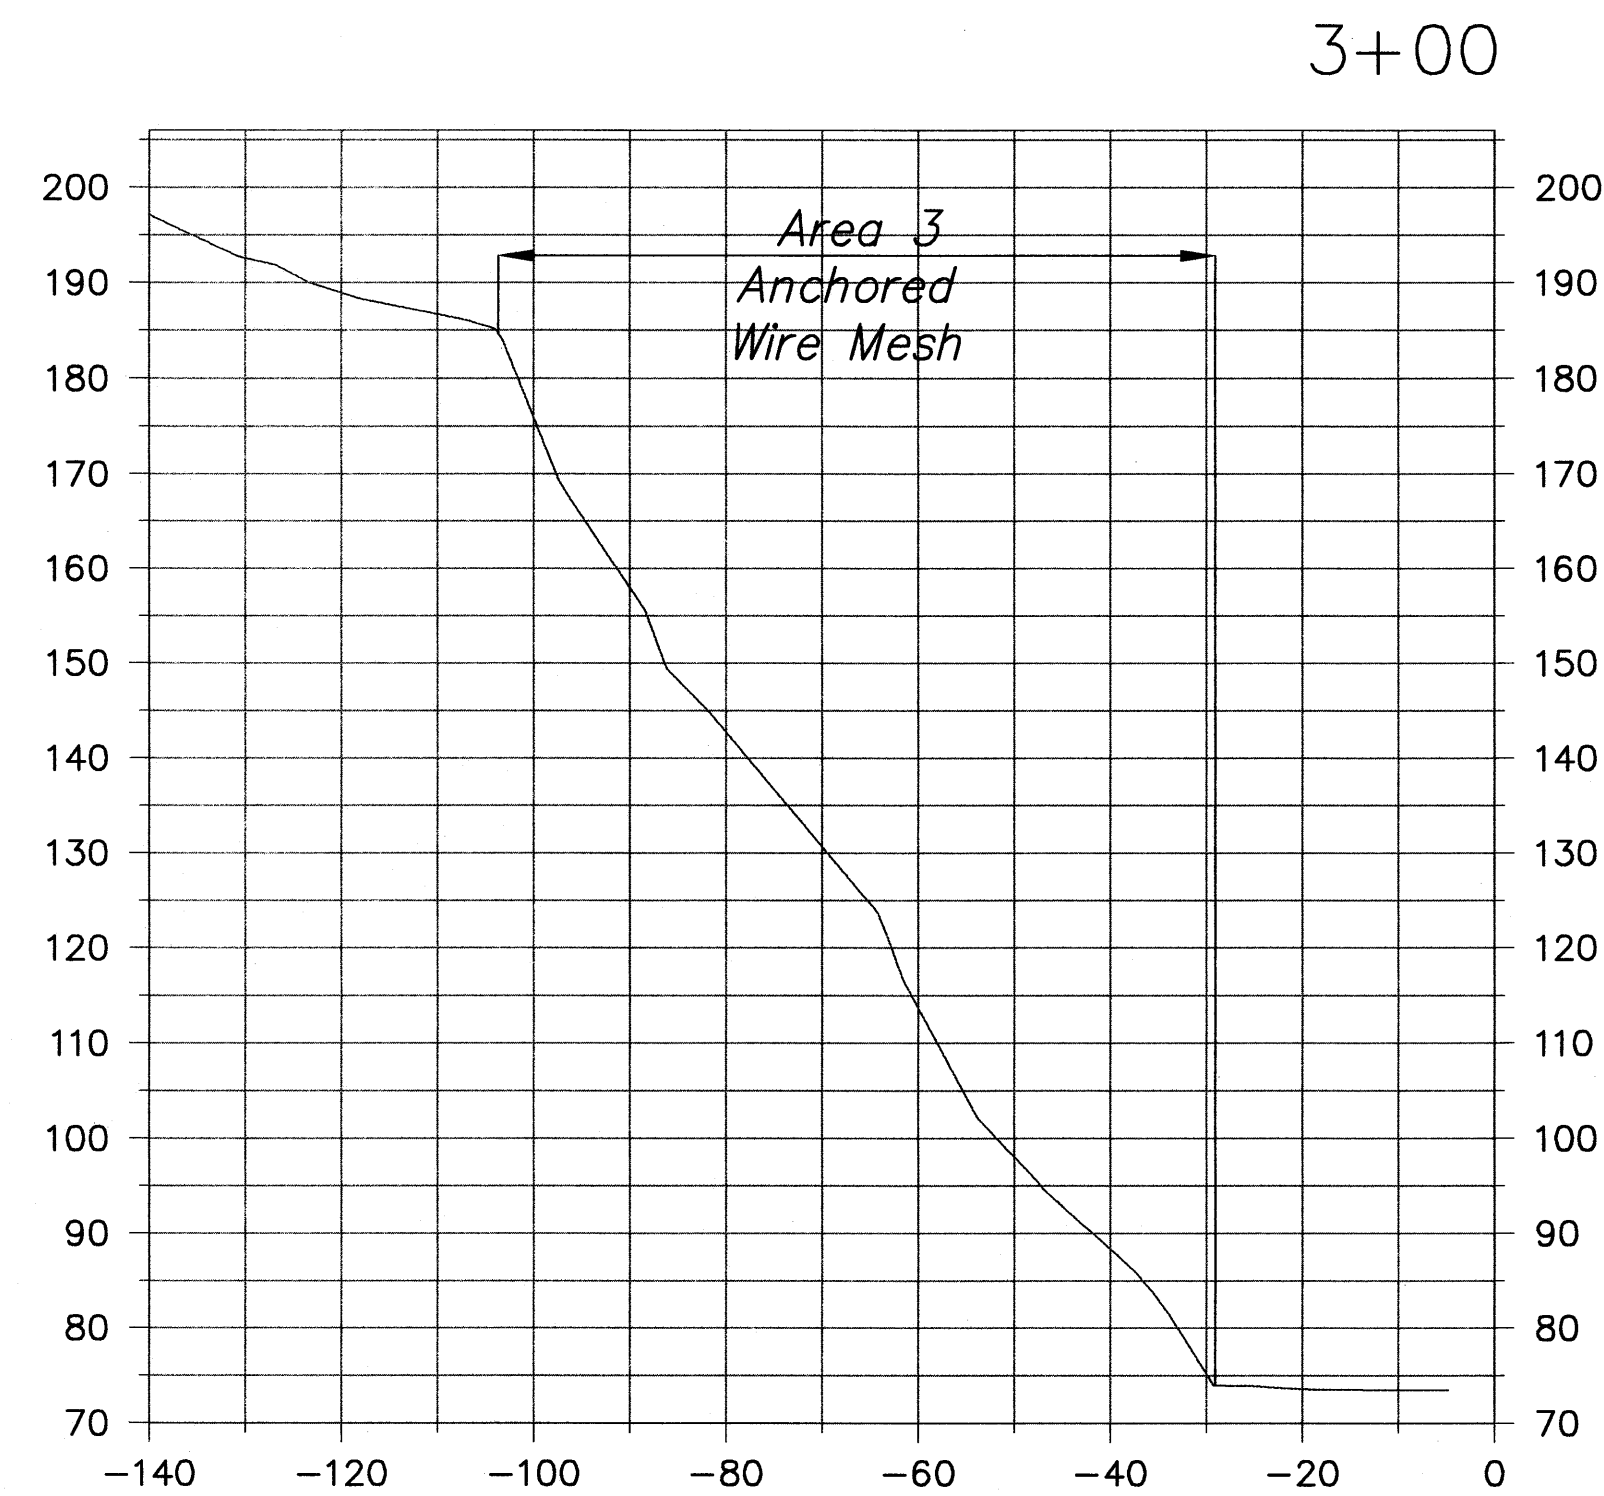


P:\1\10077 Kulei Hwy Slope Stabilization\Drawings\03 Cross Sections.dwg 5/17/2010 8:44 AM hammond

ORIGINAL PLAN	SURVEY PLATTED BY	DATE
NOTE BOOK	DRAWN BY	
	DESIGNED BY	
	QUANTITIES BY	
	CHECKED BY	
	No.	

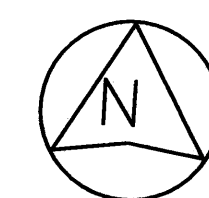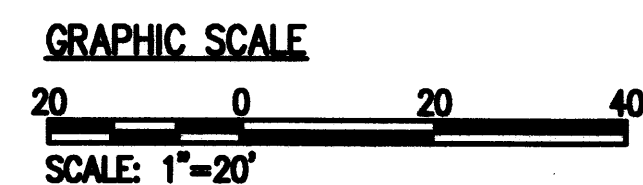

EARTH TECH | AECOM

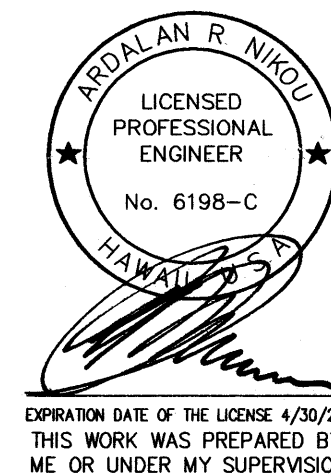

STATE OF HAWAII
DEPARTMENT OF TRANSPORTATION
HIGHWAYS DIVISION







CROSS SECTIONS

**KUHIO HIGHWAY SLOPE STABILIZATION
VICINITY OF HANAIEI BRIDGE
PROJECT NO. 560A-02-03**

Scale: As Noted Date: July 2009



SHEET No. 4 OF 5 SHEETS

FED. ROAD DIST. NO.	STATE	PROJ. NO.	FISCAL YEAR	SHEET NO.	TOTAL SHEETS
KAUAI	HAWAII	560A-02-03	2010	32	32

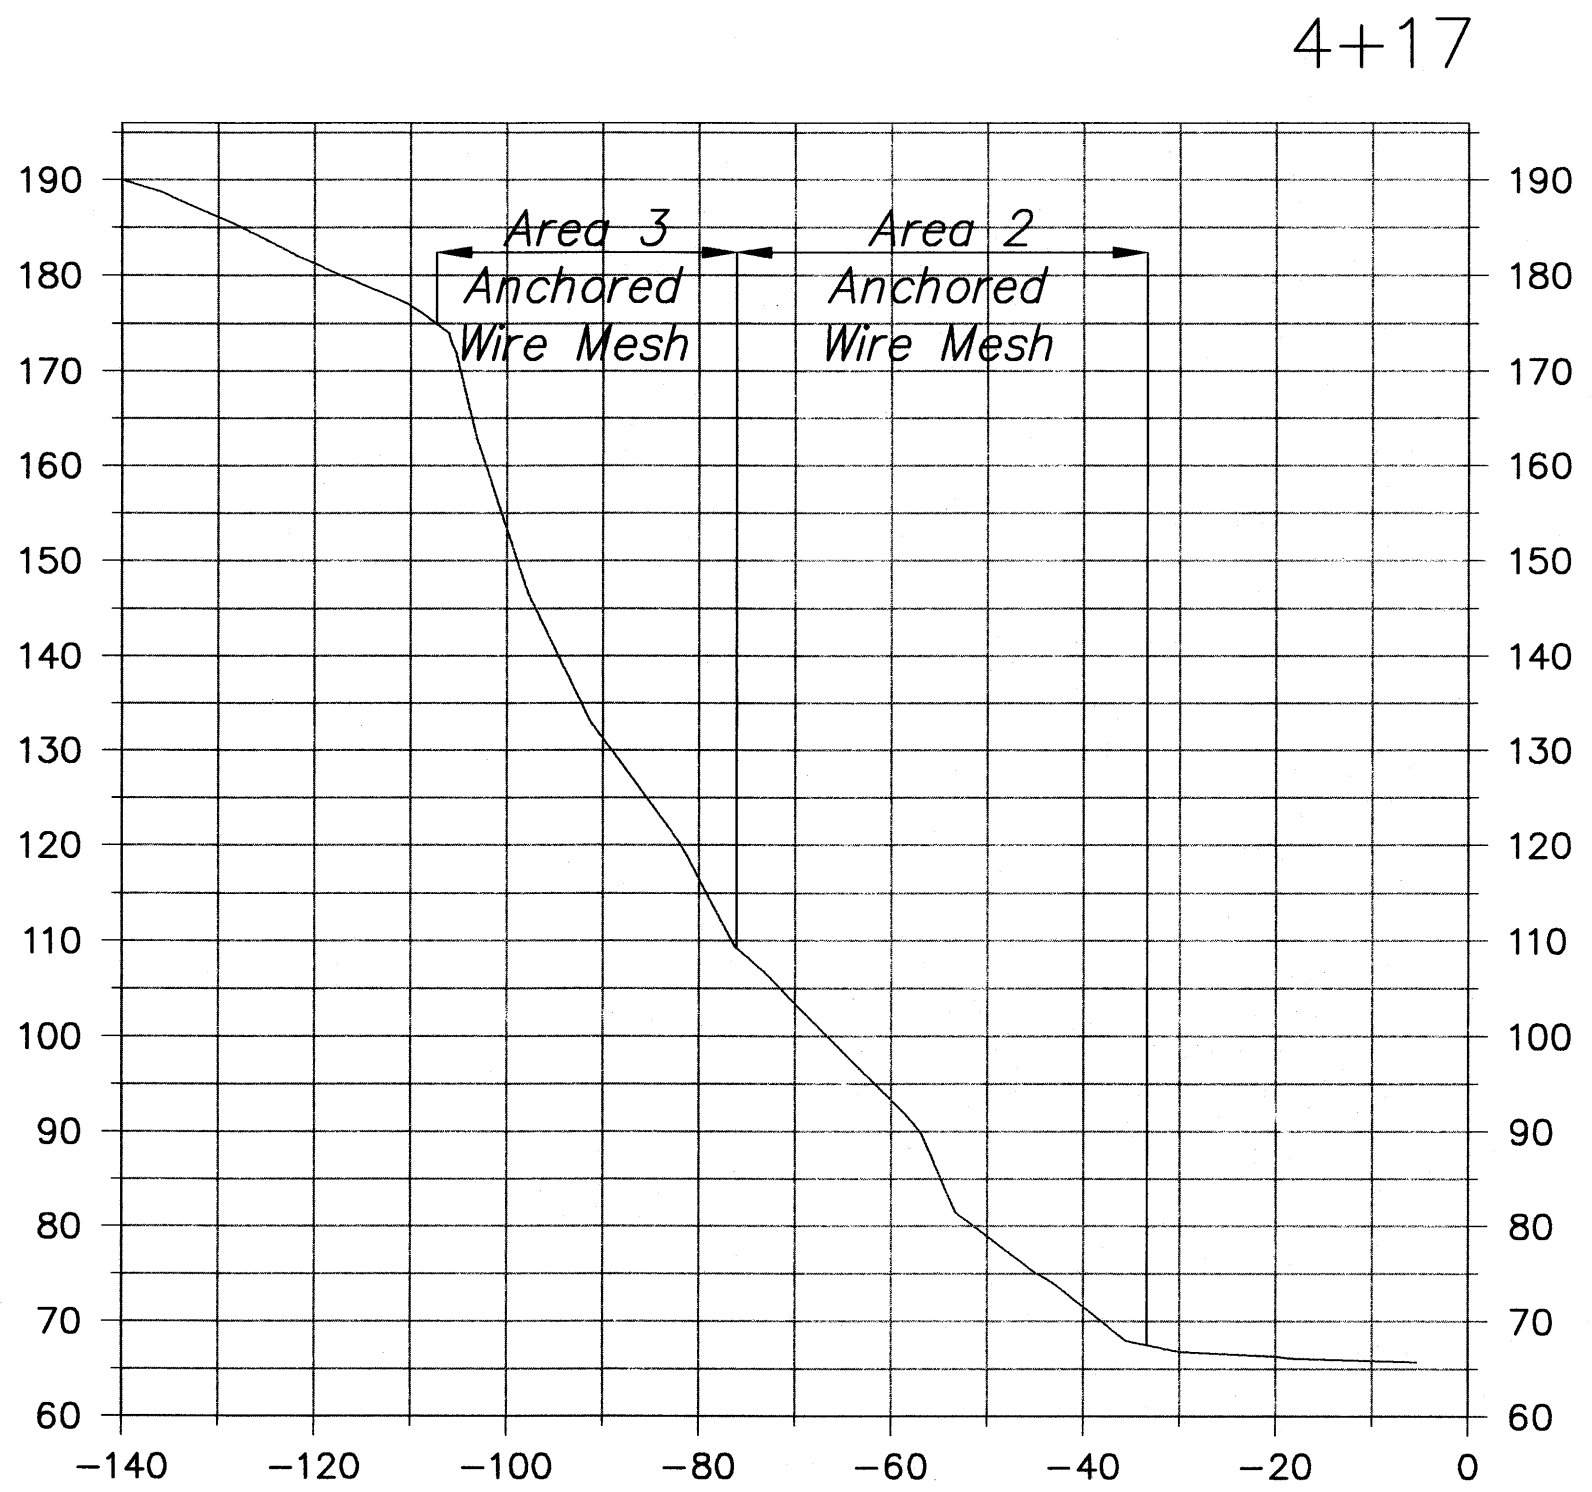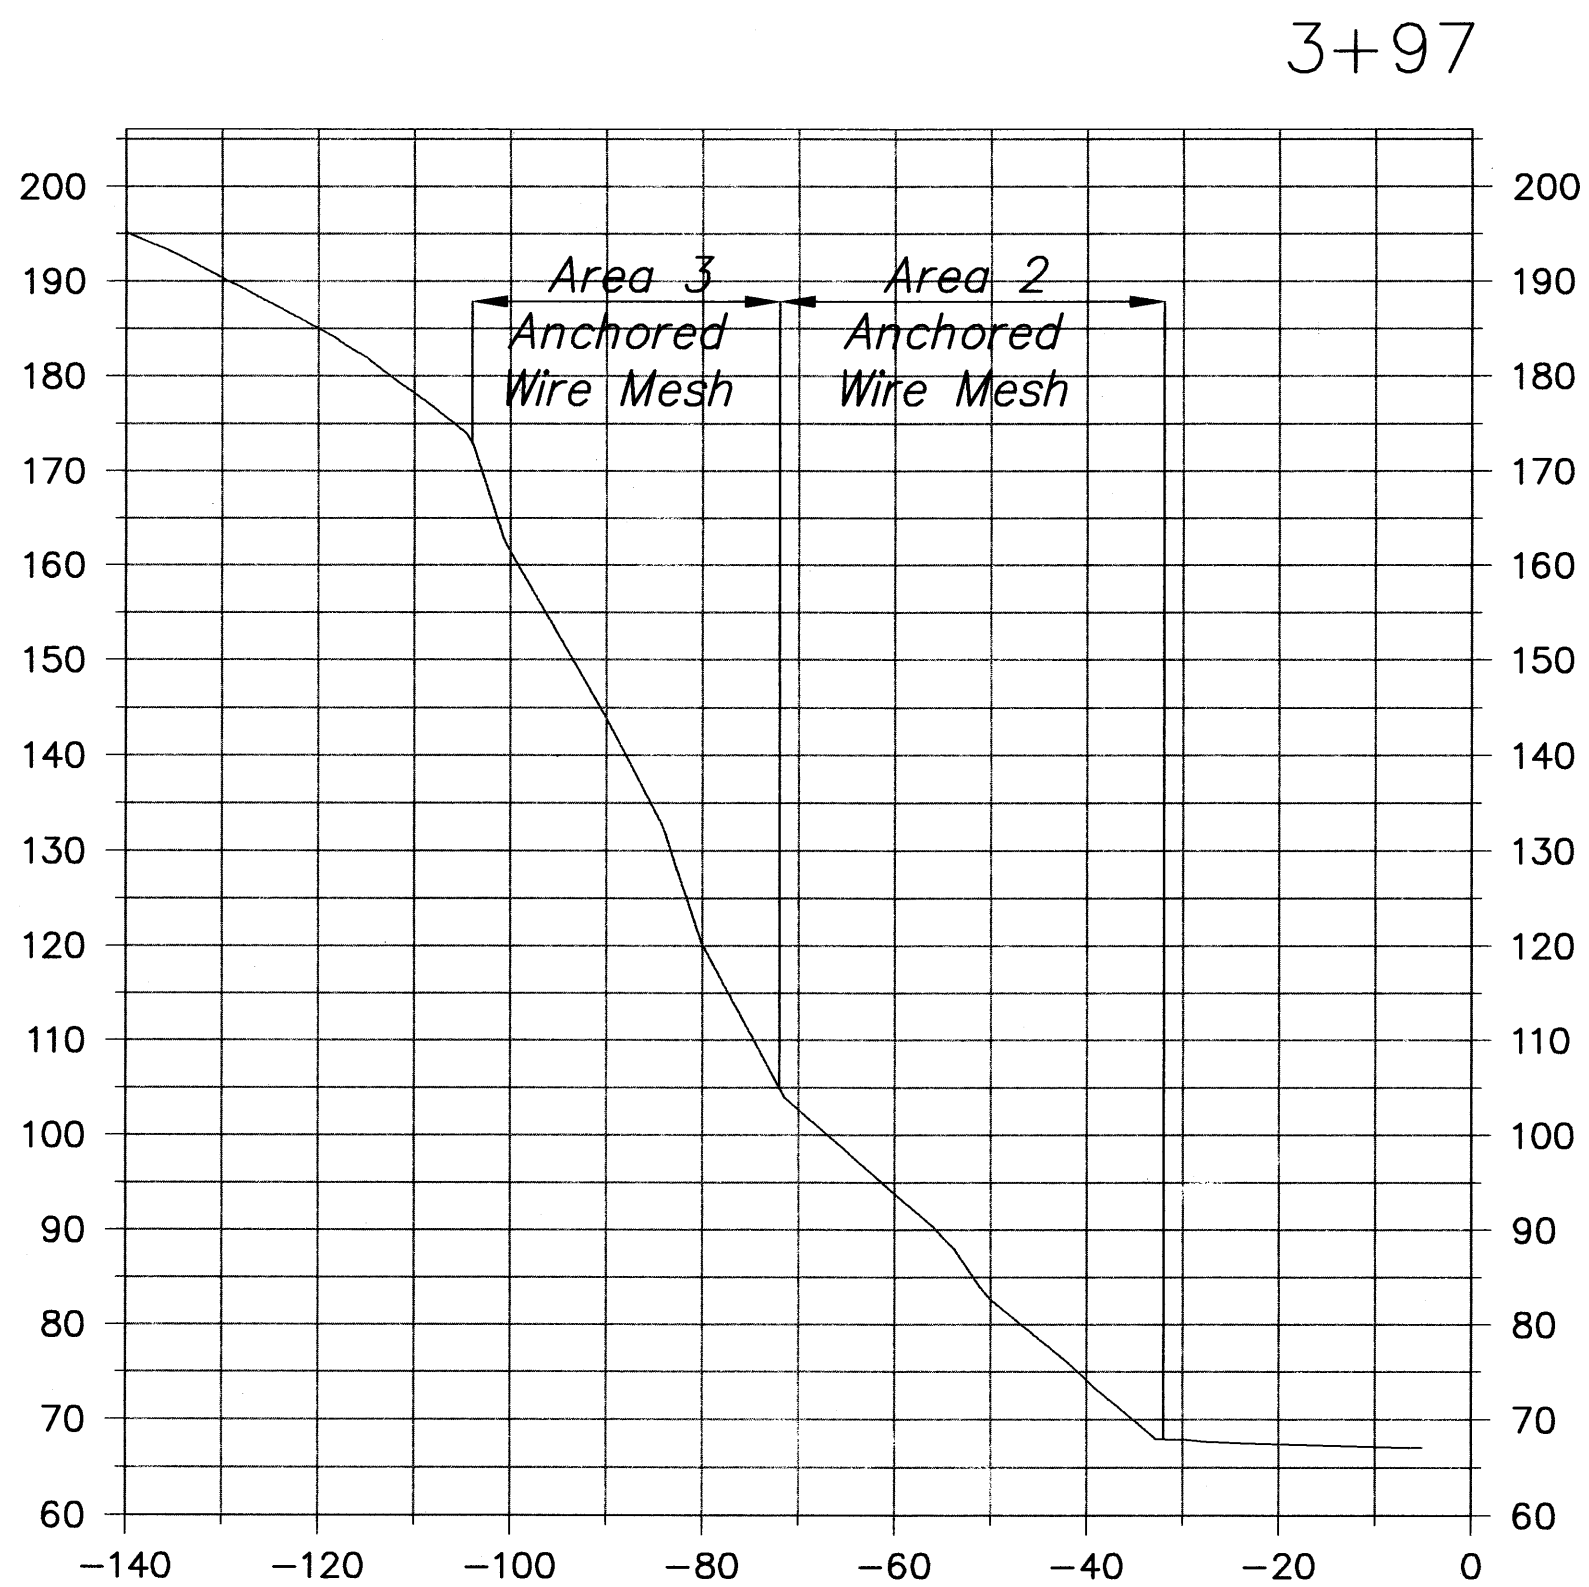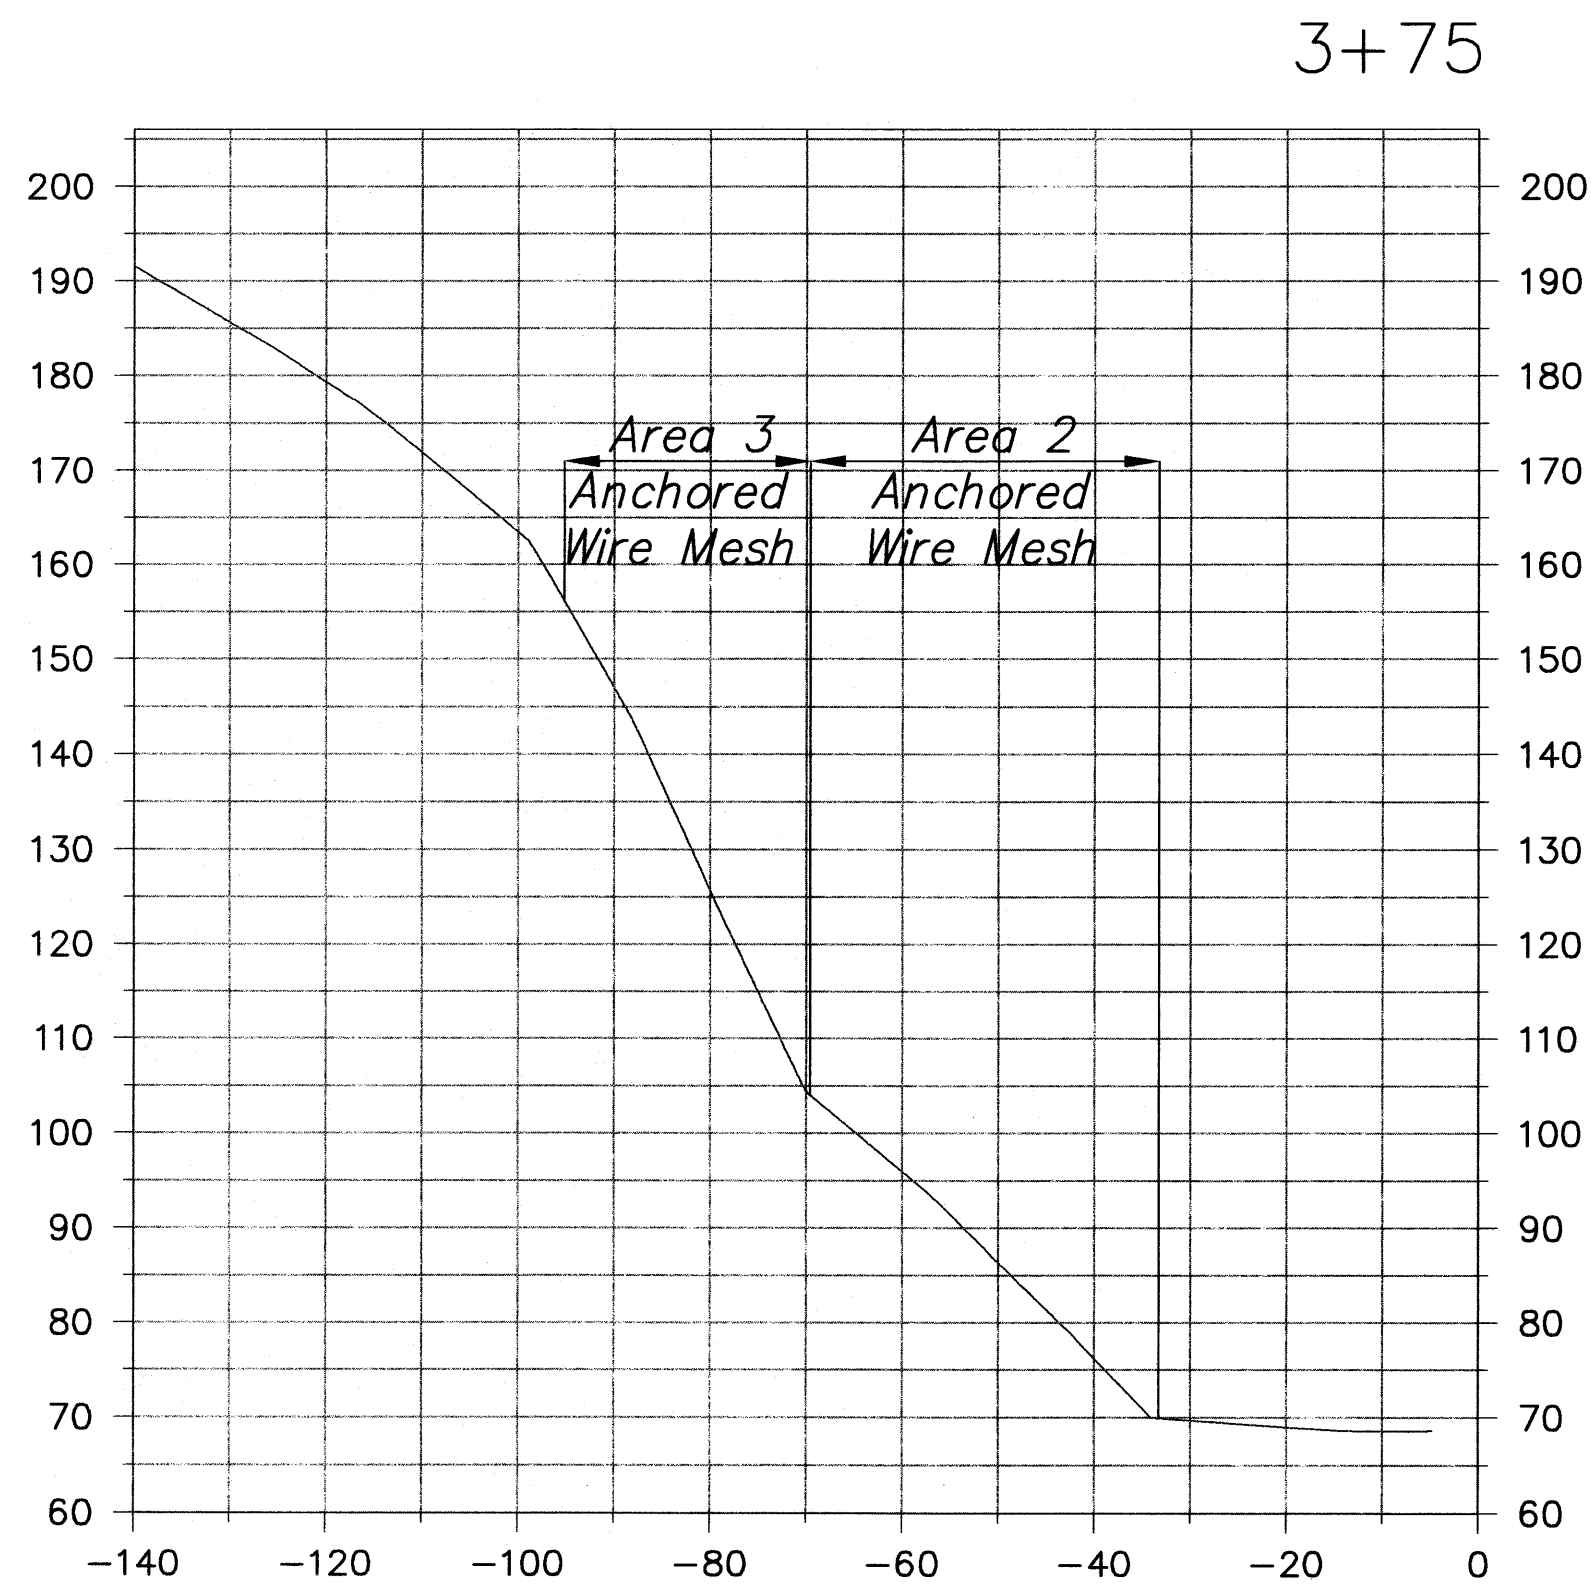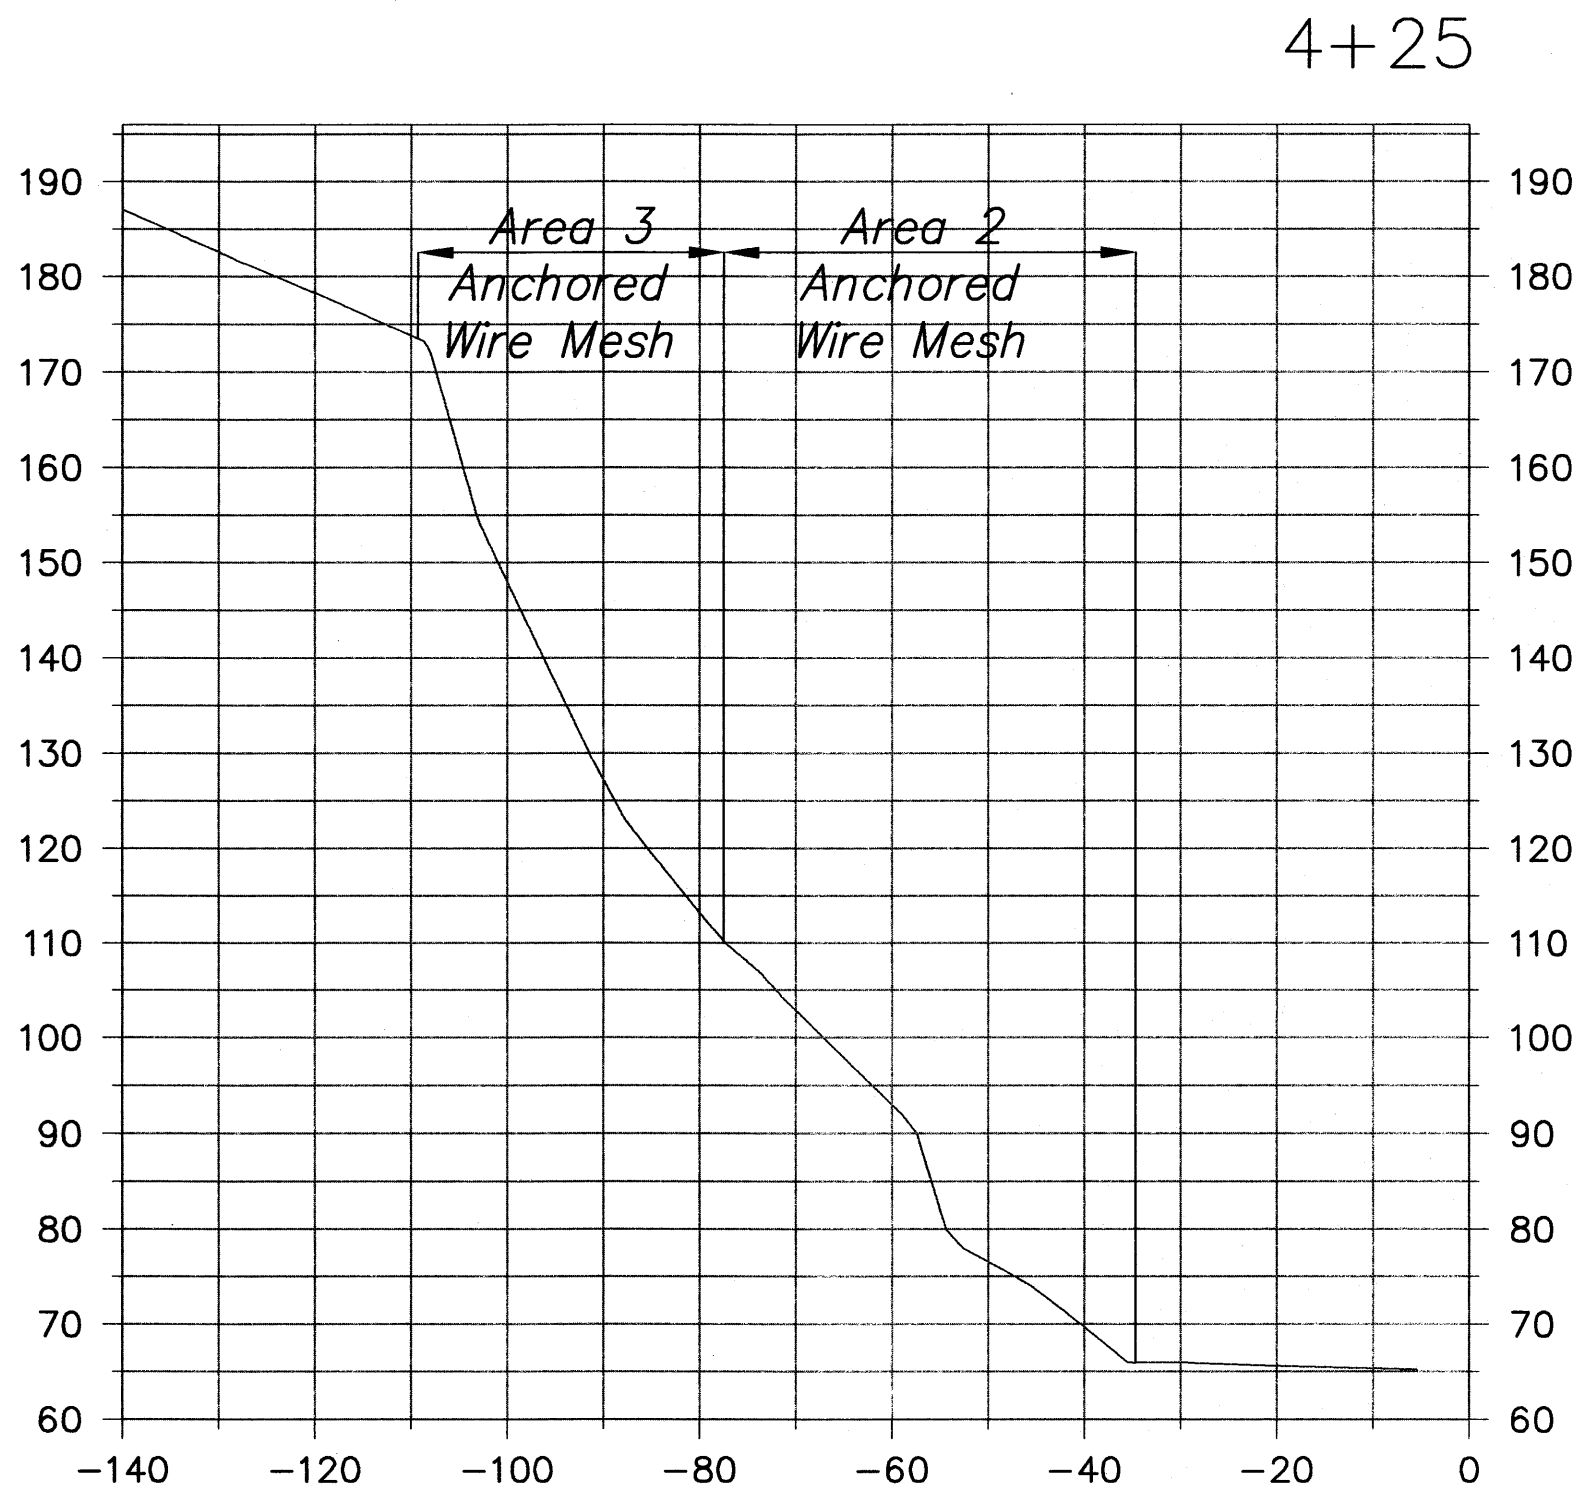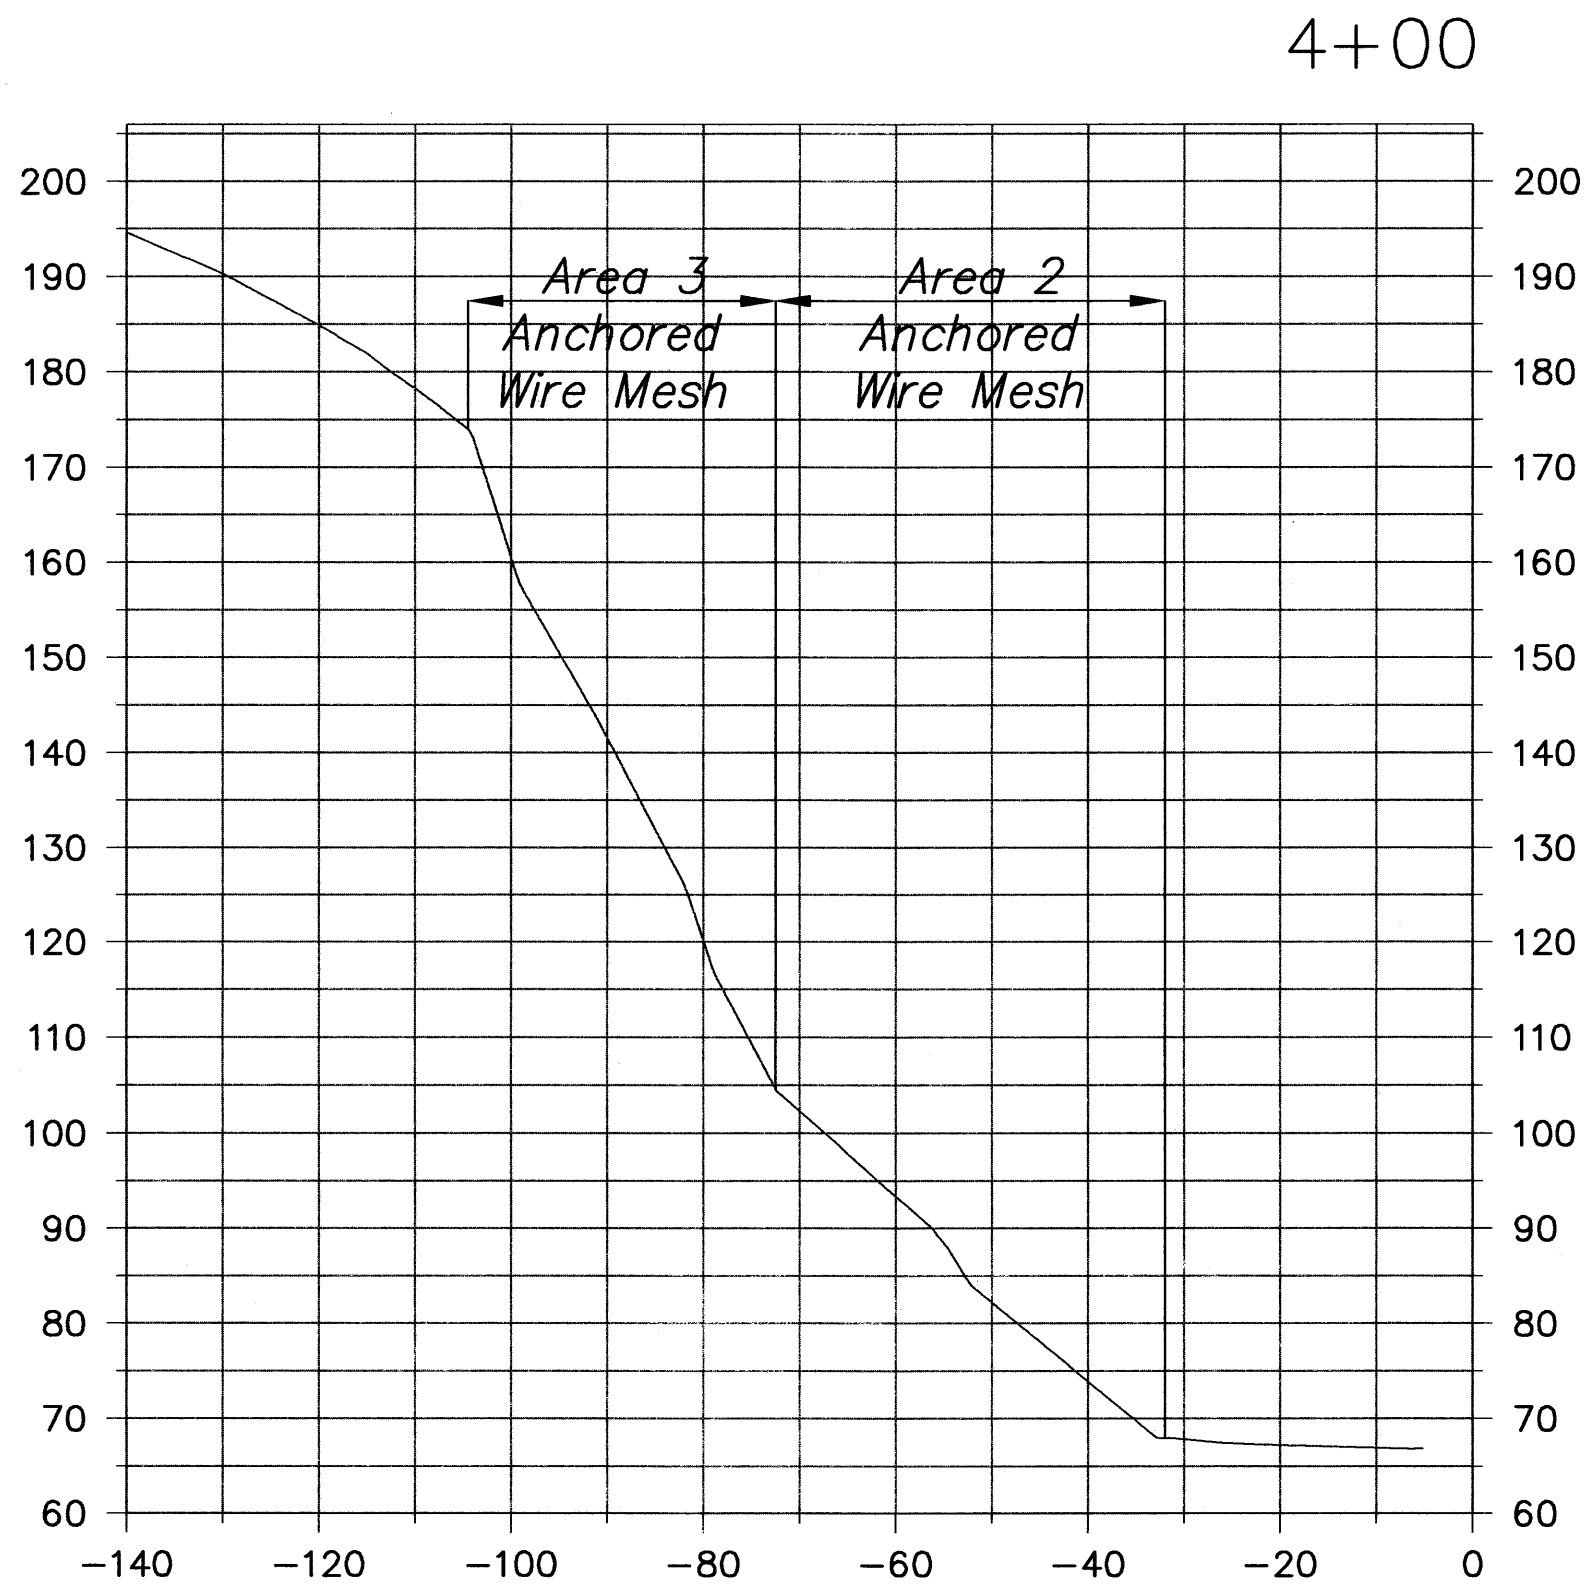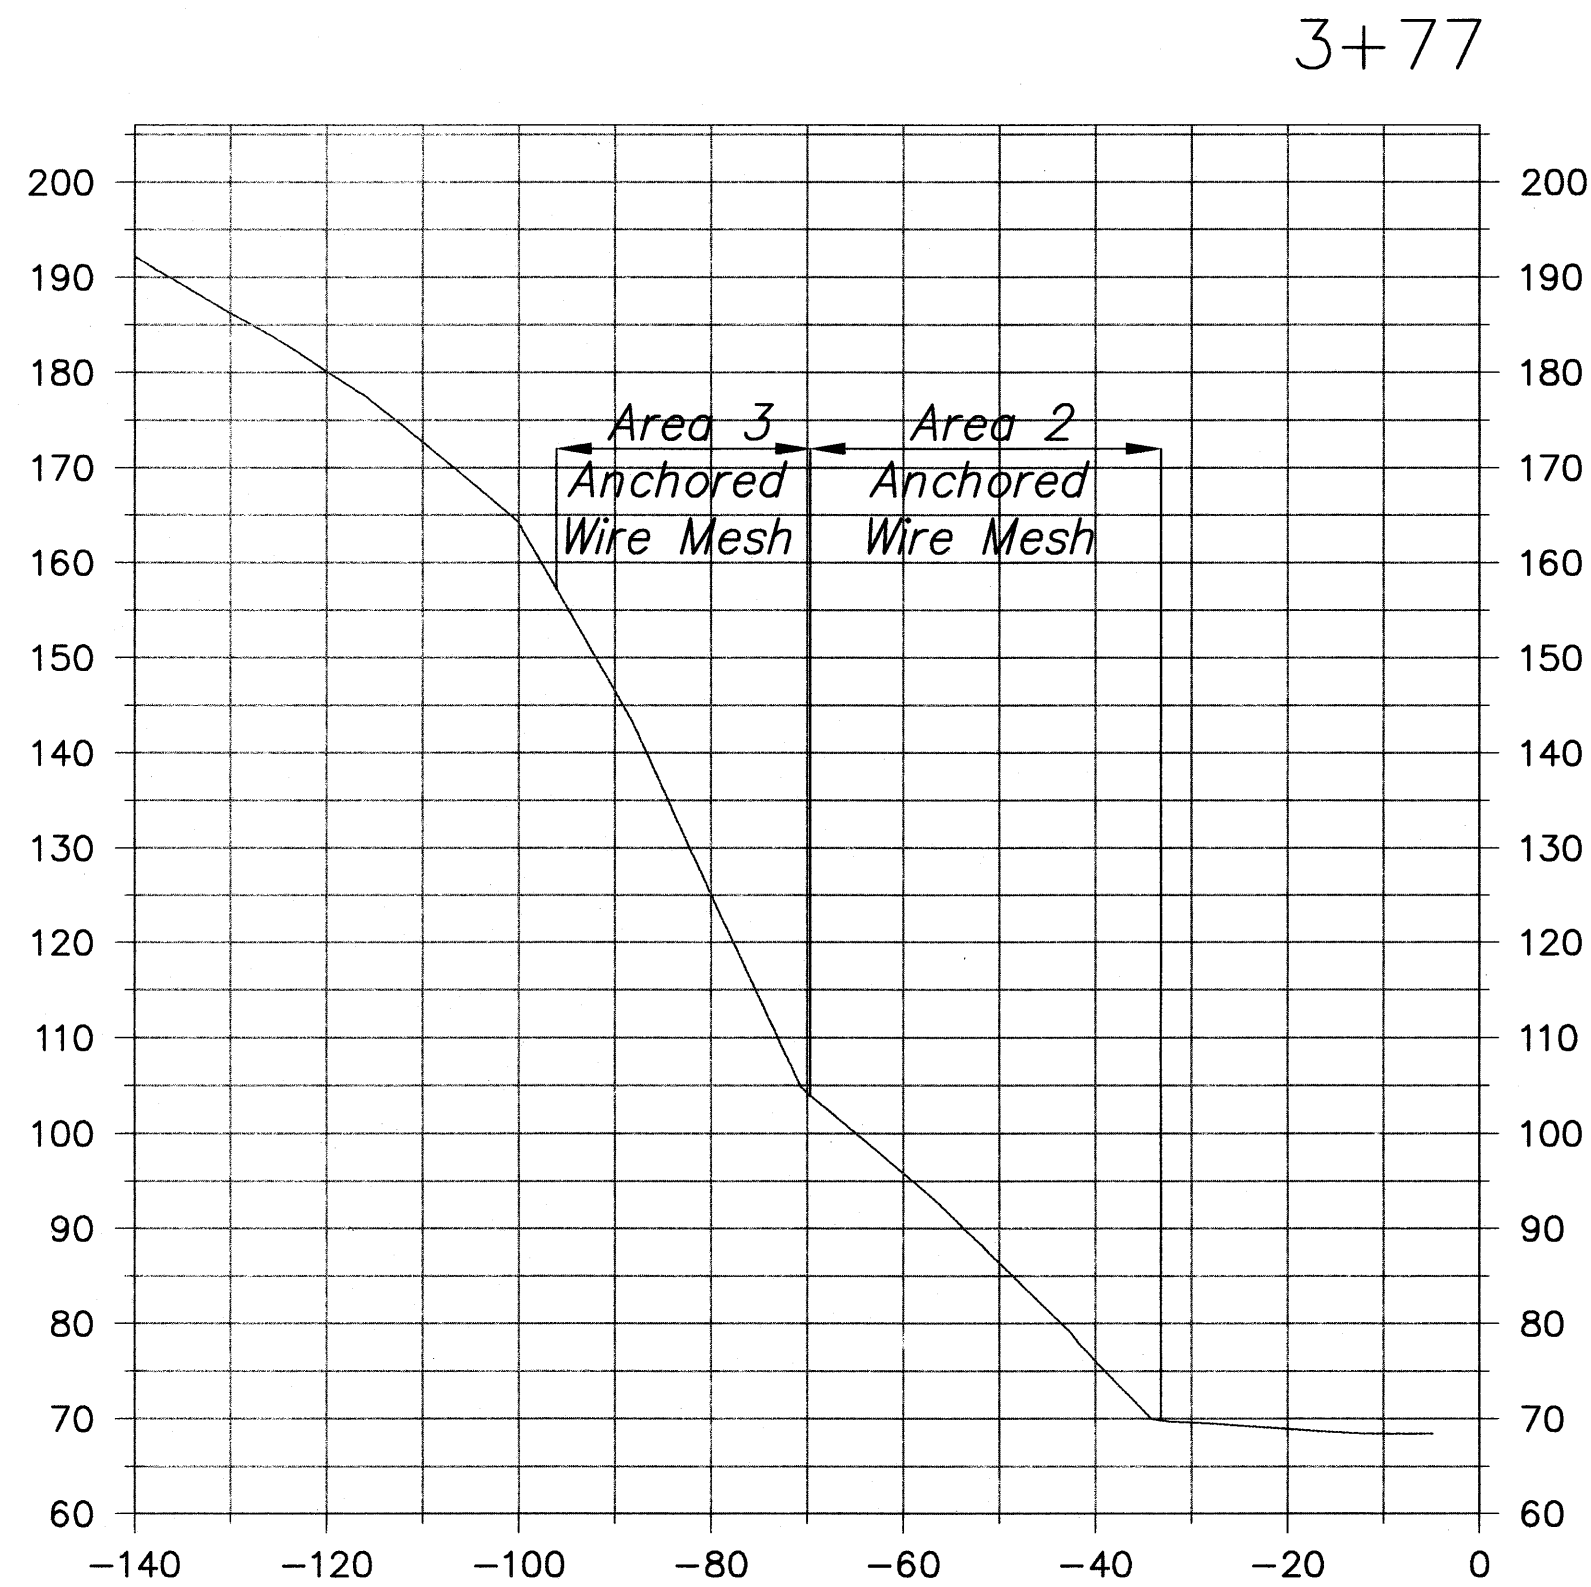


ORIGINAL PLAN	SURVEY PLATTED BY	DATE
NOTE BOOK	DRAWN BY	
	DESIGNED BY	
	QUANTITIES BY	
	CHECKED BY	
	No.	

P:\V\0077 Kulei Hwy Slope Stabilization\Drawings\2 Cross Sections.dwg 12/10/09 8:42 AM hromer

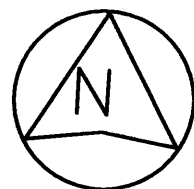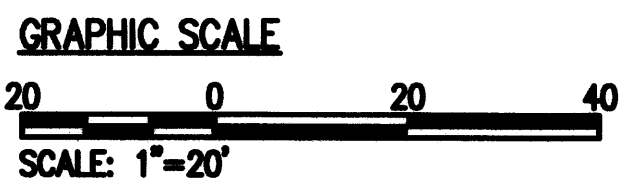

EARTH TECH | AECOM

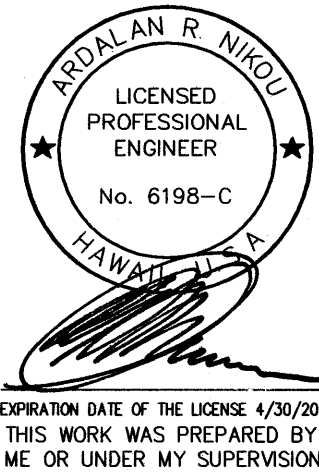

STATE OF HAWAII
DEPARTMENT OF TRANSPORTATION
HIGHWAYS DIVISION

CROSS SECTIONS

KUHO HIGHWAY SLOPE STABILIZATION
VICINITY OF HANAIEI BRIDGE
PROJECT NO. 560A-02-03

Scale: As Noted Date: July 2009

SHEET No. 5 OF 5 SHEETS