


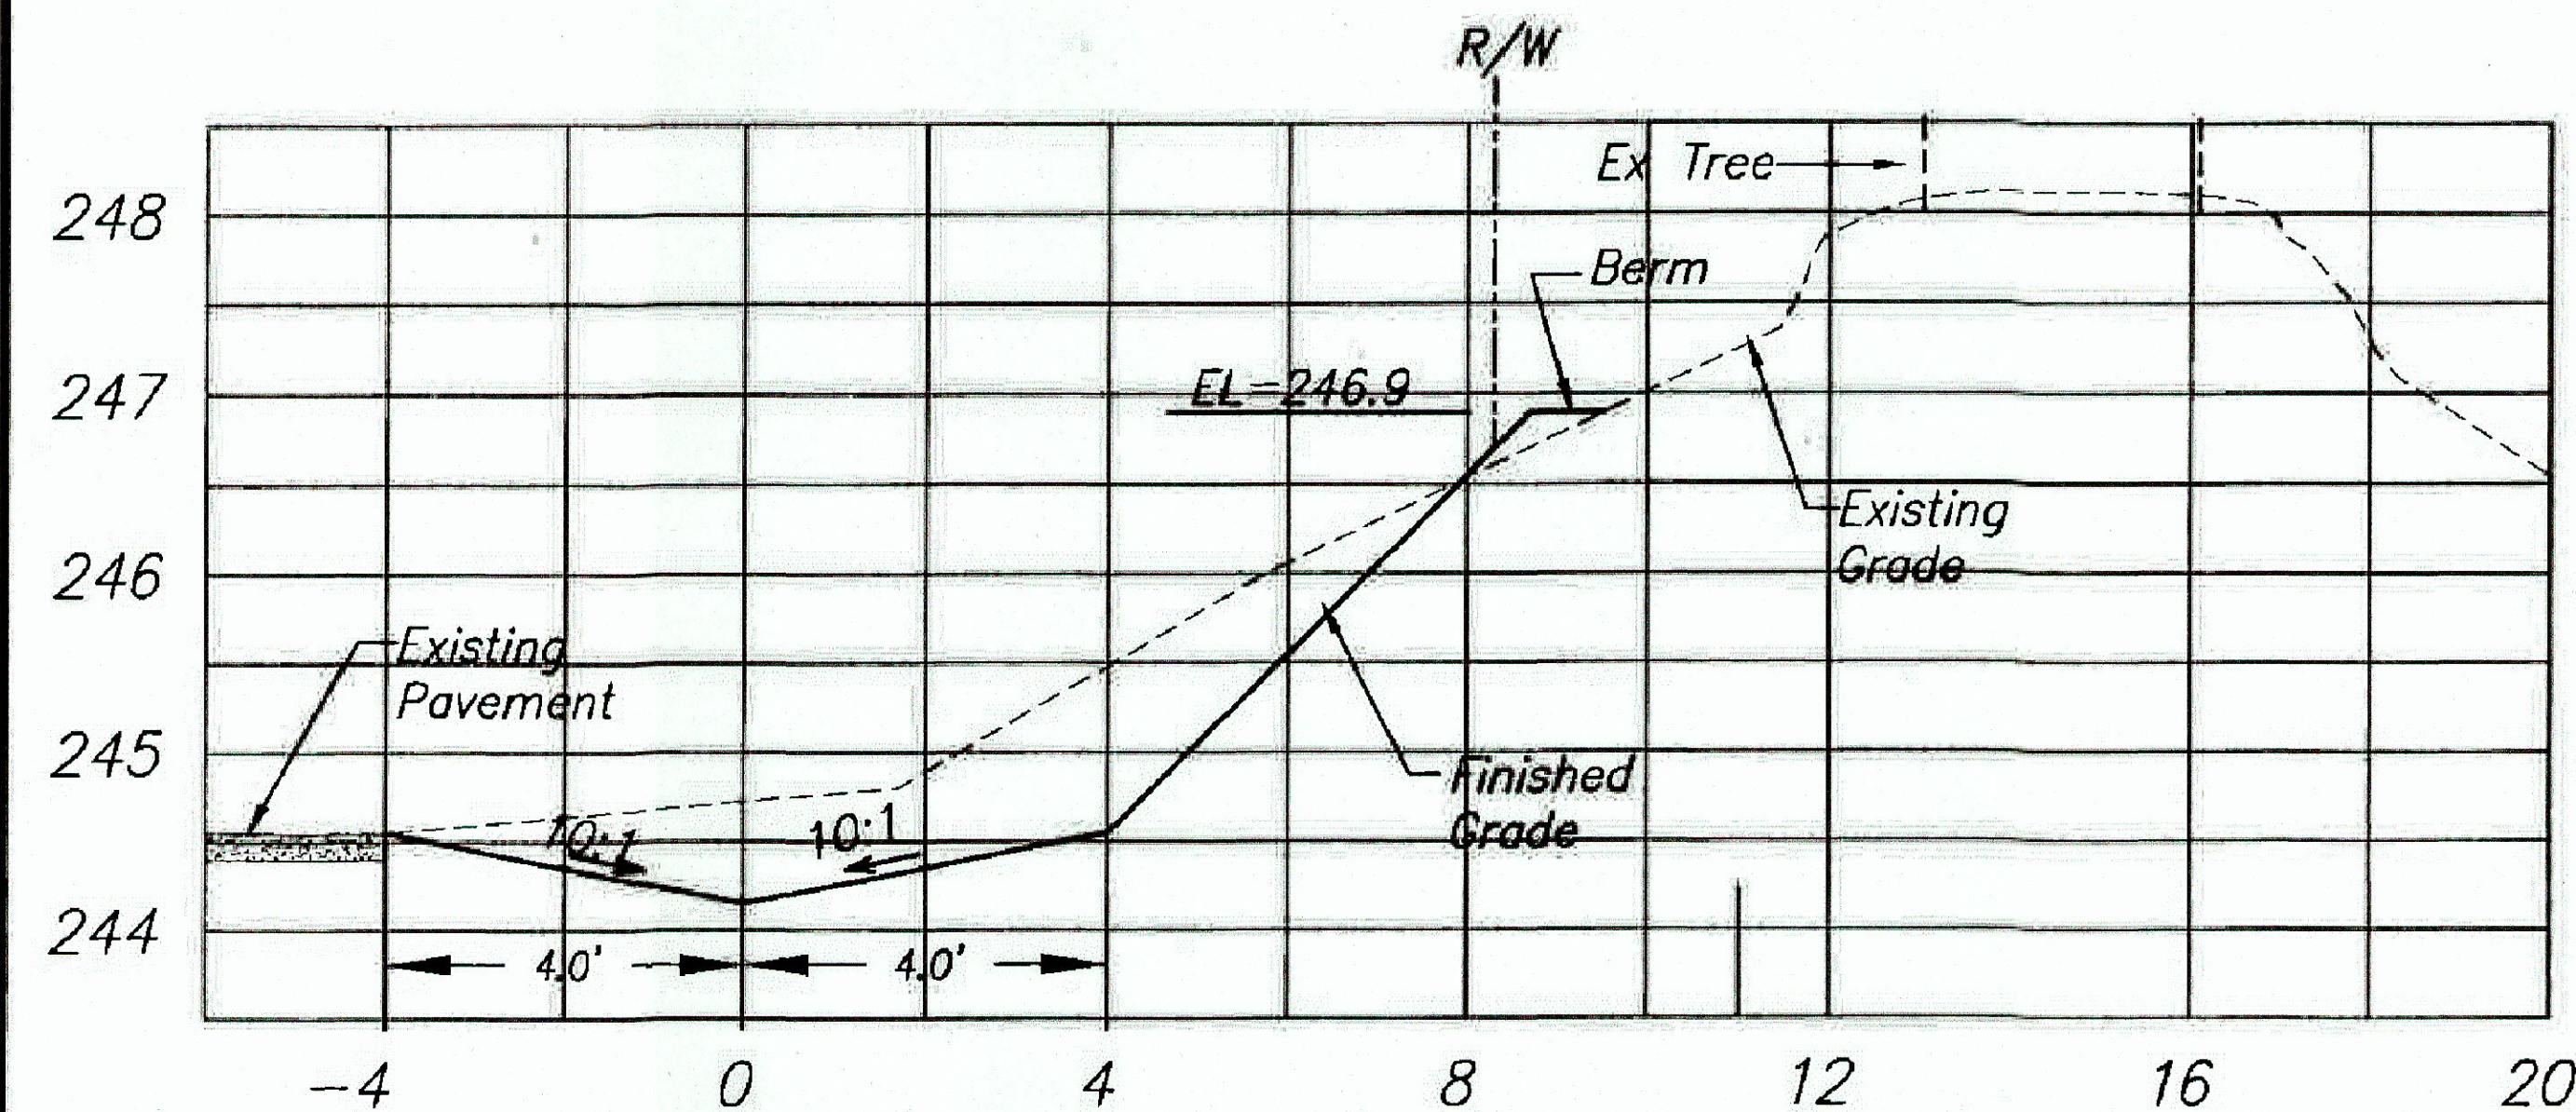

(Deleted from Contract)

C ~~SWALE REGRADING SECTION~~


8 Scale: Horiz: 1"=2'
Vert: 1"=1'

LEGEND FOR AS-BUILT POSTINGS

Squiggly line for as-built deletion

Double line for as-built deletion

Text for as-built posting

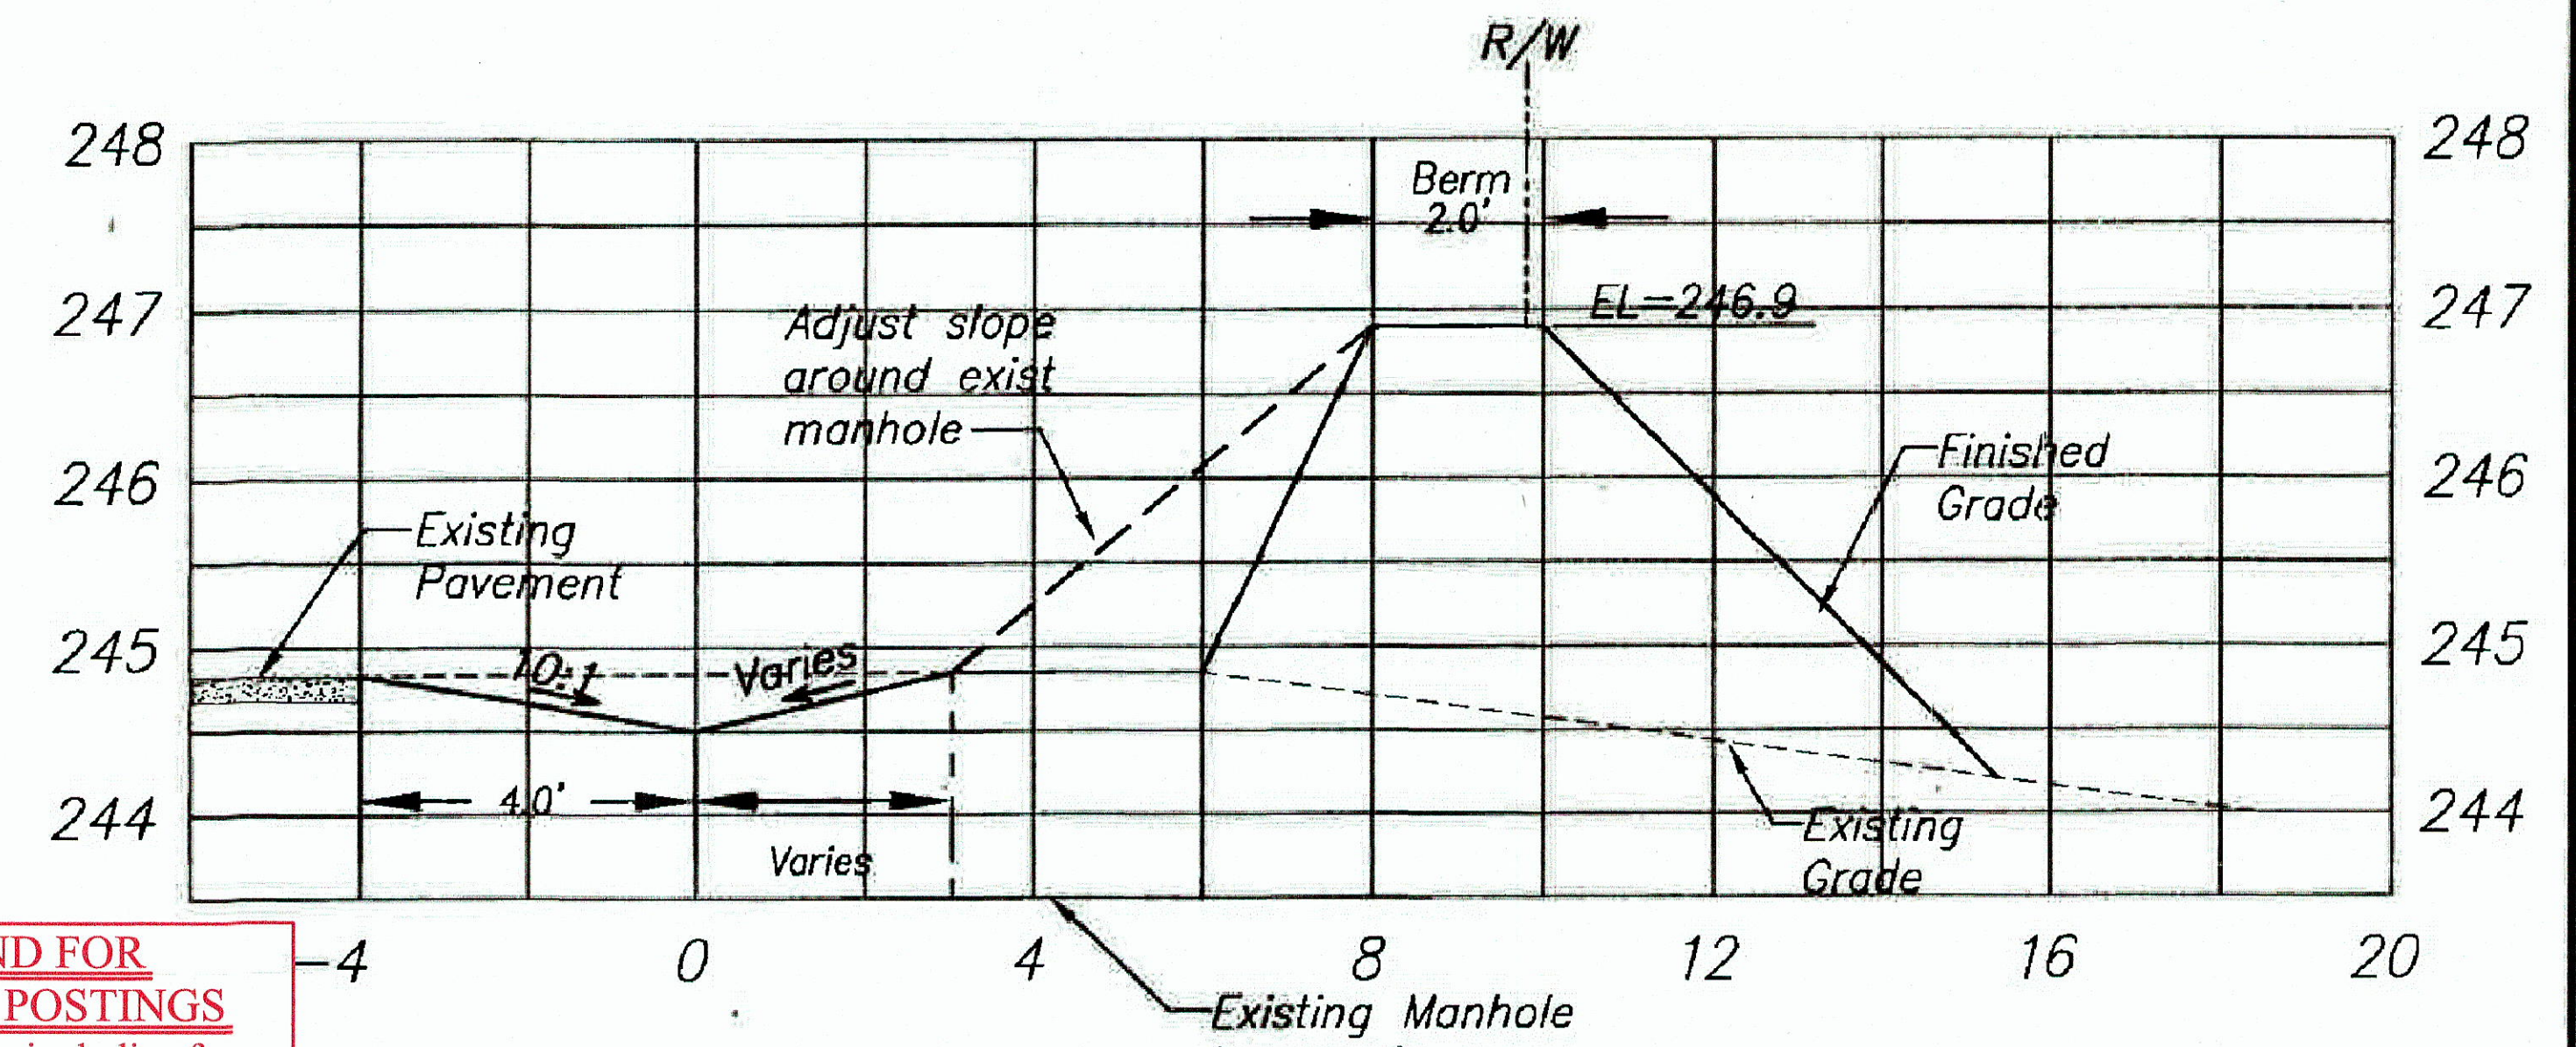


(Deleted from Contract)

D ~~SWALE REGRADING SECTION~~

8 Scale: Horiz: 1"=2'
Vert: 1"=1'

Note: Hydro-mulch seed and install temporary Erosion Control Mat over all ~~graded~~ disturbed areas.

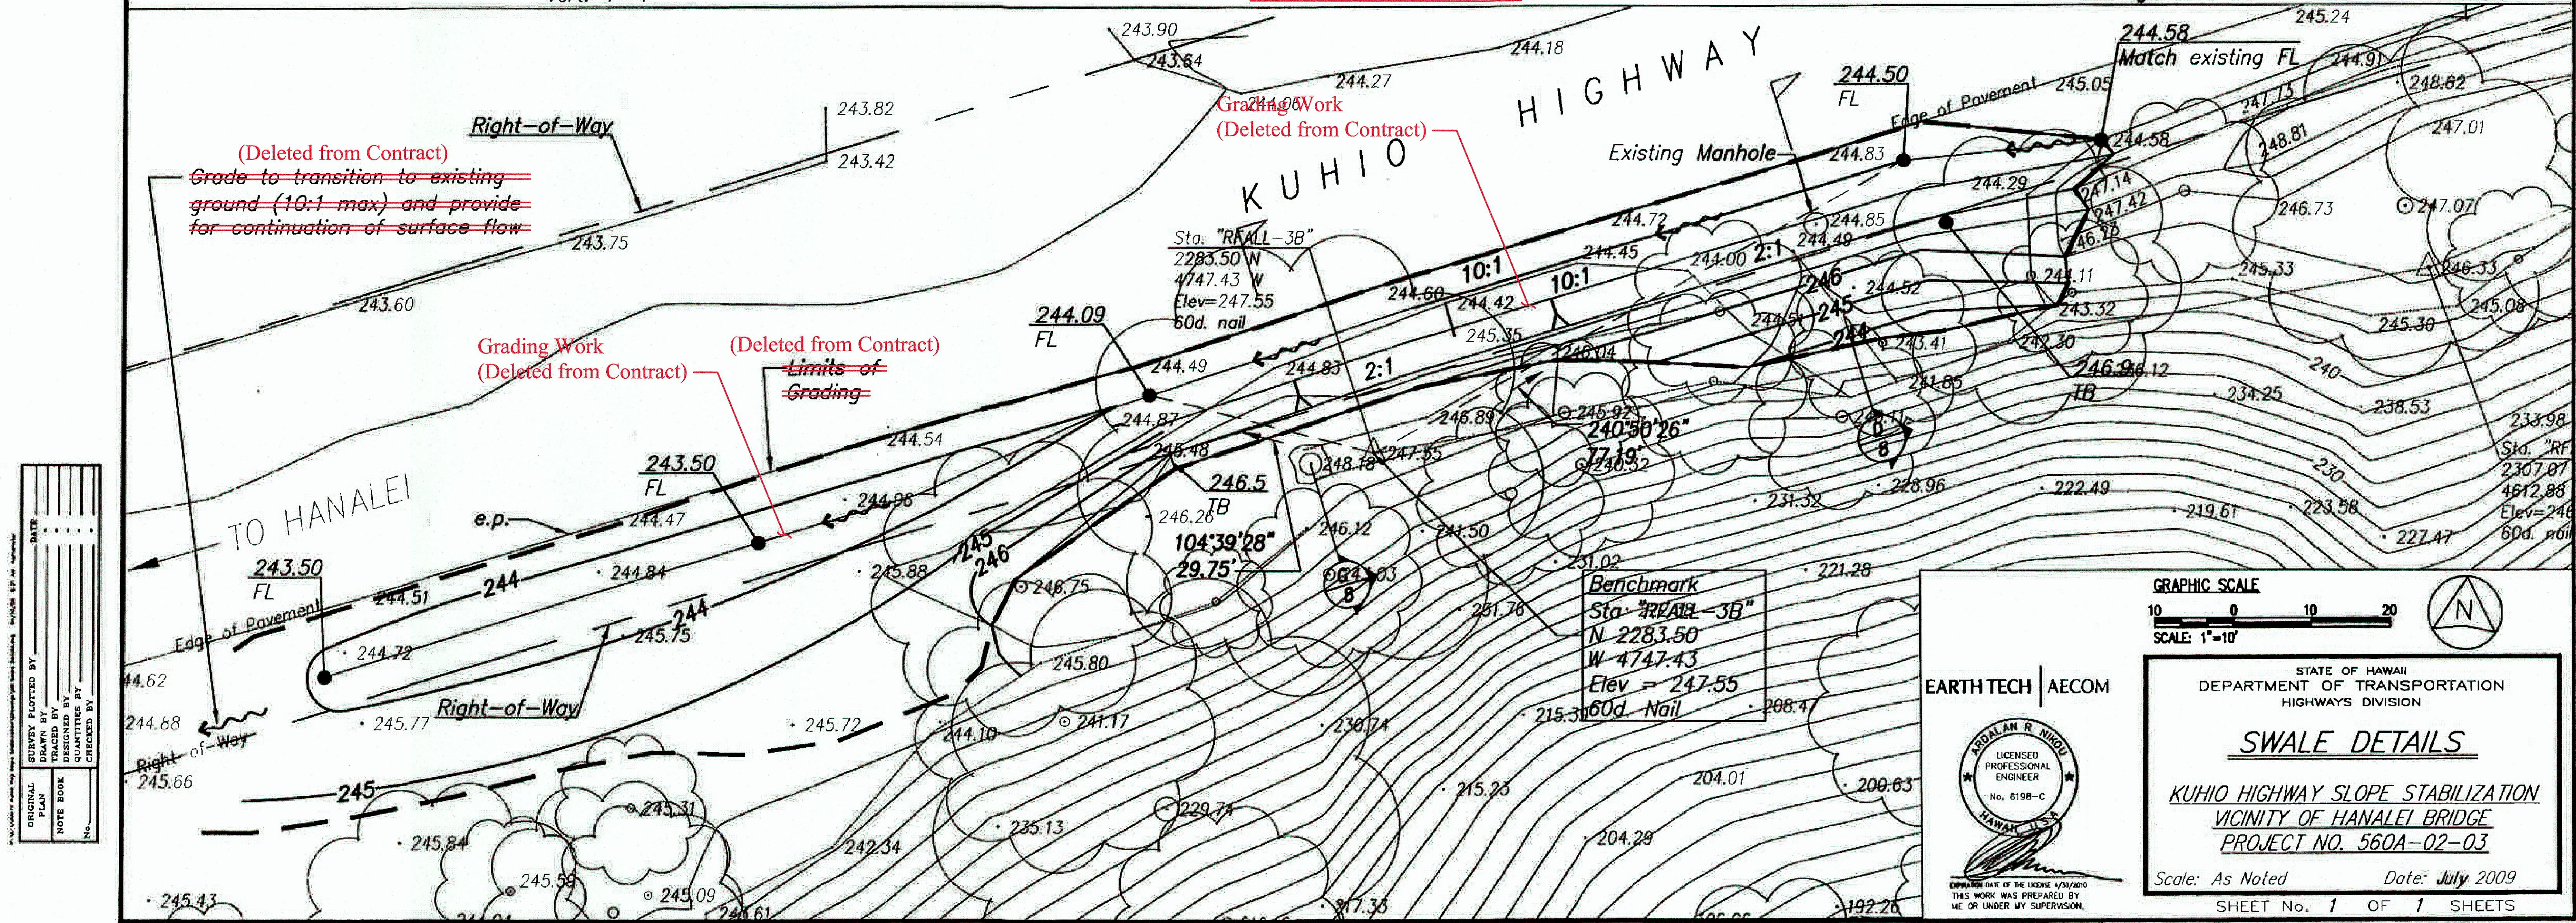

DATE: _____

DESIGNED BY: _____

TRACED BY: _____

NOTED BY: _____

QUANTITIES BY: _____

CHECKED BY: _____

EARTH TECH | AECOM

EXPIRATION DATE OF THE LICENSE: 6/30/2010
THIS WORK WAS PREPARED BY ME OR UNDER MY SUPERVISION.

GRAPHIC SCALE

10 0 10 20

SCALE: 1"=10'

N

STATE OF HAWAII
DEPARTMENT OF TRANSPORTATION
HIGHWAYS DIVISION

SWALE DETAILS

*KUHIU HIGHWAY SLOPE STABILIZATION
VICINITY OF HANAIEI BRIDGE
PROJECT NO. 560A-02-03*

Scale: As Noted Date: July 2009

SHEET No. 1 OF 1 SHEETS

"AS-BUILT"