



FED. ROAD DIST. NO.	STATE	PROJ. NO.	FISCAL YEAR	SHEET NO.	TOTAL SHEETS
KAUAI	HAWAII	560A-02-03	2010	9	32

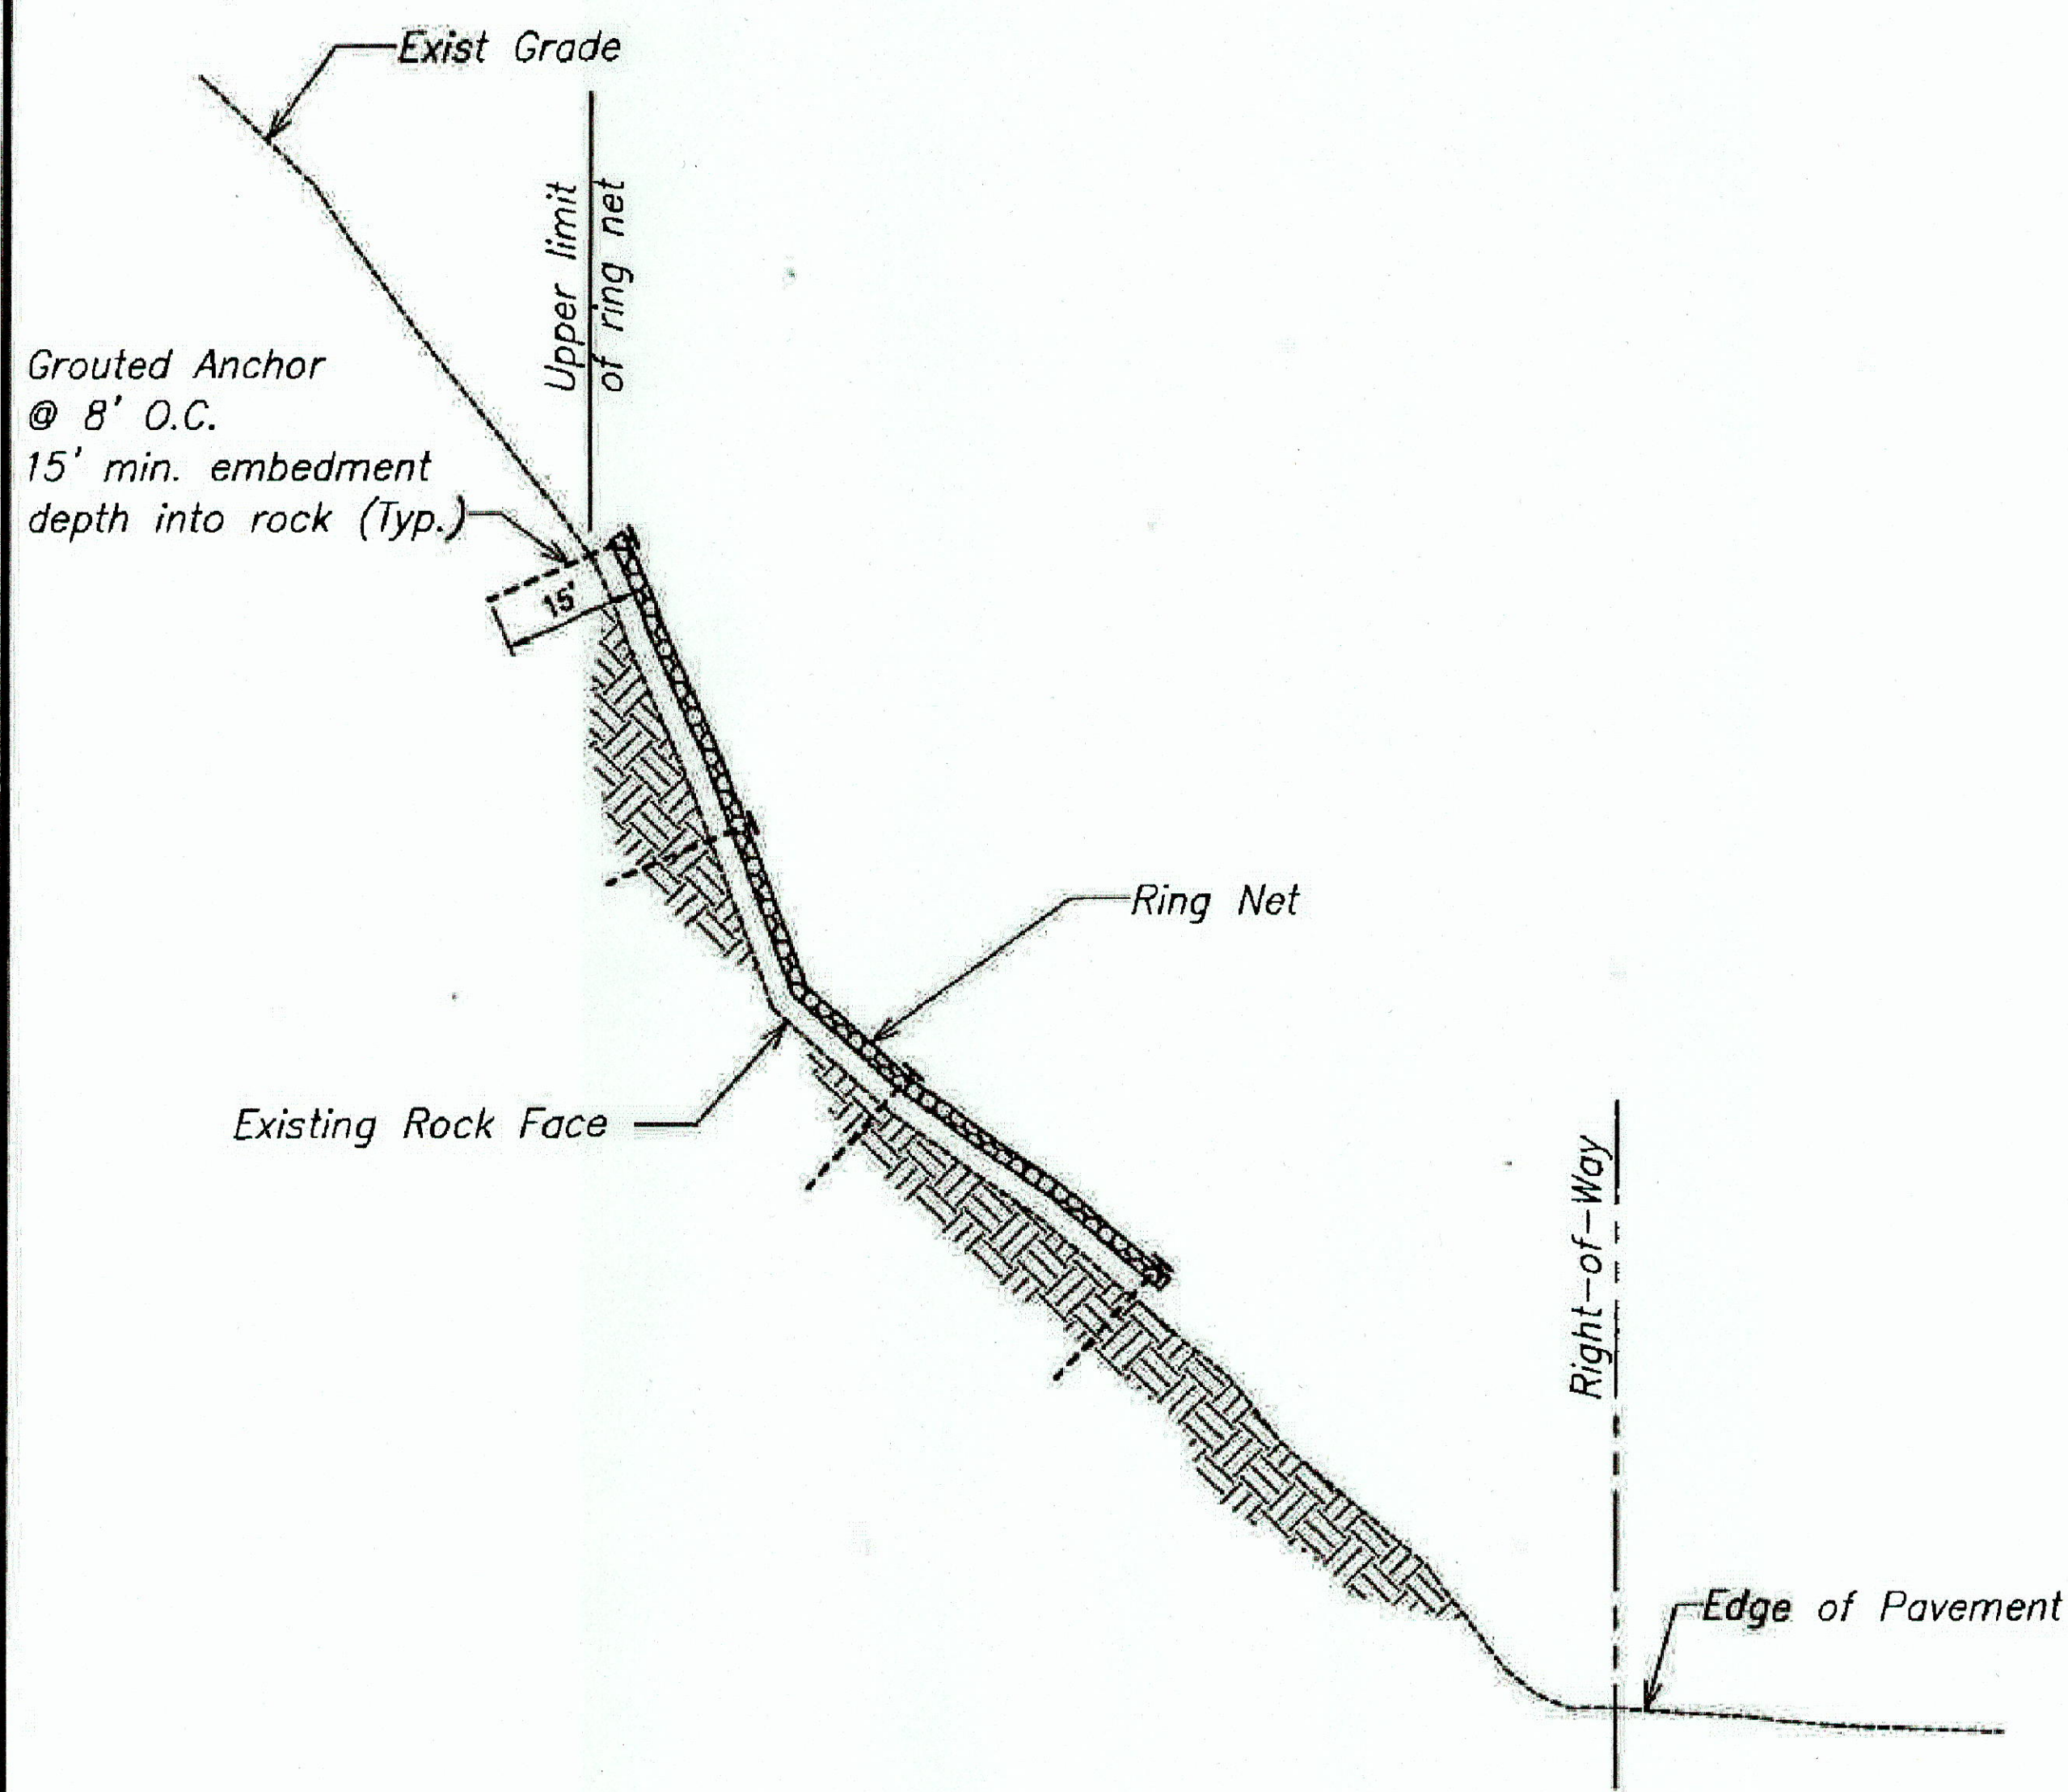

(Deleted from Contract)

A ~~RING NET SYSTEM TYPICAL SECTION~~

9 SCALE: 1" = 10'

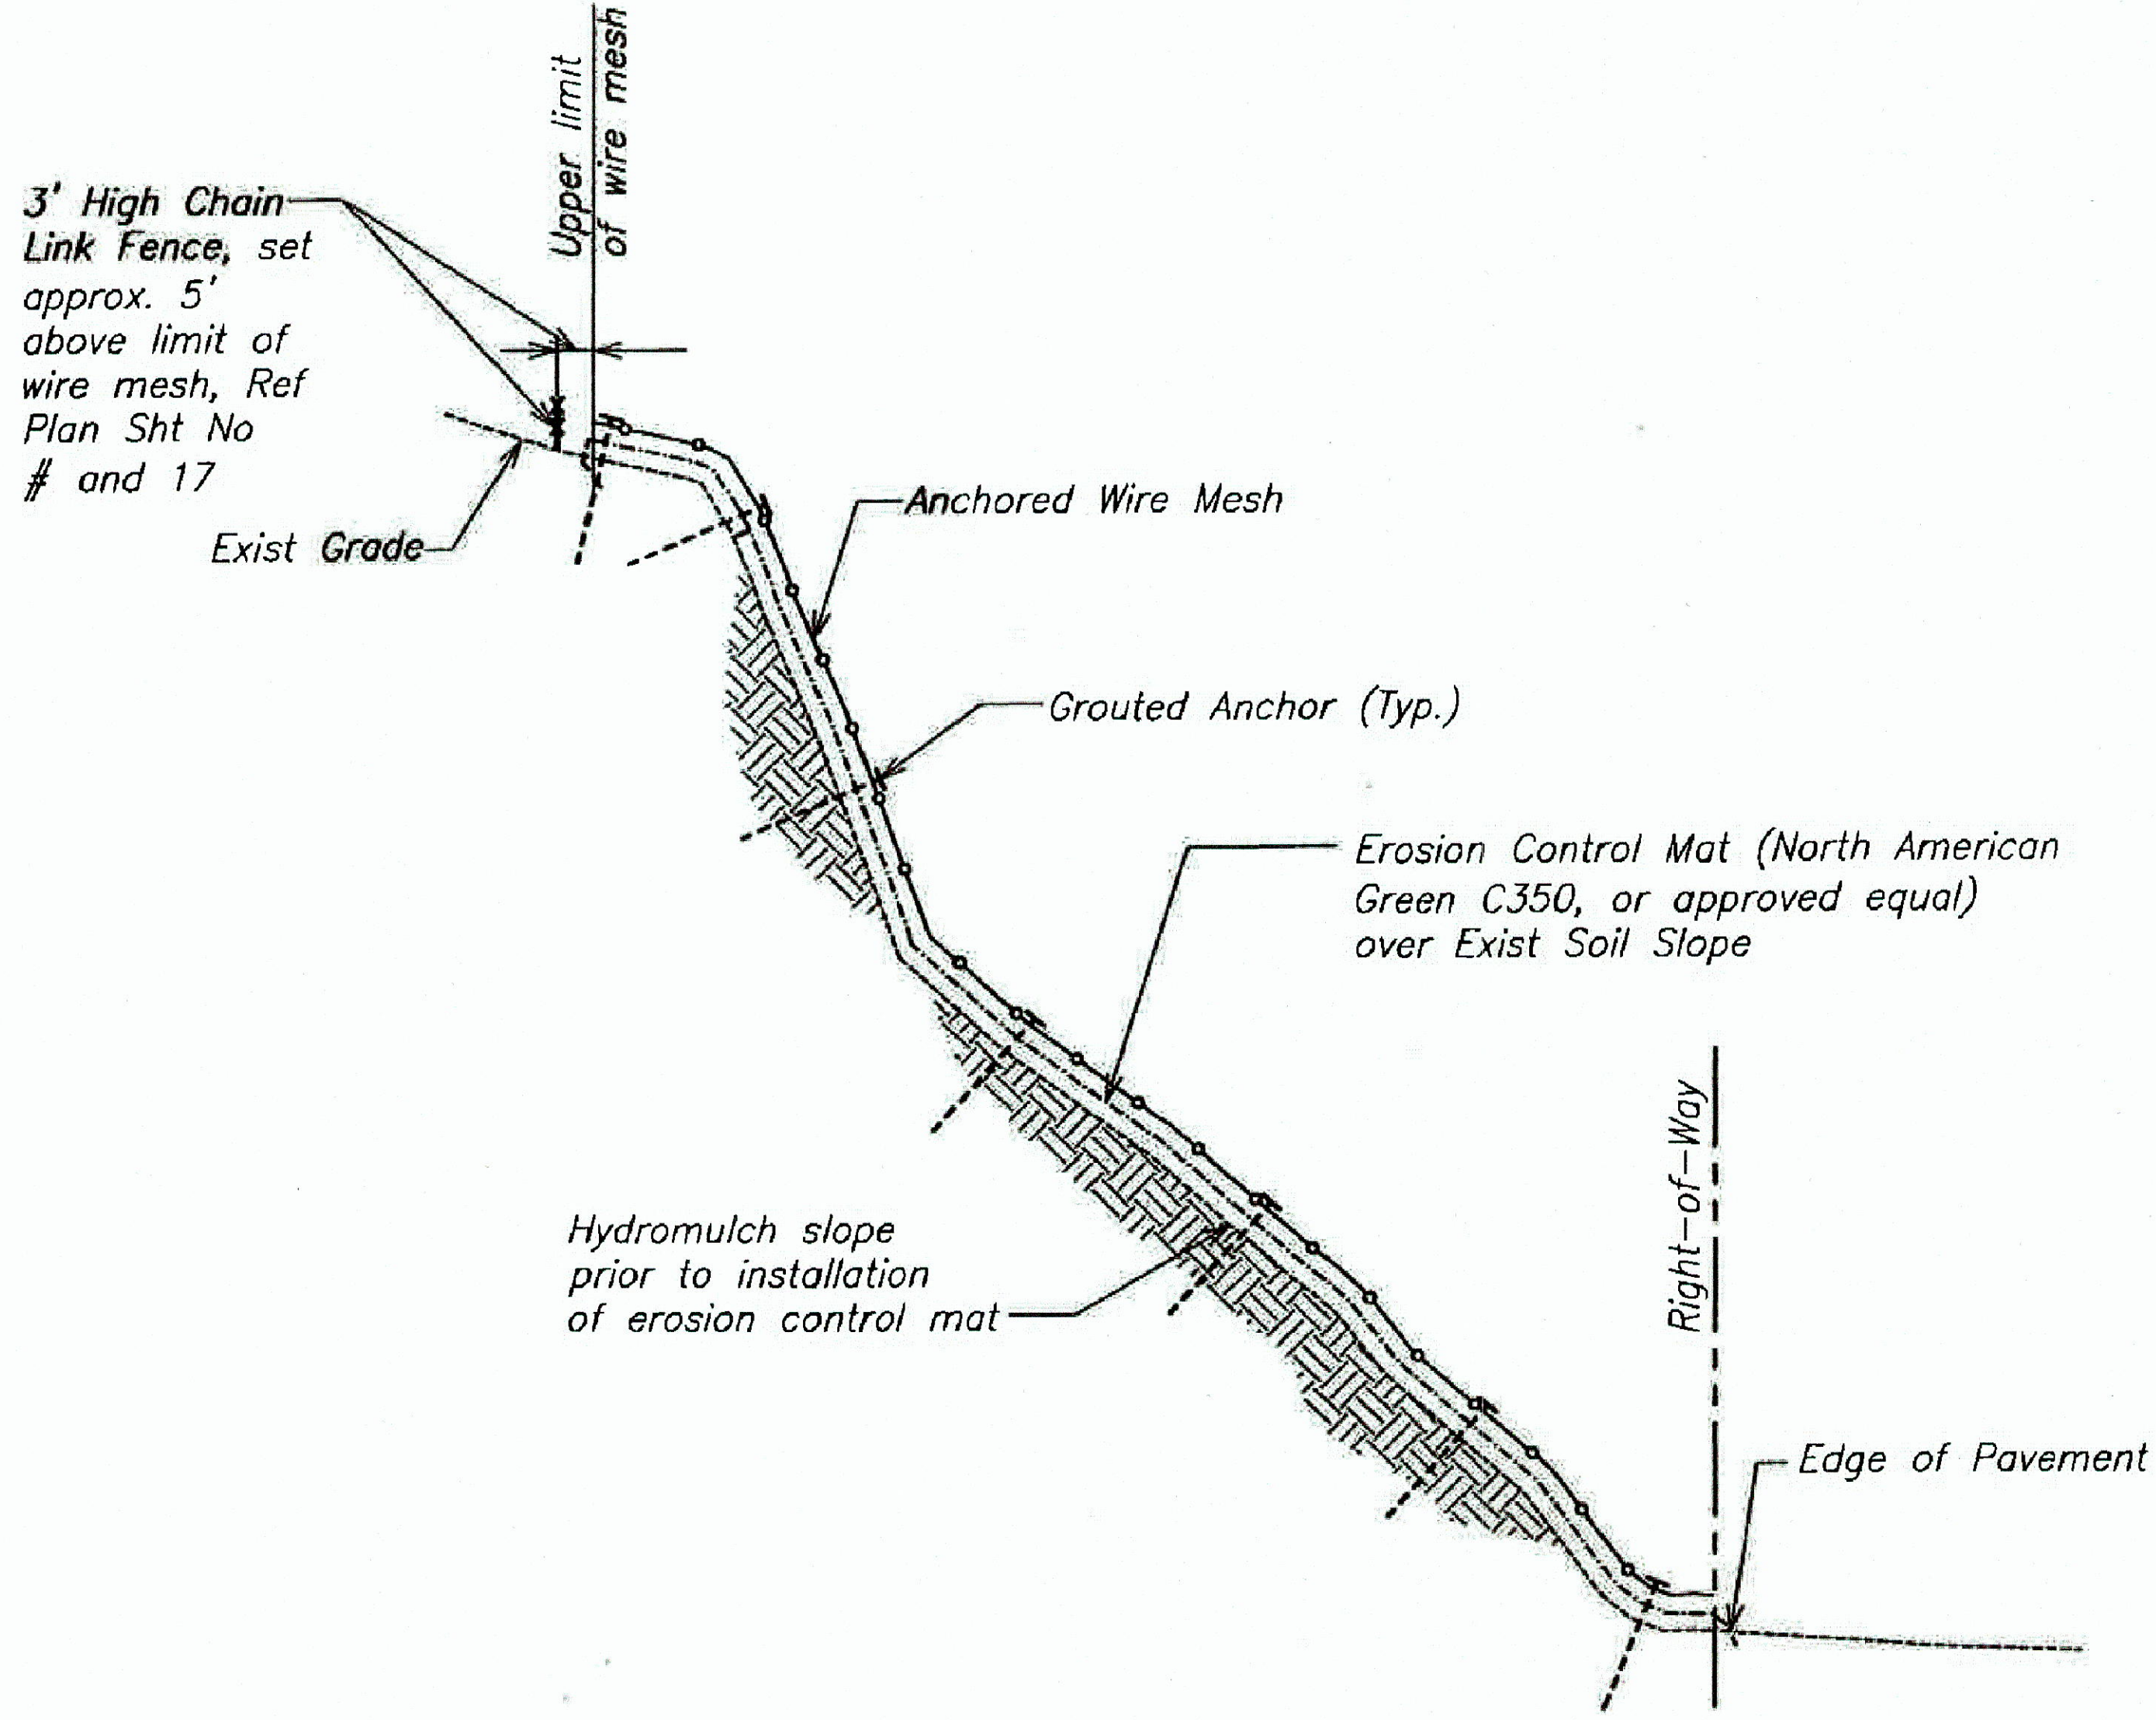

B ANCHORED WIRE MESH TYPICAL SECTION

9 SCALE: 1" = 10'

LEGEND FOR AS-BUILT POSTINGS

Squiggly line for as-built deletion

Double line for as-built deletion

Roadway Text for as-built posting

DATE	
DESIGNED BY	
DRAWN BY	
CHECKED BY	
NOTED BY	
ORIGINAL PLAN	

EARTH TECH | AECOM

EXPIRATION DATE OF THE LICENSE 4/30/2010
THIS WORK WAS PREPARED BY ME OR UNDER MY SUPERVISION.

STATE OF HAWAII
DEPARTMENT OF TRANSPORTATION
HIGHWAYS DIVISION

TYPICAL SECTIONS

KUHIO HIGHWAY SLOPE STABILIZATION
VICINITY OF HANAIEI BRIDGE
PROJECT NO. 560A-02-03

Scale: As Noted Date: July 2009

SHEET No. 1 OF 1 SHEETS

"AS-BUILT"