



FED. ROAD DIST. NO.	STATE	PROJ. NO.	FISCAL YEAR	SHEET NO.	TOTAL SHEETS
HAWAII	HAW.	560A-01-10M	2010	ADD. 6	20

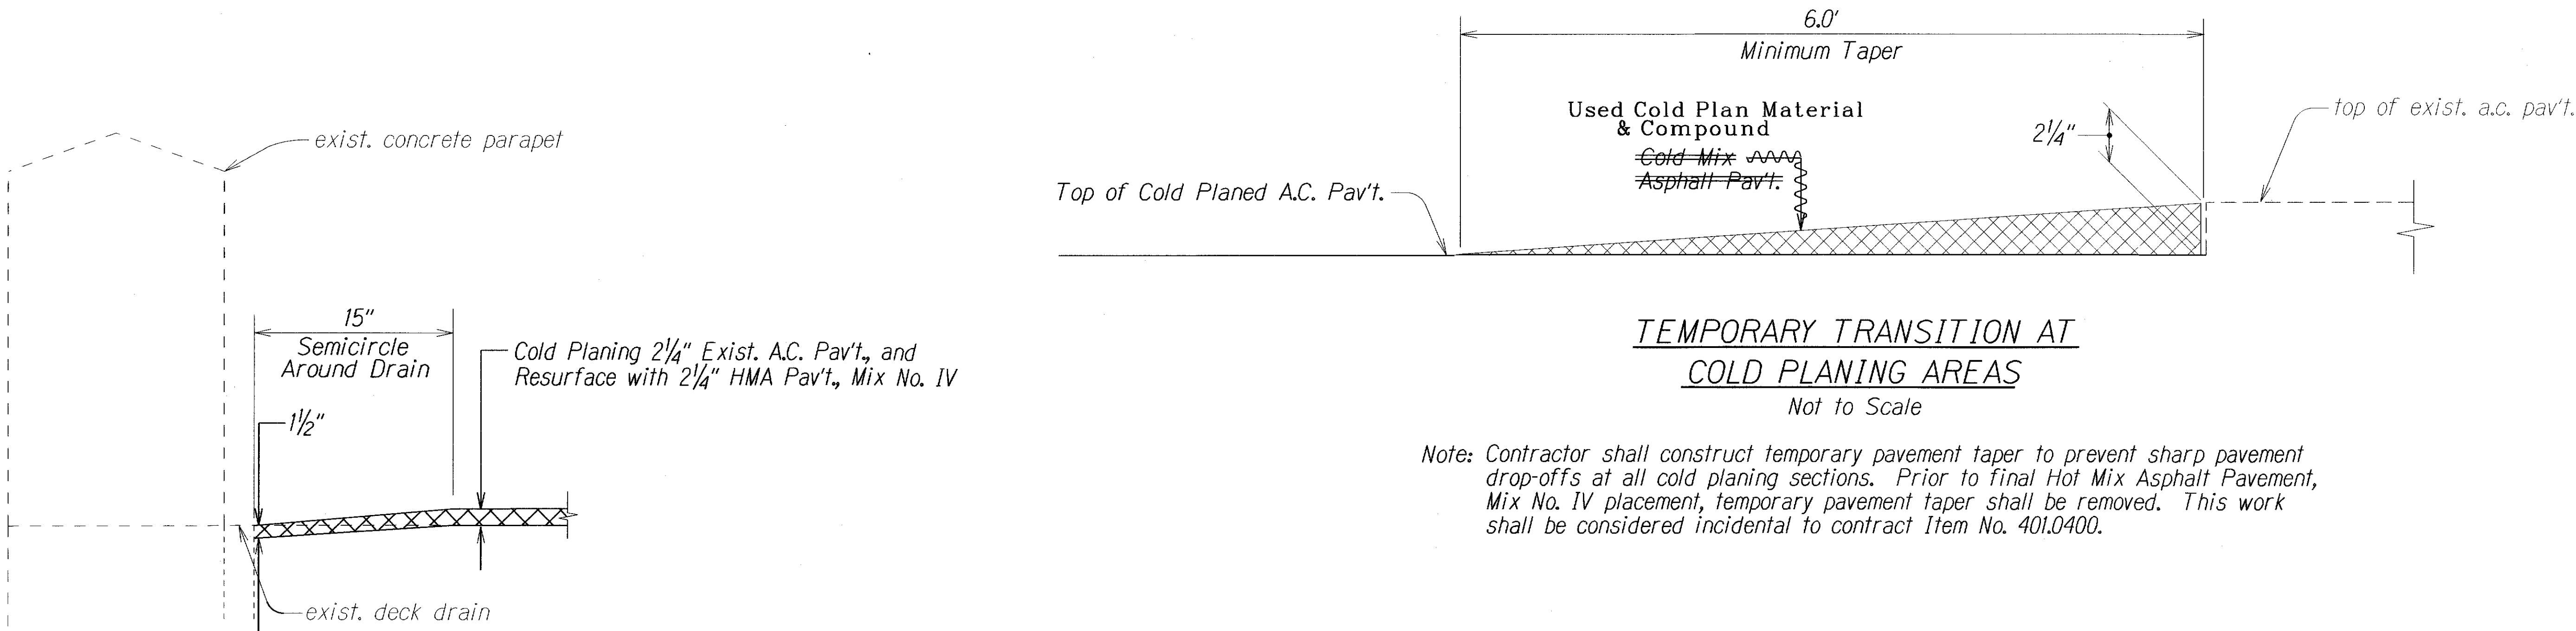

PAVEMENT REPAIR DETAIL AT
WAIPA STREAM BRIDGE DECK DRAIN
Not to Scale

Note: Maximum depth of cold planing shall be 3-3/4" at each existing deck drain opening.
This work shall be considered incidental to contract Item No. 415.0100.

Dress Shoulder and Hydro-mulch (this work shall be considered incidental to the various contract items)

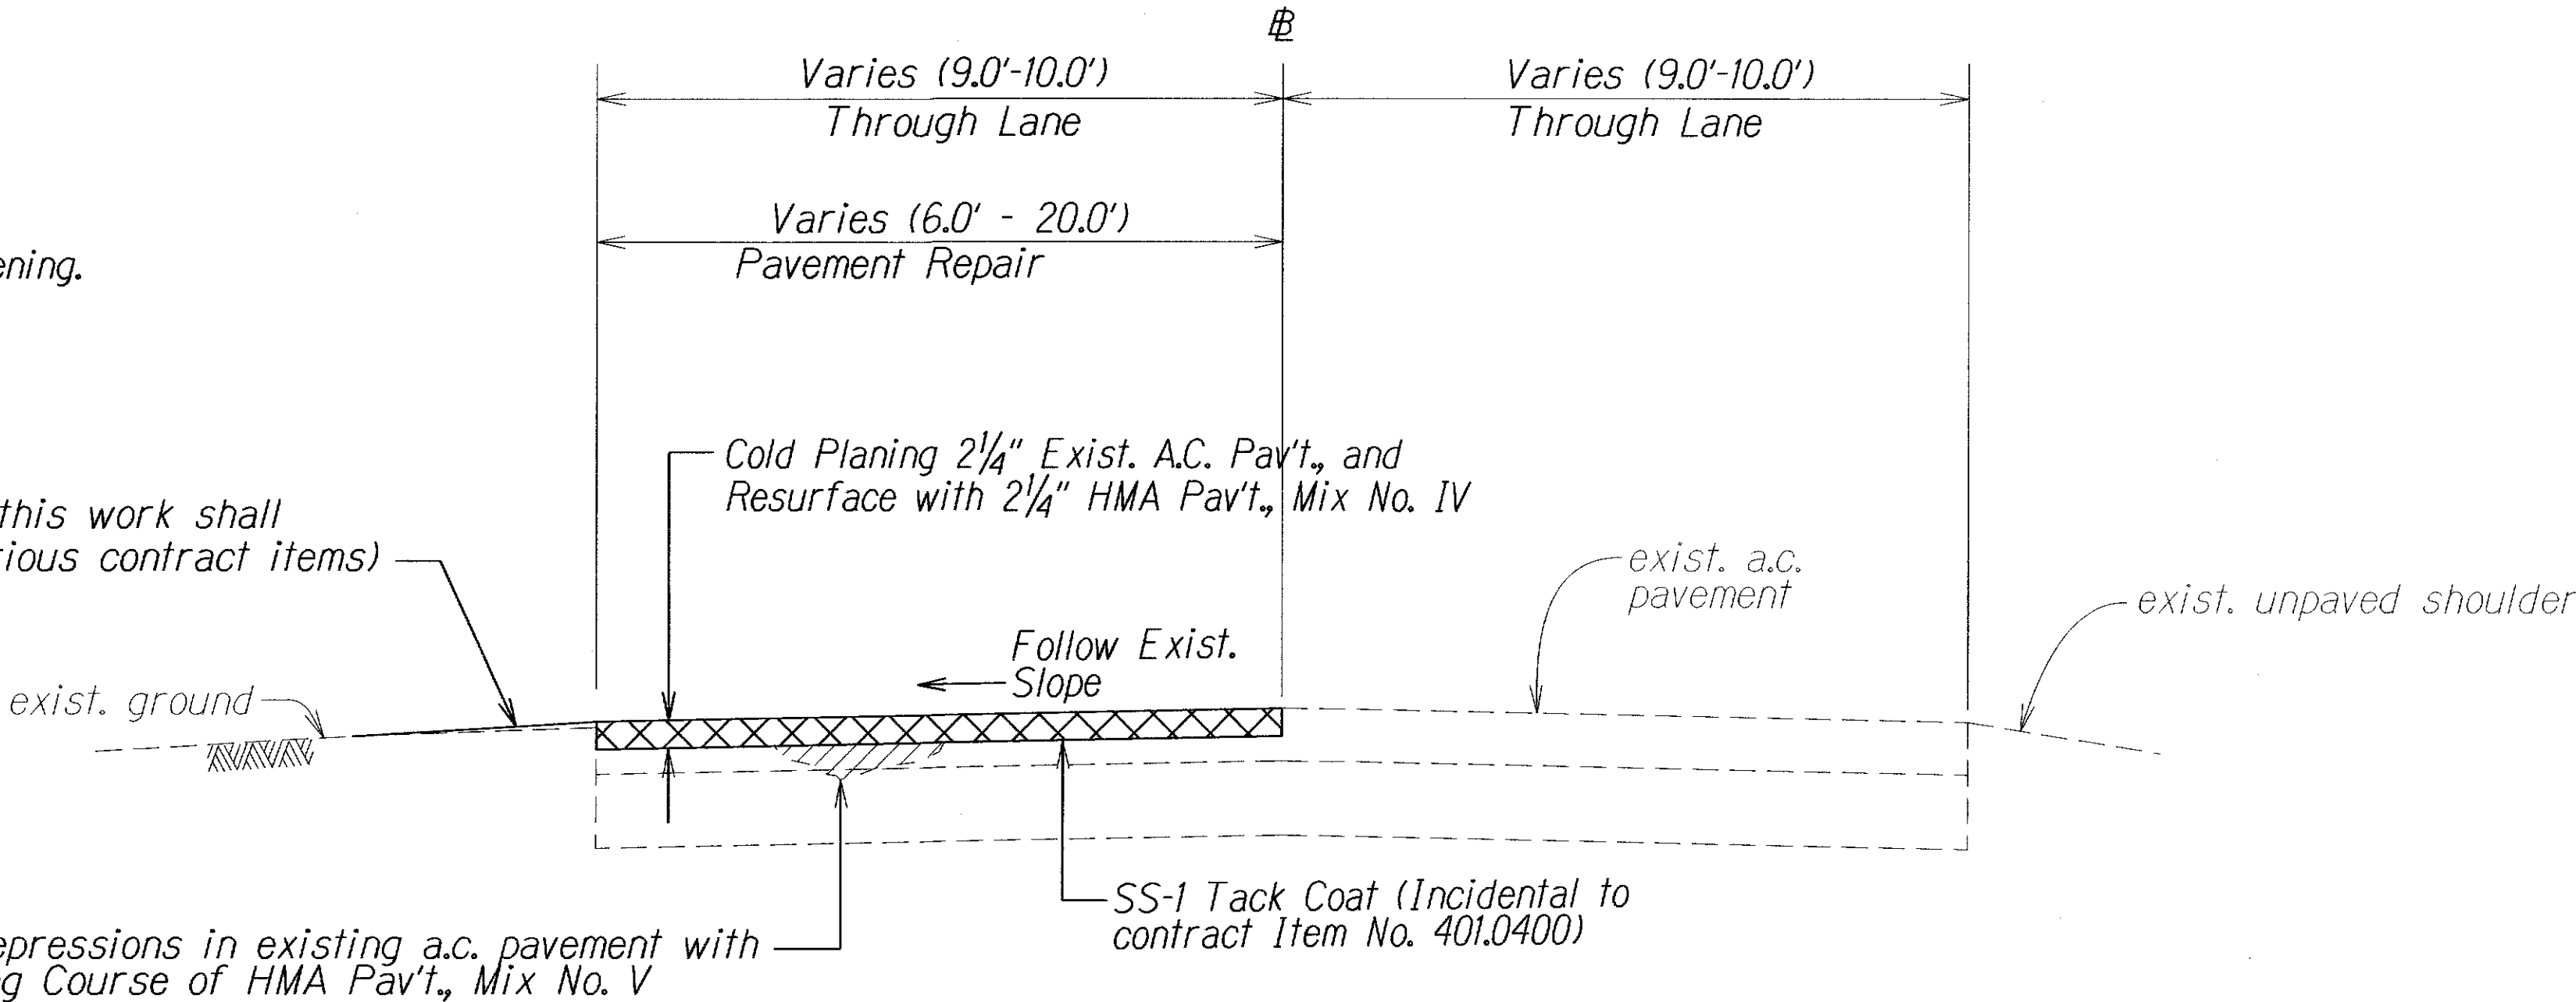

Fill Depressions in existing a.c. pavement with Leveling Course of HMA Pav't., Mix No. V

TYPICAL SECTION
A.C. PAVEMENT REPAIR
Not to Scale

LEGEND FOR AS-BUILT POSTINGS

	Squiggly line for as-built deletion
	Double line for as-built deletion
Roadway	Text for as-built posting

5/24/10	Replaced Plan Sheet No. 6
DATE	REVISION
STATE OF HAWAII DEPARTMENT OF TRANSPORTATION HIGHWAYS DIVISION TYPICAL SECTIONS # PAVEMENT DETAILS KUHO HIGHWAY PAVEMENT REPAIRS Kee Beach to Hanalei Project No. 560A-01-10M Scale: Not to Scale Date: May 2010 SHEET No. 1 OF 1 SHEETS	

ORIGINAL PLAN	SURVEY PLOTTED BY	DATE
NOTE BOOK	DRAWN BY	
ADD. 5/24/10	DESIGNED BY	
	CHECKED BY	

"AS-BUILT"

ADD. 6