


FED. ROAD DIST. NO.	STATE	PROJ. NO.	FISCAL YEAR	SHEET NO.	TOTAL SHEETS
HAWAII	HAW.	560A-01-10M	2010	ADD. 7	20

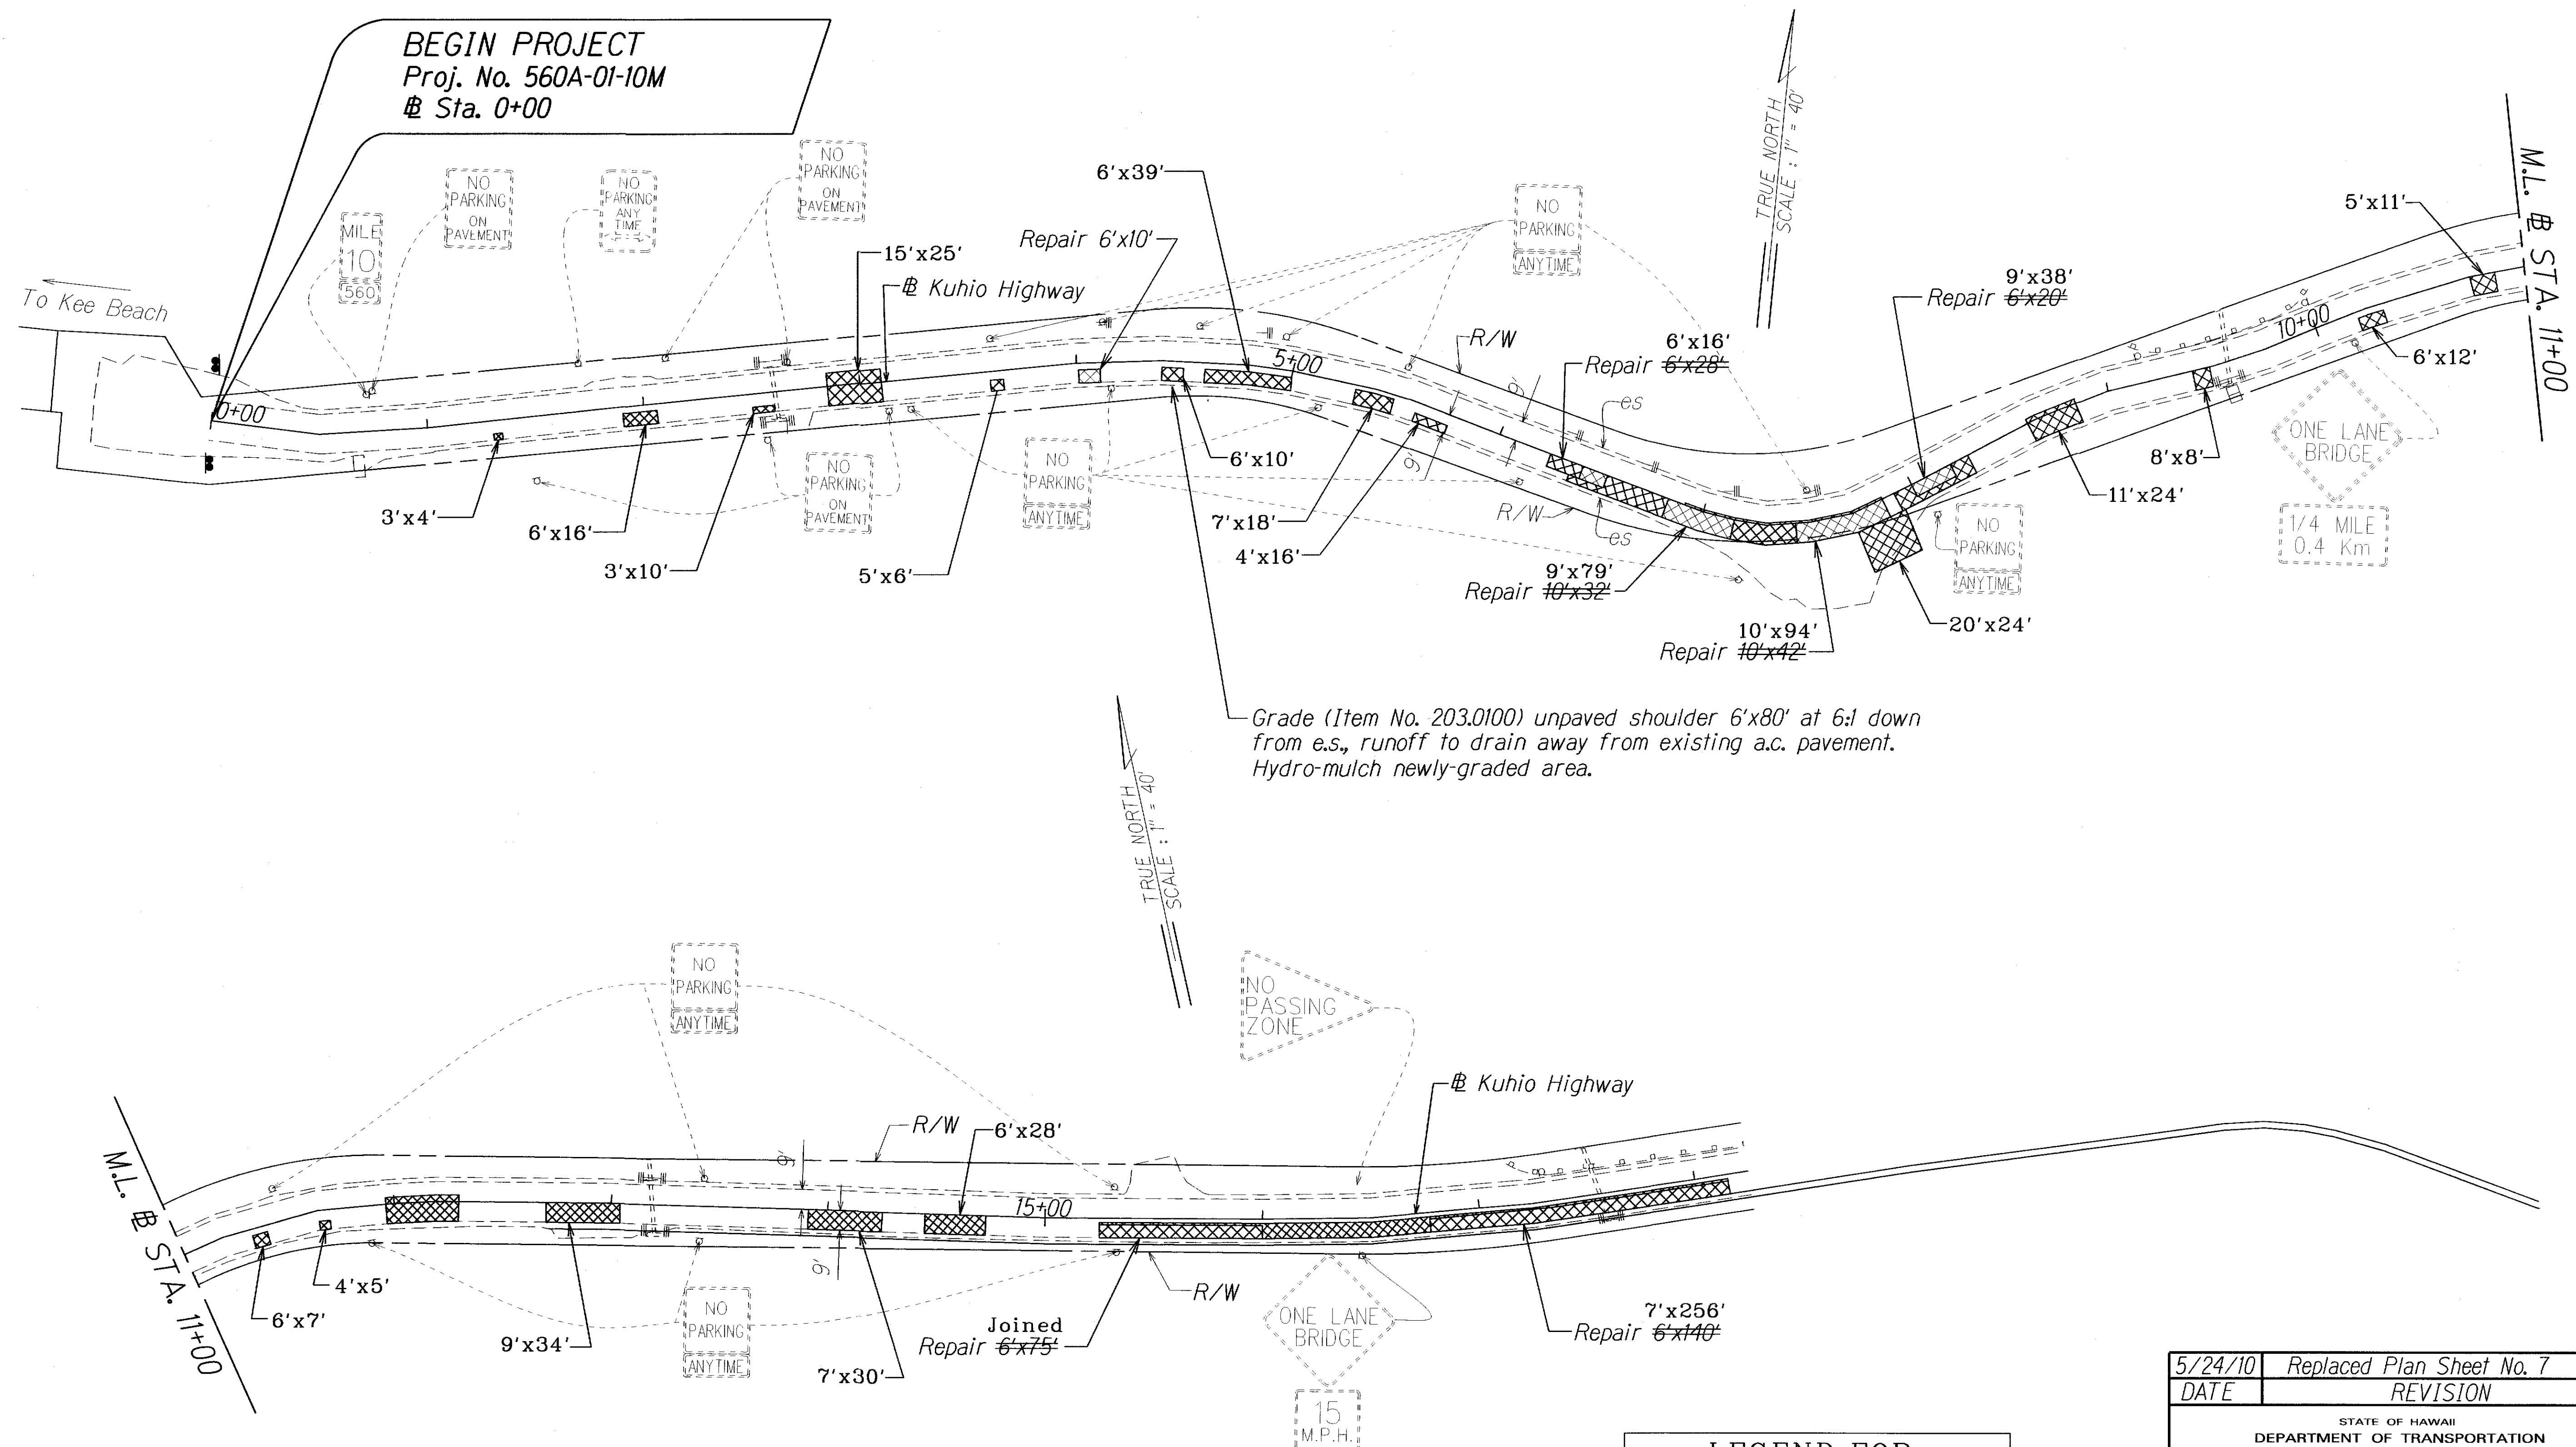


ORIGINAL PLAN	SURVEY PLOTTED BY	DATE
NOTE BOOK	DRAWN BY	
400 7 400	DESIGNED BY	
	QUANTITIES BY	
	CHECKED BY	

LEGEND FOR AS-BUILT POSTINGS	
	Squiggly line for as-built deletion
	Double line for as-built deletion
Roadway	Text for as-built posting

5/24/10	Replaced Plan Sheet No. 7
DATE	REVISION
STATE OF HAWAII DEPARTMENT OF TRANSPORTATION HIGHWAYS DIVISION	
ROADWAY PLAN	
KUHIO HIGHWAY PAVEMENT REPAIRS Kee Beach to Hanalei Project No. 560A-01-10M	
Scale: 1" = 40'	Date: May 2010
SHEET No. 1 OF 10 SHEETS	

FED. ROAD DIST. NO.	STATE	PROJ. NO.	FISCAL YEAR	SHEET NO.	TOTAL SHEETS
HAWAII	HAW.	560A-01-10M	2010	8	20

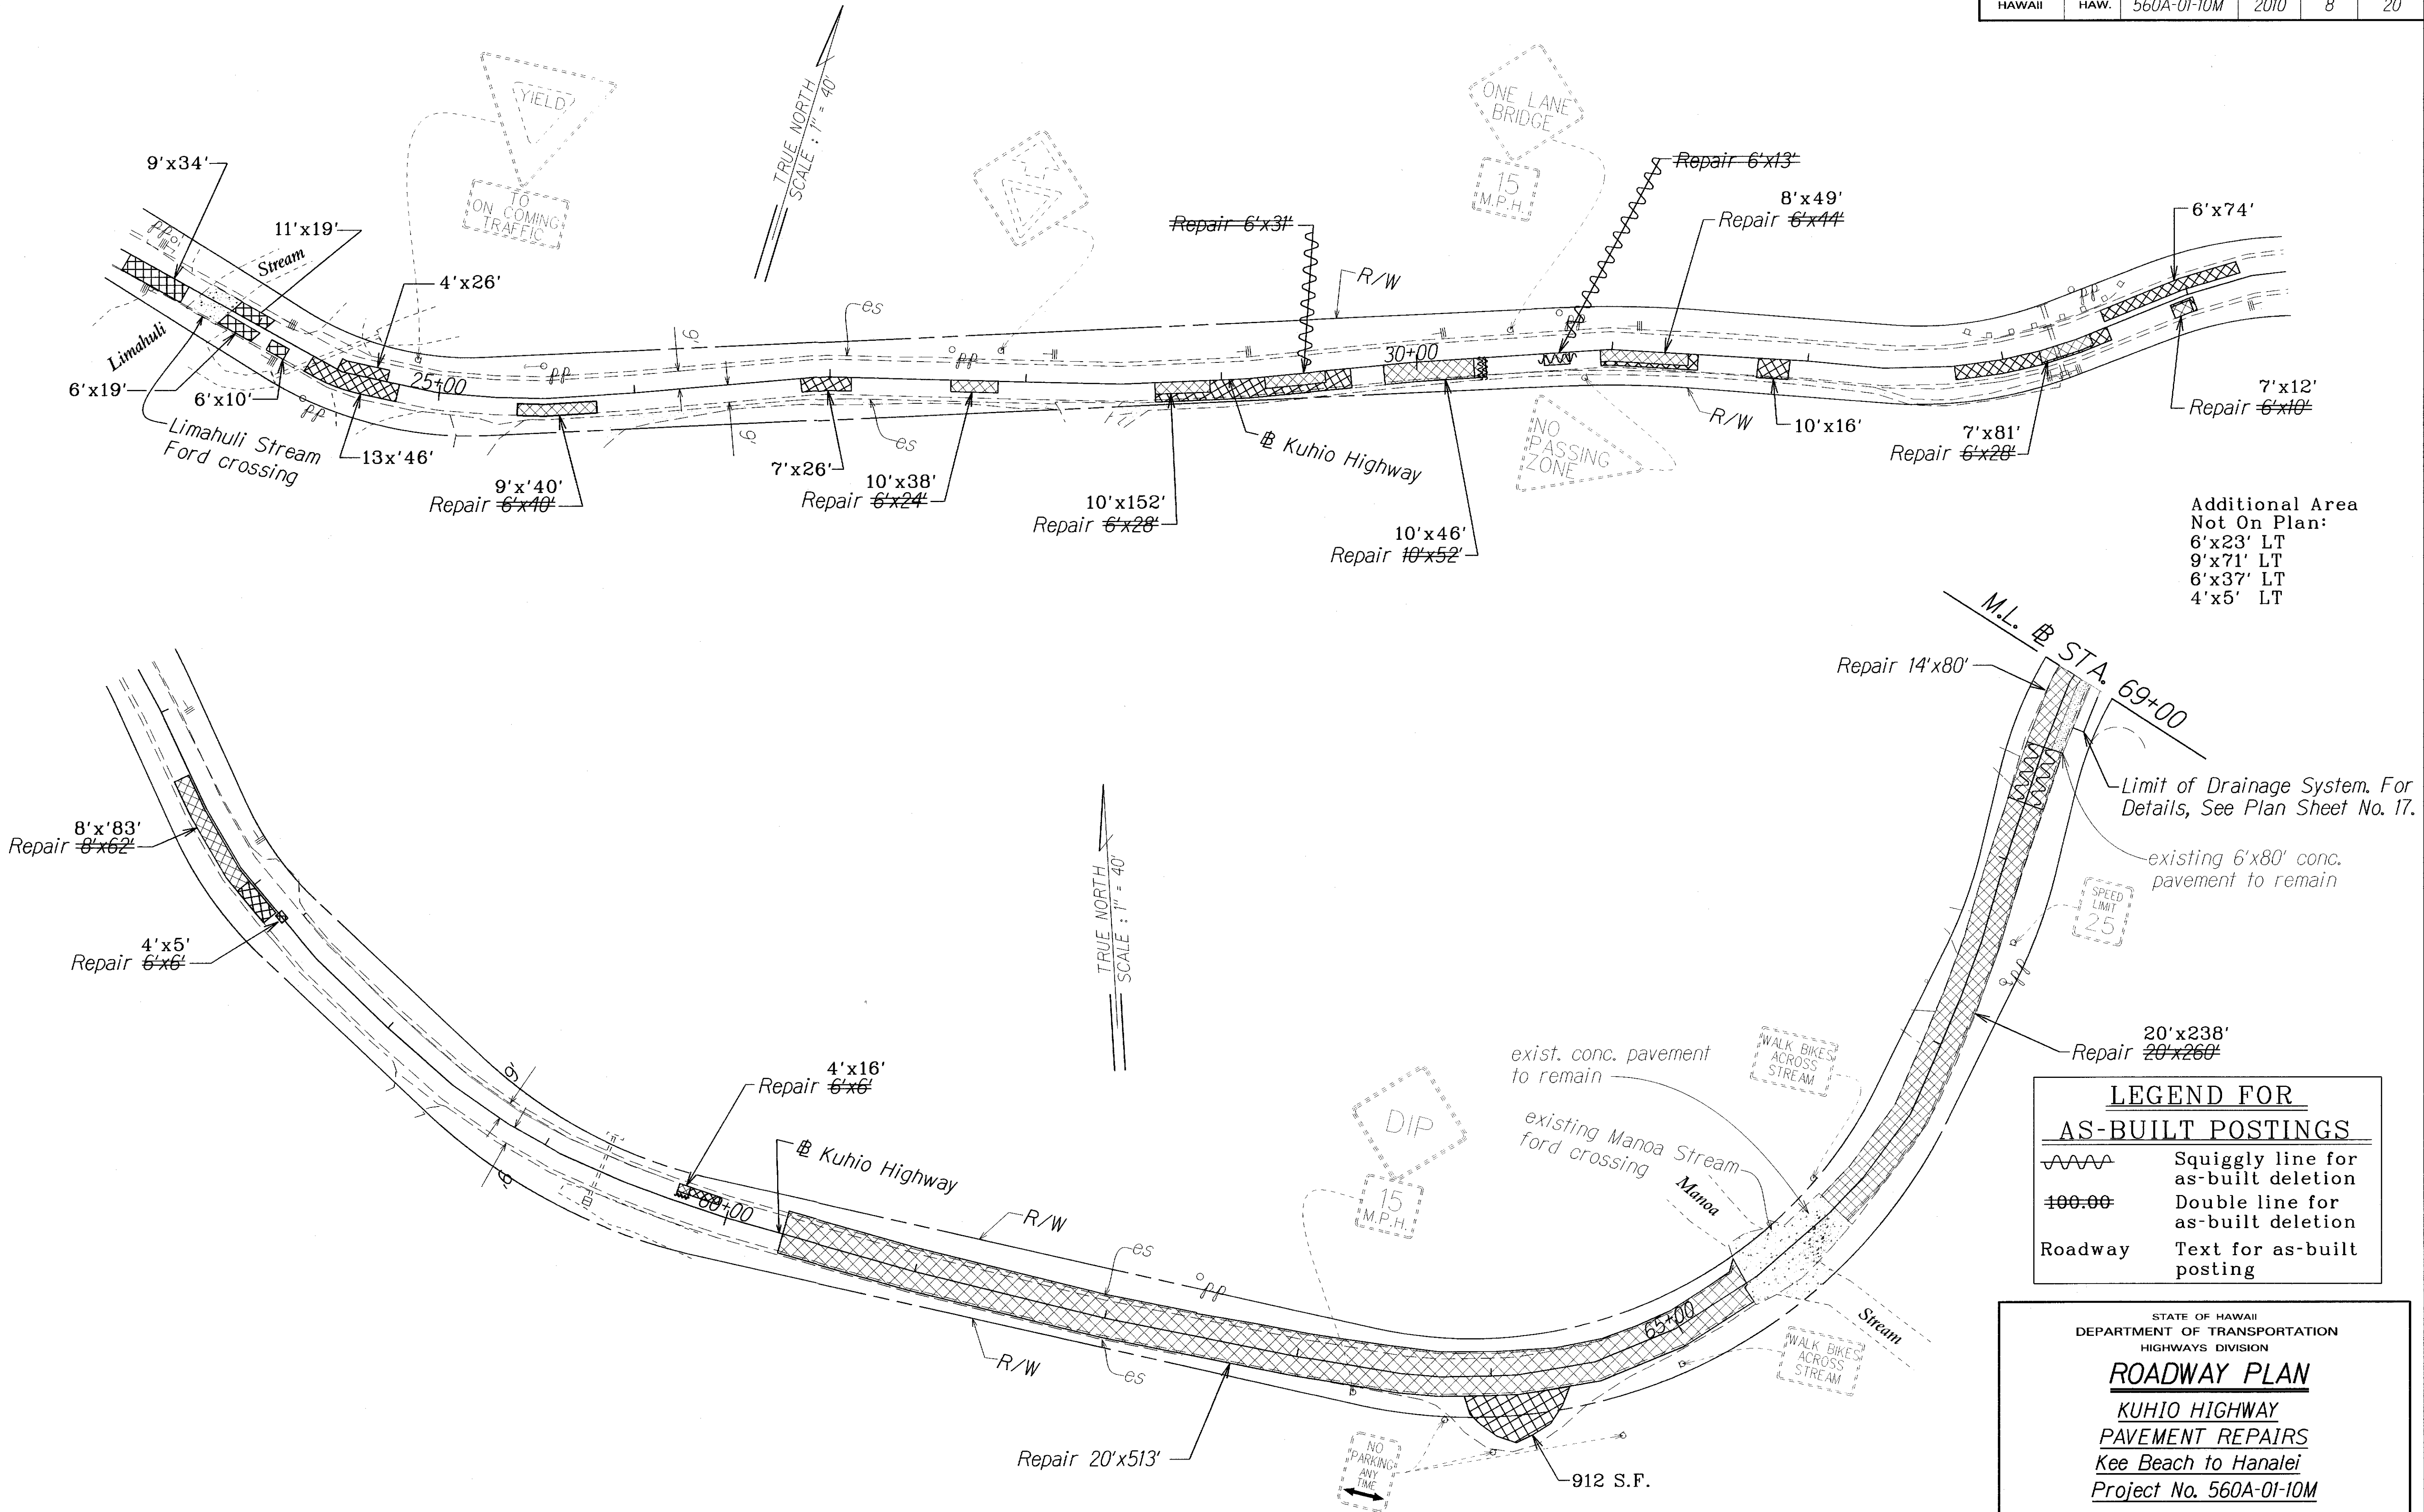

Additional Area
Not On Plan:
6'x23' LT
9'x71' LT
6'x37' LT
4'x5' LT

LEGEND FOR AS-BUILT POSTINGS	
	Squiggly line for as-built deletion
	Double line for as-built deletion
Roadway	Text for as-built posting

STATE OF HAWAII
DEPARTMENT OF TRANSPORTATION
HIGHWAYS DIVISION

ROADWAY PLAN
KUHIO HIGHWAY
PAVEMENT REPAIRS
Kee Beach to Hanalei
Project No. 560A-01-10M


Scale: 1"=40'
Date: May 2010

SHEET No. 2 OF 10 SHEETS

SURVEY PLOTTED BY	DATE
DRAWN BY	
DESIGNED BY	
QUANTITIES BY	
CHECKED BY	
ORIGINAL PLAN	
NOTE BOOK	
662	
4/20/2010	

"AS-BUILT"

FED. ROAD DIST. NO.	STATE	PROJ. NO.	FISCAL YEAR	SHEET NO.	TOTAL SHEETS
HAWAII	HAW.	560A-01-10M	2010	9	20

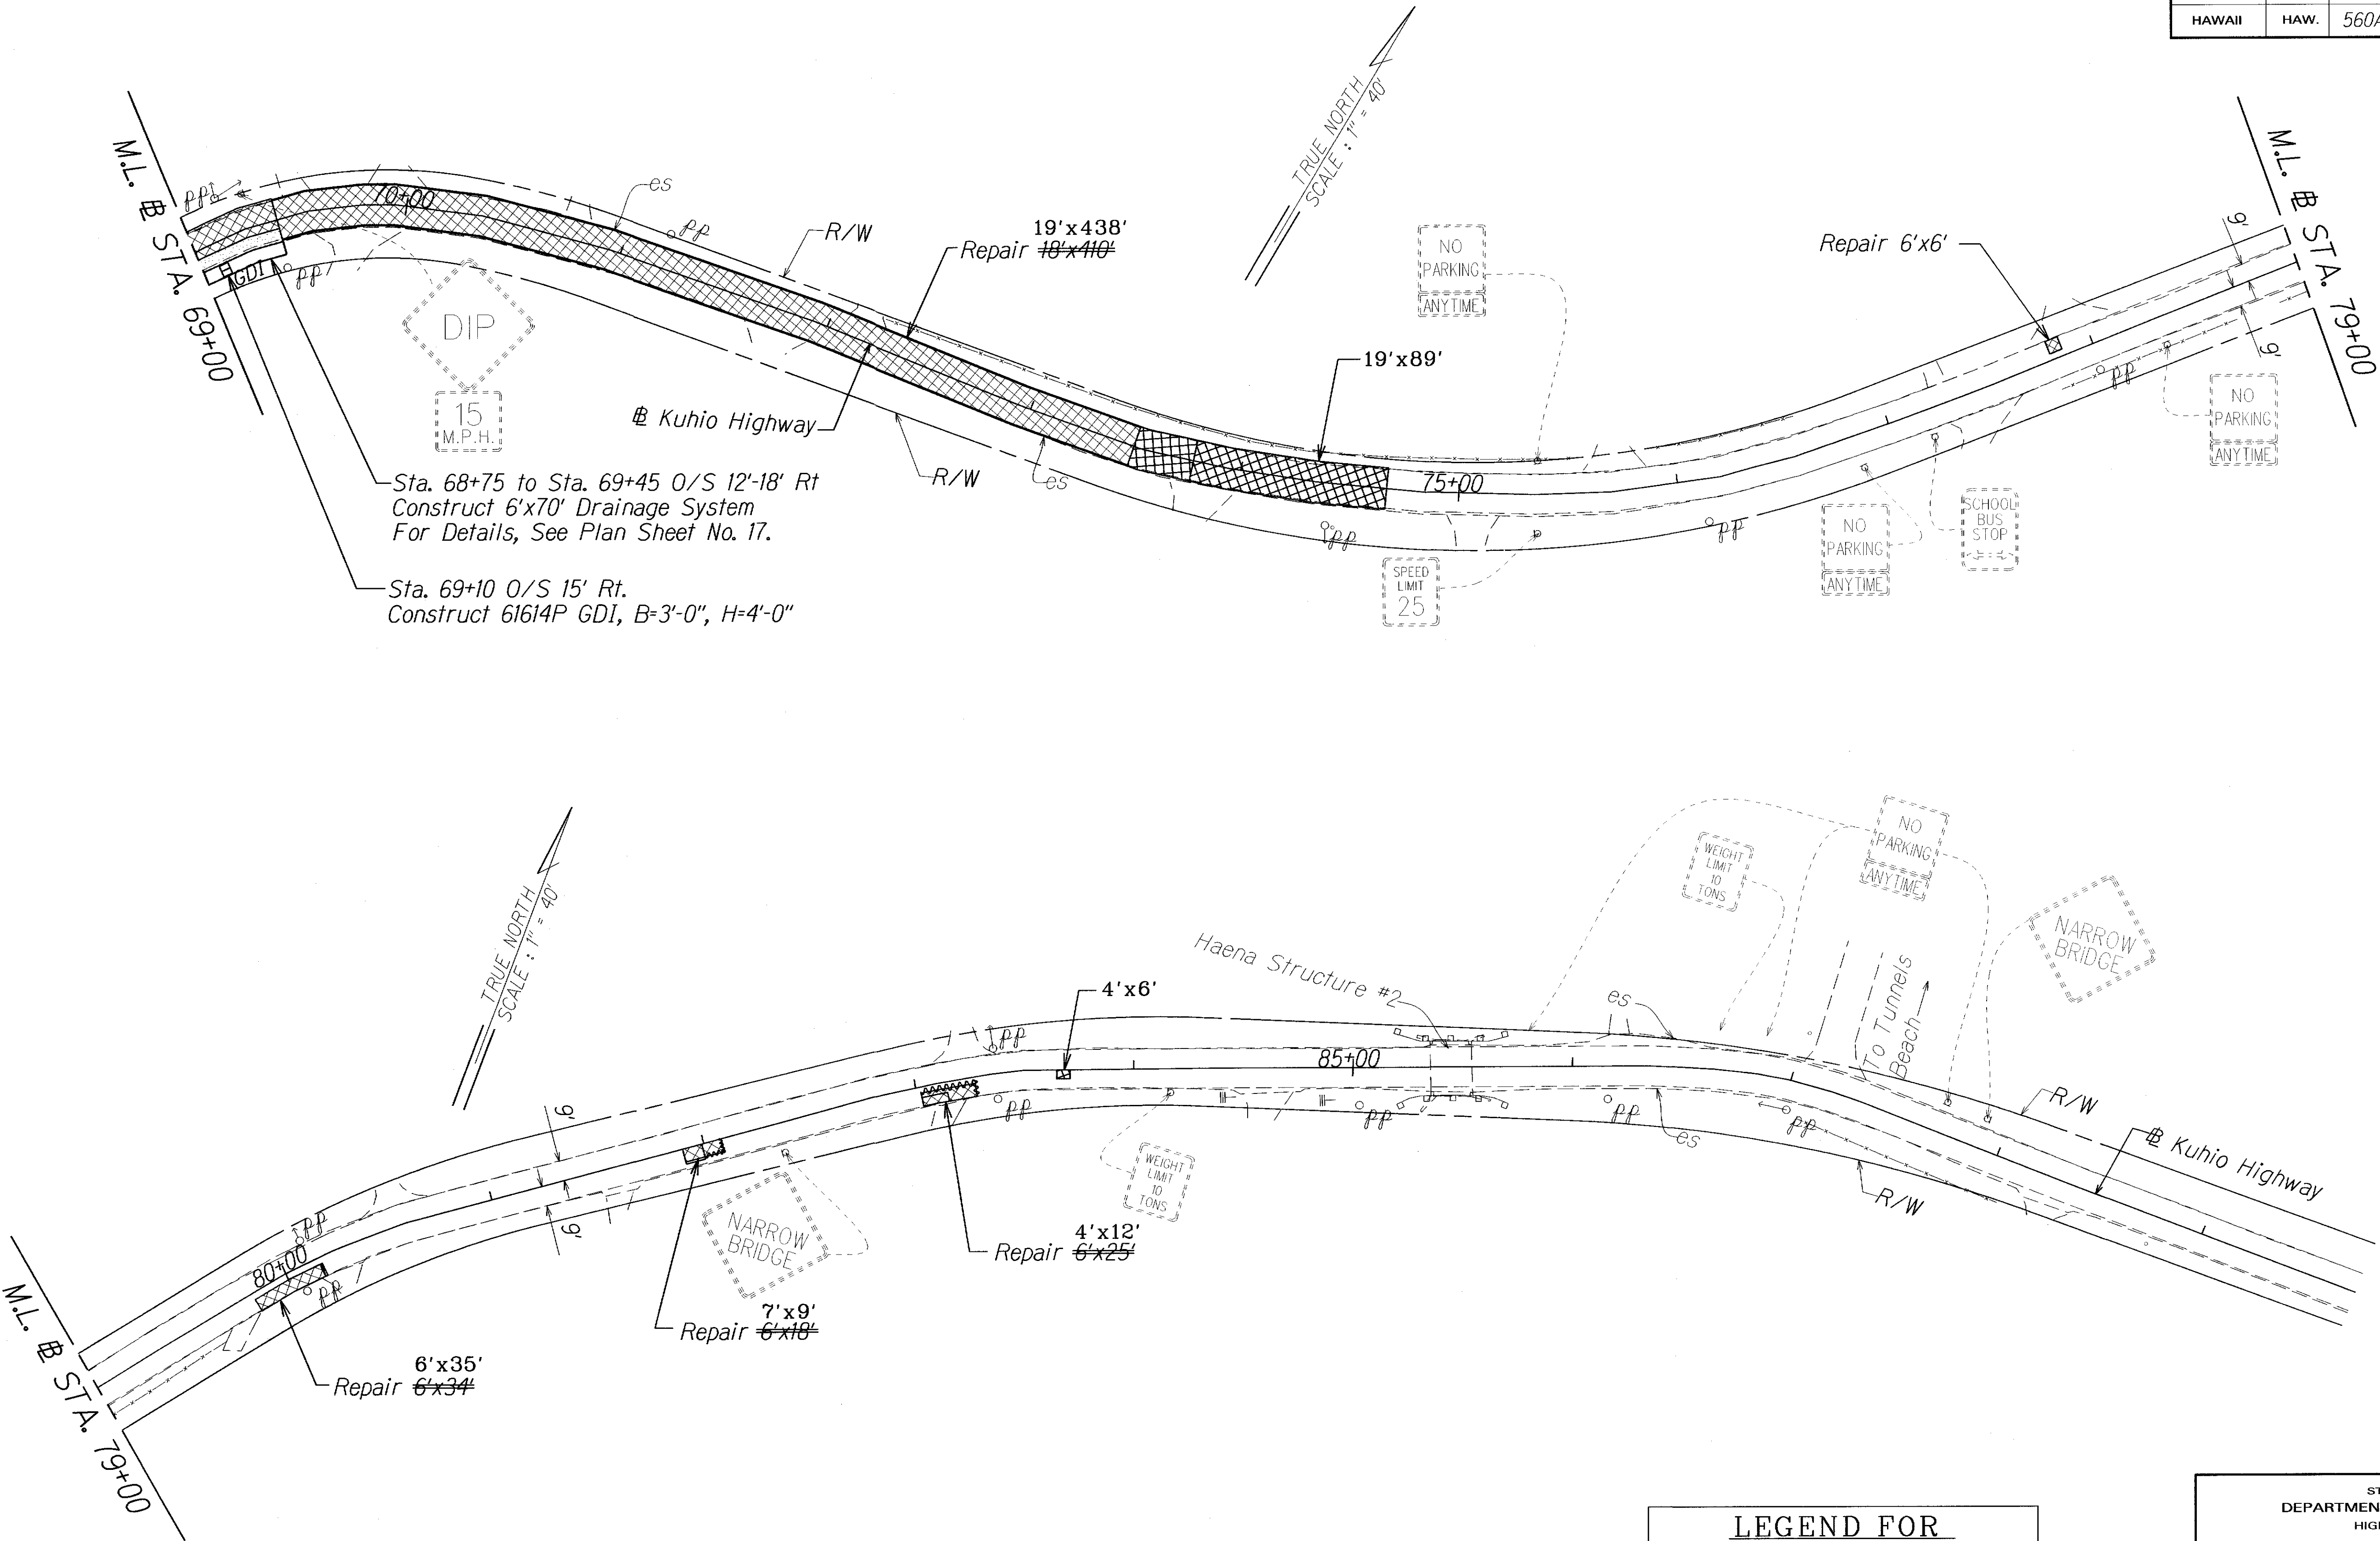

ORIGINAL PLAN	SURVEY PLOTTED BY	DATE
NOTE BOOK	DESIGNED BY	
QUANTITIES BY	CHECKED BY	

LEGEND FOR AS-BUILT POSTINGS	
	Squiggly line for as-built deletion
	Double line for as-built deletion
Roadway	Text for as-built posting



STATE OF HAWAII
DEPARTMENT OF TRANSPORTATION
HIGHWAYS DIVISION

ROADWAY PLAN
KUHIO HIGHWAY
PAVEMENT REPAIRS
Kee Beach to Hanalei
Project No. 560A-01-10M

Scale: 1"=40'
Date: May 2010

SHEET No. 3 OF 10 SHEETS

FED. ROAD DIST. NO.	STATE	PROJ. NO.	FISCAL YEAR	SHEET NO.	TOTAL SHEETS
HAWAII	HAW.	560A-01-10M	2010	10	20

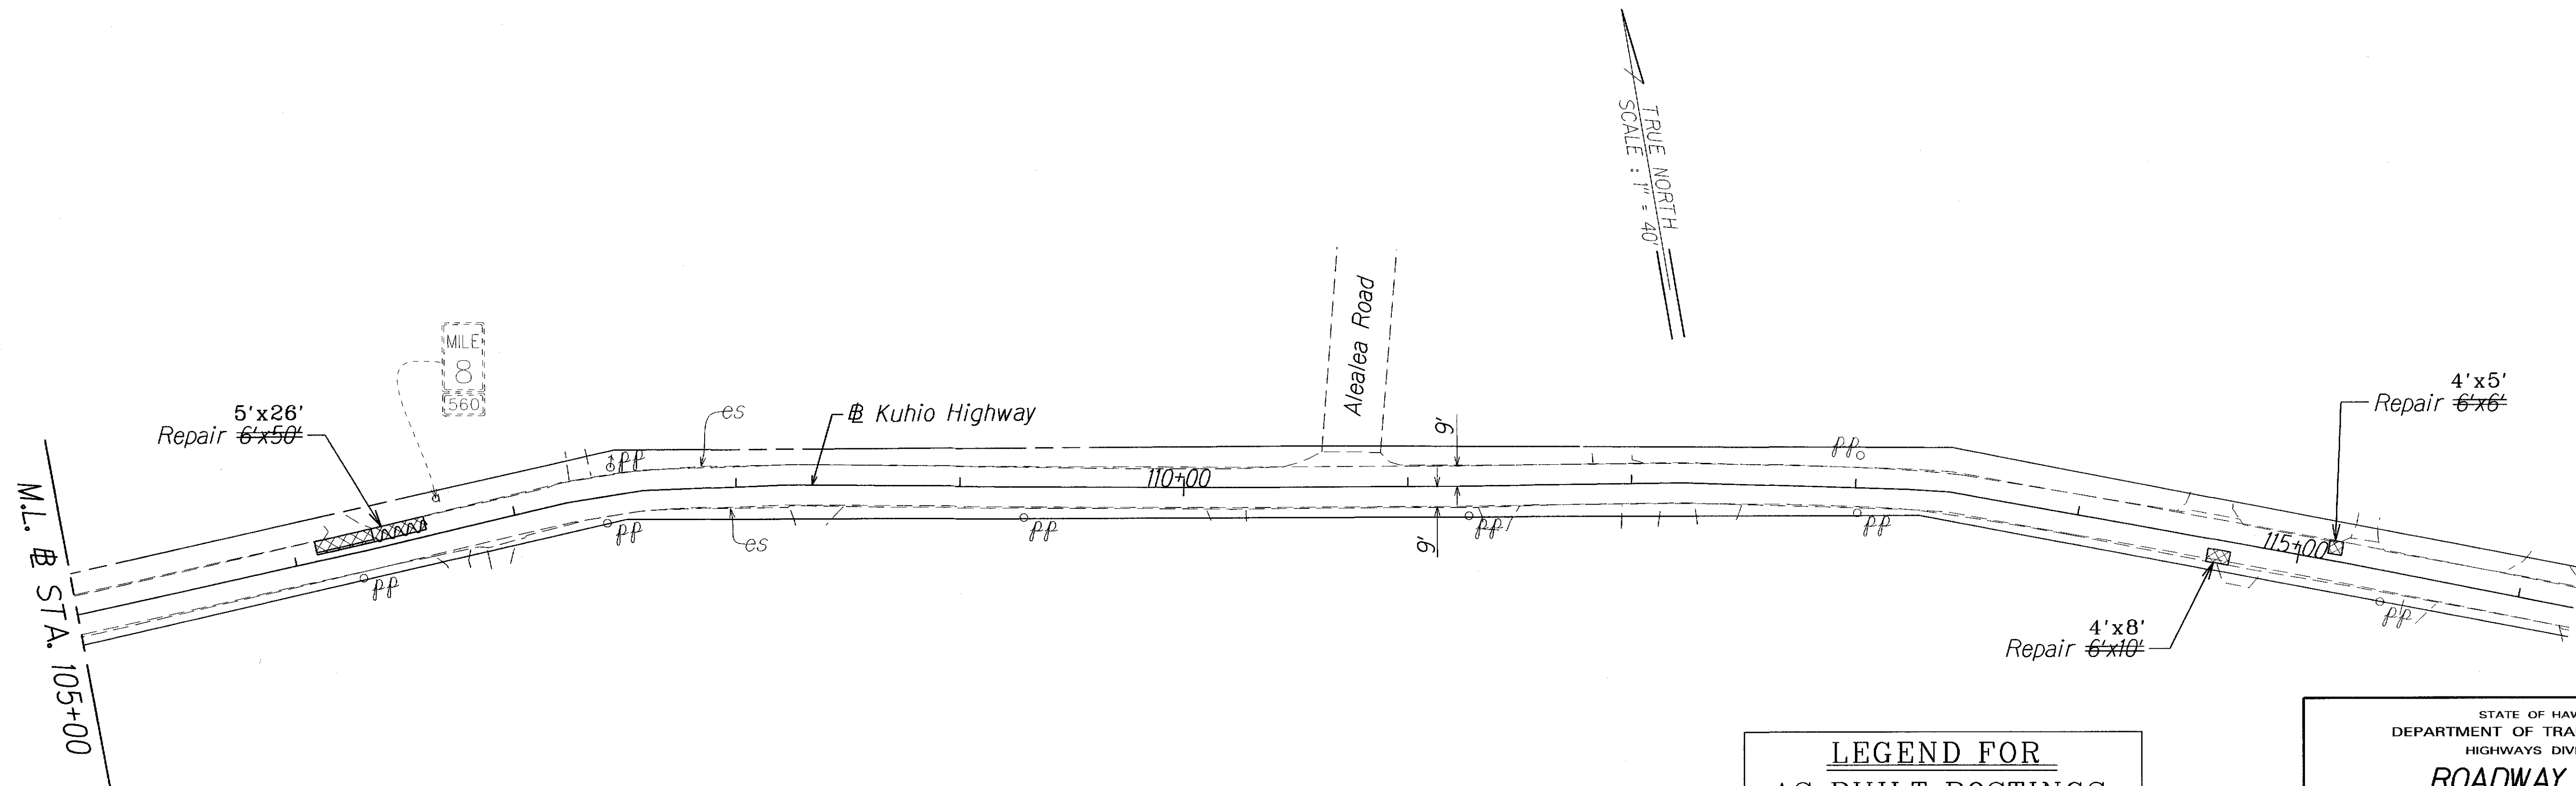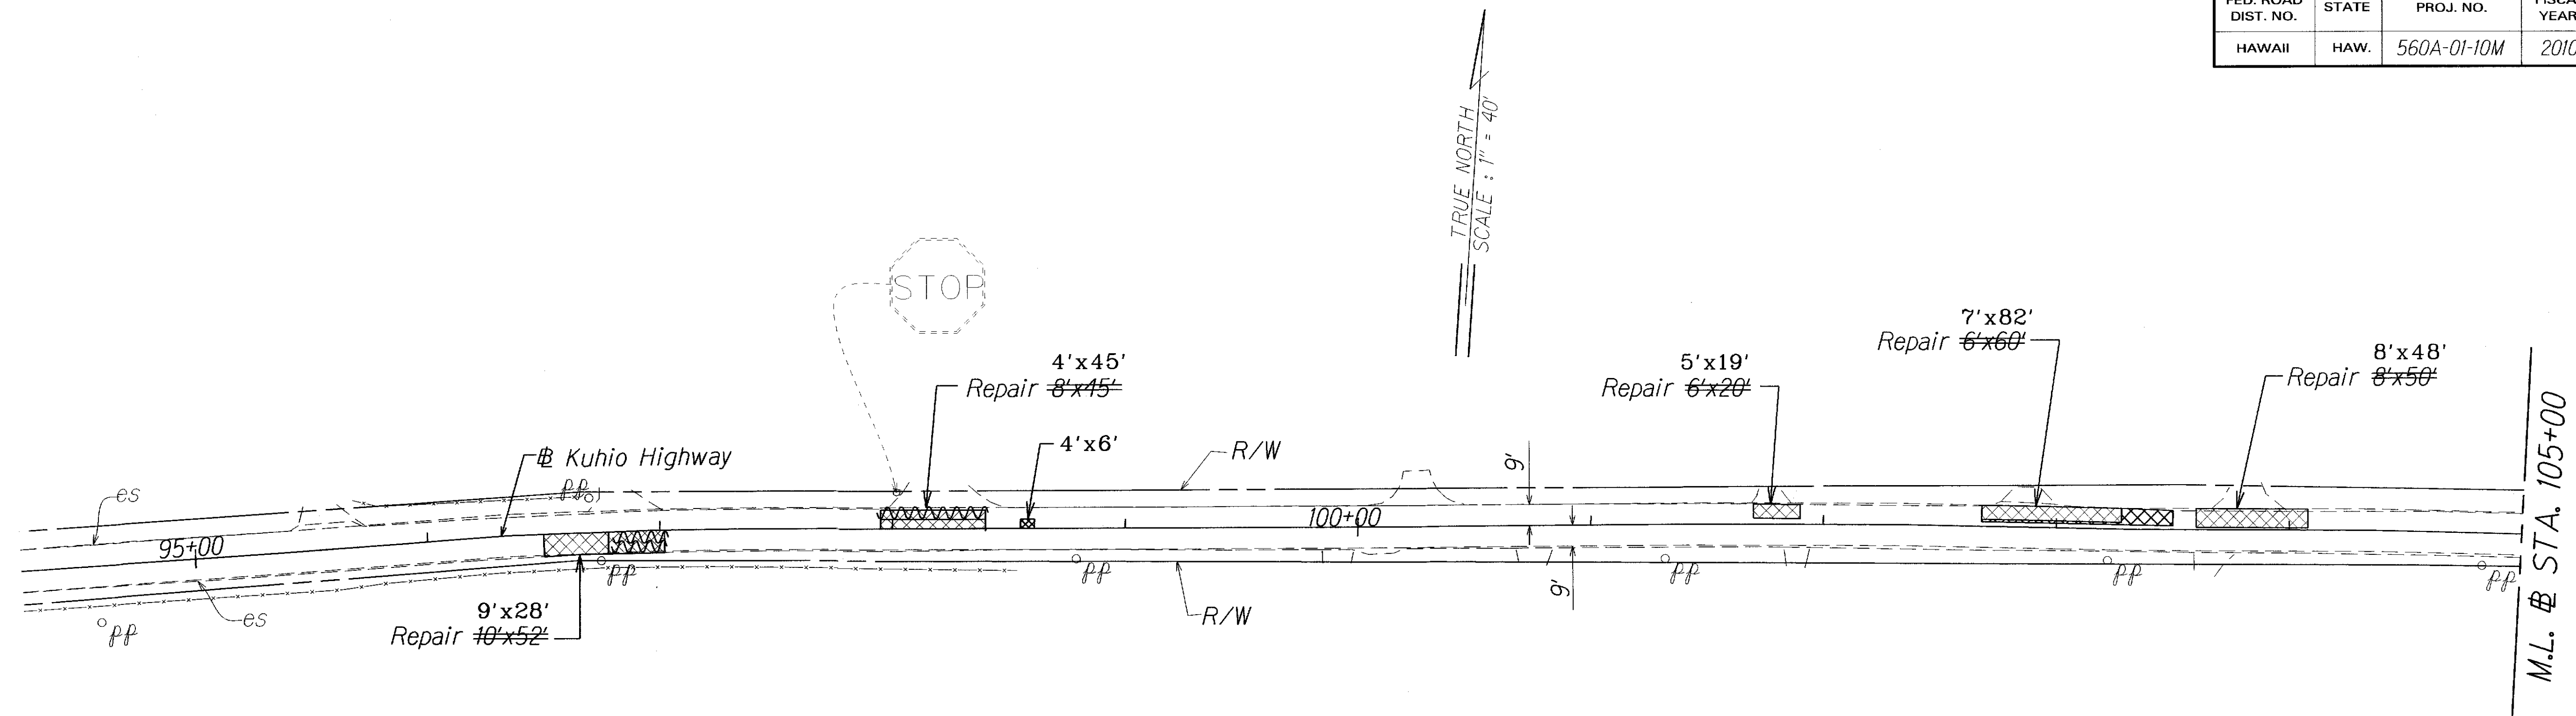

ORIGINAL PLAN	SURVEY PLOTTED BY	DATE
NOTE BOOK	DRAWN BY	
DESIGNED BY	QUANTITIES BY	
CHECKED BY		

LEGEND FOR AS-BUILT POSTINGS	
	Squiggly line for as-built deletion
	Double line for as-built deletion
Roadway	Text for as-built posting

STATE OF HAWAII
DEPARTMENT OF TRANSPORTATION
HIGHWAYS DIVISION

ROADWAY PLAN


KUHIO HIGHWAY
PAVEMENT REPAIRS
Kee Beach to Hanalei
Project No. 560A-01-10M

Scale: 1"=40' Date: May 2010

SHEET No. 4 OF 10 SHEETS

"AS-BUILT"

FED. ROAD DIST. NO.	STATE	PROJ. NO.	FISCAL YEAR	SHEET NO.	TOTAL SHEETS
HAWAII	HAW.	560A-01-10M	2010	11	20

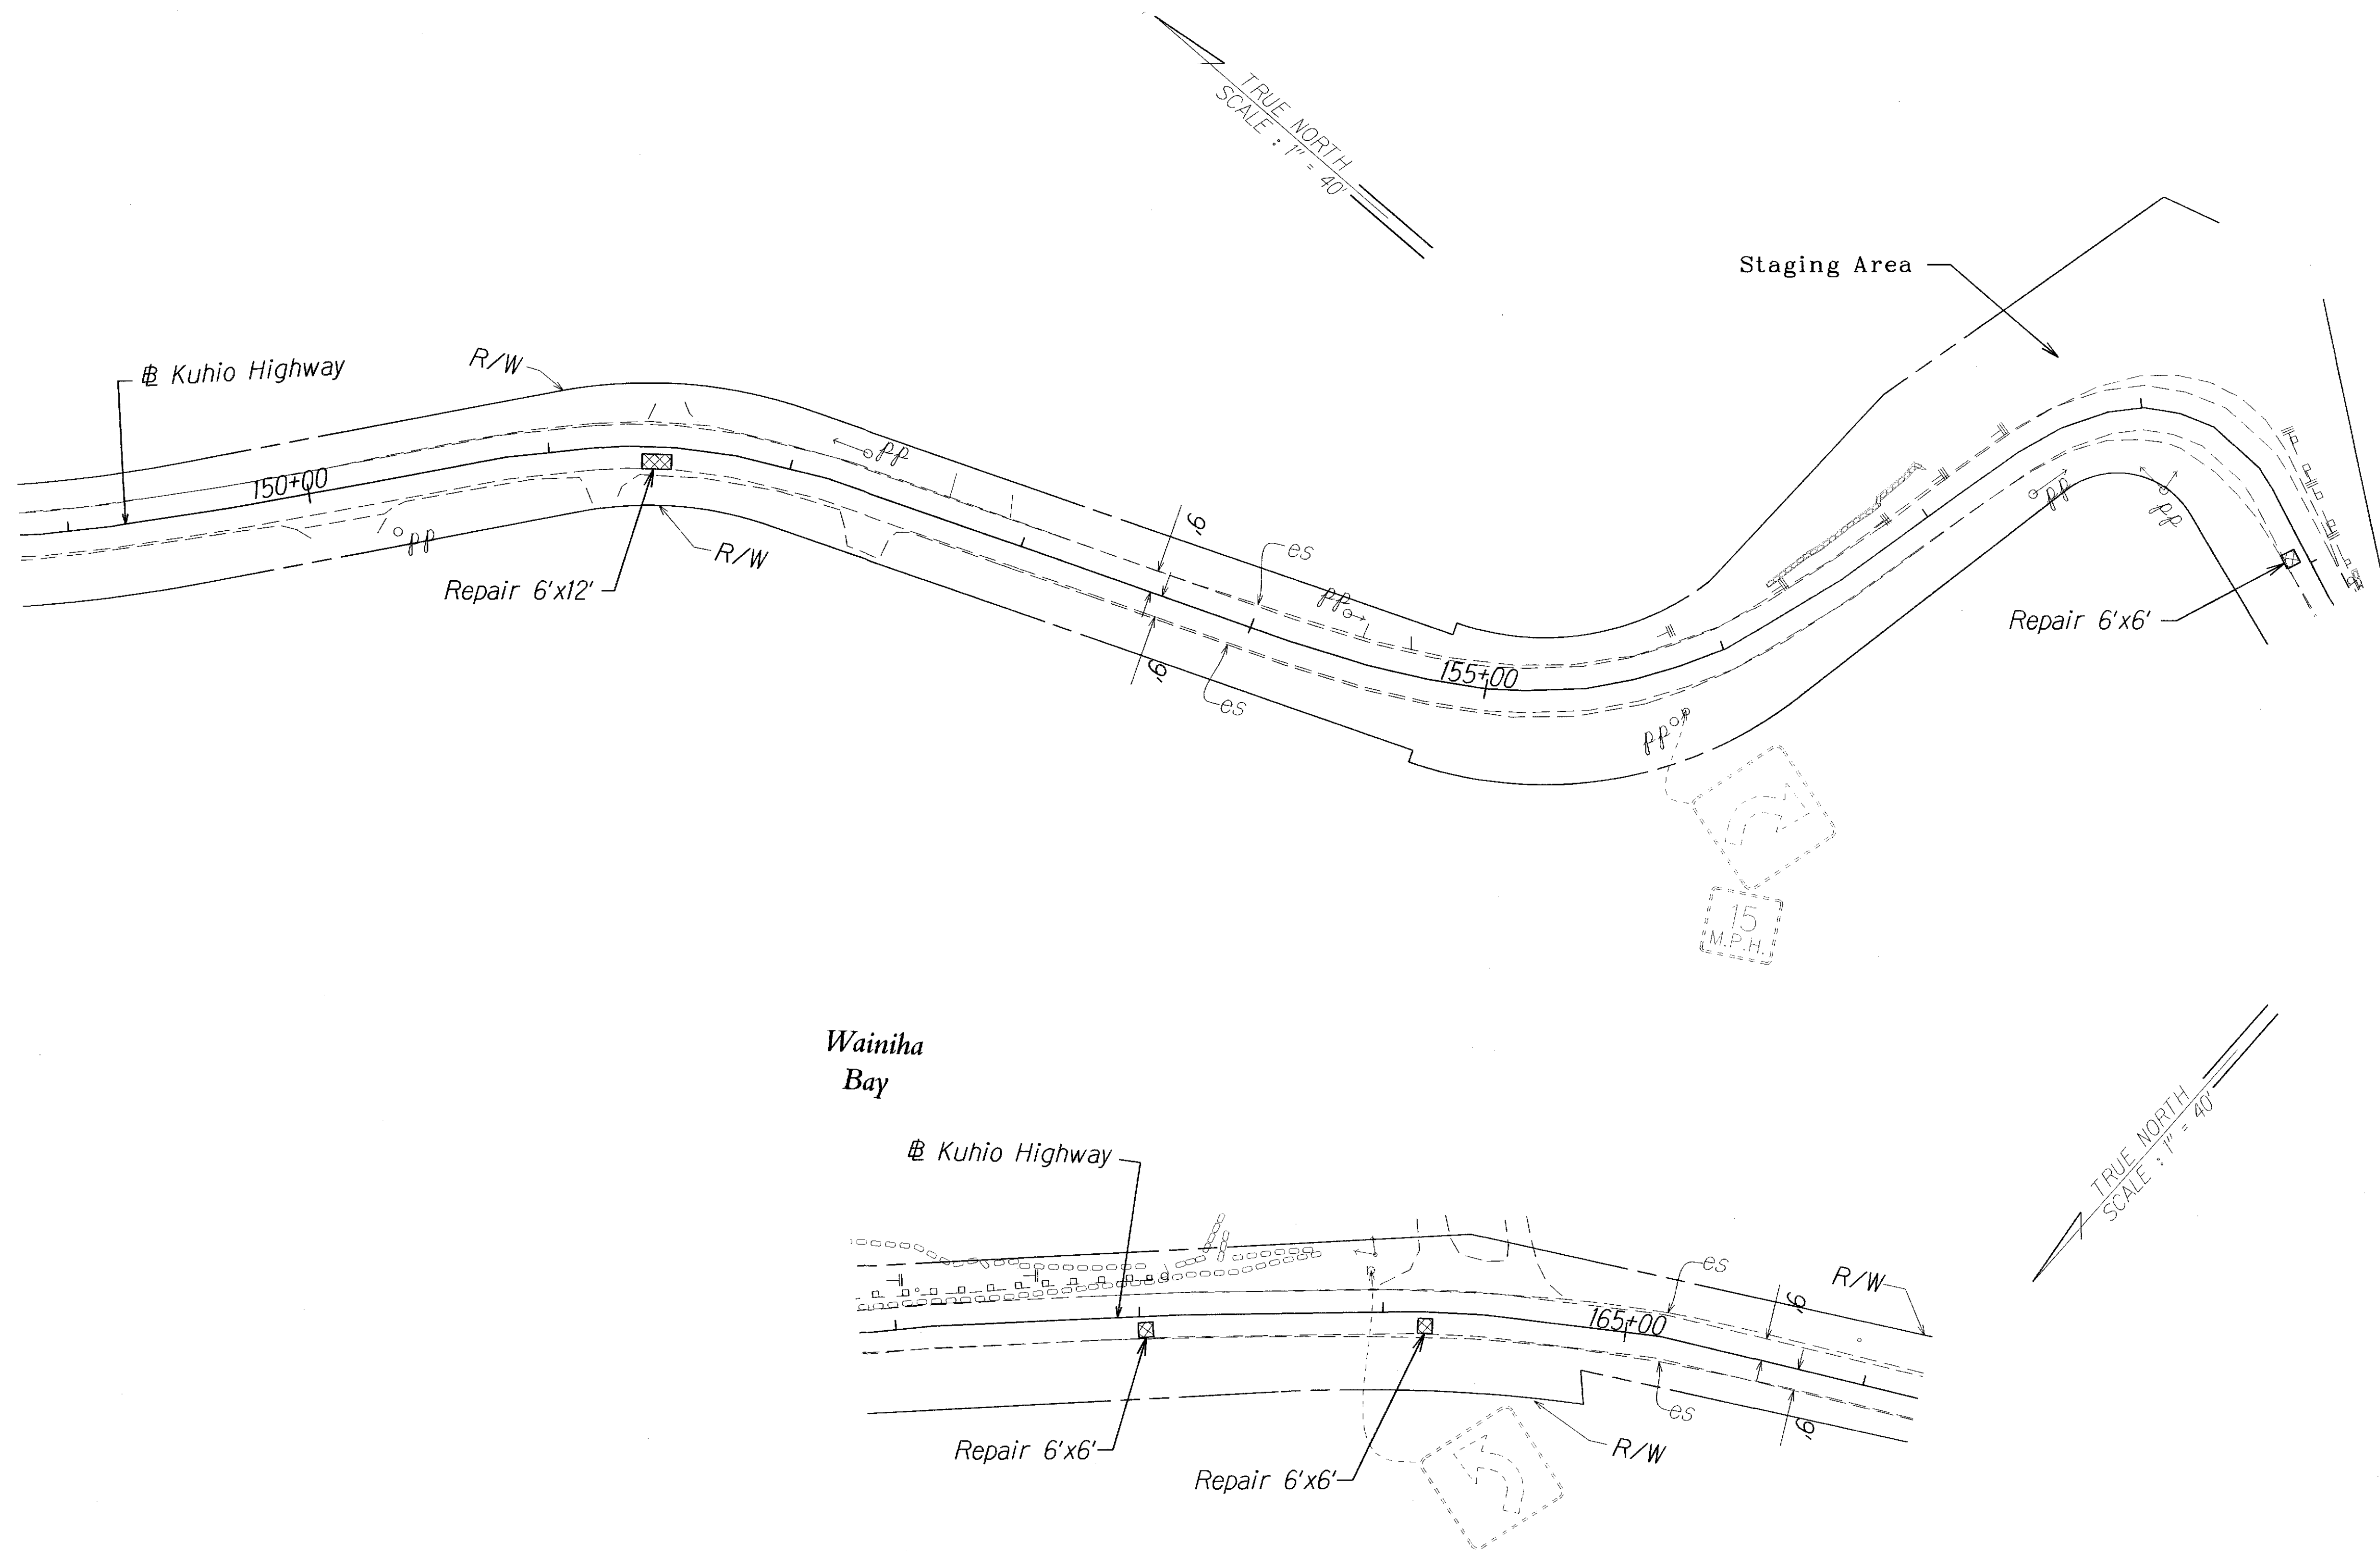


LEGEND FOR AS-BUILT POSTINGS	
	Squiggly line for as-built deletion
	Double line for as-built deletion
Roadway	Text for as-built posting

STATE OF HAWAII DEPARTMENT OF TRANSPORTATION HIGHWAYS DIVISION
ROADWAY PLAN
KUHIO HIGHWAY
PAVEMENT REPAIRS
Kee Beach to Hanalei
Project No. 560A-01-10M
Scale: 1"=40' Date: May 2010
SHEET No. 5 OF 10 SHEETS

"AS-BUILT"

ORIGINAL PLAN	SURVEY PLOTTED BY	DATE
NOTE BOOK	DRAWN BY	1/1
102	DESIGNED BY	
1/1	QUANTITIES BY	
1/1	CHECKED BY	

FED. ROAD DIST. NO.	STATE	PROJ. NO.	FISCAL YEAR	SHEET NO.	TOTAL SHEETS
HAWAII	HAW.	560A-01-10M	2010	12	20

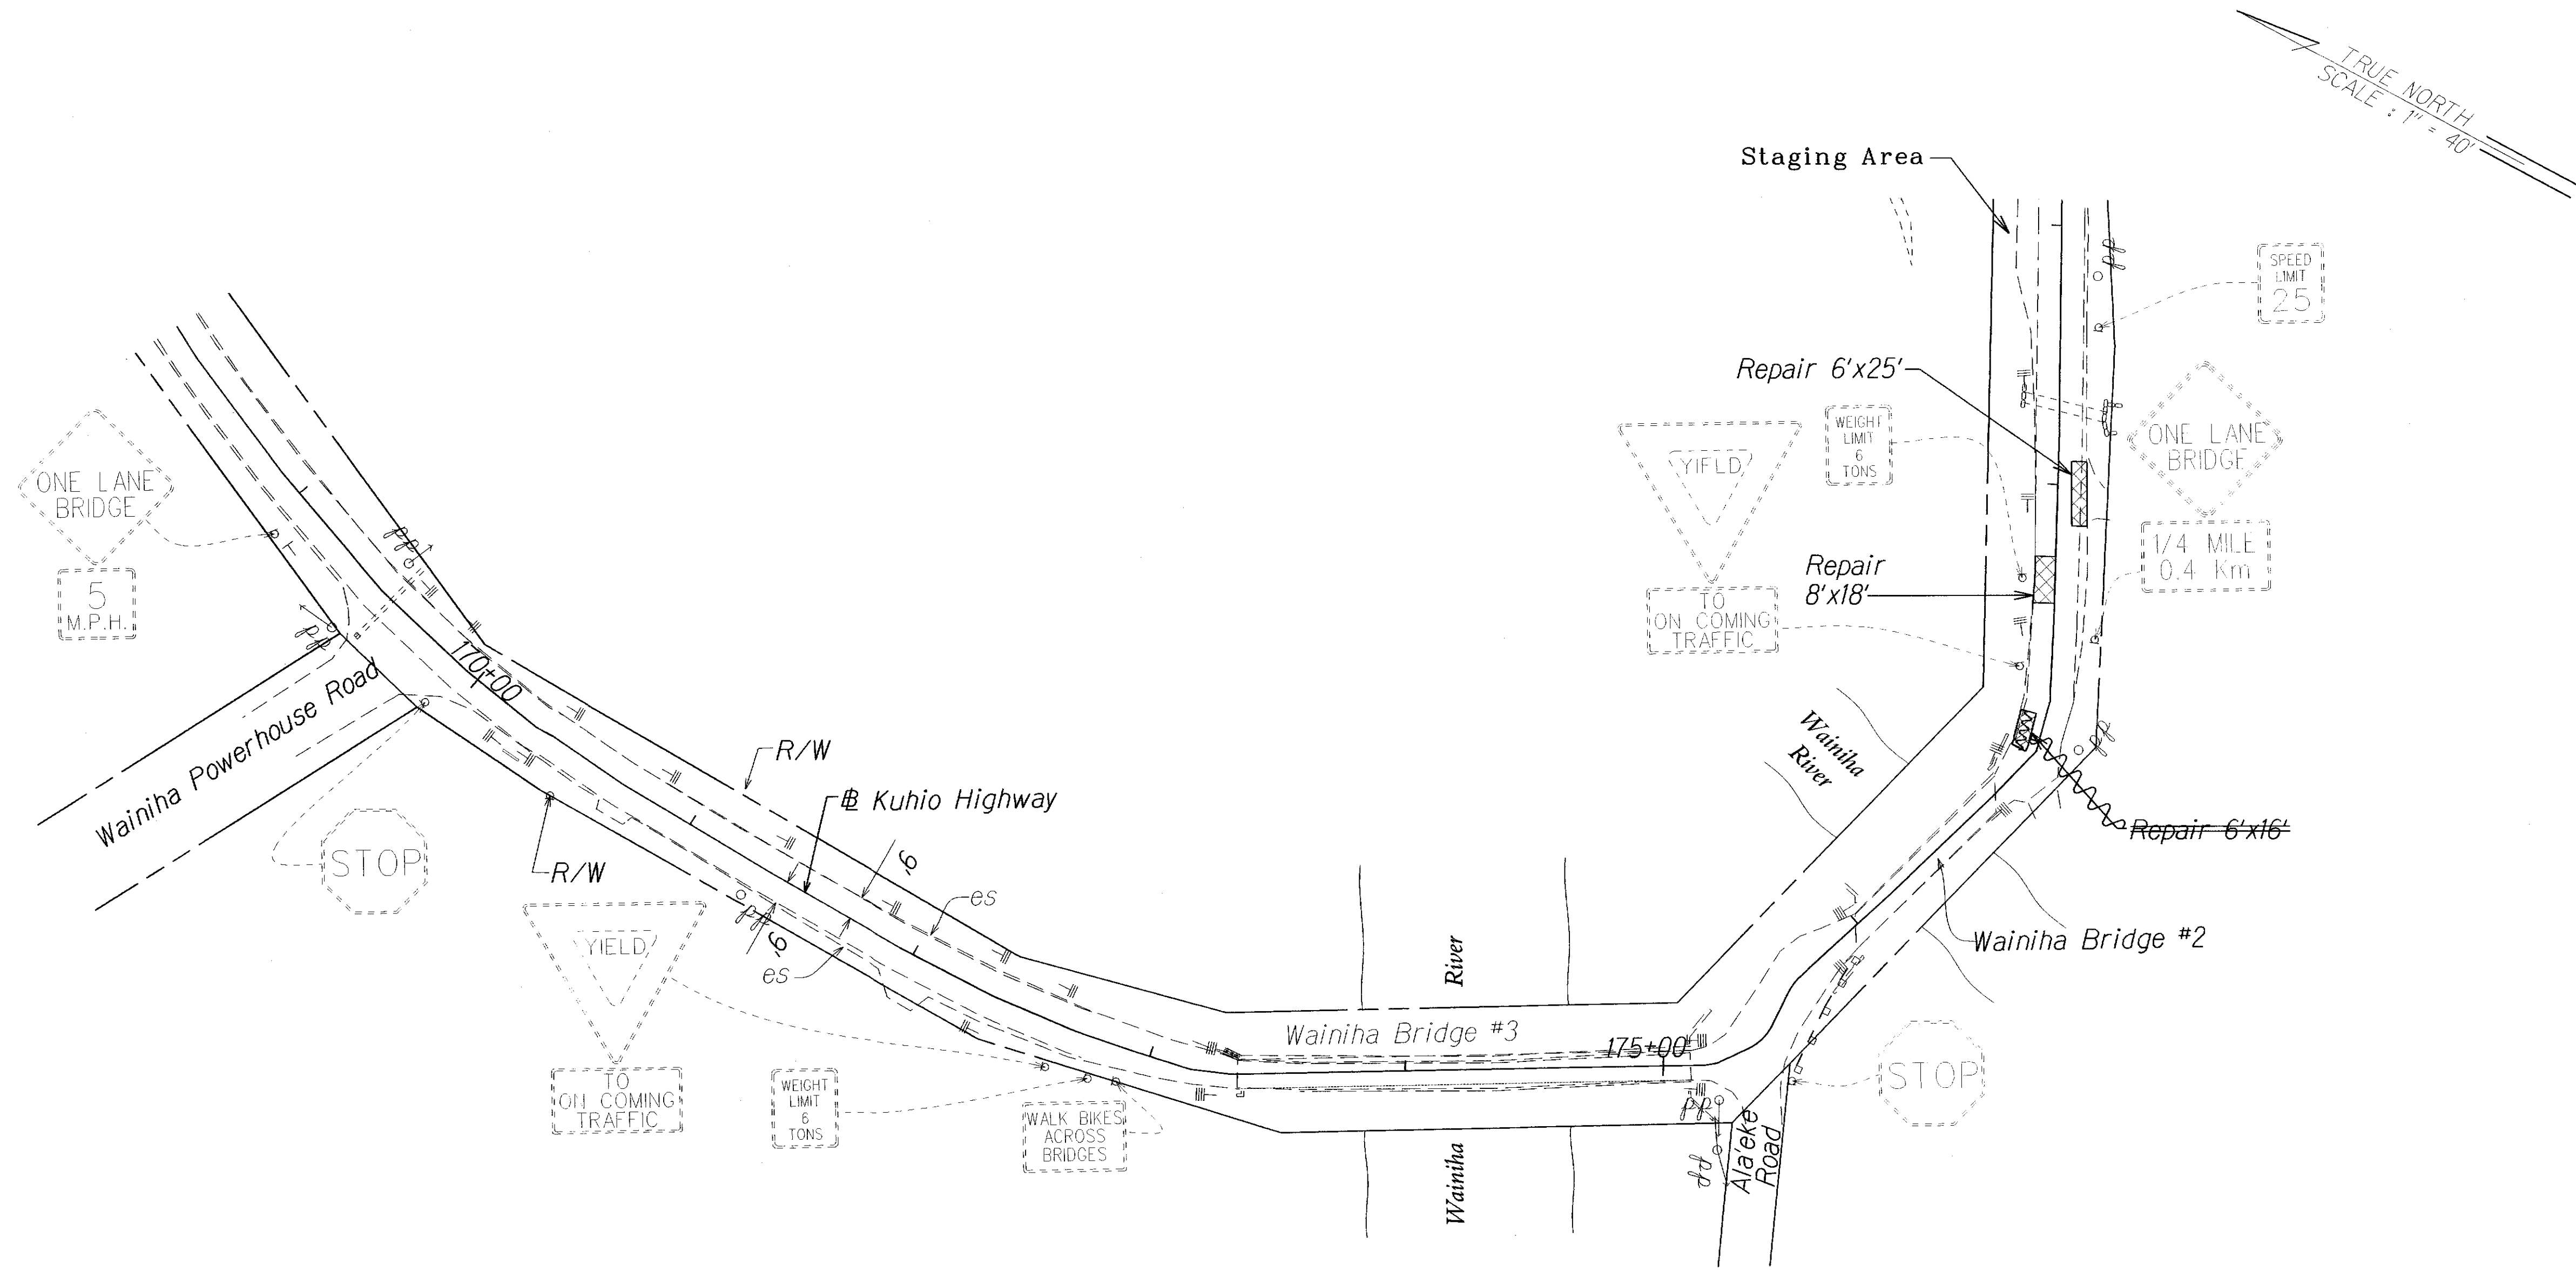

SURVEY PLOTTED BY	DATE
PLAN	
DESIGNED BY	
QUANTITIES BY	
CHECKED BY	

LEGEND FOR AS-BUILT POSTINGS	
	Squiggly line for as-built deletion
	Double line for as-built deletion
Roadway	Text for as-built posting

STATE OF HAWAII
DEPARTMENT OF TRANSPORTATION
HIGHWAYS DIVISION


ROADWAY PLAN
KUHIO HIGHWAY
PAVEMENT REPAIRS
Kee Beach to Hanalei
Project No. 560A-01-10M

Scale: 1"=40'
Date: May 2010

SHEET No. 6 OF 10 SHEETS

"AS-BUILT"

FED. ROAD DIST. NO.	STATE	PROJ. NO.	FISCAL YEAR	SHEET NO.	TOTAL SHEETS
HAWAII	HAW.	560A-01-10M	2010	13	20

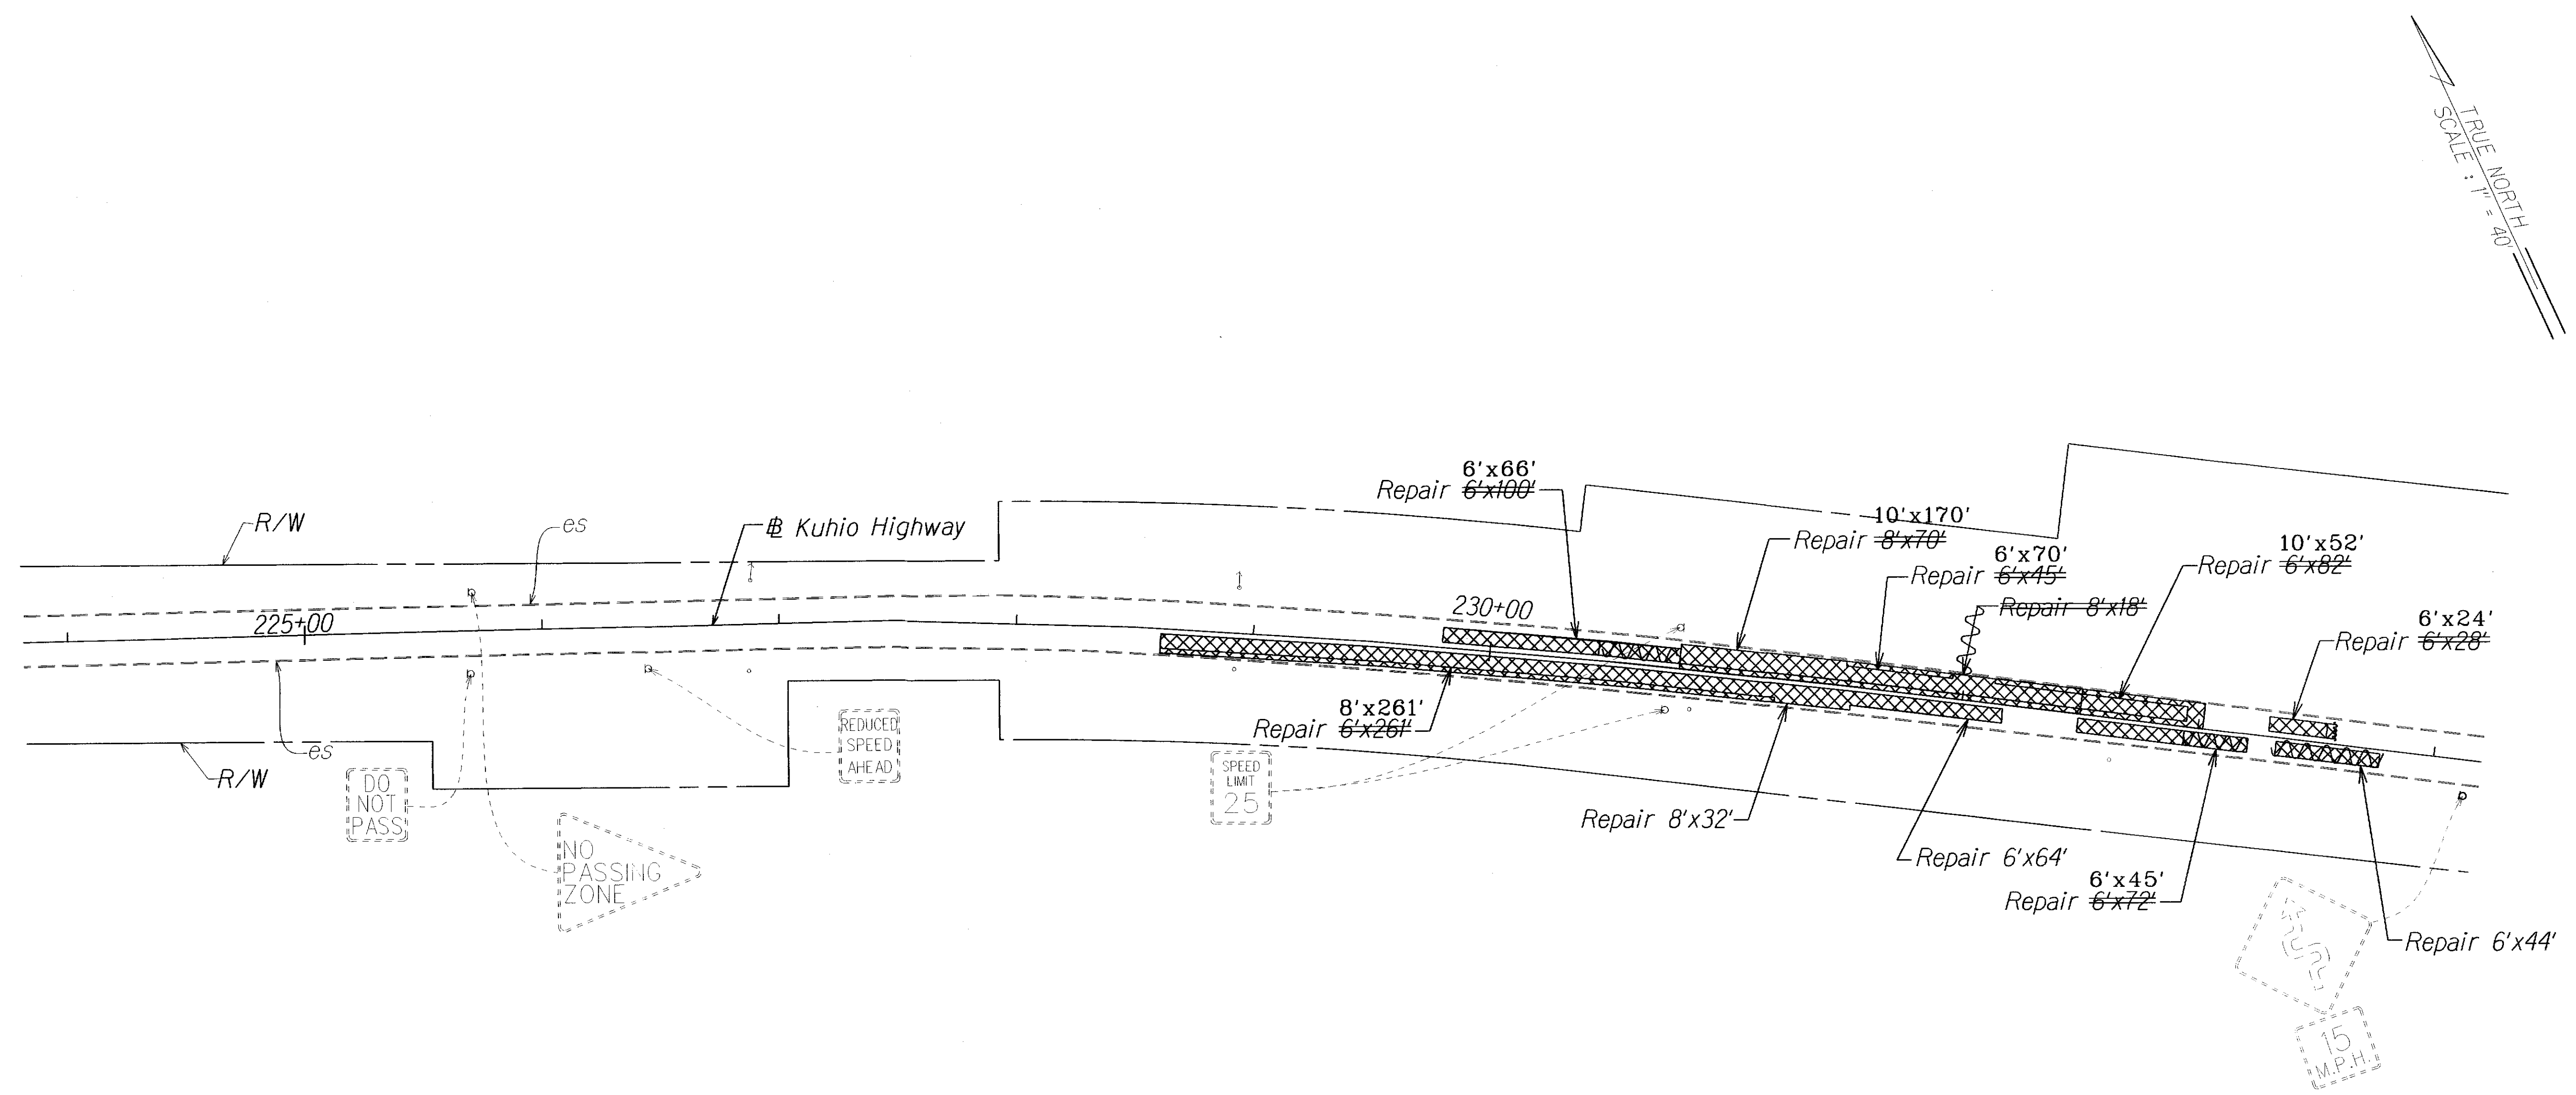

ORIGINAL PLAN	SURVEY PLOTTED BY	DATE
NOTE BOOK	DESIGNED BY	
	QUANTITIES BY	
	CHECKED BY	

LEGEND FOR AS-BUILT POSTINGS	
	Squiggly line for as-built deletion
	Double line for as-built deletion
Roadway	Text for as-built posting

STATE OF HAWAII
DEPARTMENT OF TRANSPORTATION
HIGHWAYS DIVISION

ROADWAY PLAN


KUHIO HIGHWAY
PAVEMENT REPAIRS
Kee Beach to Hanalei
Project No. 560A-01-10M

Scale: 1"=40' Date: May 2010

SHEET No. 7 OF 10 SHEETS

"AS-BUILT"

FED. ROAD DIST. NO.	STATE	PROJ. NO.	FISCAL YEAR	SHEET NO.	TOTAL SHEETS
HAWAII	HAW.	560A-01-10M	2010	14	20

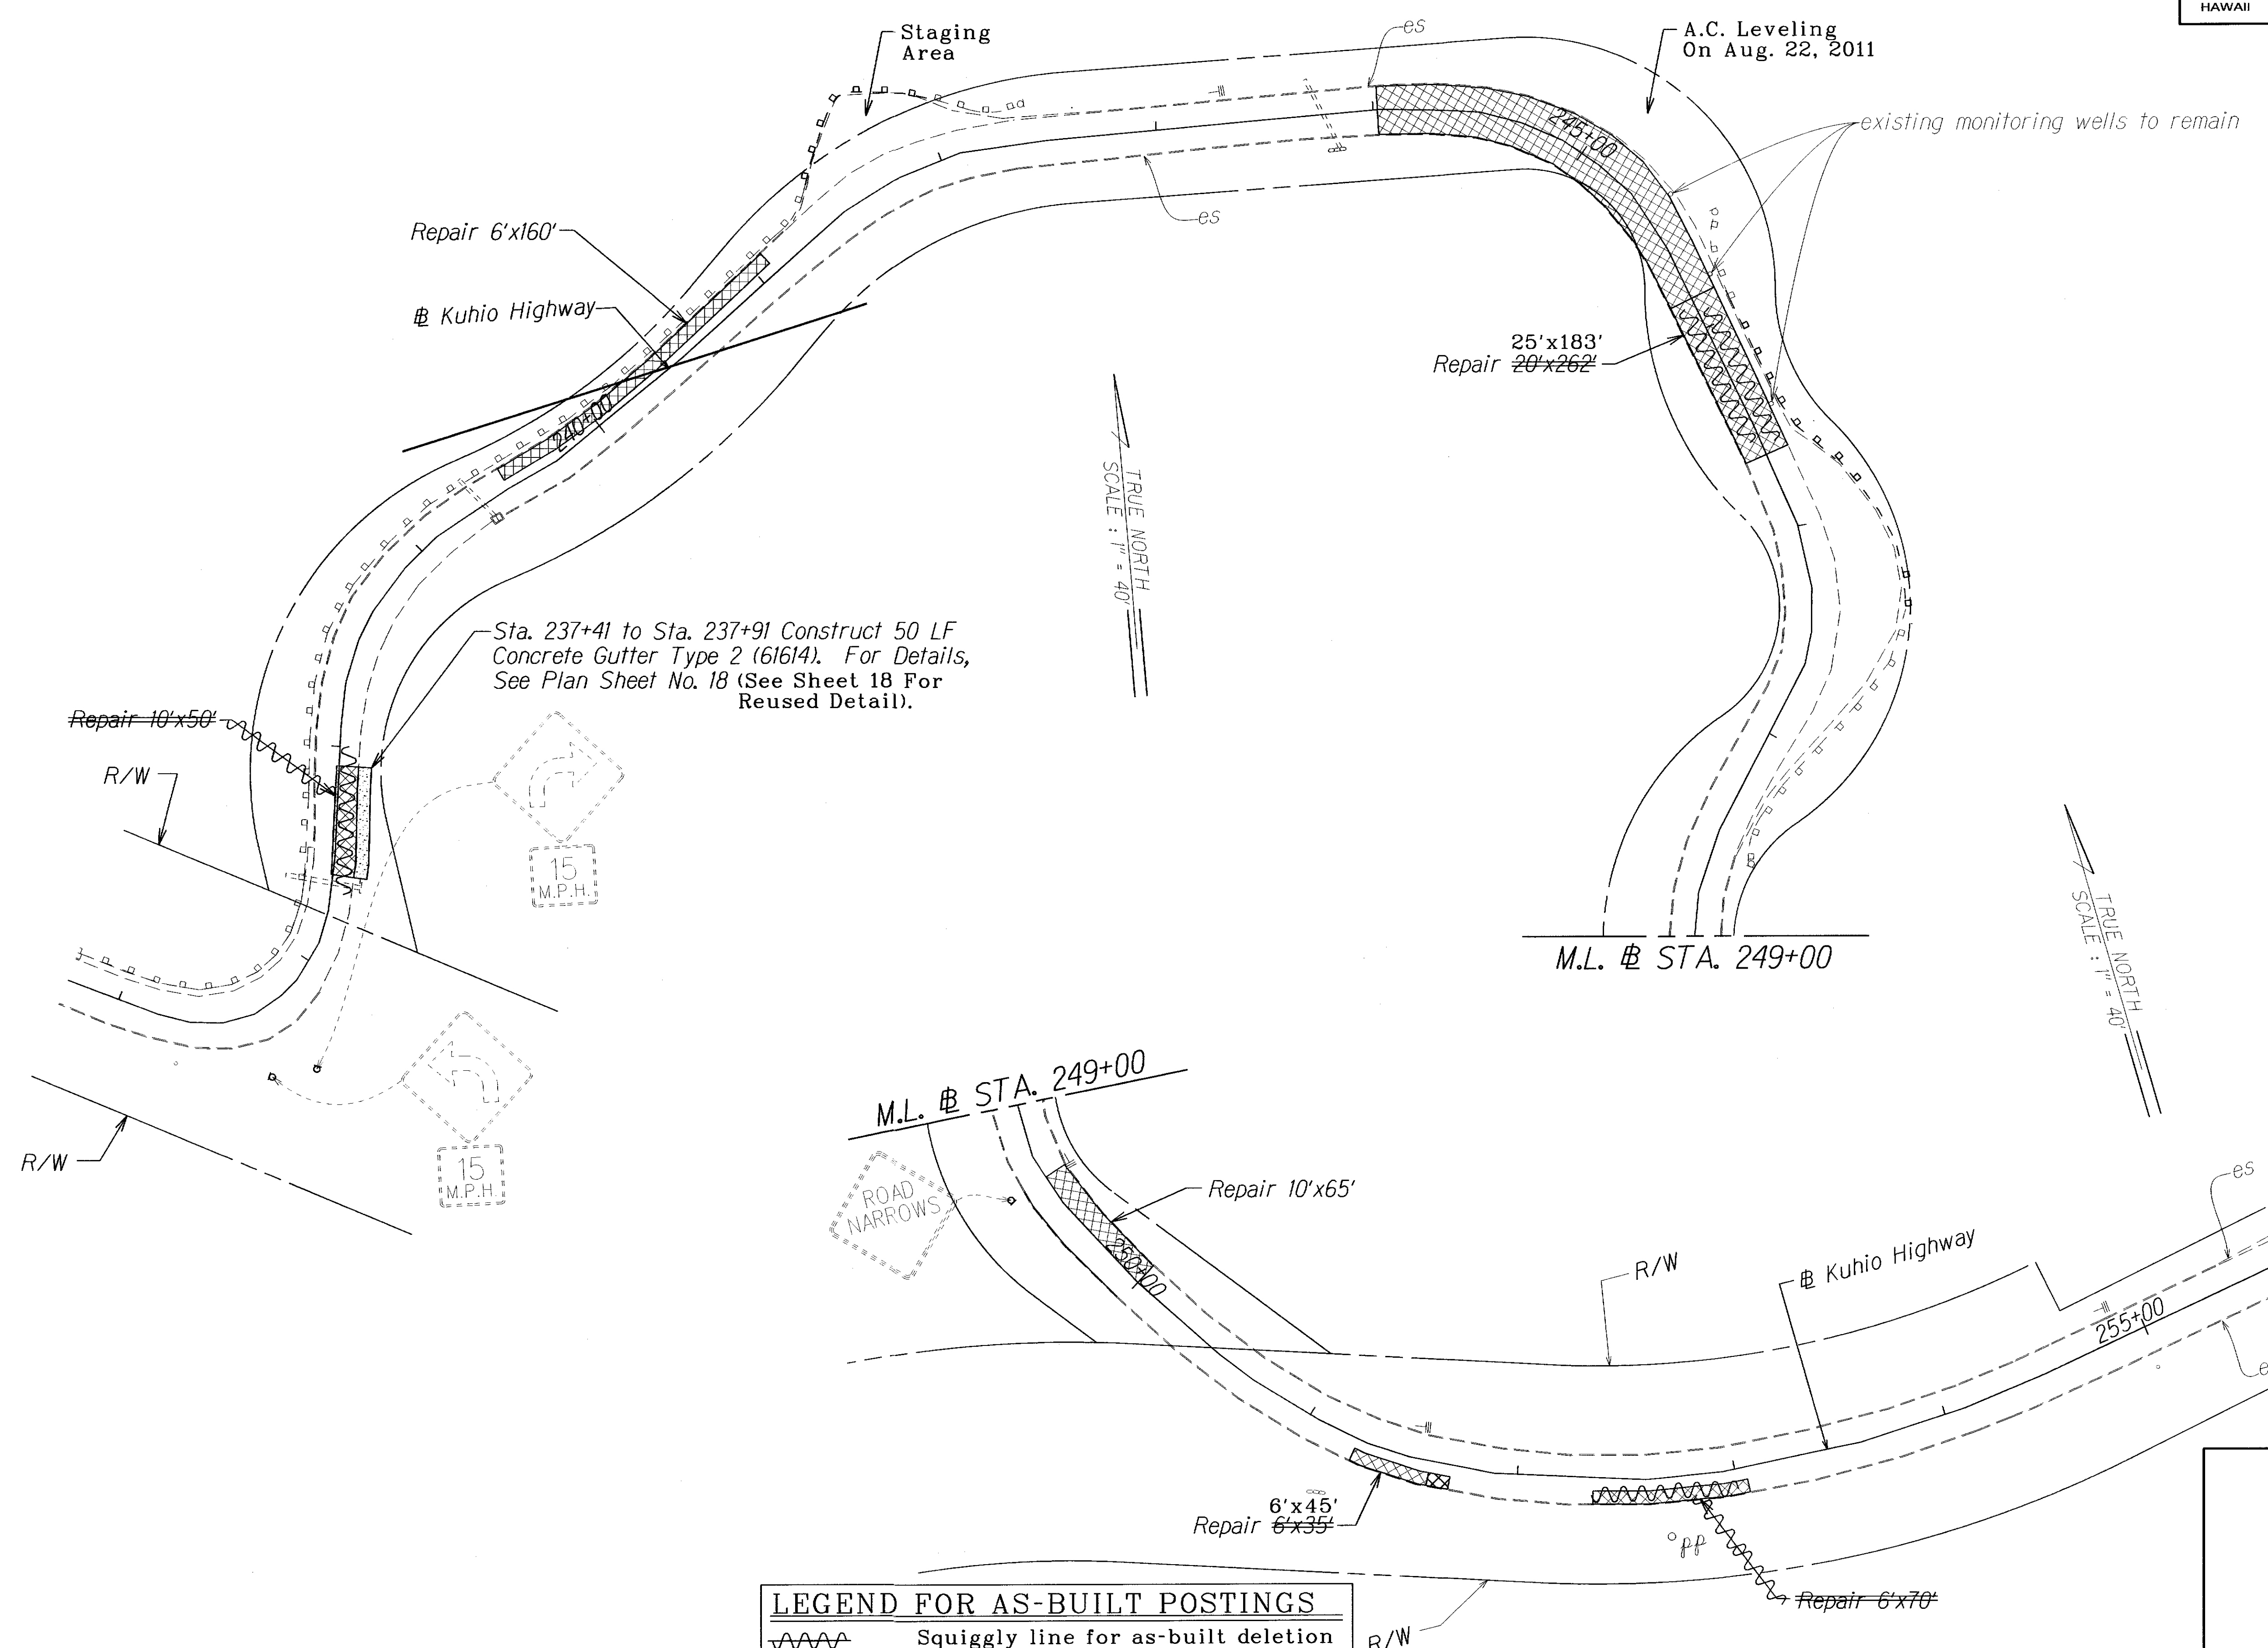

SURVEY PLOTTED BY	DATE
DESIGNED BY	
TRACED BY	
NOTE BOOK	
DESIGNED BY	
QUANTITIES BY	
CHECKED BY	

LEGEND FOR AS-BUILT POSTINGS	
	Squiggly line for as-built deletion
	Double line for as-built deletion
Roadway	Text for as-built posting

STATE OF HAWAII
DEPARTMENT OF TRANSPORTATION
HIGHWAYS DIVISION

ROADWAY PLAN


KUHIO HIGHWAY
PAVEMENT REPAIRS
Kee Beach to Hanalei
Project No. 560A-01-10M

Scale: 1"=40' Date: May 2010

SHEET No. 8 OF 10 SHEETS

"AS-BUILT"

FED. ROAD DIST. NO.	STATE	PROJ. NO.	FISCAL YEAR	SHEET NO.	TOTAL SHEETS
HAWAII	HAW.	560A-01-10M	2010	15	20

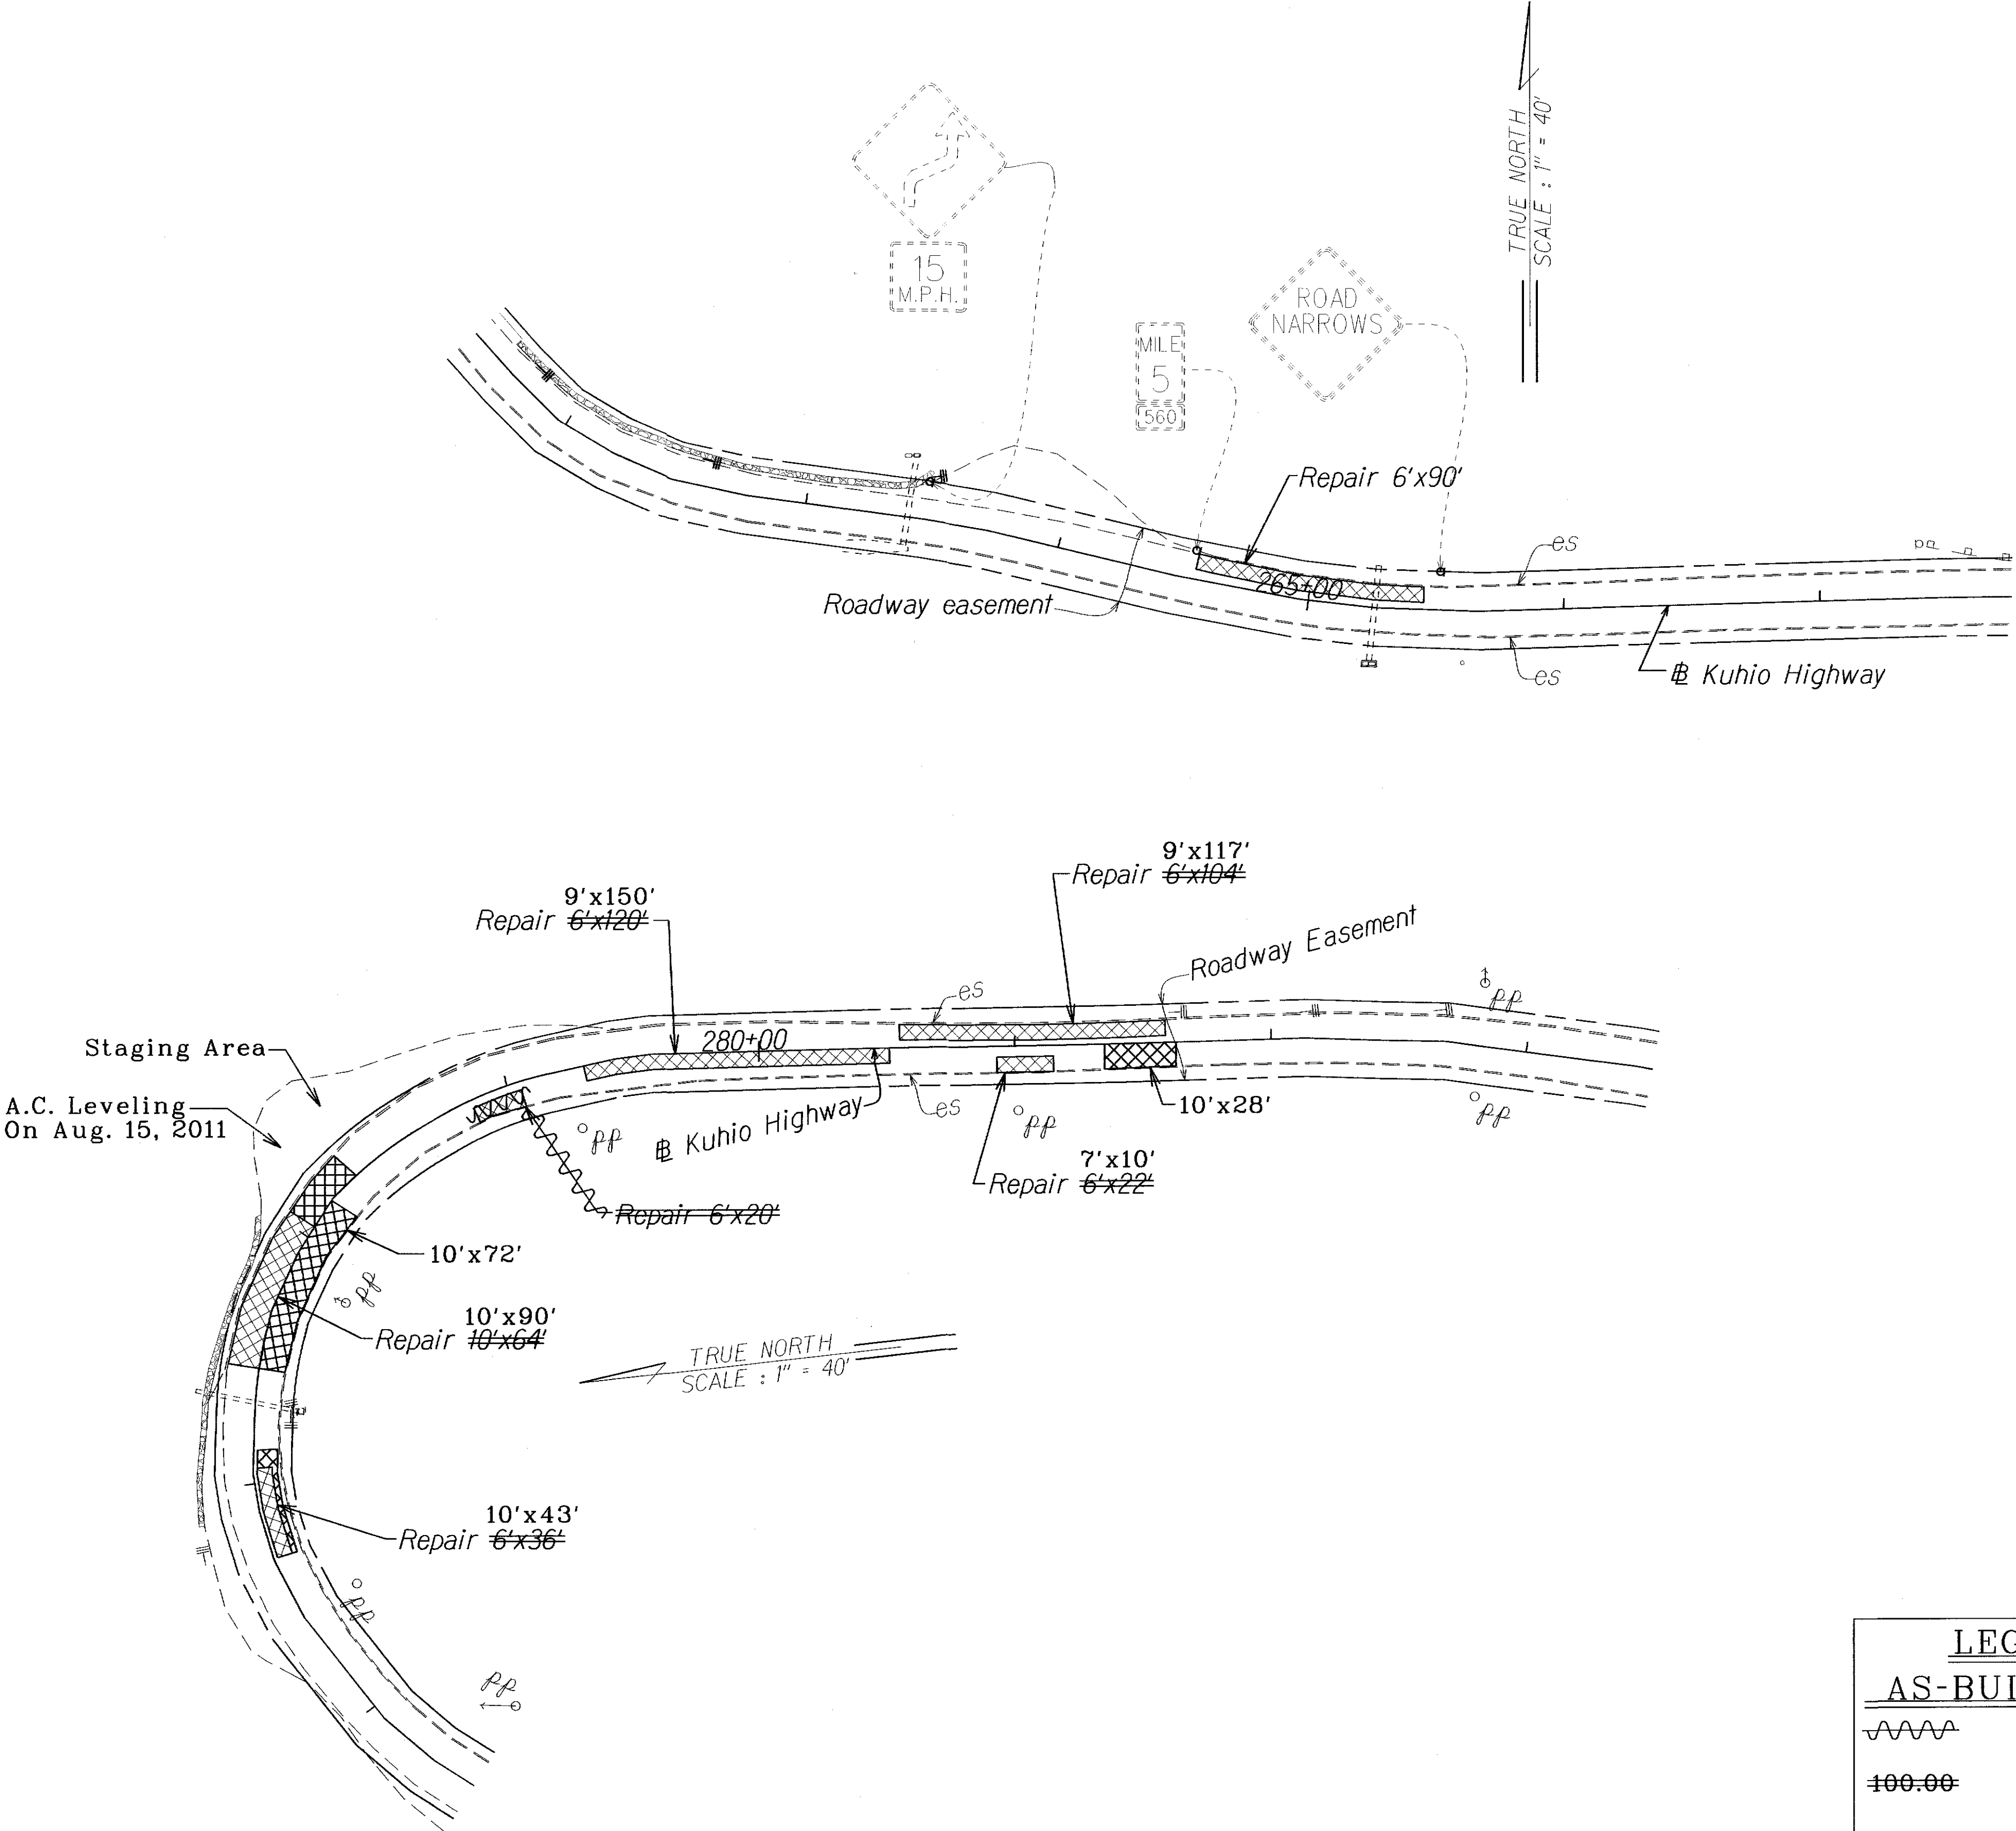

ORIGINAL PLAN	DATE
DESIGNED BY	10/1/10
CHECKED BY	10/1/10
NOTED BY	10/1/10
QUANTITIES BY	10/1/10
CHECKED BY	10/1/10

LEGEND FOR AS-BUILT POSTINGS	
	Squiggly line for as-built deletion
	Double line for as-built deletion
Roadway	Text for as-built posting




STATE OF HAWAII
DEPARTMENT OF TRANSPORTATION
HIGHWAYS DIVISION

ROADWAY PLAN
KUHIO HIGHWAY
PAVEMENT REPAIRS
Kee Beach to Hanalei
Project No. 560A-01-10M

Scale: 1"=40'
Date: May 2010

SHEET No. 9 OF 10 SHEETS

FED. ROAD DIST. NO.	STATE	PROJ. NO.	FISCAL YEAR	SHEET NO.	TOTAL SHEETS
HAWAII	HAW.	560A-01-10M	2010	16	20

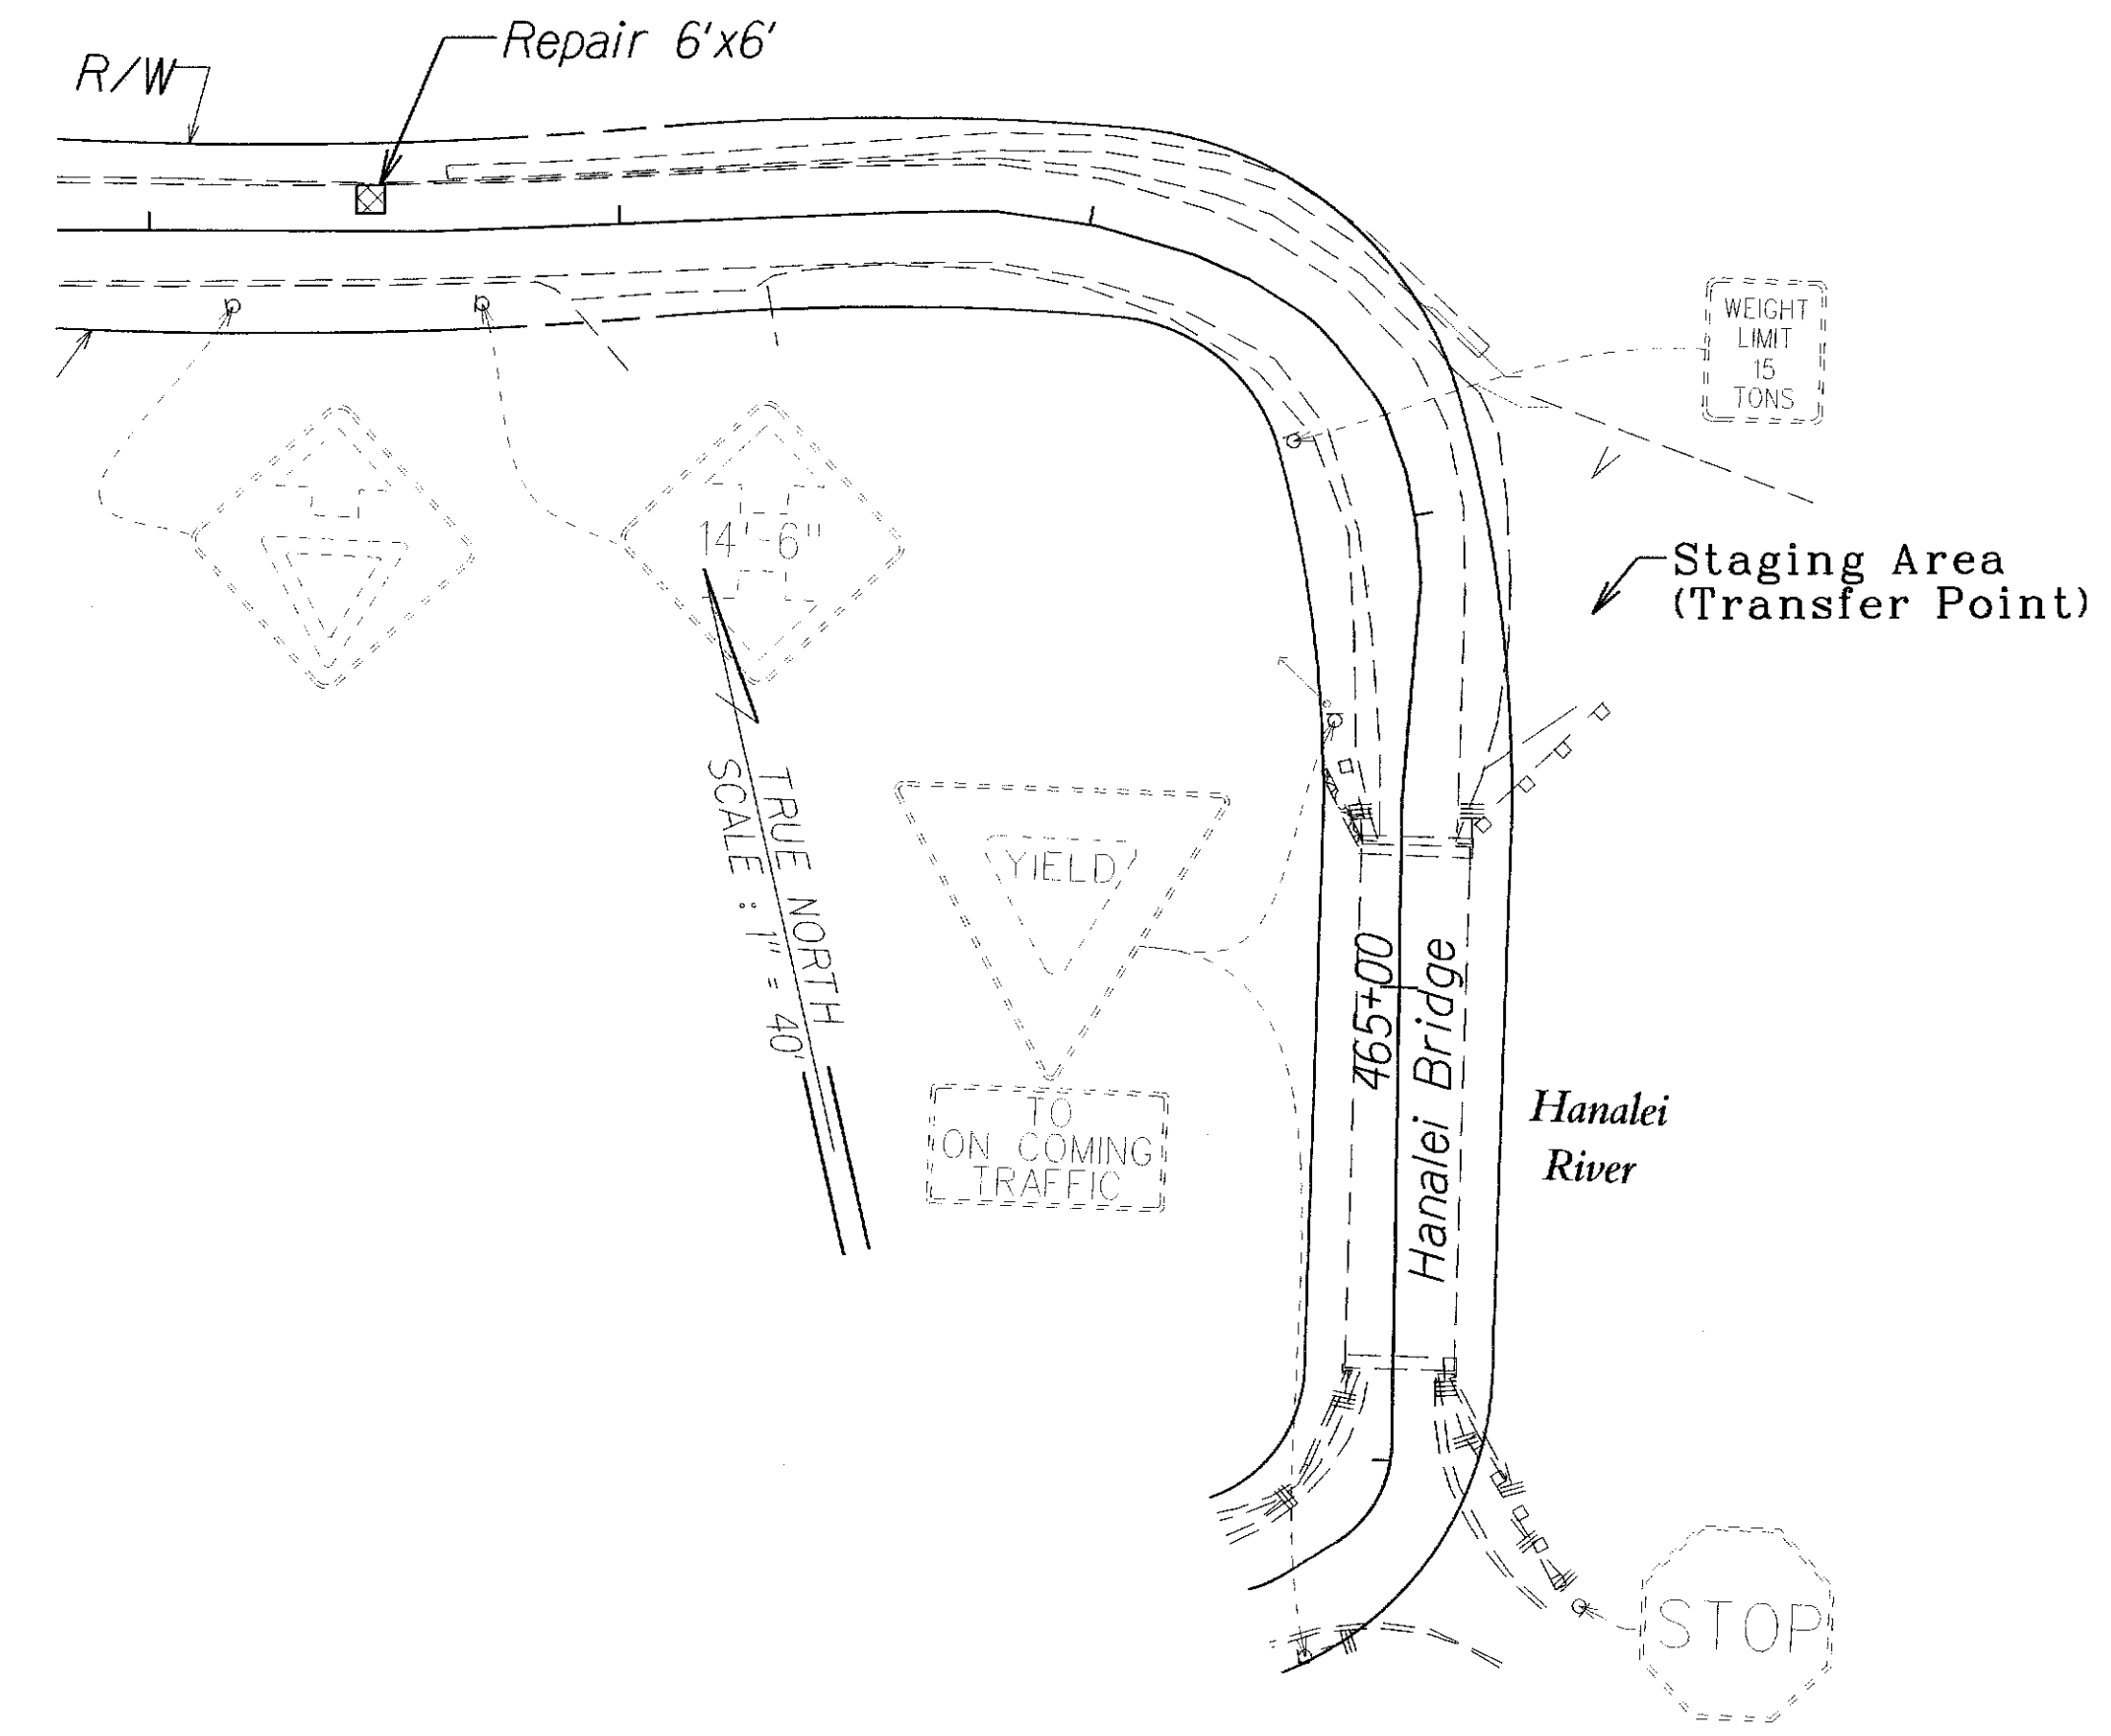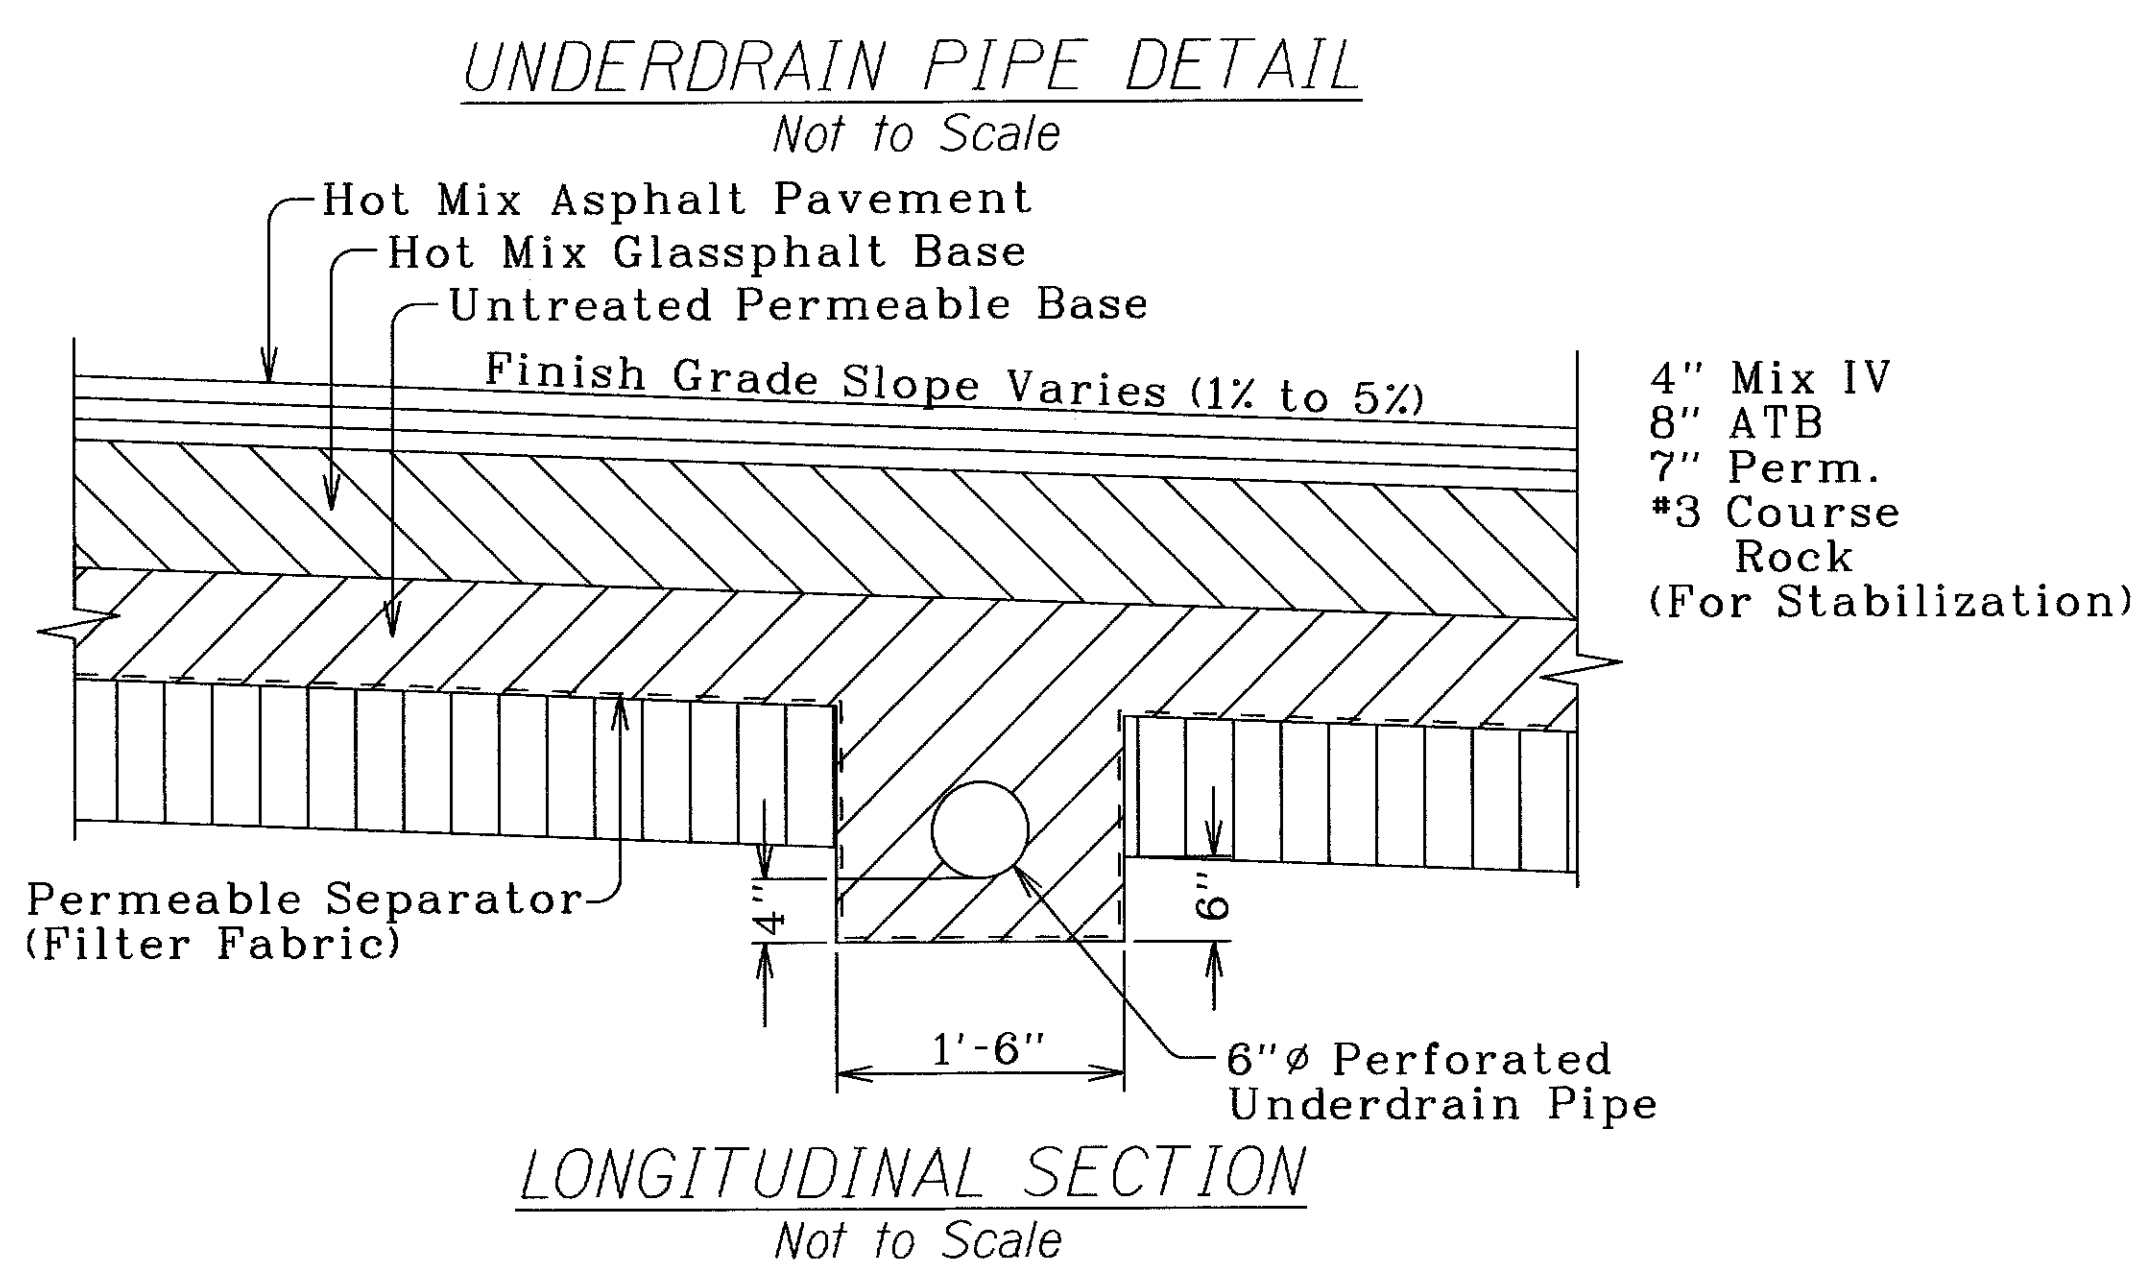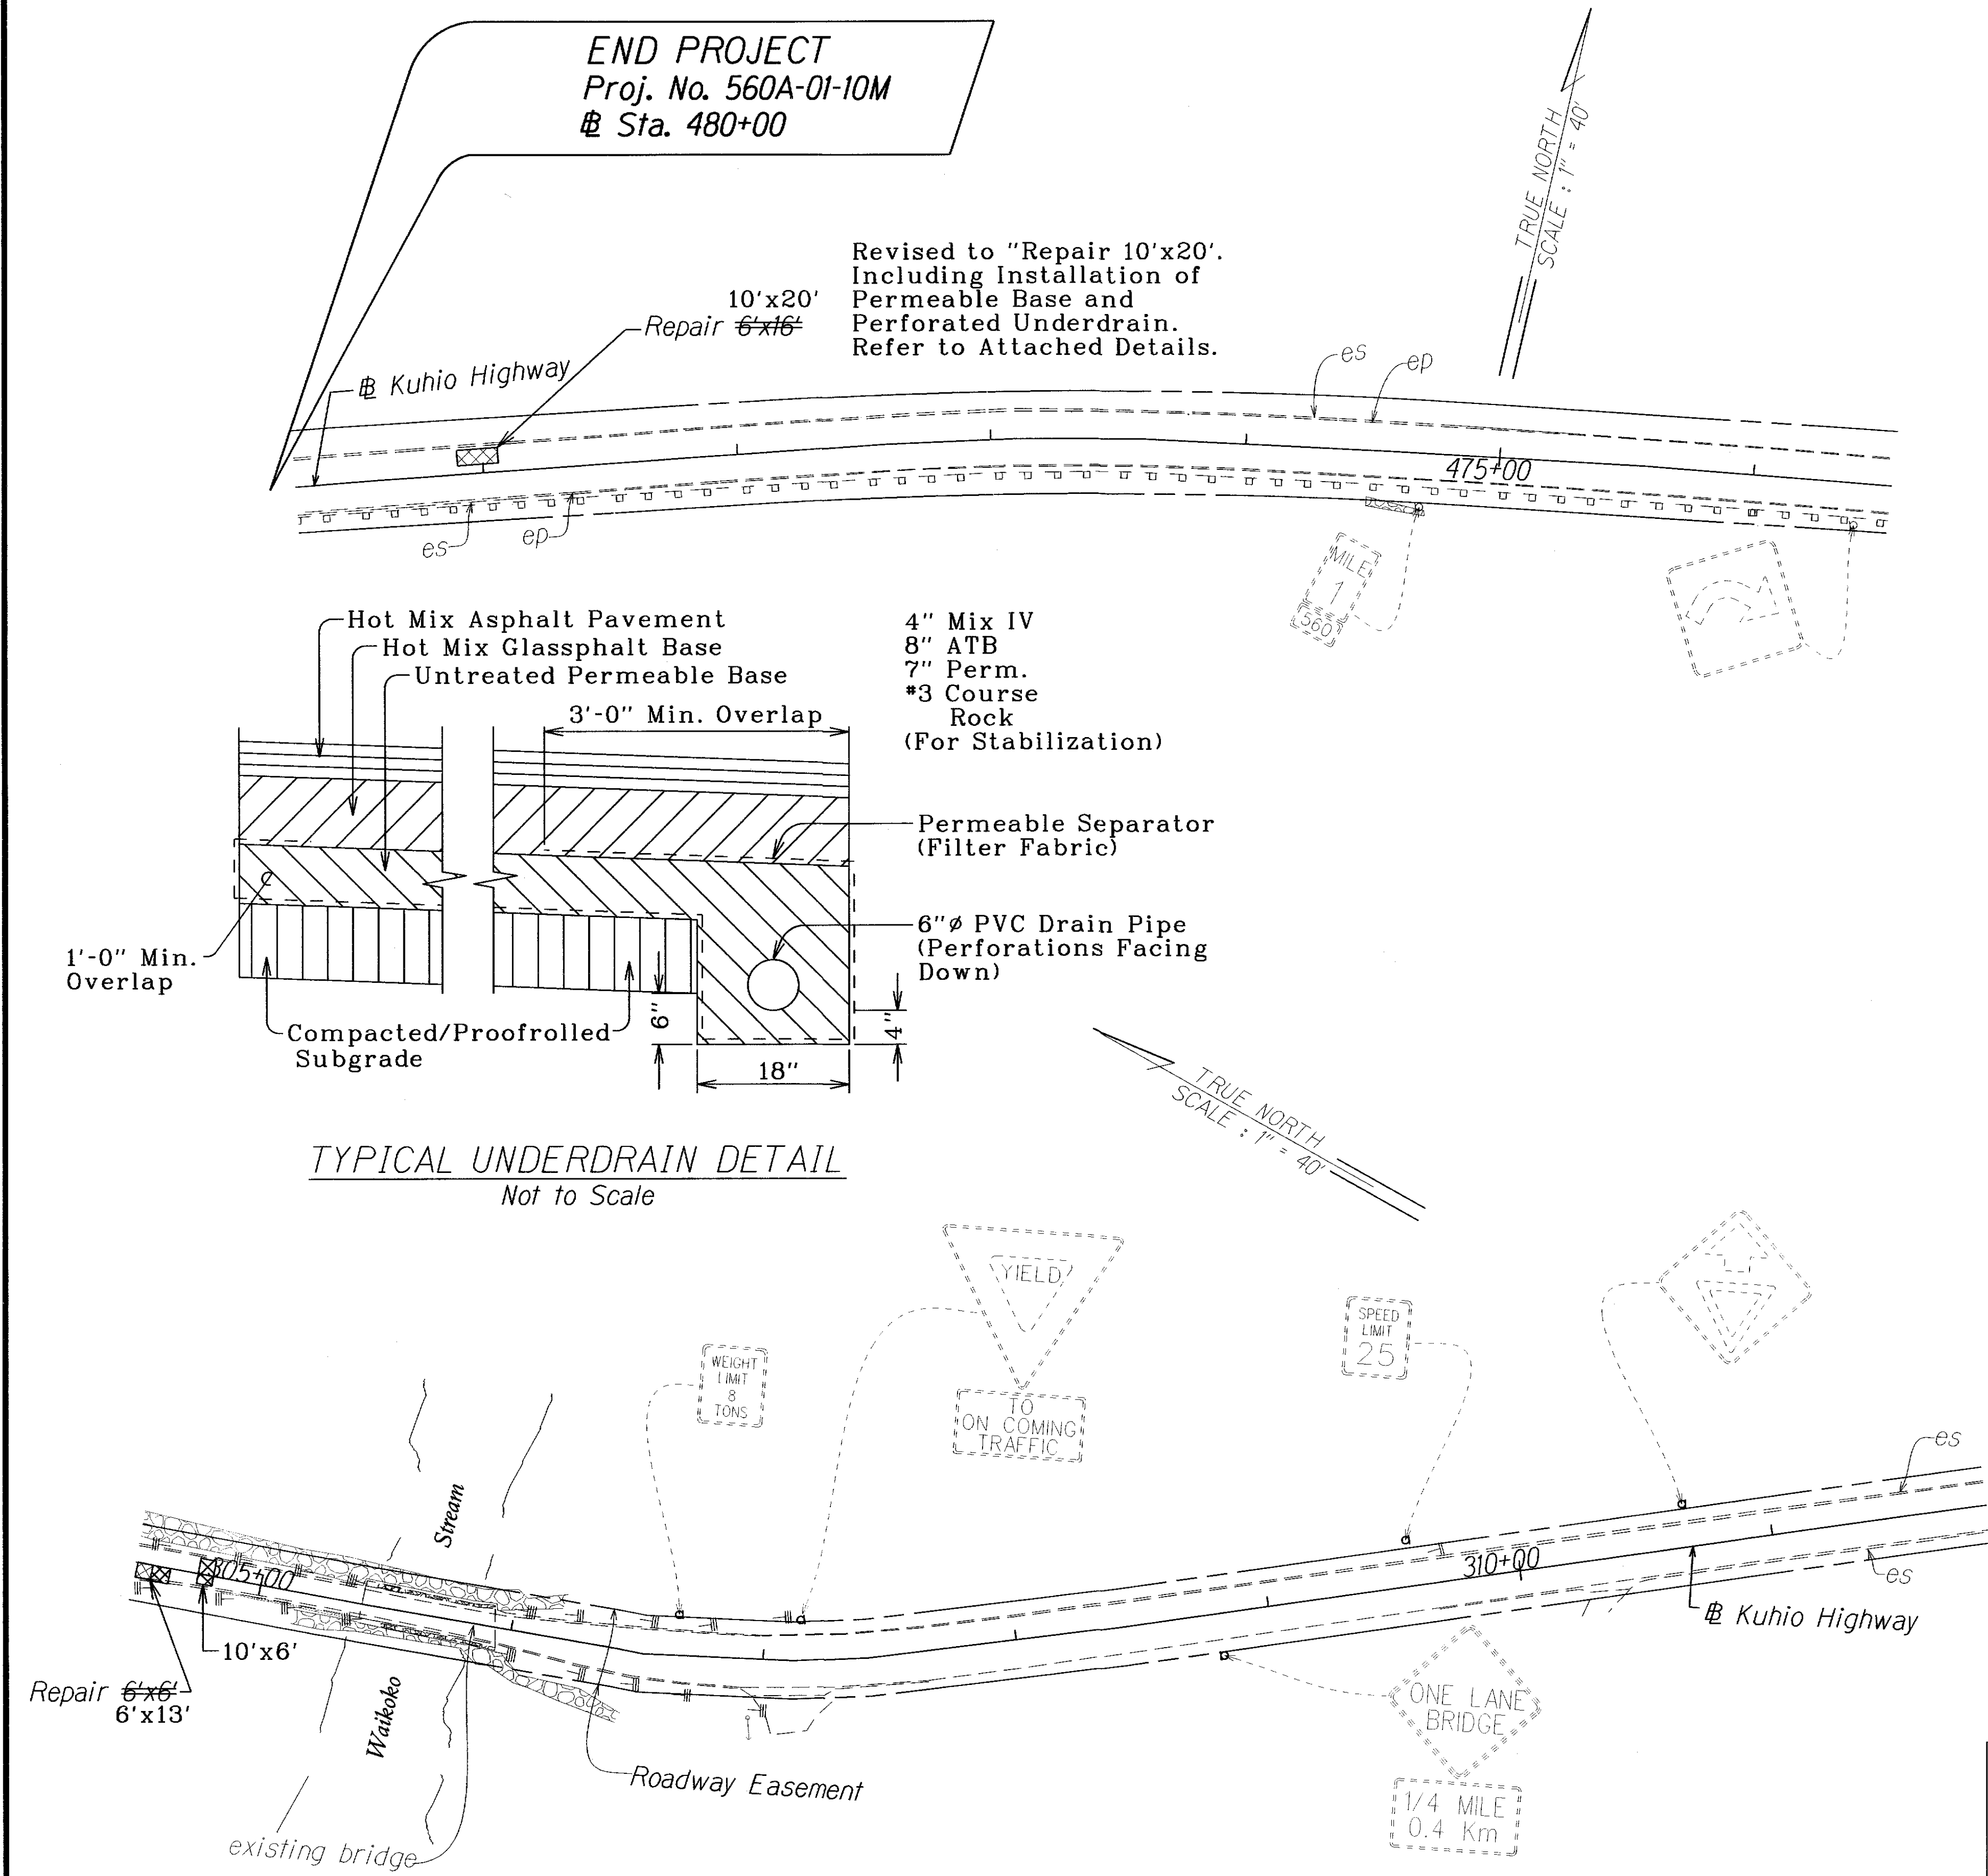


LEGEND FOR AS-BUILT POSTINGS	
	Squiggly line for as-built deletion
	Double line for as-built deletion
Roadway	Text for as-built posting

STATE OF HAWAII
DEPARTMENT OF TRANSPORTATION
HIGHWAYS DIVISION
ROADWAY PLAN
KUHIO HIGHWAY
PAVEMENT REPAIRS
Kee Beach to Hanalei
Project No. 560A-01-10M

Scale: 1"=40'
Date: May 2010
SHEET No. 10 OF 10 SHEETS

FED. ROAD DIST. NO.	STATE	PROJ. NO.	FISCAL YEAR	SHEET NO.	TOTAL SHEETS
HAWAII	HAW.	560A-01-10M	2010	ADD. 16	20

SCALE: 1"=40'
TRUE NORTH

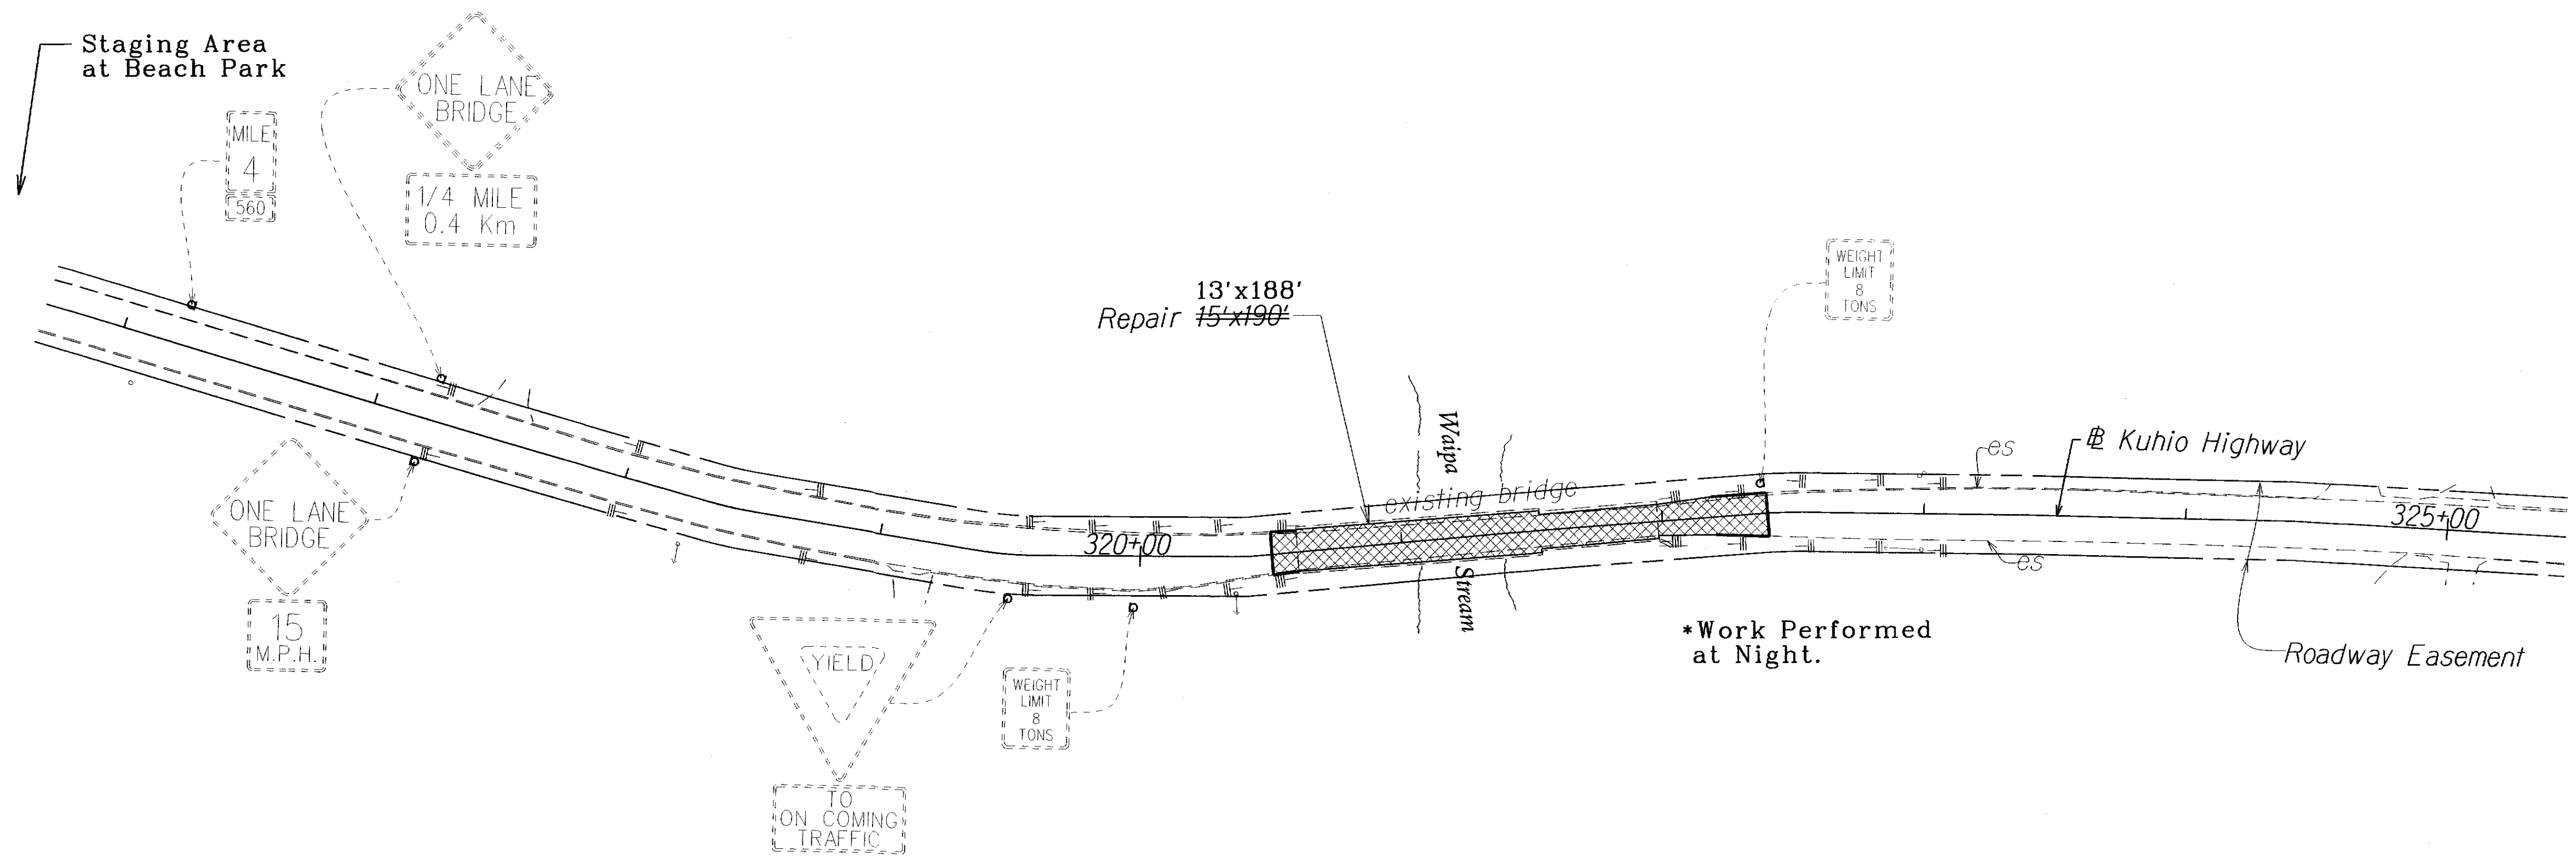

NOTES:

1. See General Note 9. on Plan Sheet 3 for working hours restrictions at this location.
2. See Pavement Repair Detail on Plan Sheet ADD. 6 for work at existing deck drains.

LEGEND FOR AS-BUILT POSTINGS

- Squiggly line for as-built deletion
- Double line for as-built deletion
- Roadway Text for as-built posting

5/24/10	New Roadway Plan Sheet
DATE	REVISION
STATE OF HAWAII DEPARTMENT OF TRANSPORTATION HIGHWAYS DIVISION	
ROADWAY PLAN	
KUHIOW HIGHWAY	
PAVEMENT REPAIRS	
Kee Beach to Hanalei	
Project No. 560A-01-10M	
Scale: 1"=40'	Date: May 2010
SHEET No.	OF SHEETS

"AS-BUILT"

ADD. 16

ORIGINAL PLAN	SURVEY PLOTTED BY	DATE
NOTE BOOK	DESIGNED BY	
ADD. 16	QUANTITIES BY	
	CHECKED BY	