
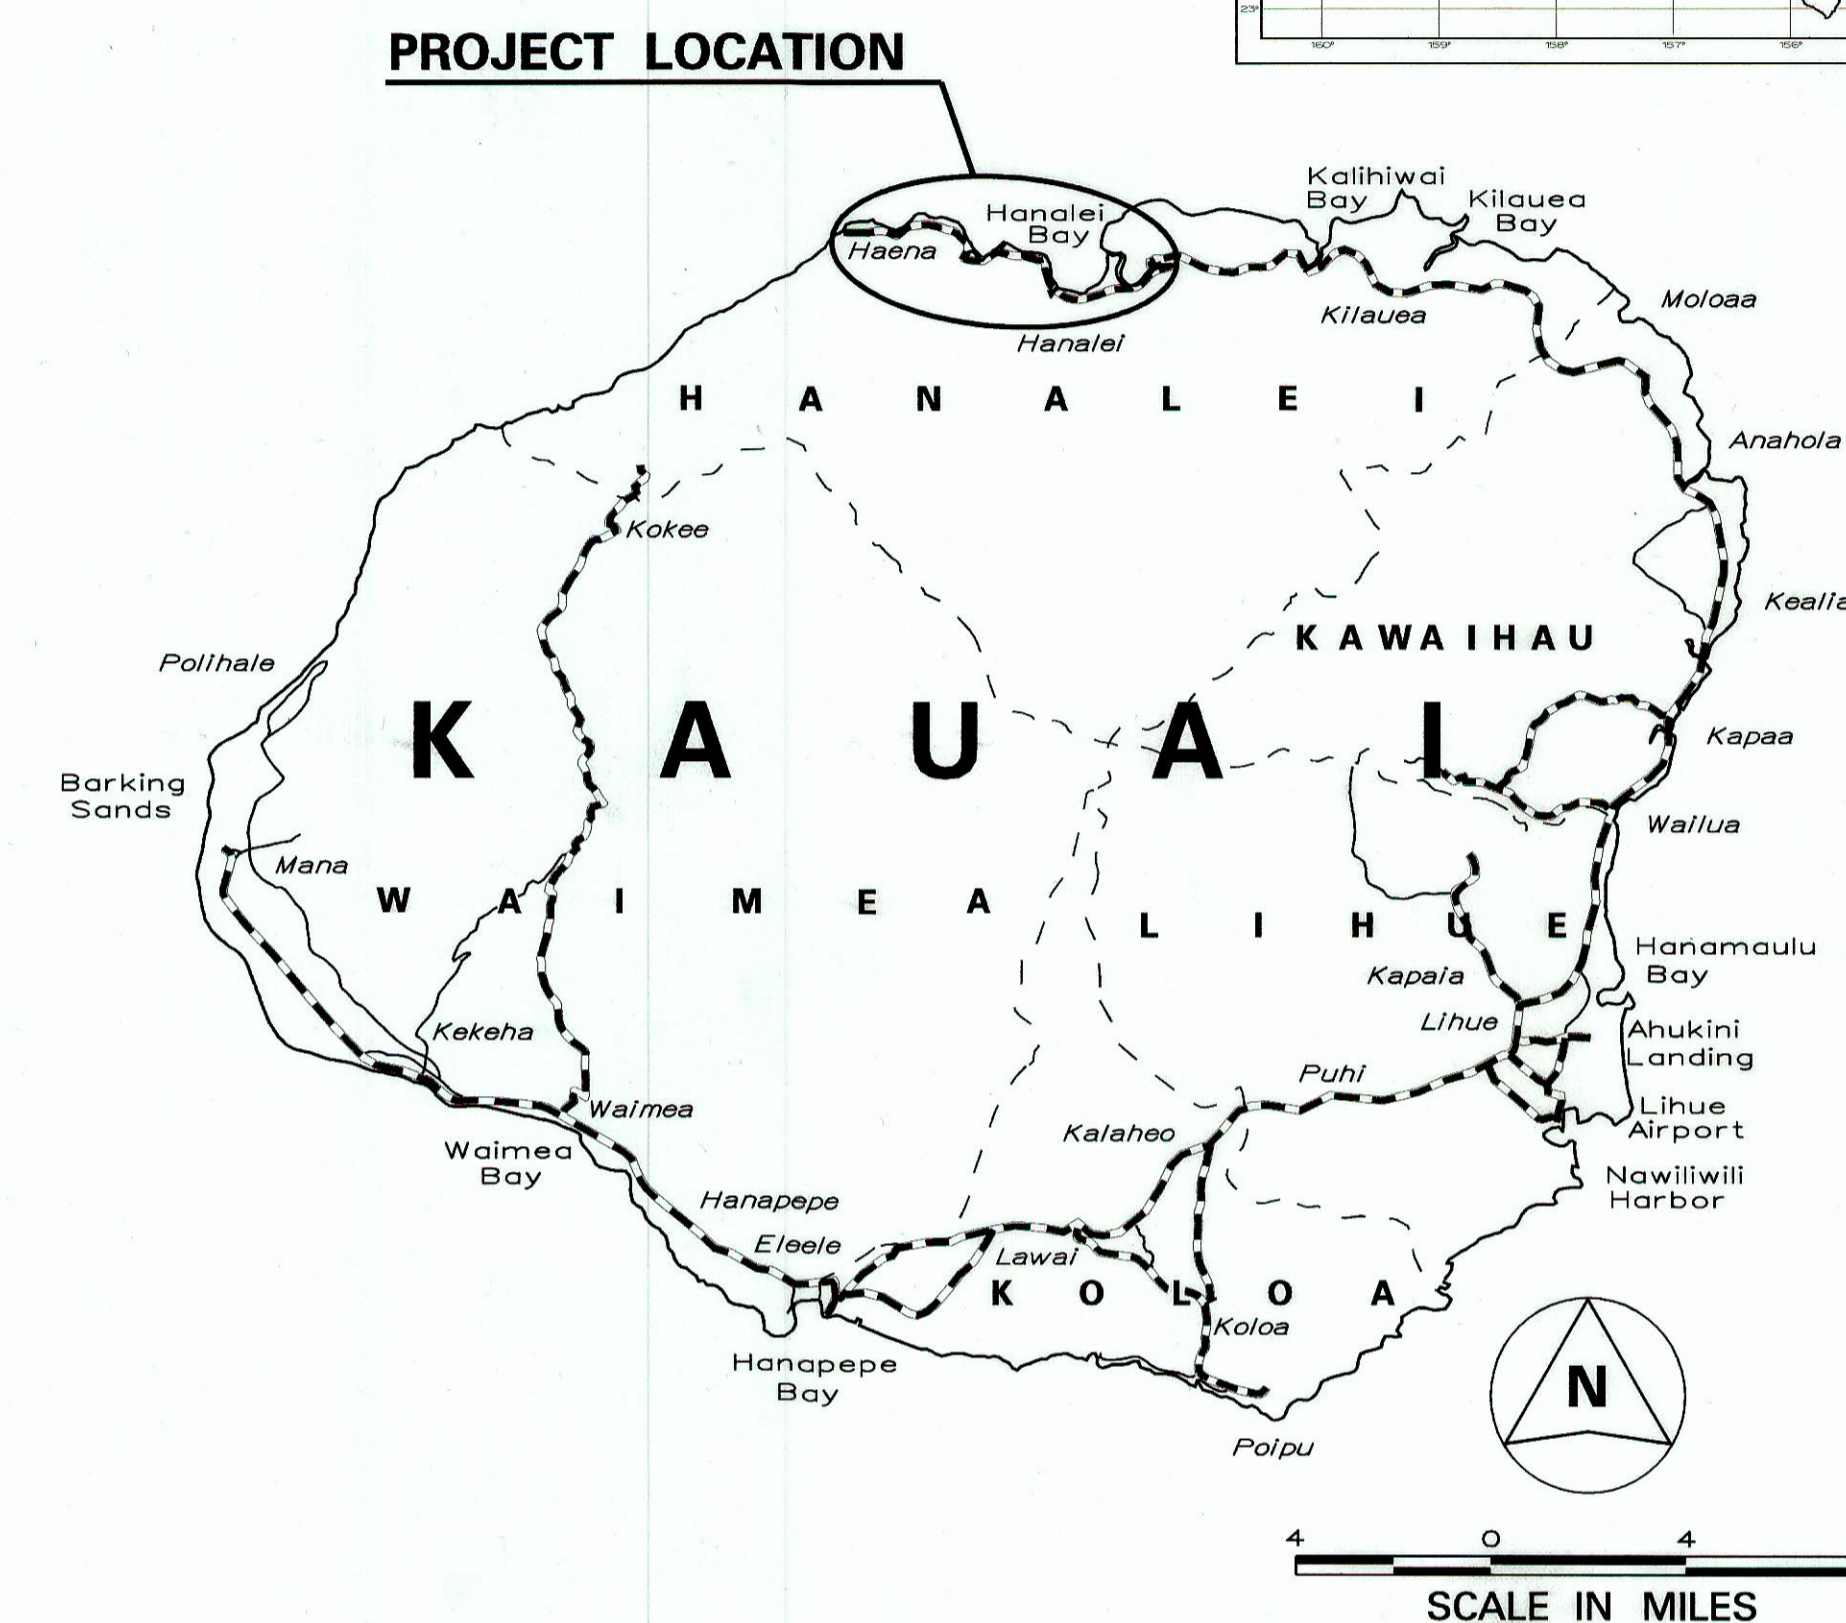
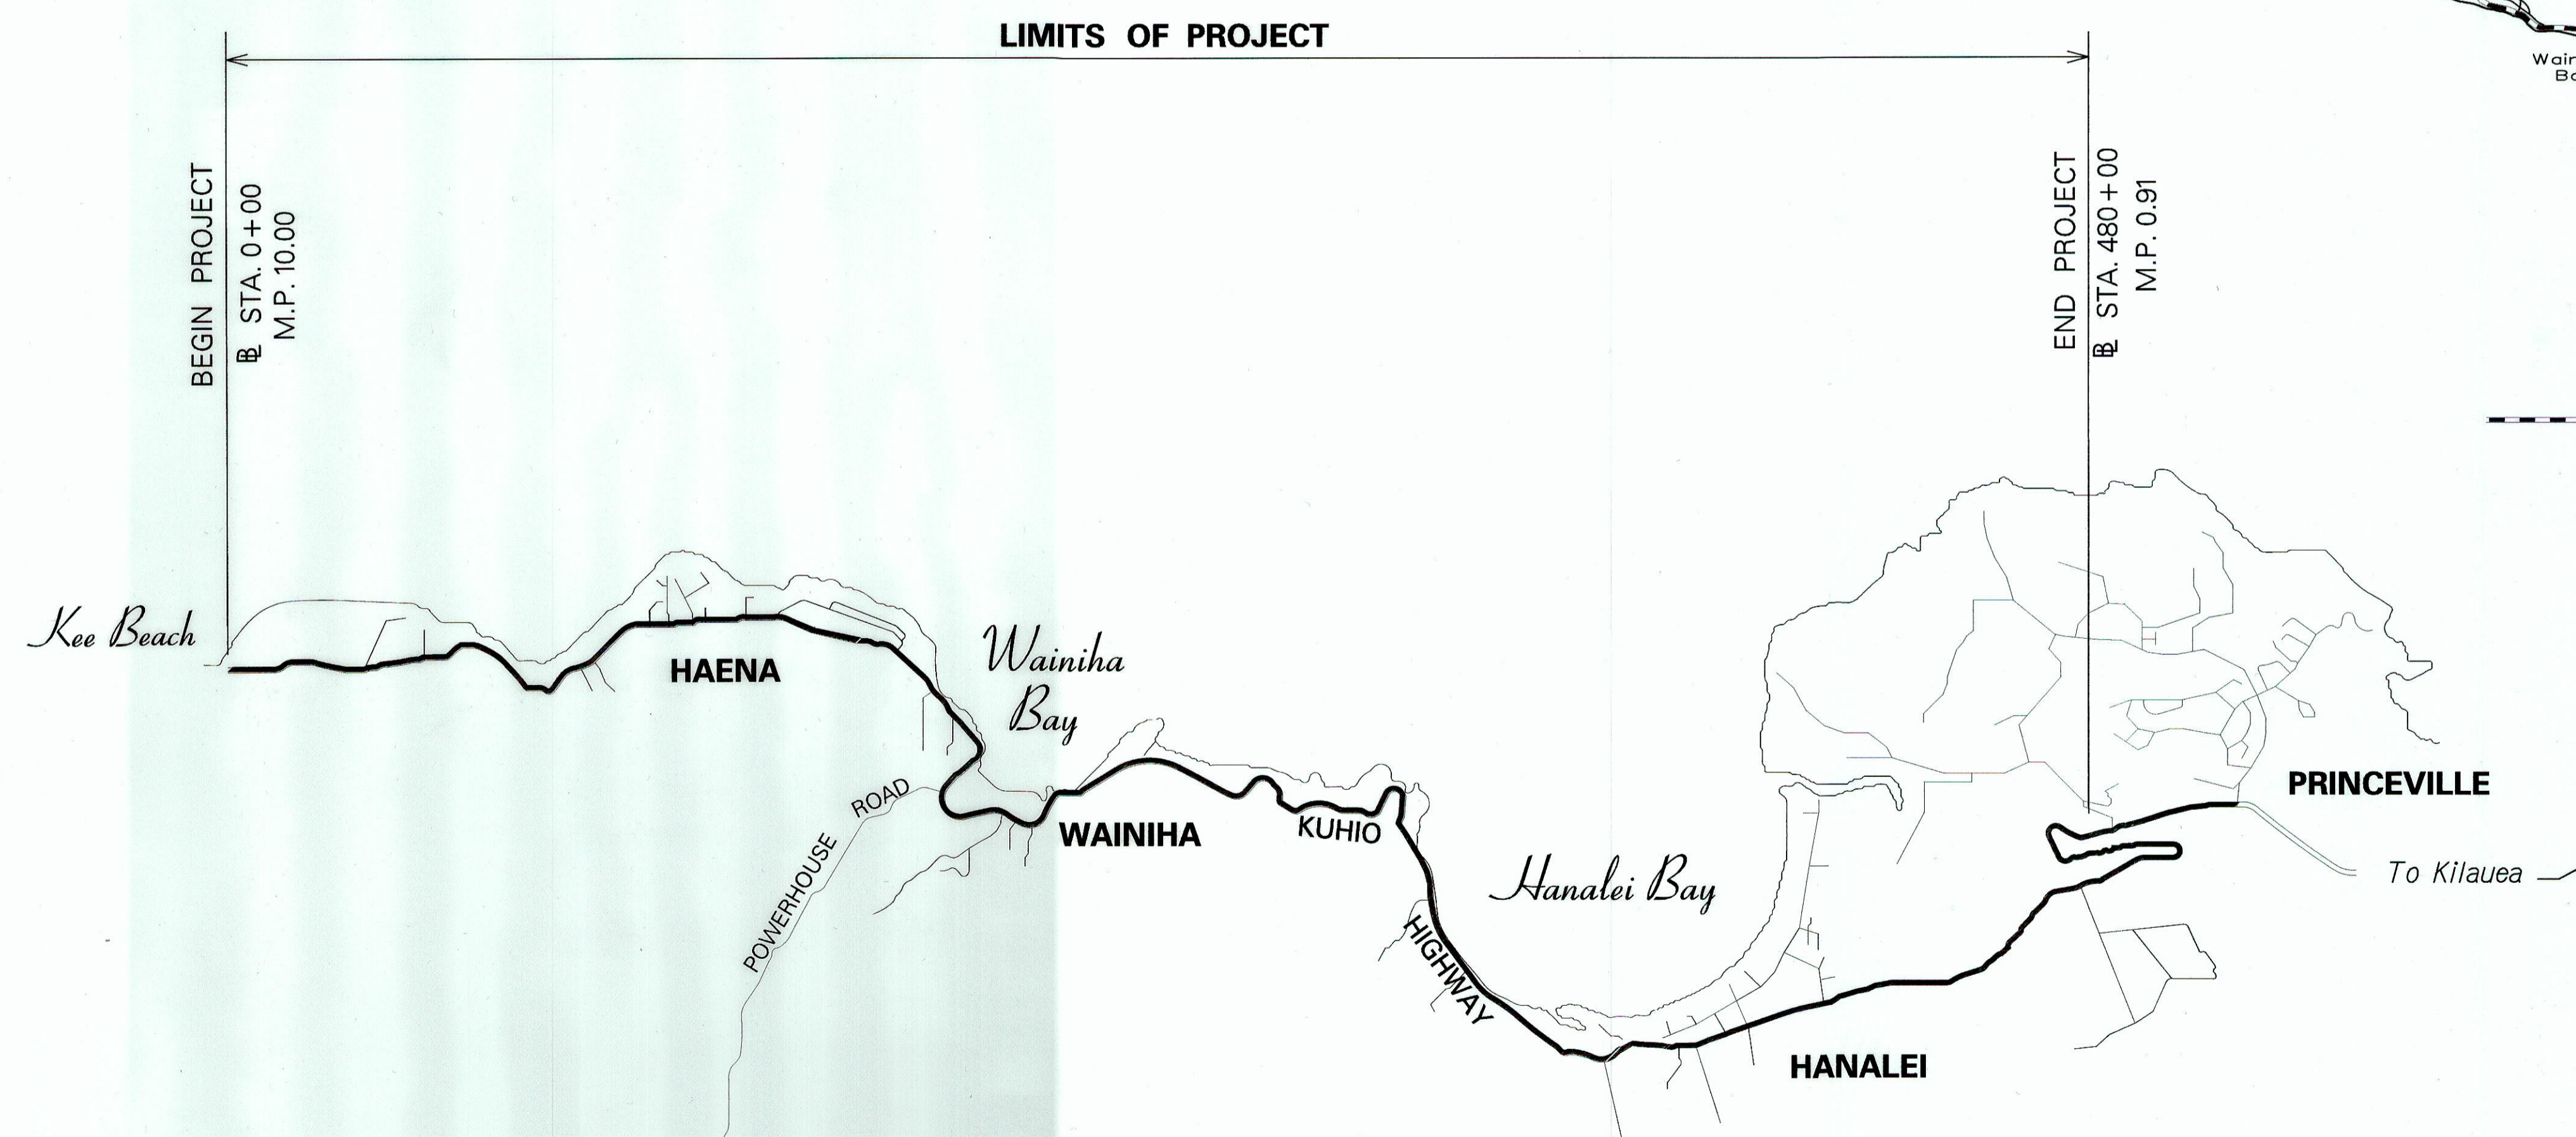


INDEX TO DRAWINGS	
SHEET NO.	DESCRIPTION
1	TITLE SHEET
2	STANDARD PLANS SUMMARY
3	GENERAL NOTES & LEGEND
4 - 5	WATER POLLUTION AND EROSION CONTROL NOTES
6	TYPICAL SECTIONS
7 - 16	ROADWAY PLANS
17 - 18	DRAINAGE PLANS
19	PAVT MARKING LEGEND, DETAILS & NOTES
20	LOW SPEED UNDIVIDED HIGHWAY WORK ZONE SIGNING PLAN, DETAILS & NOTES

STATE OF HAWAII
DEPARTMENT OF TRANSPORTATION
HIGHWAYS DIVISION
HONOLULU, HAWAII
"AS-BUILT" PLANS FOR
**KUHIO HIGHWAY
PAVEMENT REPAIRS
KEE BEACH TO HANAIEI
PROJECT NO. 560A-01-10M**
DISTRICT OF HANAIEI
ISLAND OF KAUAI

FED. ROAD DIST. NO.	STATE	PROJ. NO.	FISCAL YEAR	SHEET NO.	TOTAL SHEET
HAWAII	HAW.	560A-01-10M	2010	1	20

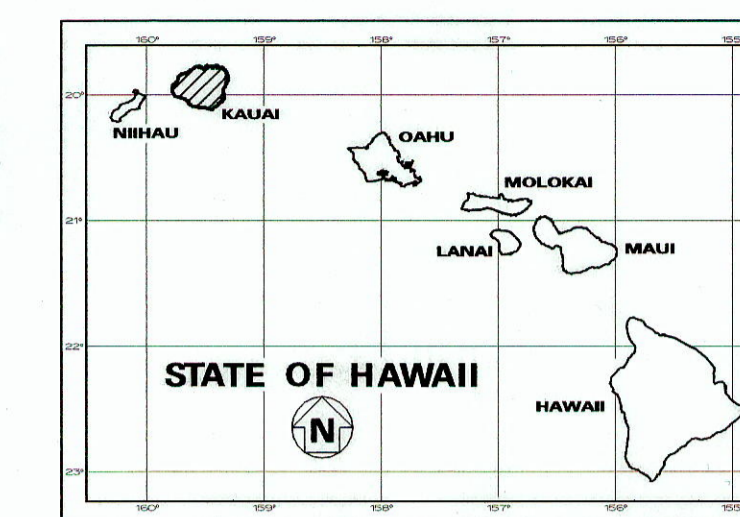


 FEDERAL AID PROJECTS PREVIOUSLY CONSTRUCTED
OR UNDER CONSTRUCTION

MILE POST 0.91 TO MILE POST 10.00

CHANGES MADE DURING CONSTRUCTION HAVE BEEN INCORPORATED ON THESE PLANS EXCEPT CHANGE IN THE ORIGINAL THEORETICAL QUANTITIES. FOR ACTUAL QUANTITIES, REFER TO PROJECT LEDGER AND/OR CONSTRUCTION BOOK.

RESIDENT ENGINEER **DATE**

DEPARTMENT OF TRANSPORTATION STATE OF HAWAII	
APPROVED:	
 DIR. OF TRANSPORTATION	4/20 DATE