




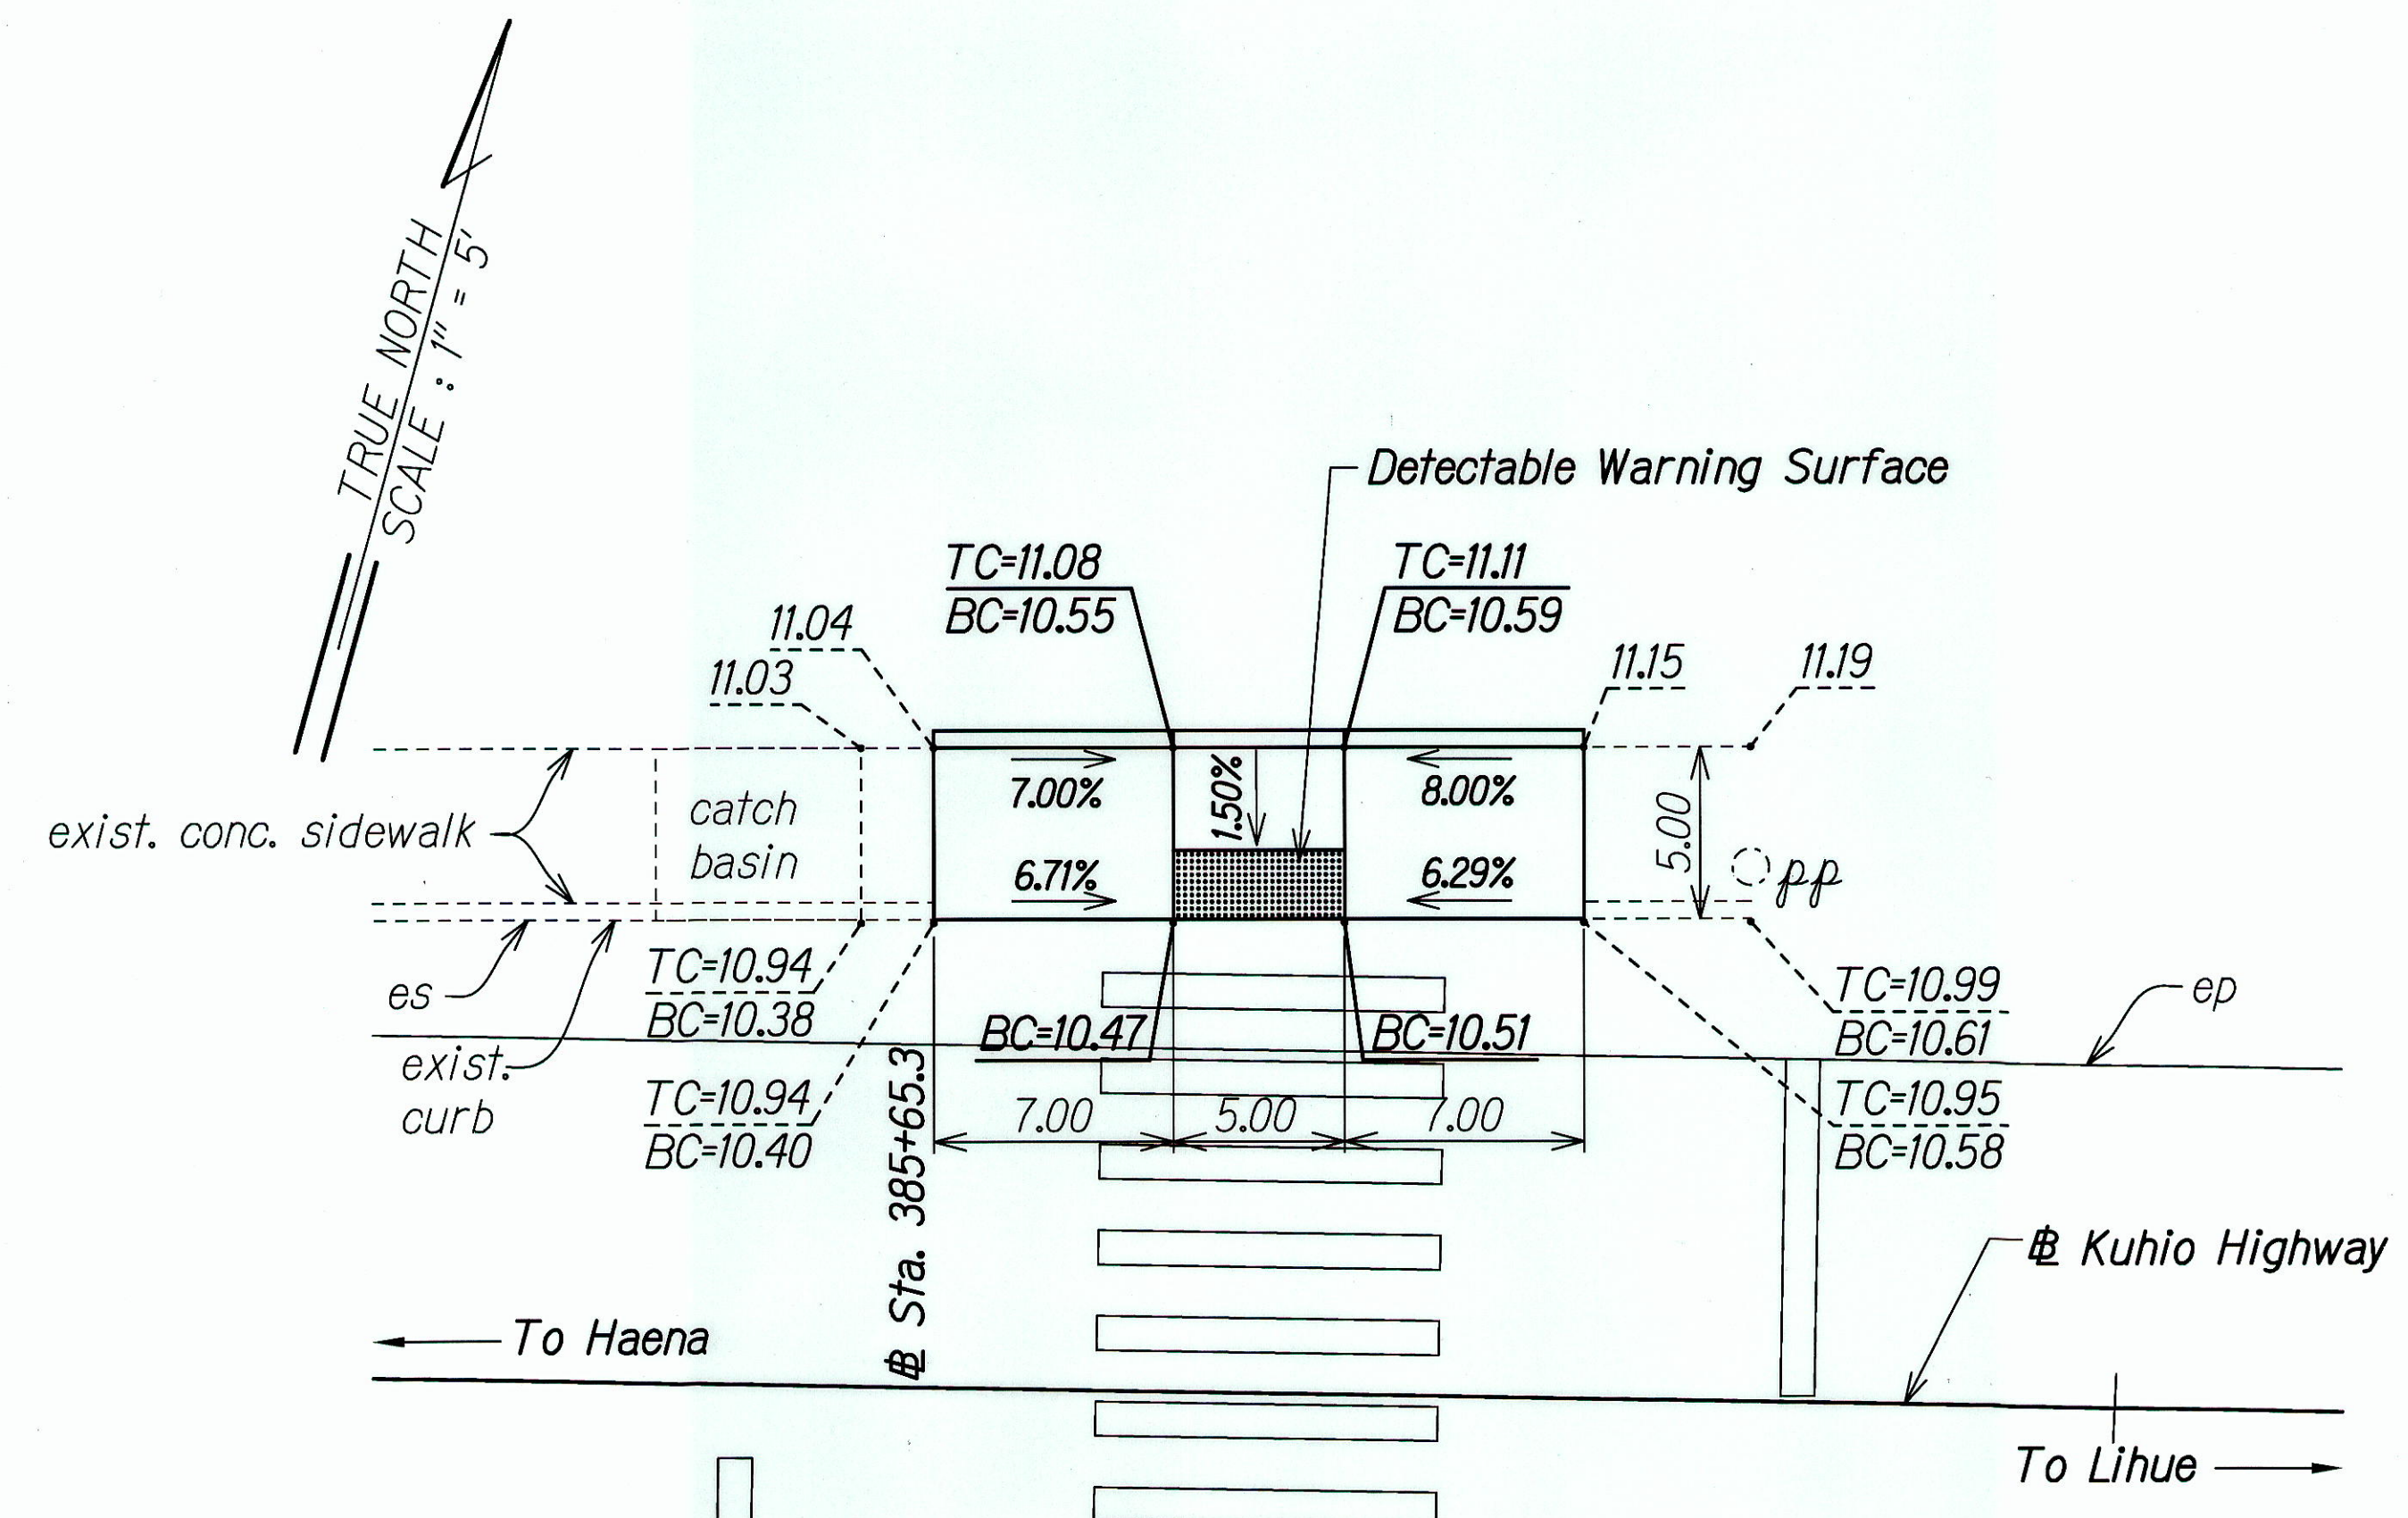


CURB RAMP - #2
Scale 1" = 5'

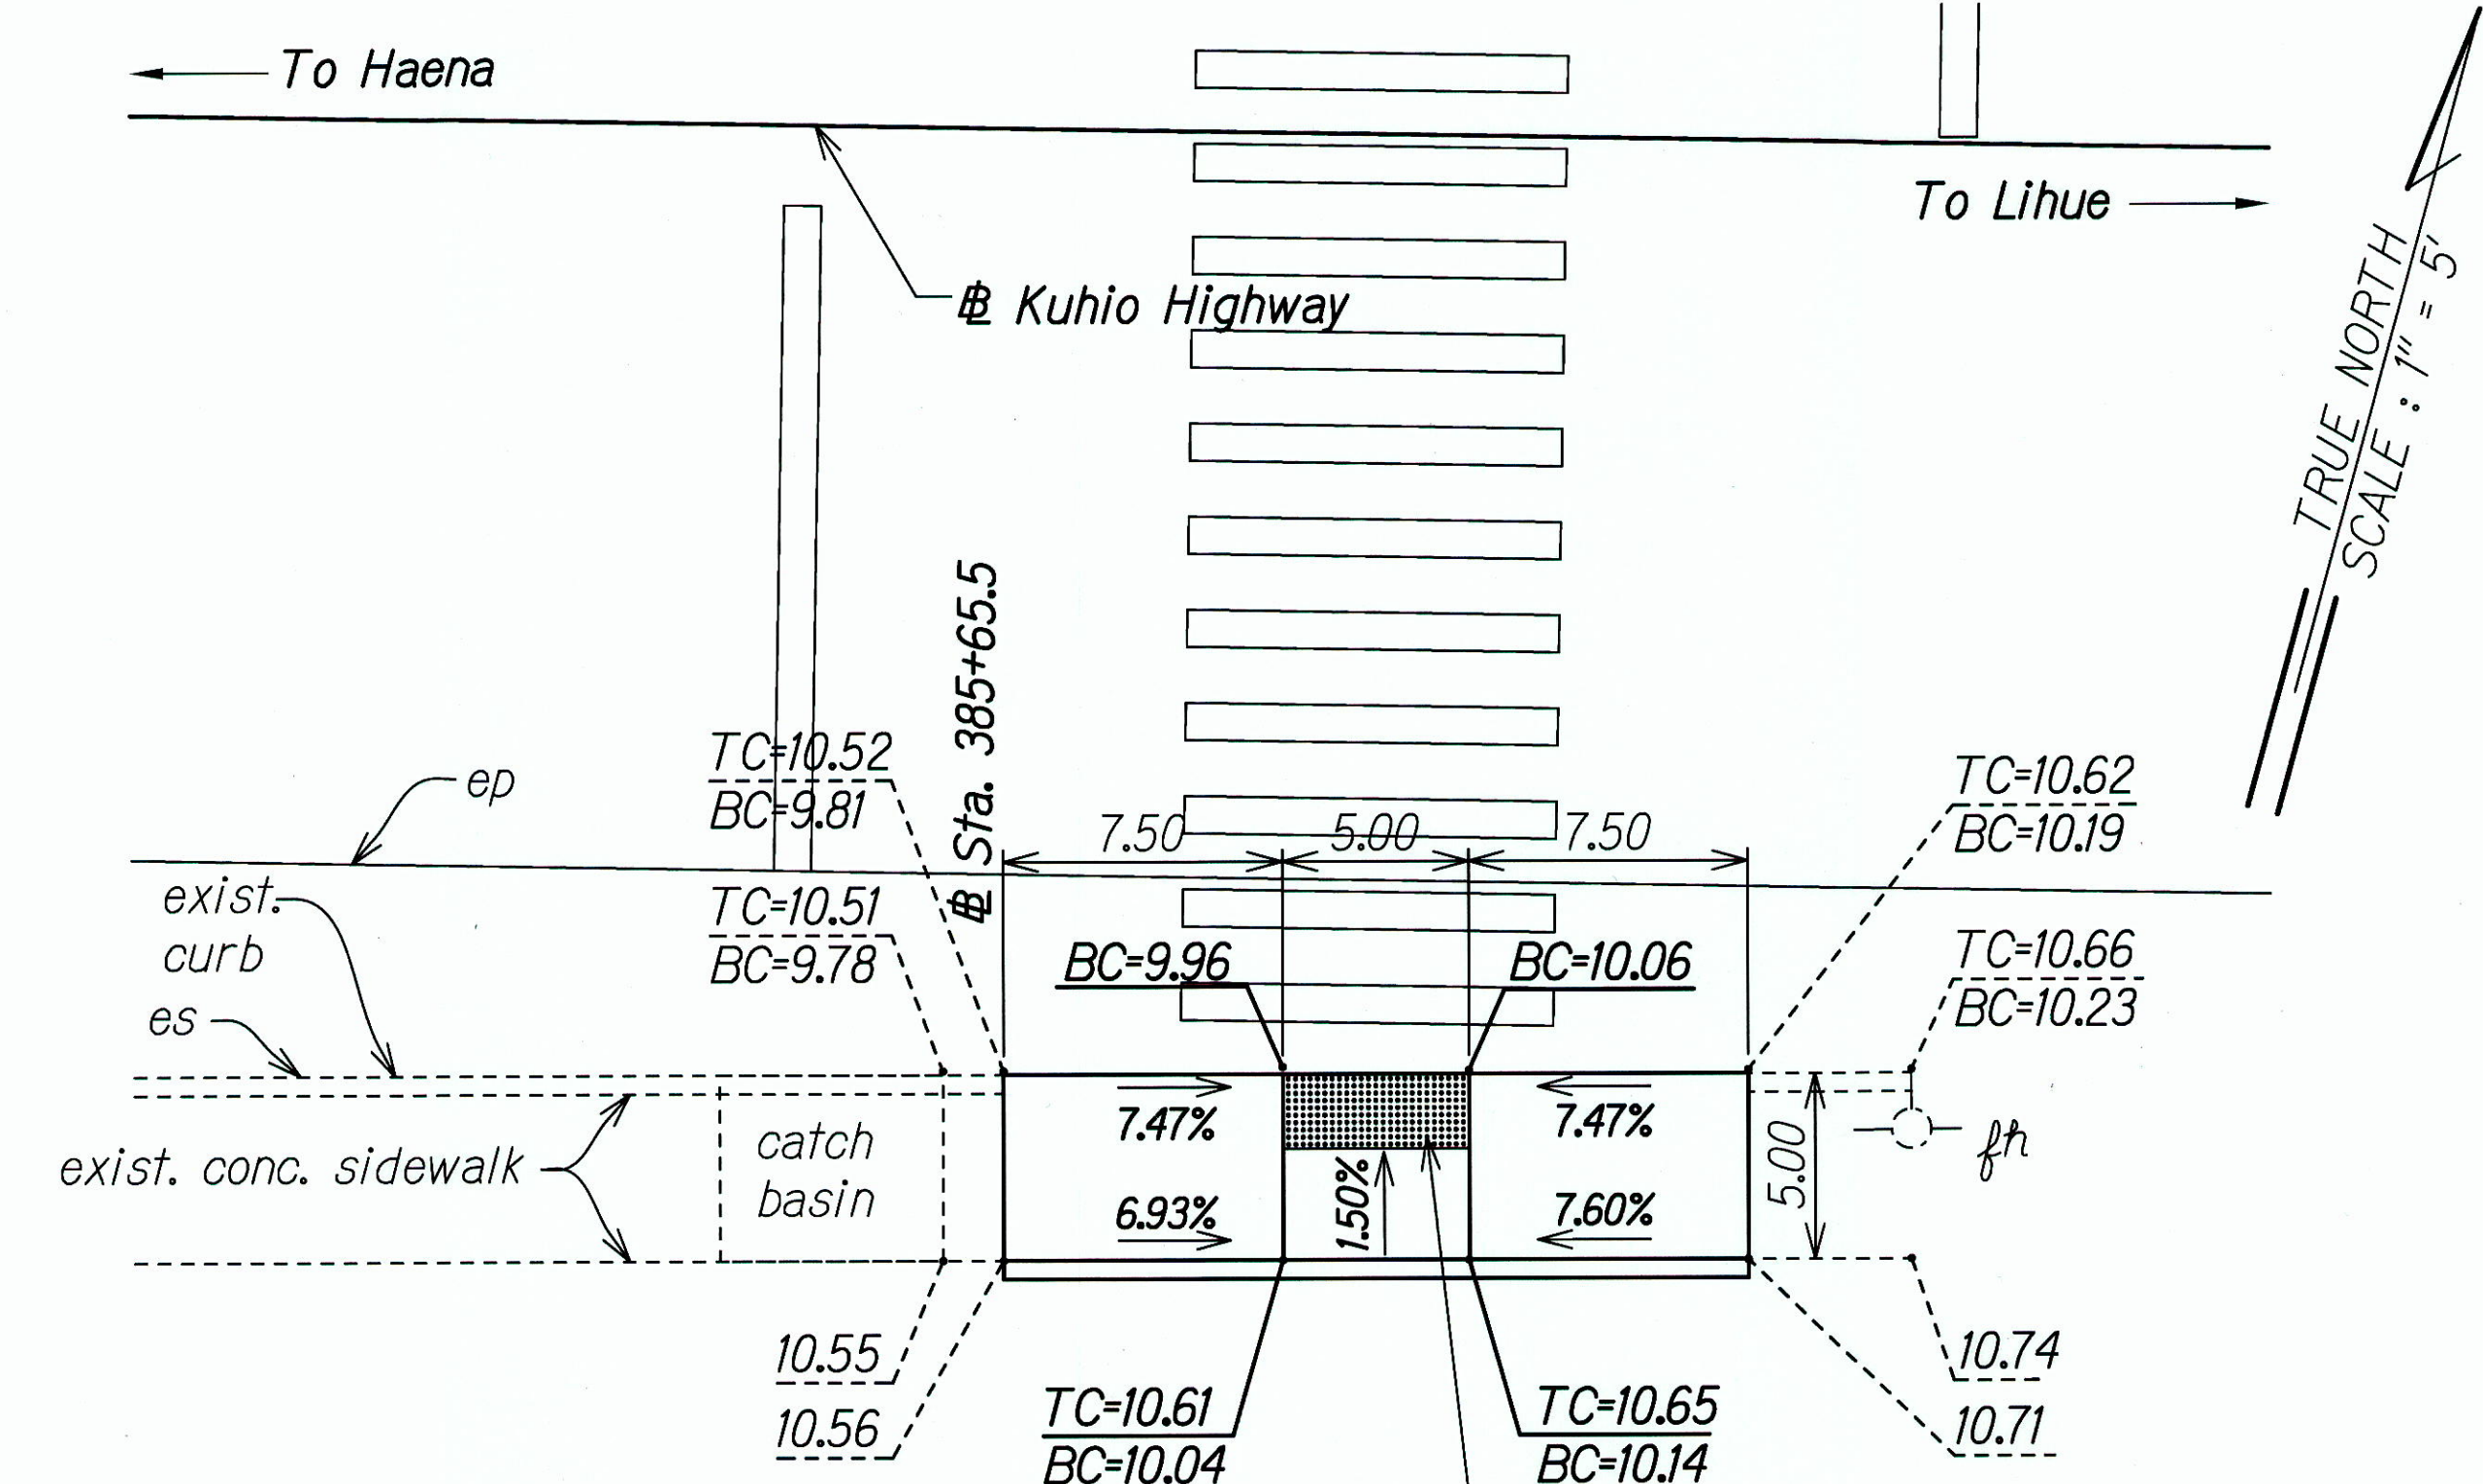

CURB RAMP - #3
Scale 1" = 5'

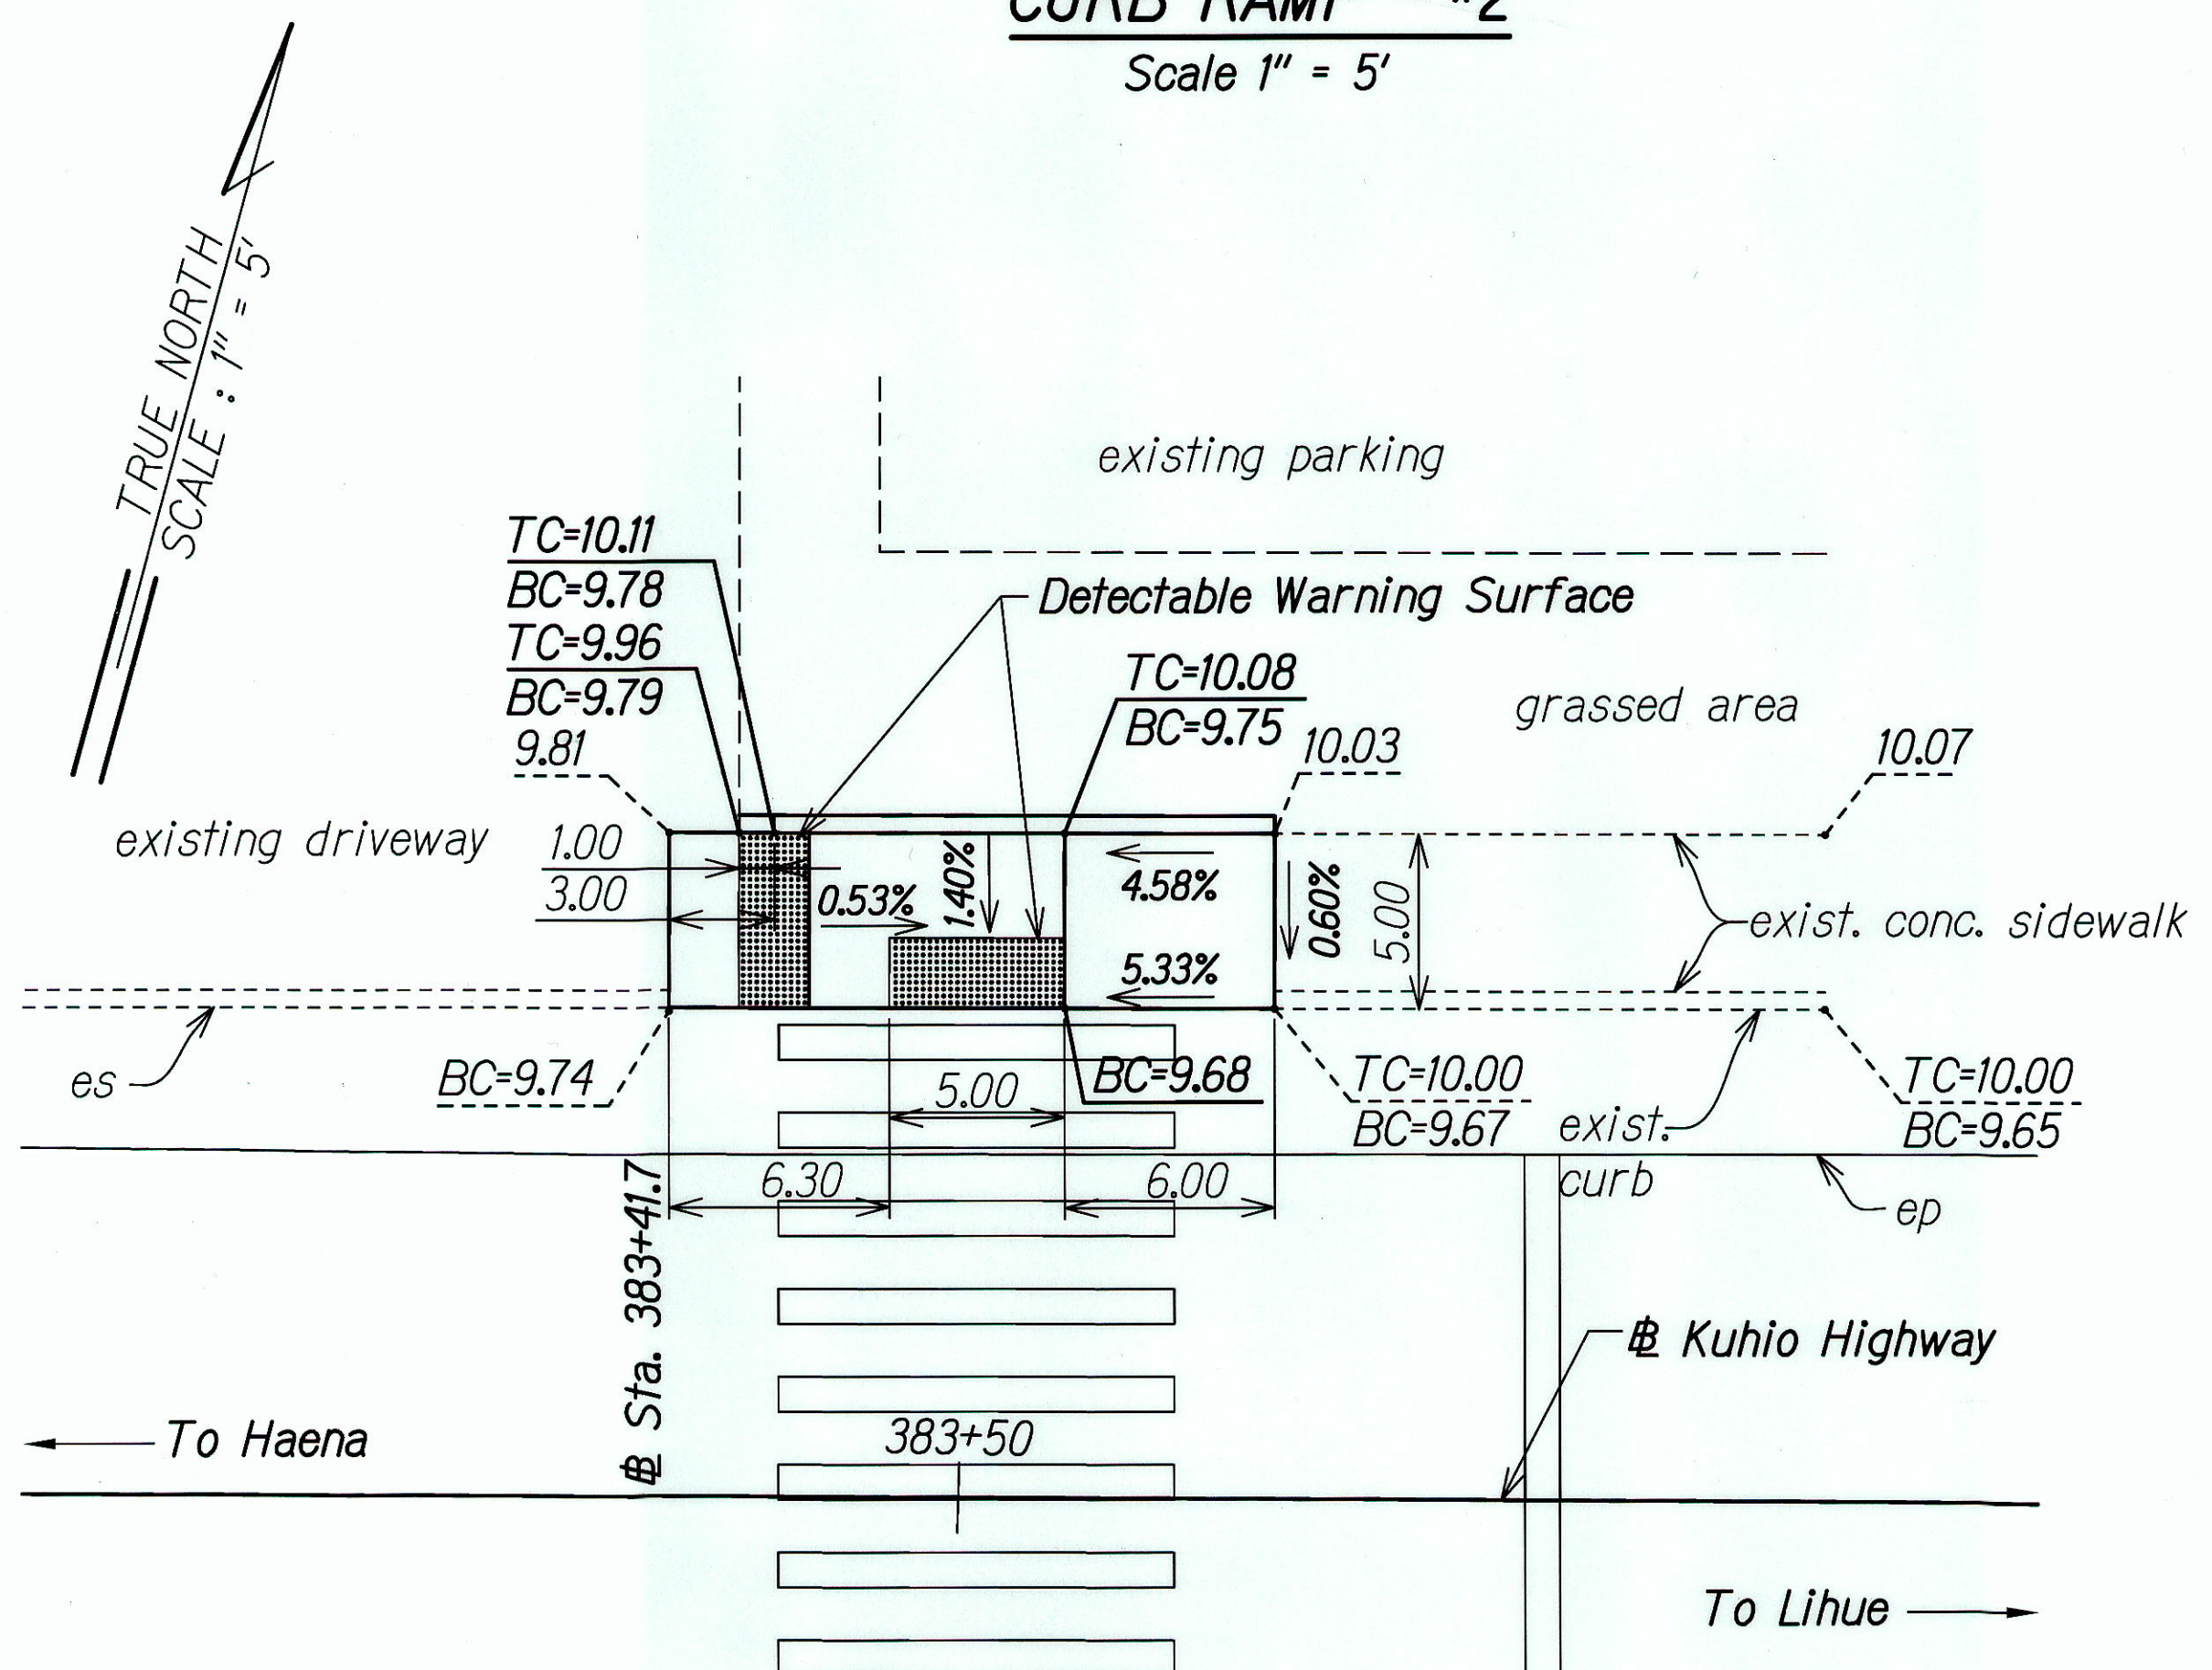

CURB RAMP - #1
Scale 1" = 5'

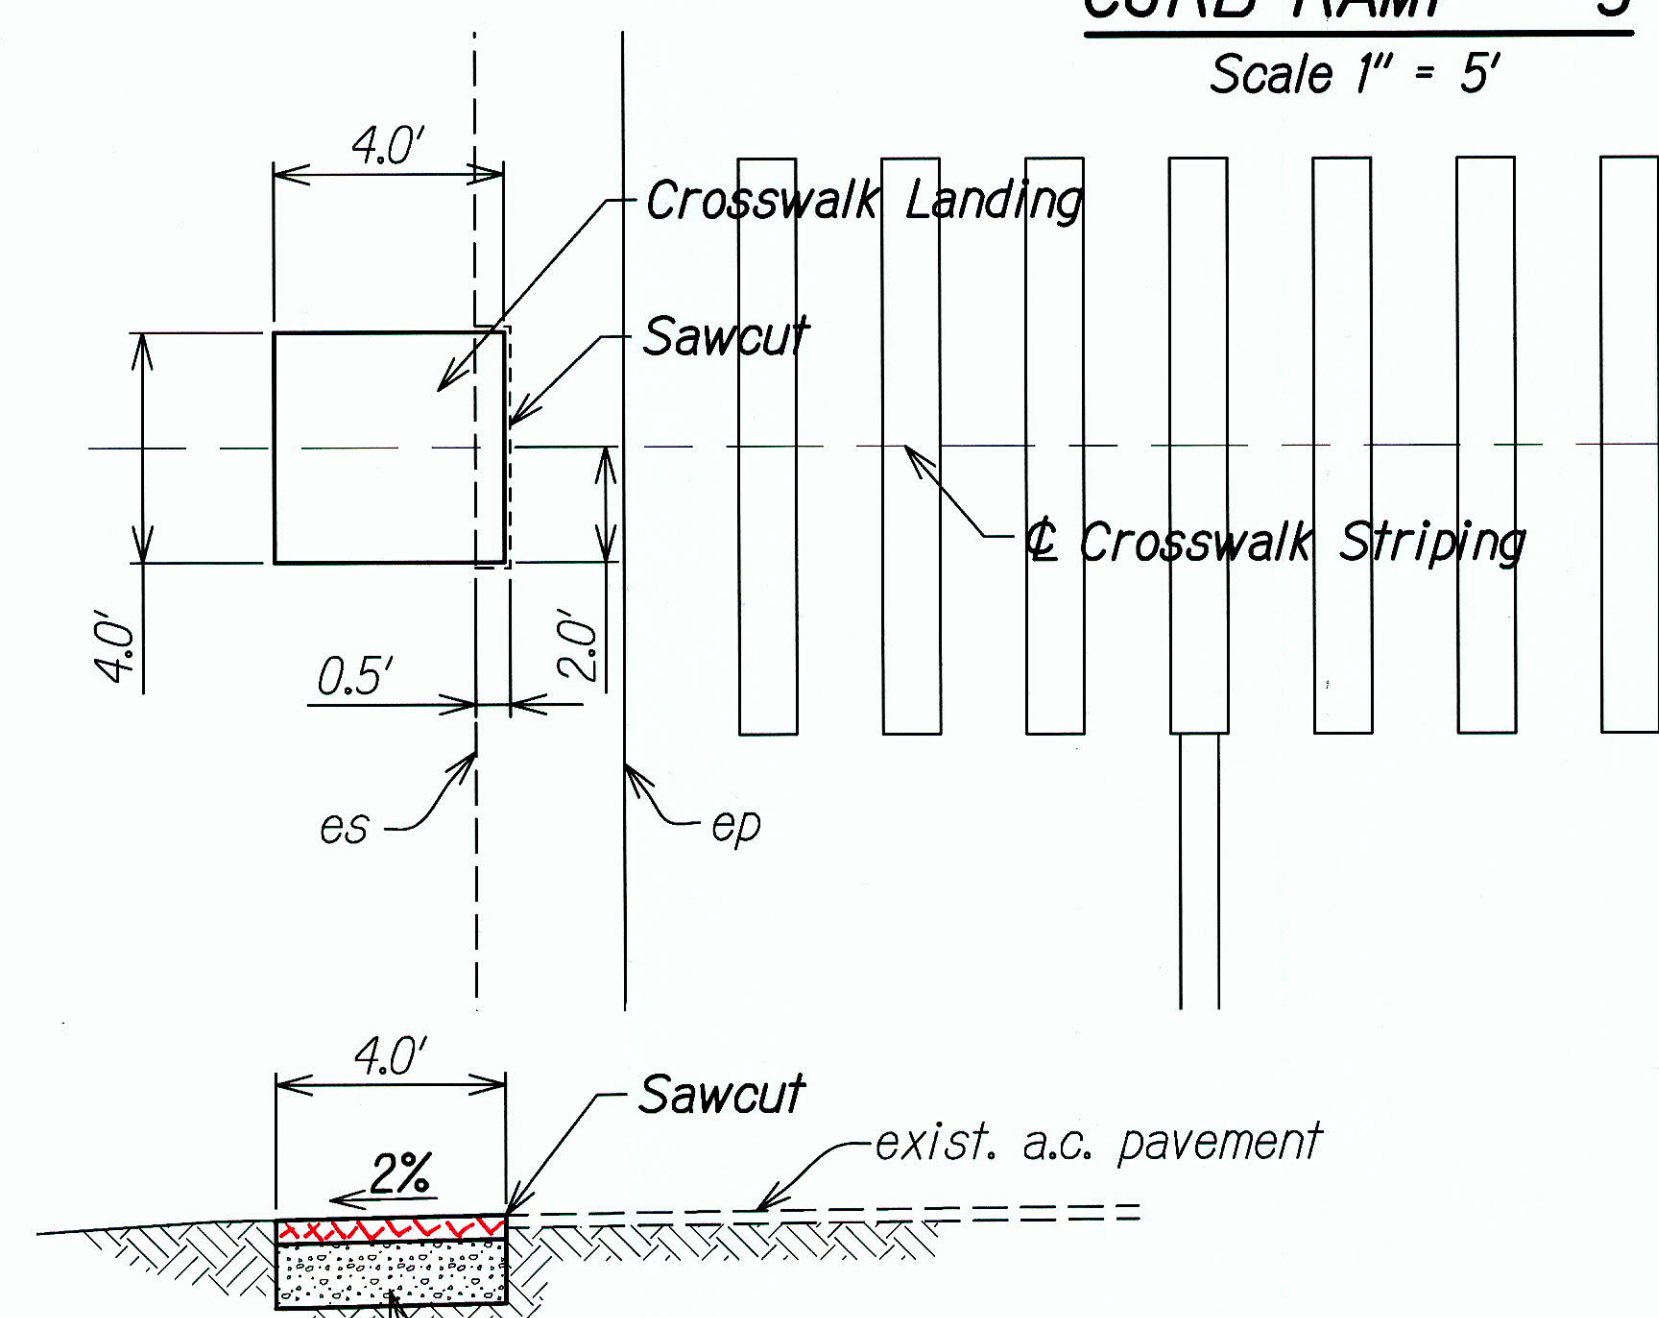


CROSSWALK LANDING DETAIL
Scale nts

Note:
Sawcut, Roadway Excavation, Aggregate Base Course, and SS-1 Tack Coat for constructing crosswalk landing shall be considered incidental to contract Item No. 401.0400, Hot Mix Asphalt Pavement, Mix No. IV.

APPROVED: (For Work Within County Right of Way)

County Engineer
County of Kauai
Date: 012/2

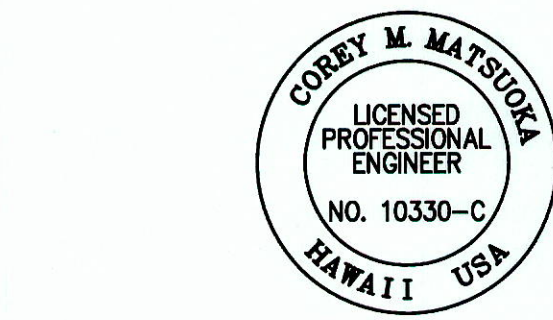

THIS WORK WAS PREPARED BY ME OR UNDER MY SUPERVISION

SIGNATURE: Corey Matsuka
Date: 4/30/14
EXPIRATION DATE OF THE LICENSE

STATE OF HAWAII
DEPARTMENT OF TRANSPORTATION
HIGHWAYS DIVISION

CURB RAMP & CROSS WALK LANDING DETAILS

KUHIO HIGHWAY SAFETY IMPROVEMENTS
Hanalei Bridge to Waikoko Bridge
Fed-Aid Project No. HRR-0560(12)

Scale: 1" = 5' Date: June 2012

SHEET No. 2 OF 2 SHEETS

"AS-BUILT"