
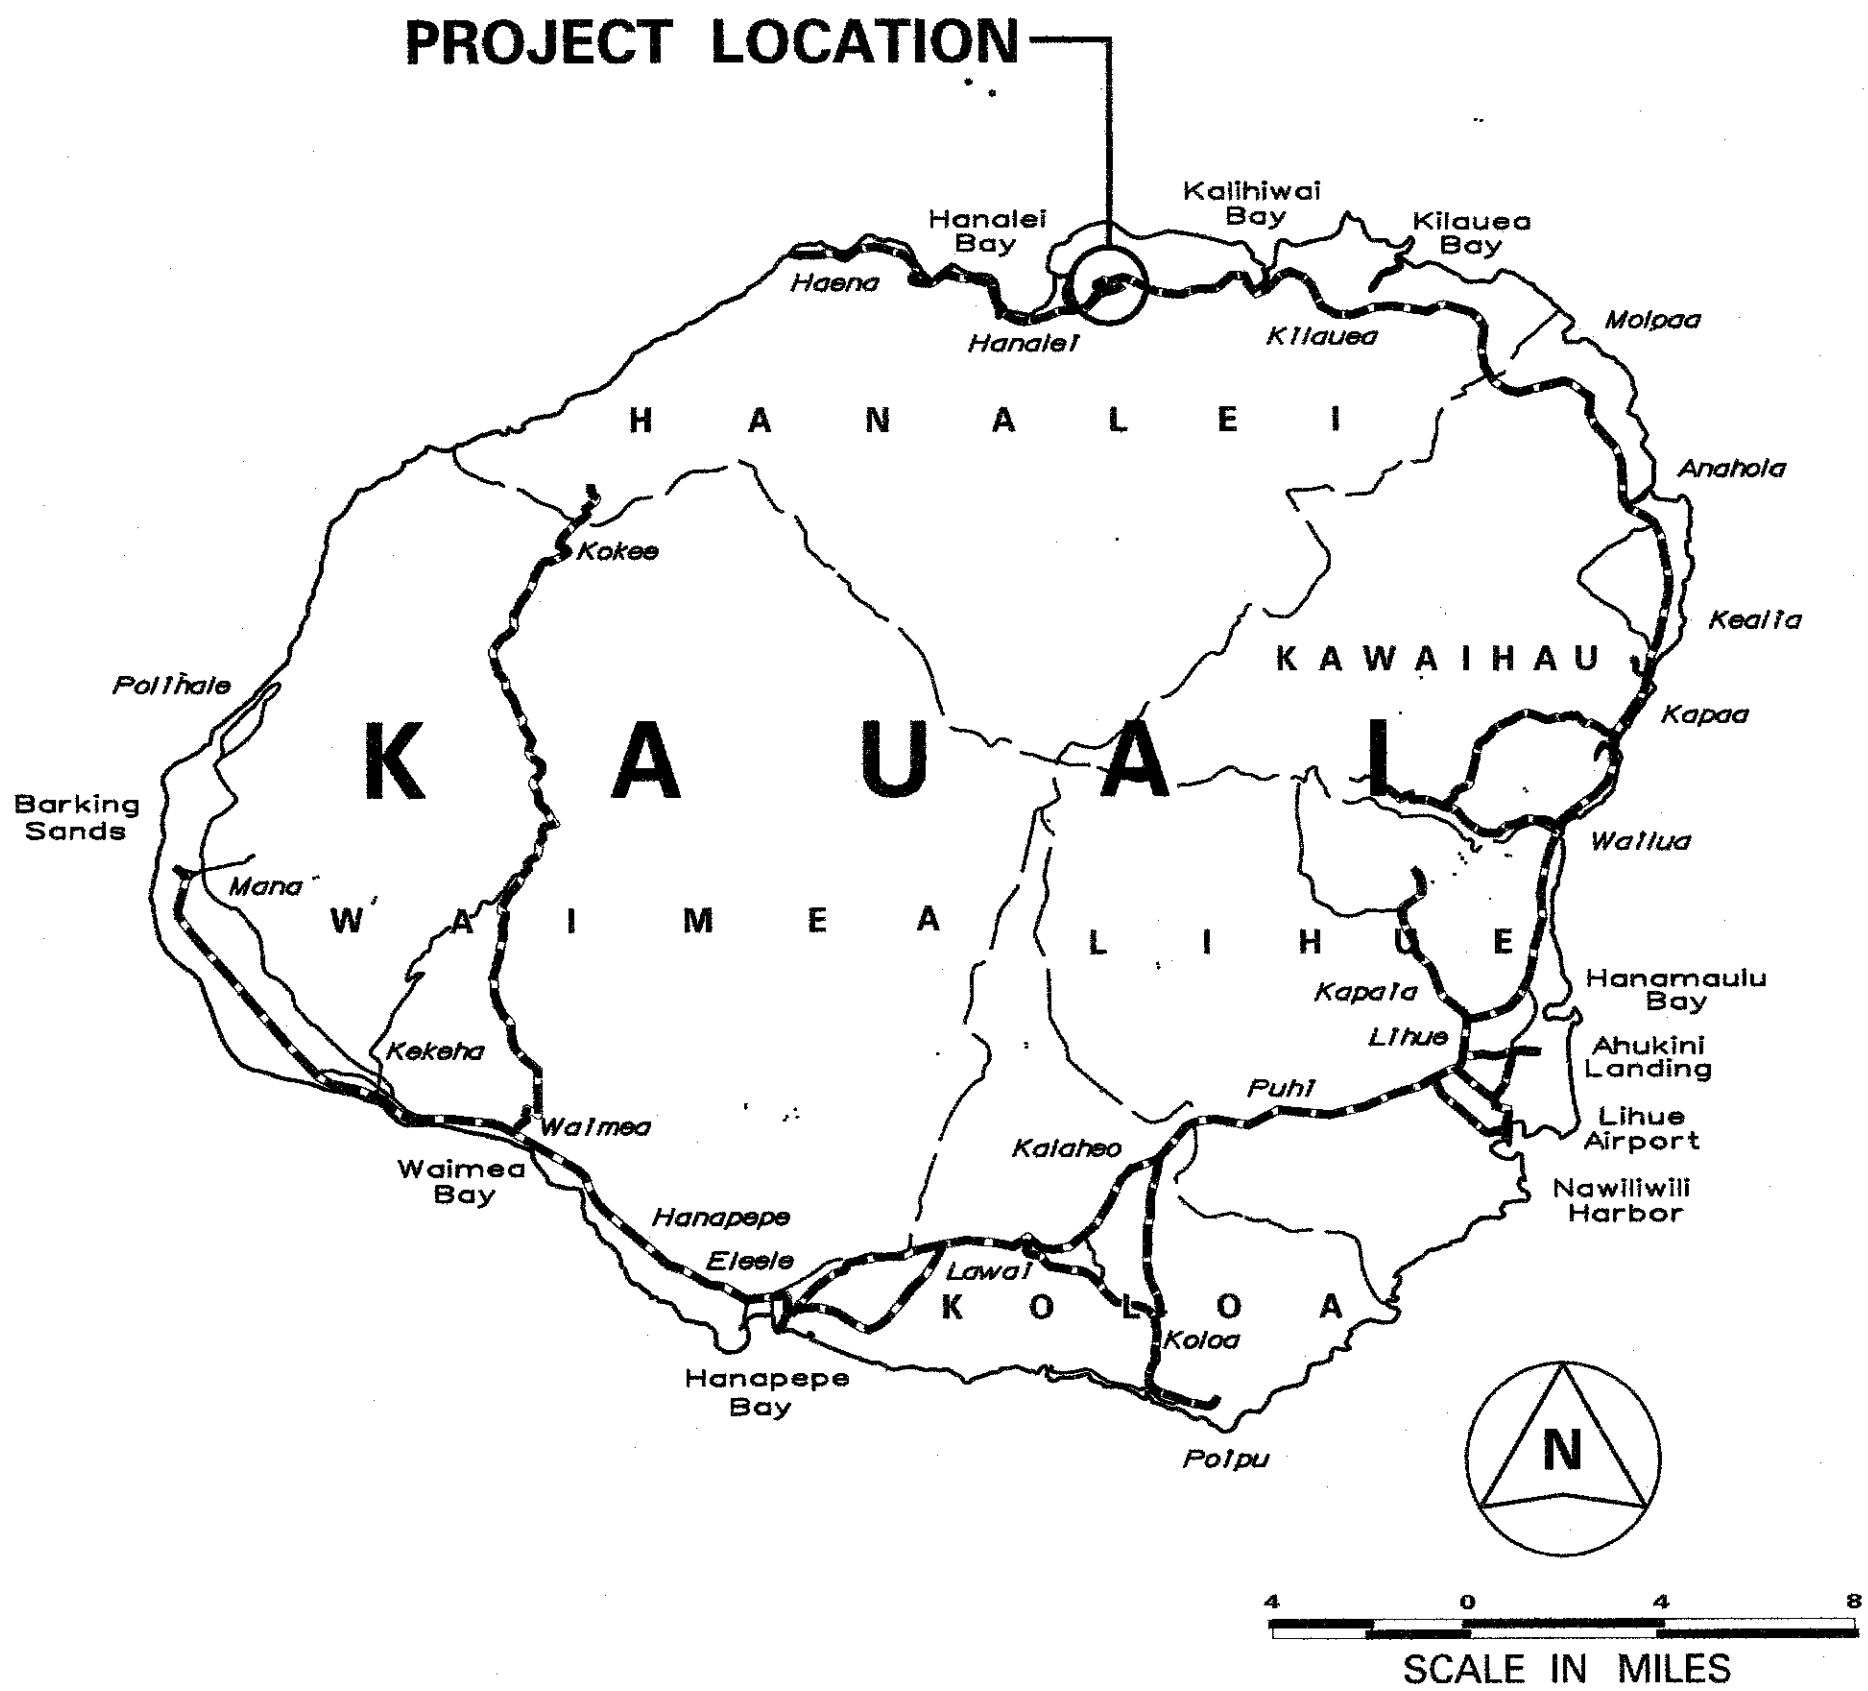


INDEX TO DRAWINGS	
SHEET NO.	DESCRIPTION
1	TITLE SHEET
2	ROADWAY PLAN AND DETAILS
3	TRAFFIC CONTROL PLAN
4	SOIL NAIL ANCHOR CAP BEAM AND STRUCTURAL NOTES
5	SOIL NAIL ANCHOR DETAILS

STATE OF HAWAII
DEPARTMENT OF TRANSPORTATION
HIGHWAYS DIVISION
HONOLULU, HAWAII
"AS-BUILT"
PLANS FOR
KUHIO HIGHWAY (ROUTE 560)
EMERGENCY SLOPE STABILIZATION
IN HANAIEI IN THE VICINITY OF M.P. 1
FEDERAL AID PROJECT NO. ER-16(004)
DISTRICT OF HANAIEI
ISLAND OF KAUAI


FED. ROAD DIST. NO.	STATE	FEDERAL AID PROJ. NO.	FISCAL YEAR	SHEET NO.	TOTAL SHEETS
HAWAII	HAW.	ER-16(004)	2012	1	5

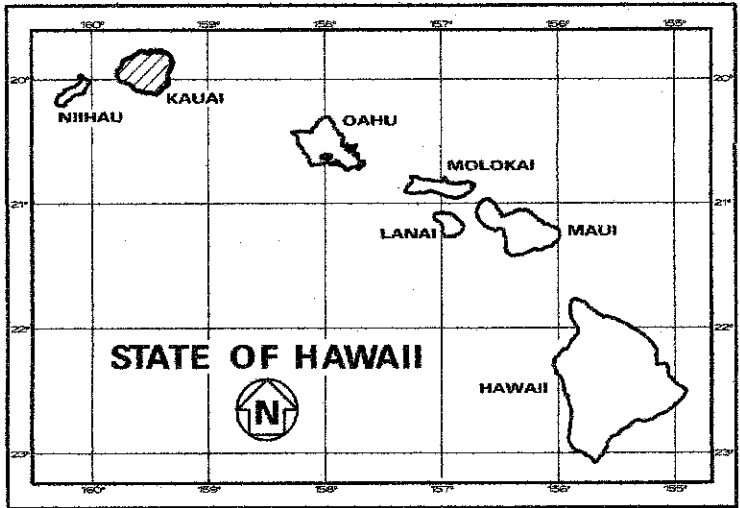

DESIGNED BY
MANAGED BY
DATE

APRIL 2012

DESIGNED BY	DATE
MANAGED BY	DATE
DATE	
NOTE BOOK	
QUANTITIES BY	
CHECKED BY	

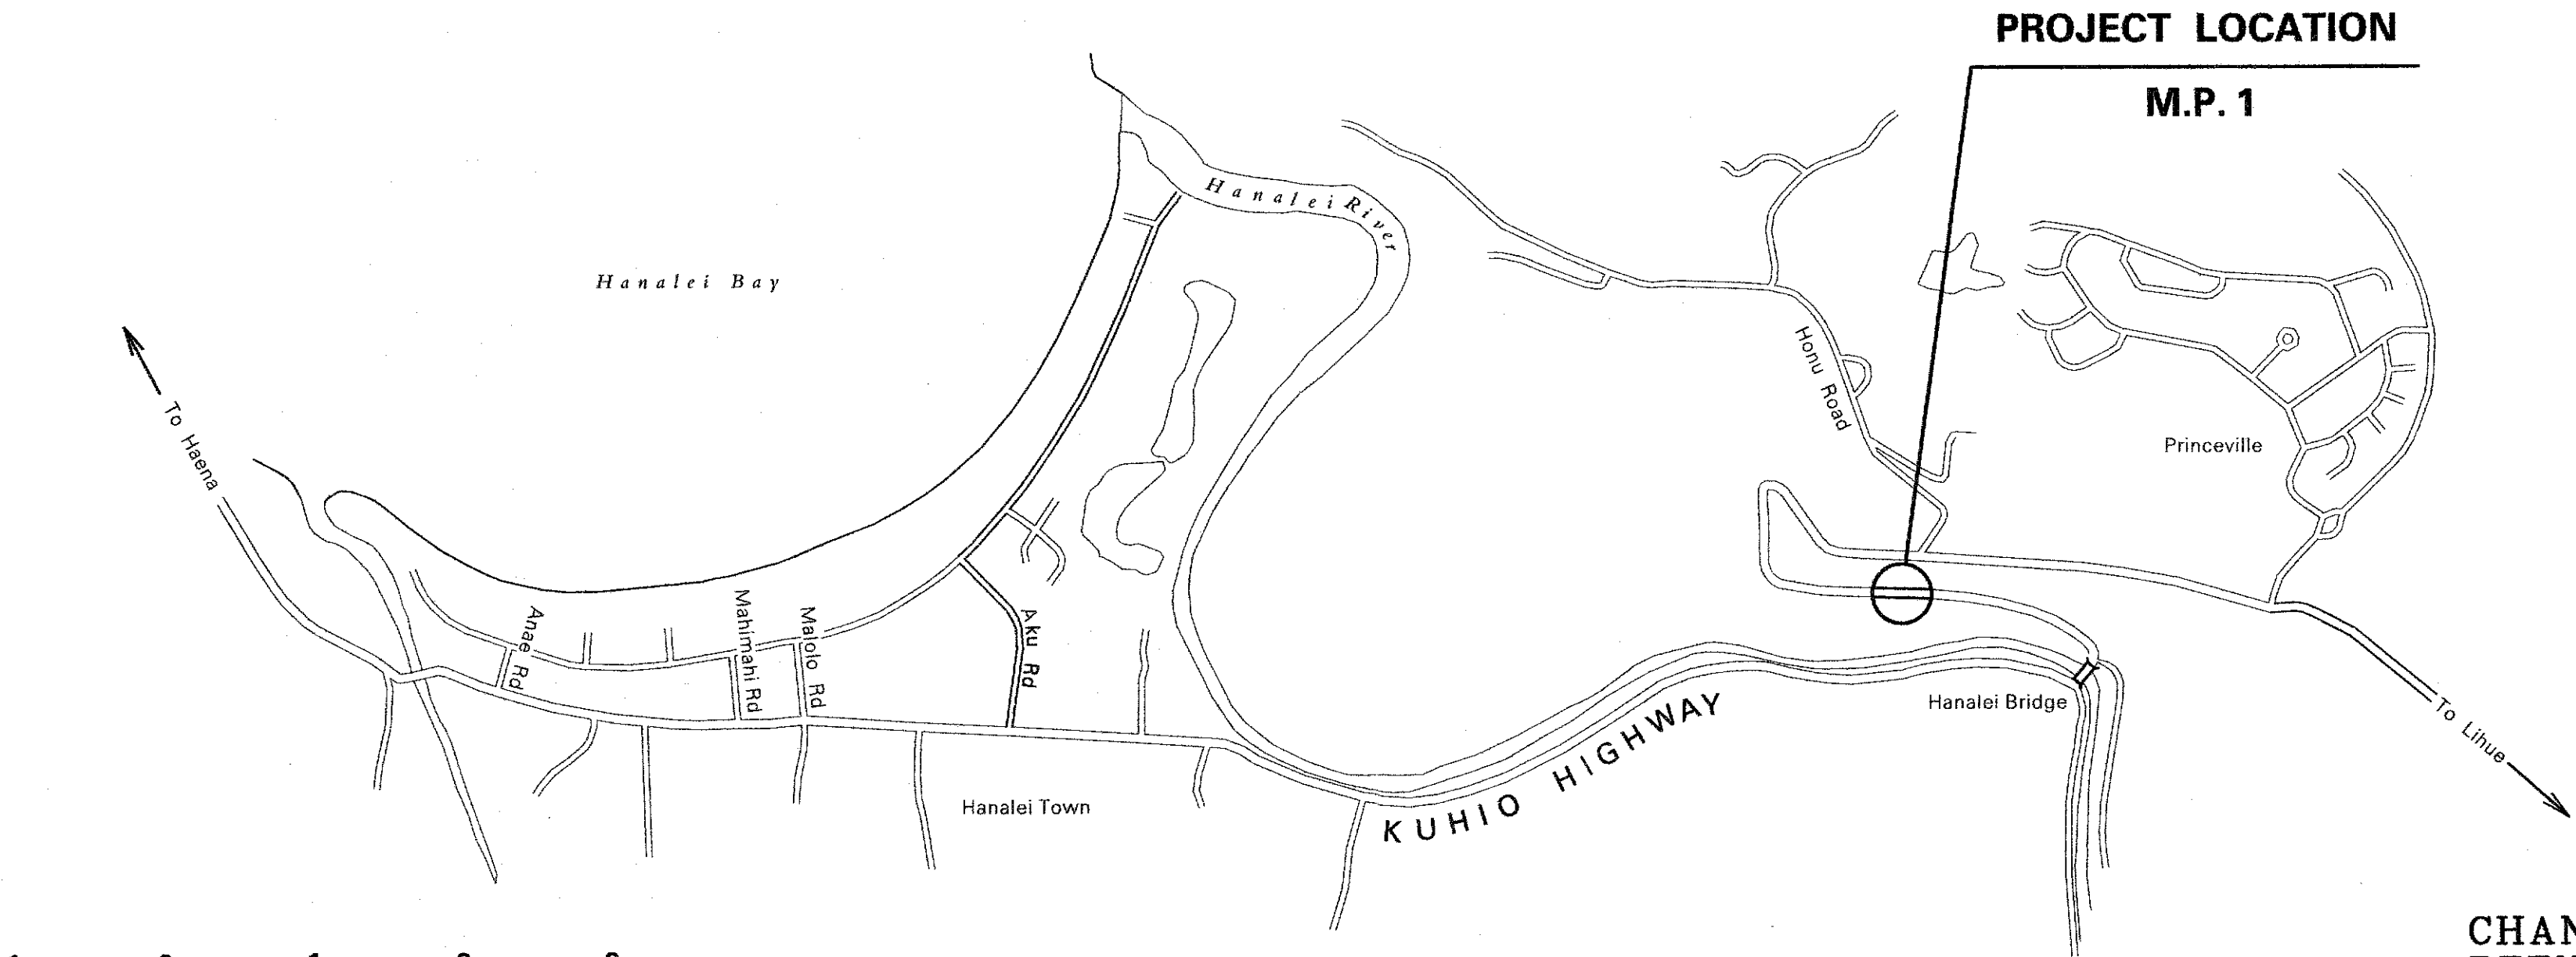

LAYOUT PLAN
Not to Scale

CHANGES MADE DURING CONSTRUCTION HAVE BEEN INCORPORATED ON THESE PLANS EXCEPT CHANGES IN THE ORIGINAL THEORETICAL QUANTITIES. FOR ACTUAL QUANTITIES, REFER TO PROJECT LEDGER AND/OR COMPUTATION BOOK.

RESIDENT ENGINEER

DATE

DEPARTMENT OF TRANSPORTATION STATE OF HAWAII	
APPROVED:	
DIR. OF TRANSPORTATION	DATE