



FED. ROAD DIST. NO.	STATE	FEDERAL AID PROJ. NO.	FISCAL YEAR	SHEET NO.	TOTAL SHEETS
HAWAII	HAW.	ER-16(002)	2014	14	54

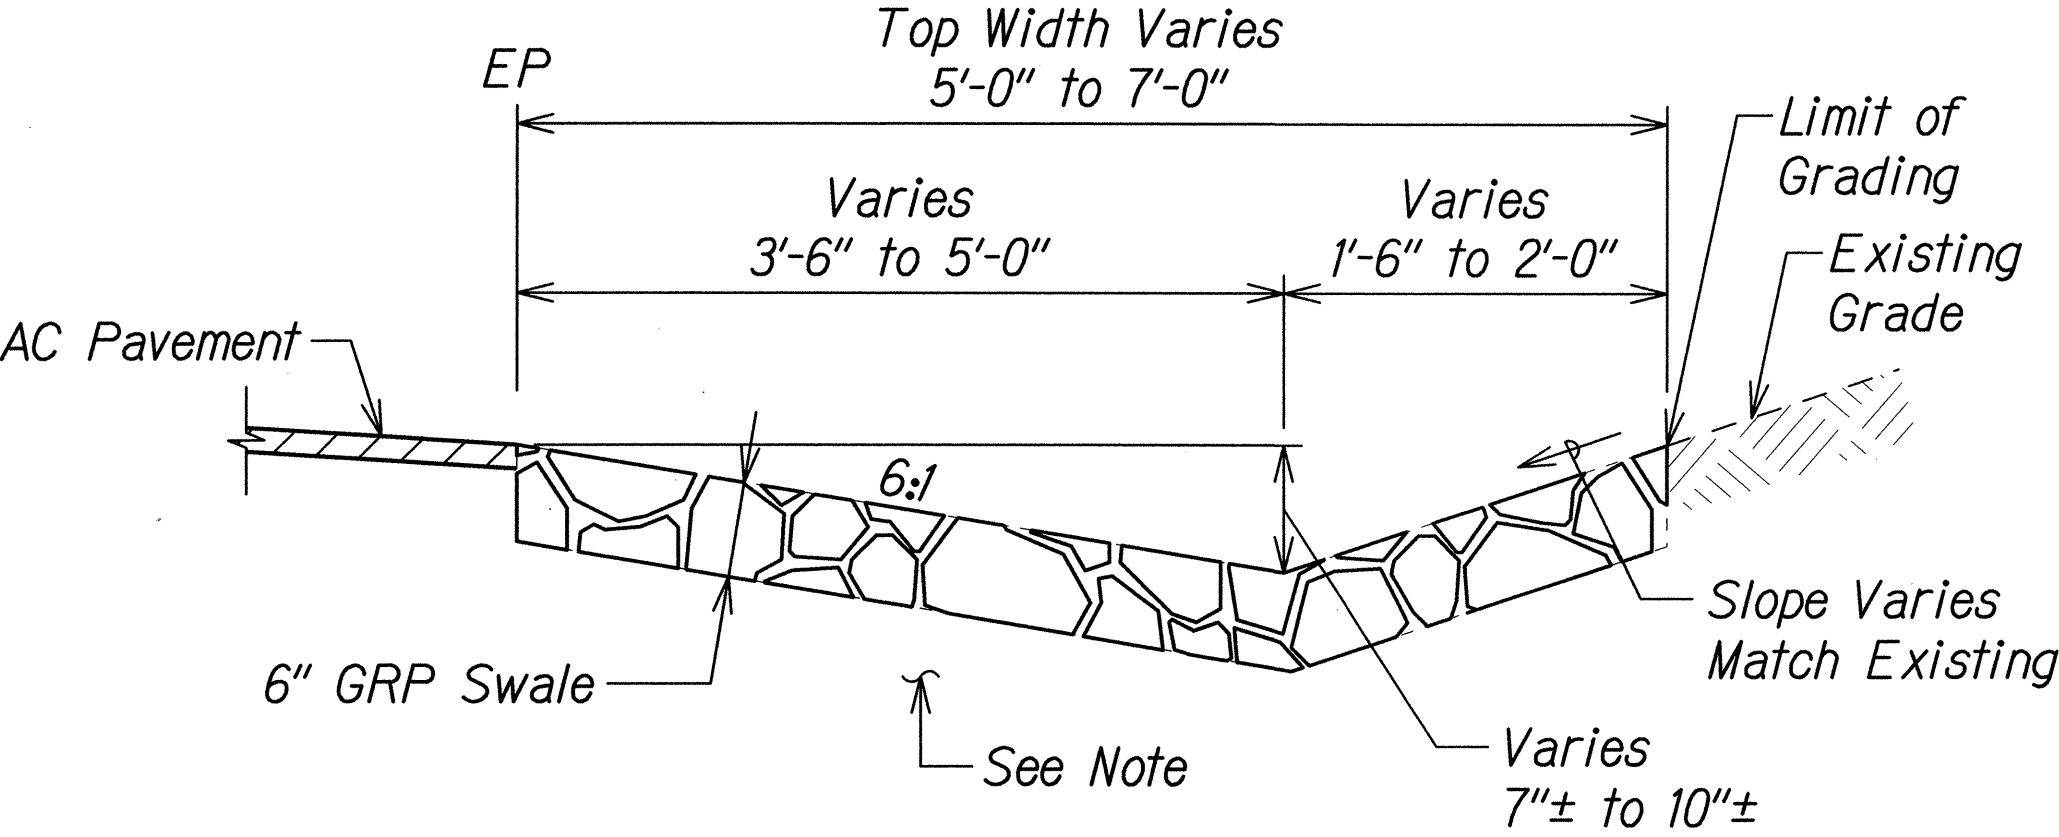

SECTION
STA. 56+81.9± TO 57+50
Scale: NTS


A
C2.4C2.6

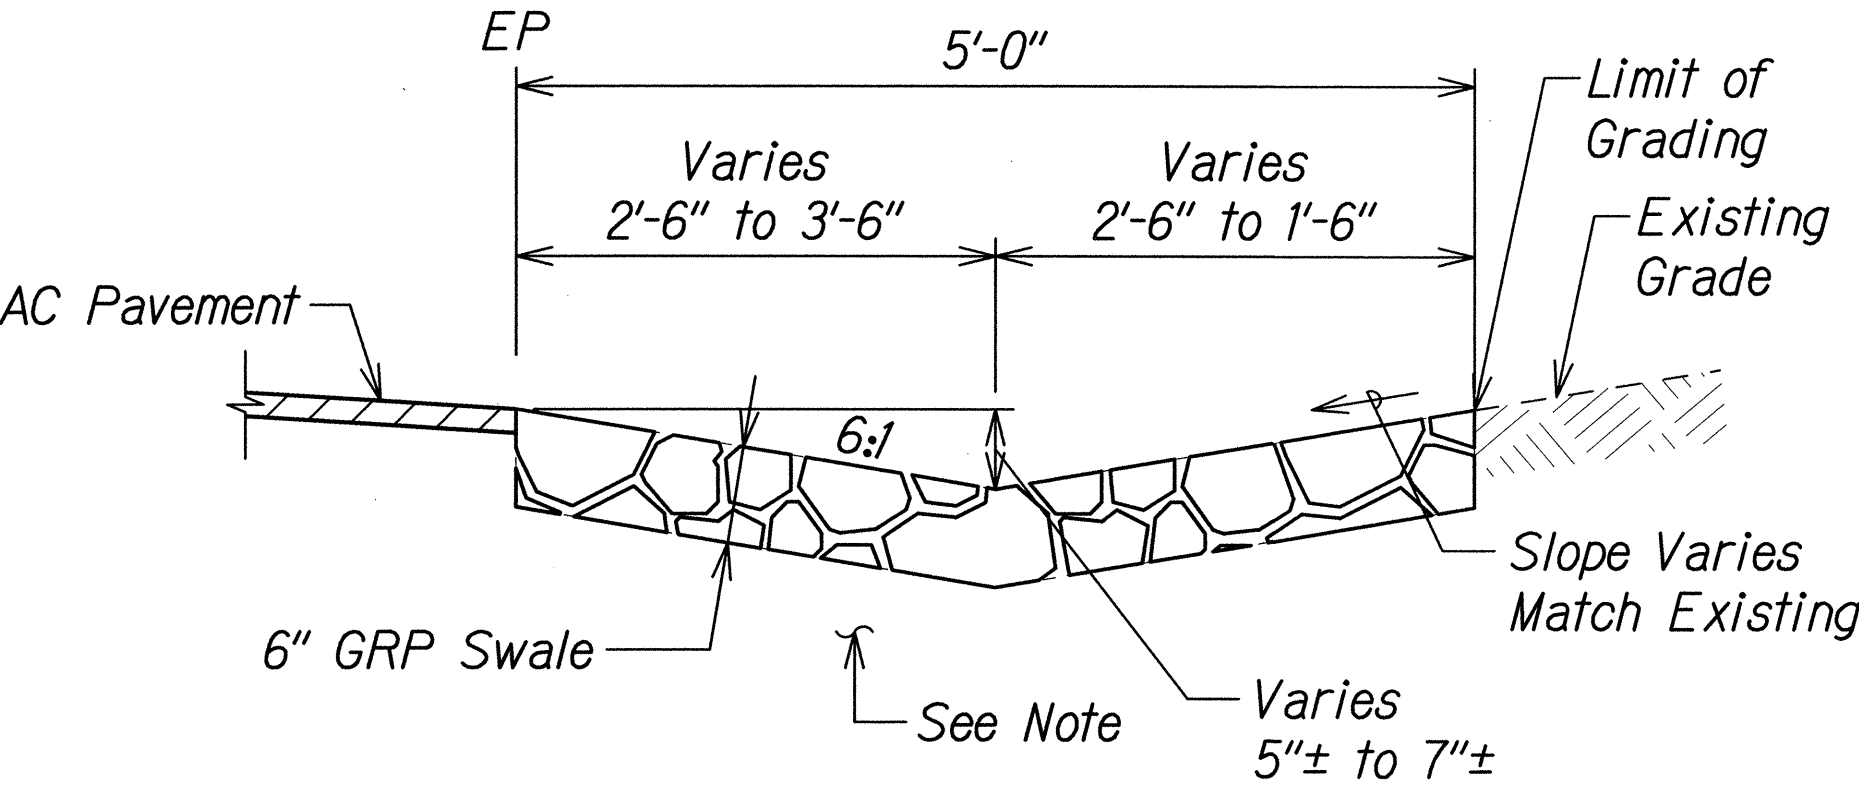

SECTION
STA. 57+50 TO 58+87
Scale: NTS


B
C2.4C2.6

NOTE:
Contractor shall compact subgrade until it is visually firm and unyielding. Acceptance shall be determined by the Engineer.

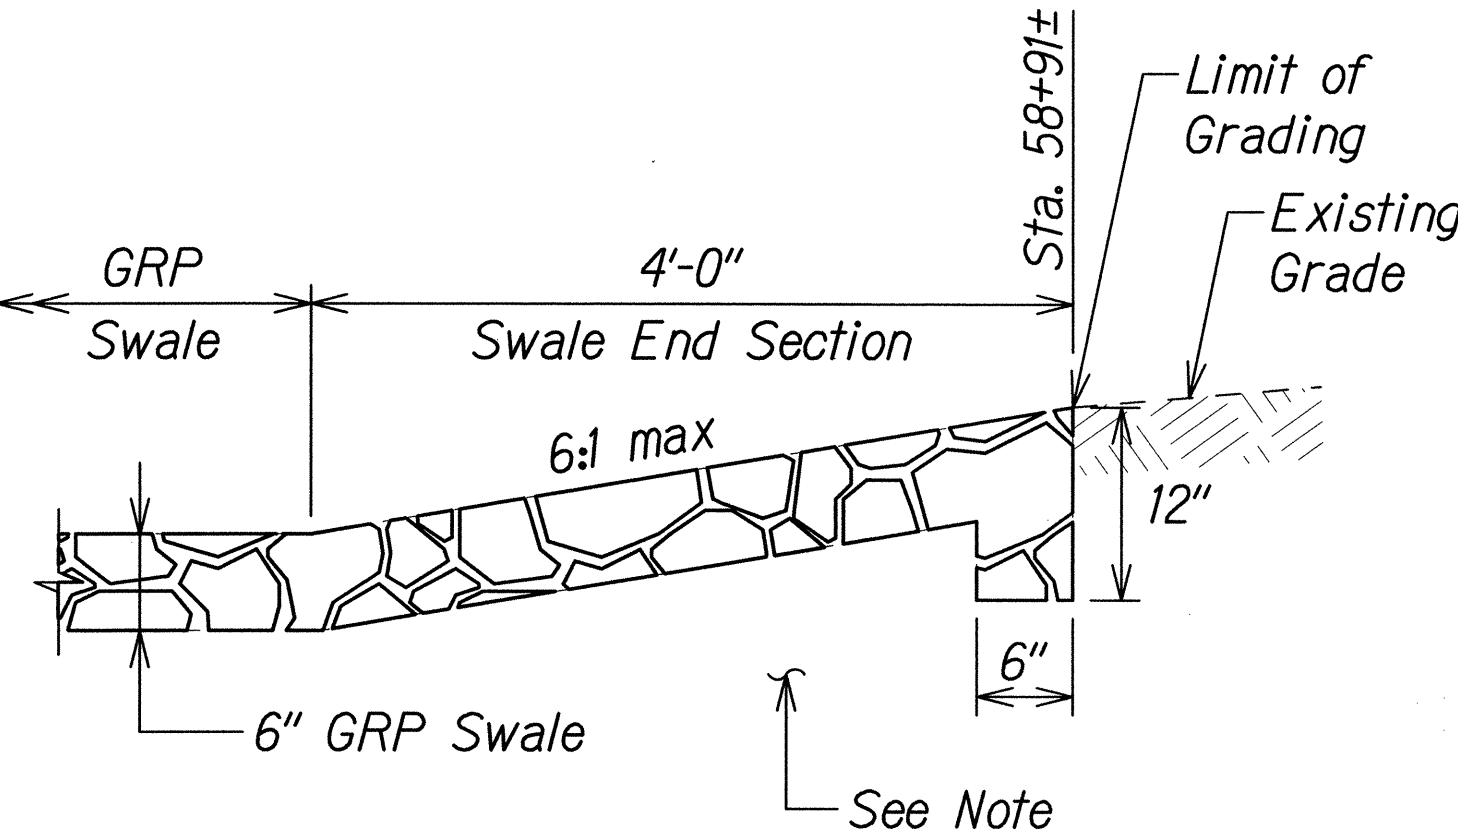

SECTION
GRP SWALE END
Scale: NTS

C
C2.5C2.6

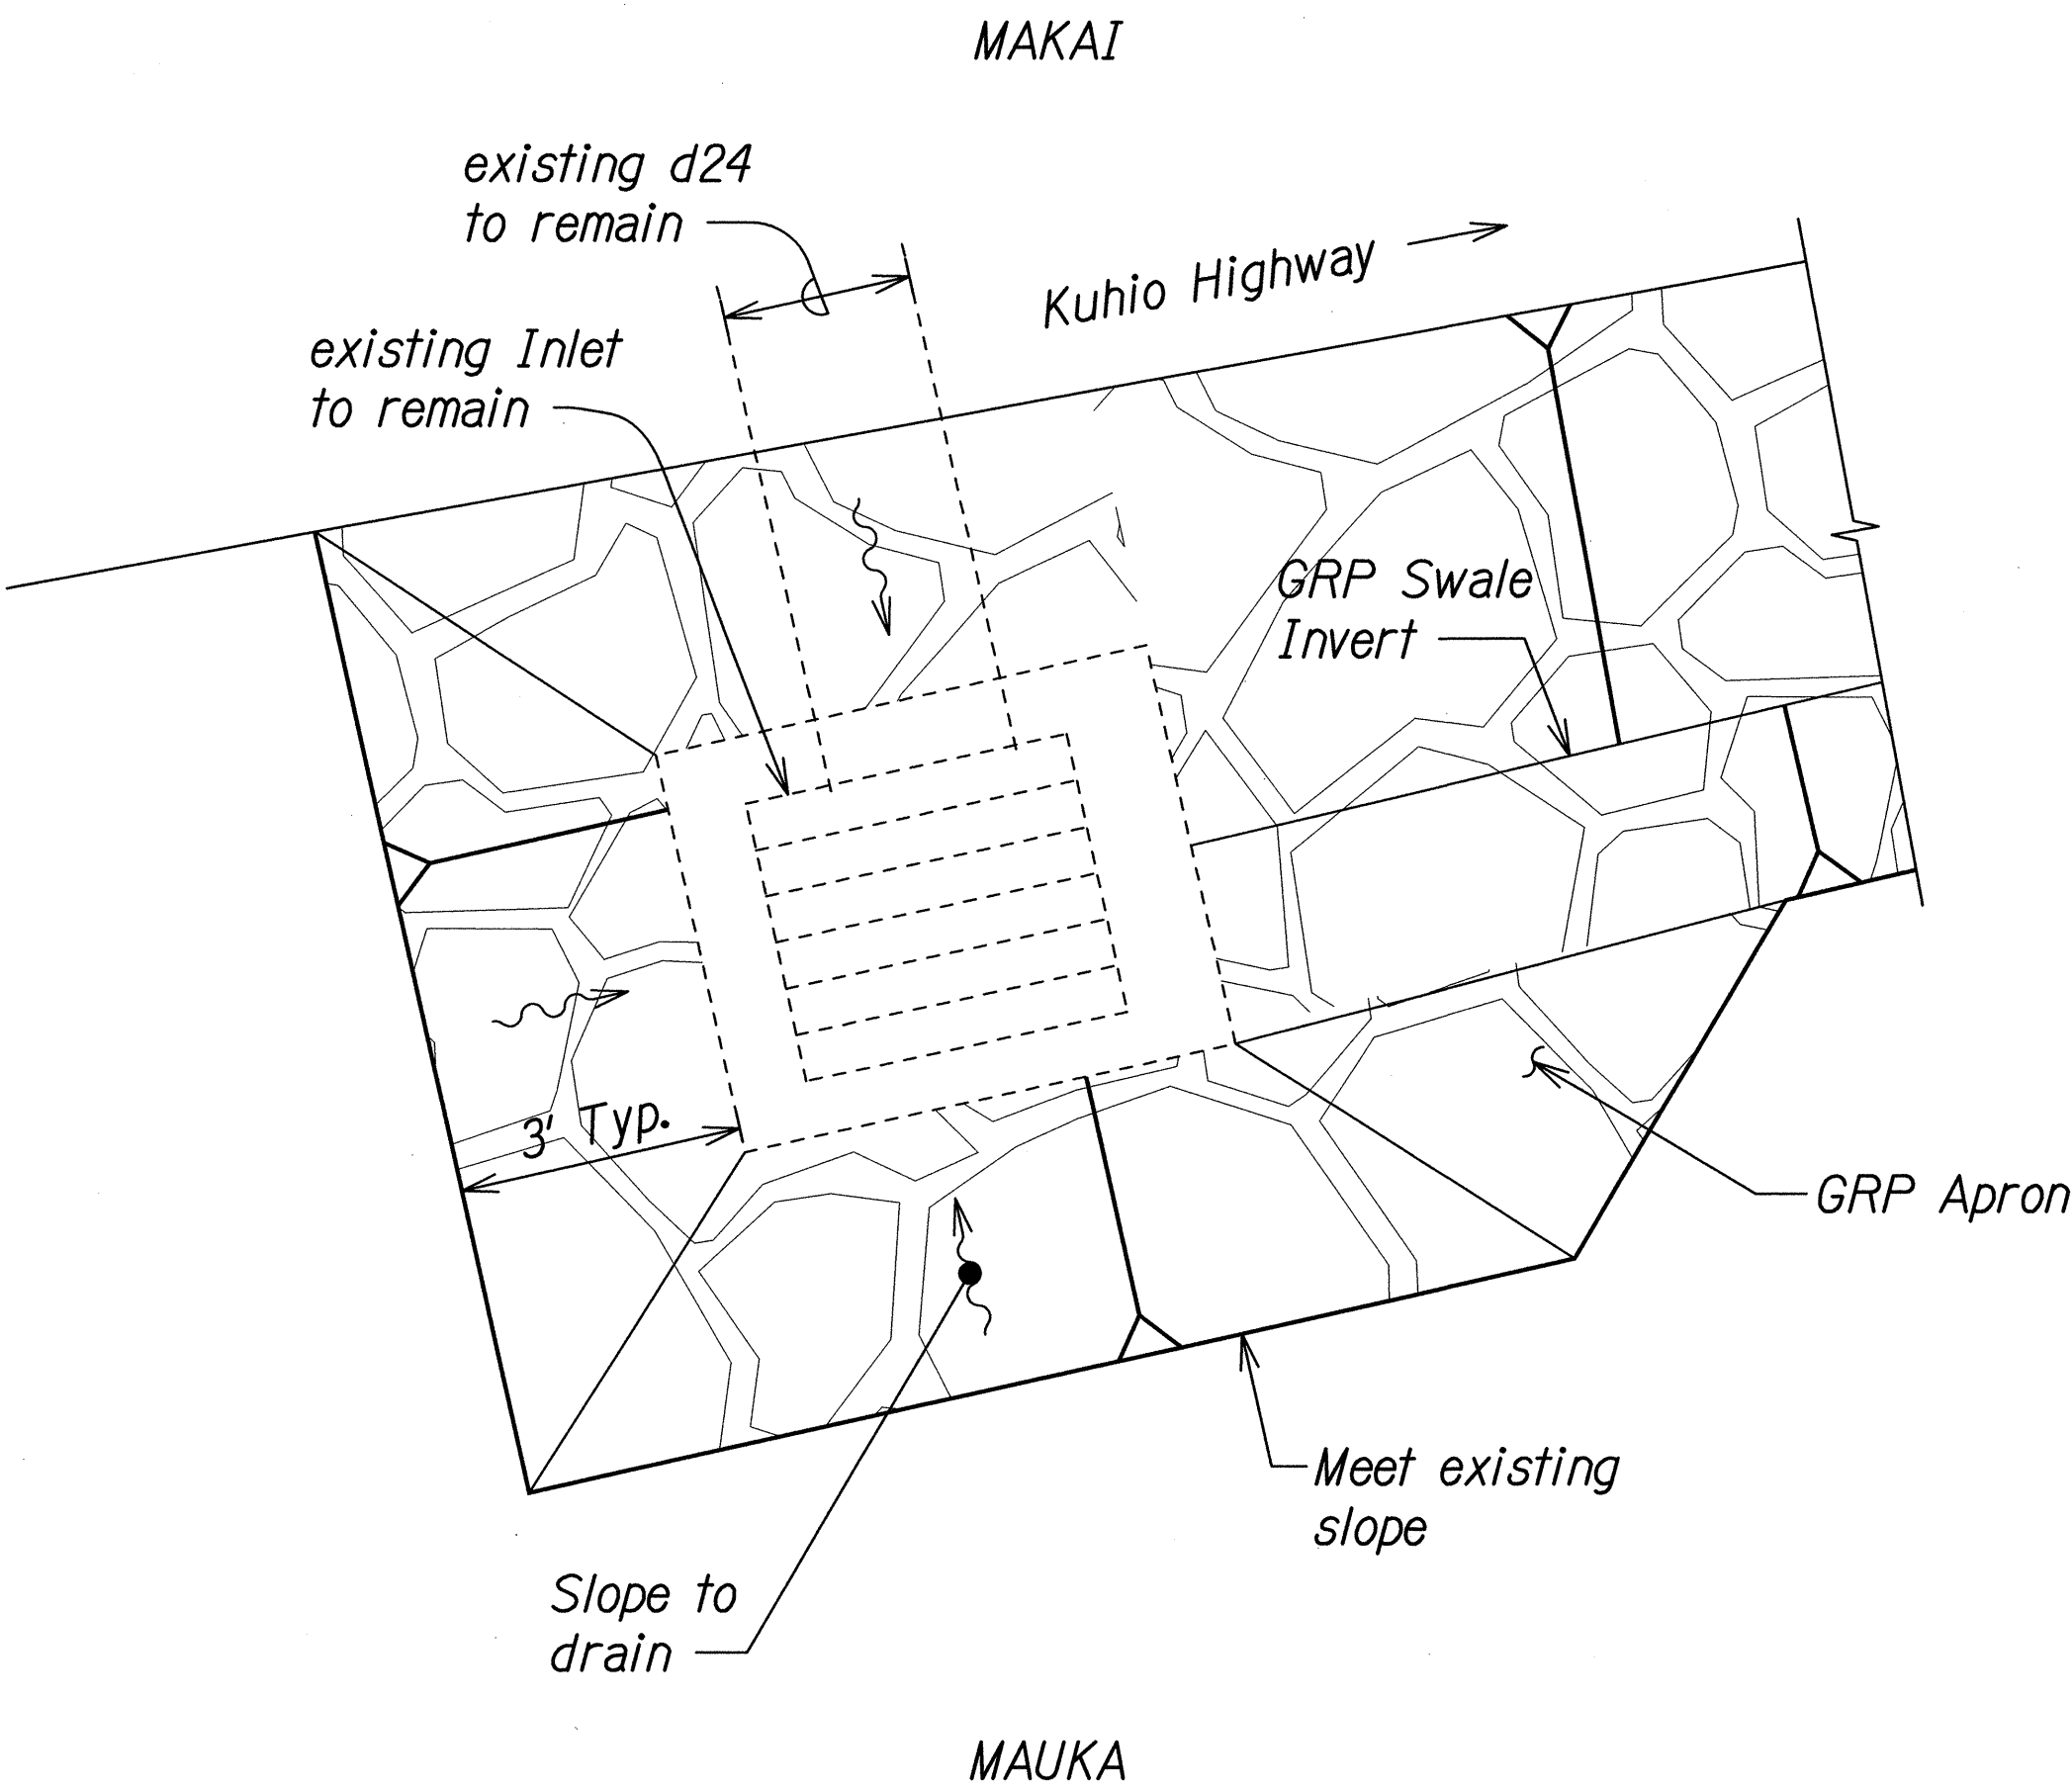

GRP APRON AT EXISTING GDI
Scale: NTS

SURVEY PLATTED BY	DATE
DRAWN BY	
CHECKED BY	
NOTED BY	
QUANTITIES BY	
CHECKED BY	
DATE	

T:\16524A Lumahai\Cadd\Phase 3 Emergency\Sheets\Section.dgn

THIS WORK WAS PREPARED BY ME OR UNDER MY SUPERVISION.

[Signature] 04/30/14
SIGNATURE EXPIRATION DATE OF THE LICENSE

STATE OF HAWAII
DEPARTMENT OF TRANSPORTATION
HIGHWAYS DIVISION

GRP SWALE DETAILS

KUHIO HIGHWAY (ROUTE 560)
EMERGENCY SLOPE STABILIZATION IN LUMAHA
IN THE VICINITY OF M.P. 5.1 TO 5.3
Fed. Aid Proj. No. ER-16(002)

Scale: NTS Date: Oct. 25, 2013