




FED. ROAD DIST. NO.	STATE	FED. AID PROJ. NO.	FISCAL YEAR	SHEET NO.	TOTAL SHEETS
HAWAII	HAW.	BR-0560(016)	2022	ADD. 28	34

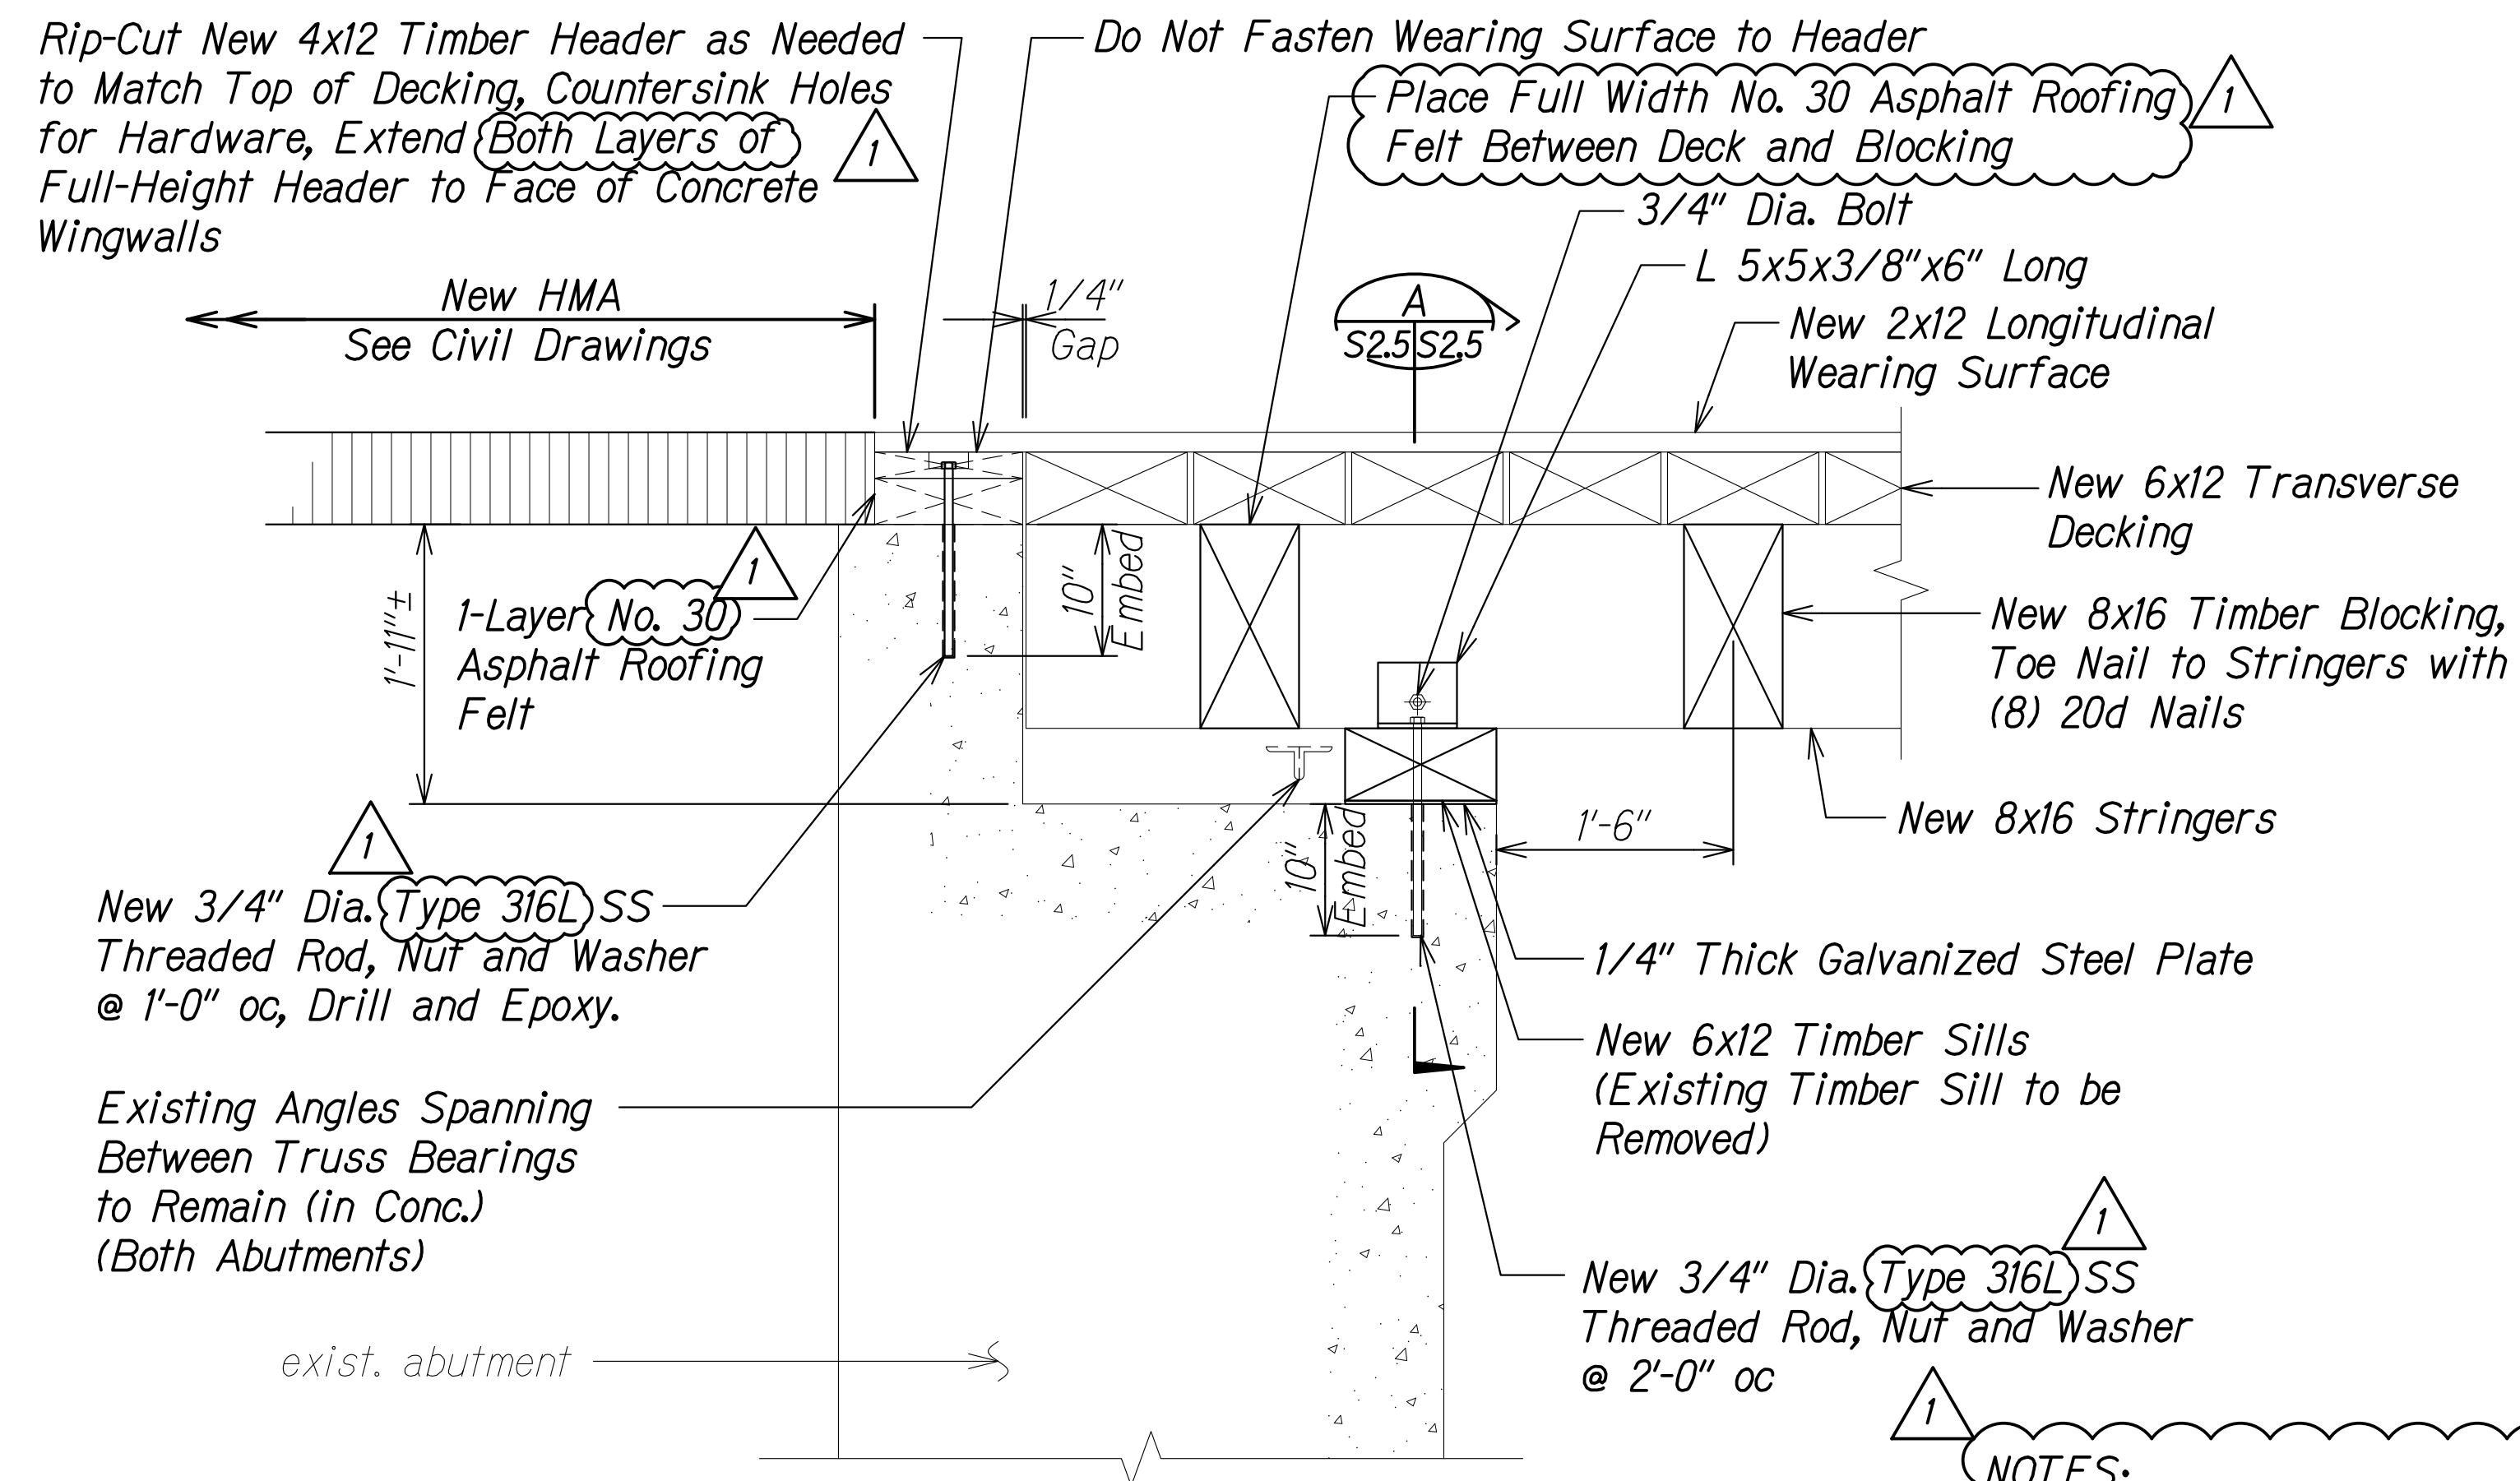


DECK DETAIL AT ABUTMENT (1) S2.5 S2.5
Scale: 1" = 1'-0"

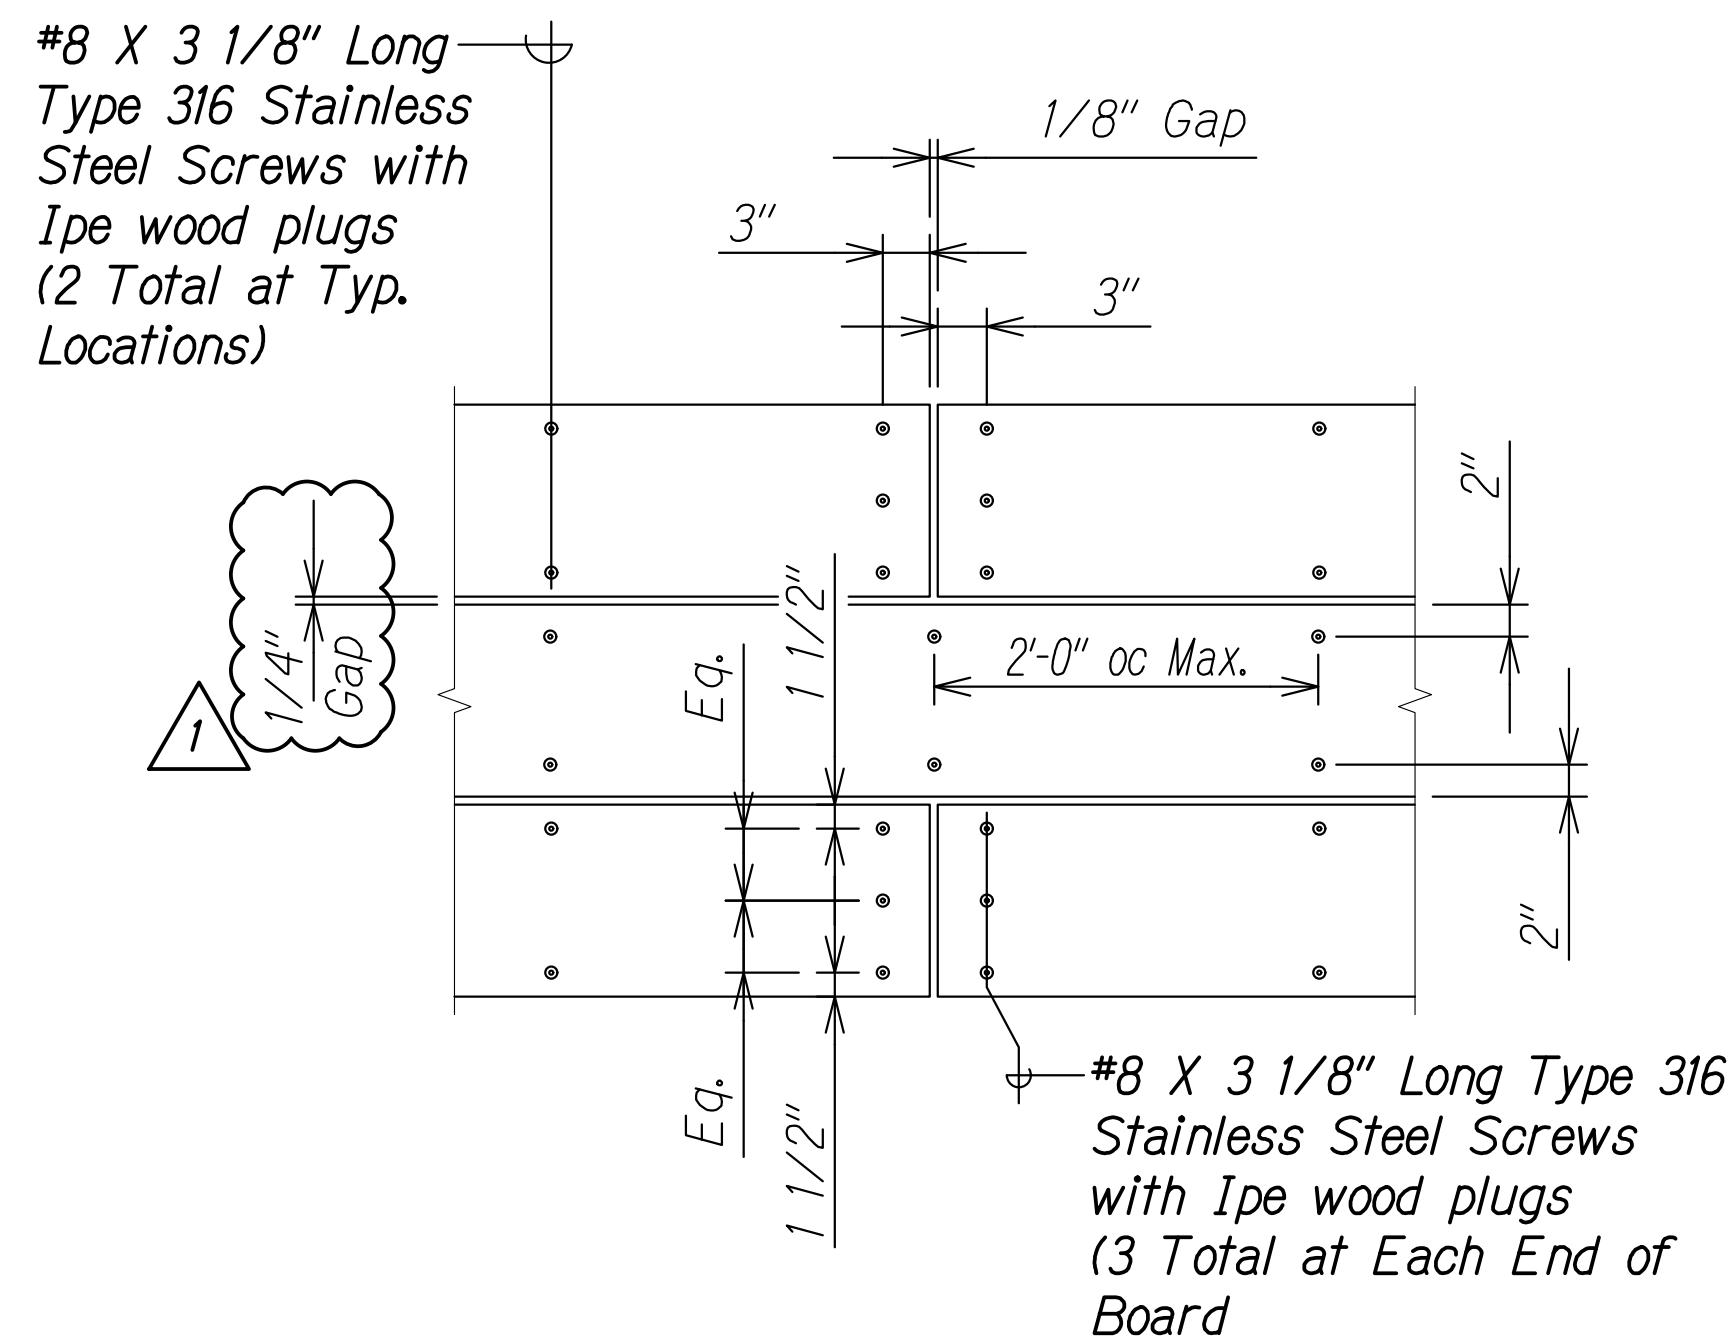


WEARING SURFACE FASTENING DETAIL (3) S2.5 S2.5
Scale: 1" = 1'-0"

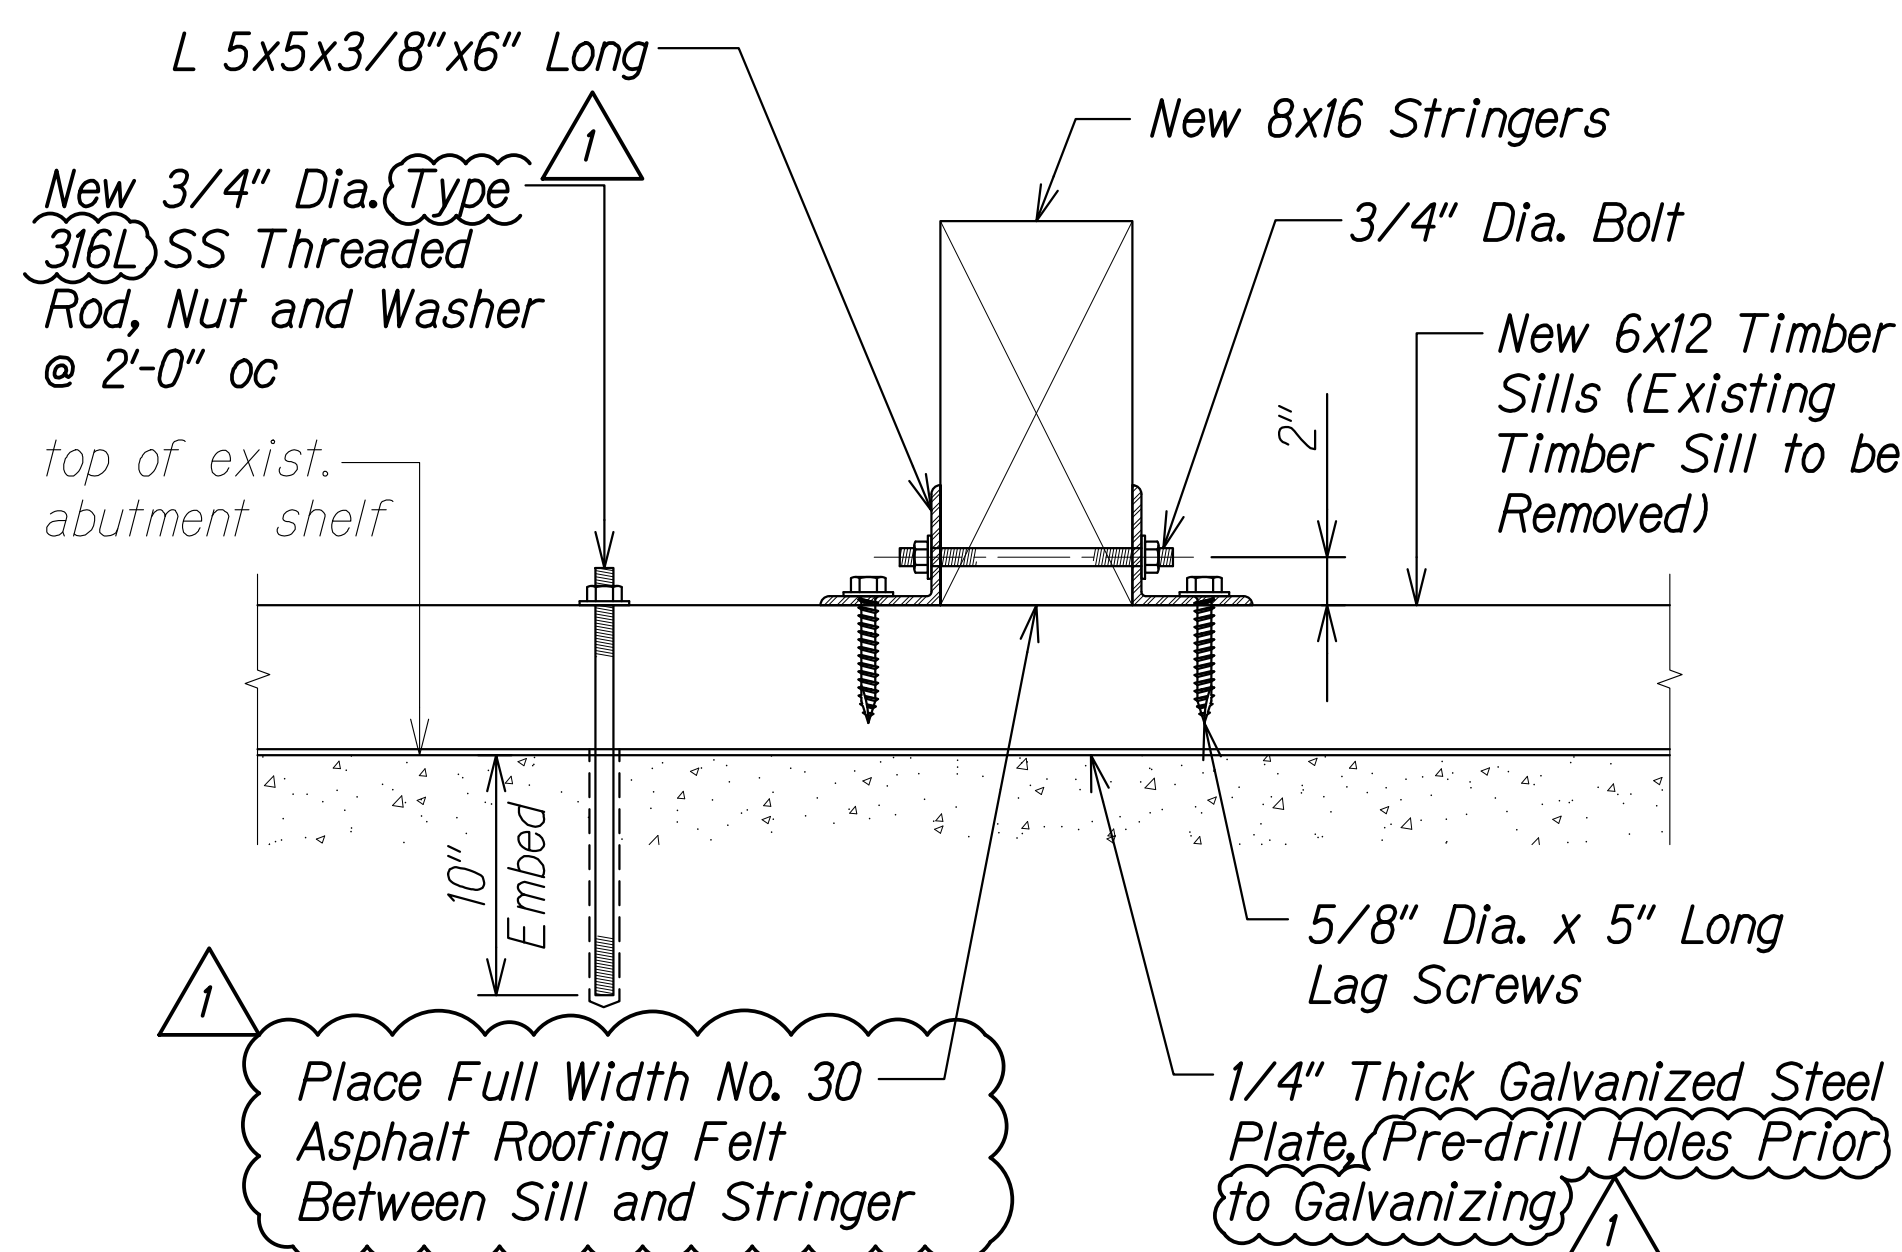


SECTION (A) S2.5 S2.5
Scale: 1 1/2" = 1'-0"

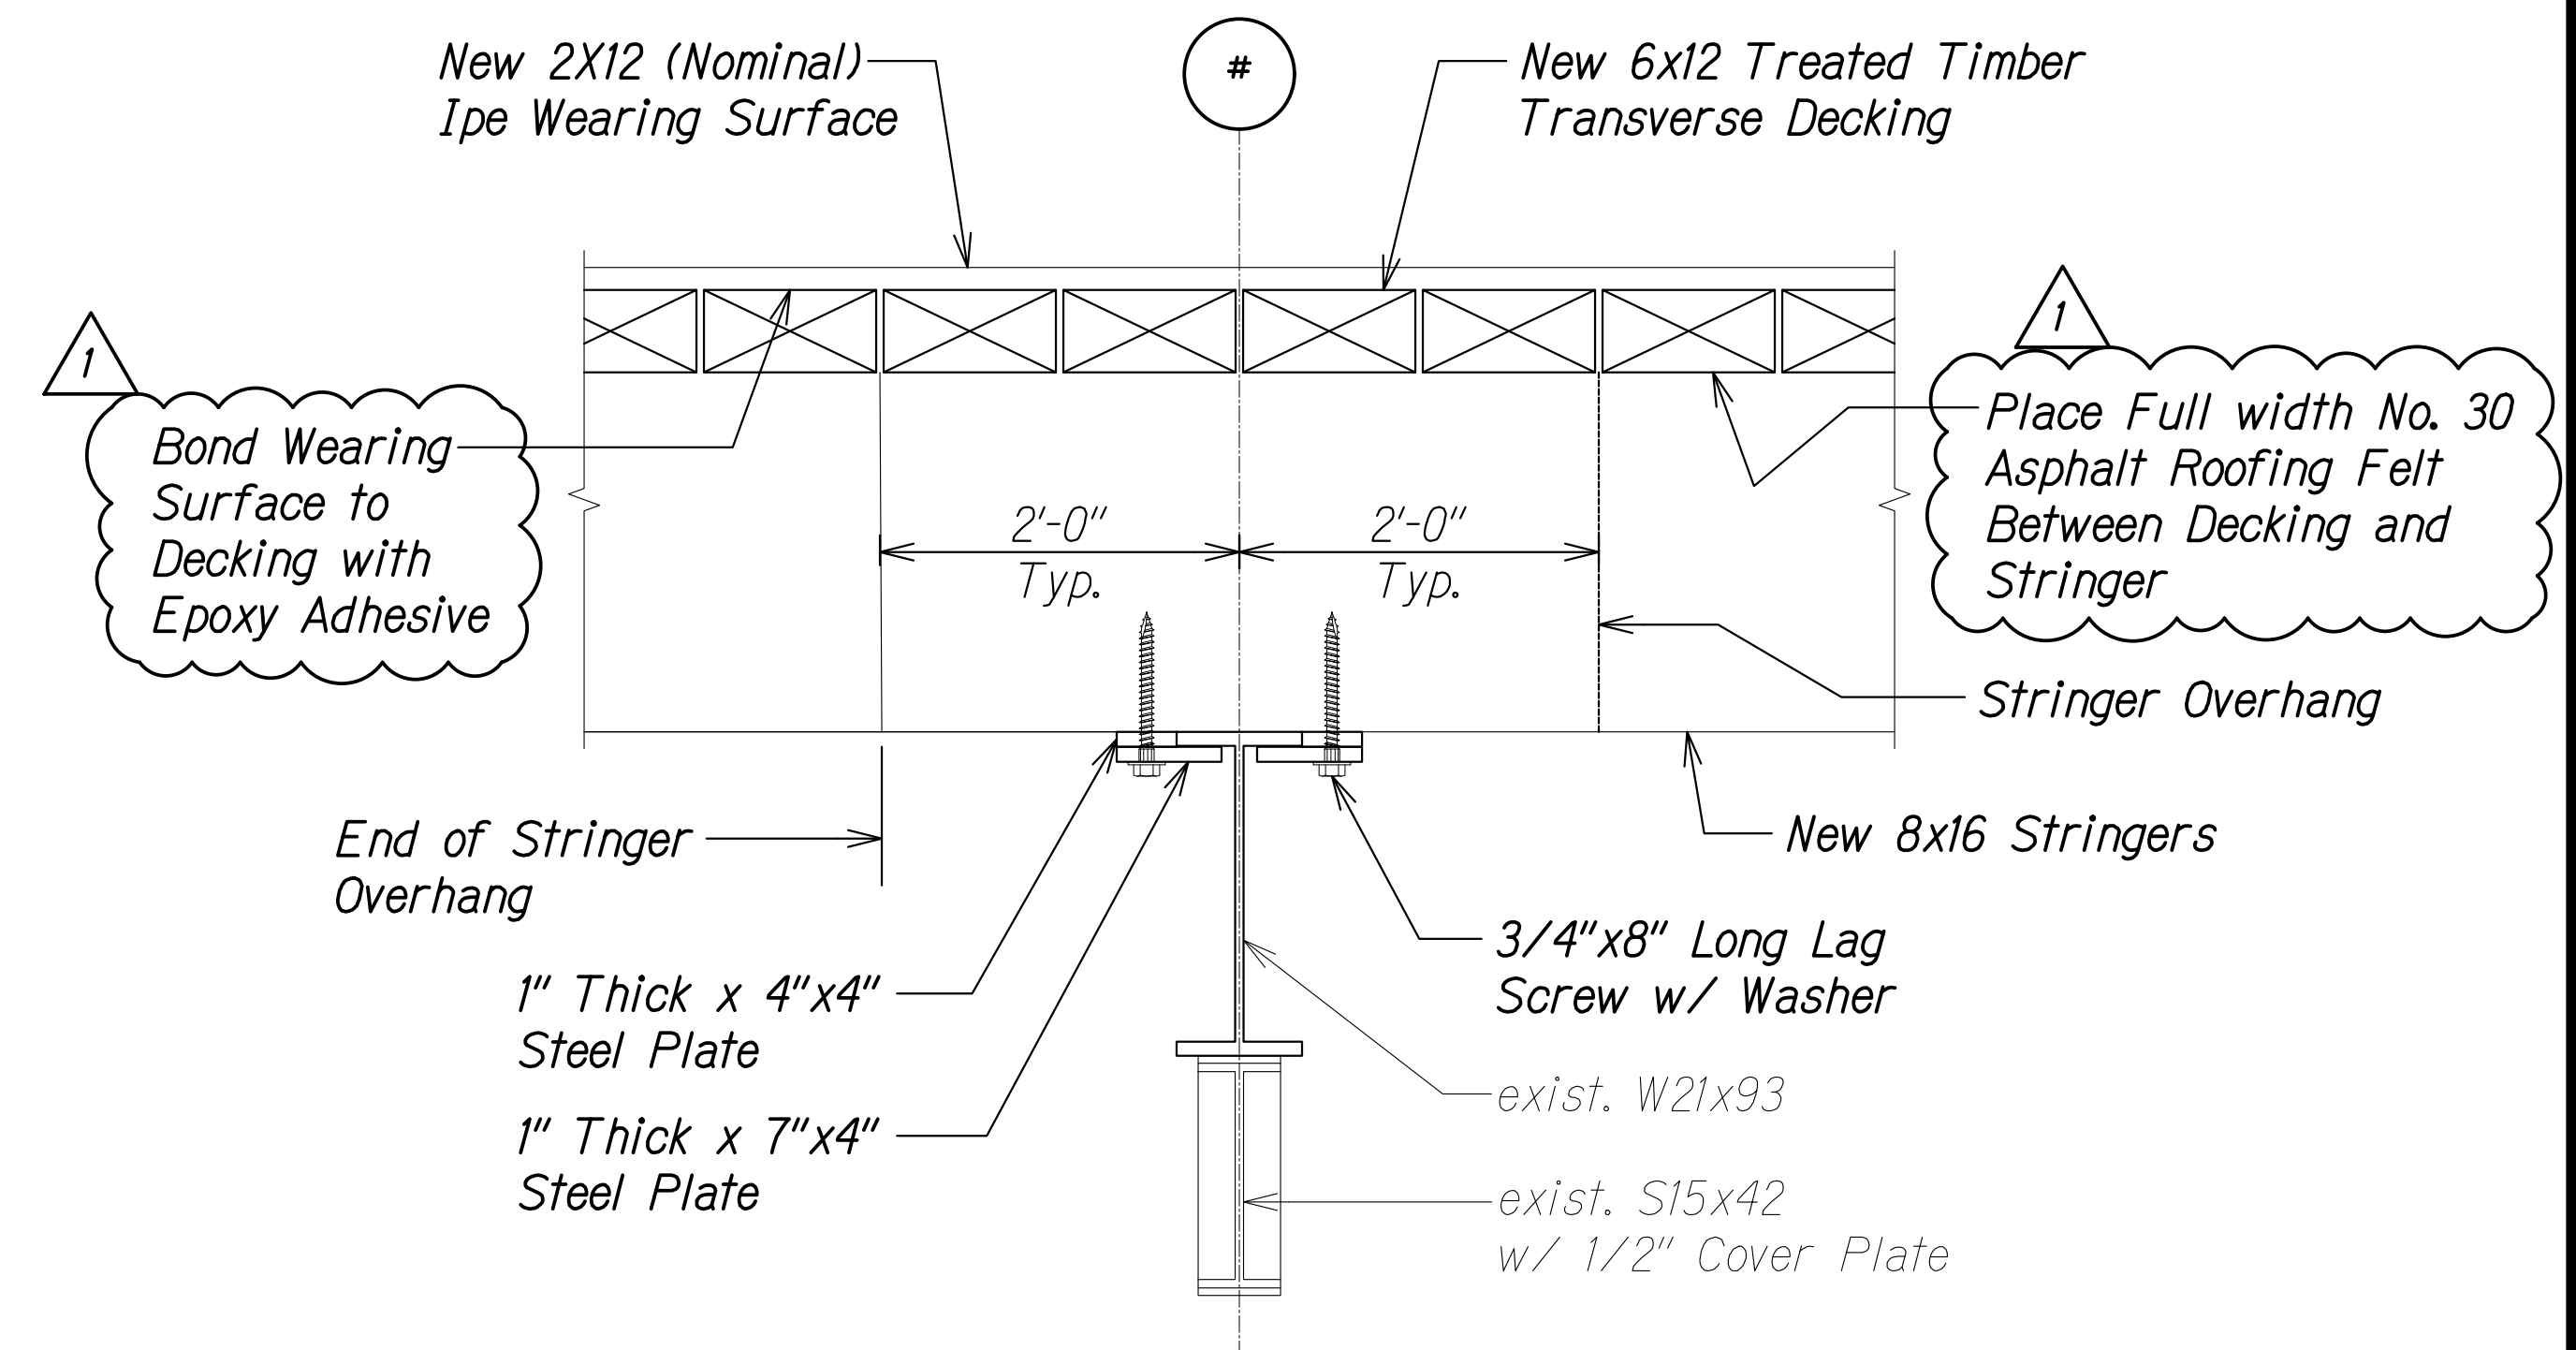

STRINGER KEEPER PLATE DETAIL (2) S2.5 S2.5
Scale: 1" = 1'-0"

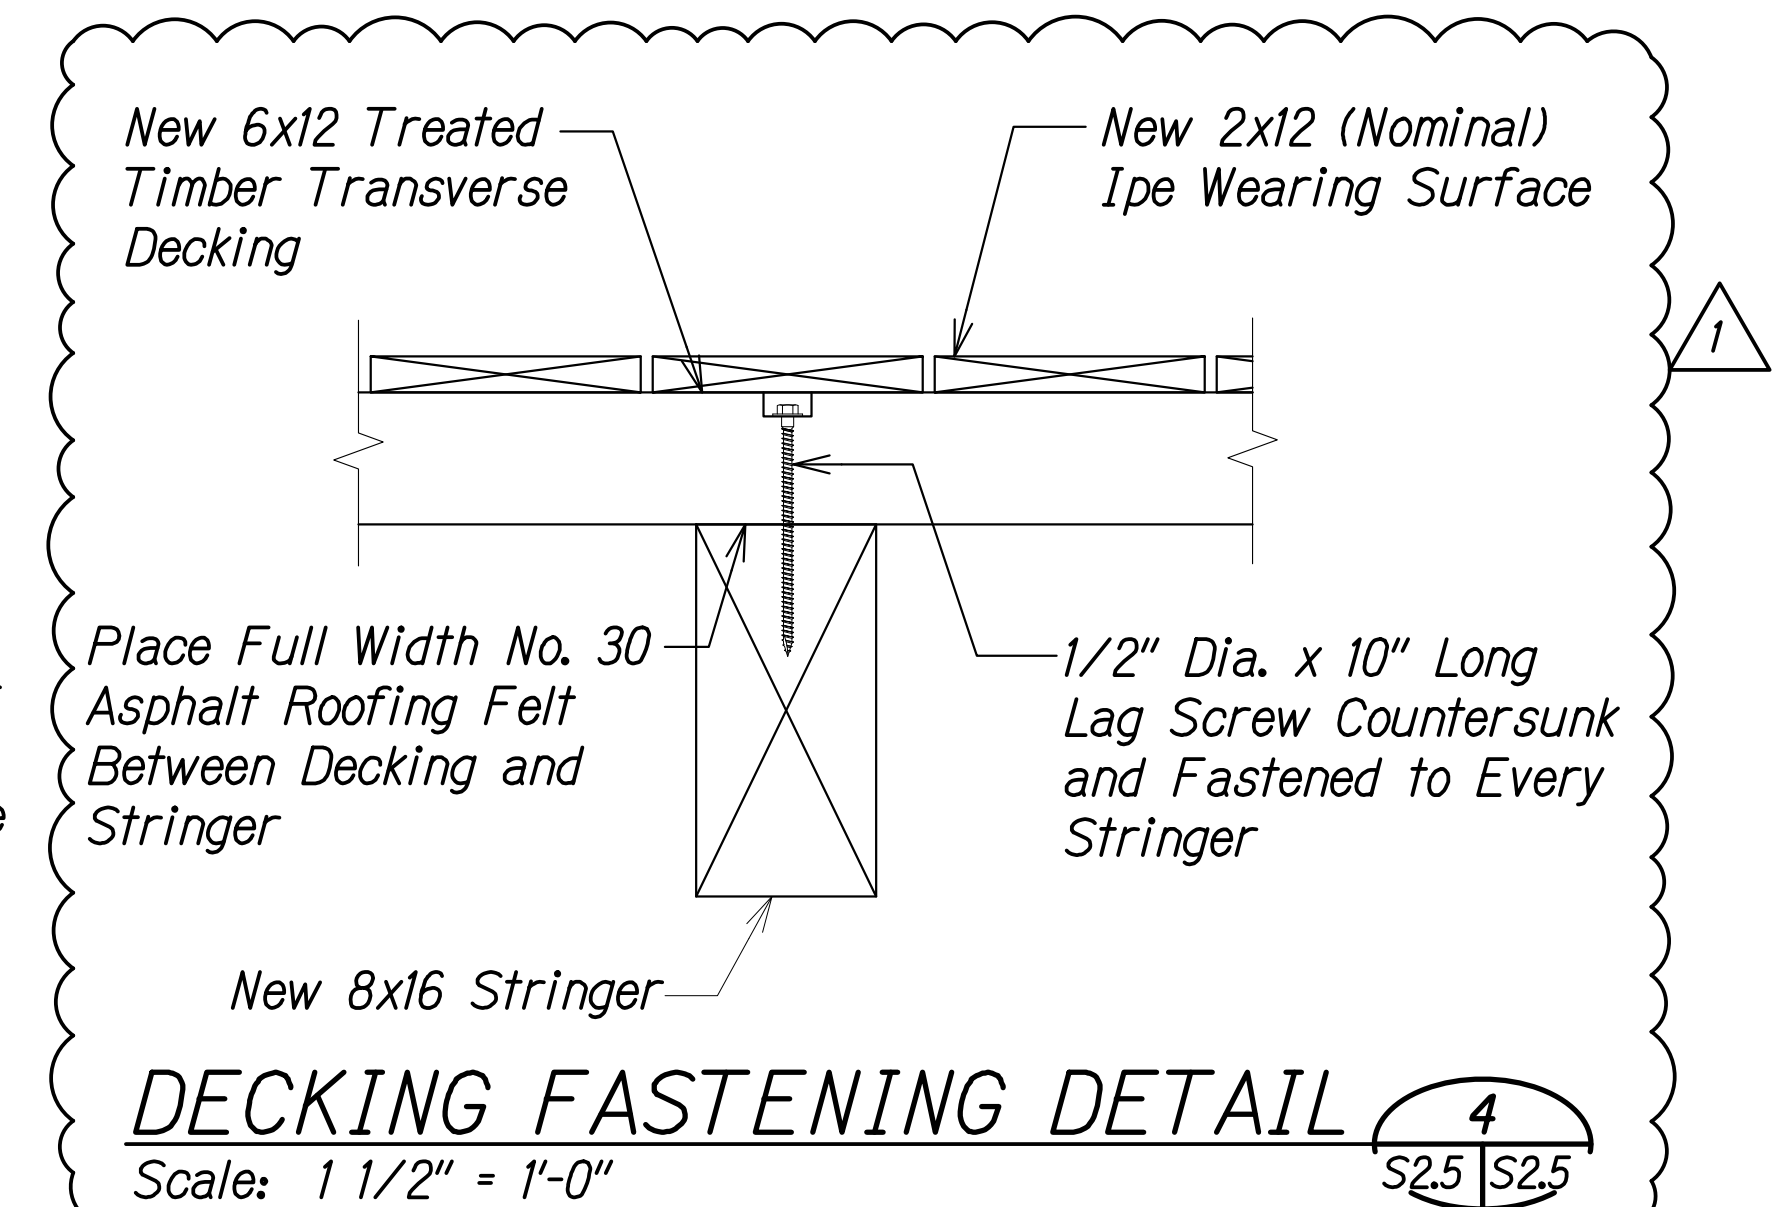

DECKING FASTENING DETAIL (4) S2.5 S2.5
Scale: 1 1/2" = 1'-0"

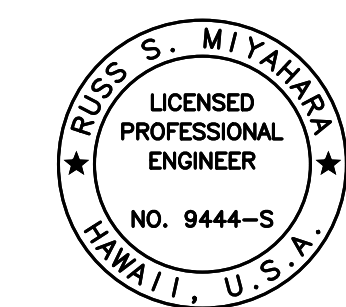

THIS WORK WAS PREPARED BY ME OR UNDER MY SUPERVISION.

SIGNATURE: *Russ S. Miyahara*
EXPIRATION DATE OF THE LICENSE: 12-31-24

STATE OF HAWAII
DEPARTMENT OF TRANSPORTATION
HIGHWAYS DIVISION

TYPICAL DETAILS AND SECTION

**KUHIO HIGHWAY
Hanalei Bridge Repair
FAP Proj. No. BR-0560(016)**

Scale: As Noted Date: July 2022

SHEET No. S2.5 OF 5 SHEETS