



FED. ROAD DIST. NO.	STATE	PROJ. NO.	FISCAL YEAR	SHEET NO.	TOTAL SHEETS
HAWAII	HAW.	560A-02-23M	2023	7	9

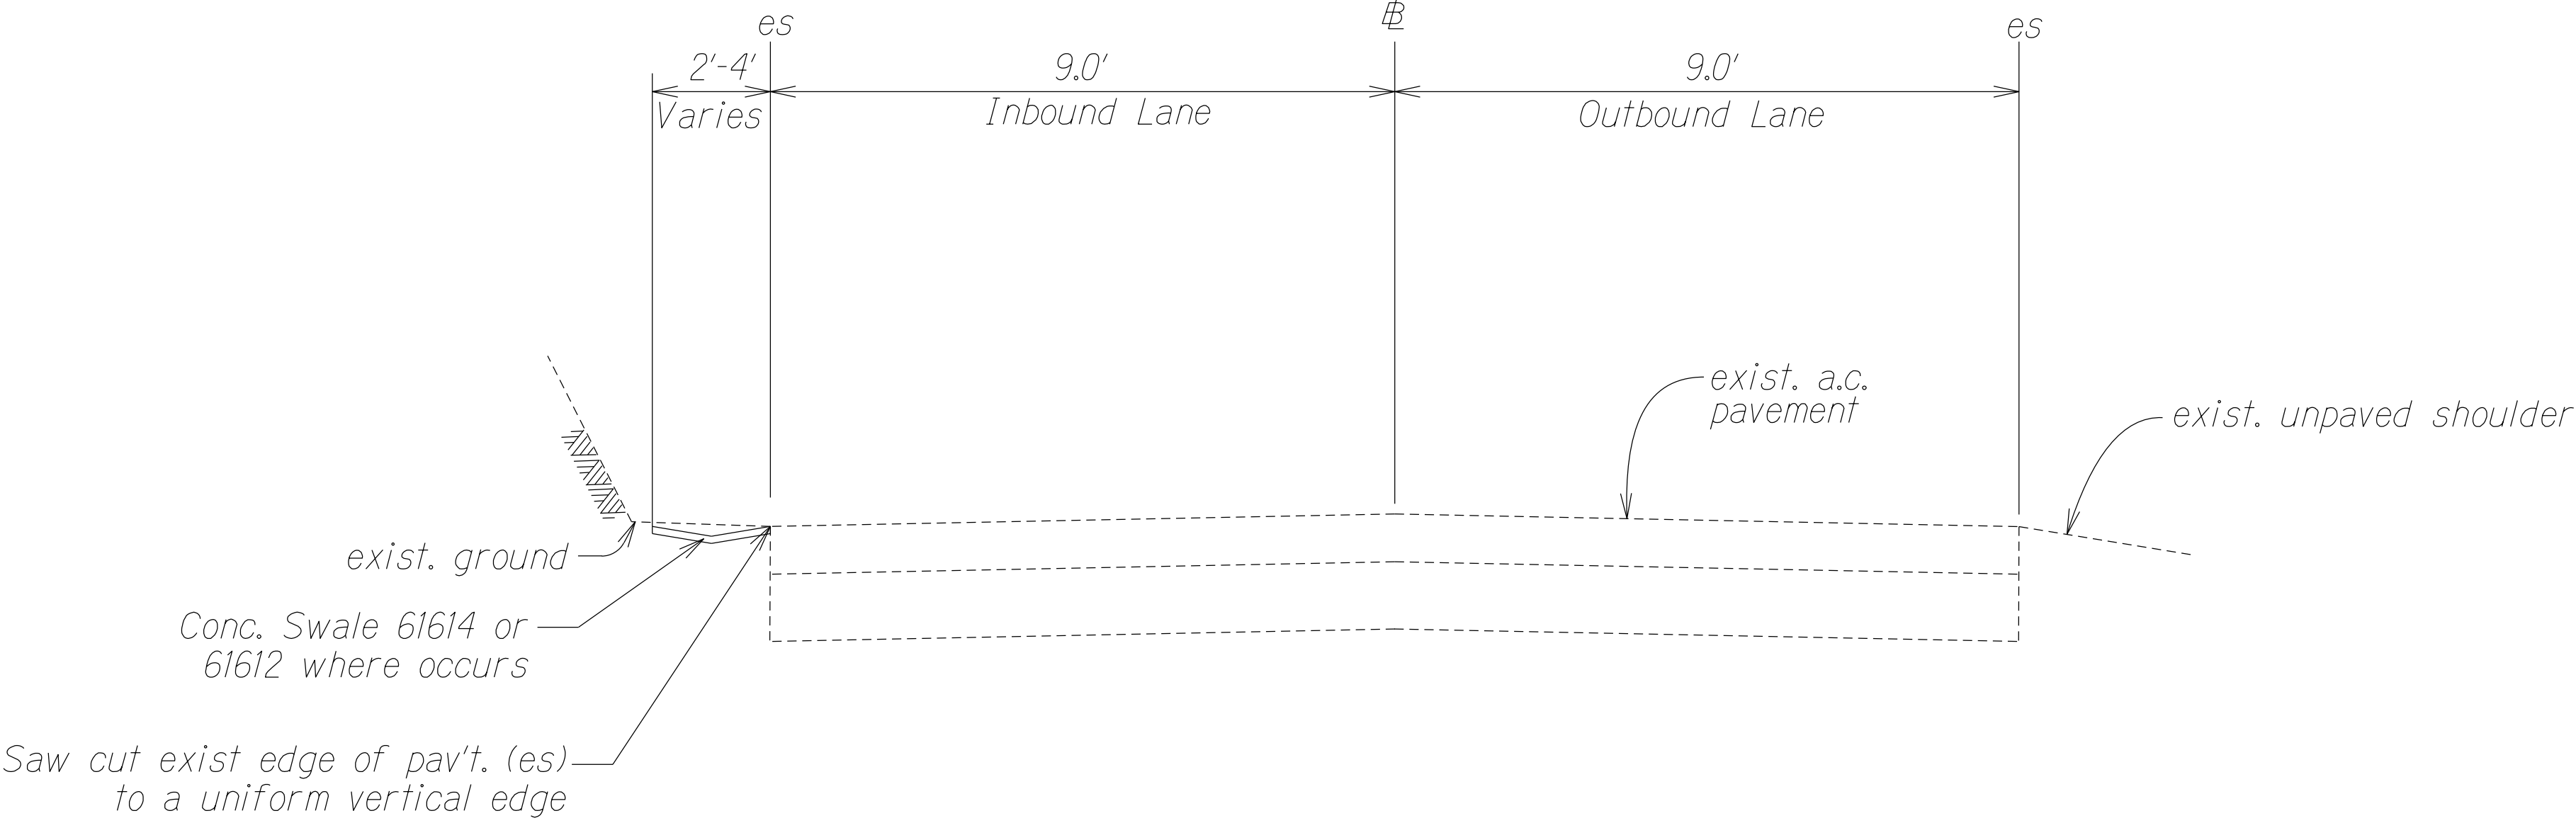

TYPICAL SECTION
Not to Scale

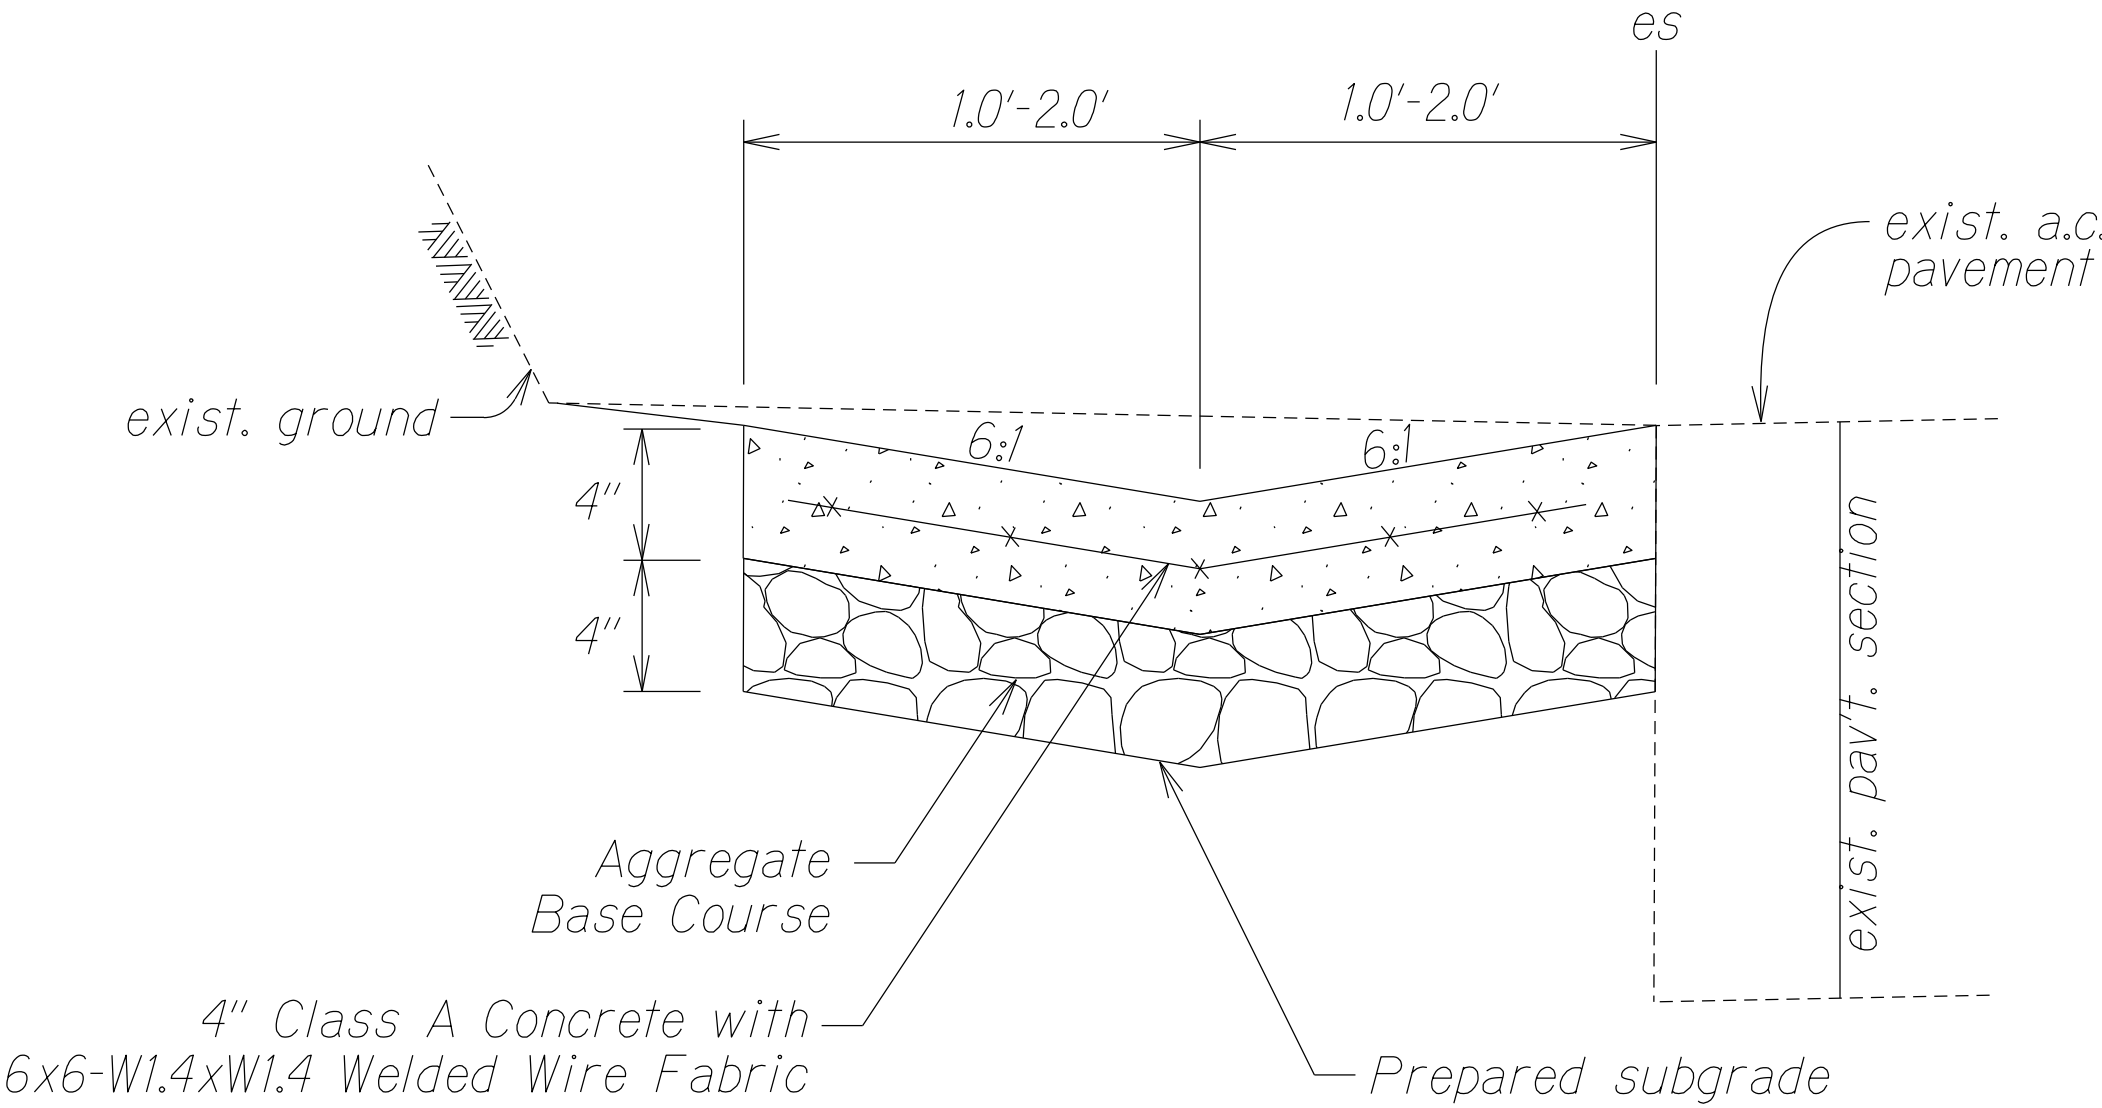

TYPICAL SECTION -61614
Not to Scale

STATE OF HAWAII
DEPARTMENT OF TRANSPORTATION
HIGHWAYS DIVISION

TYPICAL SECTIONS & DETAILS
KUHIO HIGHWAY (ROUTE 560)
DRAINAGE IMPROVEMENTS
Vicinity of Limahuli Garden
Project No. 560A-02-23M

Scale: Not to Scale Date: April 2023

SHEET No. 1 OF 1 SHEETS

ORIGINAL PLAN	SURVEY PLOTTED BY	DATE
NOTE BOOK	DRAWN BY	
N ^o	DESIGNED BY	
	CHECKED BY	