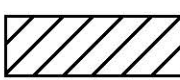
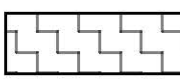
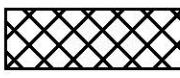
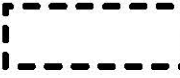
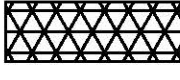
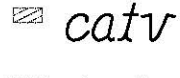
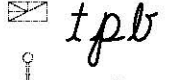
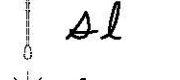
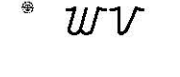
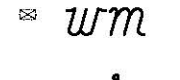
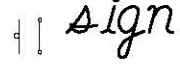
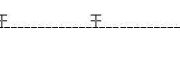
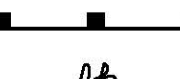
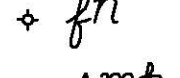
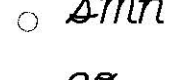
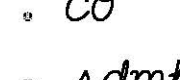
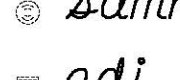
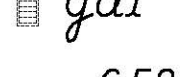
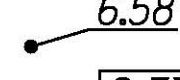
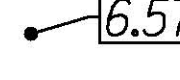


GENERAL NOTES (Cont.):

26. The exact locations and limits or areas to be excavated, reconstructed and cold planed shall be determined in the field by the Engineer.
27. All asphalt concrete materials from cold planing, reconstruction and roadway excavation operations shall become property of the Contractor. The Contractor shall remove and dispose these materials and shall be considered incidental to various contract items. The Contractor shall provide the Solid Waste Disclosure notice to the HDOT Engineer.
28. At the end of each day's paving operations, temporary pavement markers and striping shall be in place prior to leaving the site.
29. After completion of resurfacing, the Contractor and the Engineer will test for and determine ponding areas (i.e. low spots within the resurfaced area). It shall be the responsibility of the Contractor to correct and resurface and/or repair all such ponding areas at no cost to the State.
30. Removal and disposal of asphalt concrete curb, concrete curb, sidewalk, traffic signs, pavement marking and striping shall be considered incidental to various contract items and shall not be paid for separately.
31. Furnishing and installation of reinforcing bars, epoxy grout, premolded joint filler with sealant and bed course materials shall be considered incidental to Item 634.0100 - Portland Cement Concrete Sidewalk and shall not be paid for separately.
32. All existing Rectangular Rapid-Flashing Beacon (RRFB) assemblies in the project limits shall be removed and returned to the State Highways Division.
33. After completion of the work, the Contractor shall submit the complete set of "as-built" plans to the Engineer.
34. All new guardrail shall be Manual for Assessing Safety Hardware (MASH) compliant unless noted otherwise
35. Guardrail Paint:
- a. Contractor shall shop coat all members. Field coating shall be for existing guardrail and post, and of touch up only. 
- b. Color for top coat shall be brown color as approved by the Engineer. Intermediate coat shall have a contrasting light color. Finish top coat shall not be gloss or high gloss.
- c. See special coating options in the schedule below.

LEGEND:

-  New PMA Pavement Areas
-  Demolished & Removed A.C. Pavement Areas
-  Pavement Reconstruction Areas
-  Cold-Planing & Resurfacing Limits
-  HFST Application Areas
-  New Conc. Pedestrian Path
-  Existing Utility Pole
-  Existing Electrical Pullbox
-  Existing Cable/TV Pullbox
-  Existing Telephone Pullbox
-  Existing Street Light
-  Existing Lamp Pole
-  Existing Water Valve Box
-  Existing Water Meter Box
-  Existing Traffic Sign
-  New Traffic Sign
-  New Reflective Marker (RM-3) w/ Post
-  New Object Marker (OM2-2H)
-  Existing Metal Guardrail
-  New Metal Guardrail
-  Existing Fire Hydrant
-  Existing Sewer Manhole
-  Existing Sewer Cleanout
-  Existing Storm Drain Manhole
-  Existing Grated Drop Inlet
-  Existing Ground Elevation
-  Finished Grade Elevation

ABBREVIATIONS:


- AC ASPHALT CONCRETE
- ACB HOT MIX ASPHALT-TREATED BASE COURSE
- ADA AMERICANS WITH DISABILITIES ACT
- ARV AIR RELEASE VALVE
- AVE AVENUE
- # BASELINE
- BC BOTTOM CURB
- BFP BACK FLOW PREVENTER
- BMP BEST MANAGEMENT PRACTICES
- BW BOTTOM WALL
- ¢ CENTERLINE
- CATV CABLE/TELEVISION
- CB CATCH BASIN
- CD CONDUIT
- CLF CHAIN LINK FENCE
- CMU CONCRETE MASONRY UNIT
- CONC CONCRETE
- CRM CONCRETE RUBBLE MASONRY
- CY CUBIC YARD
- D DIAMETER OR DRAIN
- DI DRAIN INLET
- DOT STATE OF HAWAII DEPARTMENT OF TRANSPORTATION
- DS DOWN SPOUT
- ELEC ELECTRIC
- ELEV ELEVATION
- ep EXISTING EDGE OF PAVEMENT
- EP NEW EDGE OF PAVEMENT
- es EXISTING EDGE OF SHOULDER
- ES NEW EDGE OF SHOULDER
- FH FIRE HYDRANT
- GDI GRATED DROP INLET
- GW GUY WIRE
- H HEIGHT
- HFST HIGH FRICTION SURFACE TREATMENT
- HMA HOT MIX ASPHALT
- HWY HIGHWAY
- ICV IRRIGATION CONTROL VALVE
- INV INVERT
- LF LINEAR FEET
- LP LAMP POLE
- Lt. LEFT
- MASH MANUAL FOR ASSESSING SAFETY HARDWARE
- MH MANHOLE
- NTS NOT TO SCALE
- O/H OVERHEAD ELECTRICAL
- o/s OFFSET
- OM OBJECT MARKER
- PBX PANEL BOX
- PCCP PORTLAND CEMENT CONCRETE PAVEMENT
- PMA POLYMER-MODIFIED ASPHALT PAVEMENT
- PVMT PAVEMENT
- R RADIUS
- RD ROAD
- REF REFLECTOR
- RM REFLECTOR MARKER
- RPM RAISED PAVEMENT MARKING
- RRFB RECTANGULAR RAPID FLASHING BEACON
- Rt. RIGHT
- R/W RIGHT-OF-WAY
- SDMH STORM DRAIN MANHOLE
- S.E. SUPERELEVATION
- SF SQUARE FEET
- SHT SHEET
- SL STREET LIGHT
- SPR SPRINKLER
- SR STATE ROUTE
- ST STREET
- STA. STATION
- STD STANDARD
- T TANGENT
- TC TOP CURB
- TEL TELEPHONE
- TP TOP PIPE
- TS TOP STEM
- TW TOP WALL
- TYP. TYPICAL
- U/G UNDERGROUND
- UP UTILITY POLE
- W WATER
- WM WATER METER
- WV WATER VALVE

FED. ROAD DIST. NO.	STATE	FED. AID PROJ. NO.	FISCAL YEAR	SHEET NO.	TOTAL SHEETS
HAWAII	HAW.	STP-0560(017)	2023	ADD. 4	92

SURVEY PLOTTED BY	DATE
DRAWN BY	
DESIGNED BY	
QUANTITIES BY	
CHECKED BY	
ORIGINAL PLAN	
NOTE BOOK	
NO.	


SPECIAL COATING SCHEDULE FOR ZINC COATED METAL BEAMS AND POSTS				
	Option #1	Option #2	Option #3	Option #4
Preparation	Carboline Thinner #2 or Surface Cleaner #3 per SSPC-SP1, Apply Rustbound Penetrating Sealer	Solvent Clean per SSPC-SP1, Apply Sealer 513-V-110	Solvent Clean per SSPC-SP1 and as Recommended by the Manufacturer	Solvent Clean per SSPC-SP1, Apply Galvaprep Zinc Treatment
1st Coat:	Carboline 890 Epoxy DFT 5 mil (min.) WFT 7 mil (min.)	Valspar VyGuard V75 Epoxy DFT 5 mil (min.) WFT 7 mil (min.)	Sherman Williams Tile Clad High Solids B62 Series DFT 4 mil (min.) WFT 7 mil (min.)	PPG Amerlock 600 Epoxy  DFT 5 mil (min.) WFT 8 mil (min.)
Re-Coating Time:	8 Hrs. (min.) 2 Days (min.)	36 Hrs. (min.) 14 Days (min.)	8 Hrs. (min.) 10 Days (min.)	8 Hrs. (min.) 4 Days (min.) 
Top Coat:	Carboline 133HB Alyphatic Polyurethane DFT 5 mil (min.) WFT 7 mil (min.)	Valspar VyGuard V41 Series DFT 4 mil (min.) WFT 7 mil (min.)	Sherman Williams Corothane II B65 W200 Series / B60V2 DFT 4 mil (min.) WFT 7 mil (min.)	PPG Pitthane Ultra LS  Polyurethane DFT 4 mil (min.) WFT 7 mil (min.)

10/12/23	 - Revised Paint Notes
DATE	REVISION

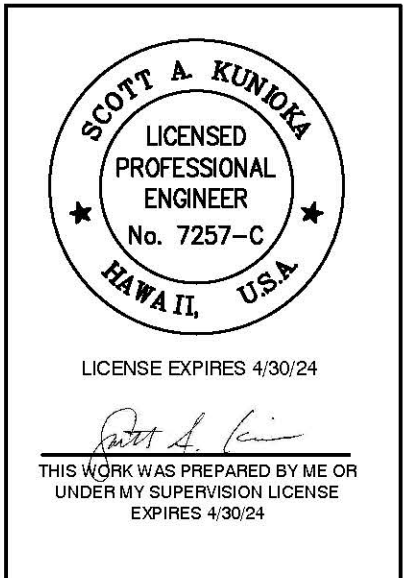


STATE OF HAWAII DEPARTMENT OF TRANSPORTATION HIGHWAYS DIVISION	
GENERAL NOTES, LEGEND & ABBREVIATIONS	
KUHIO HIGHWAY RESURFACING AND SAFETY IMPROVEMENTS	
Route 560 M.P. 0.0 to M.P. 4.5	
Fed. Aid Proj. No. STP-0560(017)	
Scale: None	Date: July, 2023
SHEET No. N-3A OF 6 SHEETS	

FED. ROAD DIST. NO.	STATE	FED. AID PROJ. NO.	FISCAL YEAR	SHEET NO.	TOTAL SHEETS
HAWAII	HAW.	STP-0560(017)	2023	ADD.26	92

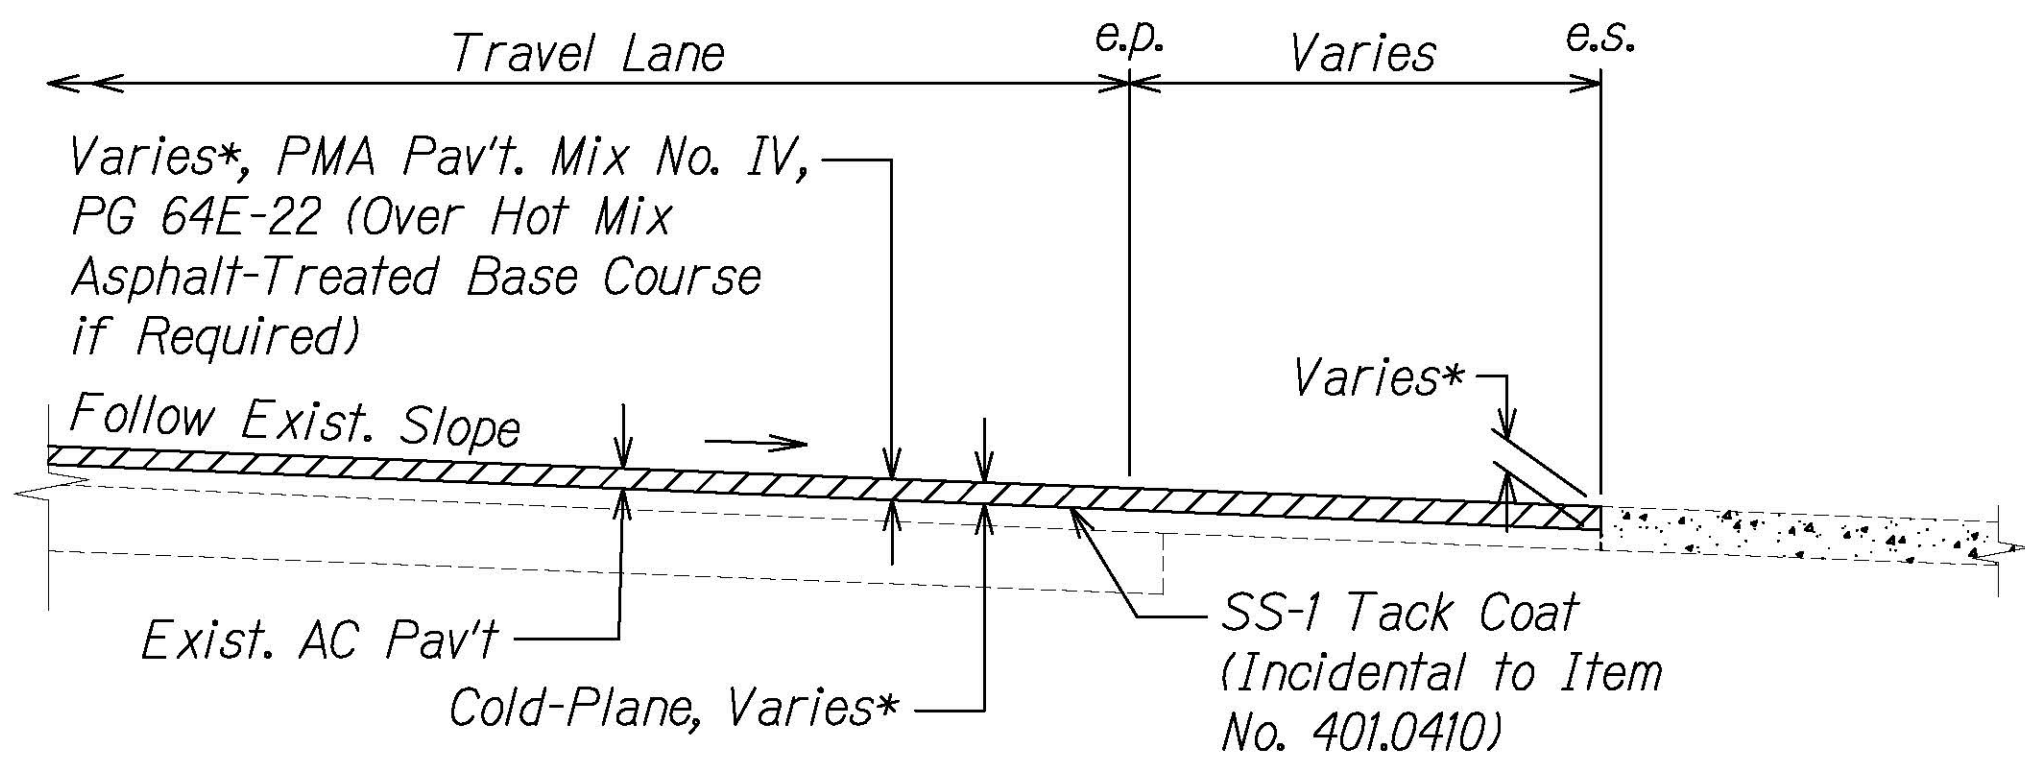


*See Table 1 on Sht R-1 for Cold Plane, Base Course, and Top Coat Depths and Materials.

RESURFACING AT CONCRETE DRIVEWAYS
Not to Scale

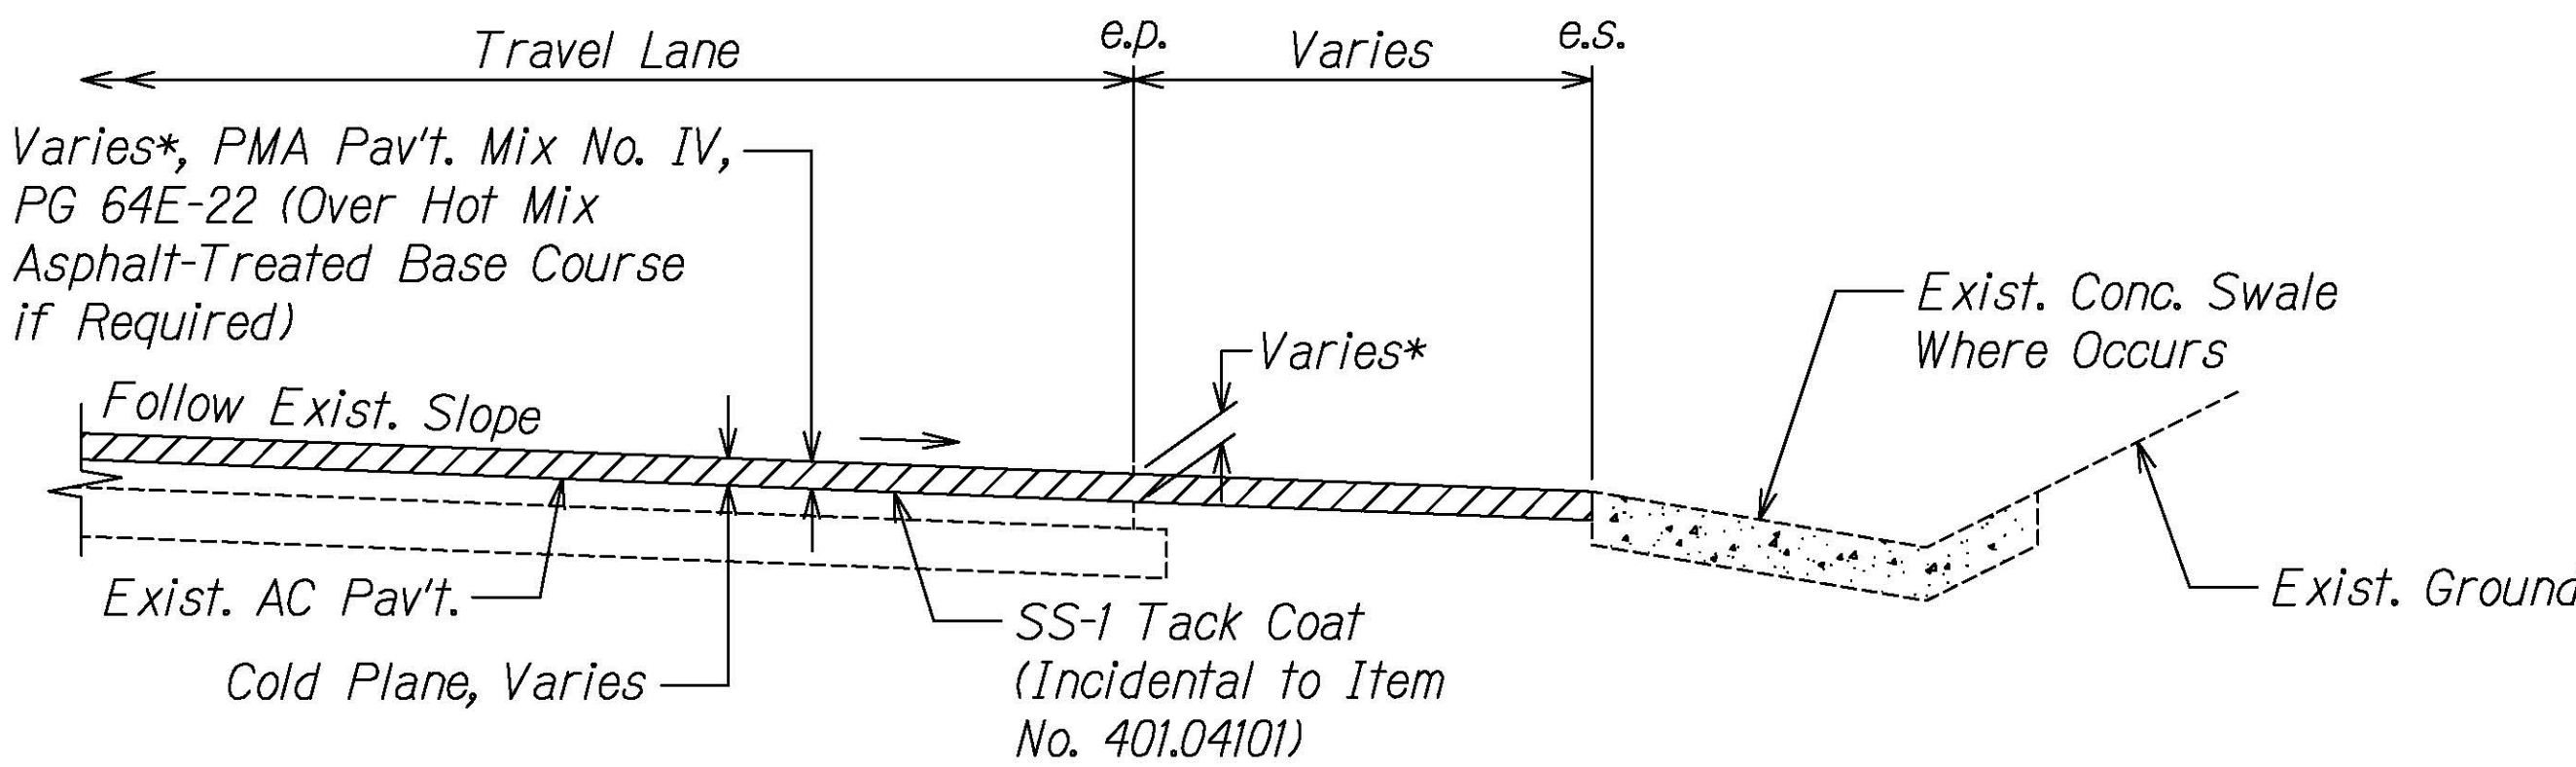


*See Table 1 on Sht R-1 for Cold Plane, Base Course, and Top Coat Depths and Materials.

RESURFACING AT CONCRETE OR ASPHALT SWALE
Not to Scale

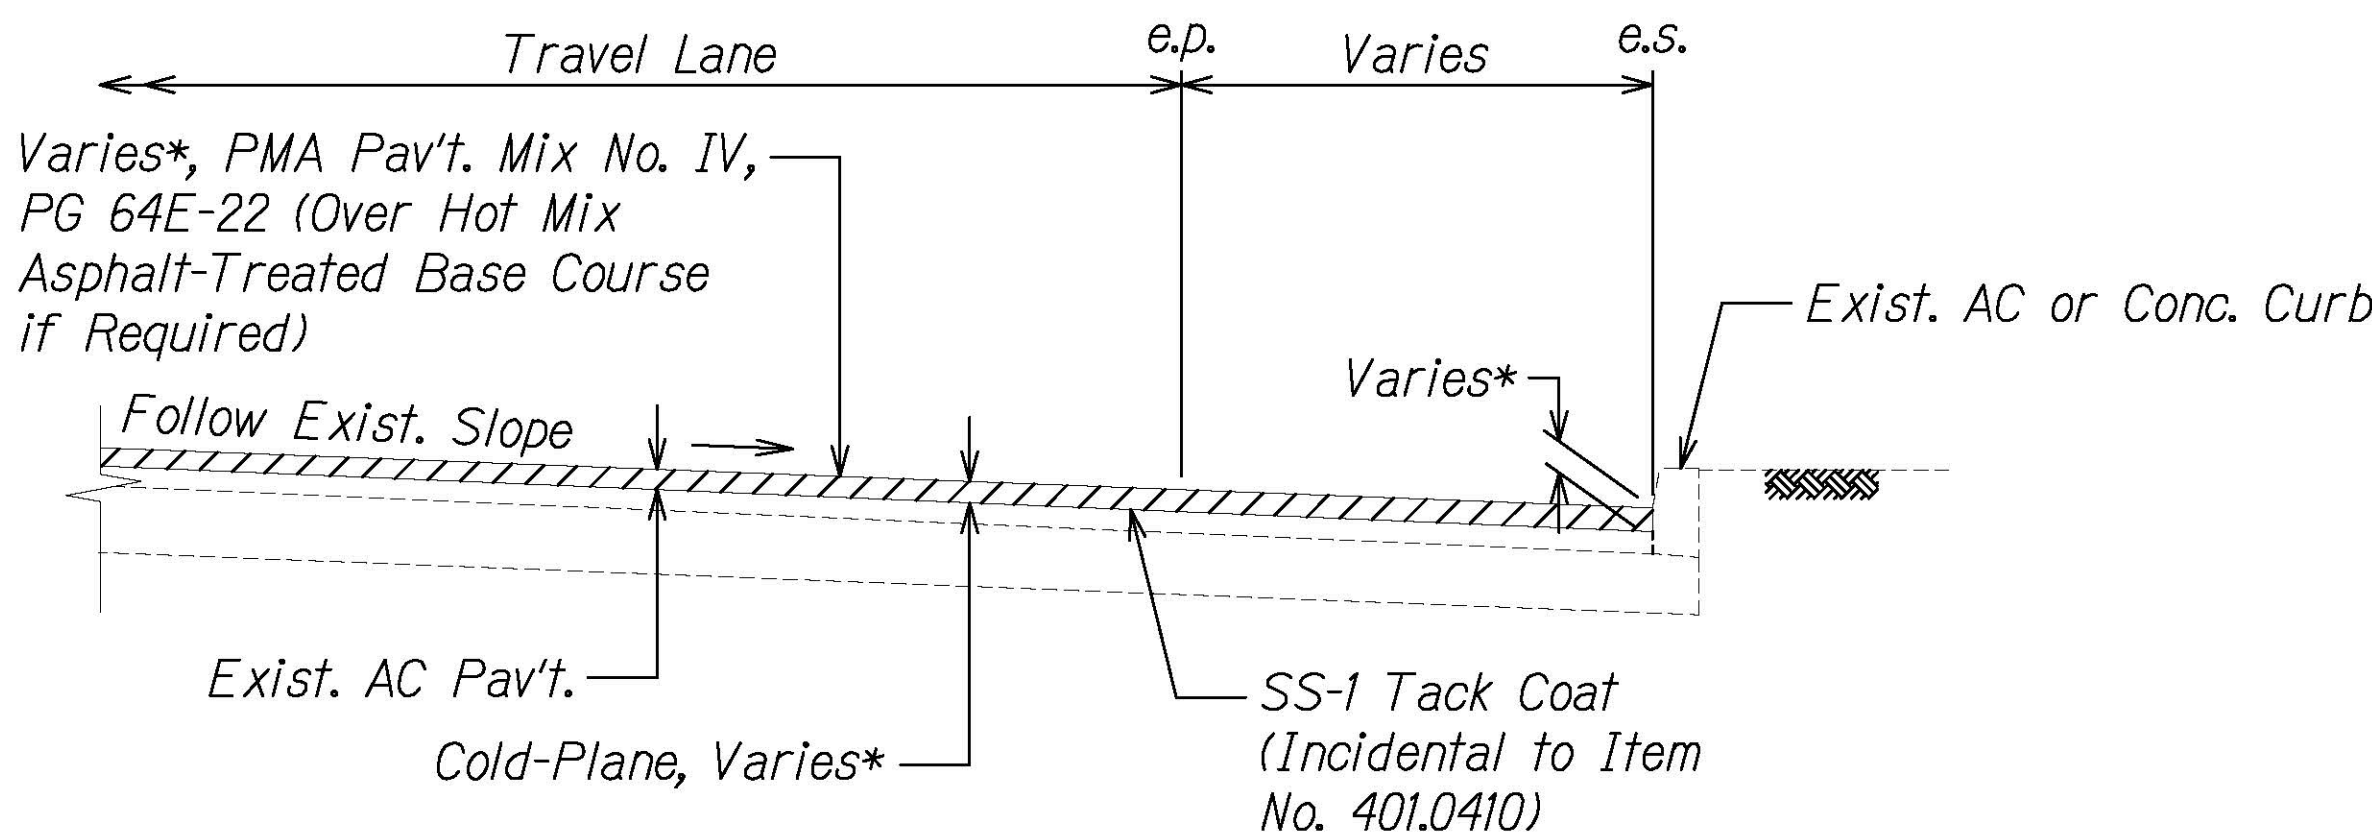


*See Table 1 on Sht R-1 for Cold Plane, Base Course, and Top Coat Depths and Materials.

RESURFACING AT CONCRETE OR ASPHALT CURB
Not to Scale

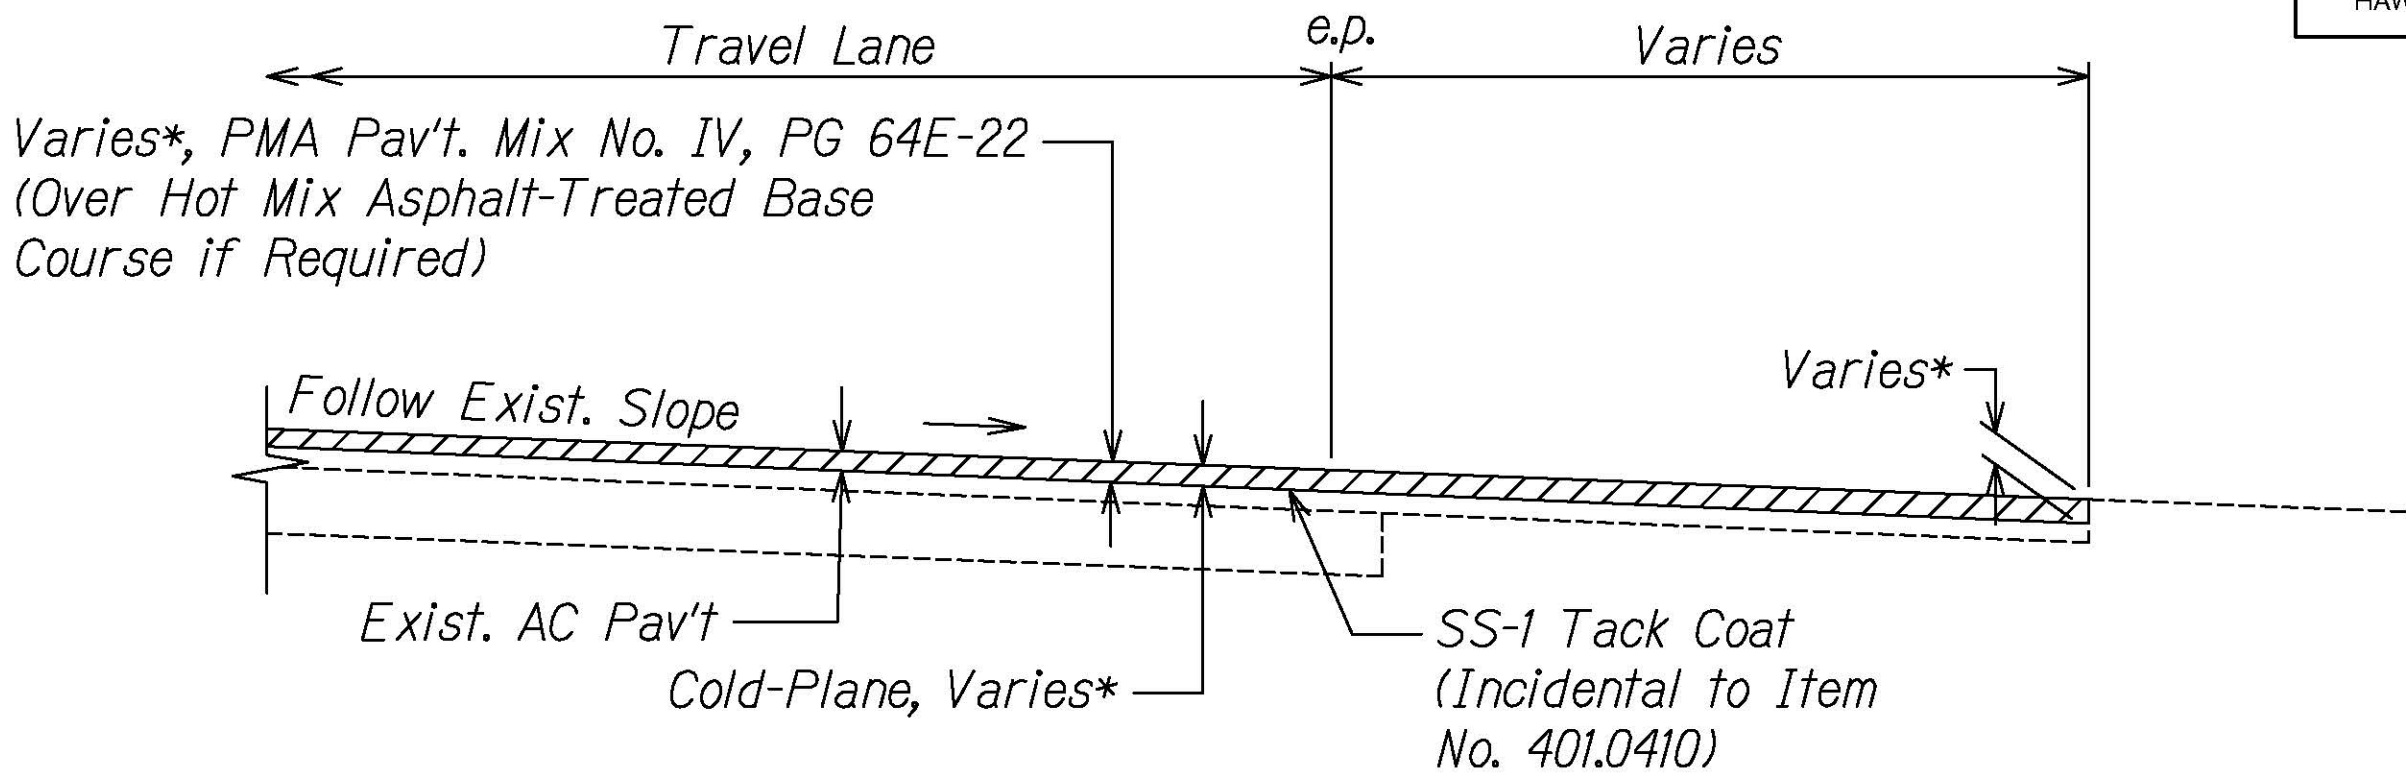

RESURFACING AT PAVED SIDEROADS/DRIVEWAYS
Not to Scale

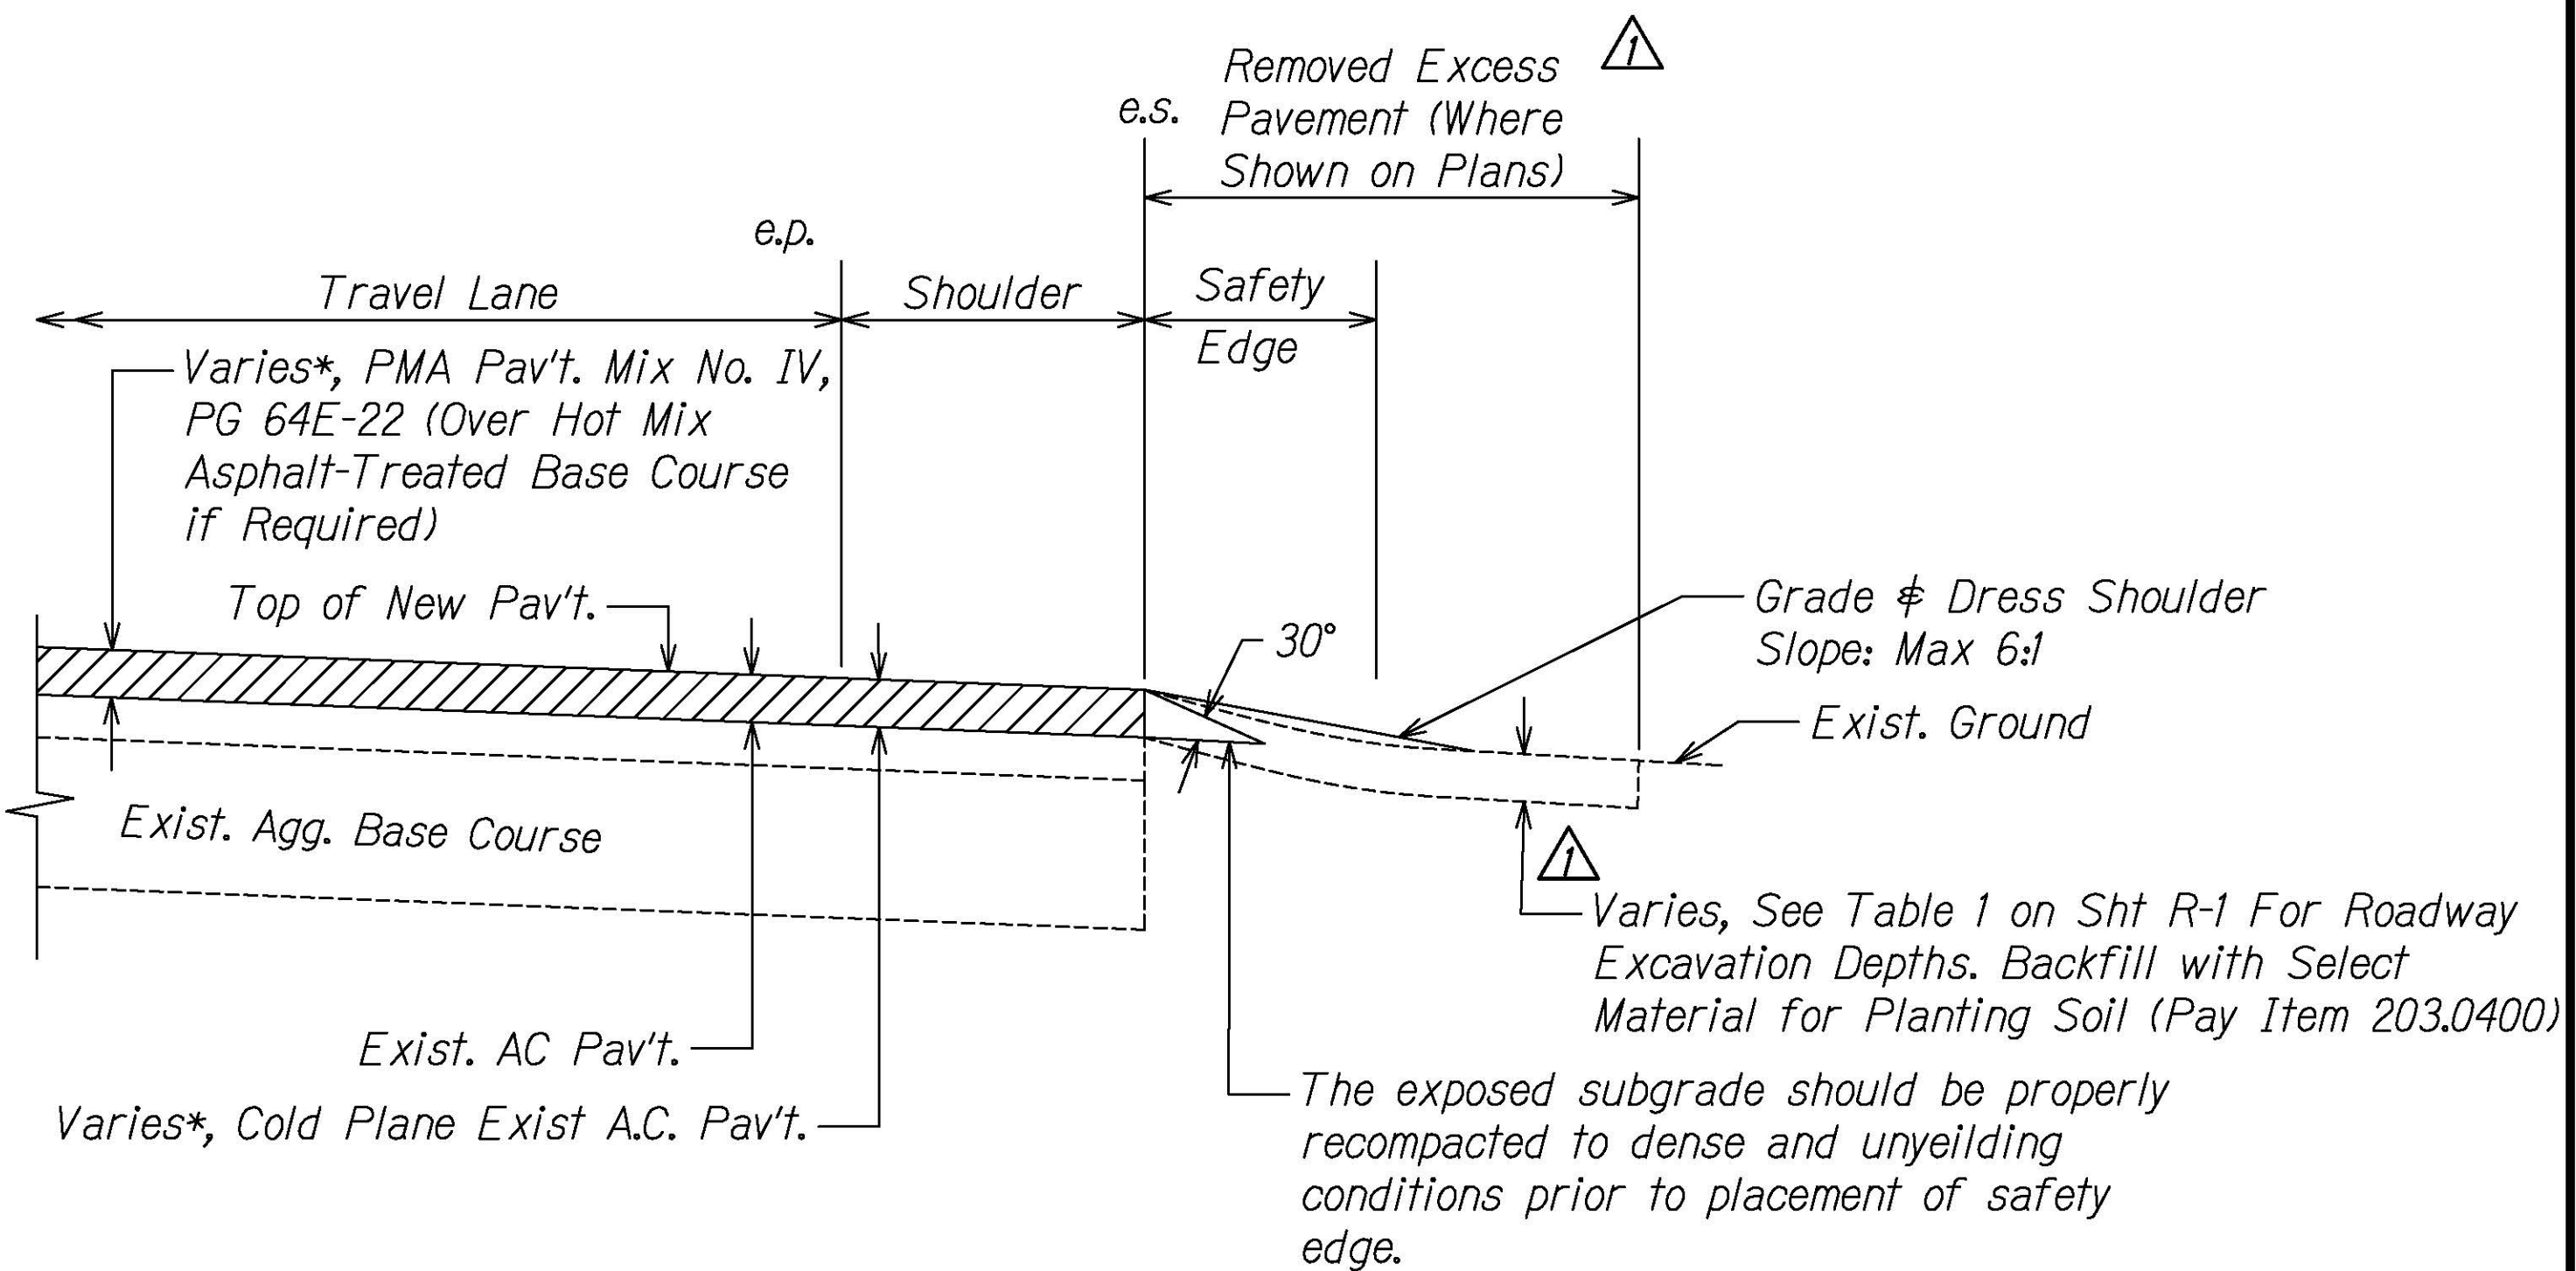


*See Table 1 on Sht R-1 for Cold Plane, Base Course, and Top Coat Depths and Materials.

Note:

- Contractor shall mount a device directly on the paver screed extension to provide a 30° beveled shoulder edge.
- Construct safety edge at all edges of a.c. pavement. This work shall be considered incidental to Item No. 401.0410 - PMA Pavement Mix No. IV.

TYPICAL PAVEMENT EDGE DETAIL
Not to Scale

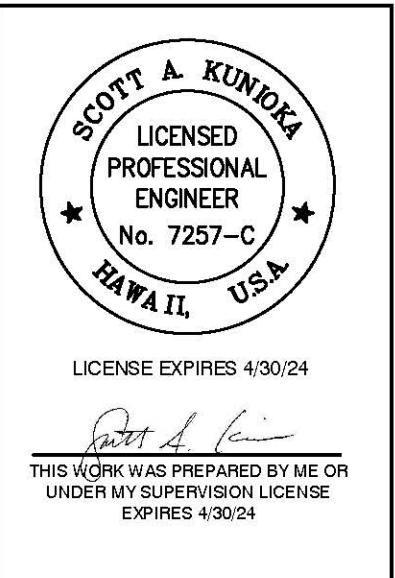

STATE OF HAWAII DEPARTMENT OF TRANSPORTATION HIGHWAYS DIVISION	
<u>TYPICAL SECTIONS</u>	
<u>KUHIO HIGHWAY RESURFACING AND SAFETY IMPROVEMENTS</u>	
<u>Route 560 M.P. 0.0 to M.P. 4.5</u>	
<u>Fed. Aid Proj. No. STP-0560(017)</u>	
Scale: Not to Scale	Date: July, 2023
SHEET No. R-7A OF 28 SHEETS	

10/12/23	△ - Revised Typ. Pav't Edge Detail
DATE	REVISION

GENERAL NOTES:

1. All hardware, posts and fasteners shall be hot-dip zinc coated galvanized after fabrication. No punching, drillings or cutting will be permitted after galvanizing.

2. Where conditions require, special post lengths in increments of 6 inches may be specified by the Engineer.

3. All fasteners, posts, and rail elements (i.e. FBB03, PWE01, RWM04b, etc.) shall conform to the latest edition and amendments of "A Guide to Standardized Highway Barrier Rail Hardware", a report prepared and approved by the AASHTO-AGC-ARTBA Joint Cooperative Committee, Subcommittee on New Highway Materials, Task Force 13 Report. Dimensions of fasteners, posts, and rail elements have been converted from metric units into their present form.

4. The Blockout or Offset Block shall be approved by the State.
5. All new guardrail systems (system consists of total length of guardrail including both end treatments) shall include the Additional Paved Area.

6. After the guardrail posts are installed in the paved area, the Contractor shall fill/seal around each guardrail post and all cracks in the paved area caused during the guardrail post installation. If required by the inspector/engineer, the Contractor shall tamper the paved area around the guardrail post prior to filling/sealing. All costs associated with this work shall not be paid for separately, but shall be considered incidental to the various guardrail items.

7. When standards for the fill slope area cannot be met, a site specific, engineer approved design may be used.


8. Minimum working width (clear distance) between back of MGS post to any fixed object is 4'-1" (49").
9. New Hot Mix Asphalt (HMA) pavement at guardrails shall extend 6 feet longitudinally beyond terminal ends.

10. Reflector Markers (RM-5) mounted on guardrails shall be spaced every 25 feet. RM-5's shall not be installed on terminal sections. Furnishing and installing of each RM-5 shall be considered incidental to the guardrail system.


11. Polymer-Modified Asphalt (PMA) pavement shall be used in place of HMA when the adjacent roadway is paved with PMA.

12. All guardrail, guardrail posts and appurtenances (both new and existing) shall be painted in accordance to Note 35 Guardrail Paint on Sheet N-3. Payment for painting shall be considered incidental to the various guardrail items. Top coat paint color shall be brown and match existing guardrails.


FED. ROAD DIST. NO.	STATE	FED. AID PROJ. NO.	FISCAL YEAR	SHEET NO.	TOTAL SHEETS
HAWAII	HAW.	STP-0560(017)	2023	ADD.29	92

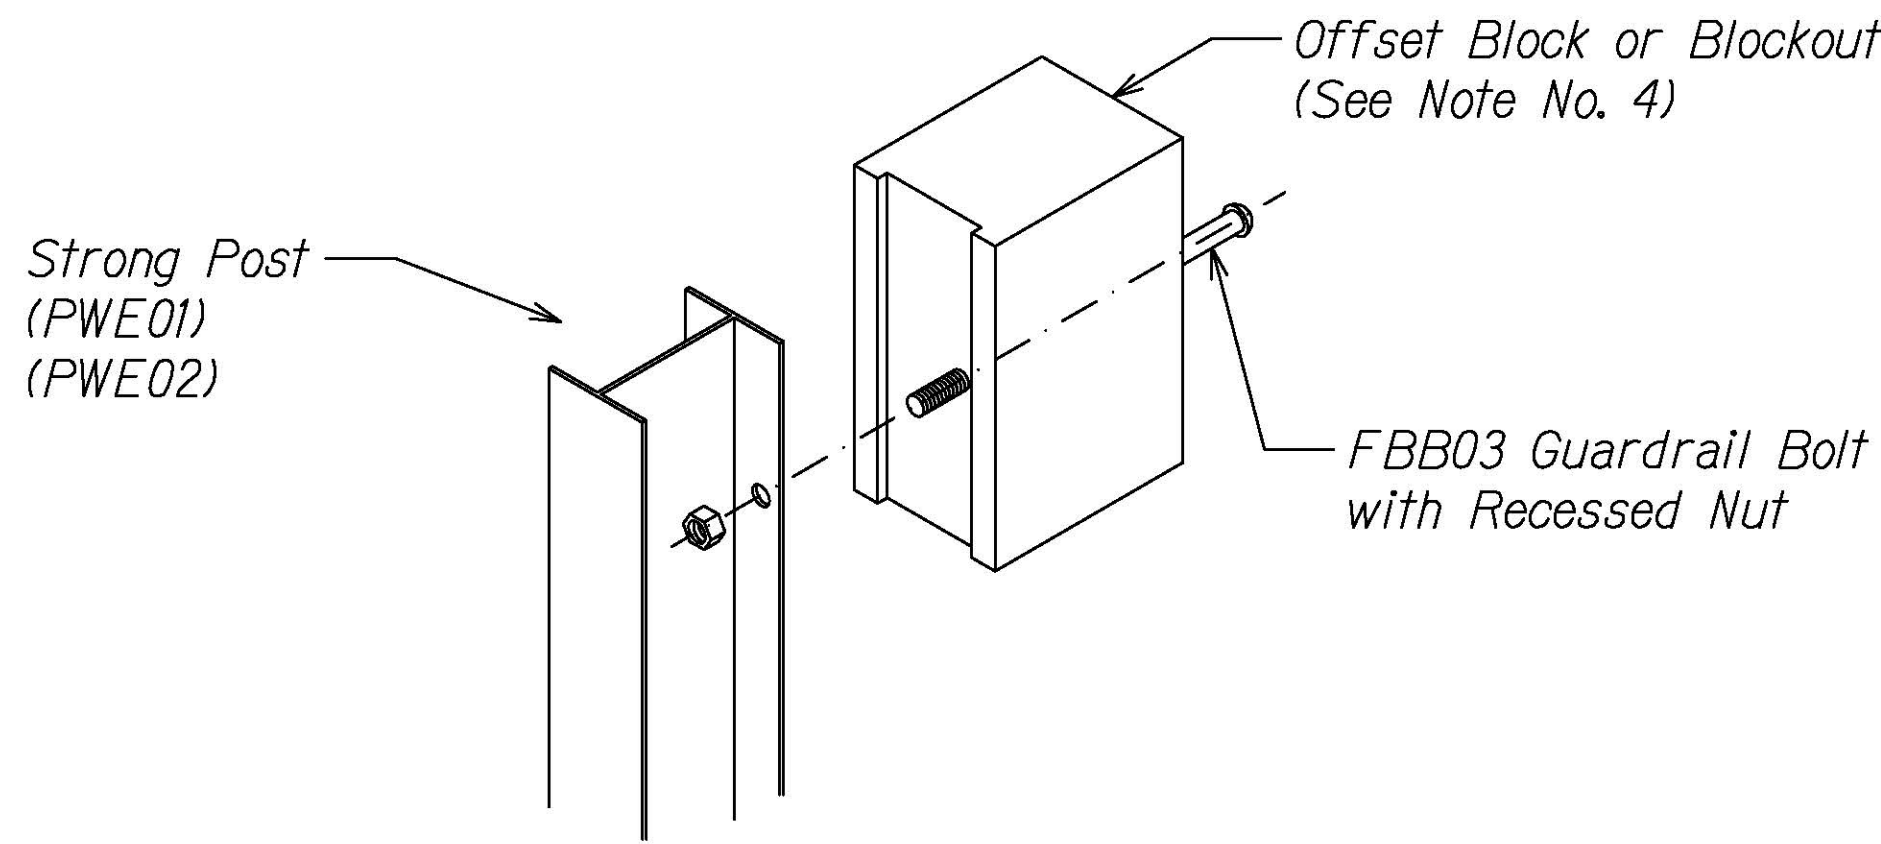

Exploded View
(Rail and washer not shown)
STEEL POST AND BLOCK DETAIL

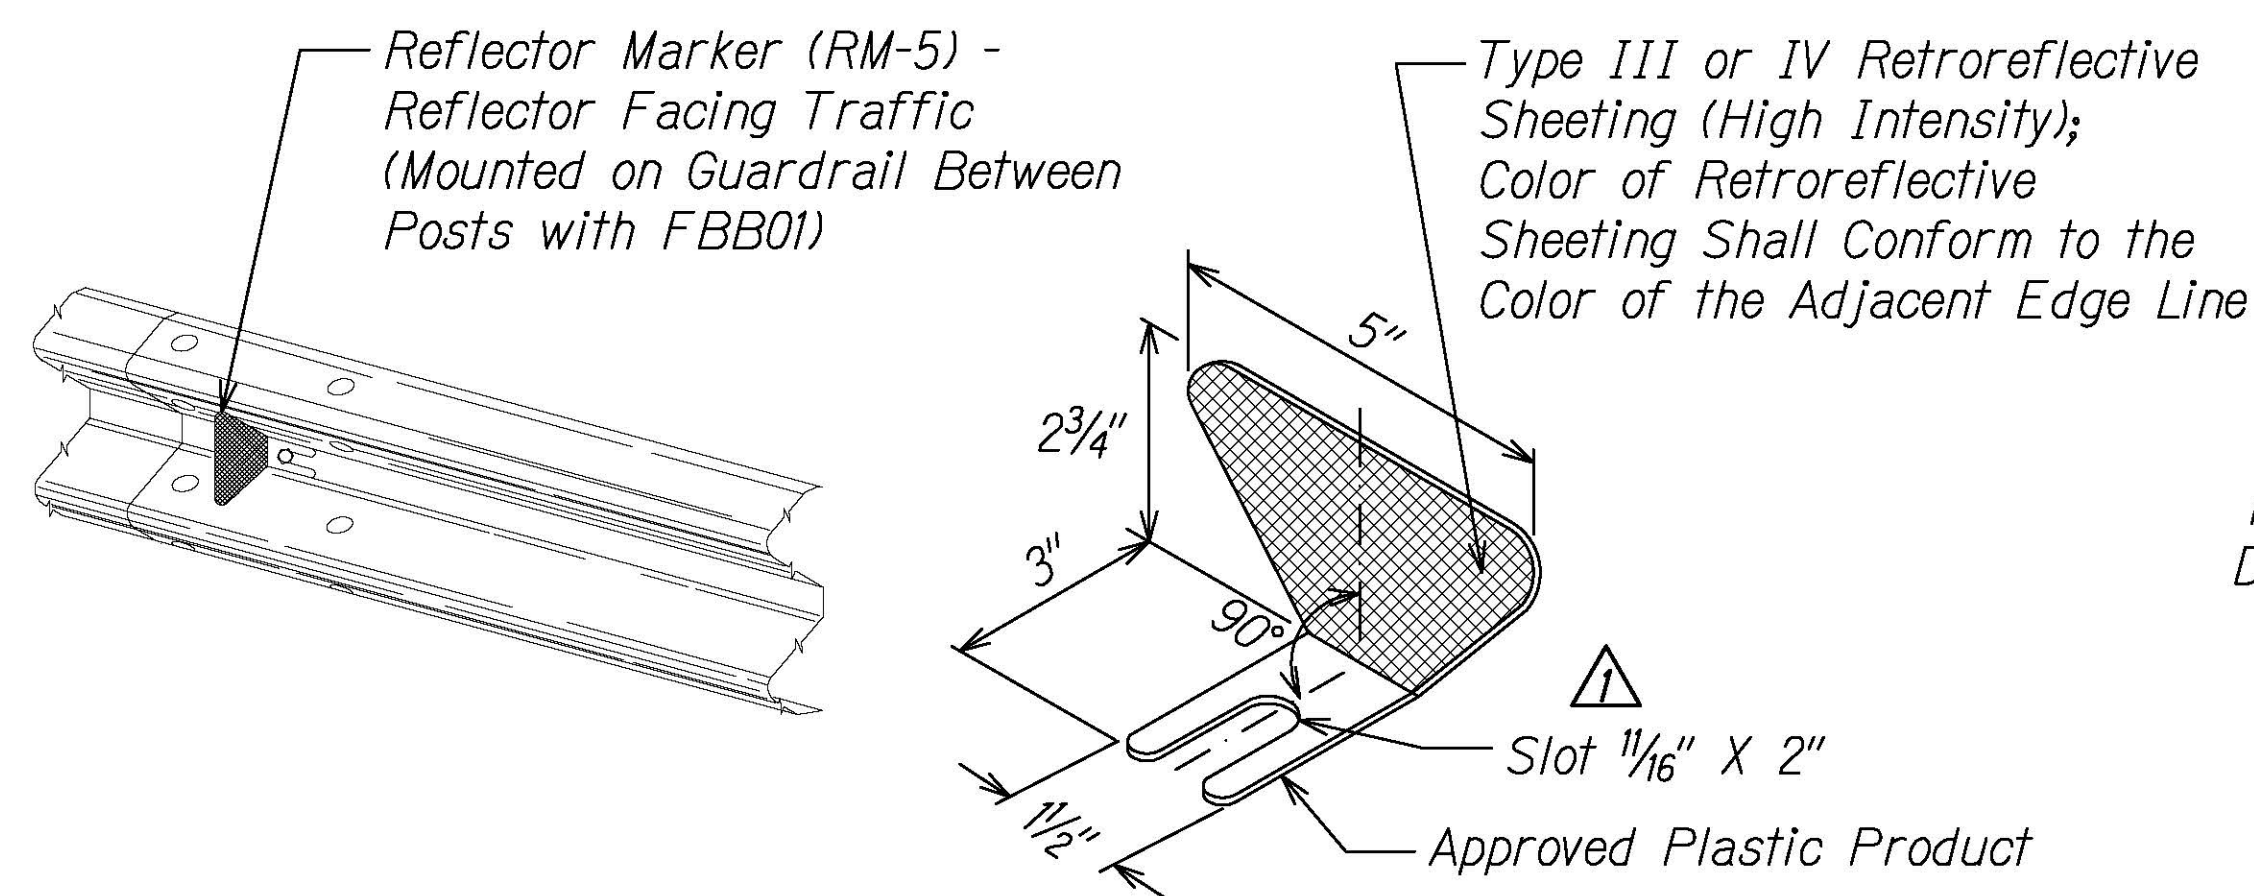


REFLECTOR MARKER (RM-5) DETAIL AND TYPICAL INSTALLATION

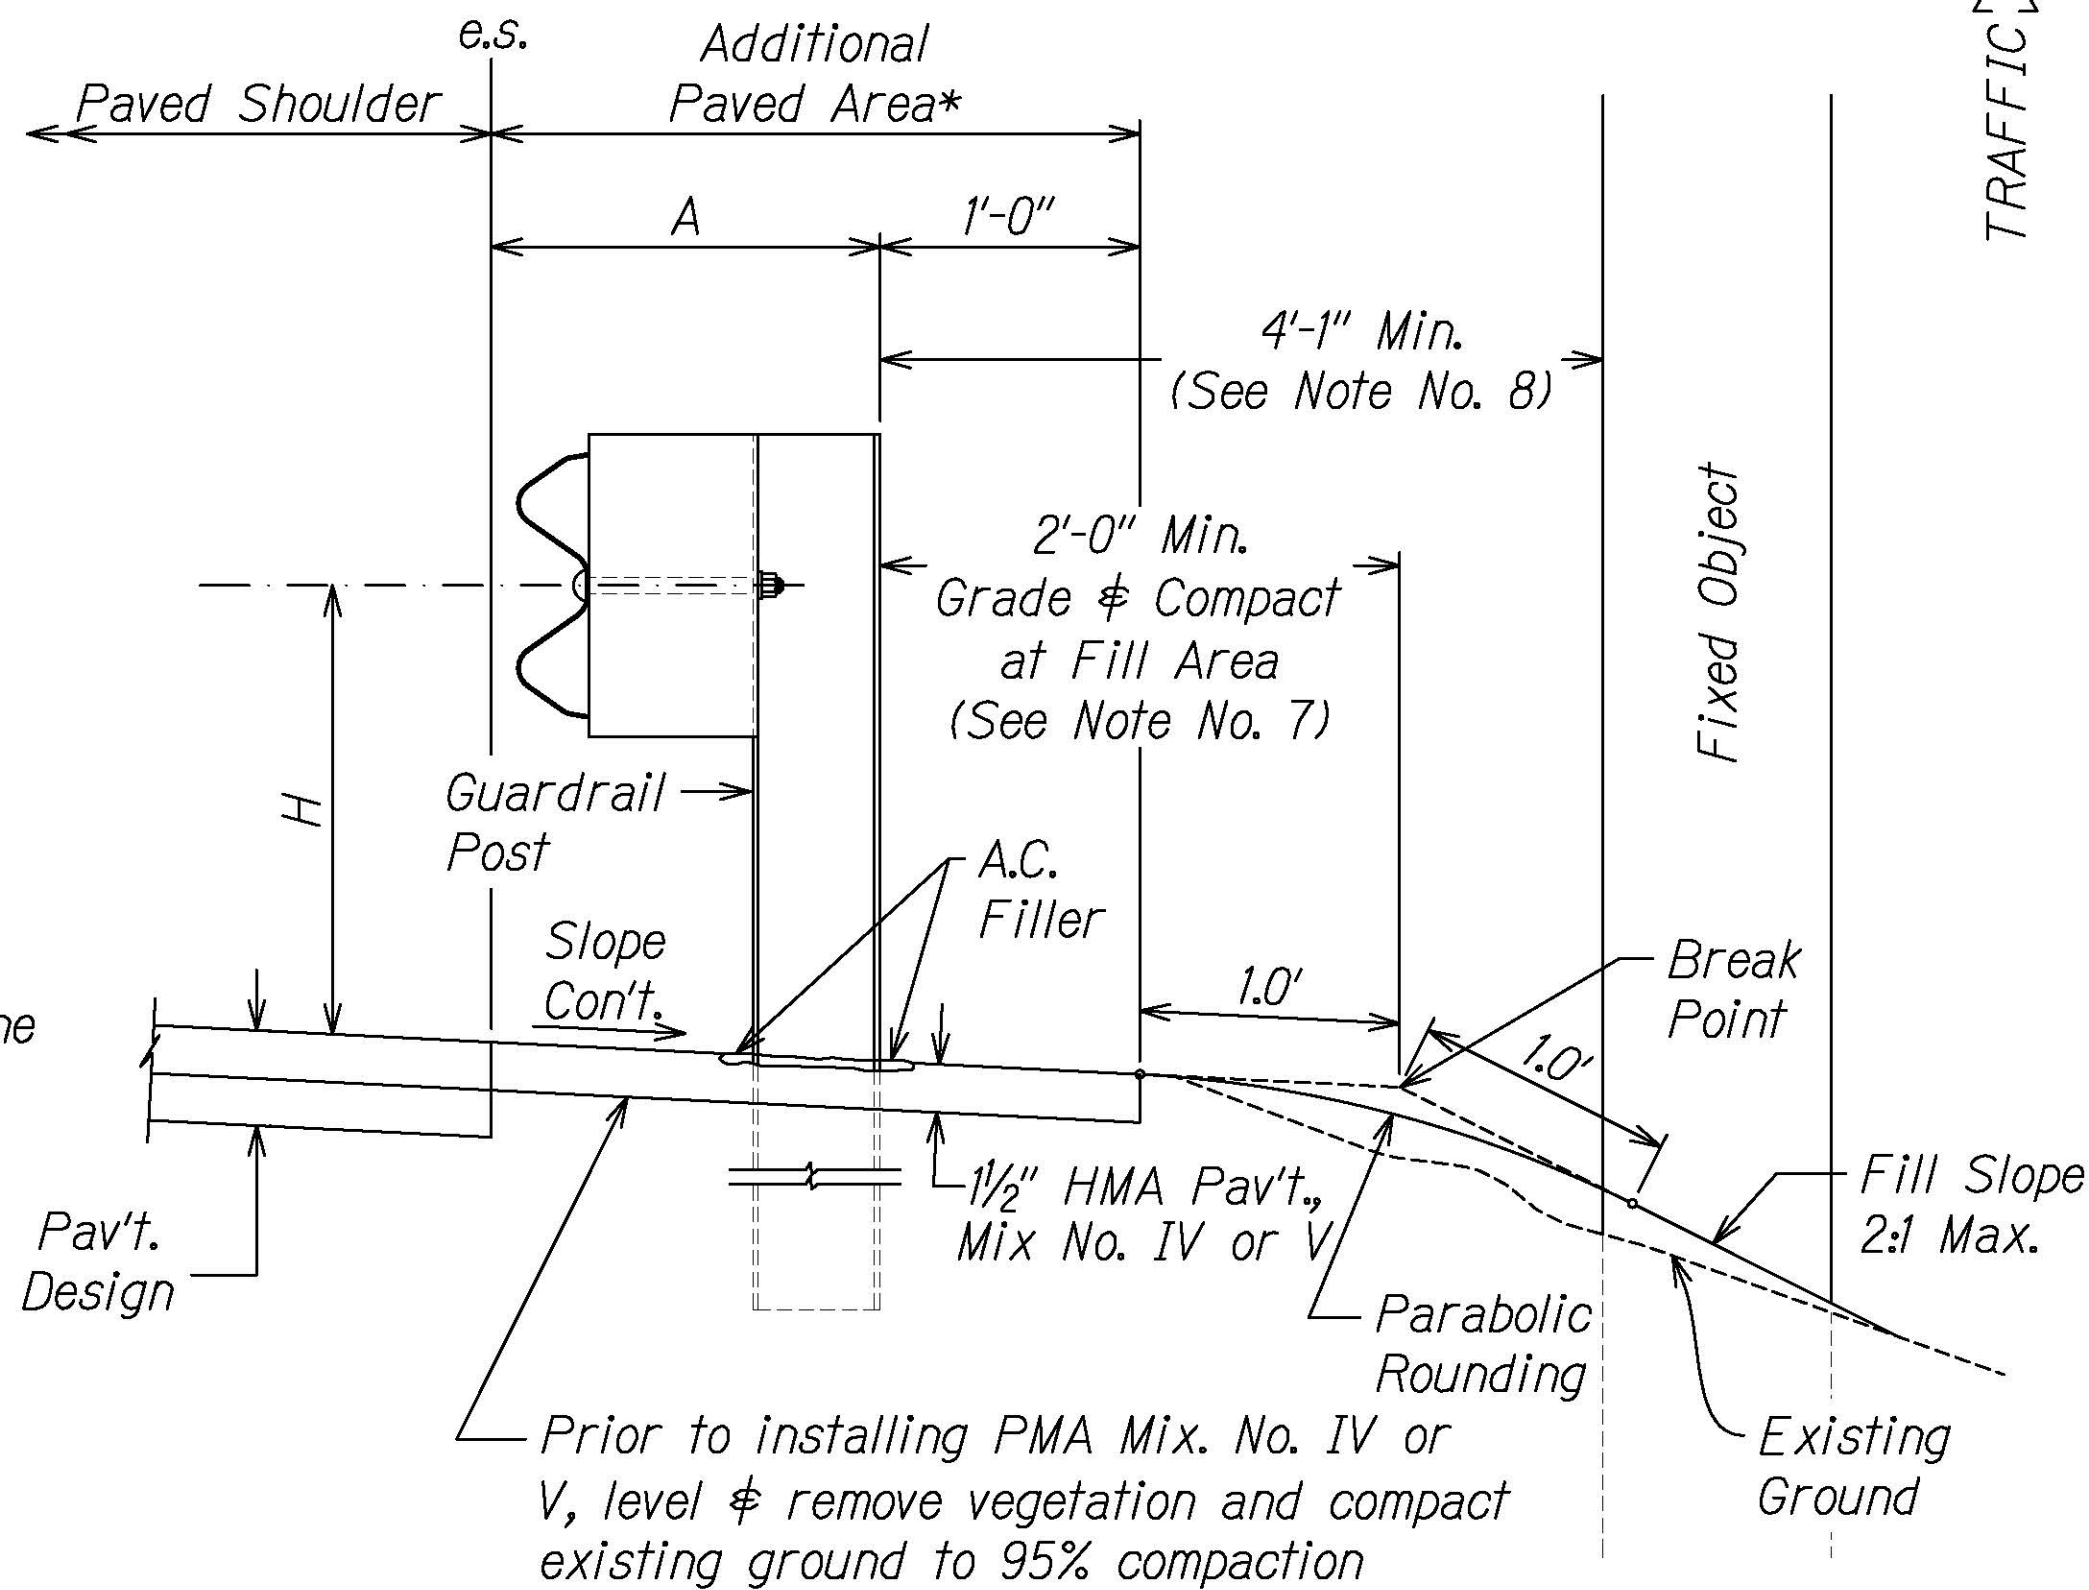


ELEVATION

TYPICAL GUARDRAIL INSTALLATION

GUARDRAIL TYPE	DIMENSION	
	H	A
MGS w/ Standard 8" Offset Block	2'-1"	1'-6"
MGS w/ No Blockout	2'-7/8"	9 1/4"

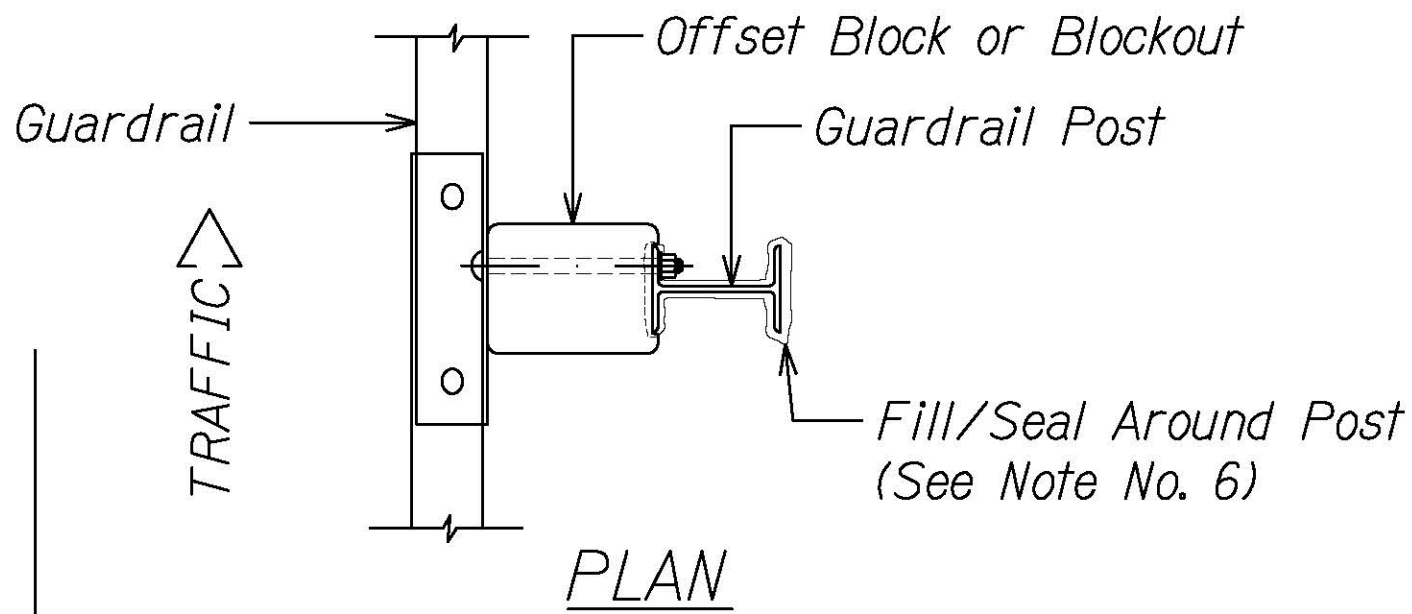

PLAN

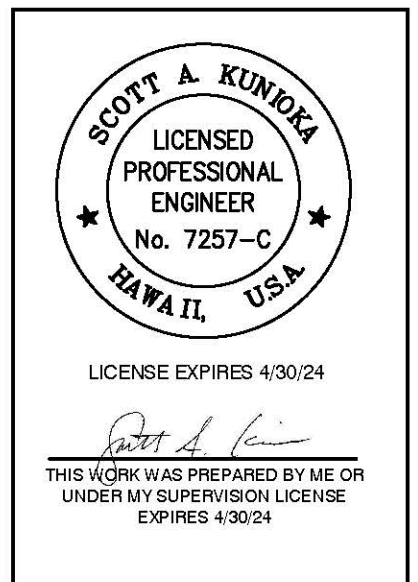

STATE OF HAWAII
DEPARTMENT OF TRANSPORTATION
HIGHWAYS DIVISION

GUARDRAIL DETAILS
**KUHIO HIGHWAY RESURFACING
AND SAFETY IMPROVEMENTS**
Route 560 M.P. 0.0 to M.P. 4.5
Fed. Aid Proj. No. STP-0560(017)

Scale: Not to Scale Date: July, 2023

SHEET No. R-10A OF 28 SHEETS

SURVEY PLOTTED BY	DATE
DRAWN BY	
DESIGNED BY	
QUANTITIES BY	
CHECKED BY	
ORIGINAL PLAN	
NOTE BOOK	
NO.	

10/12/23	△ - Revised RM-5 Detail
DATE	REVISION

PLAN

TRAFFIC →

Guardrail

Offset Block or Blockout

Guardrail Post

7⁵/₈"

5⁷/₈"

4"

PLAN

SECTION A-A

RWM04a

Offset Block or Blockout

PWE01

7"

FBB03

Guardrail Post

Ground Line

31"

25"

6'-0"

SECTION A-A

SECTION B-B

WIDE-FLANGED GUARDRAIL POST (PWE01)

5⁷/₈"

6'-0"

2'-1"

2'-8"

W6x8.5 Structural Shape

2³/₈"

3/4"

2"

5"

5"

Ground Line

Ground Line

FRONT

1/16"

3/4"

2 1/4"

1 5/8"

10° ± 1°

55° (Typ.)

15/16" R (Typ.)

7 5/8"

12 1/4"

(± 3/16")

6/8"

3/4"

25/16"

9/16"

55°

55°

55°

3/8" R

Post Bolt Slot

3/16" x 29/16"

1/16" x 13/16" Slot (Typ.)

Tol. (-0, +5)

1/16"

SECTION B-B

SECTION C-C

13'-6 1/2"

3'-1 1/2"

13'-6 1/2"

3'-1 1/2"

4 SPACE W-BEAM GUARDRAIL

2"

4 1/4"

4 1/4"

8 1/2"

ELEVATION

13'-6 1/2"

6'-3"

6'-3"

6'-3"

Ø Rail Bolt Hole

Ø Rail Bolt Hole

Ø Rail Bolt Hole

Lap in Direction of Traffic

Ground Line

RWM04a

Wide-Flange Guardrail Post

8-FBB01 Splice Bolts

ELEVATION

MIDWEST GUARDRAIL SYSTEM WITH STANDARD 8" OFFSET BLOCK (SGR47)

NOTE:
All Holes are 3/4" Dia.

GUARDRAIL BOLTS AND REINFORCEMENT

DESIGNATOR	L
FBB01	1 3/8"
FBB02	2"
FBB03	10"

Mod. Heavy Hex Nut

DESIGNATOR	BASE METAL THICKNESS
RWM04a	12 Gauge

10/12/23

1 - Revised Guardrail Detail

GUARDRAIL BOLTS AND RECESSED NUT

4 SPACE W-BEAM GUARDRAIL (RWM04a)






STATE OF HAWAII
DEPARTMENT OF TRANSPORTATION
HIGHWAYS DIVISION

GUARDRAIL DETAILS


**KUHIO HIGHWAY RESURFACING
AND SAFETY IMPROVEMENTS**
Route 560 M.P. 0.0 to M.P. 4.5
Fed. Aid Proj. No. STP-0560(017)

Scale: Not to Scale Date: July, 2023

FED. ROAD DIST. NO.	STATE	FED. AID PROJ. NO.	FISCAL YEAR	SHEET NO.	TOTAL SHEETS
HAWAII	HAW.	STP-0560(017)	2023	ADD.32	92

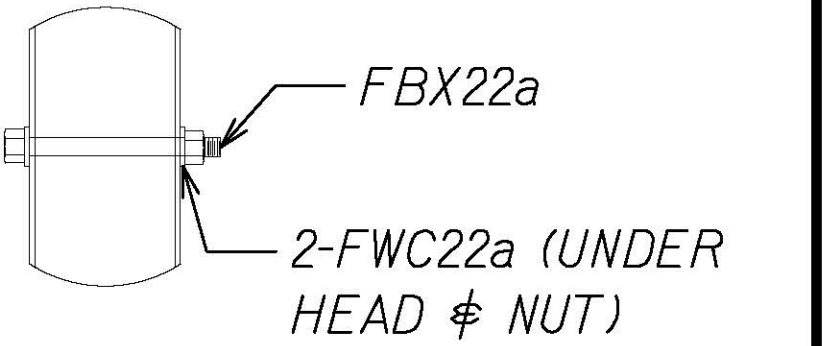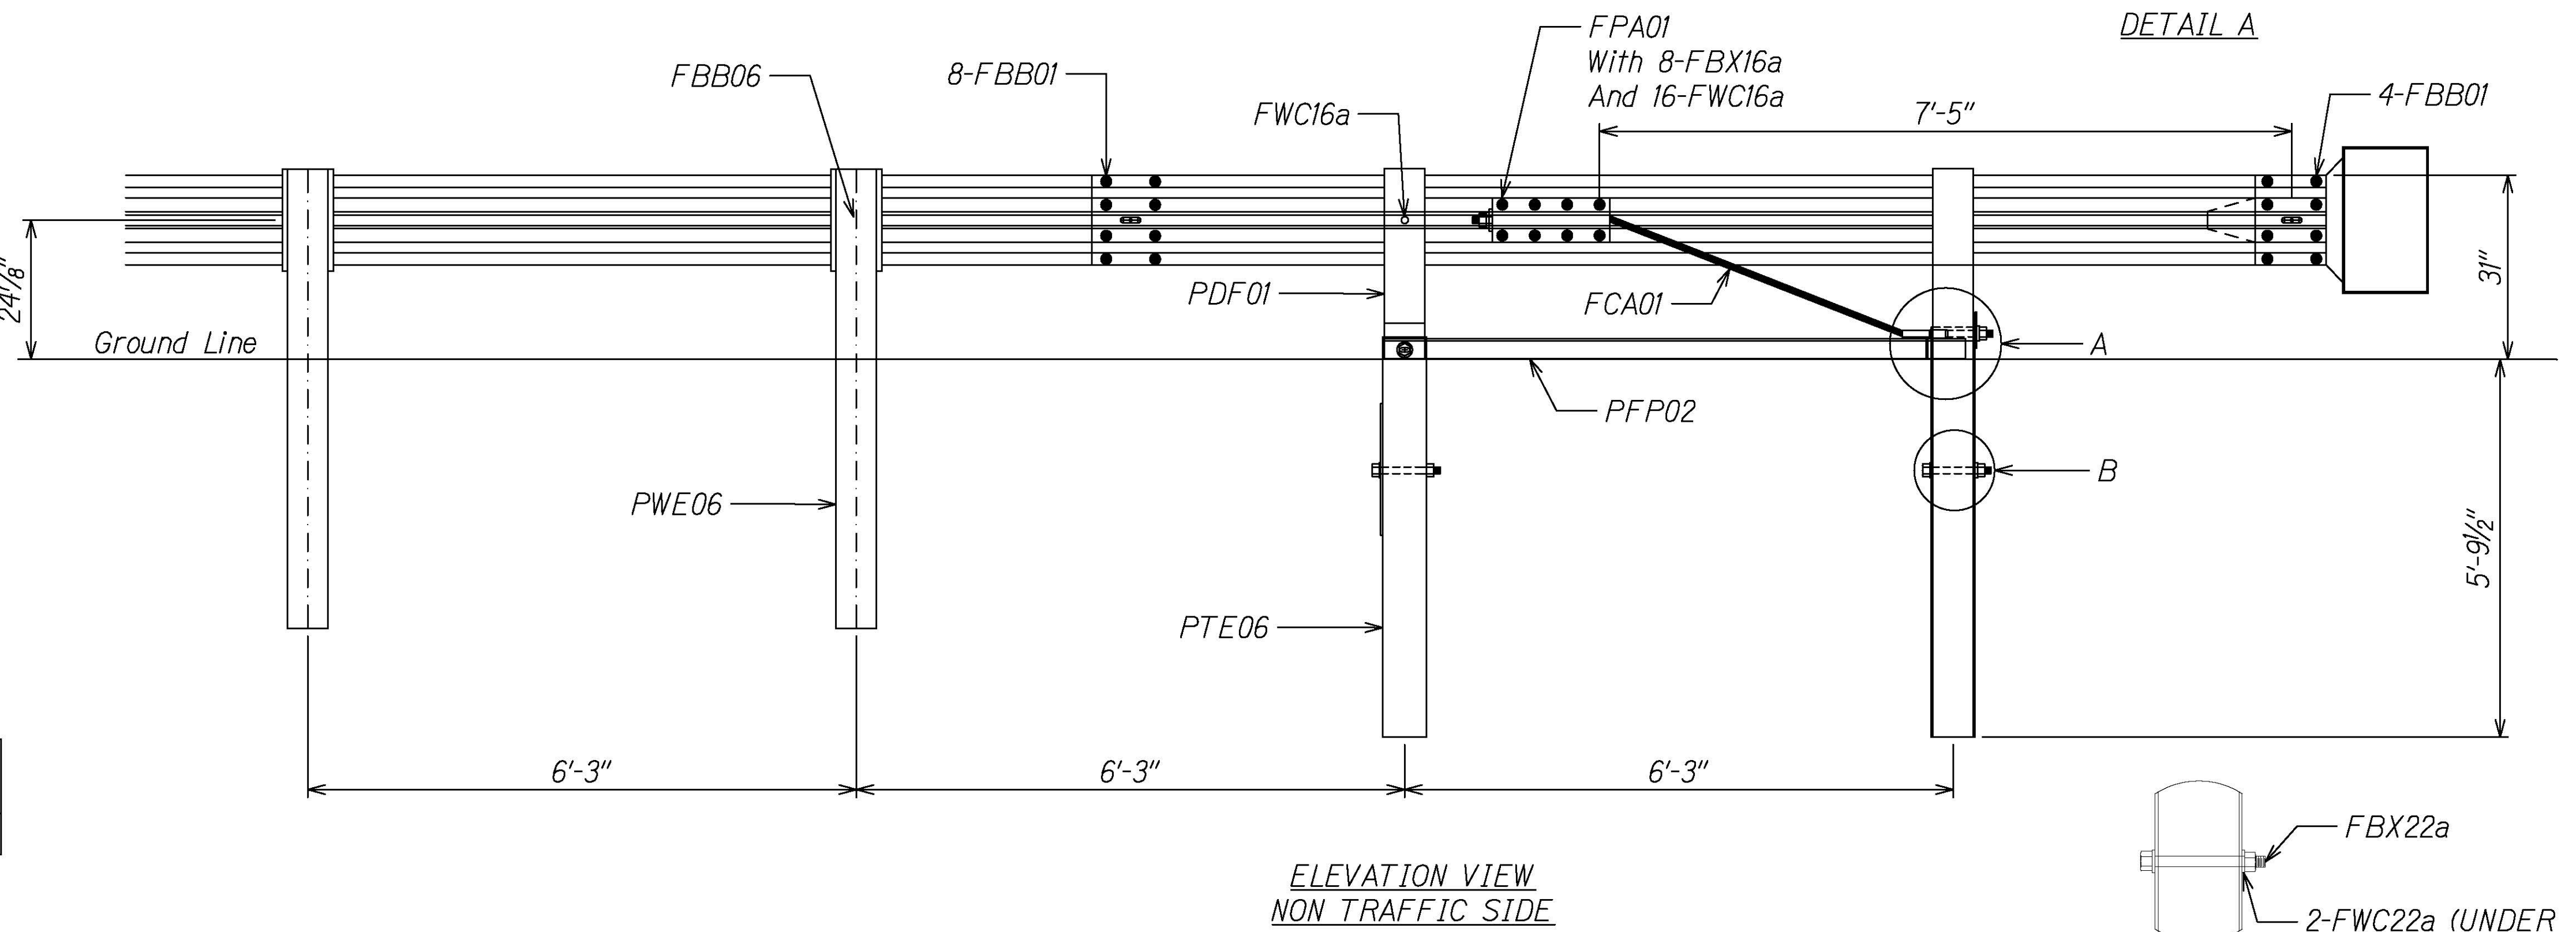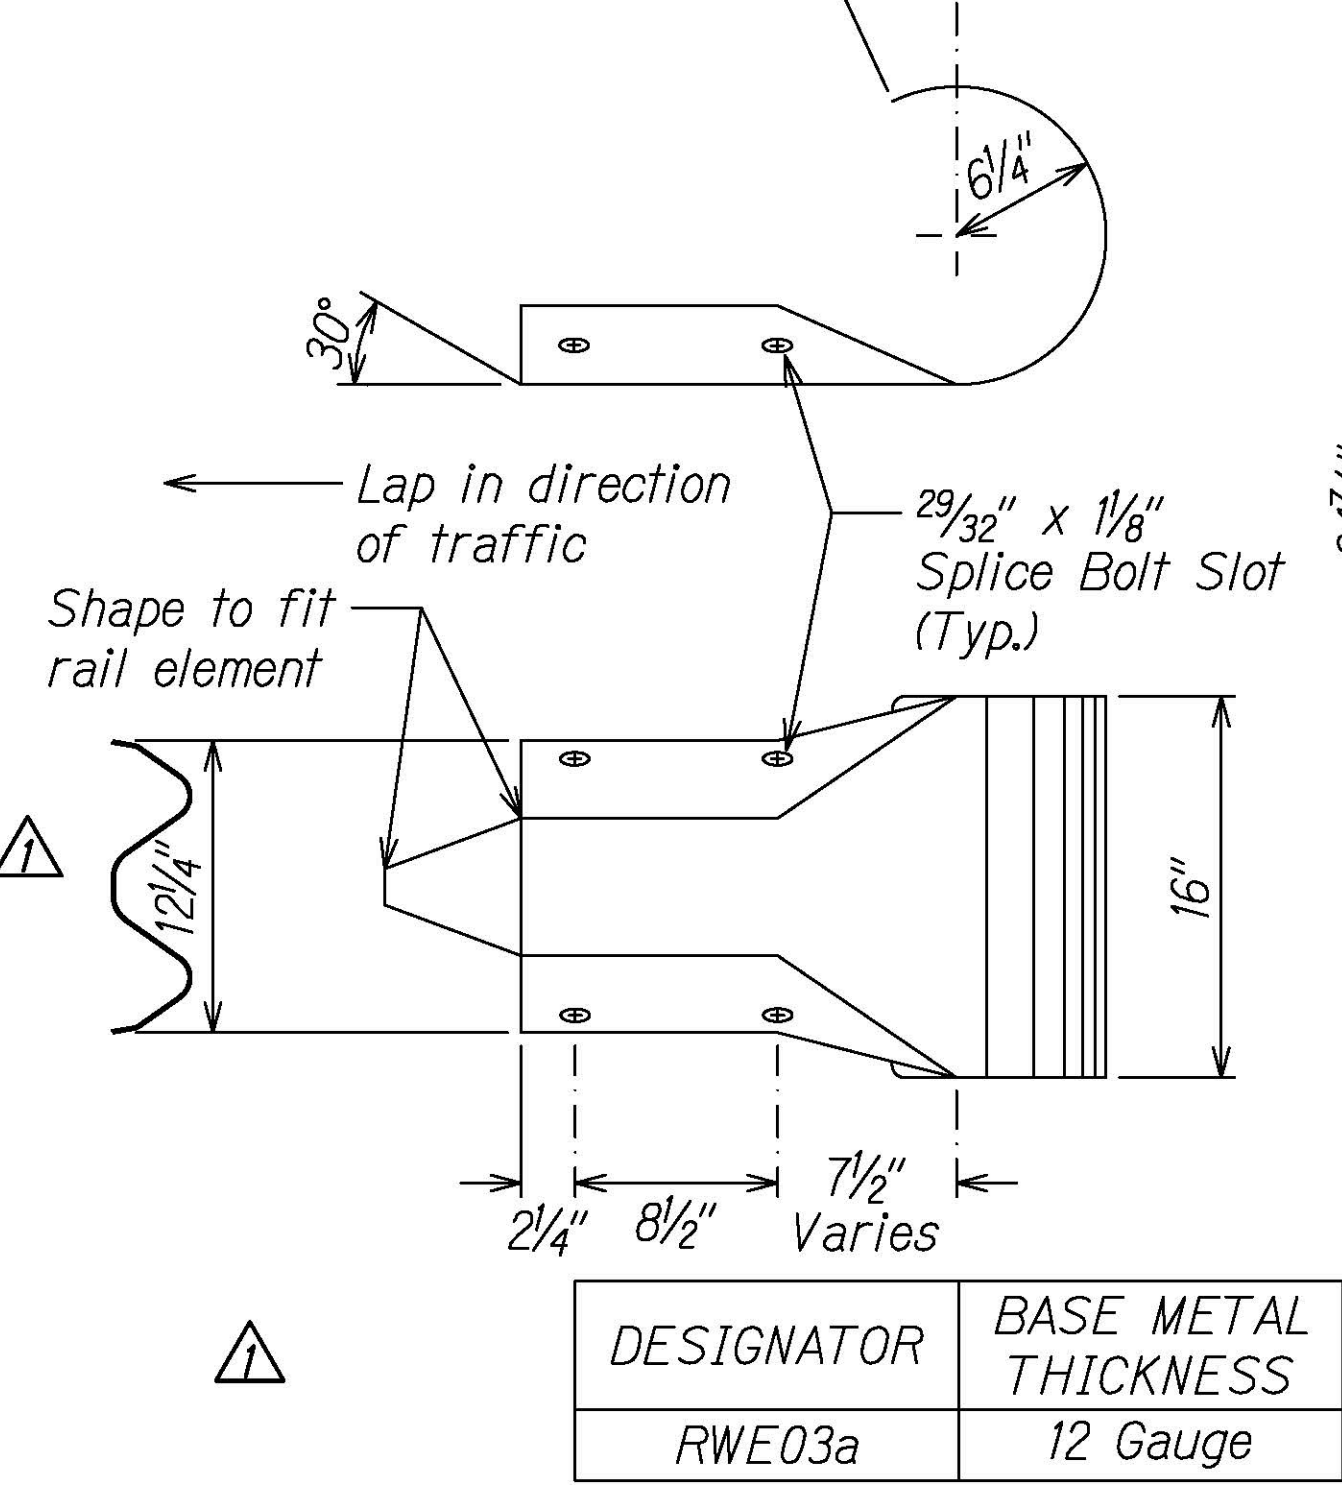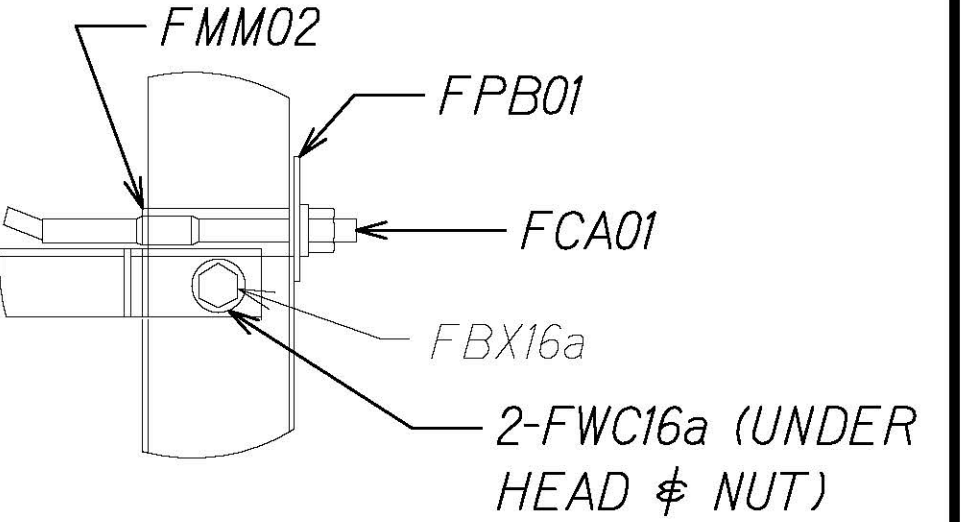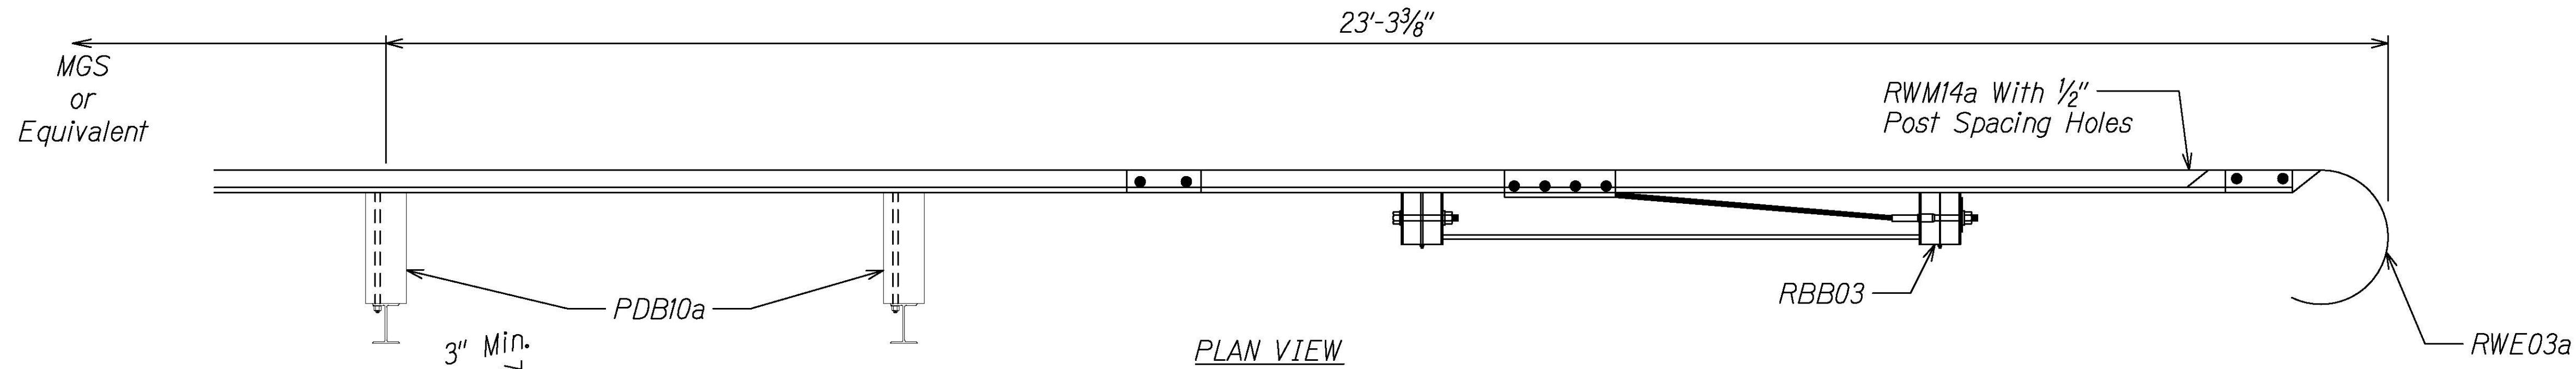

ITEM NO.	QTY	COMPONENTS
FBB01	12	Guardrail Bolt and Nut
FBB03	2	Guardrail Bolt and Nut
FBB06	1	Guardrail Bolt and Nut
FBX16a	2	Hex Head Bolt (10") and Nut
FBX16a	8	Hex Head Bolt (1 1/2") and Nut
FBX22a	2	Hex Head Bolt (7 1/2") and Nut
FCA01	1	BCT Anchor Cable Assembly
PDB10a	2	MGS Timber Blockout
PFP02	1	Strut and Yoke Assembly
PWE06	1	Wide-Flange Guardrail Post
FMM02	1	BCT Post Sleeve
FPA01	1	Anchor Bracket Assembly
FPB01	1	BCT Bearing Plate
FWC16a	22	Circular Washer
FWC22a	4	Circular Washer
PDF01	2	BCT Timber Post
PTE06	2	Foundation Tube
RWE03a	1	W-Beam Rounded End Section
RWM14a	1	W-Beam MGS End Section

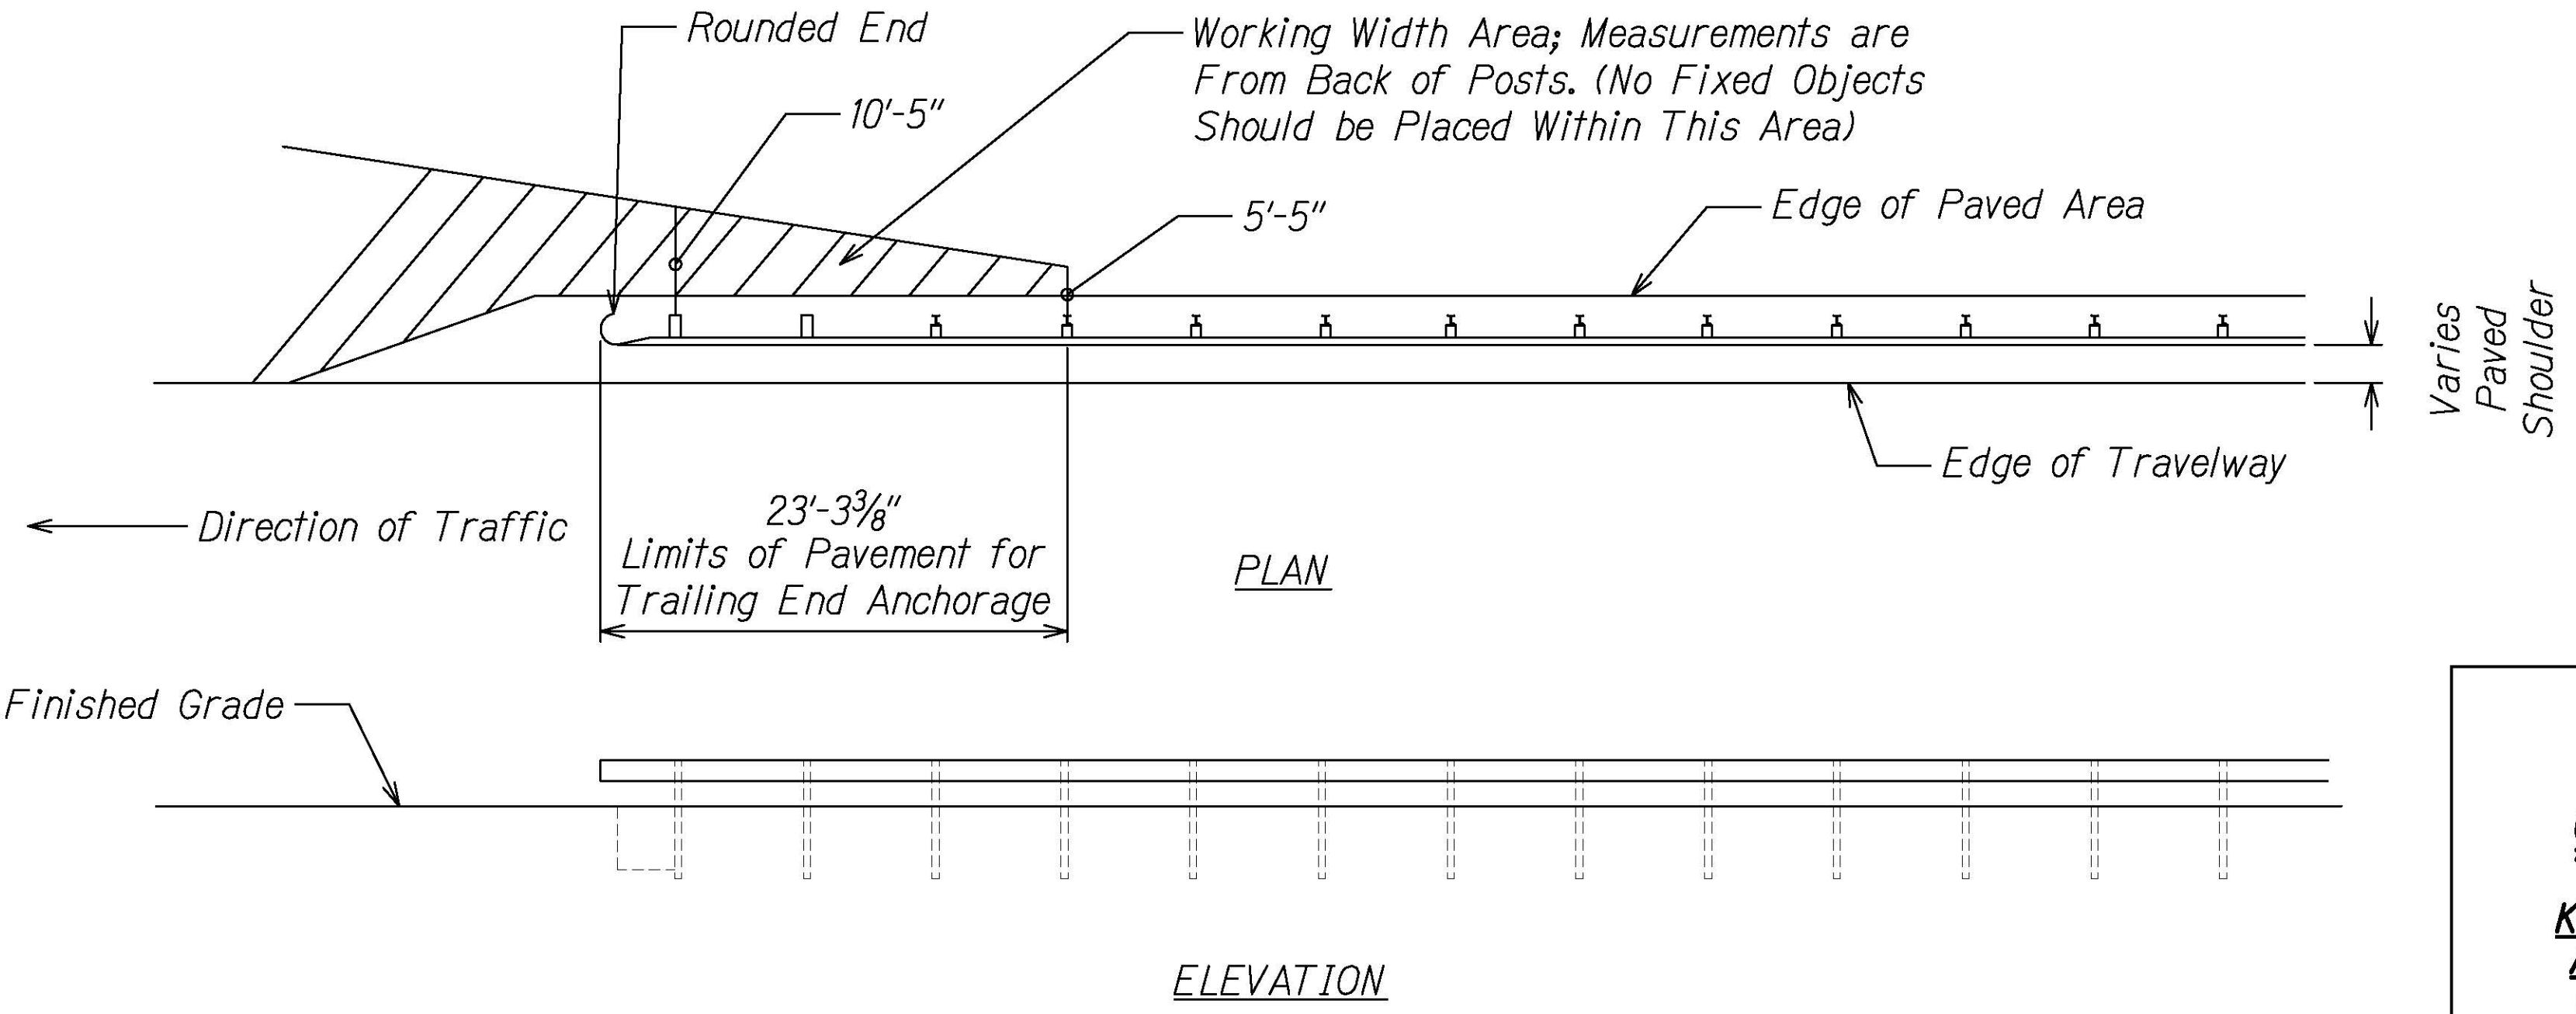

TRAILING-END ANCHORAGE SYSTEM DETAILS
Not to Scale

SURVEY PLOTTED BY	DATE
DRAWN BY	
DESIGNED BY	
QUANTITIES BY	
CHECKED BY	
NO.	

10/12/23	△ - Revised Guardrail Details
DATE	REVISION

STATE OF HAWAII
DEPARTMENT OF TRANSPORTATION
HIGHWAYS DIVISION

GUARDRAIL DETAILS

**KUHIO HIGHWAY RESURFACING
AND SAFETY IMPROVEMENTS**
Route 560 M.P. 0.0 to M.P. 4.5
Fed. Aid Proj. No. STP-0560(017)



Scale: Not to Scale Date: July, 2023

SHEET No. R-13A OF 28 SHEETS

SCOTT A. KUNIK
LICENSED PROFESSIONAL ENGINEER
No. 7257-C
HAWAII, U.S.A.
LICENSE EXPIRES 4/30/24

THIS WORK WAS PREPARED BY ME OR UNDER MY SUPERVISION LICENSE EXPIRES 4/30/24

FED. ROAD DIST. NO.	STATE	FED. AID PROJ. NO.	FISCAL YEAR	SHEET NO.	TOTAL SHEETS
HAWAII	HAW.	STP-0560(017)	2023	ADD.37	92

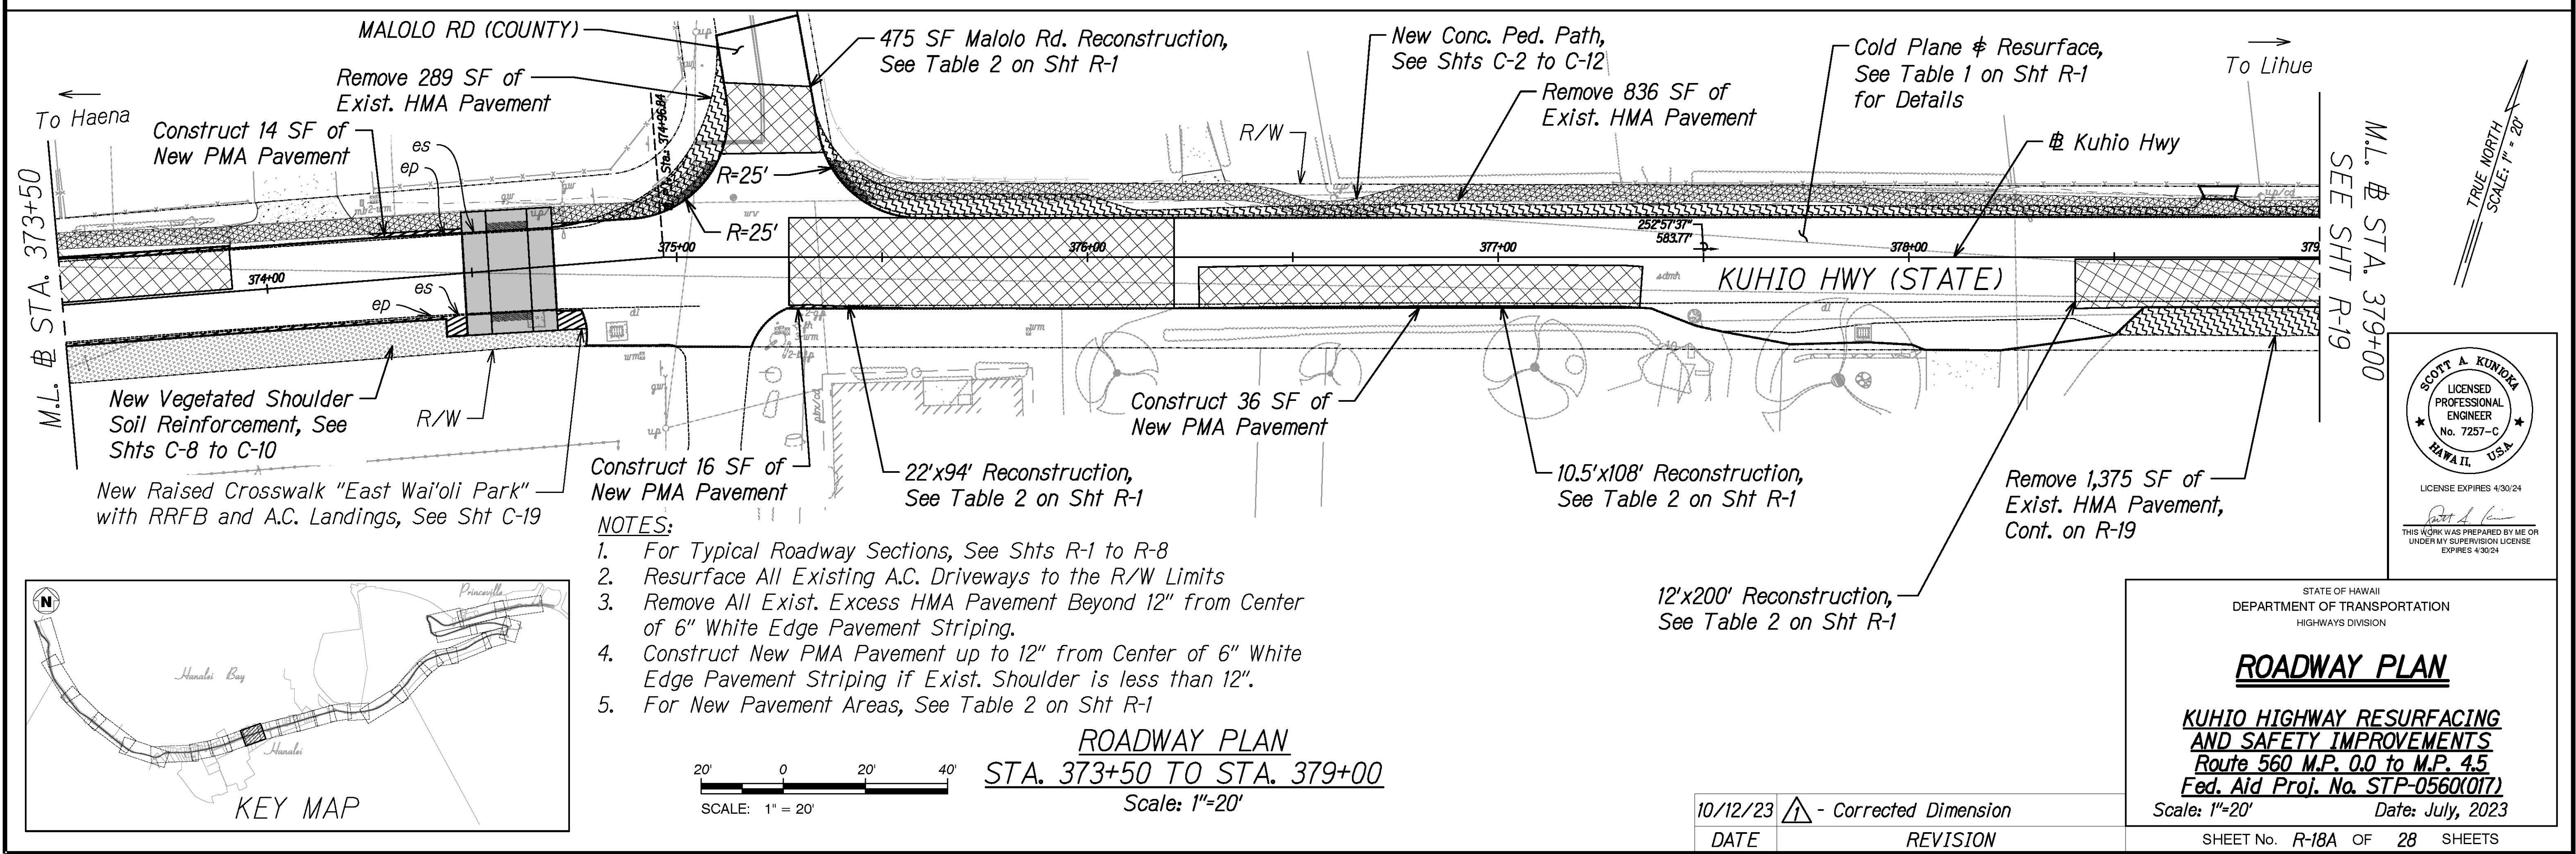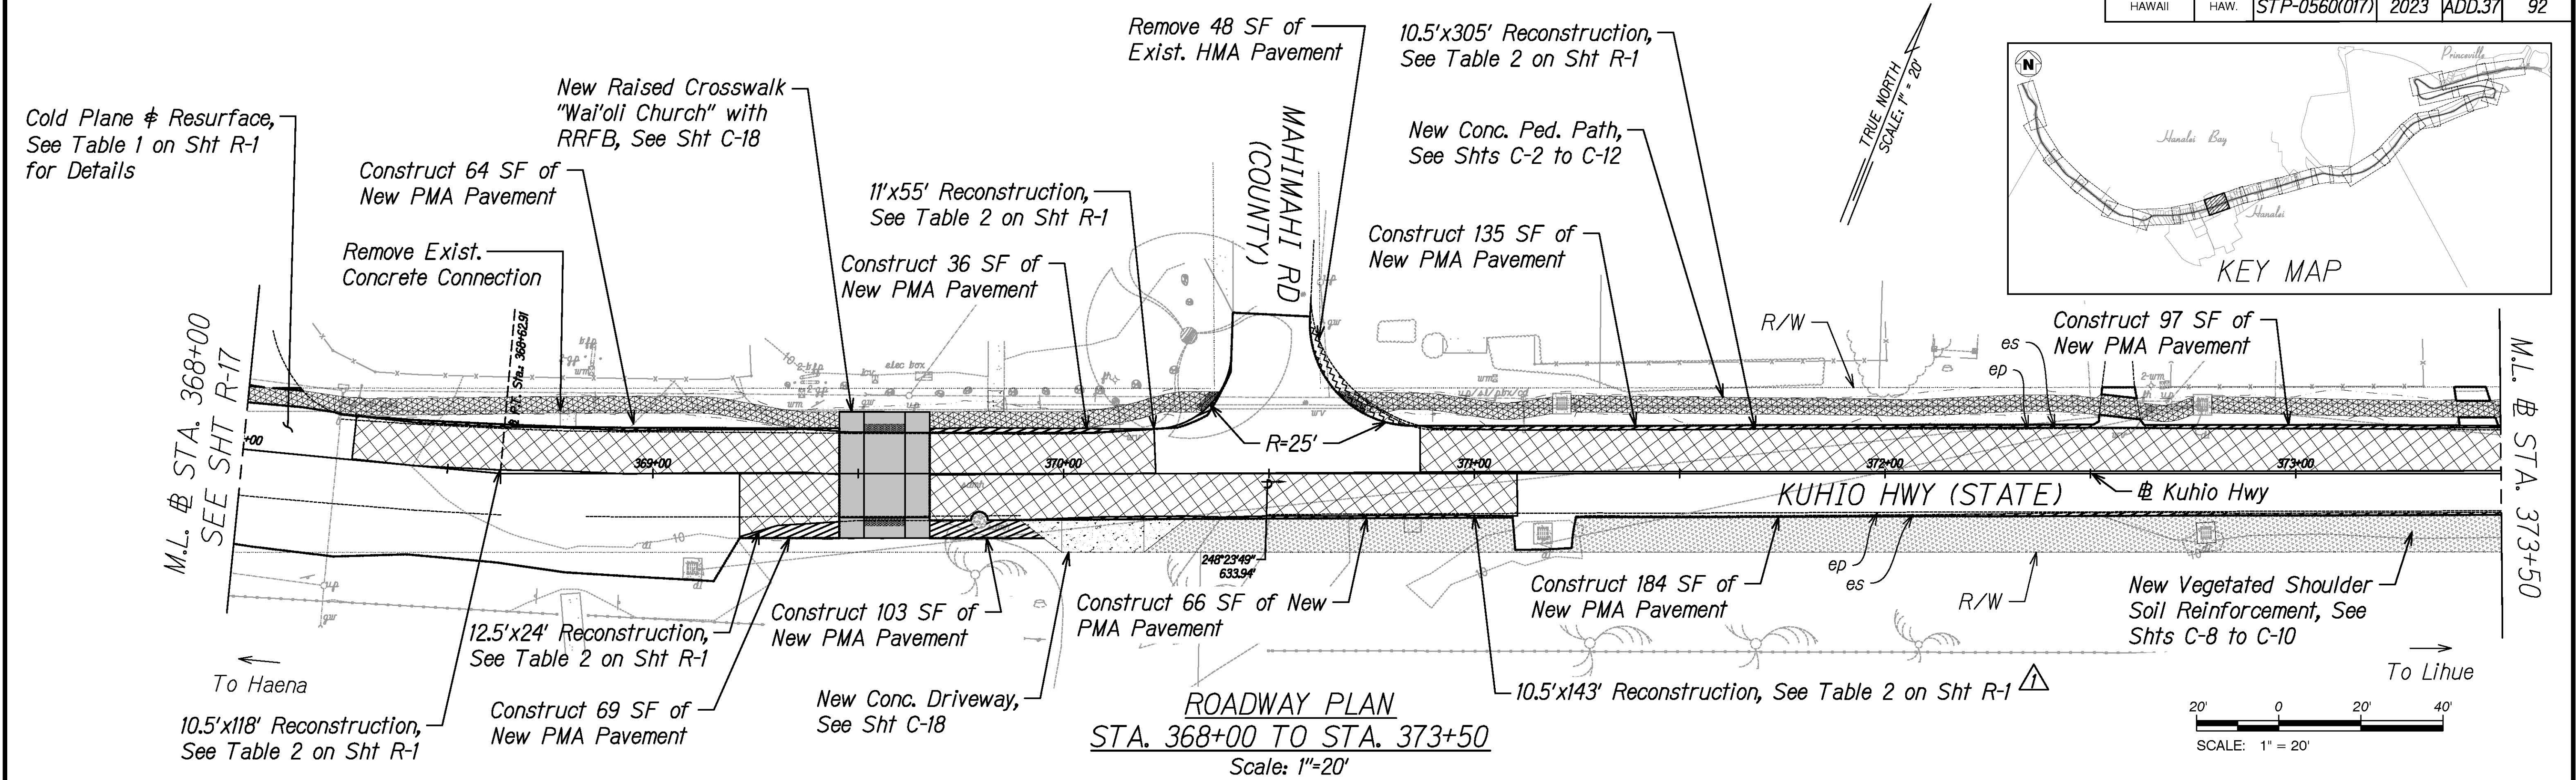


- NOTES:
- For Typical Roadway Sections, See Shts R-1 to R-8
 - Resurface All Existing A.C. Driveways to the R/W Limits
 - Remove All Exist. Excess HMA Pavement Beyond 12" from Center of 6" White Edge Pavement Striping.
 - Construct New PMA Pavement up to 12" from Center of 6" White Edge Pavement Striping if Exist. Shoulder is less than 12".
 - For New Pavement Areas, See Table 2 on Sht R-1



10/12/23	△ - Corrected Dimension
DATE	REVISION

STATE OF HAWAII DEPARTMENT OF TRANSPORTATION HIGHWAYS DIVISION	
ROADWAY PLAN	
KUHIO HIGHWAY RESURFACING AND SAFETY IMPROVEMENTS	
Route 560 M.P. 0.0 to M.P. 4.5	
Fed. Aid Proj. No. STP-0560(017)	
Scale: 1"=20'	Date: July, 2023
SHEET No. R-18A OF 28 SHEETS	


SURVEY PLOTTED BY	DATE
DRAWN BY	
DESIGNED BY	
QUANTITIES BY	
CHECKED BY	
ORIGINAL PLAN	
NOTE BOOK	
NO.	

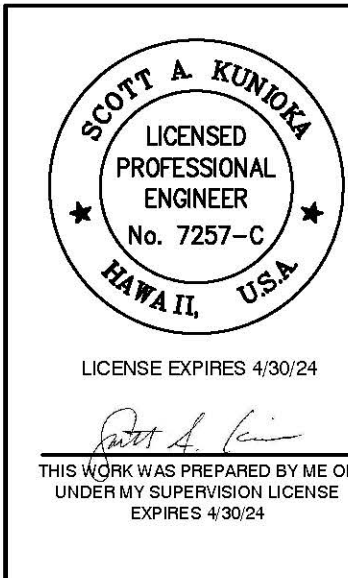

FED. ROAD DIST. NO.	STATE	FED. AID PROJ. NO.	FISCAL YEAR	SHEET NO.	TOTAL SHEETS
HAWAII	HAW.	STP-0560(017)	2023	ADD.39	92

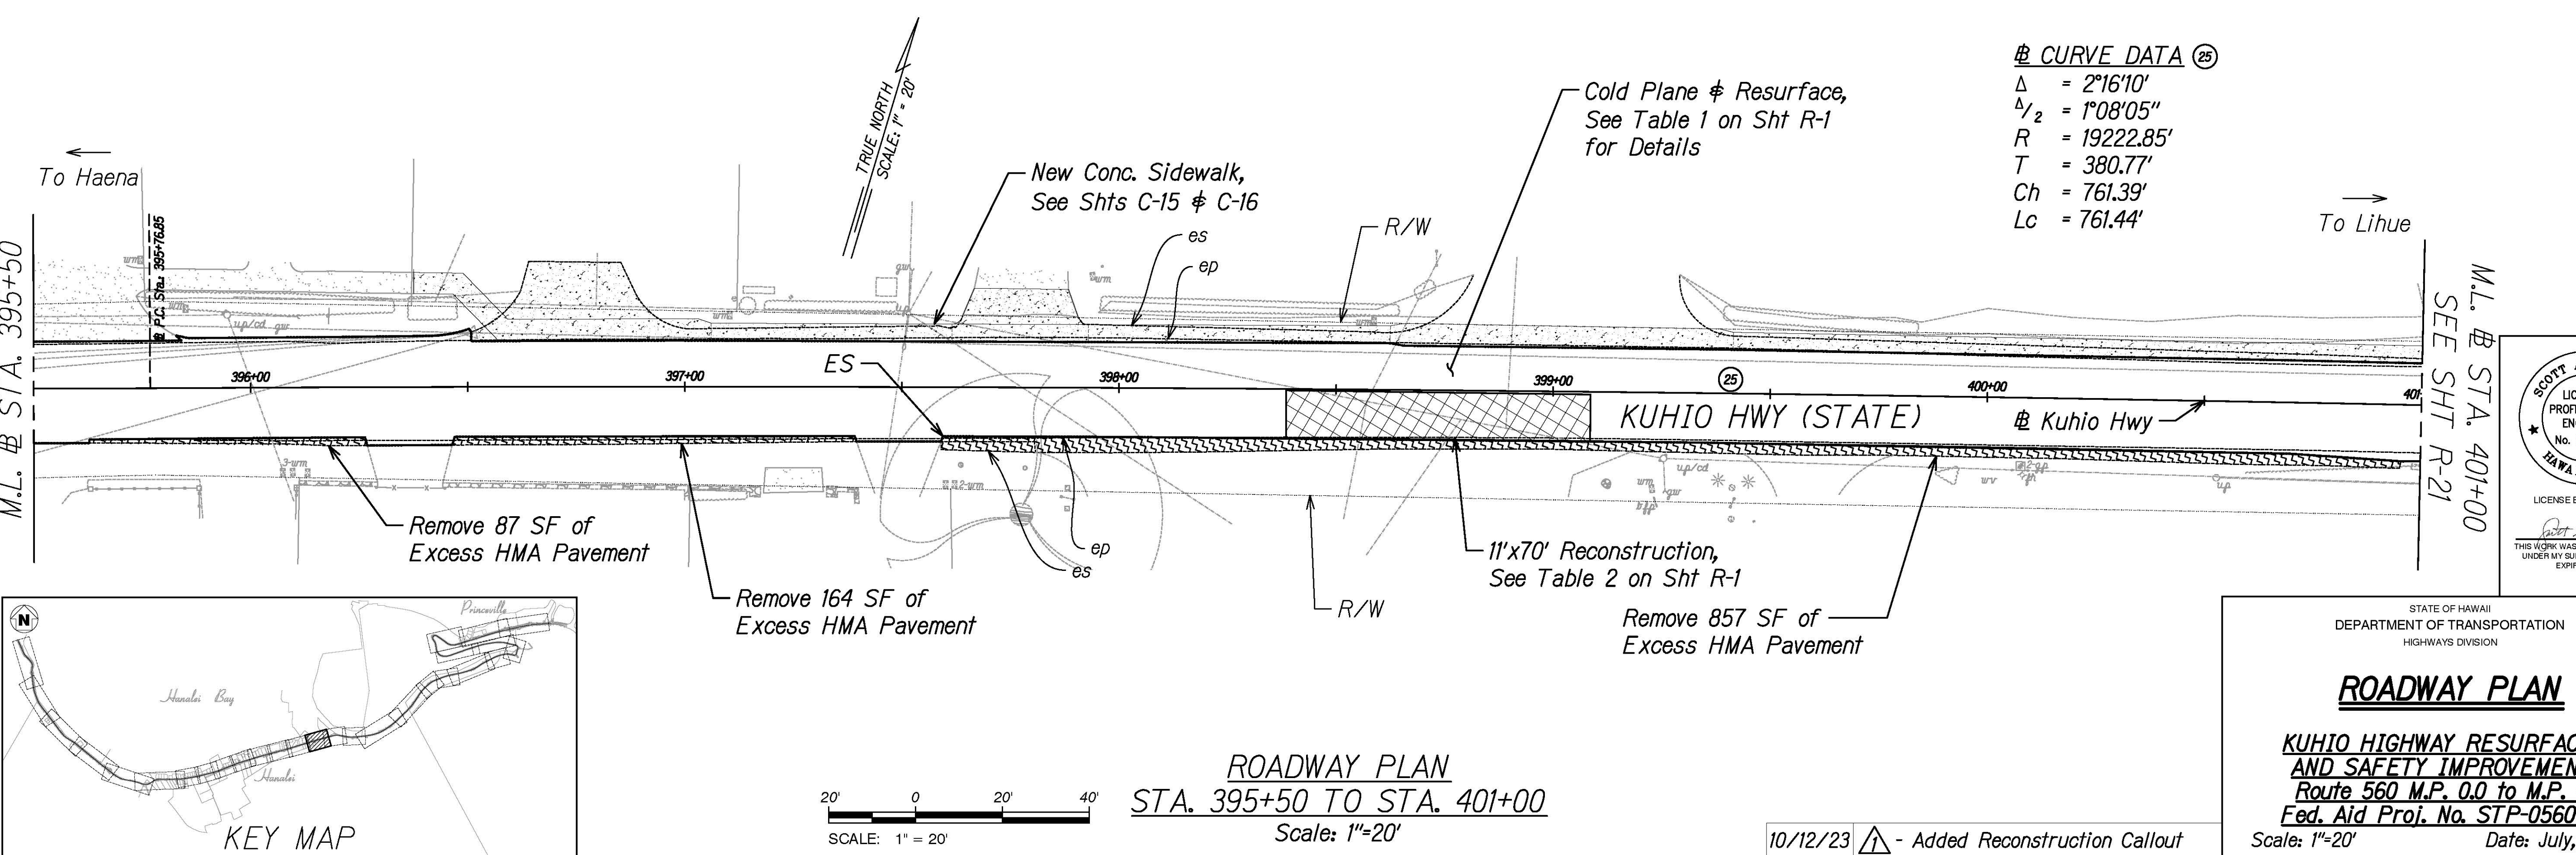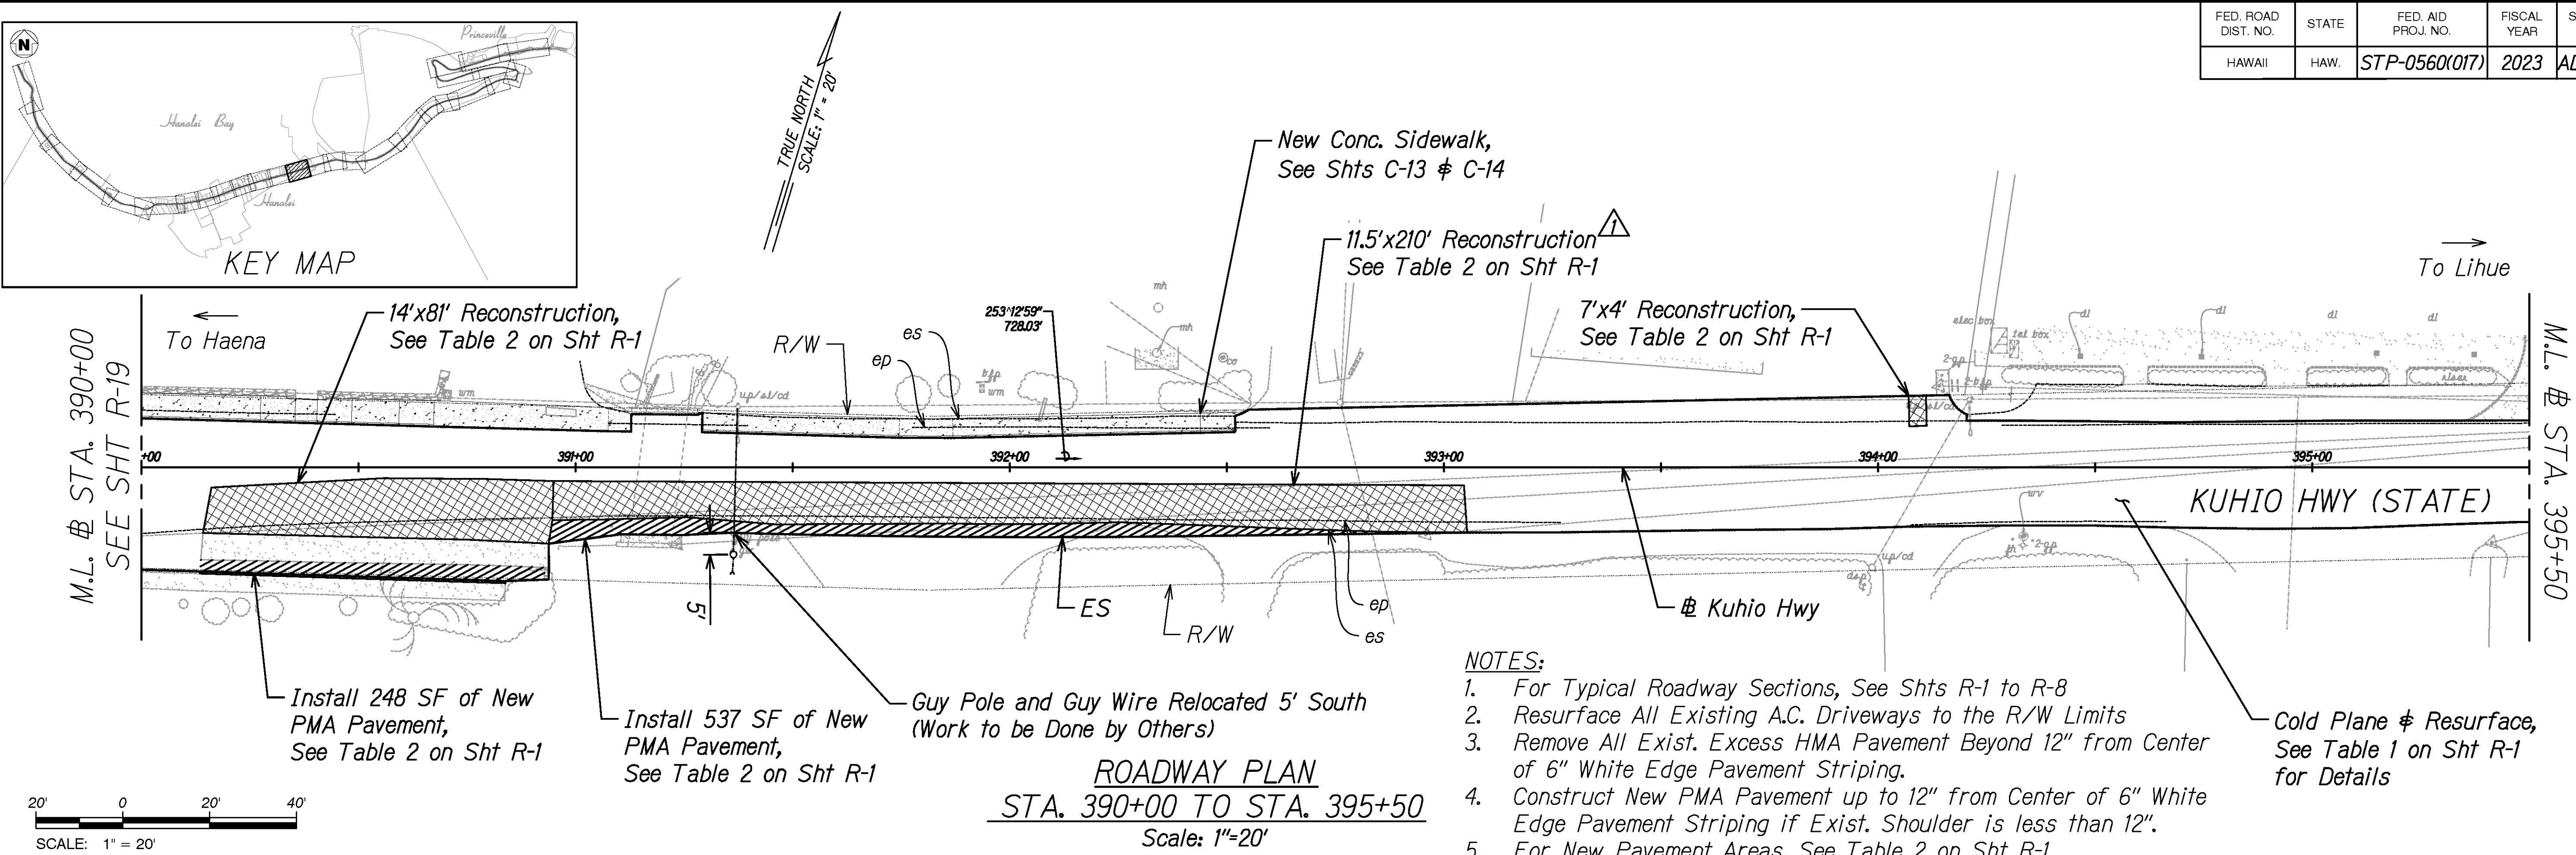

SURVEY PLOTTED BY	DATE
DRAWN BY	
DESIGNED BY	
QUANTITIES BY	
CHECKED BY	
NO.	

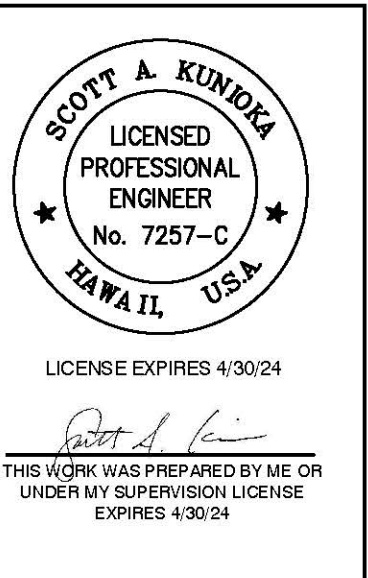

STATE OF HAWAII
DEPARTMENT OF TRANSPORTATION
HIGHWAYS DIVISION

ROADWAY PLAN

**KUHIO HIGHWAY RESURFACING
AND SAFETY IMPROVEMENTS**
Route 560 M.P. 0.0 to M.P. 4.5
Fed. Aid Proj. No. STP-0560(017)




Scale: 1"=20' Date: July, 2023

10/12/23 - Added Reconstruction Callout

DATE REVISION


SHEET No. R-20A OF 28 SHEETS

FED. ROAD DIST. NO.	STATE	FED. AID PROJ. NO.	FISCAL YEAR	SHEET NO.	TOTAL SHEETS
HAWAII	HAW.	STP-0560(017)	2023	ADD.41	92

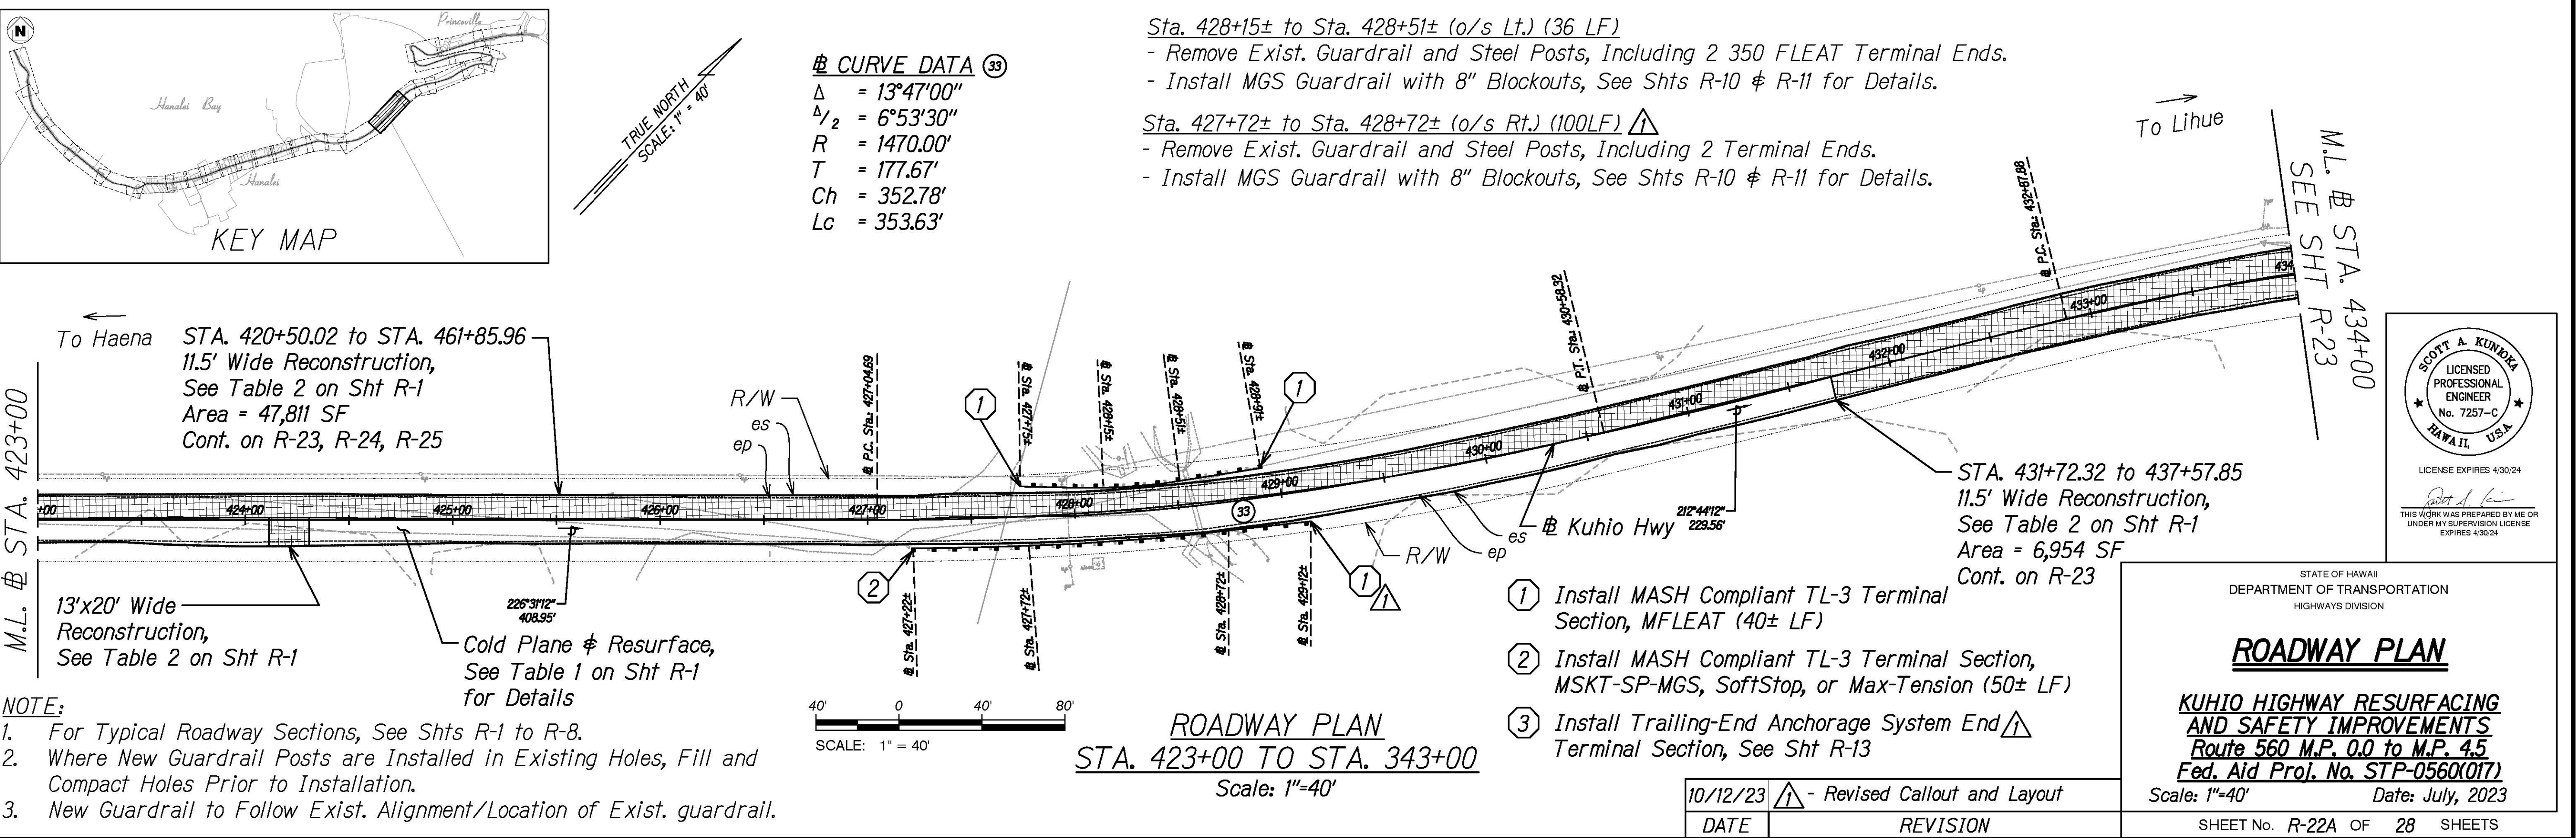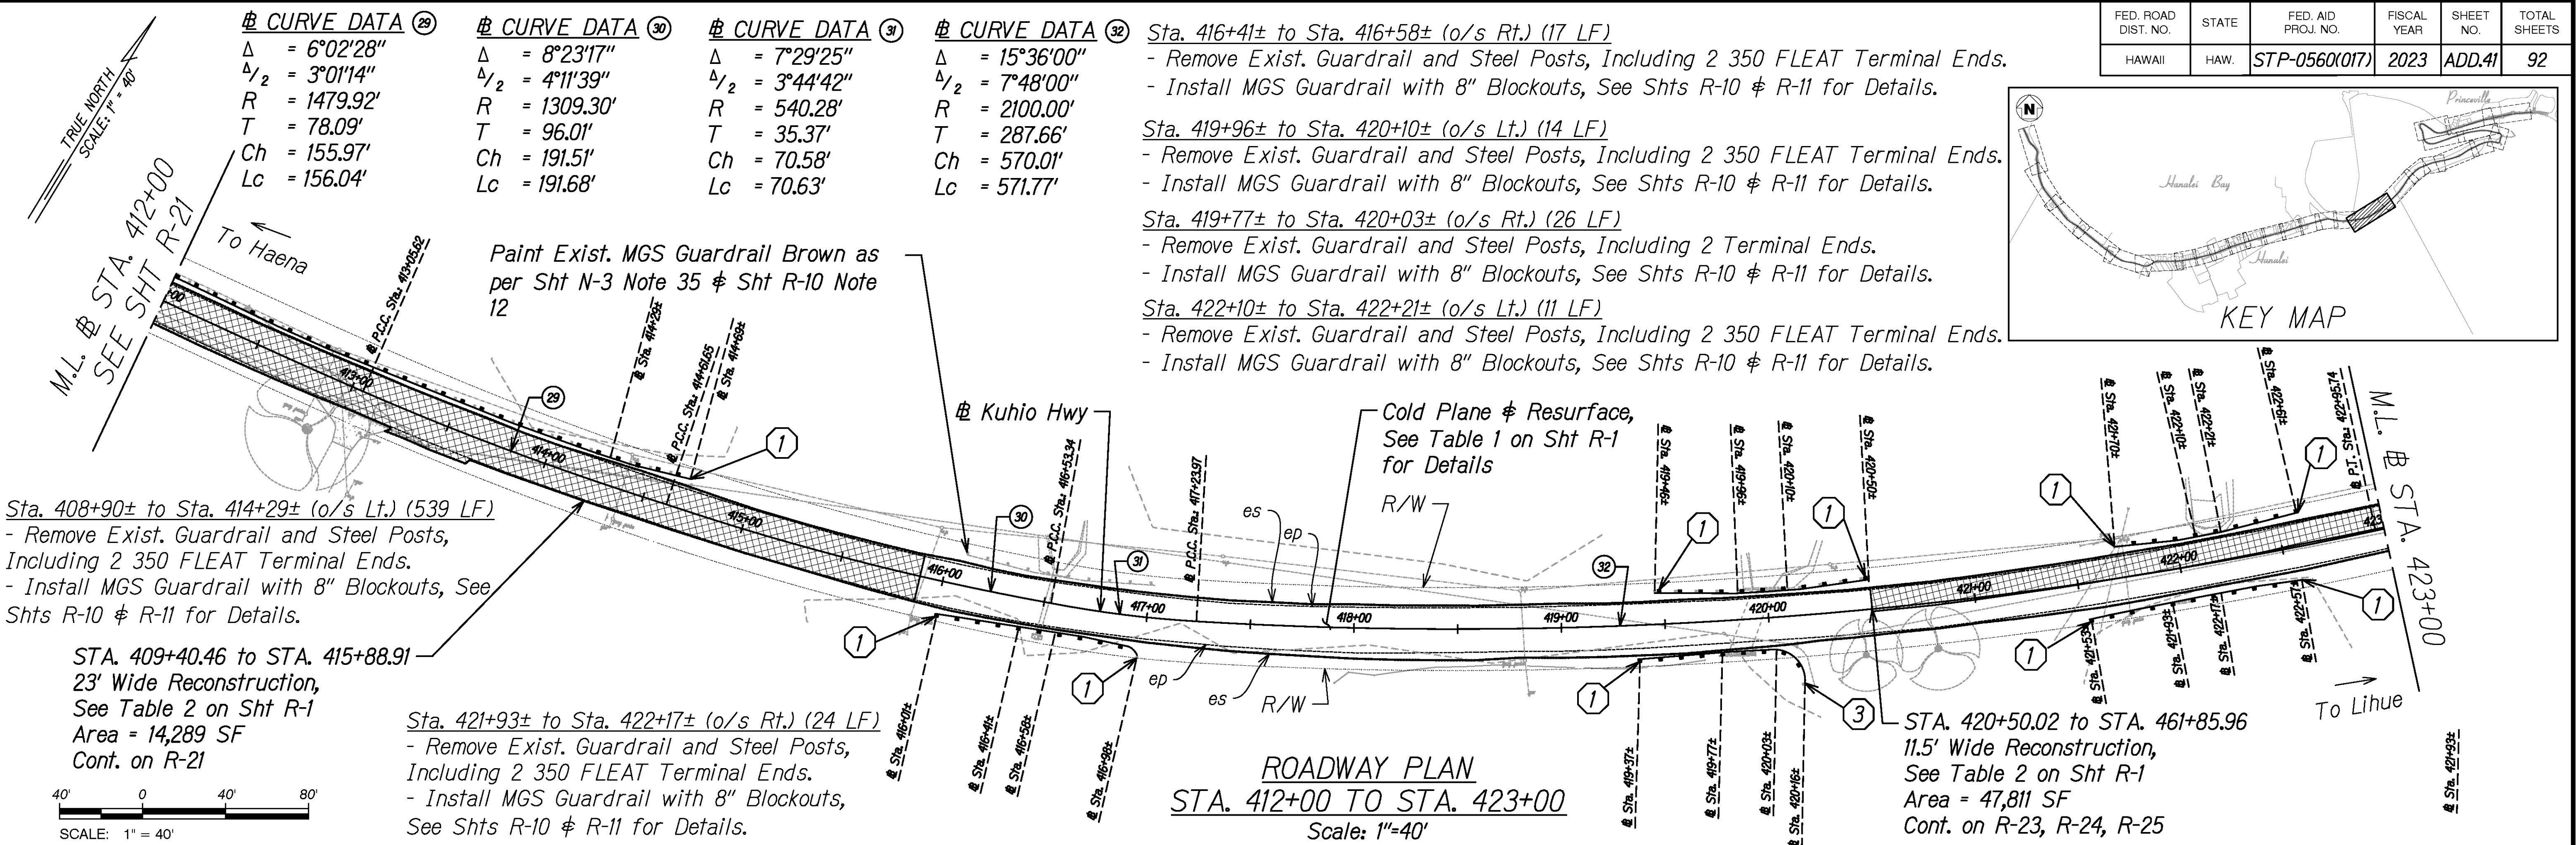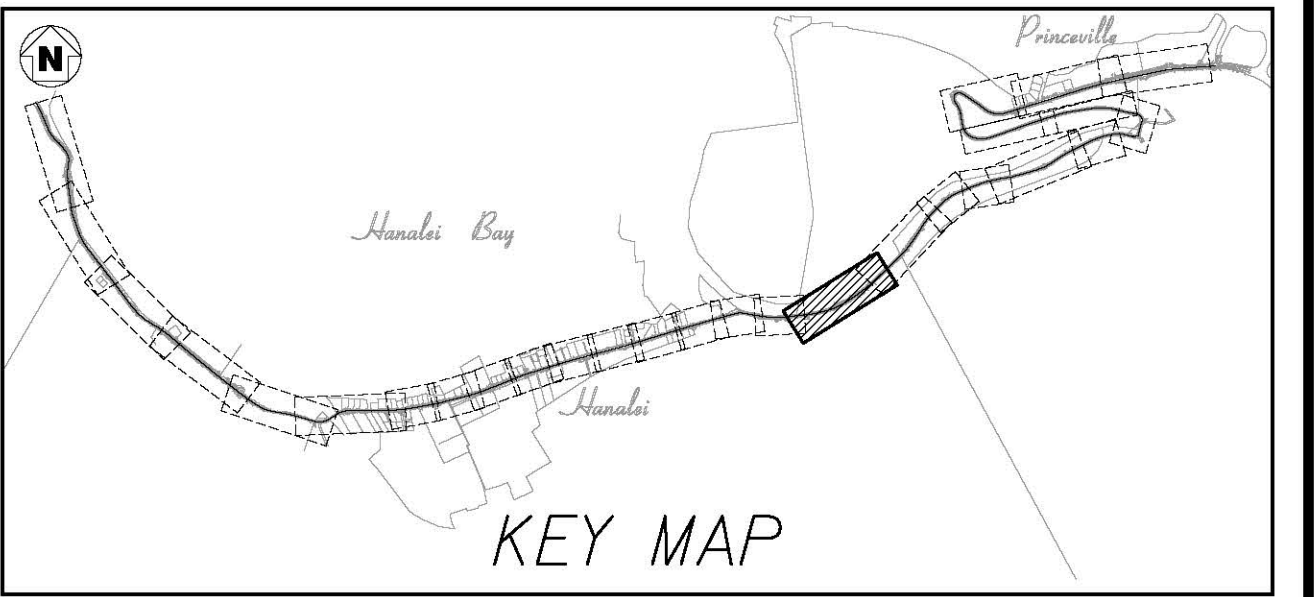

- NOTE:**
- For Typical Roadway Sections, See Shts R-1 to R-8.
 - Where New Guardrail Posts are Installed in Existing Holes, Fill and Compact Holes Prior to Installation.
 - New Guardrail to Follow Exist. Alignment/Location of Exist. guardrail.

SURVEYED BY	DATE
DRAWN BY	
DESIGNED BY	
QUANTITIES BY	
CHECKED BY	
ORIGINAL PLAN	
NOTE BOOK	
NO.	

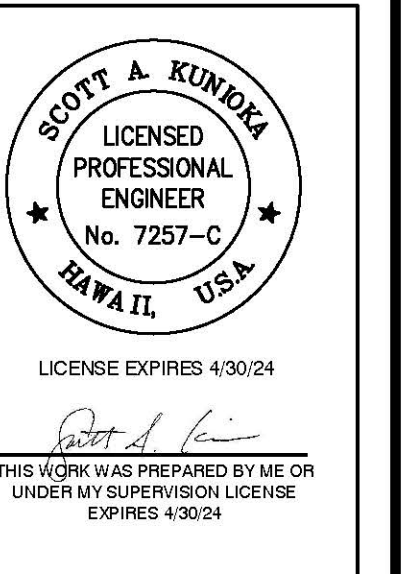

STATE OF HAWAII
DEPARTMENT OF TRANSPORTATION
HIGHWAYS DIVISION


ROADWAY PLAN

KUHIO HIGHWAY RESURFACING AND SAFETY IMPROVEMENTS
Route 560 M.P. 0.0 to M.P. 4.5
Fed. Aid Proj. No. STP-0560(017)

Scale: 1"=40' Date: July, 2023

SHEET No. R-22A OF 28 SHEETS

10/12/23	Δ - Revised Callout and Layout
DATE	REVISION

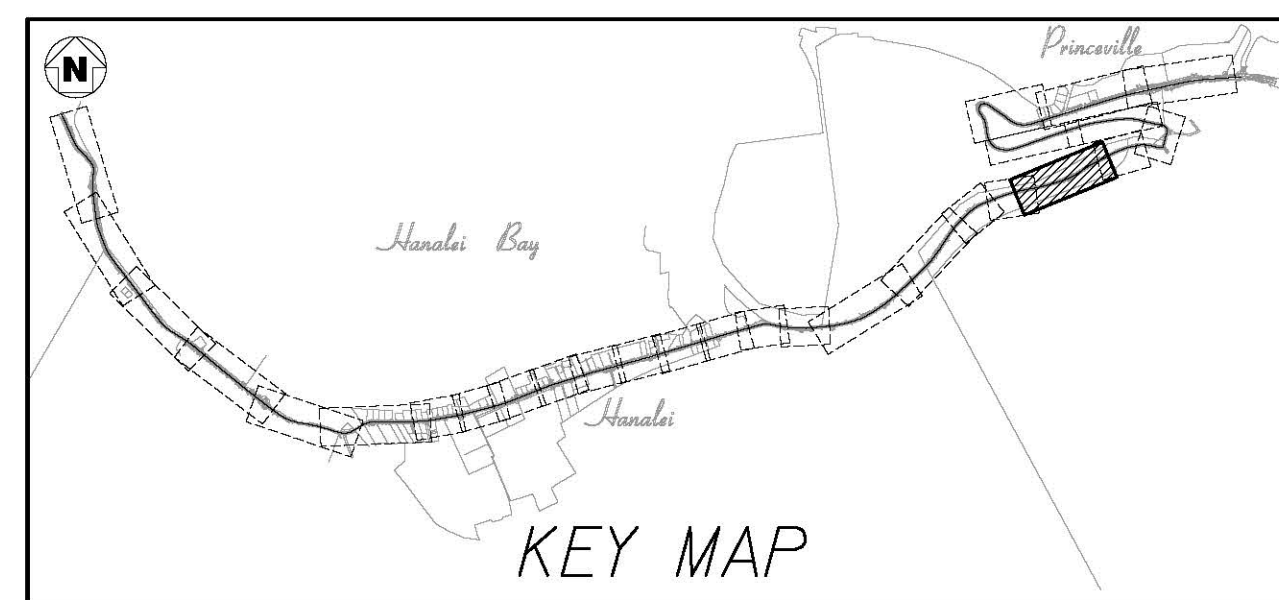

CURVE DATA (37)
 $\Delta = 8^{\circ}01'00''$
 $\Delta/2 = 4^{\circ}00'30''$
 $R = 1600.00'$
 $T = 112.12'$
 $Ch = 223.68'$
 $Lc = 223.87'$

CURVE DATA (38)
 $\Delta = 17^{\circ}51'00''$
 $\Delta/2 = 8^{\circ}55'30''$
 $R = 657.00'$
 $T = 103.18'$
 $Ch = 203.86'$
 $Lc = 204.68'$

CURVE DATA (39)
 $\Delta = 7^{\circ}25'30''$
 $\Delta/2 = 3^{\circ}42'45''$
 $R = 850.00'$
 $T = 55.15'$
 $Ch = 110.08'$
 $Lc = 110.15'$

Sta. 443+99± to Sta. 447+48± (o/s Lt.) (349 LF)
- Remove Exist. Guardrail and Steel Posts, Including 2 350 FLEAT Terminal Ends.
- Install MGS Guardrail with 8" Blockouts, See Shts R-10 & R-11 for Details.

Sta. 450+35± to Sta. 451+17± (o/s Lt.) (82 LF)
- Remove Exist. Guardrail and Steel Posts, Including 350 FLEAT Terminal End.
- Install MGS Guardrail with 8" Blockouts, See Shts R-10 & R-11 for Details.

STA. 420+50.02 to STA. 461+85.96
11.5' Wide Reconstruction,
See Table 2 on Sht R-1
Area = 47,811 SF
Cont. on R-22, R-23, R-25

Sta. 453+95± to Sta. 454+12± (o/s Lt.) (17 LF)
- Remove Exist. Guardrail and Steel Posts,
Including 2 350 FLEAT Terminal Ends.
- Install MGS Guardrail with 8" Blockouts,
See Shts R-10 & R-11 for Details.

Paint Exist. MGS Guardrail Brown as
per Sht N-3 Note 35 & Sht R-10 Note
12
Sta. 451+17± o/s Lt. Connect New
Guardrail to Exist. MGS Guardrail.

TRUE NORTH
SCALE: 1" = 40'

M.L. # STA. 445+00
SEE SHT R-23

SCALE: 1" = 40'

ROADWAY PLAN
STA. 445+00 TO STA. 456+00
Scale: 1"=40'

STA. 438+42.39 to STA. 451+51.76
11.5' Wide Reconstruction,
See Table 2 on Sht R-1
Area = 15,751 SF
Cont. on R-23

Sta. 450+40± to Sta. 450+76± (o/s Rt.) (36 LF)
- Remove Exist. Guardrail and Steel Posts,
Including 350 FLEAT Terminal End.
- Install MGS Guardrail with 8" Blockouts,
See Shts R-10 & R-11 for Details.

STA. 453+56.62 to STA. 455+50.69
11.5' Wide Reconstruction,
See Table 2 on Sht R-1
Area = 2,514 SF

Sta. 458+37± to Sta. 458+97± (o/s Lt.) (60 LF)
- Remove Exist. Guardrail and Steel Posts, Including 2 350 FLEAT Terminal Ends.
- Install MGS Guardrail with 8" Blockouts, See Shts R-10 & R-11 for Details.


CURVE DATA (40)
 $\Delta = 19^{\circ}03'09''$
 $\Delta/2 = 9^{\circ}31'35''$
 $R = 945.27'$
 $T = 158.63'$
 $Ch = 312.88'$
 $Lc = 314.33'$

M.L. # STA. 456+00
To Haena

STA. 456+13.76 to STA. 459+36.83
11.5' Wide Reconstruction,
See Table 2 on Sht R-1
Area = 3,750 SF

NOTE:

1. For Typical Roadway Sections, See Shts R-1 to R-8.
2. Where New Guardrail Posts are Installed in Existing Holes, Fill and Compact Holes Prior to Installation.
3. New Guardrail to Follow Exist. Alignment/Location of Exist. guardrail.

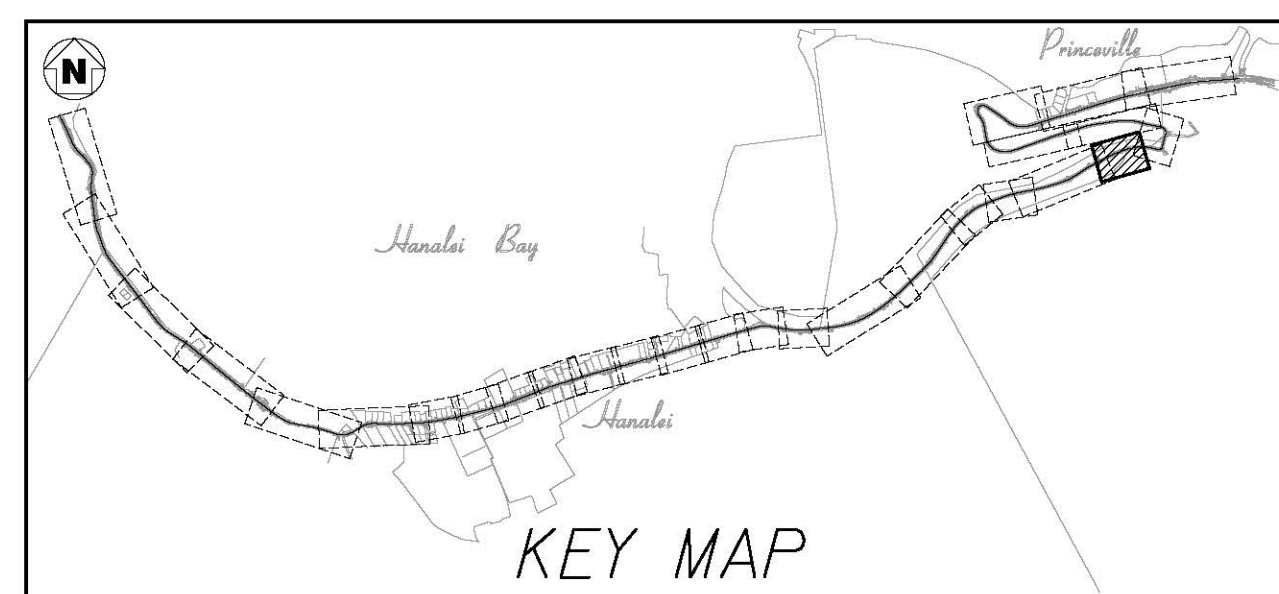

SCALE: 1" = 20'

ROADWAY PLAN
STA. 456+00 TO STA. 461+00
Scale: 1"=20'

Cold Plane & Resurface,
See Table 1 on Sht R-1
for Details

1. Install MASH Compliant TL-3 Terminal Section, MFLEAT (40± LF)
2. Install MASH Compliant TL-3 Terminal Section, MSKT-SP-MGS, SoftStop, or Max-Tension (50± LF)
3. Install Trailing-End Anchorage System End Δ Terminal Section, See Sht R-13

10/12/23 Δ - Revised Callout
DATE REVISION

M.L. # STA. 461+00
SEE SHT R-25
To Lihue

TRUE NORTH
SCALE: 1" = 20'




STATE OF HAWAII
DEPARTMENT OF TRANSPORTATION
HIGHWAYS DIVISION

ROADWAY PLAN

KUHIO HIGHWAY RESURFACING
AND SAFETY IMPROVEMENTS
Route 560 M.P. 0.0 to M.P. 4.5
Fed. Aid Proj. No. STP-0560(017)
Scale: As Noted Date: July, 2023

SHEET No. R-24A OF 28 SHEETS

ADD. 43

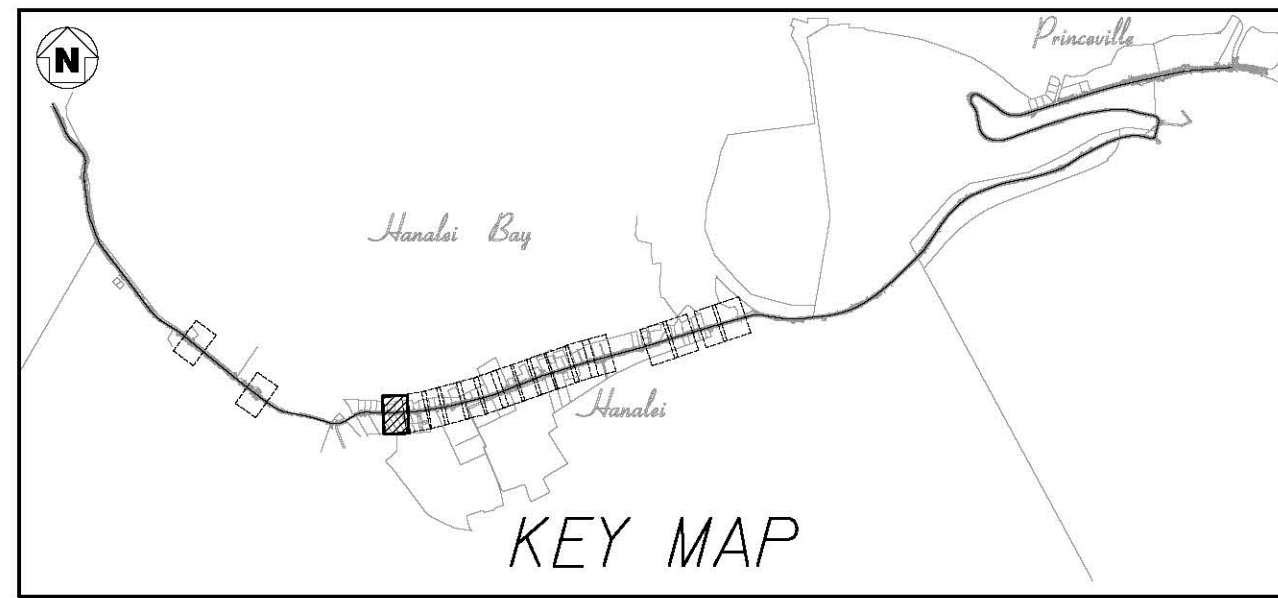


CL CURVE DATA ①	CL CURVE DATA ②	CL CURVE DATA ③	CL CURVE DATA ④	CL CURVE DATA ⑤	CL CURVE DATA ⑥	CL CURVE DATA ⑦
$\Delta = 28^{\circ}53'47''$	$\Delta = 29^{\circ}04'30''$	$\Delta = 16^{\circ}26'27''$	$\Delta = 16^{\circ}42'34''$	$\Delta = 12^{\circ}36'12''$	$\Delta = 14^{\circ}17'05''$	$\Delta = 2^{\circ}35'18''$
$\Delta/2 = 14^{\circ}26'53''$	$\Delta/2 = 14^{\circ}32'15''$	$\Delta/2 = 8^{\circ}13'14''$	$\Delta/2 = 8^{\circ}21'17''$	$\Delta/2 = 6^{\circ}18'06''$	$\Delta/2 = 7^{\circ}08'32''$	$\Delta/2 = 1^{\circ}17'39''$
$R = 7.50'$	$R = 10.00'$	$R = 10.00'$	$R = 10.05'$	$R = 25.00'$	$R = 25.00'$	$R = 100.00'$
$T = 1.93'$	$T = 2.59'$	$T = 1.44'$	$T = 1.48'$	$T = 2.76'$	$T = 3.13'$	$T = 2.26'$
$Ch = 3.74'$	$Ch = 5.02'$	$Ch = 2.86'$	$Ch = 2.92'$	$Ch = 5.49'$	$Ch = 6.22'$	$Ch = 4.52'$
$Lc = 3.78'$	$Lc = 5.07'$	$Lc = 2.87'$	$Lc = 2.93'$	$Lc = 5.50'$	$Lc = 6.23'$	$Lc = 4.52'$



FED. ROAD DIST. NO.	STATE	FED. AID PROJ. NO.	FISCAL YEAR	SHEET NO.	TOTAL SHEETS
HAWAII	HAW.	STP-0560(017)	2023	ADD.49	92

CL CURVE DATA ⑧
$\Delta = 2^{\circ}07'52''$
$\Delta/2 = 1^{\circ}04'56''$
$R = 100.00'$
$T = 1.86'$
$Ch = 3.72'$
$Lc = 3.72'$

CL CURVE DATA ⑨
$\Delta = 0^{\circ}55'10''$
$\Delta/2 = 0^{\circ}27'35''$
$R = 200.00'$
$T = 1.60'$
$Ch = 3.21'$
$Lc = 3.21'$

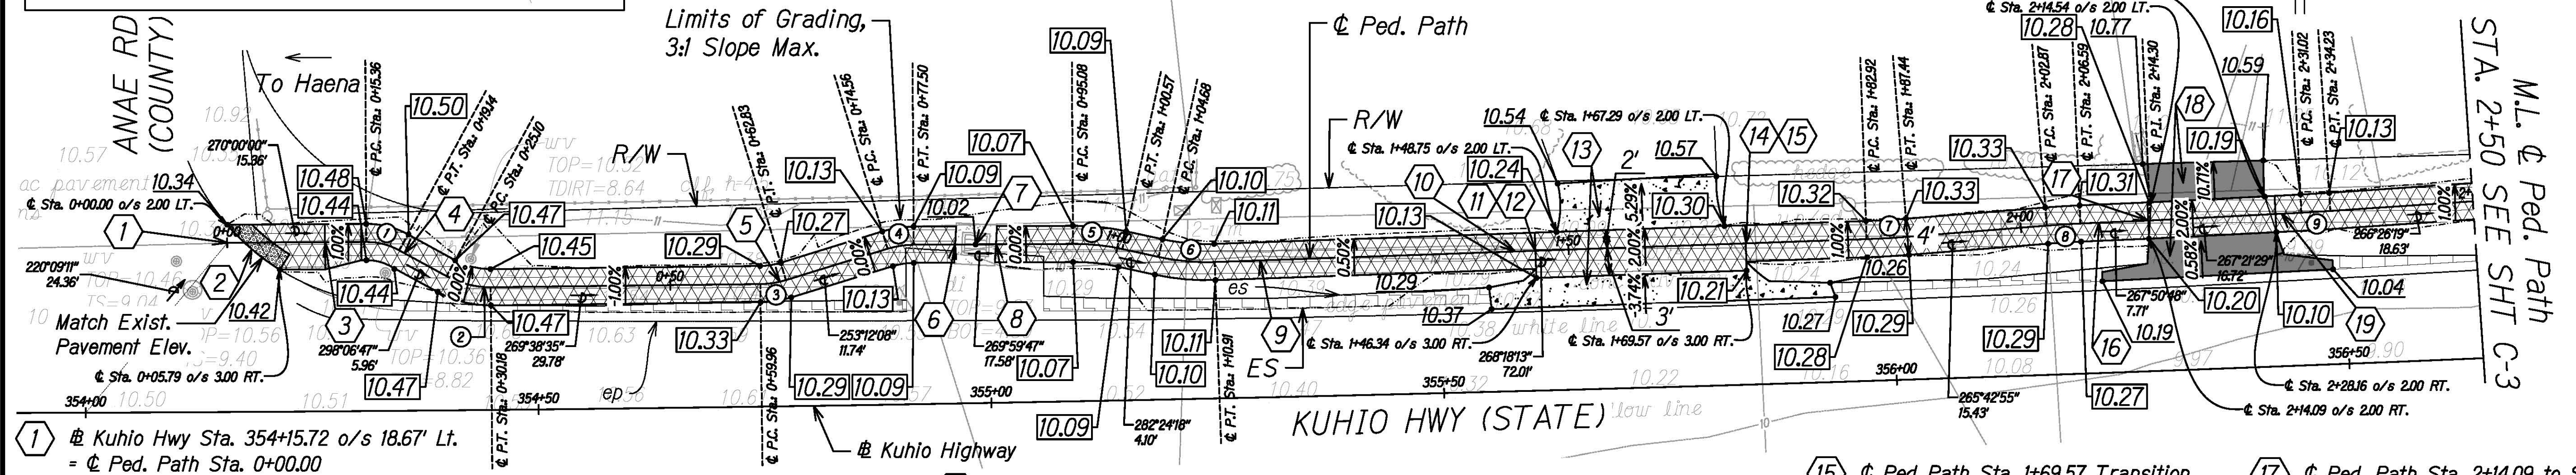

WEST HANAIEI PEDESTRIAN PATH
STA. 0+00 TO STA. 2+50 - PLAN
Scale: 1"=10'

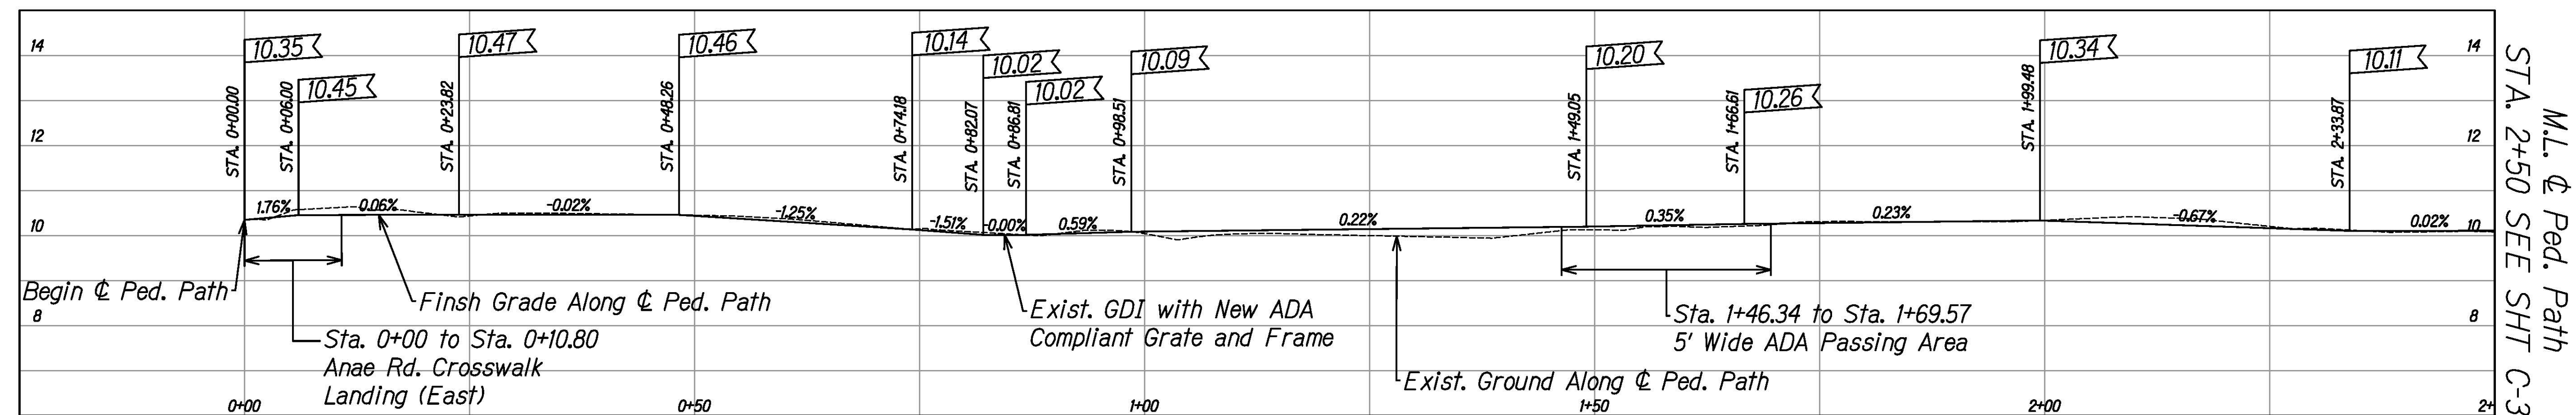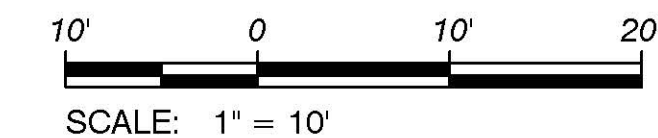

WEST HANAIEI PEDESTRIAN PATH
STA. 0+00 TO STA. 2+50 - PROFILE
Scale: Horiz: 1"=10'
Vert: 1"=2'

PEDESTRIAN PATH DETAIL
Not to Scale

6" THICK PEDESTRIAN PATH DETAIL
Not to Scale

10/12/23	Revised Slope Maximum
DATE	REVISION

STATE OF HAWAII
DEPARTMENT OF TRANSPORTATION
HIGHWAYS DIVISION

**HANAIEI TOWN CIVIL
IMPROVEMENTS**

**KUHIO HIGHWAY RESURFACING
AND SAFETY IMPROVEMENTS**



Route 560 M.P. 0.0 to M.P. 4.5

Fed. Aid Proj. No. STP-0560(017)

Scale: As Noted Date: July, 2023

SHEET No. C-2A OF 22 SHEETS


FED. ROAD DIST. NO.	STATE	FED. AID PROJ. NO.	FISCAL YEAR	SHEET NO.	TOTAL SHEETS
HAWAII	HAW.	STP-0560(017)	2023	ADD.60	92

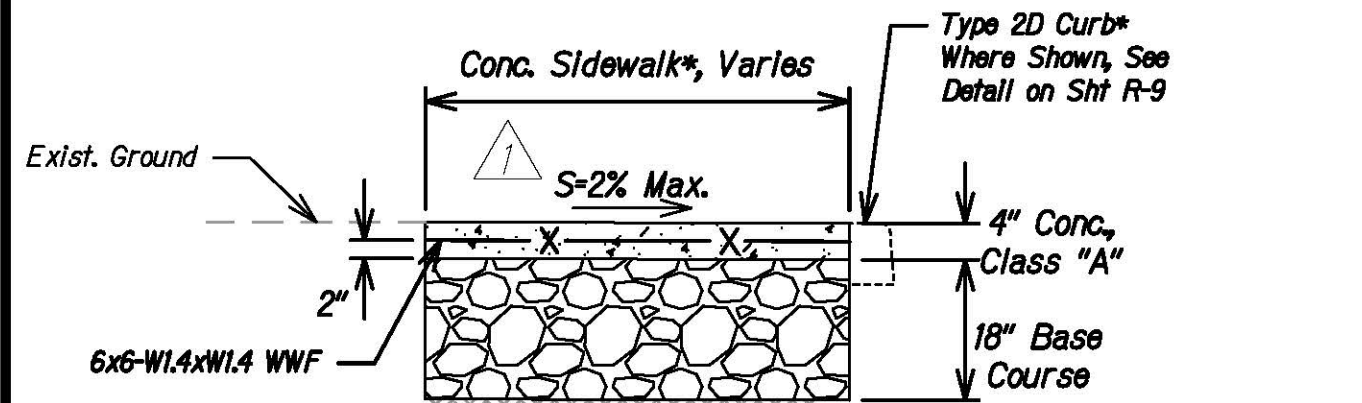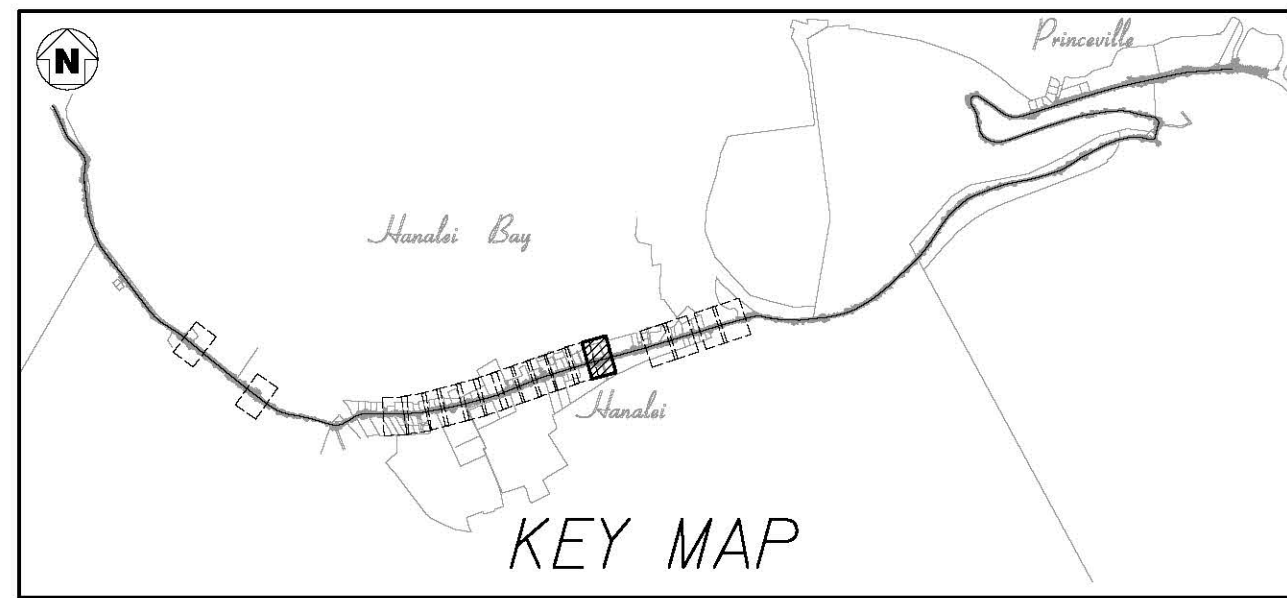

*Sidewalk & Curb to be Colored Brown, BASF "Champagne MC2510" or Approved Equal

4" THICK CONC. SIDEWALK DETAIL


Not to Scale

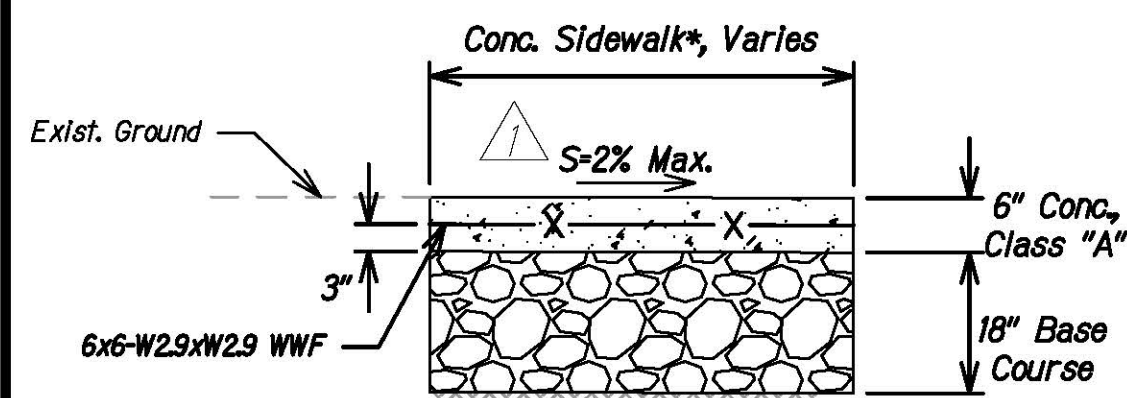

*Sidewalk & Curb to be Colored Brown, BASF "Champagne MC2510" or Approved Equal



6" THICK CONC. SIDEWALK DETAIL

Not to Scale

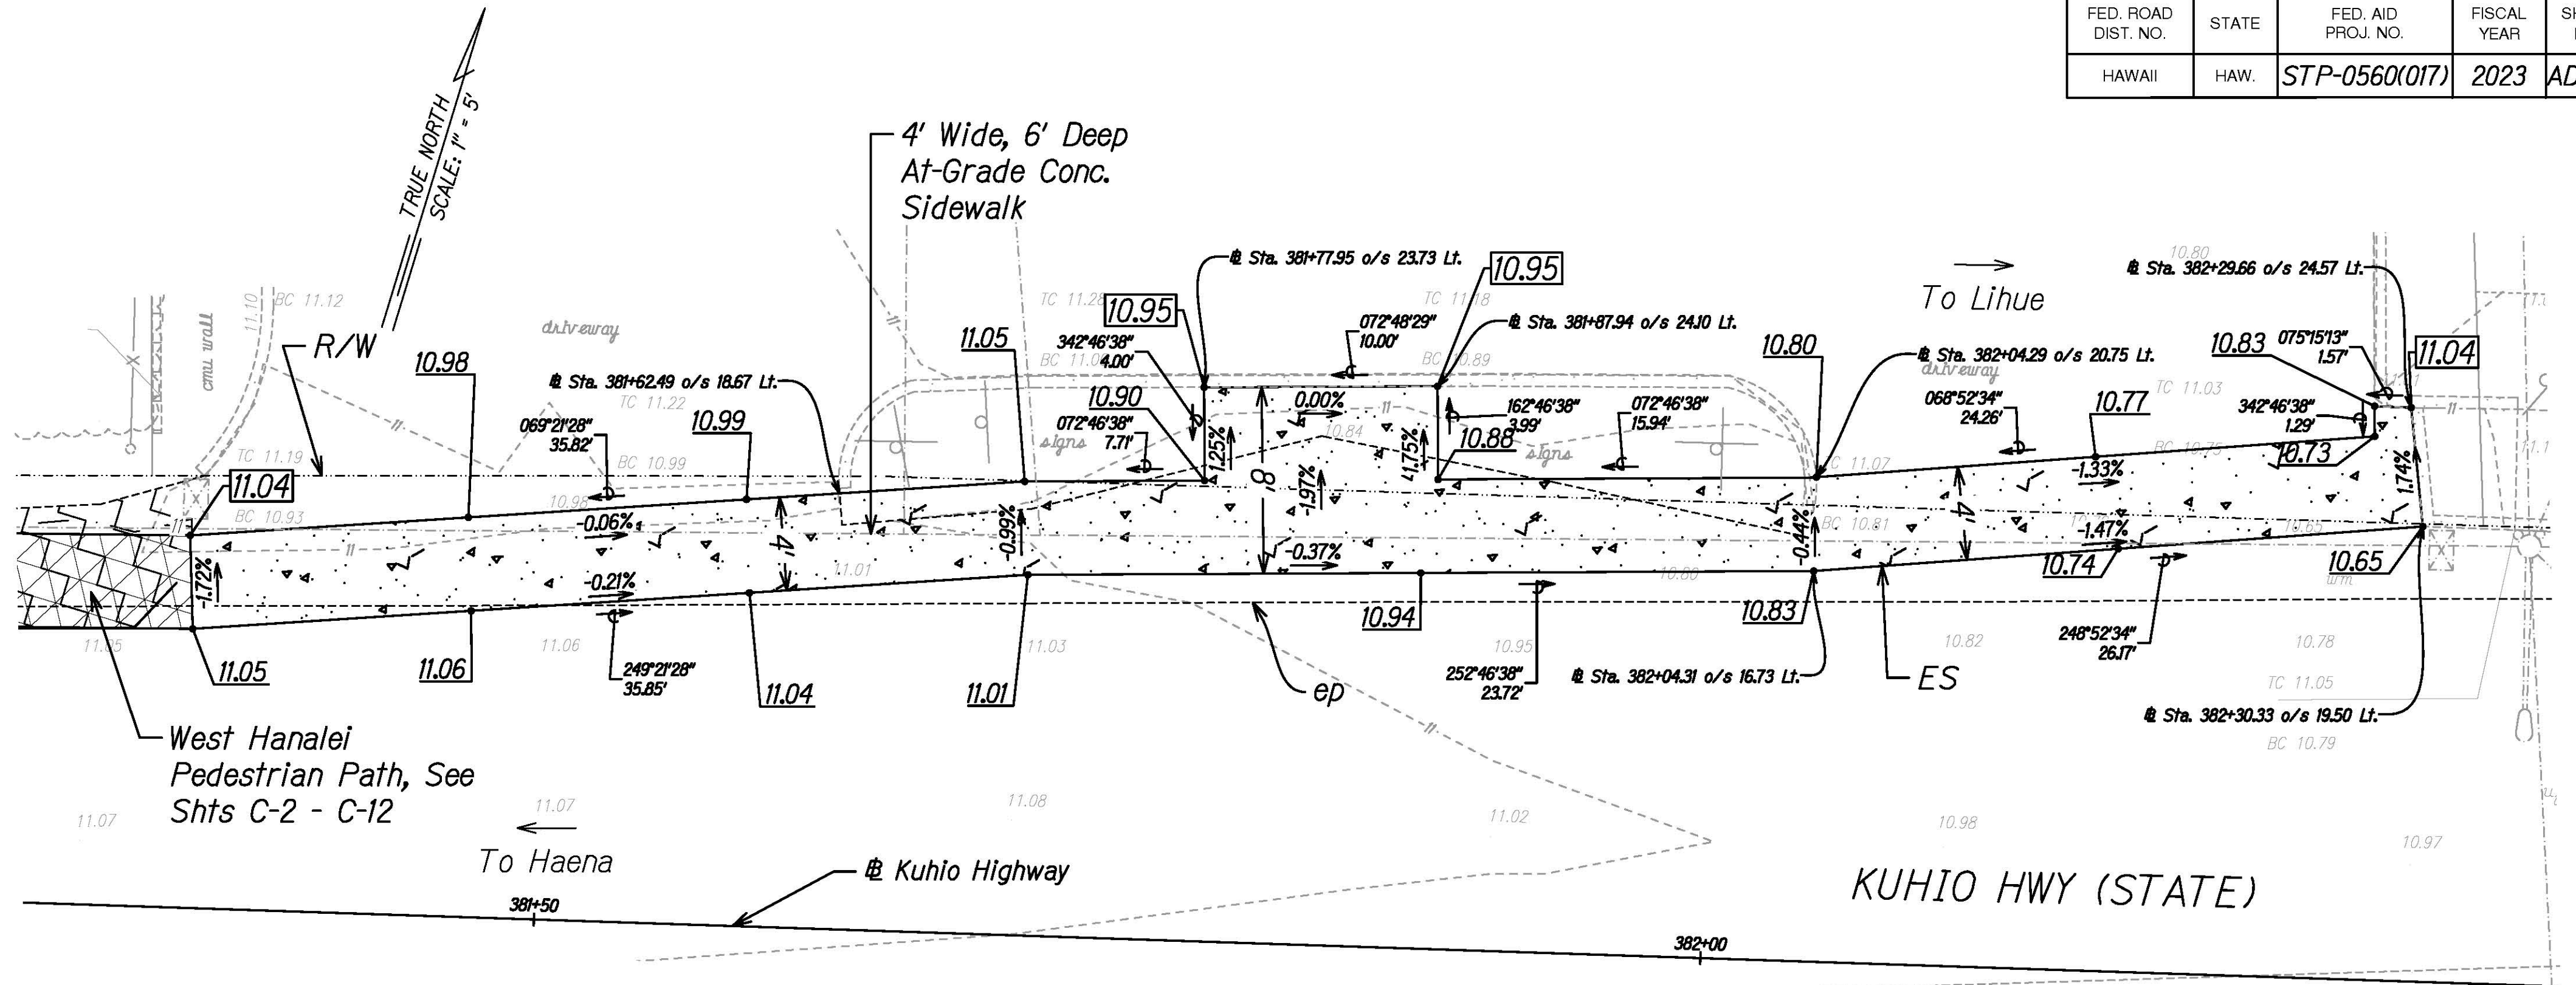


HANALEI POST OFFICE AT-GRADE SIDEWALK CONNECTION PLAN

Scale: 1"=5'

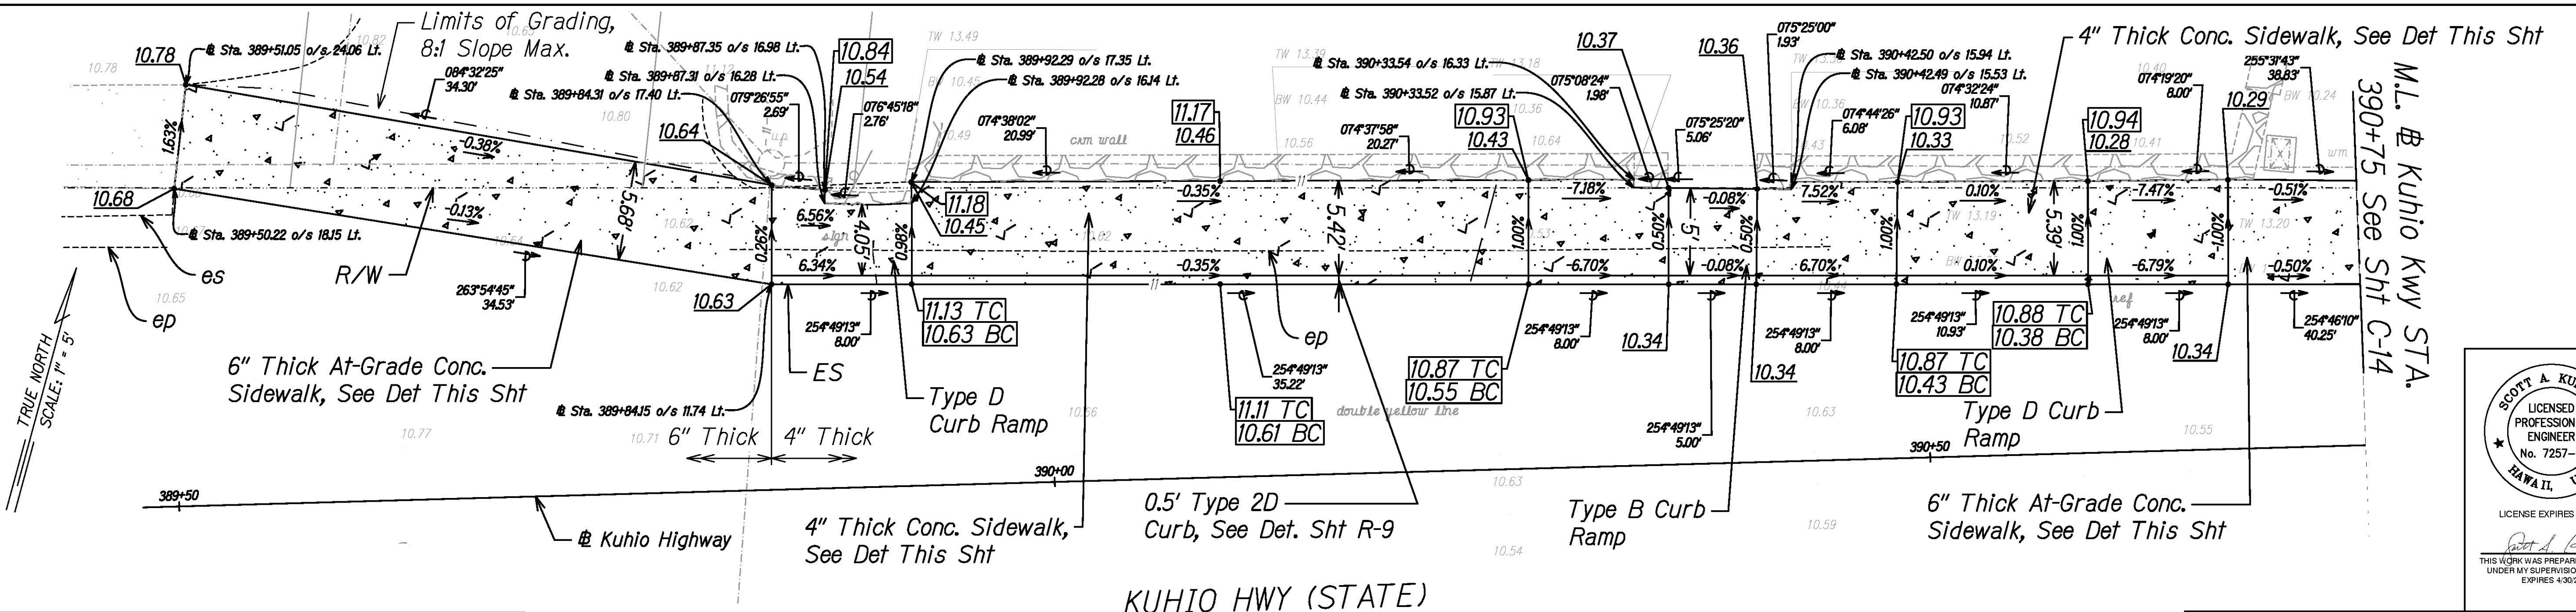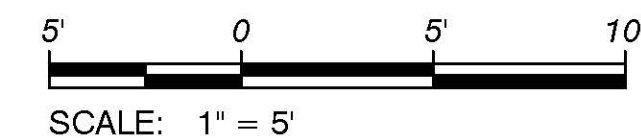


EAST HANAIEI RAISED SIDEWALK PLAN

Scale: 1"=5'

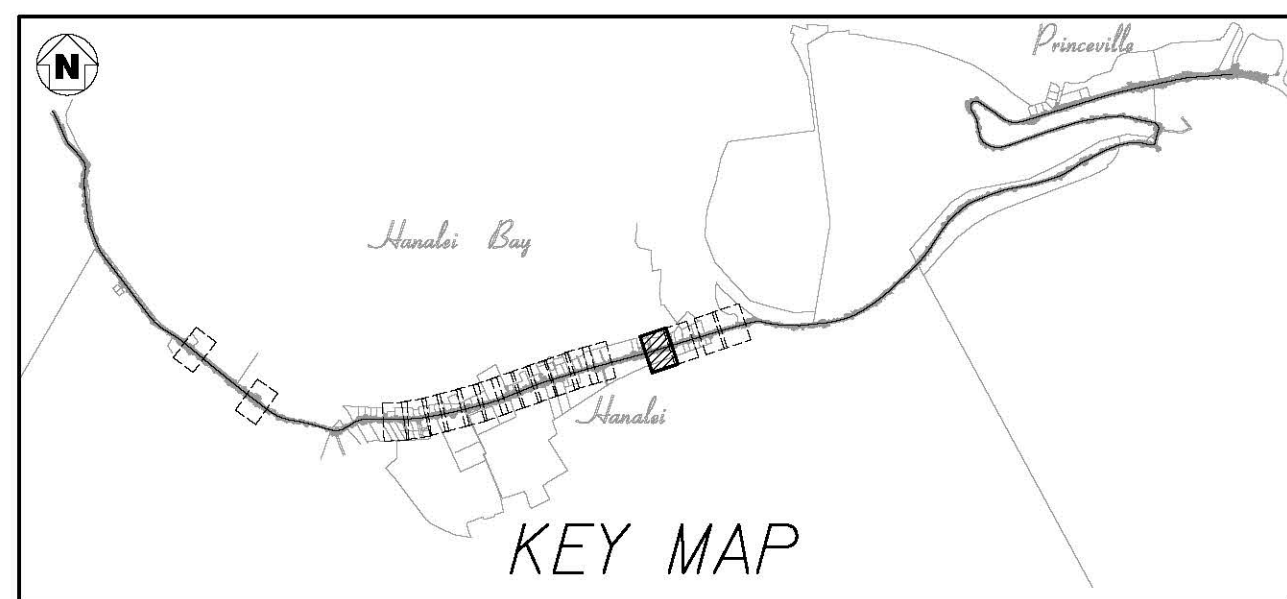

SURVEY PLOTTED BY	DATE
DRAWN BY	
DESIGNED BY	
QUANTITIES BY	
CHECKED BY	

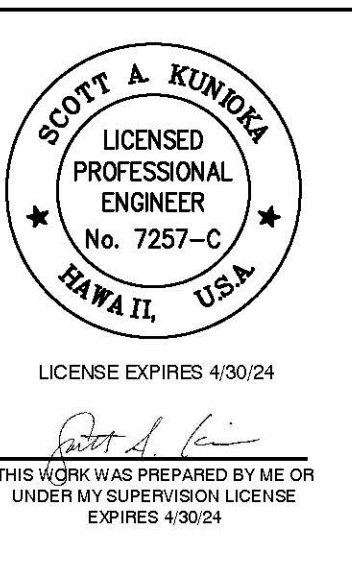

STATE OF HAWAII
DEPARTMENT OF TRANSPORTATION
HIGHWAYS DIVISION

HANALEI TOWN CIVIL IMPROVEMENTS
KUHIO HIGHWAY RESURFACING AND SAFETY IMPROVEMENTS
Route 560 M.P. 0.0 to M.P. 4.5
Fed. Aid Proj. No. STP-0560(017)

Scale: 1"=5' Date: July, 2023


SHEET No. C-13A OF 22 SHEETS

10/12/23	▲ - Revised Slope Maximum
DATE	REVISION



FED. ROAD DIST. NO.	STATE	FED. AID PROJ. NO.	FISCAL YEAR	SHEET NO.	TOTAL SHEETS
HAWAII	HAW.	STP-0560(017)	2023	ADD.71	92

SIGN POST NOTES:


- Object Markers (OM-5) shall be installed on all proposed regulatory and warning sign posts within the project limits.
- If a strip of reflective material is used on the sign support, it shall be at least 2 inches in width, it shall be placed for the full length of the support from the sign within 2 feet above the edge of roadway, and its color shall match the background color of the sign, except that the color of the strip for the "YIELD" and "DO NOT ENTER" signs shall be red. Payment for reflective material shall be considered incidental to the various pay items.
- Background of object marker shall be retroreflectorized with Type XI retroreflective sheeting.
- Install new type II Object Marker (OM2-2H) on all utility poles and trees that are shown on the pavement and striping plan. Refer to Standard Plan No. TE-15 for details.
- All red OM-5 object markers shall cover 4 sides of the sign post. All other OM-5 object marker colors shall cover 3 sides of the sign post, facing all directions.
- See TE-16 for typical sign installation.
- All existing RRFB assemblies shall be returned to the State.

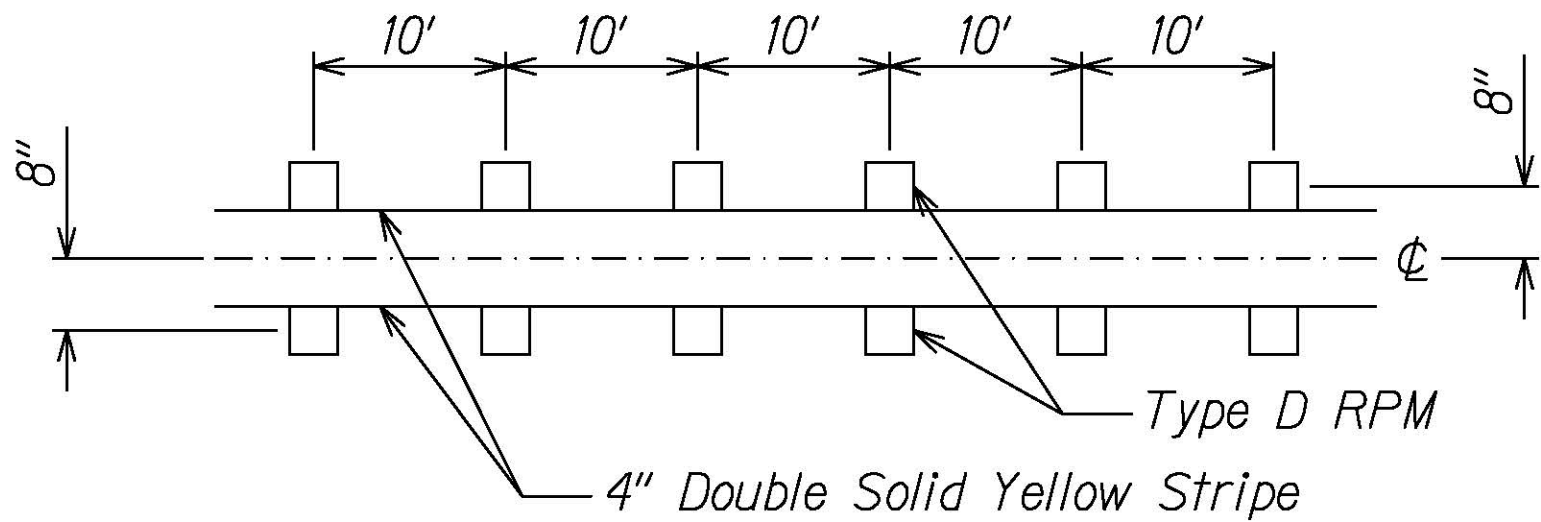


LAYOUT AT DOUBLE NO PASS ZONE
Not to Scale

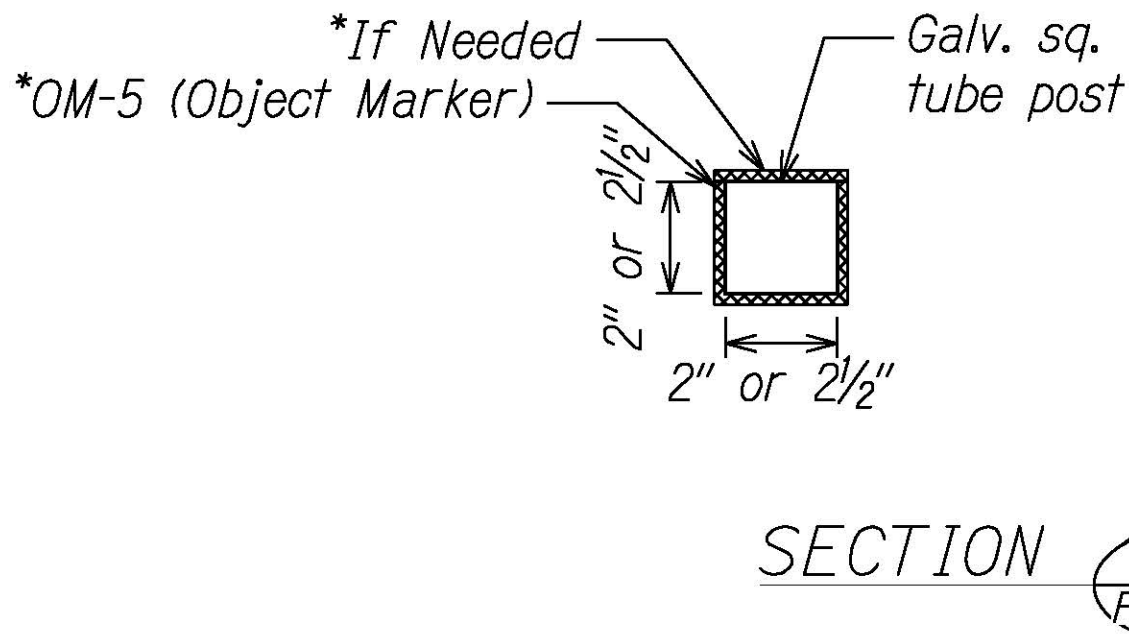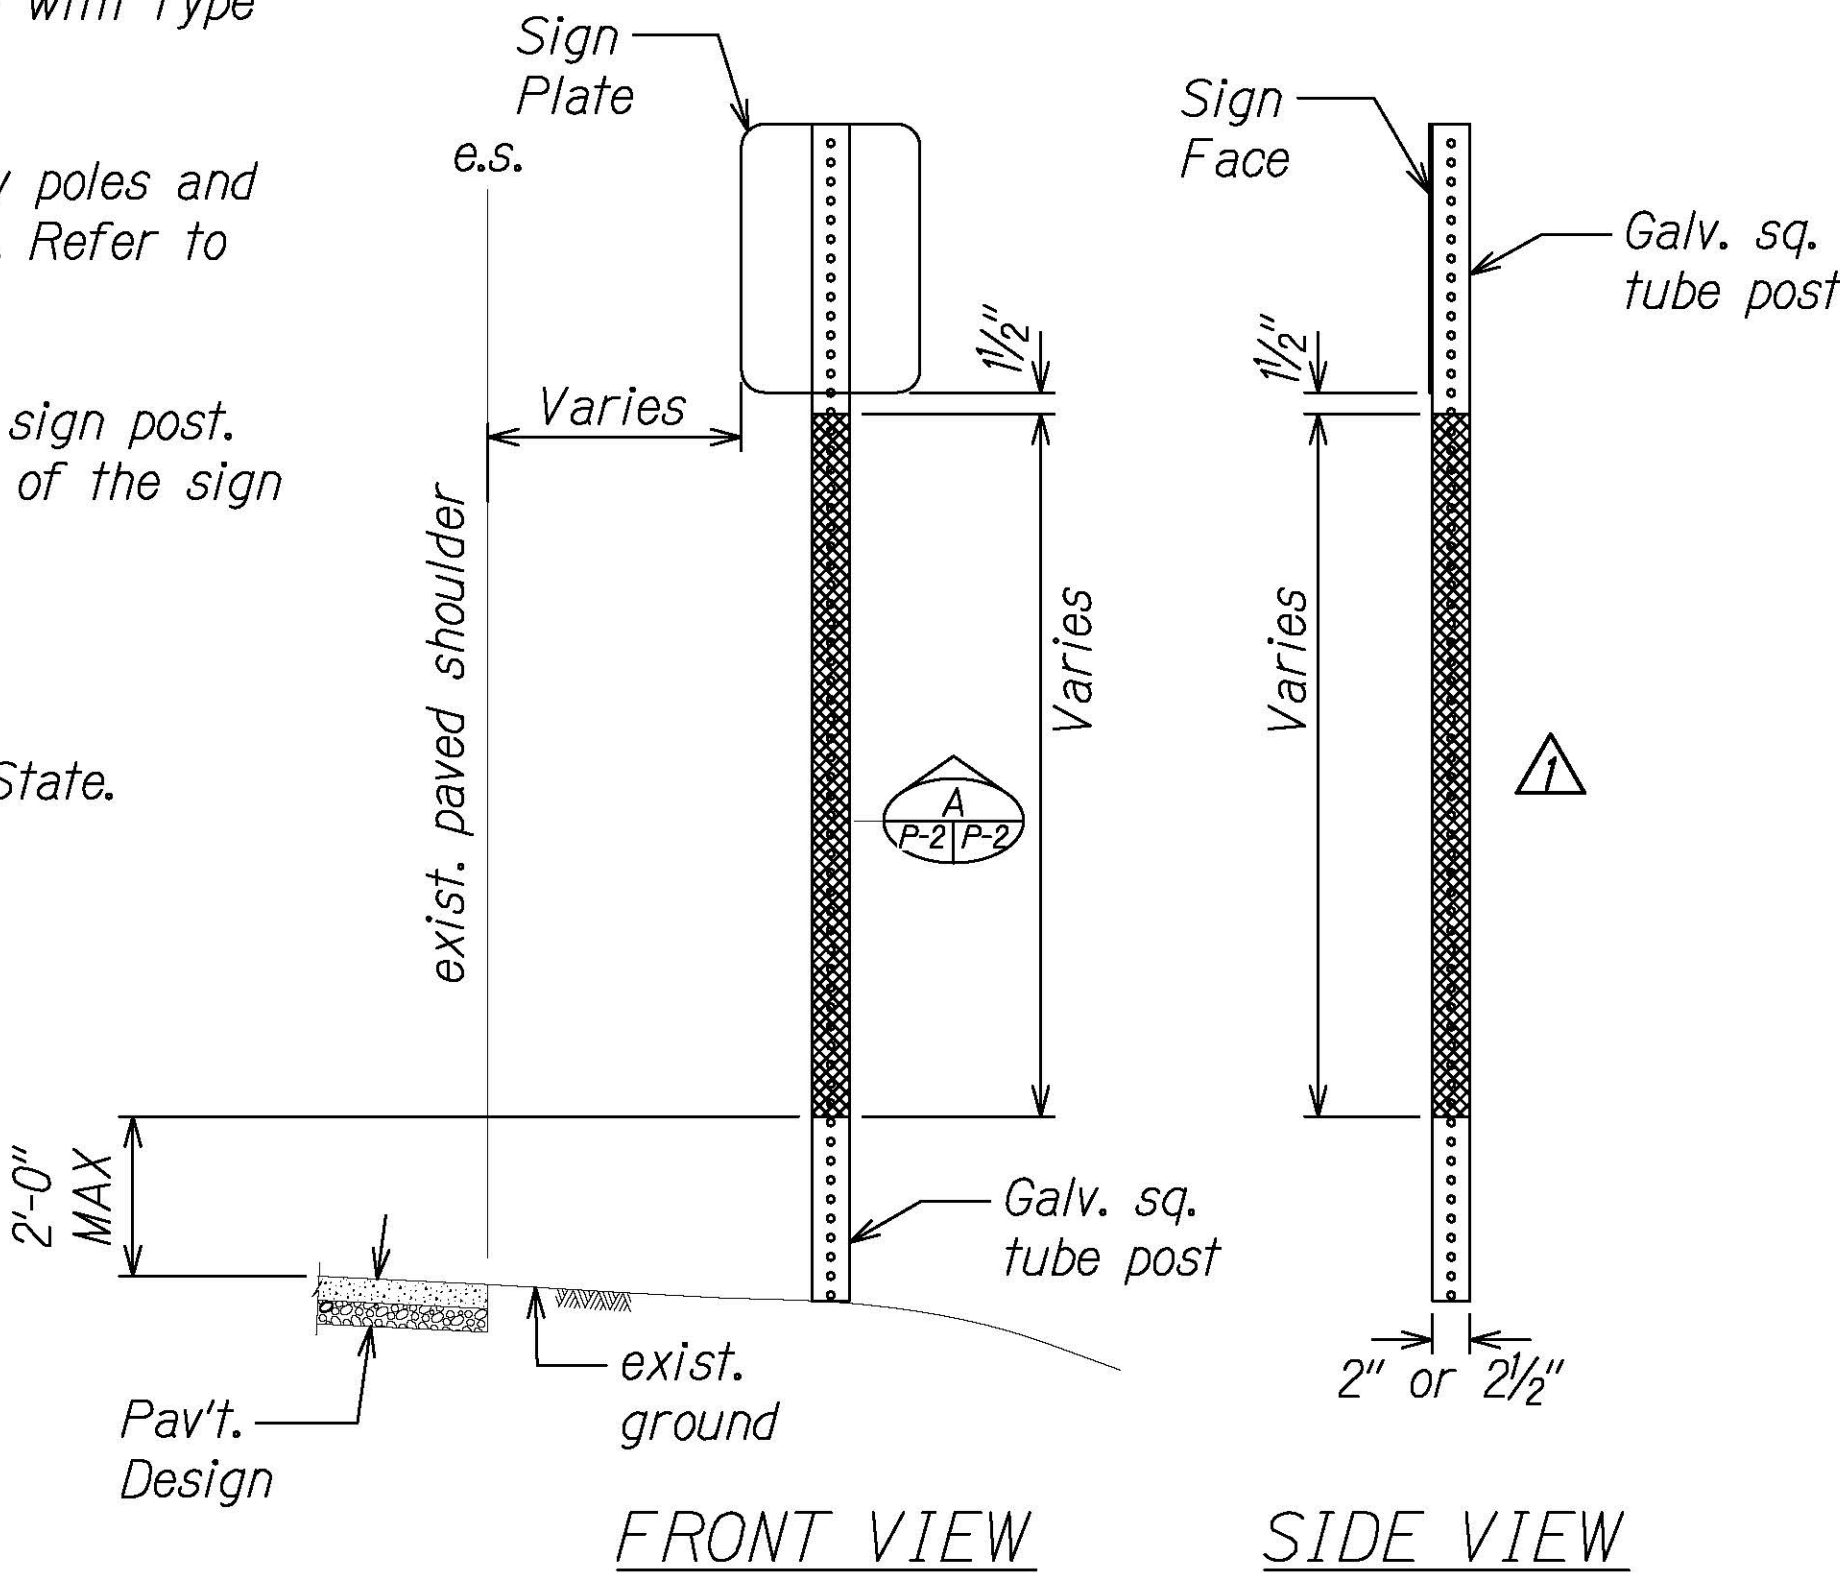

*NOTE: All red OM-5 object markers shall be 4-sided.
OBJECT MARKER (OM-5) DETAIL @ TRAFFIC SIGN POST
Not to Scale

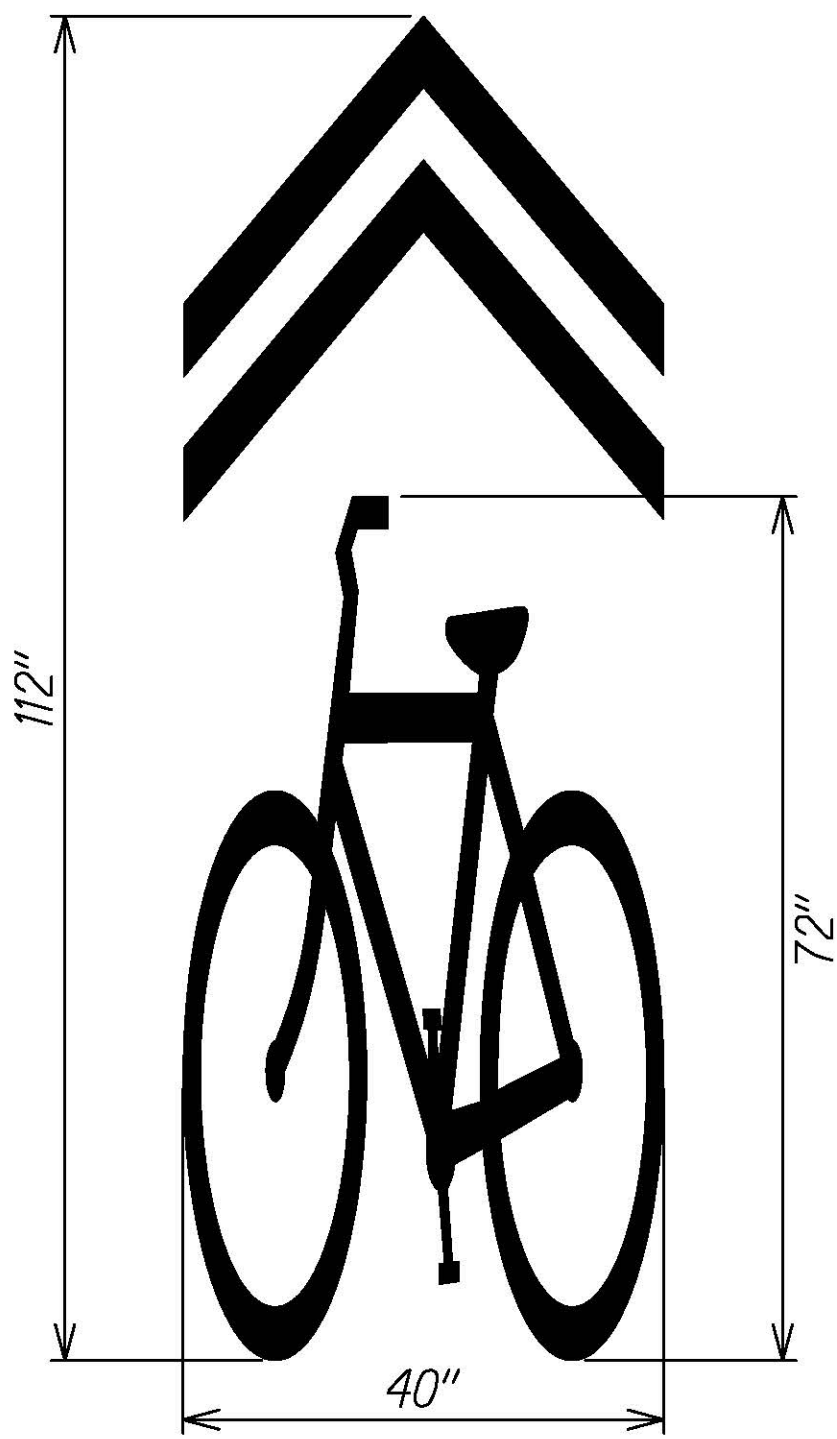


NOTE: Shared Pavement Markings to be Centered in Lane
SHARED LANE PAVEMENT MARKING DETAIL
Not to Scale

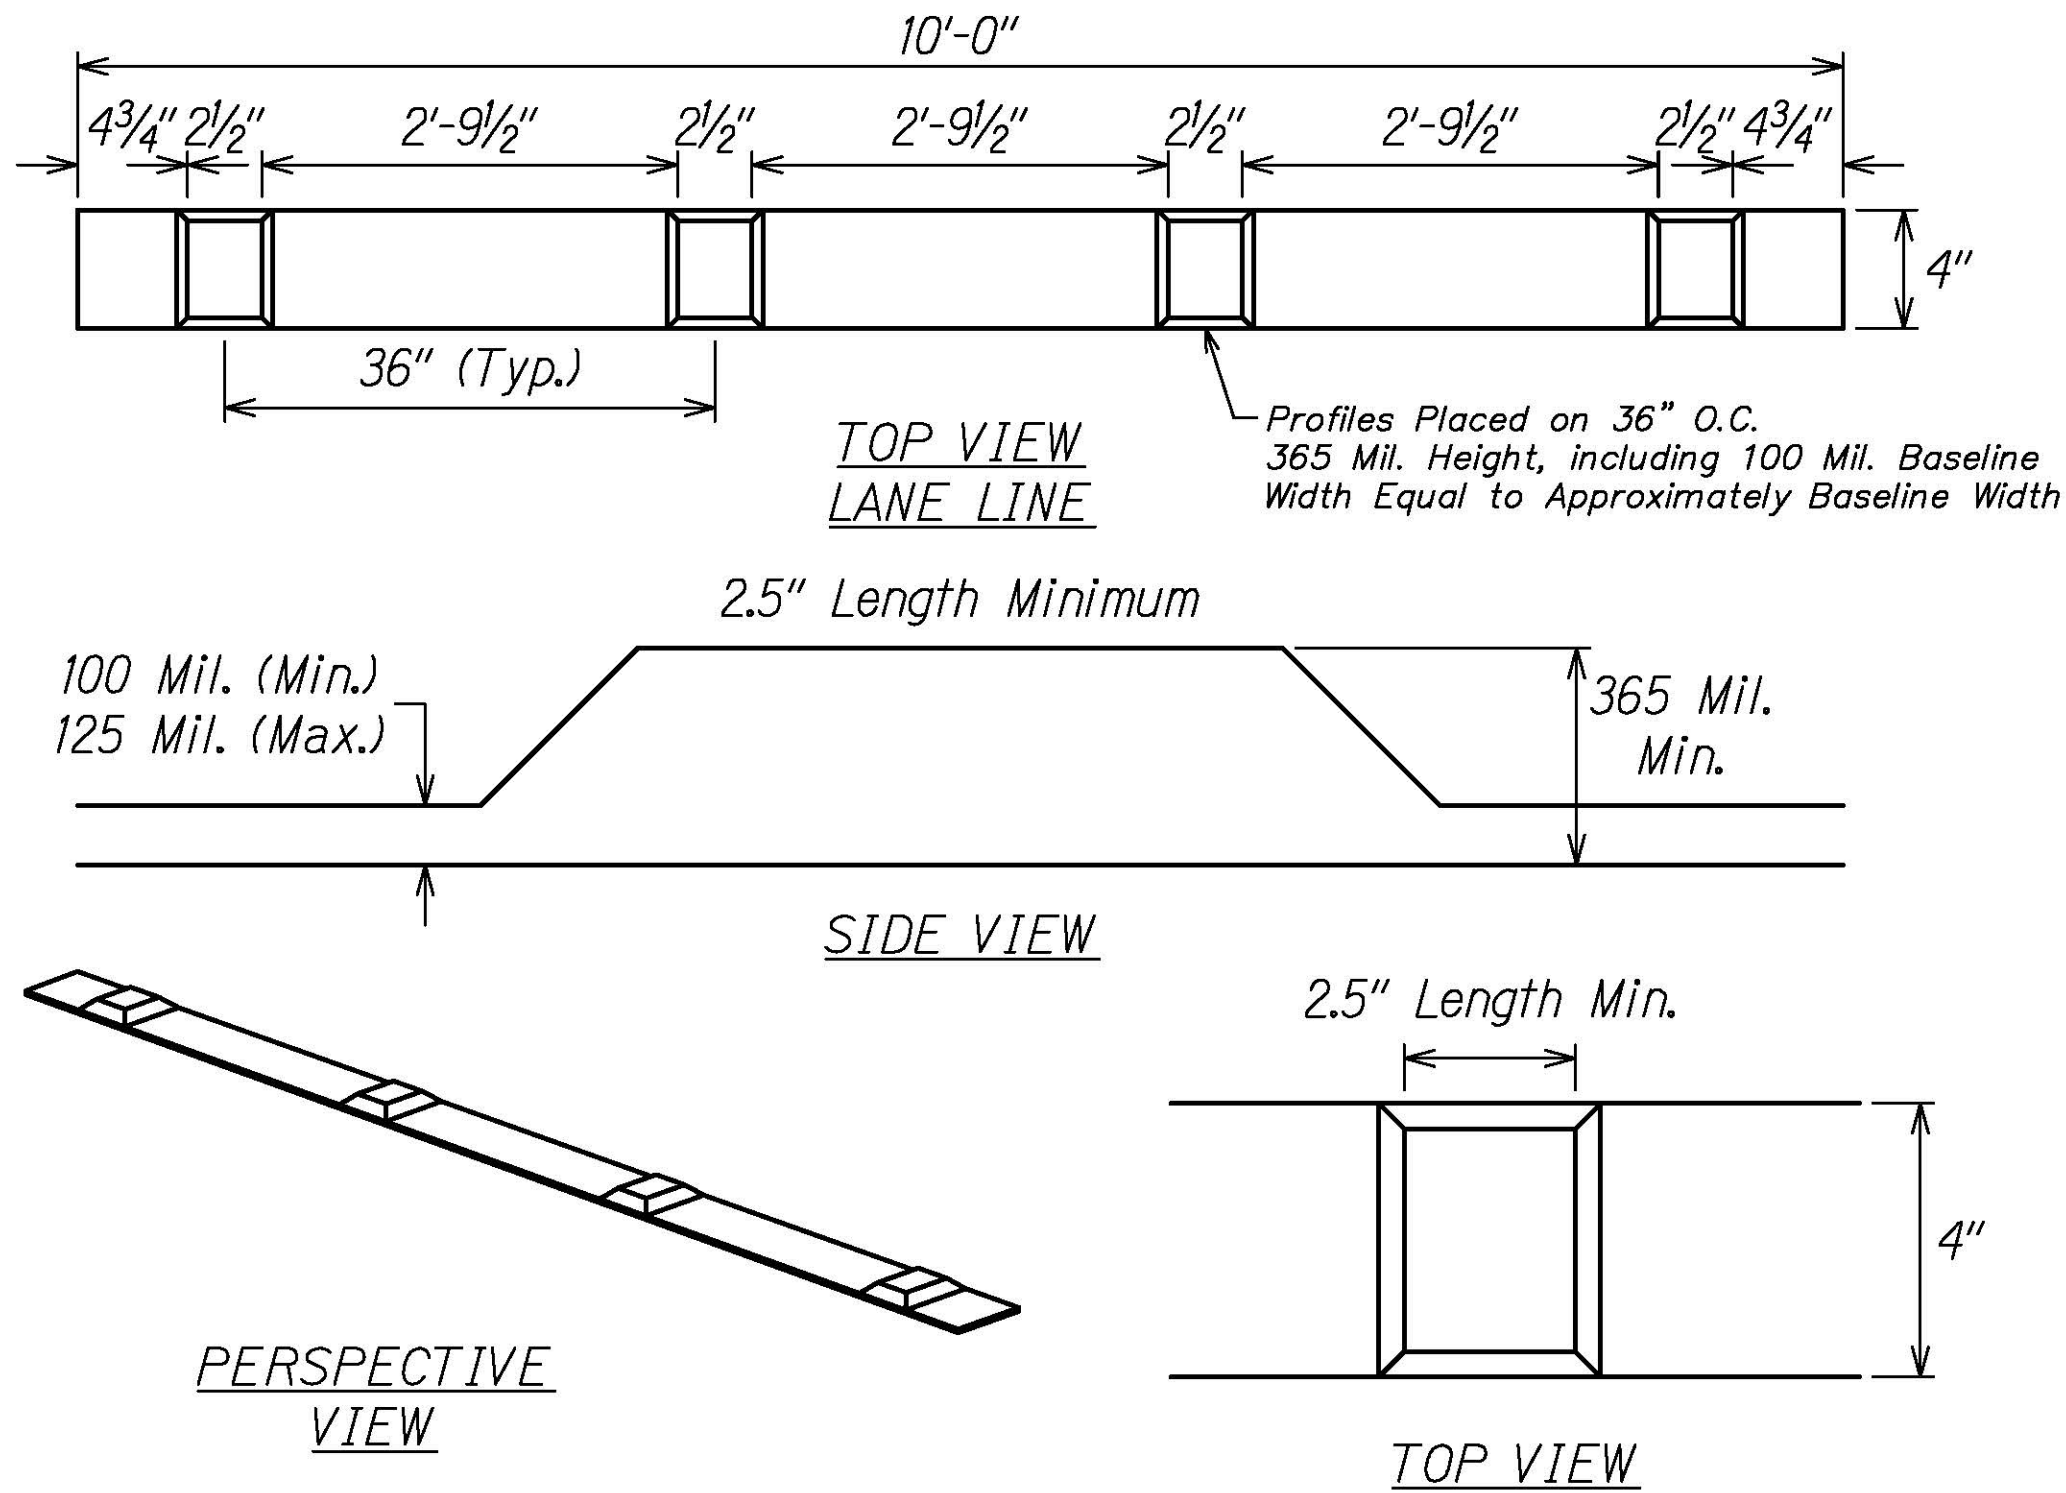


- NOTES:
- The Thermoplastic Material shall be Alkyd-based Compound Formulated for Profiled Pavement Marking. See Specs Subsection 629.03 for Additional Requirements.
 - The Engineer will include the Longitudinal Gaps for Skip Striping, up to Thirty (30) Feet Long, in the Measurement for Payment.
 - Install Yellow Profiled Thermoplastic Stripes for Centerline Passing Zone.

PROFILED THERMOPLASTIC STRIPING DETAIL
Not to Scale

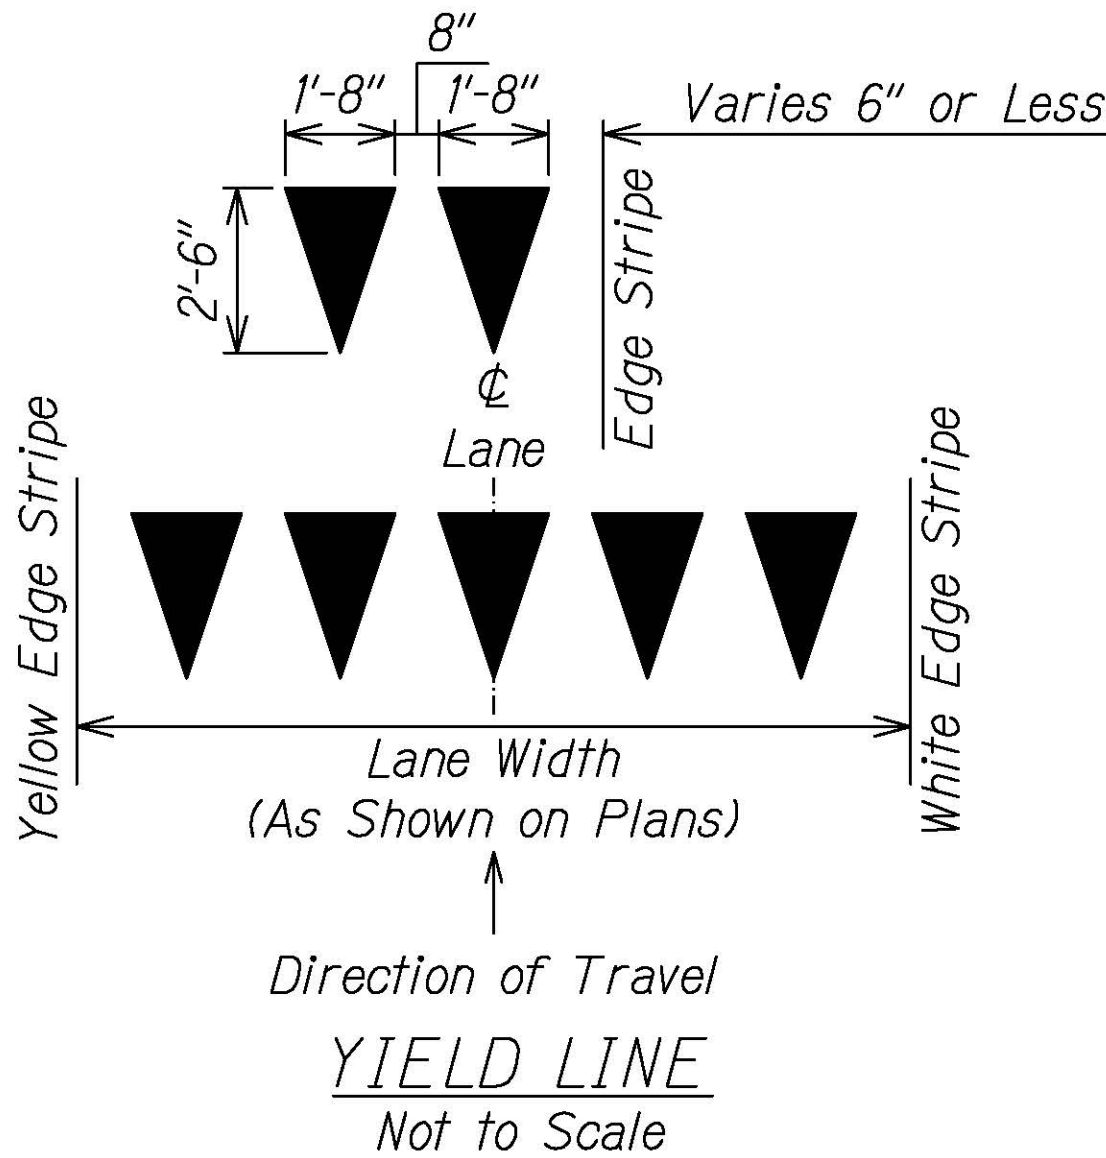

10/12/23 Revised Detail






DATE REVISION

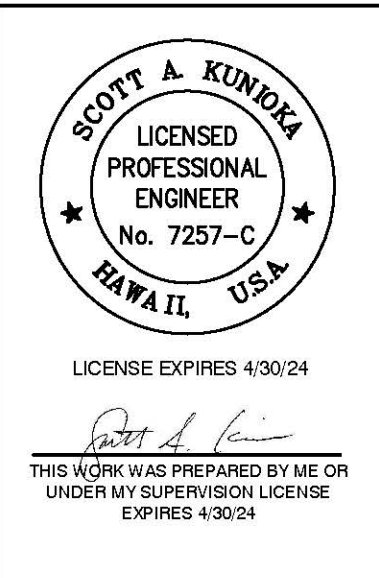

STATE OF HAWAII
DEPARTMENT OF TRANSPORTATION
HIGHWAYS DIVISION
PAVEMENT MARKING
NOTES & DETAILS
KUHIO HIGHWAY RESURFACING
AND SAFETY IMPROVEMENTS
Route 560 M.P. 0.0 to M.P. 4.5
Fed. Aid Proj. No. STP-0560(017)
Scale: Not to Scale Date: July, 2023

SHEET No. P-2A OF 20 SHEETS

FED. ROAD DIST. NO.	STATE	FED. AID PROJ. NO.	FISCAL YEAR	SHEET NO.	TOTAL SHEETS
HAWAII	HAW.	STP-0560(017)	2023	ADD.72	92

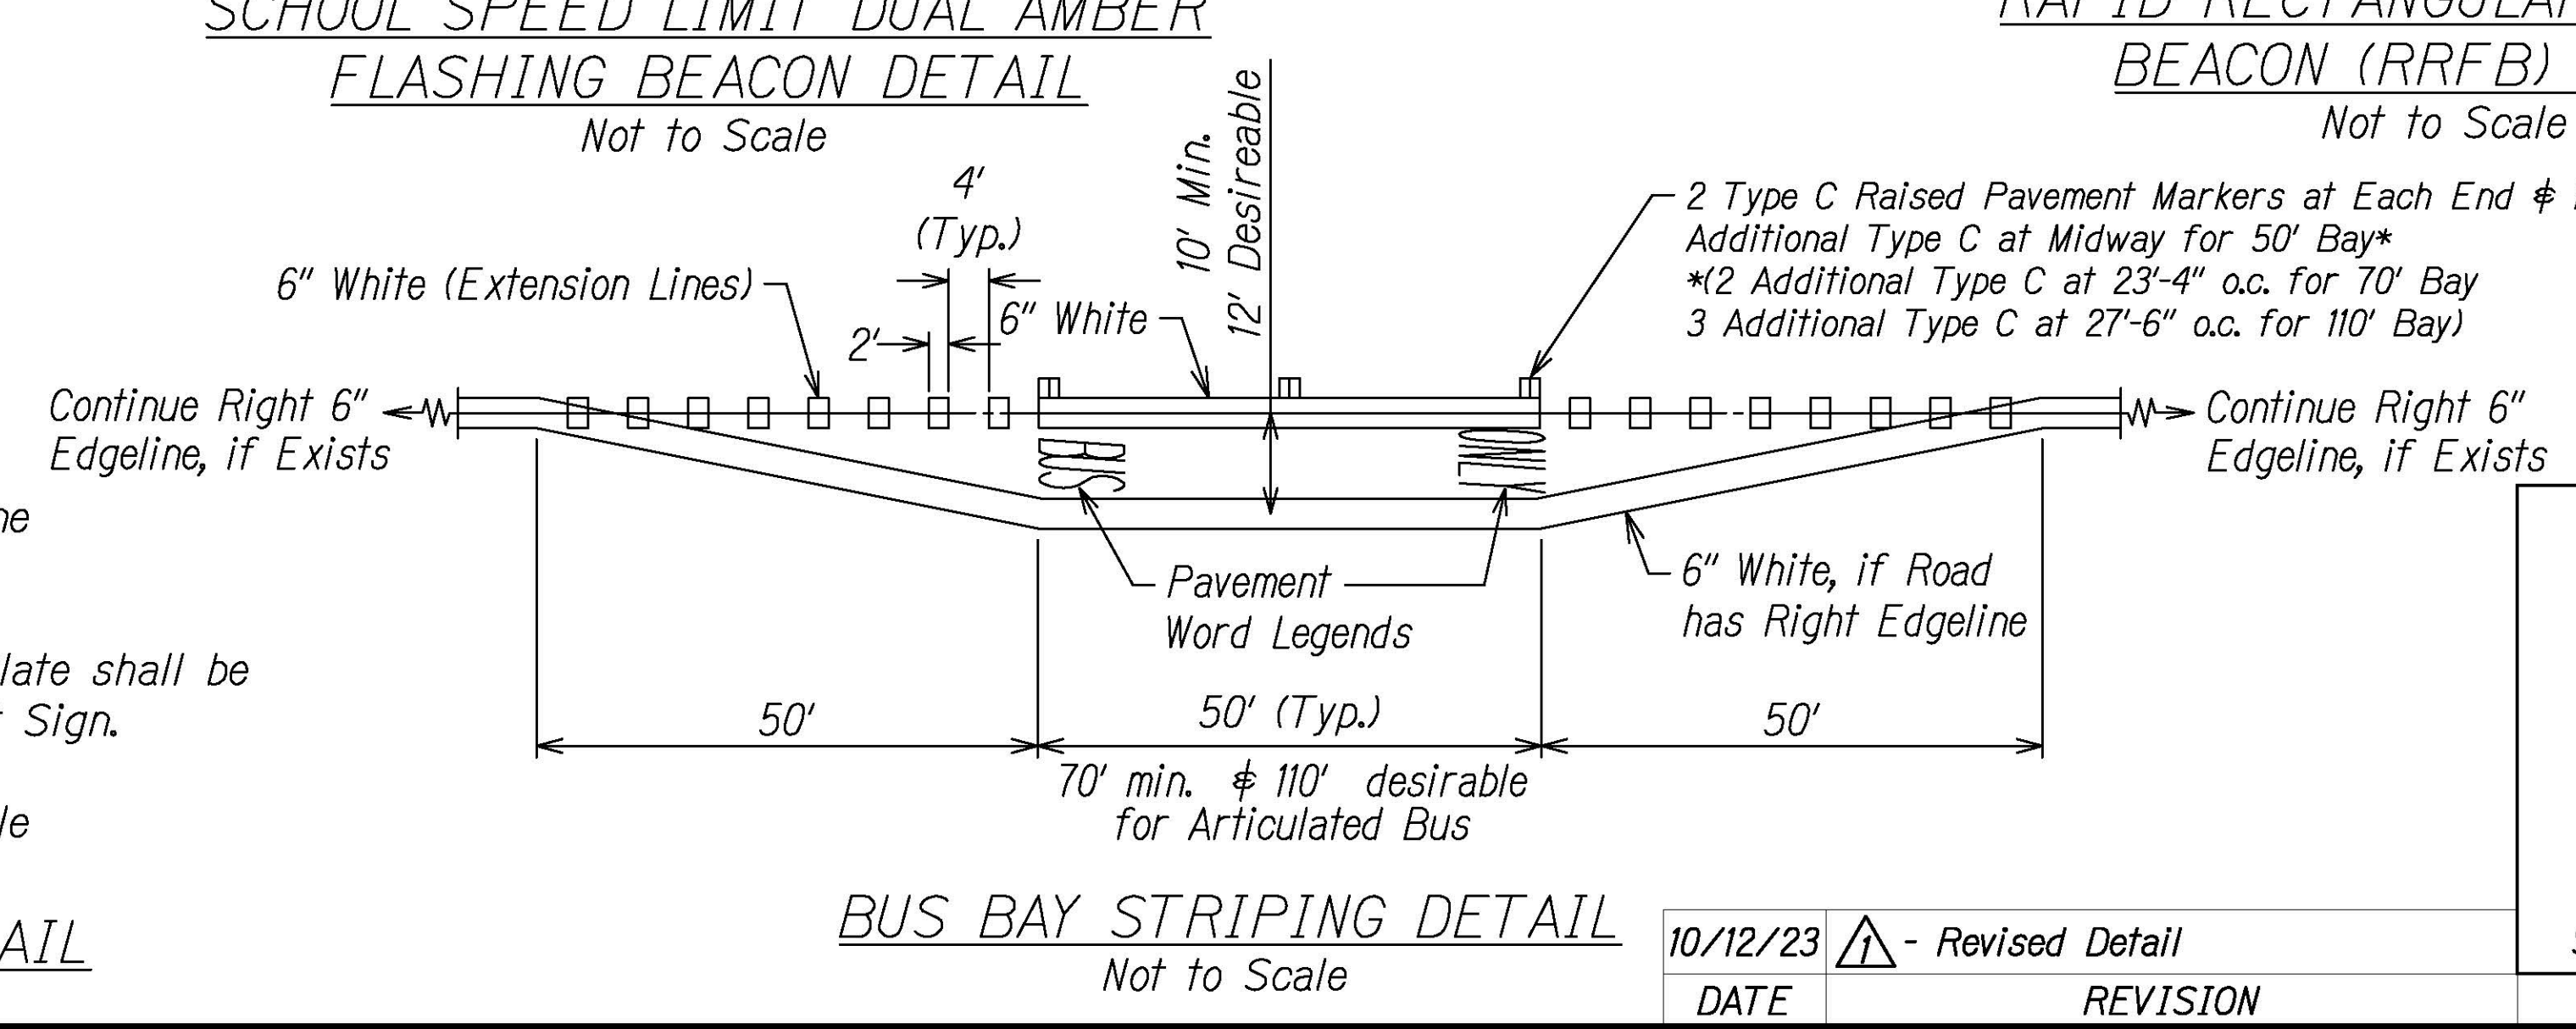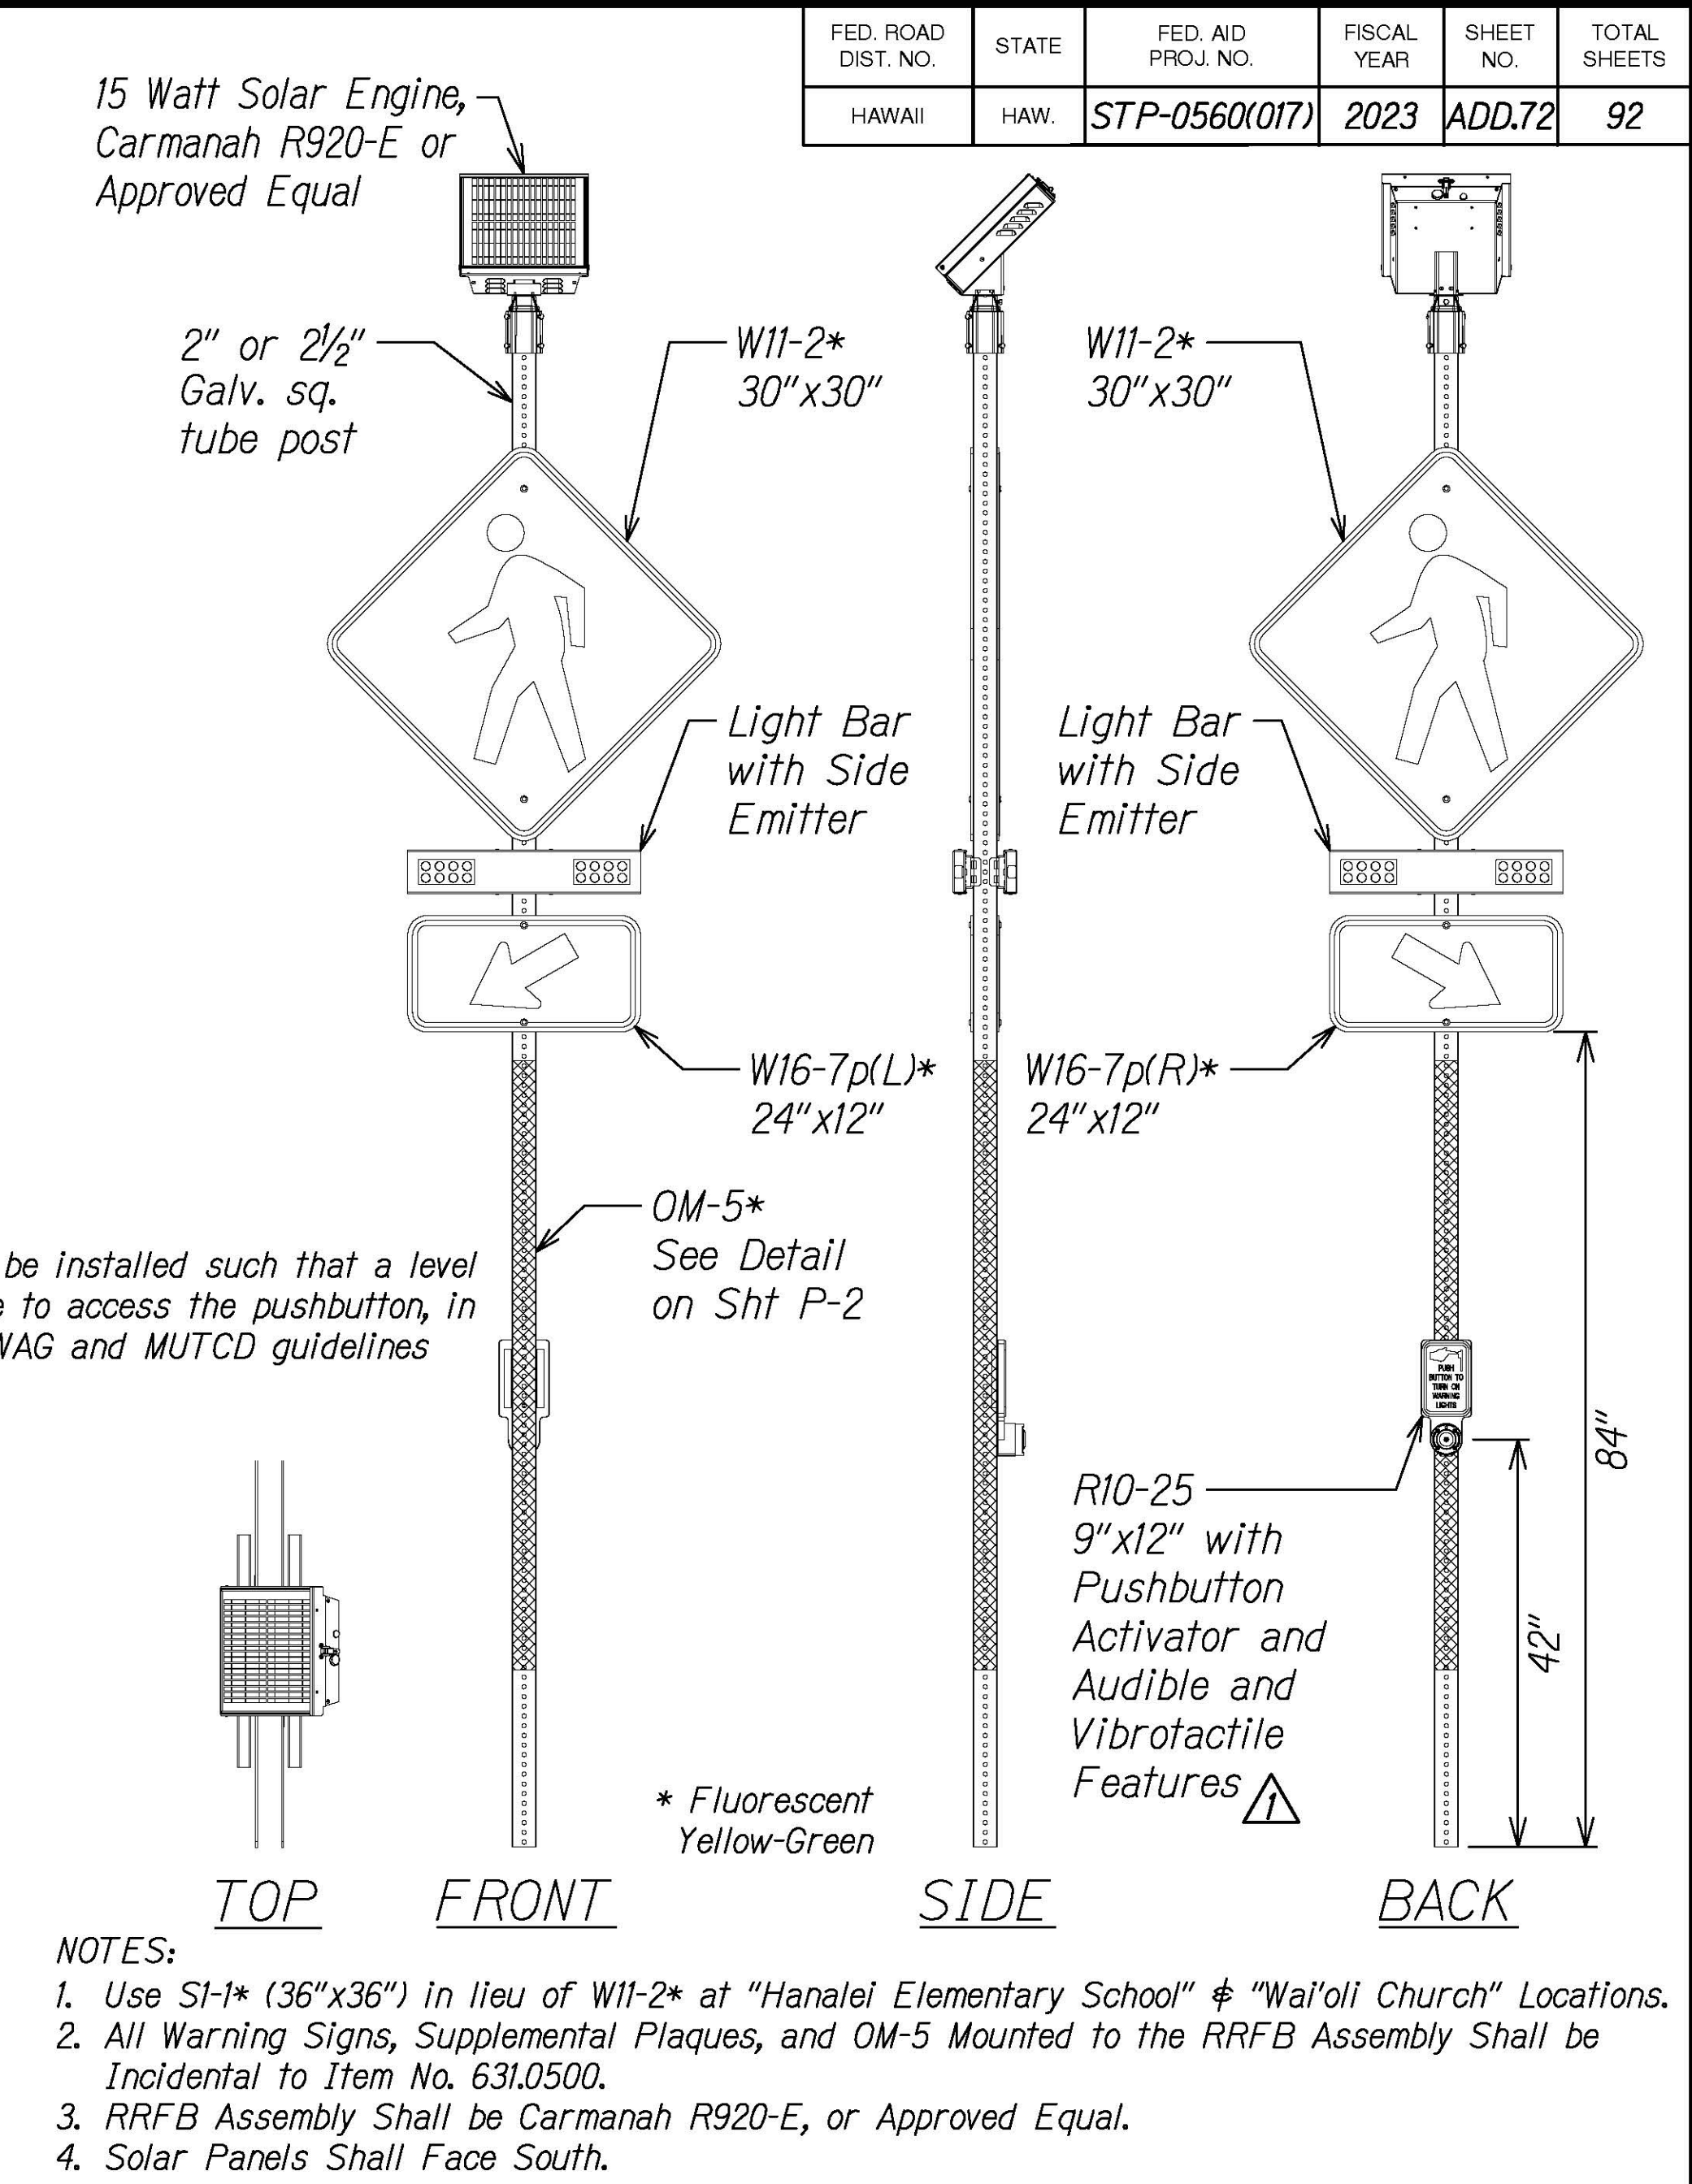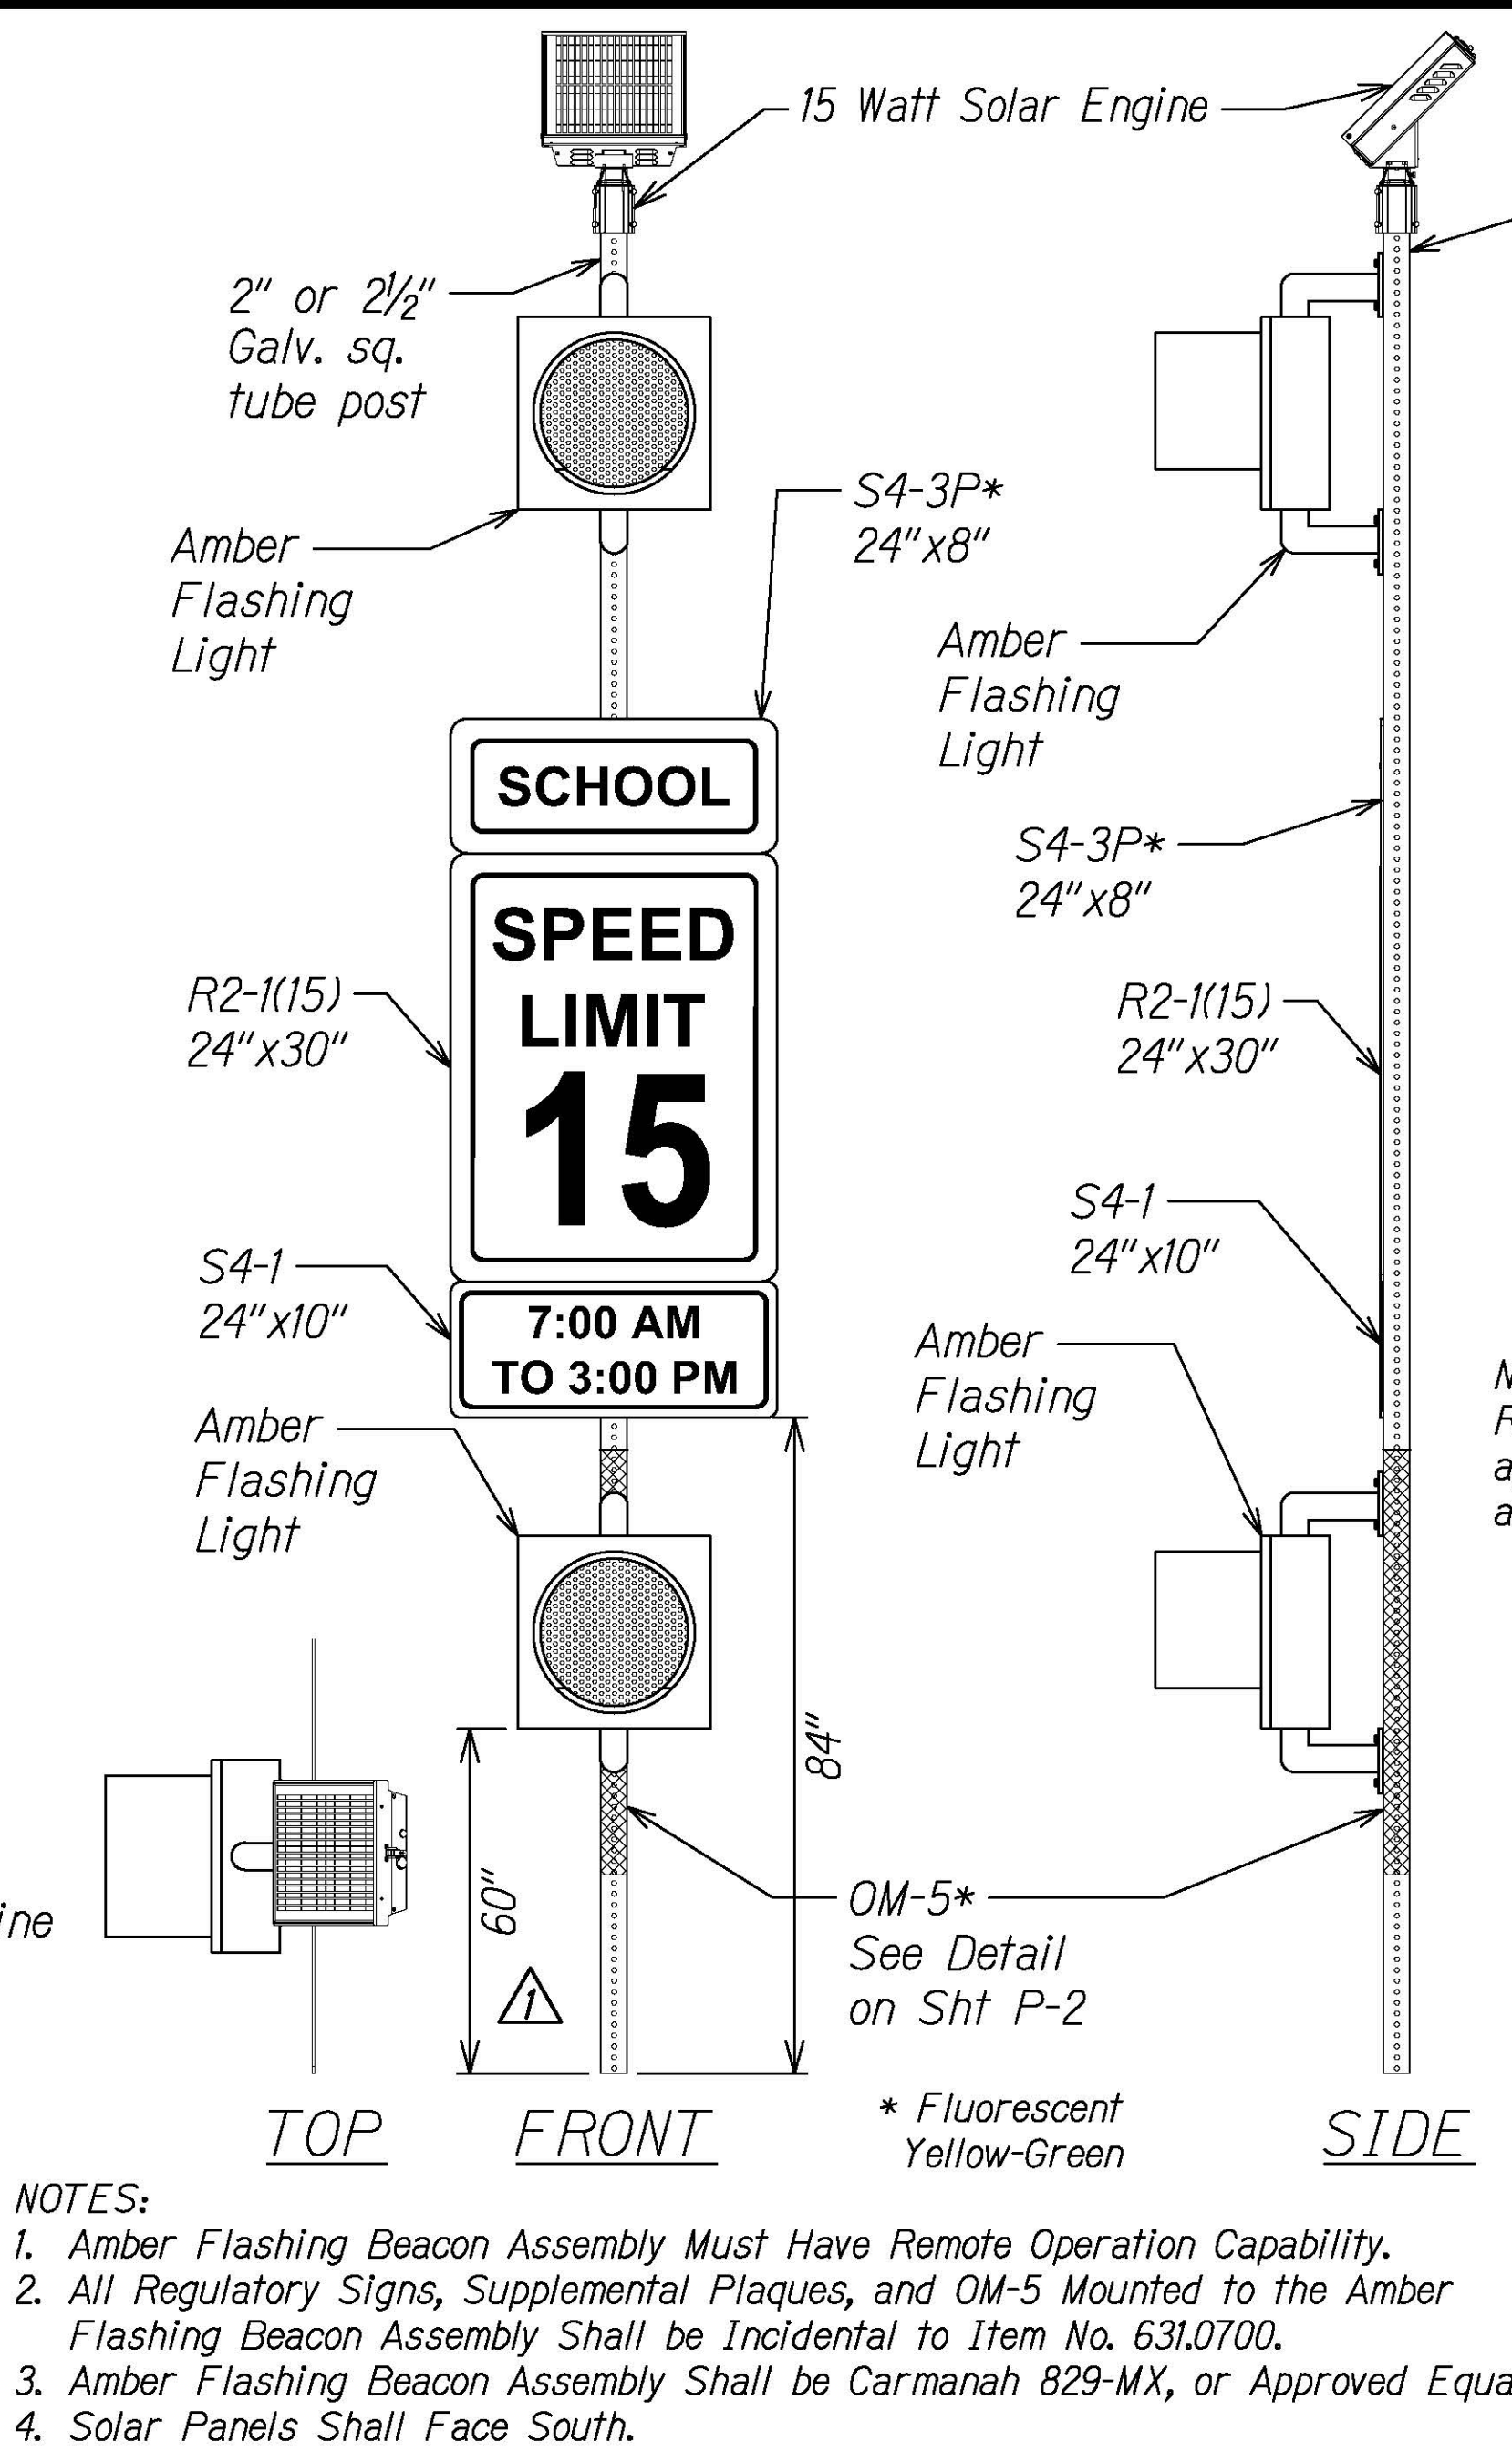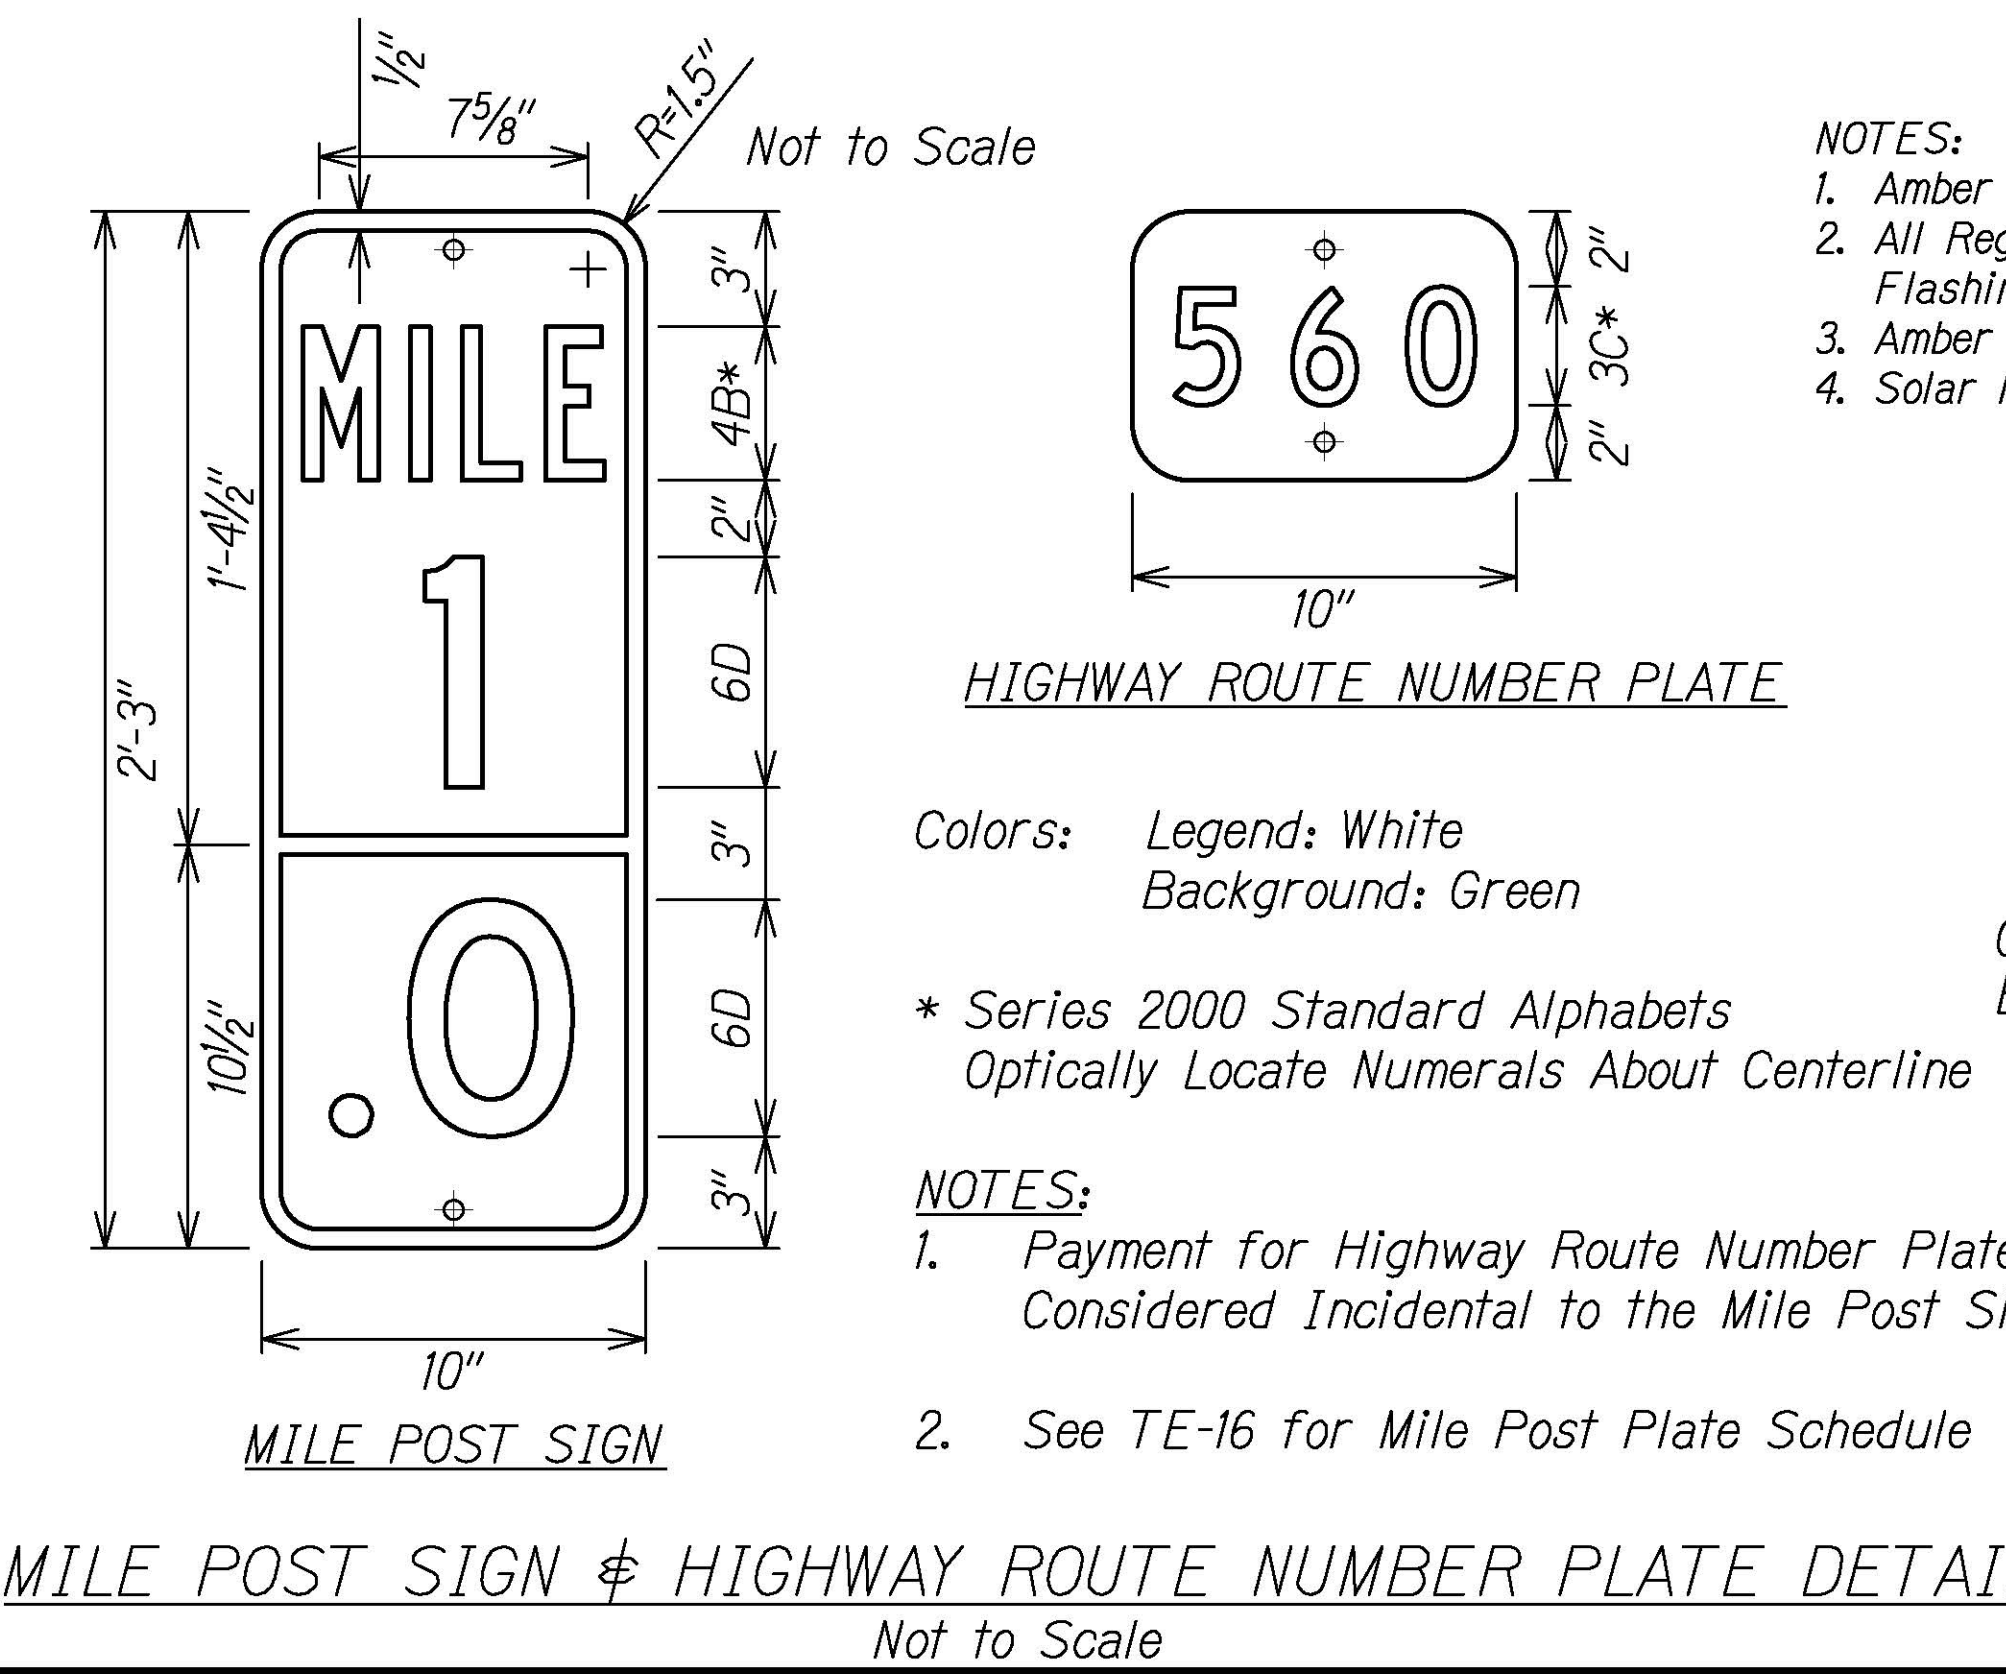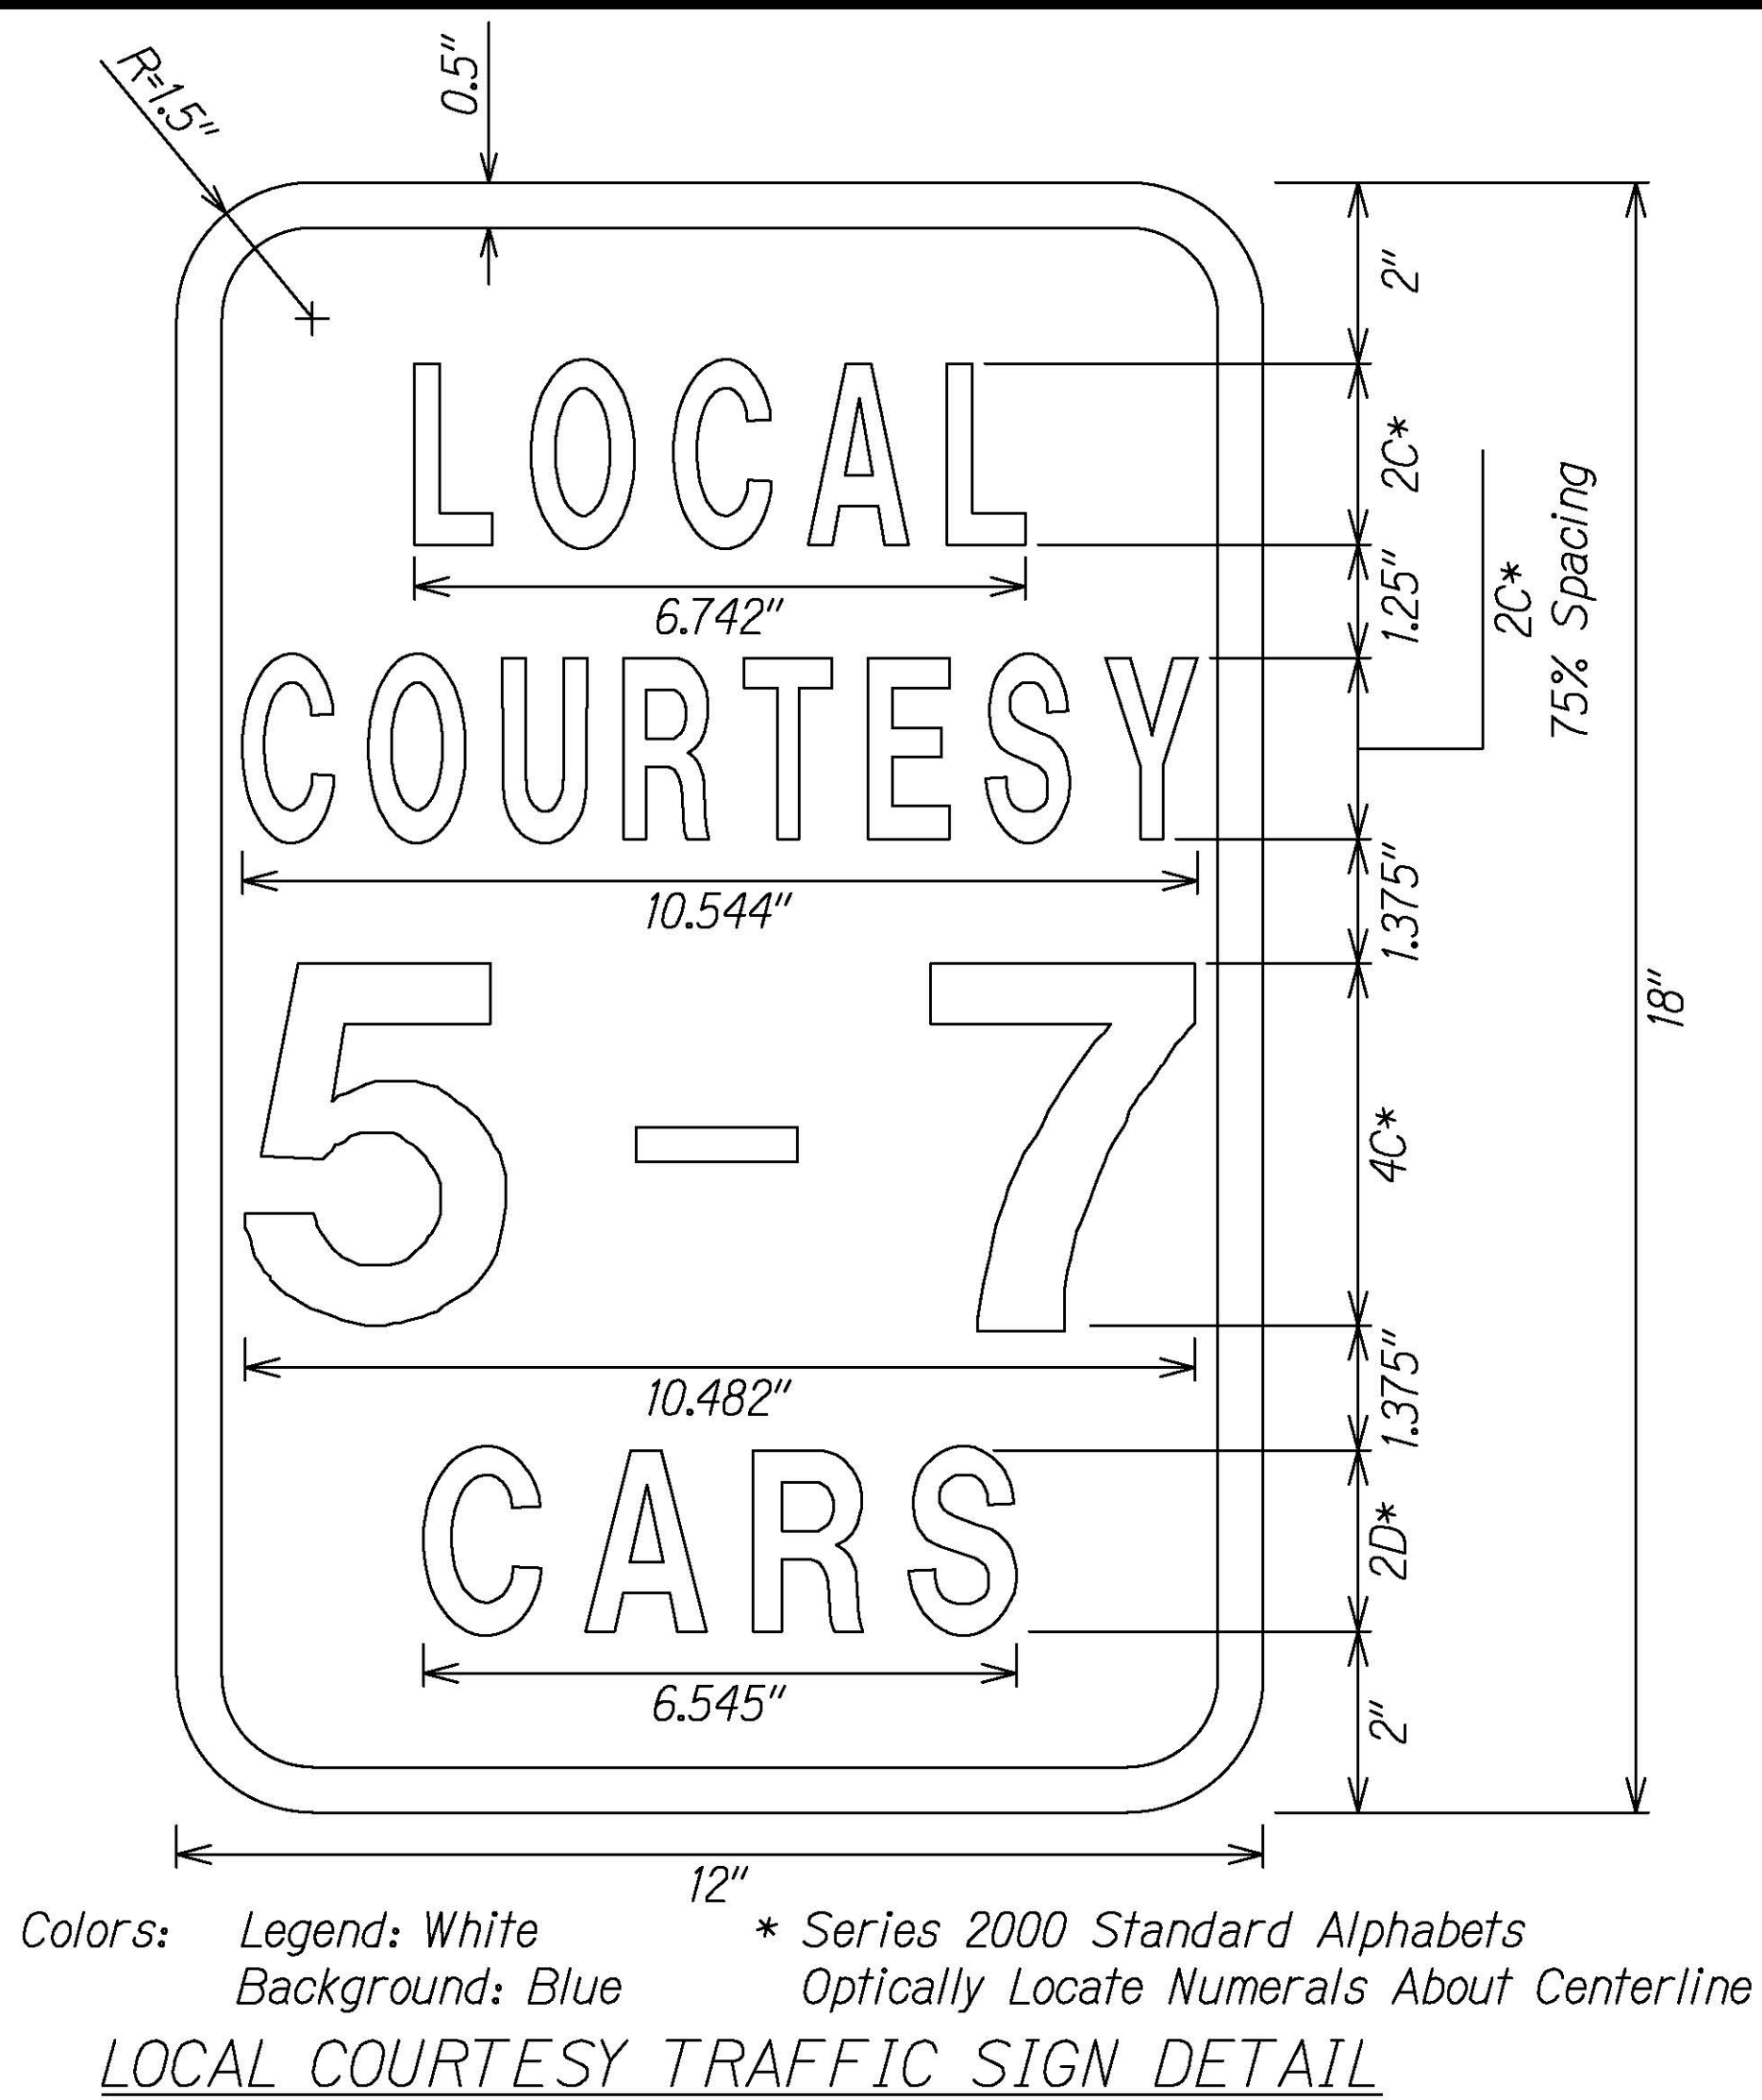

STATE OF HAWAII
DEPARTMENT OF TRANSPORTATION
HIGHWAYS DIVISION

**PAVEMENT MARKING
NOTES & DETAILS**

**KUHIO HIGHWAY RESURFACING
AND SAFETY IMPROVEMENTS**
Route 560 M.P. 0.0 to M.P. 4.5
Fed. Aid Proj. No. STP-0560(017)



Scale: Not to Scale Date: July, 2023

SHEET No. P-3A OF 20 SHEETS

SCOTT A. KUNIK
LICENSED PROFESSIONAL ENGINEER
No. 7257-C
HAWAII, U.S.A.
LICENSE EXPIRES 4/30/24


THIS WORK WAS PREPARED BY ME OR UNDER MY SUPERVISION LICENSE EXPIRES 4/30/24

FED. ROAD DIST. NO.	STATE	FED. AID PROJ. NO.	FISCAL YEAR	SHEET NO.	TOTAL SHEETS
HAWAII	HAW.	STP-0560(017)	2023	ADD.75	92

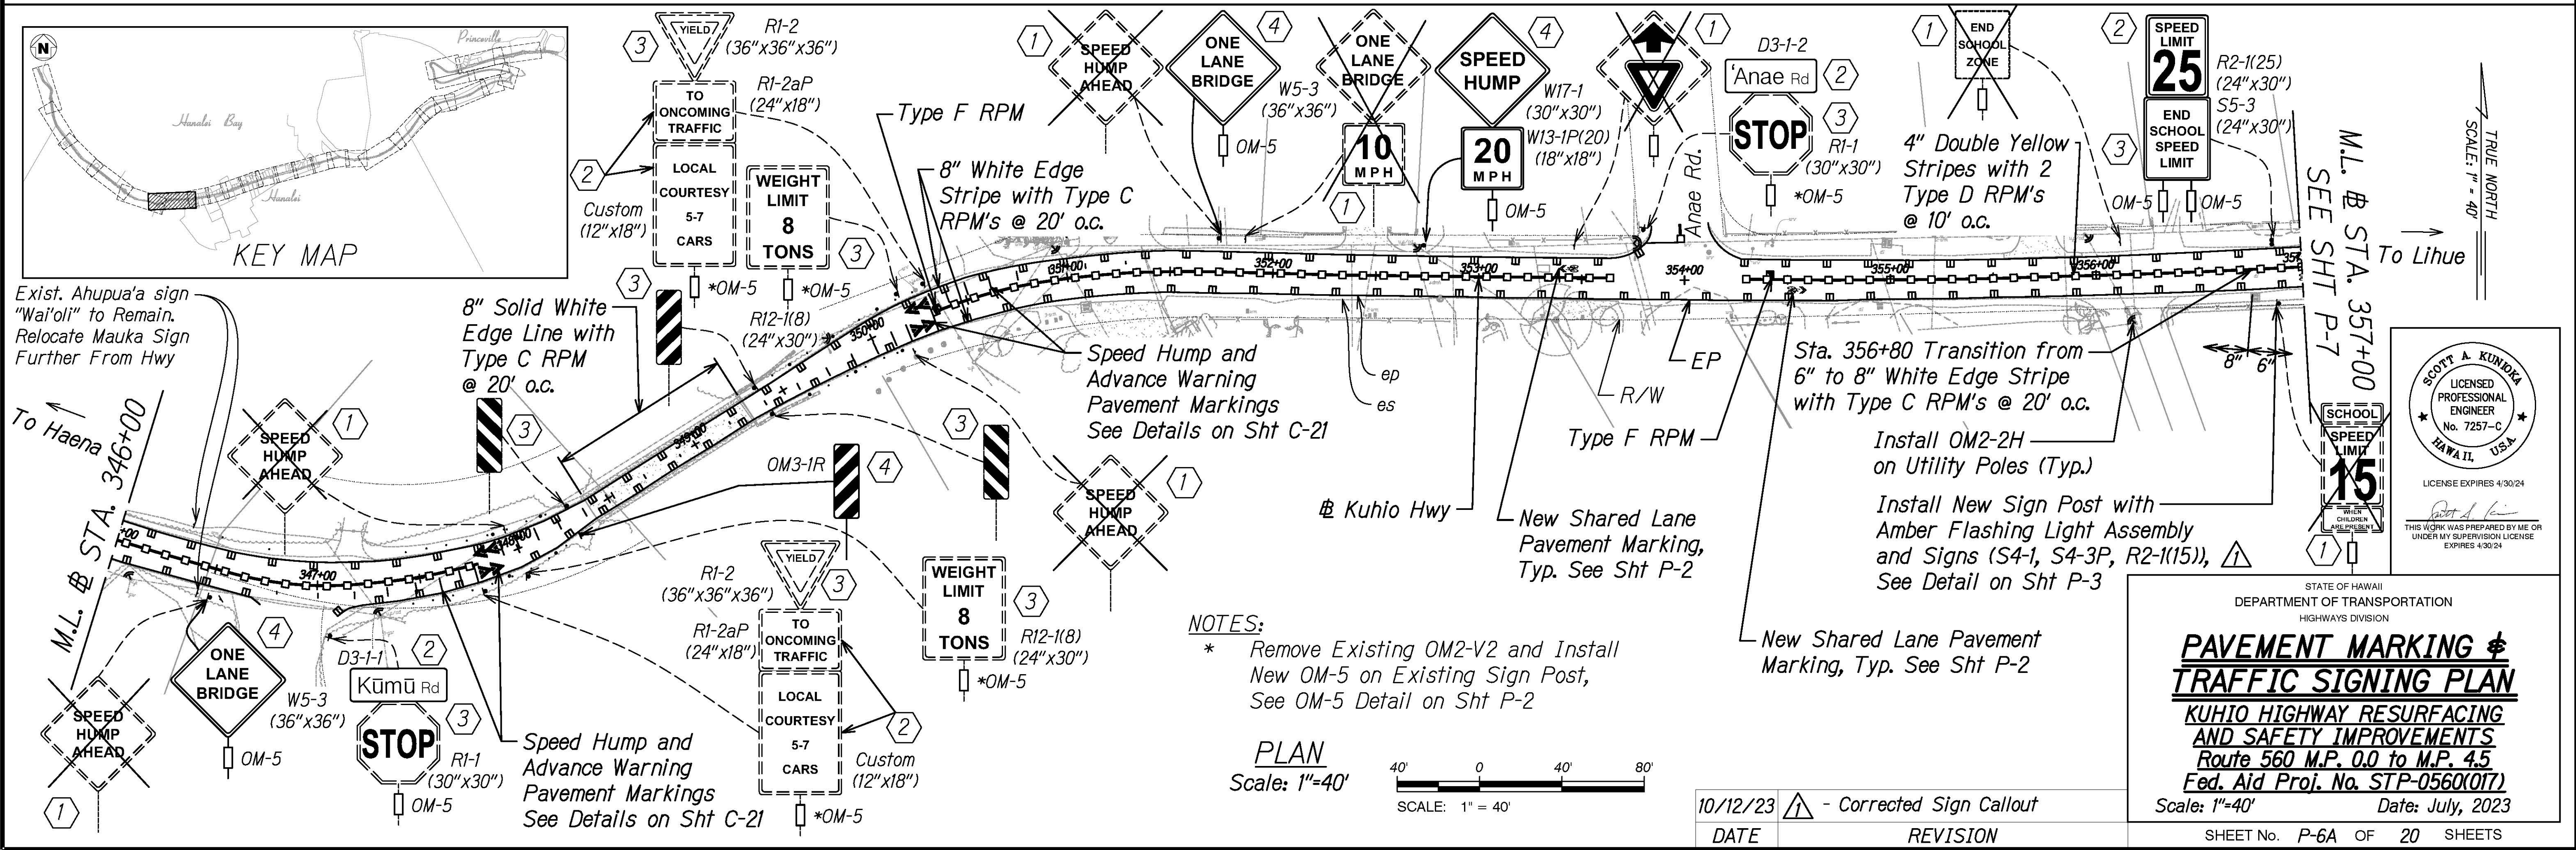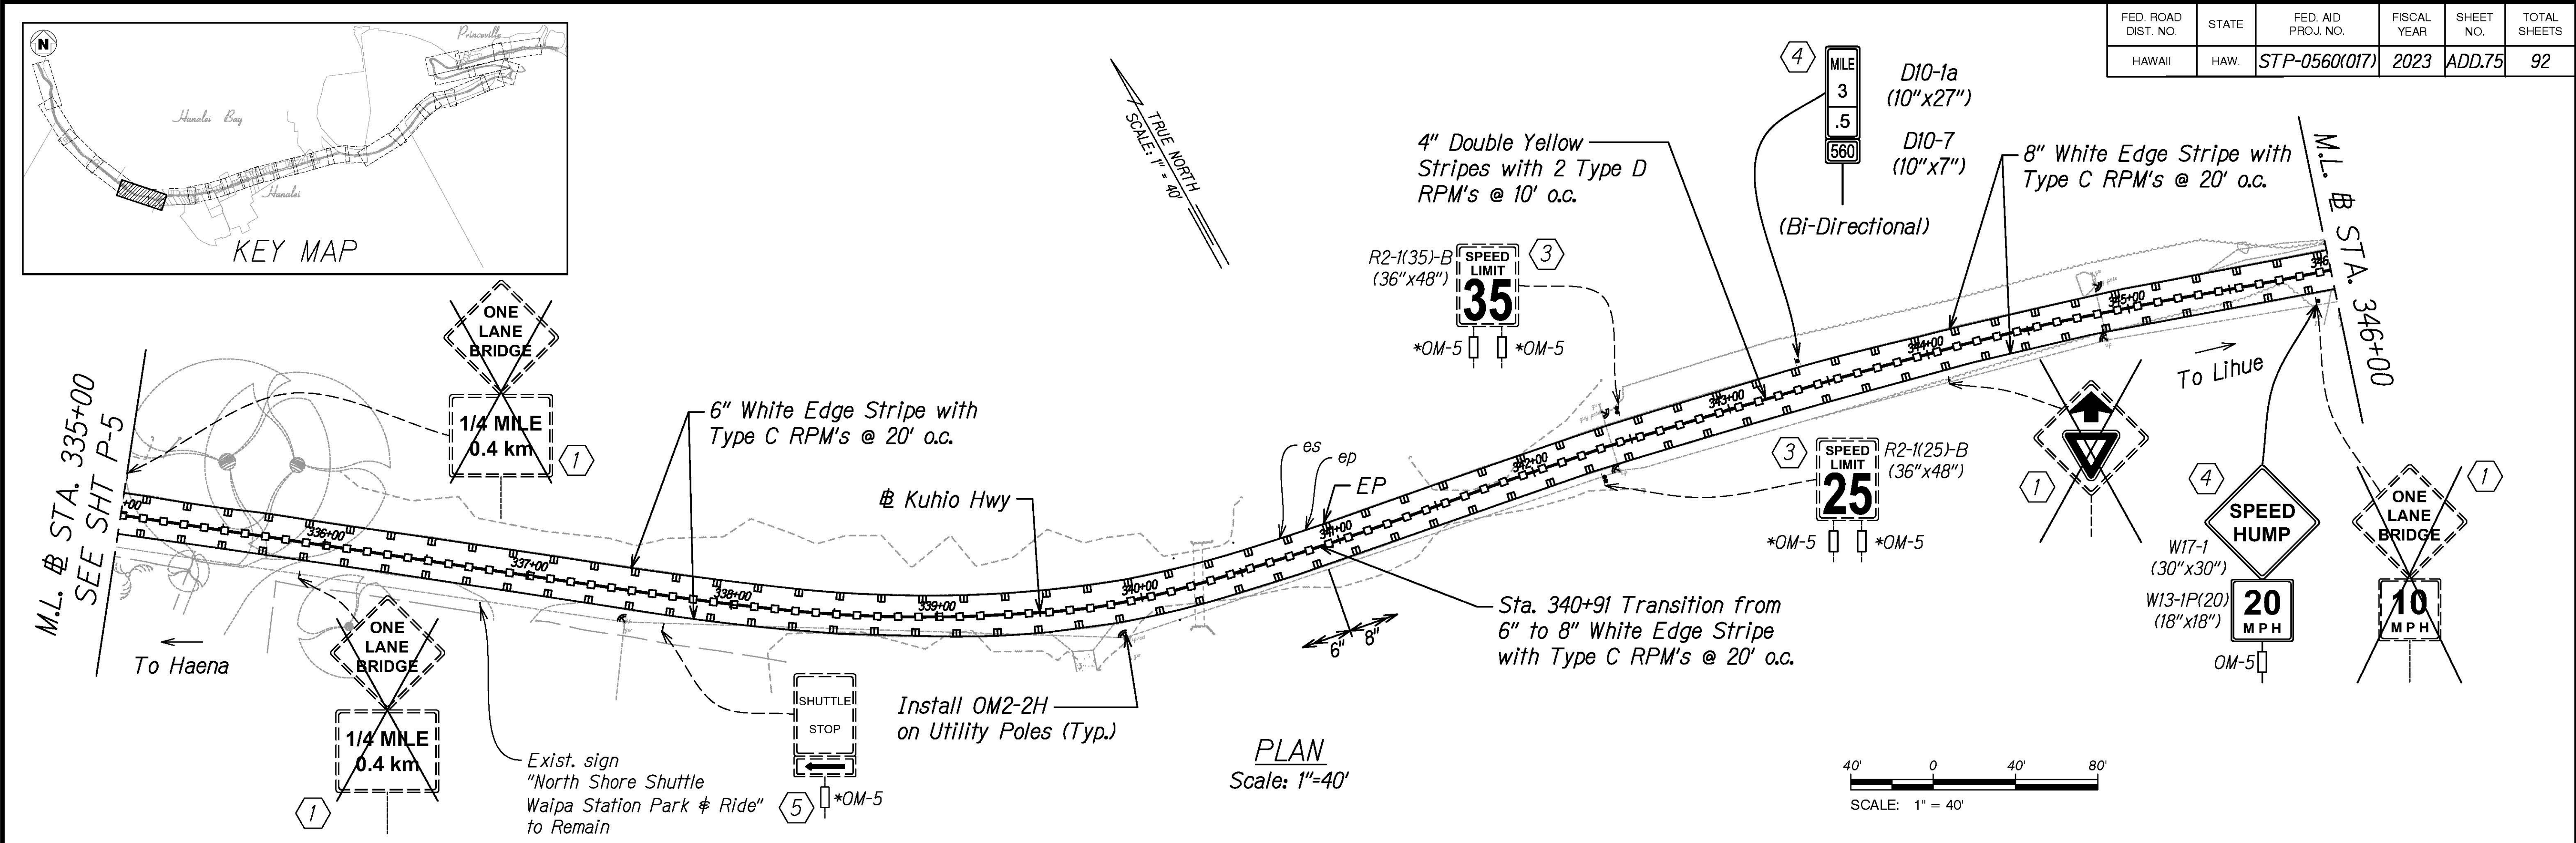

NOTES:
 * Remove Existing OM2-V2 and Install New OM-5 on Existing Sign Post, See OM-5 Detail on Sht P-2

PLAN
 Scale: 1"=40'


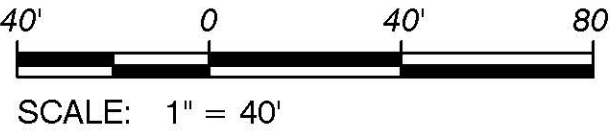


10/12/23	1 - Corrected Sign Callout
DATE	REVISION

PAVEMENT MARKING & TRAFFIC SIGNING PLAN
KUHIO HIGHWAY RESURFACING AND SAFETY IMPROVEMENTS
 Route 560 M.P. 0.0 to M.P. 4.5
 Fed. Aid Proj. No. STP-0560(017)
 Scale: 1"=40' Date: July, 2023

SHEET No. P-6A OF 20 SHEETS

FED. ROAD DIST. NO.	STATE	FED. AID PROJ. NO.	FISCAL YEAR	SHEET NO.	TOTAL SHEETS
HAWAII	HAW.	STP-0560(017)	2023	ADD.77	92

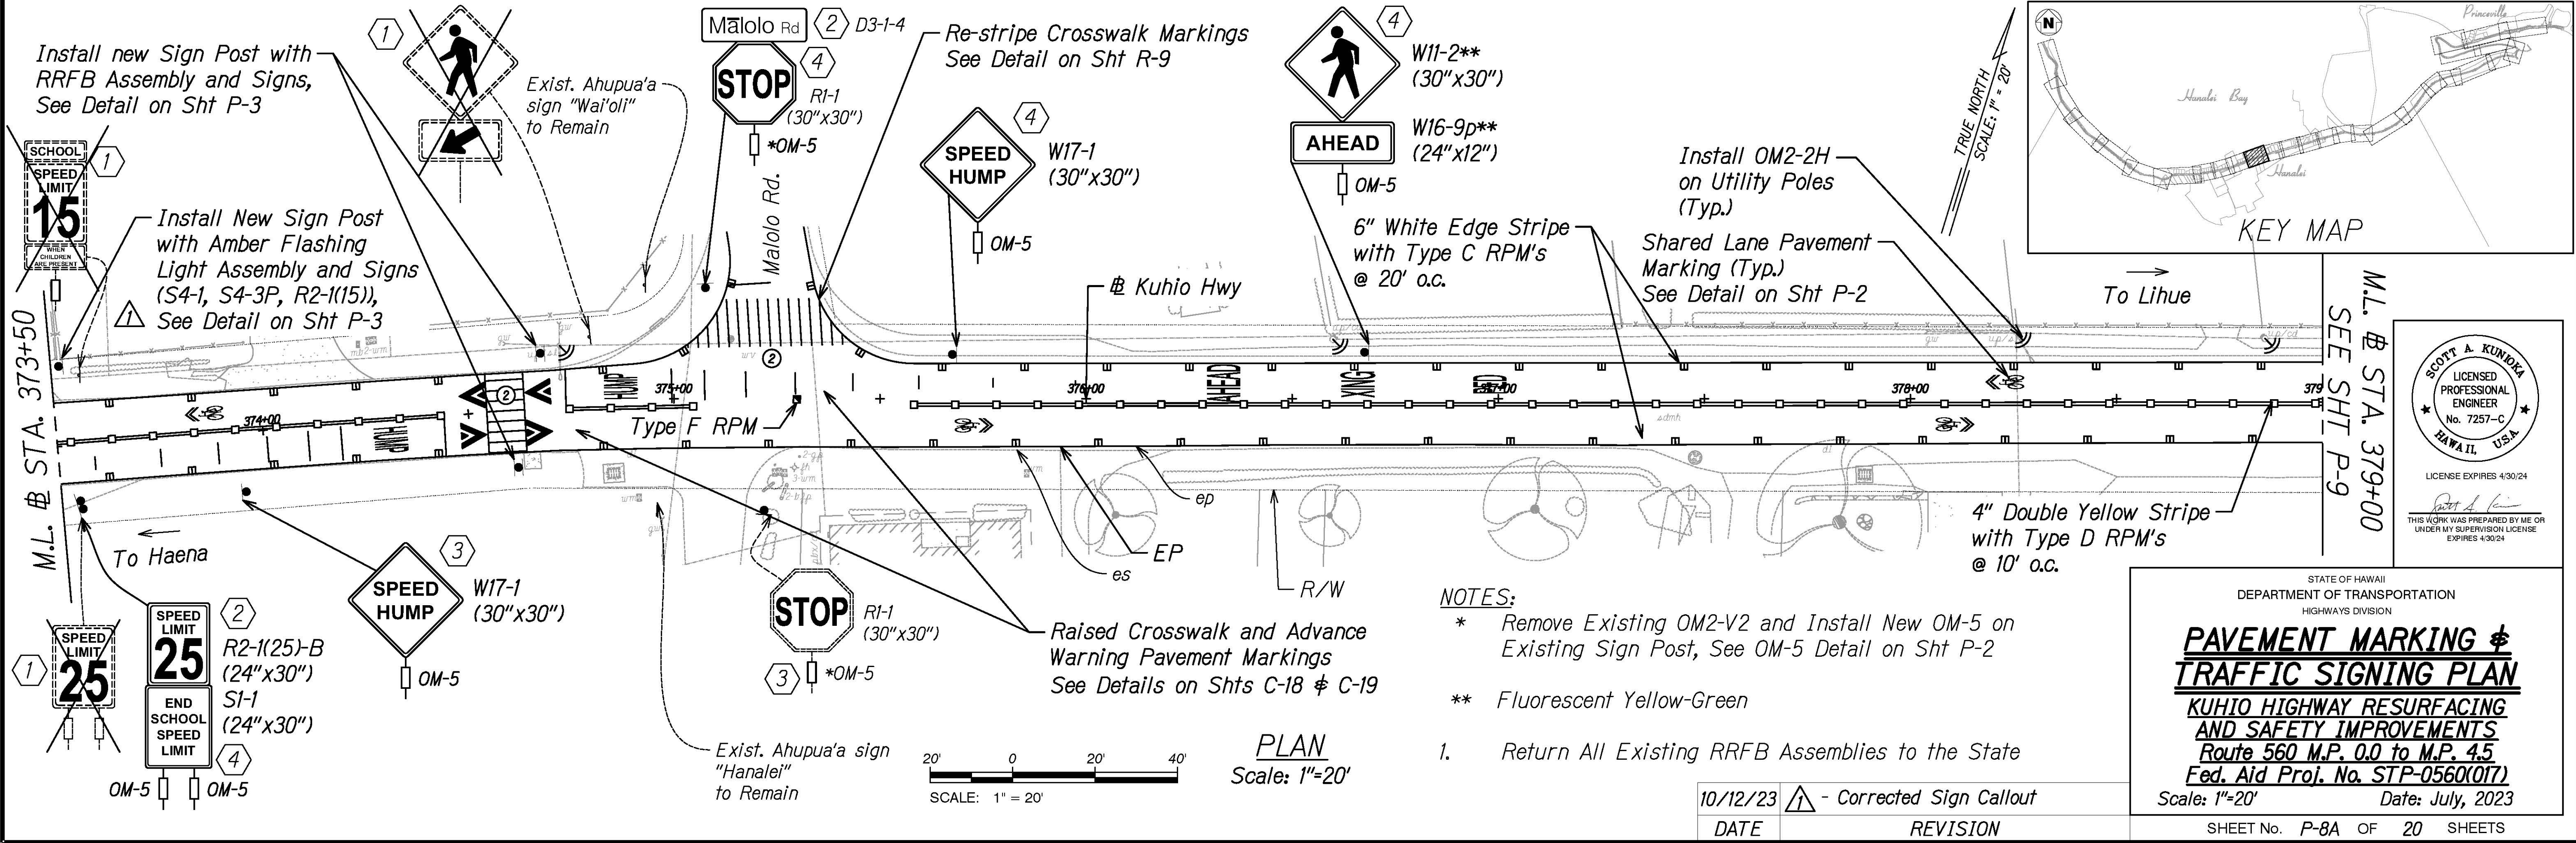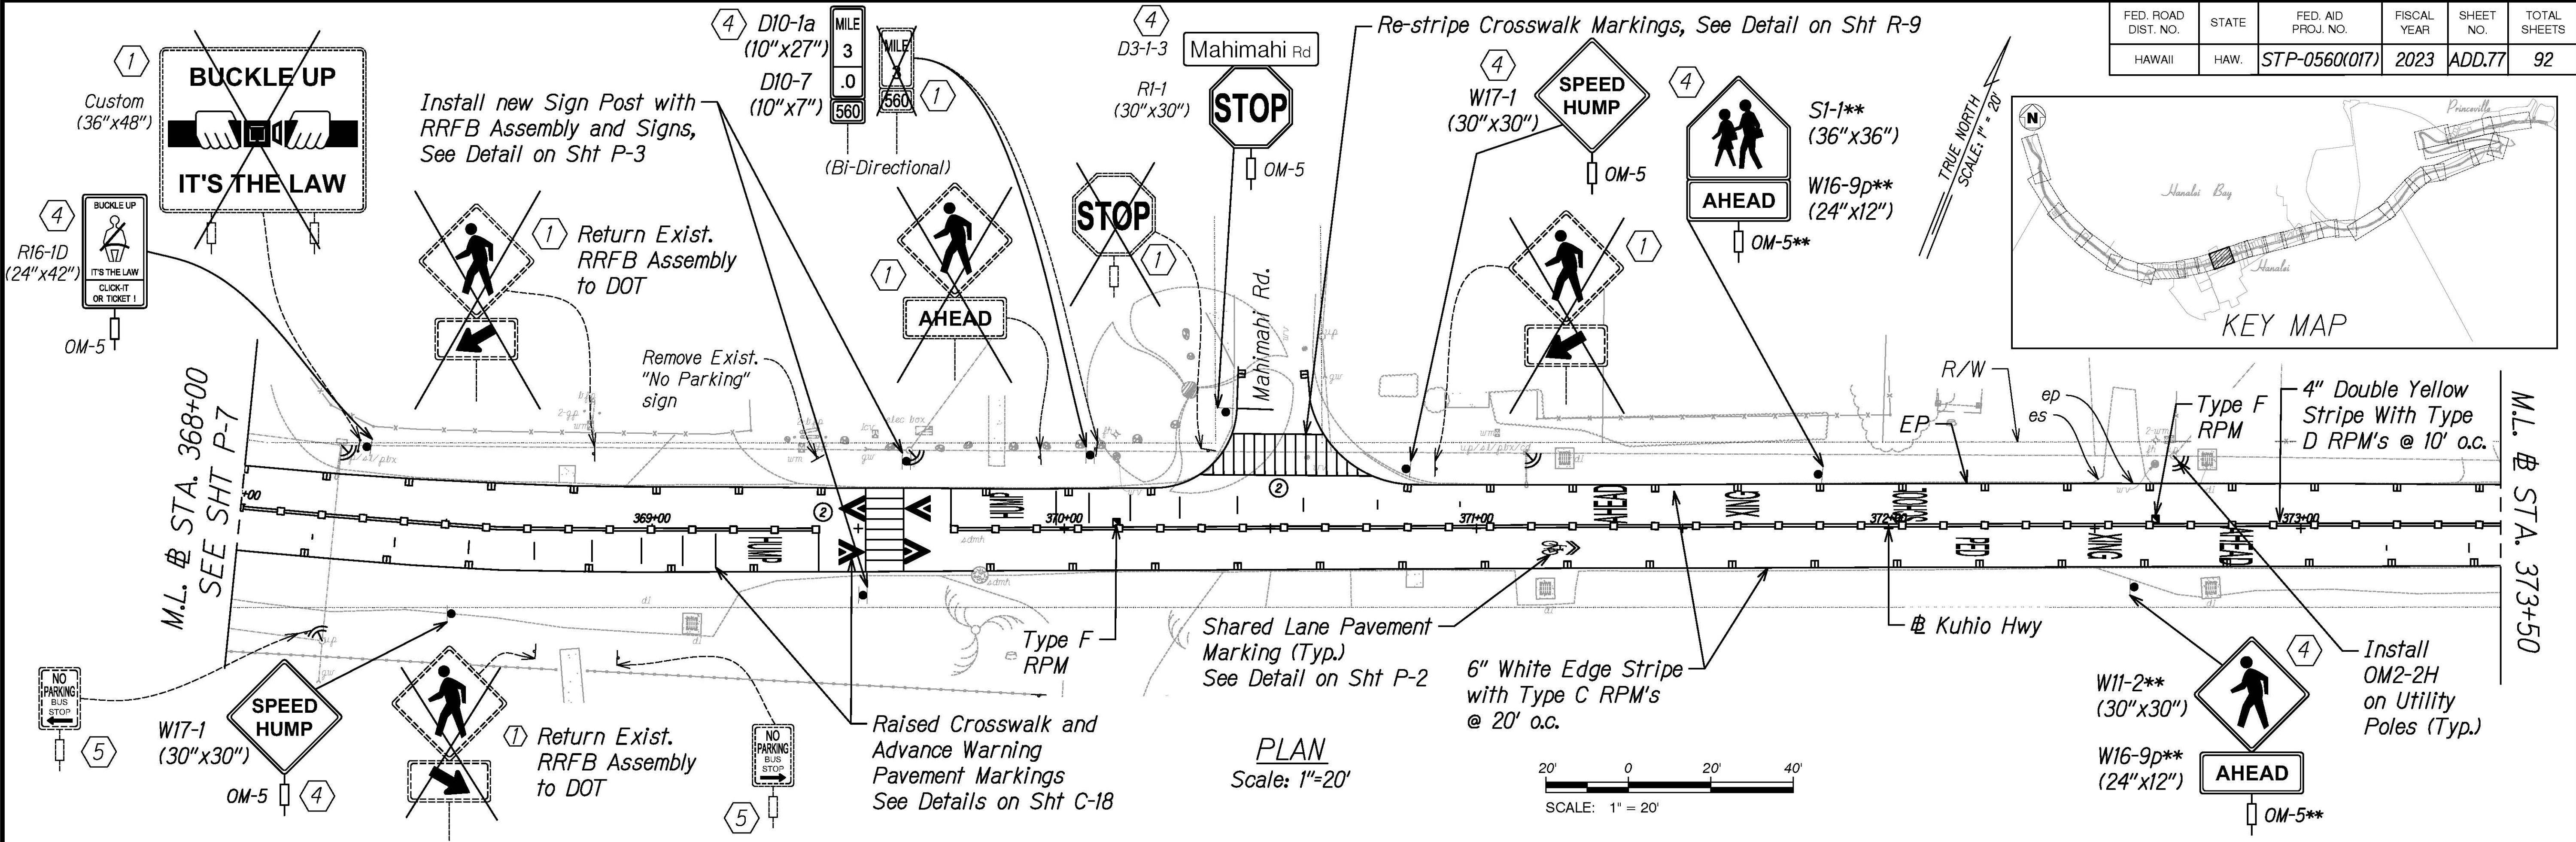

SURVEY PLOTTED BY	DATE
DRAWN BY	
DESIGNED BY	
QUANTITIES BY	
CHECKED BY	
ORIGINAL PLAN	
NOTE BOOK	
NO.	

NOTES:	
* Remove Existing OM2-V2 and Install New OM-5 on Existing Sign Post, See OM-5 Detail on Sht P-2	
** Fluorescent Yellow-Green	
1. Return All Existing RRFB Assemblies to the State	
10/12/23	△ - Corrected Sign Callout
DATE	REVISION

SCOTT A. KUNZ
LICENSED PROFESSIONAL ENGINEER
No. 7257-C
HAWAII, U.S.A.
LICENSE EXPIRES 4/30/24

STATE OF HAWAII
DEPARTMENT OF TRANSPORTATION
HIGHWAYS DIVISION

PAVEMENT MARKING & TRAFFIC SIGNING PLAN

KUHIO HIGHWAY RESURFACING AND SAFETY IMPROVEMENTS

Route 560 M.P. 0.0 to M.P. 4.5

Fed. Aid Proj. No. STP-0560(017)

Scale: 1"=20' Date: July, 2023


SHEET No. P-8A OF 20 SHEETS

ADD. 91

FED. ROAD DIST. NO.	STATE	FED. AID PROJ. NO.	FISCAL YEAR	SHEET NO.	TOTAL SHEETS
HAWAII	HAW.	STP-0560(017)	2023	ADD.92	92


LEGEND

- Sign
- Cone Or Delineator
- Direction Of Traffic
- ▨ Work Area
- ▭ Portable Message Board
- ⊥ Type III Barricade
- 🚧 Flagman

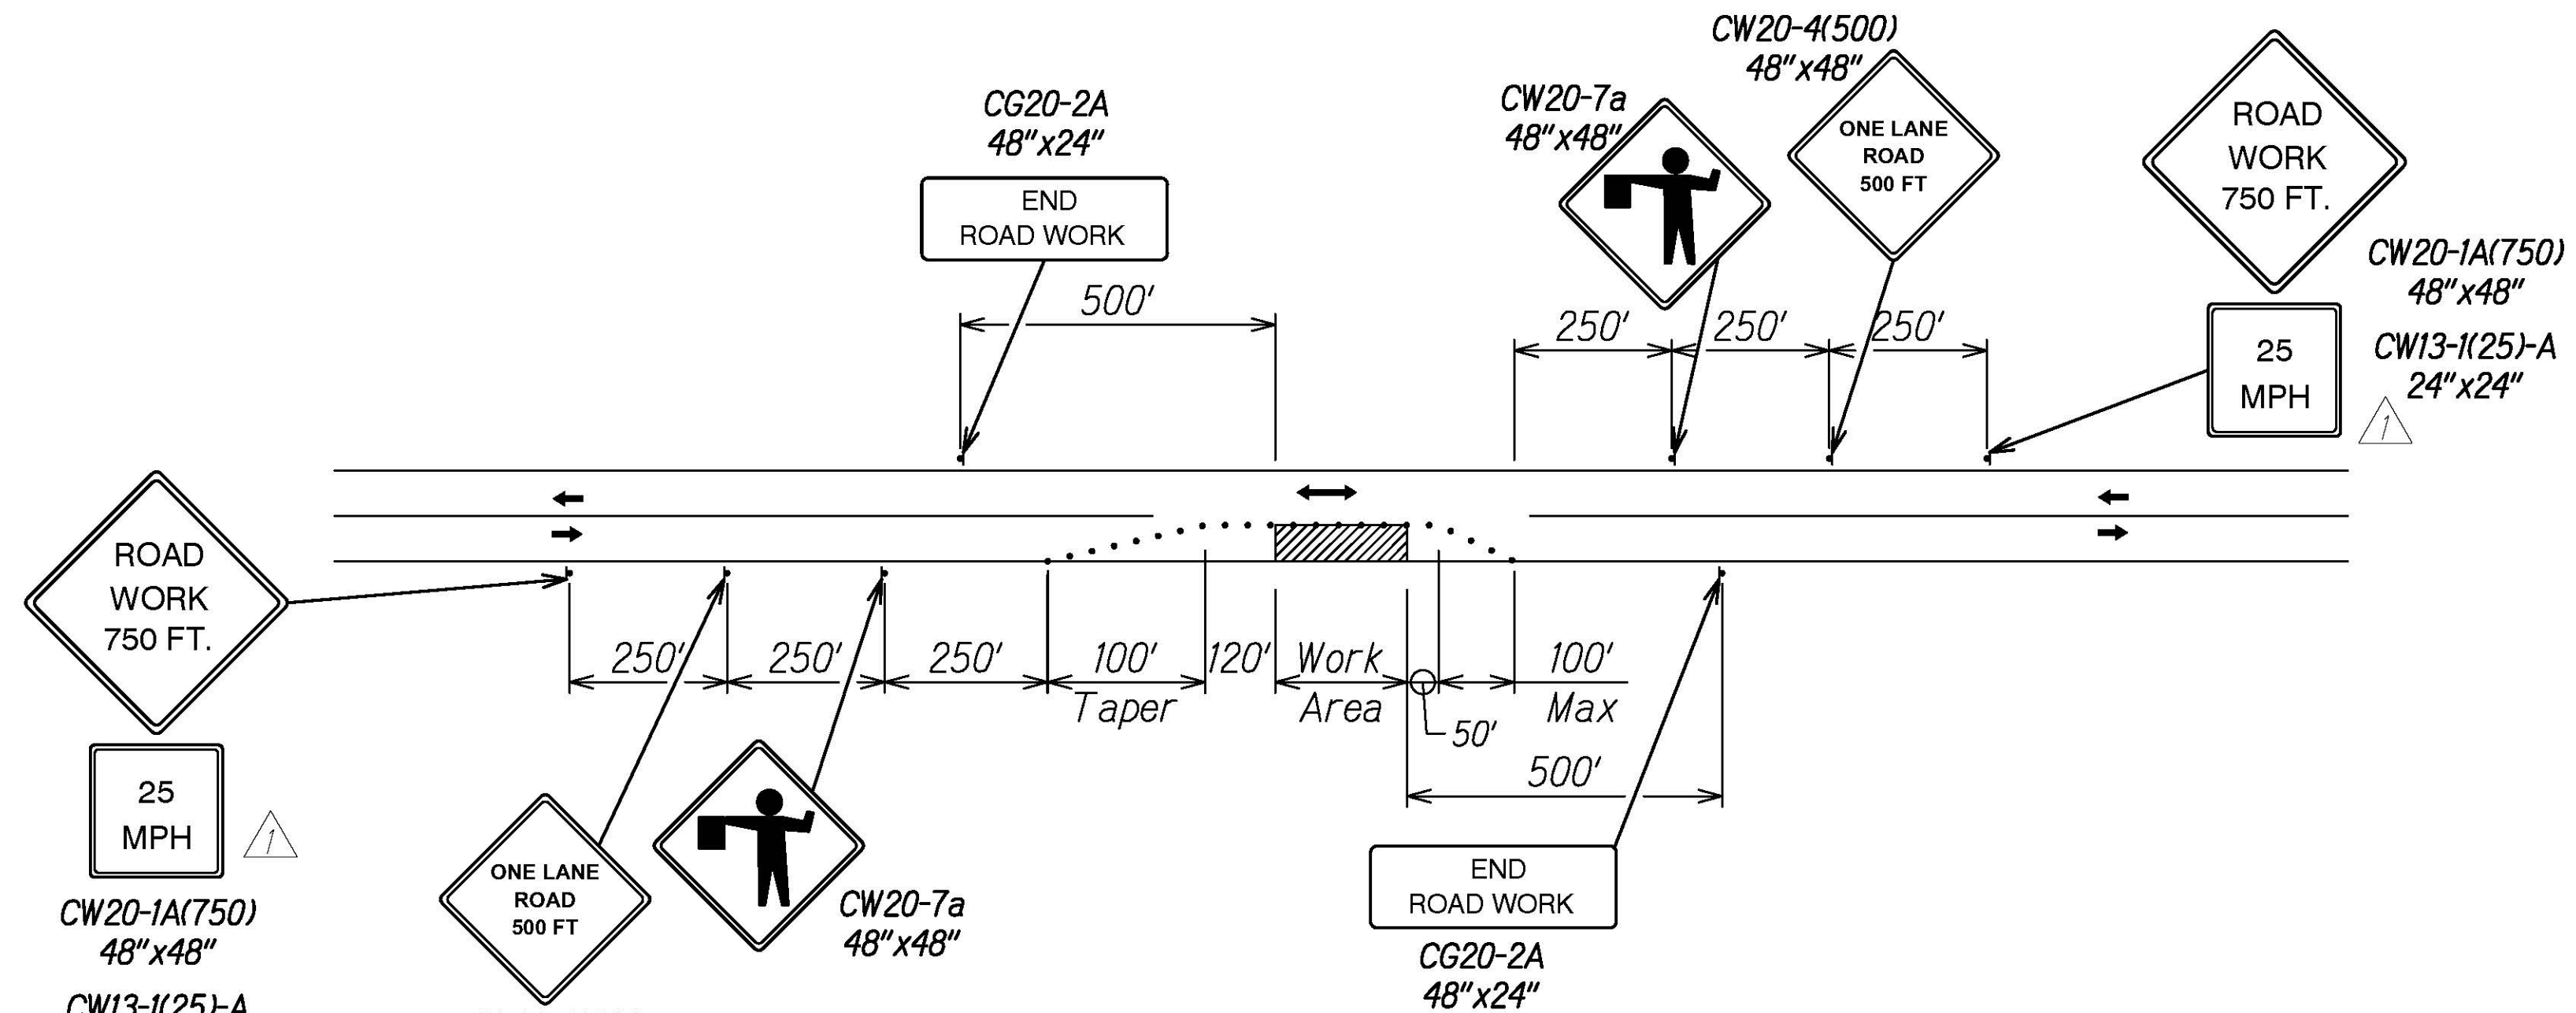

HIGHWAY FULL LANE CLOSURE
TRAFFIC CONTROL PLAN


Not To Scale

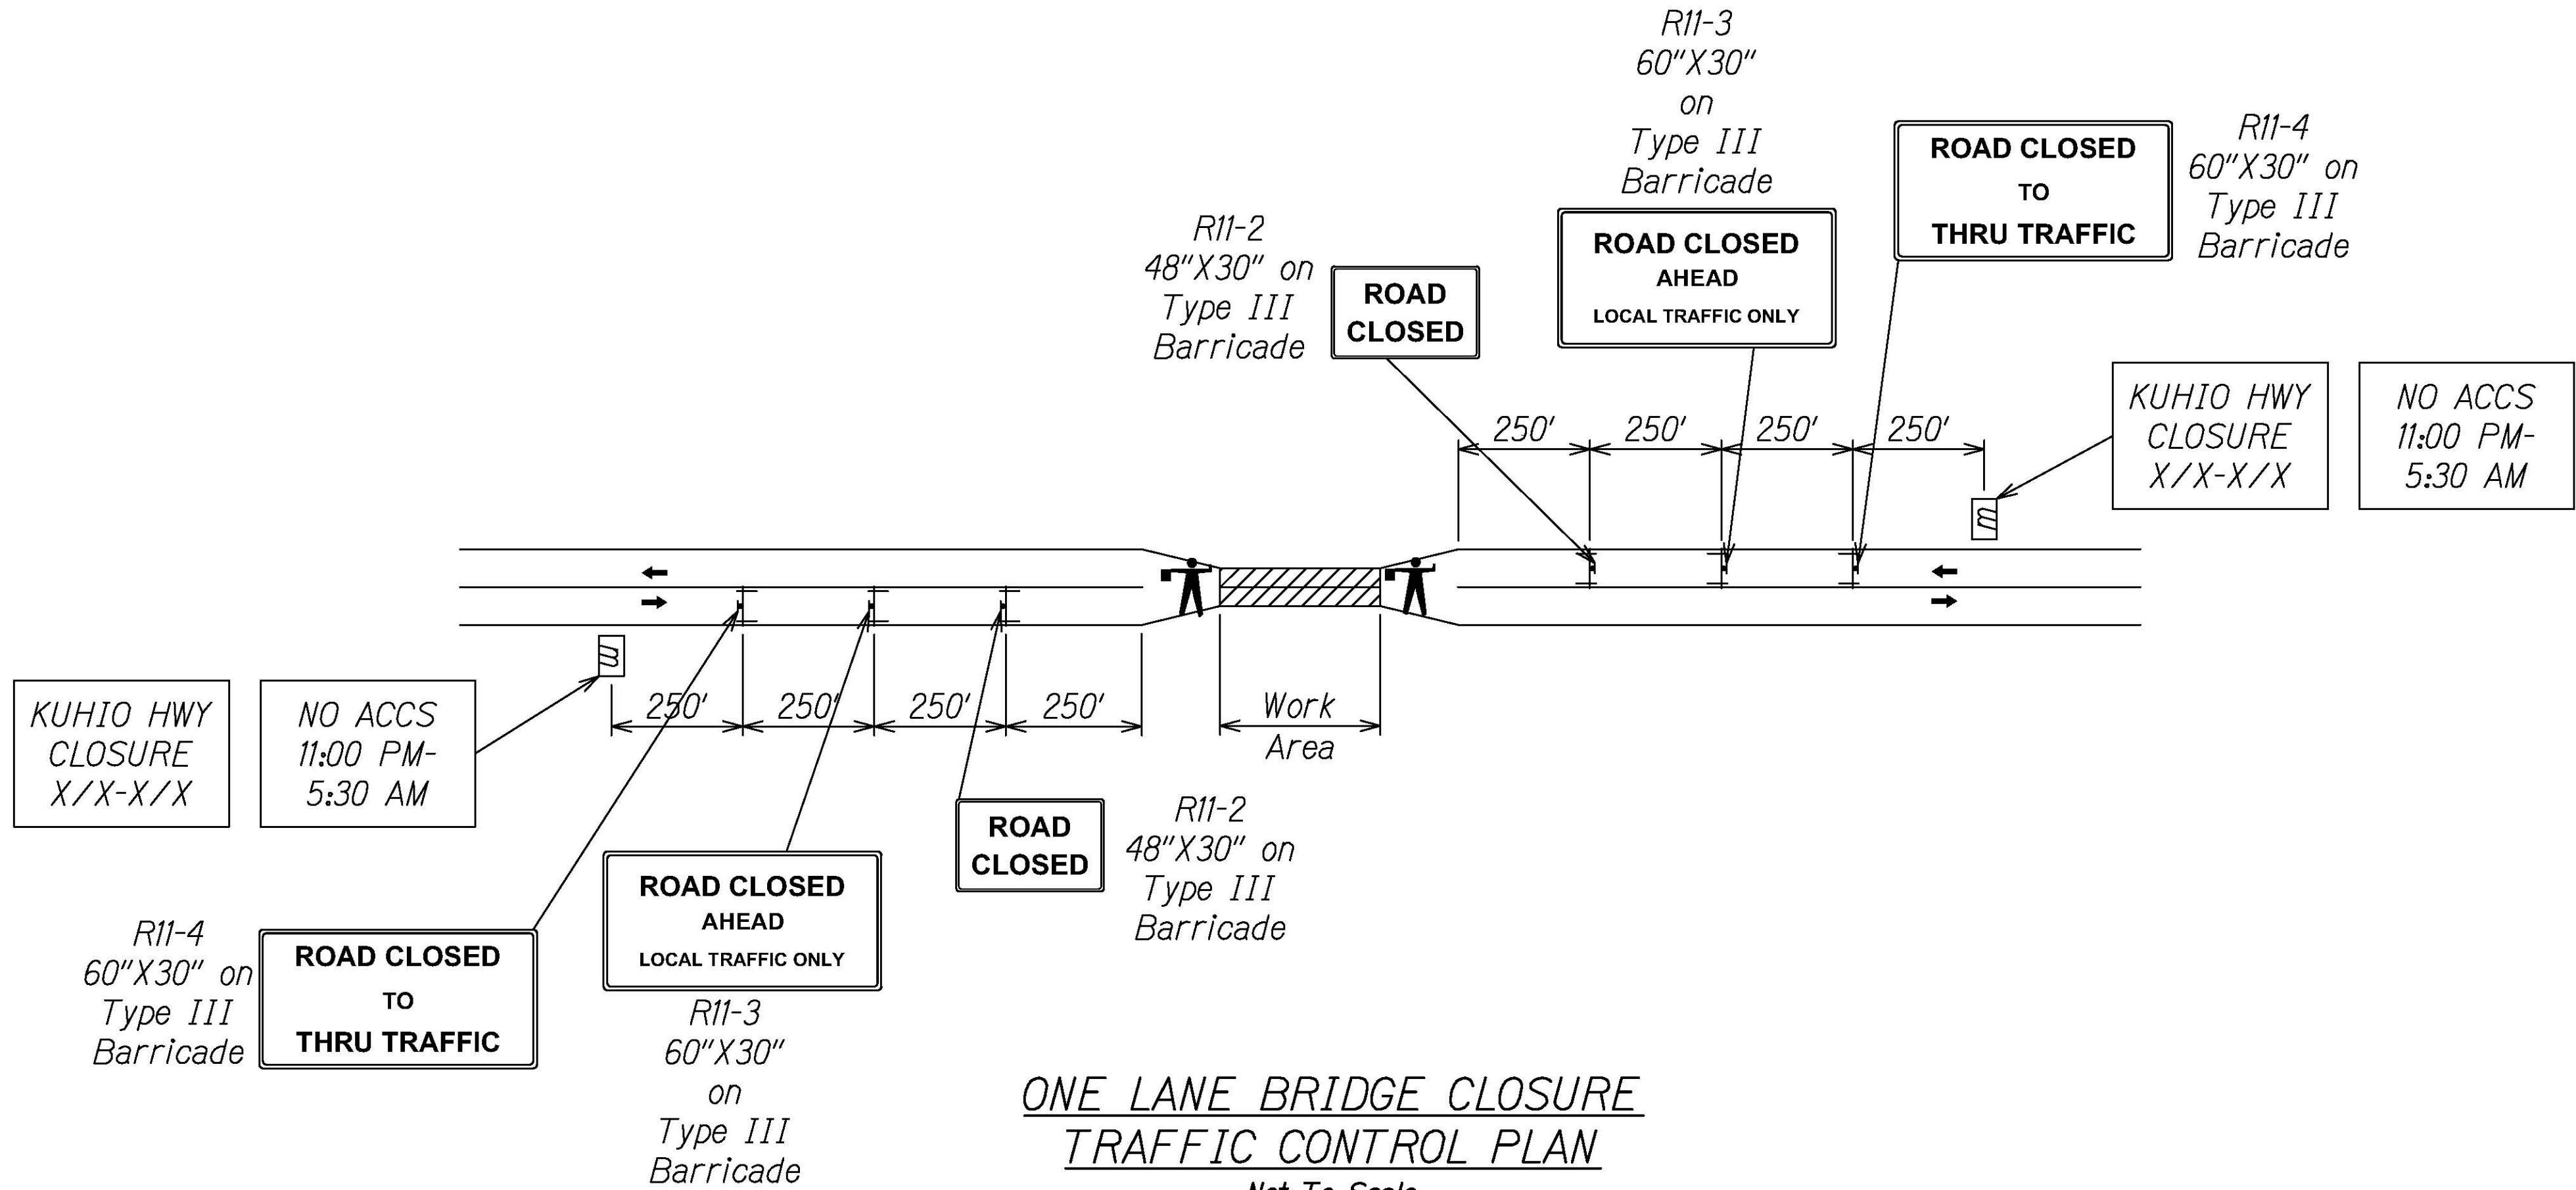

ONE LANE BRIDGE CLOSURE
TRAFFIC CONTROL PLAN

Not To Scale

SURVEY PLOTTED BY	DATE
DRAWN BY	
DESIGNED BY	
QUANTITIES BY	
CHECKED BY	
ORIGINAL PLAN	
NOTE BOOK	
NO.	

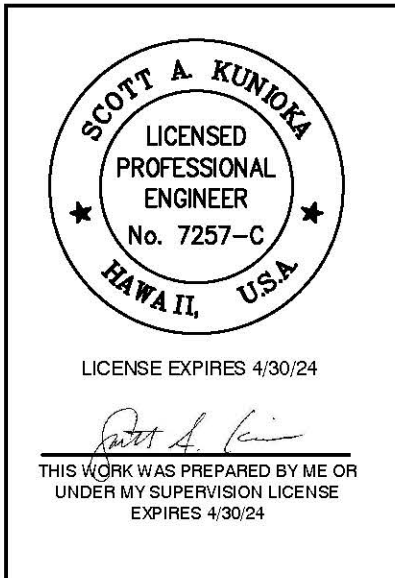

STATE OF HAWAII
DEPARTMENT OF TRANSPORTATION
HIGHWAYS DIVISION
**TEMPORARY TRAFFIC
CONTROL PLAN & NOTES**
**KUHIO HIGHWAY RESURFACING
AND SAFETY IMPROVEMENTS**
Route 560 M.P. 0.0 to M.P. 4.5
Fed. Aid Proj. No. STP-0560(017)
Scale: Not to Scale Date: July, 2023

10/12/23	△ - Revised Advisory Speed
DATE	REVISION

SHEET No. TC-3A OF 3 SHEETS