




FED. ROAD DIST. NO.	STATE	PROJ. NO.	FISCAL YEAR	SHEET NO.	TOTAL SHEETS
HAWAII	HAW.	570A-01-11MR	2013	ADD.7	18

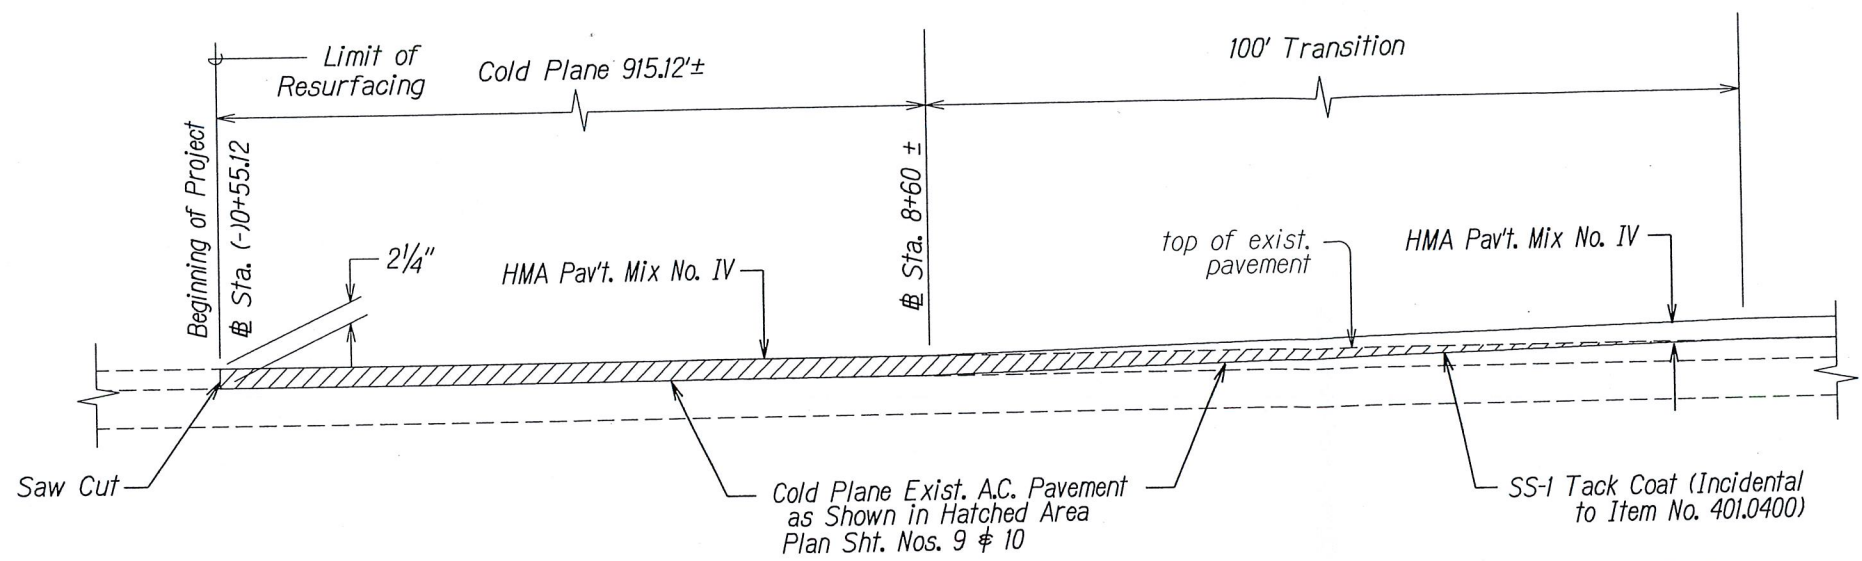


COLD PLANED TRANSITION TO EXISTING A.C. PAVEMENT AT THE BEGINNING OF PROJECT

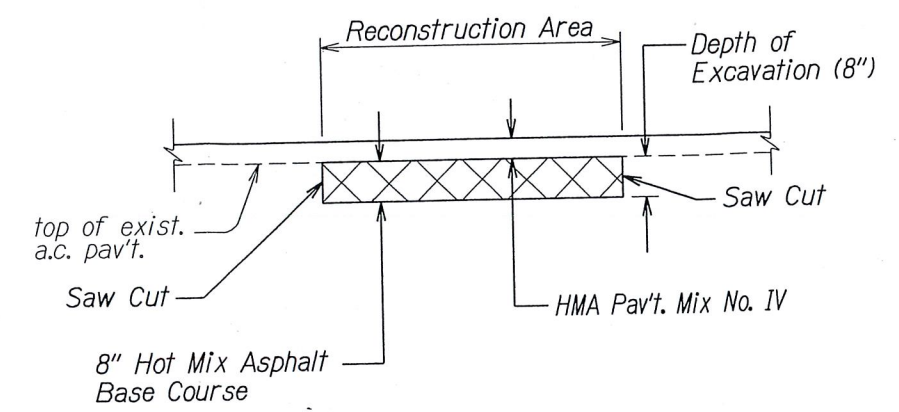

A.C. PAVEMENT RECONSTRUCTION DETAIL
Not to Scale

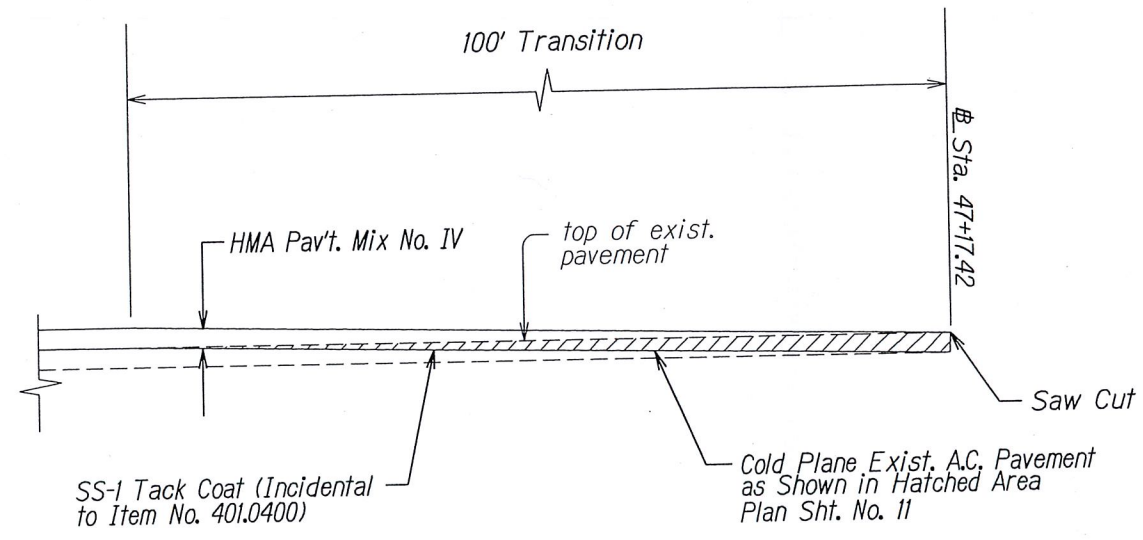


COLD PLANED TRANSITION TO EXISTING A.C. PAVEMENT AT THE END OF PROJECT

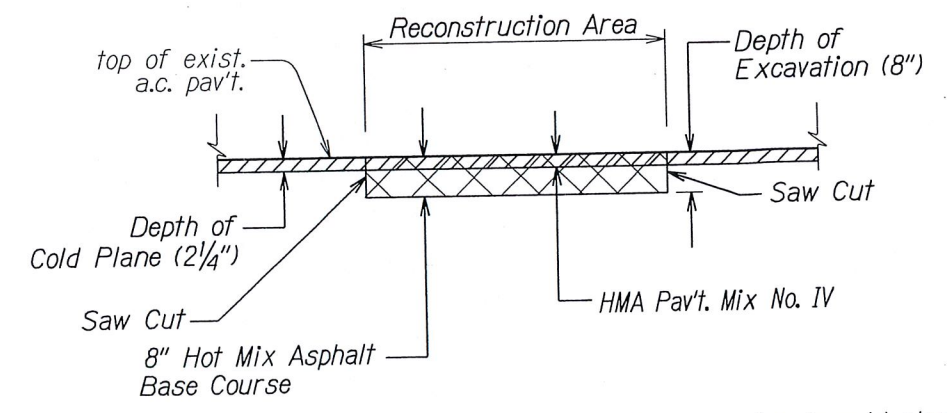

Note: Reconstruct weakened pavement areas prior to cold plane

A.C. PAVEMENT RECONSTRUCTION DETAIL
@ COLD PLANED AREAS
Not to Scale

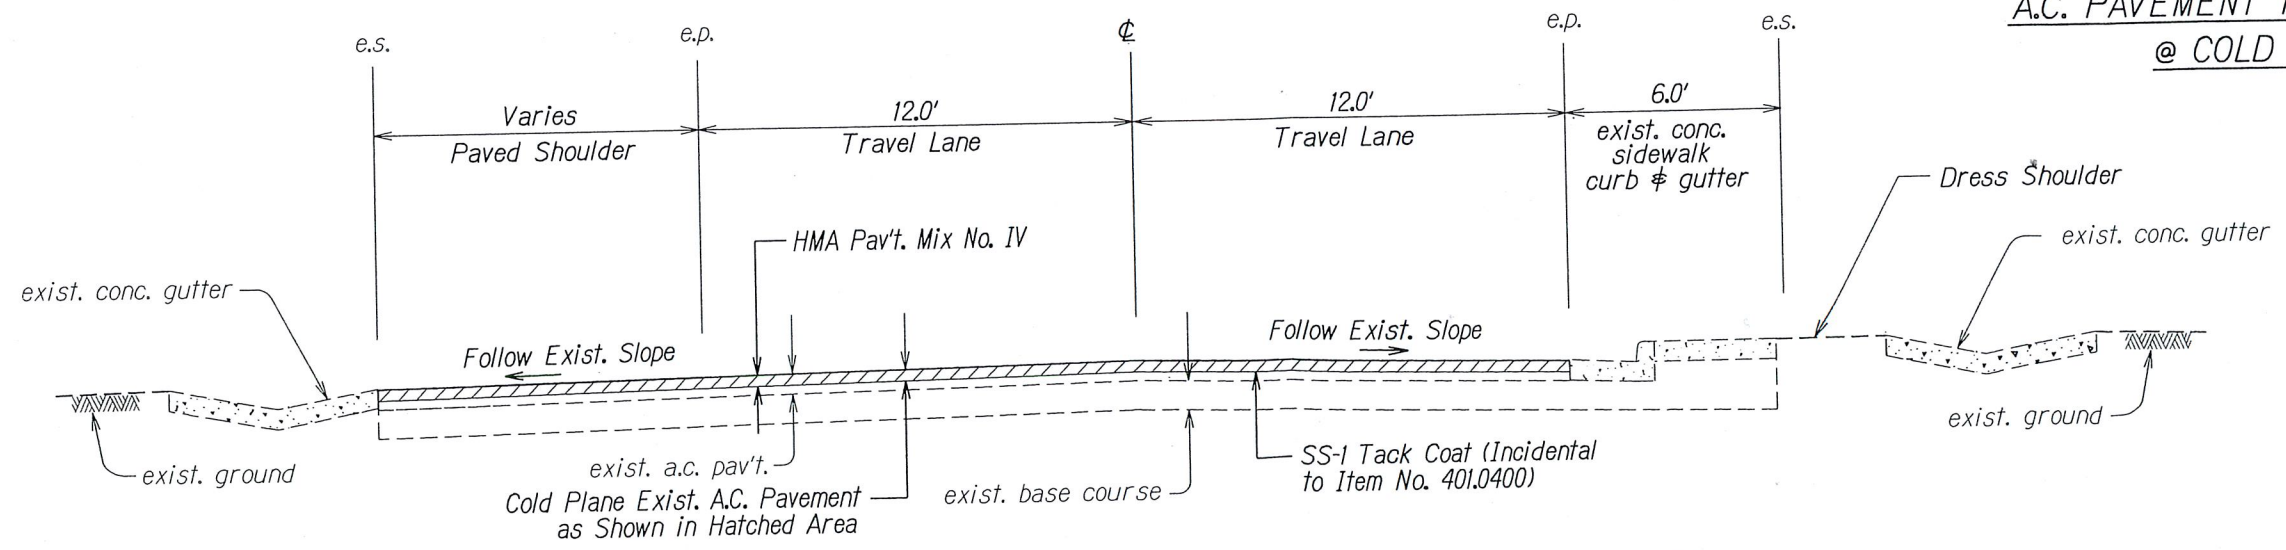

TYPICAL ROADWAY SECTION # Sta. (-)0+55.12 TO # Sta. 8+60

DATE	04/16/13	Revise Typical Roadway Section
DATE		REVISION
STATE OF HAWAII DEPARTMENT OF TRANSPORTATION HIGHWAYS DIVISION		
TYPICAL SECTIONS		
AHUKINI ROAD RESURFACING		
Kuhio Highway to Kapule Highway		
Project No. 570A-01-11MR		
Not to Scale		
Date: April 2013		
SHEET No. 2 OF 3 SHEETS		

ORIGINAL PLAN	DATE
SURVEY PLOTTED BY	
DRAWN BY	
TRACED BY	
NOTED BY	
CHECKED BY	
DATE	