


FED. ROAD DIST. NO.	STATE	PROJ. NO.	FISCAL YEAR	SHEET NO.	TOTAL SHEETS
HAWAII	HAW.	570A-01-11MR	2013	9	18

TRUE NORTH
SCALE: 1" = 40'

△ CURVE DATA
 $\Delta = 2^\circ 16' 00''$
 $R = 1500.00$
 $T = 281.62$
 $L = 556.76$

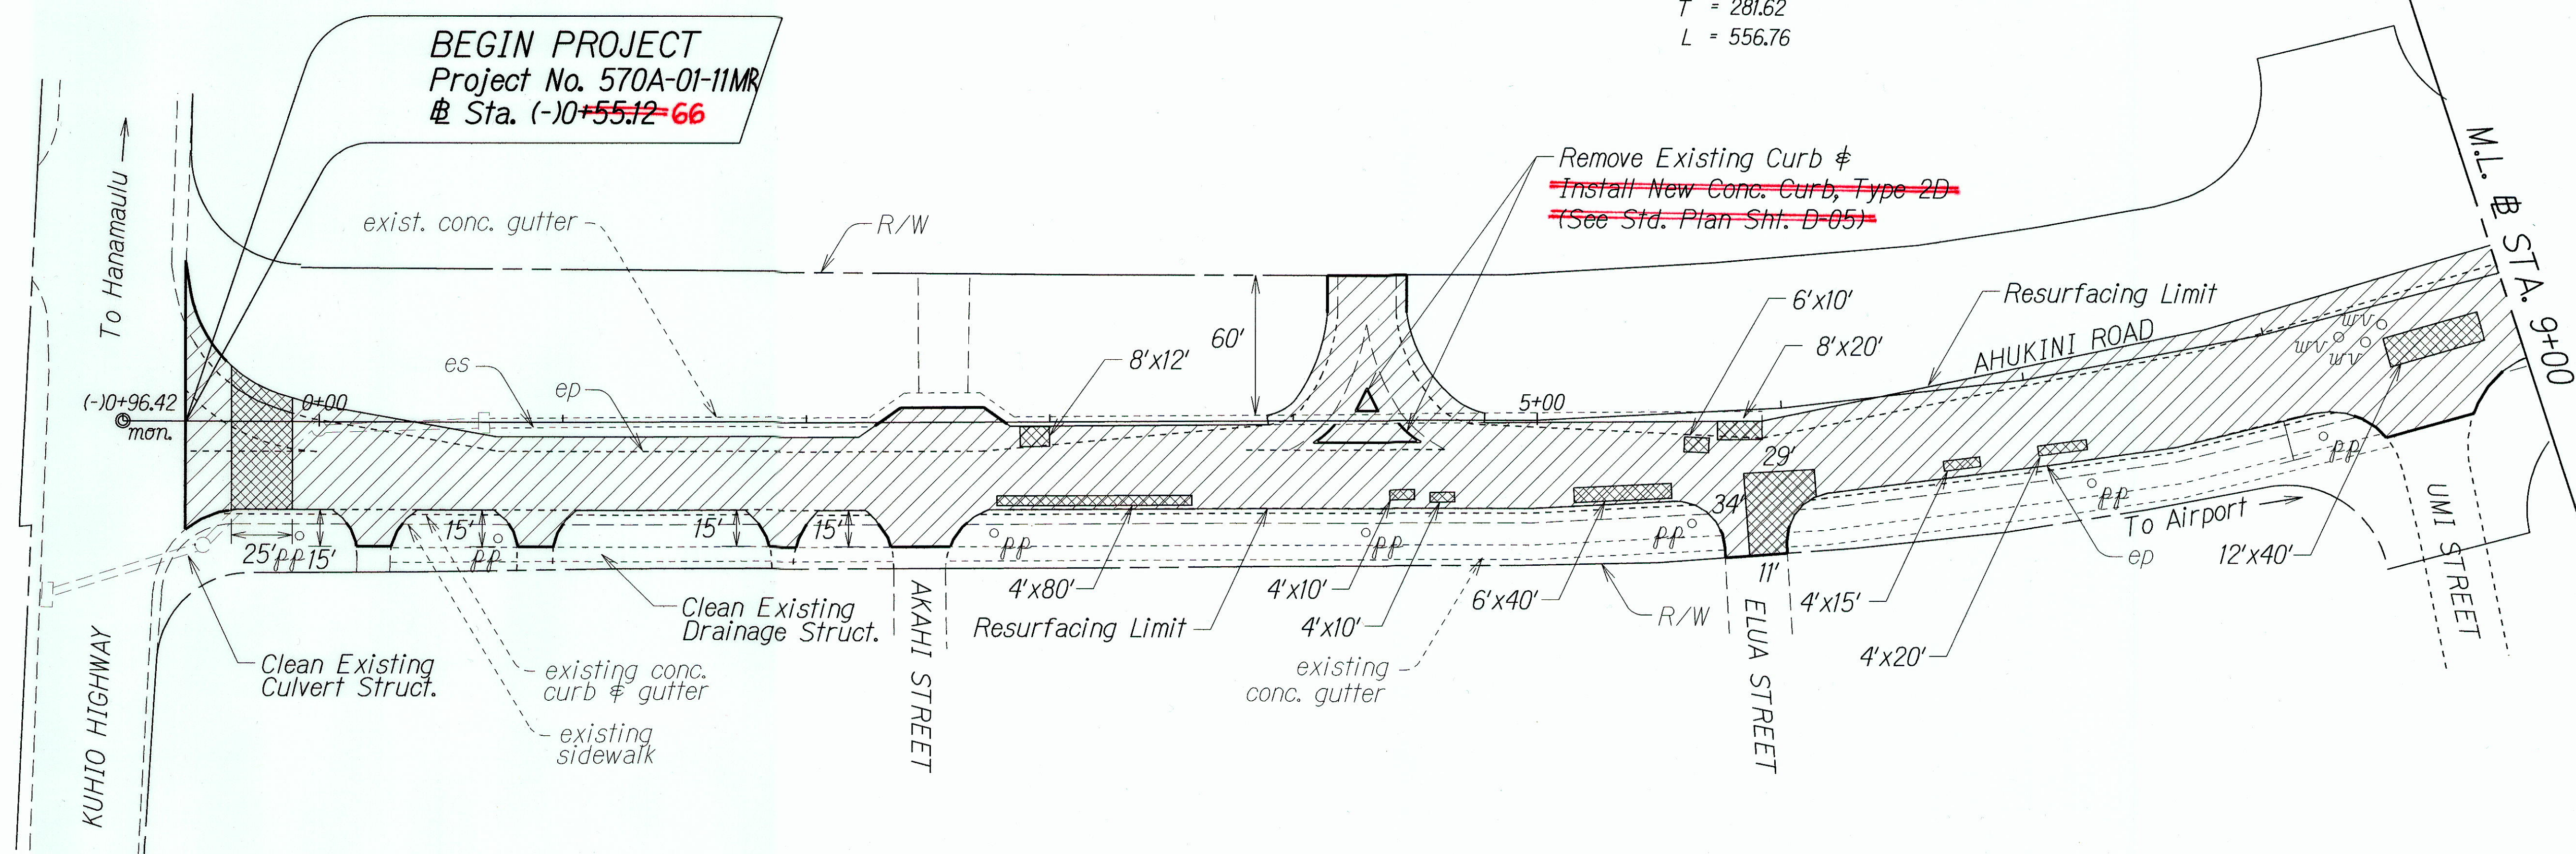

DESIGNED BY	DATE
TRACED BY	
DESIGNED BY	
QUANTITIES BY	
CHECKED BY	

APPROVED:
 for *[Signature]* Manager & Chief Engineer
 Department of Water
 Date: 2/22/13

STATE OF HAWAII
 DEPARTMENT OF TRANSPORTATION
 HIGHWAYS DIVISION

ROADWAY PLAN


AHUKINI ROAD RESURFACING
 Kuhio Highway to Kapule Highway
 Project No. 570A-01-11MR

Scale: 1" = 40' Date: Feb. 2013

SHEET No. 1 OF 3 SHEETS

"AS-BUILT"

FED. ROAD DIST. NO.	STATE	PROJ. NO.	FISCAL YEAR	SHEET NO.	TOTAL SHEETS
HAWAII	HAW.	570A-01-11MR	2013	10	18

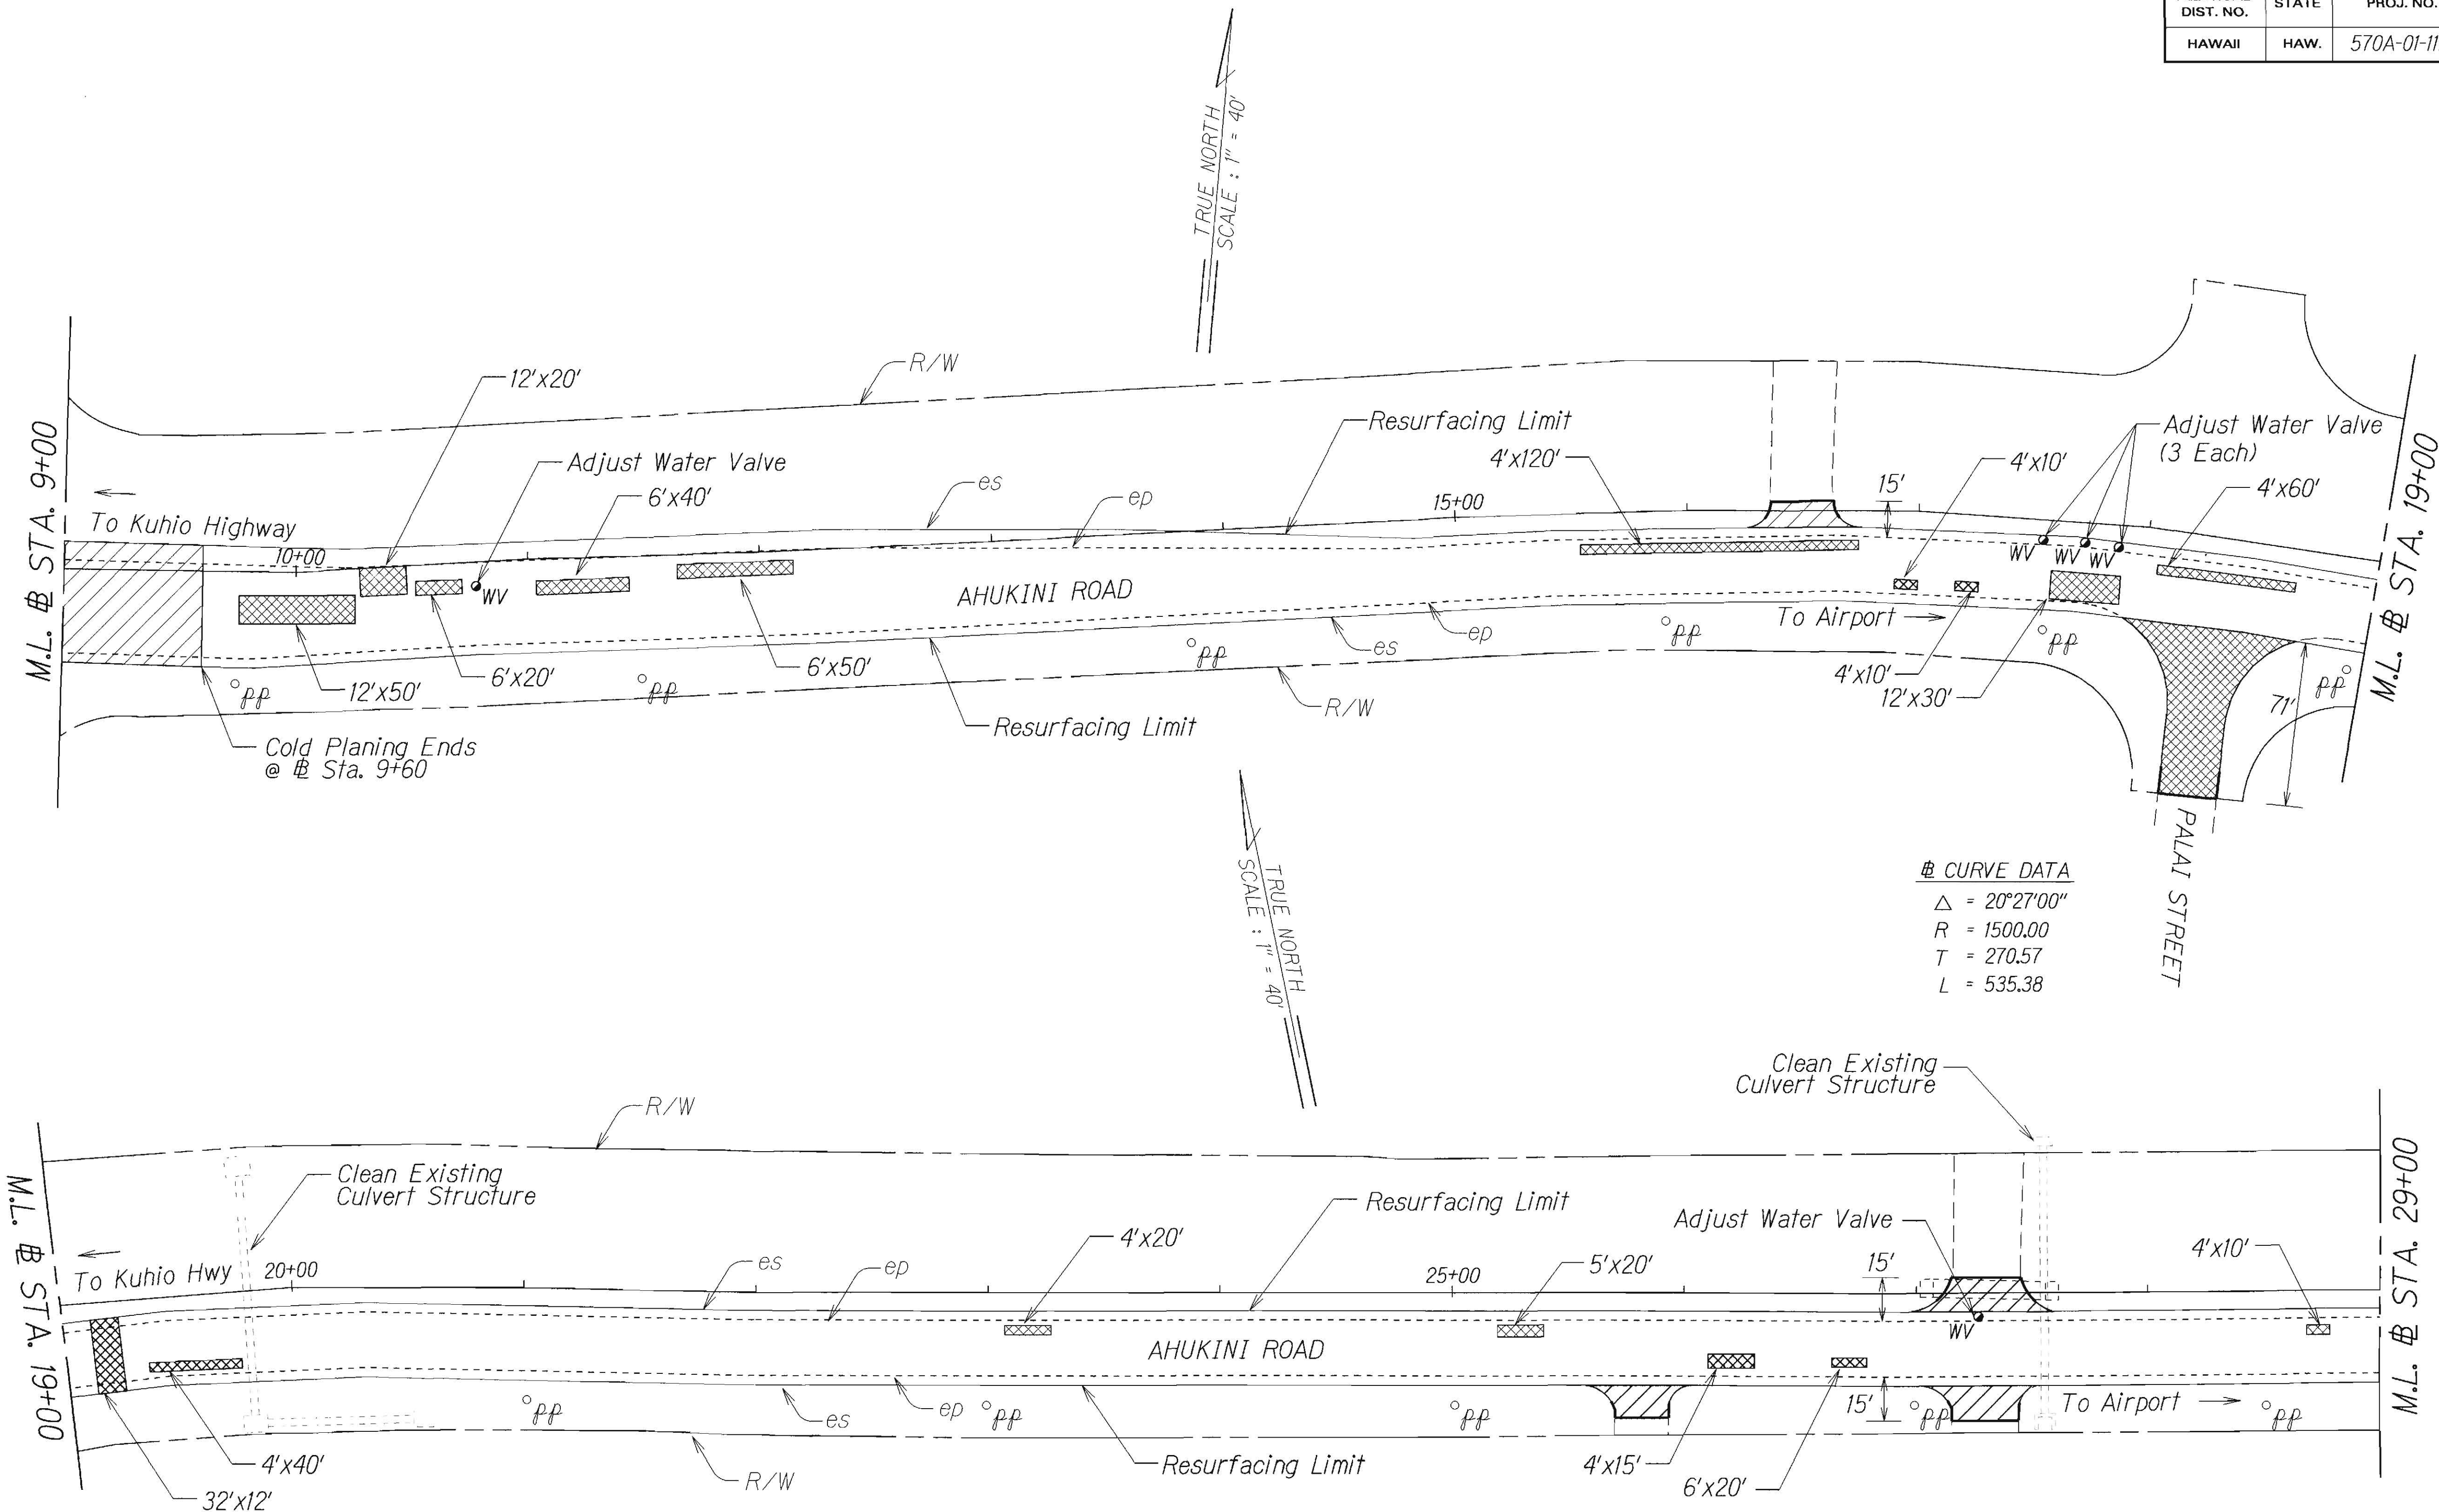

DATE	_____
SURVEY PLOTTED BY	_____
DESIGNED BY	_____
QUANTITIES BY	_____
CHECKED BY	_____
ORIGINAL PLAN	_____
NOTE BOOK	_____
N.	_____

APPROVED:

for Kath A.
Manager & Chief Engineer
Department of Water

2/22/13
Date

STATE OF HAWAII
DEPARTMENT OF TRANSPORTATION
HIGHWAYS DIVISION

ROADWAY PLAN


AHUKINI ROAD RESURFACING
Kuhio Highway to Kapule Highway
Project No. 570A-01-11MR

Scale: 1" = 40'

Date: Feb. 2013

SHEET No. 2 OF 3 SHEETS

FED. ROAD DIST. NO.	STATE	PROJ. NO.	FISCAL YEAR	SHEET NO.	TOTAL SHEETS
HAWAII	HAW.	570A-01-11MR	2013	11	18

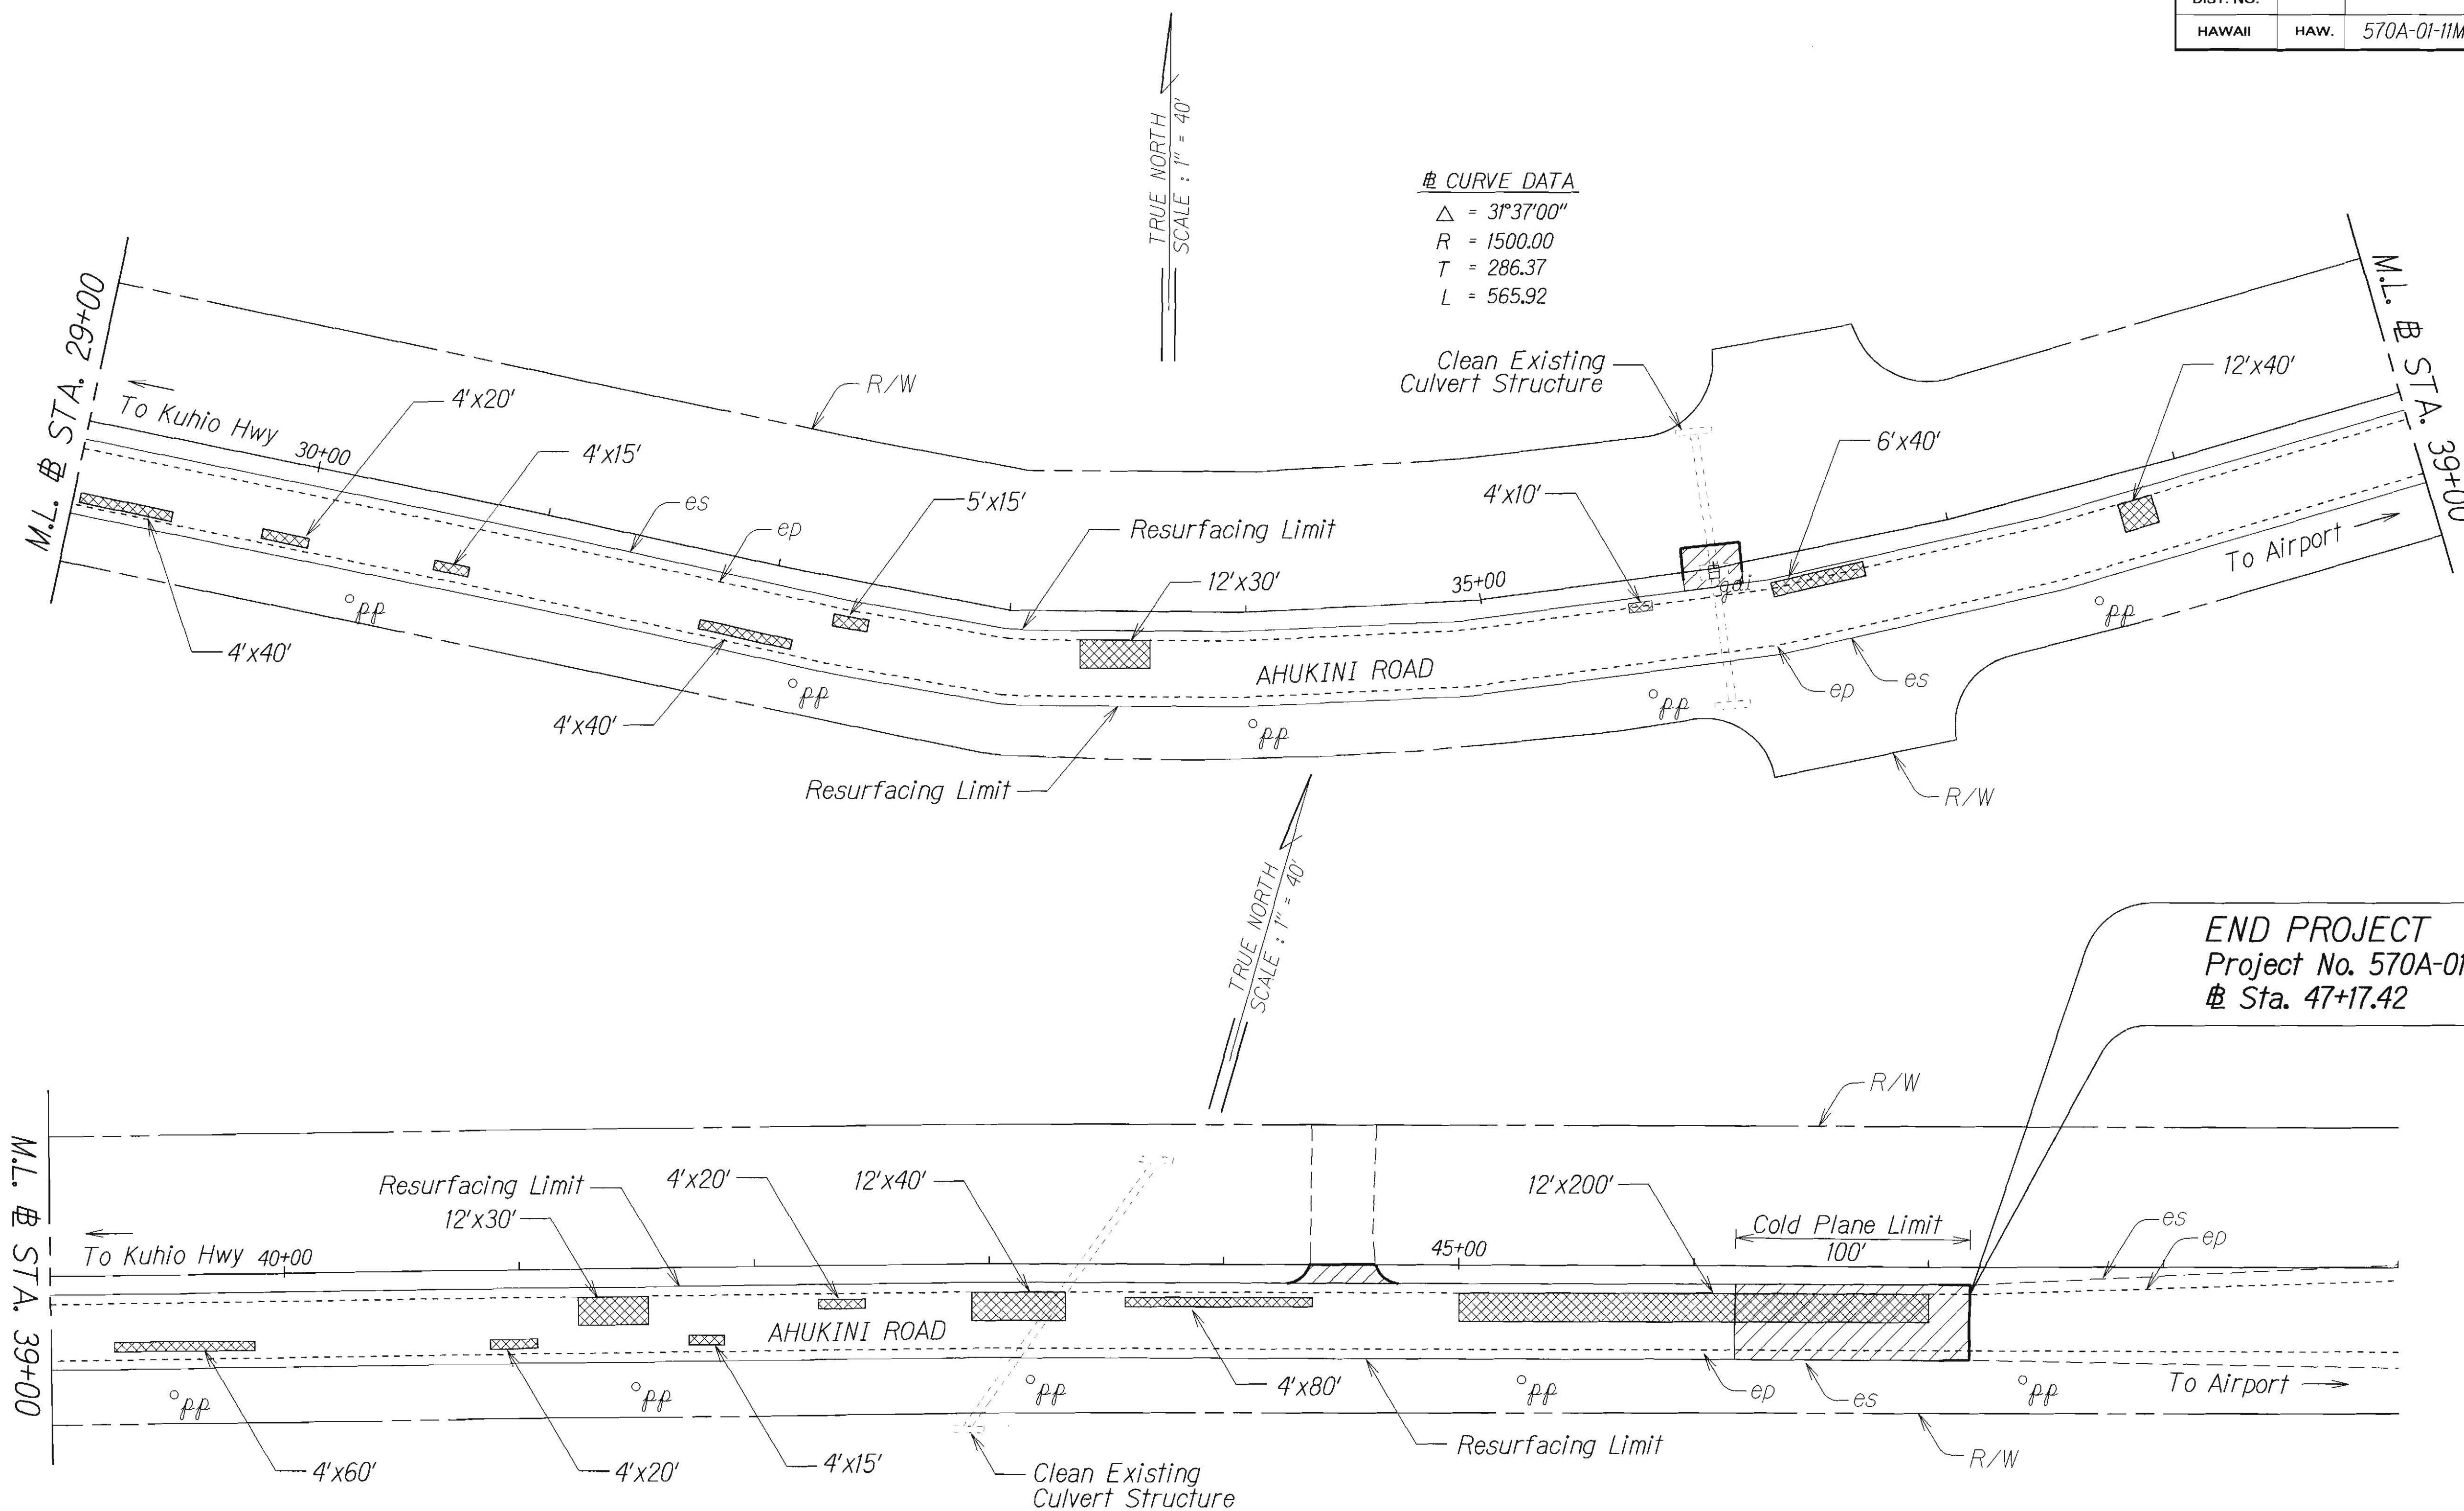

CURVE DATA
 $\Delta = 31^{\circ}37'00''$
 $R = 1500.00$
 $T = 286.37$
 $L = 565.92$

END PROJECT
 Project No. 570A-01-11MR
 # Sta. 47+17.42

DATE	
SURVEY PLOTTED BY	
DRAWN BY	
TRACED BY	
NOTE BOOK	
QUANTITIES BY	
CHECKED BY	

APPROVED:

[Signature]
 for Manager & Chief Engineer
 Department of Water

2/22/13
 Date

STATE OF HAWAII
 DEPARTMENT OF TRANSPORTATION
 HIGHWAYS DIVISION

ROADWAY PLAN

AHUKINI ROAD RESURFACING
 Kuhio Highway to Kapule Highway
 Project No. 570A-01-11MR

Scale: 1" = 40' Date: Feb. 2013

SHEET No. 3 OF 3 SHEETS