

INDEX TO DRAWINGS	
SHEET NO.	DESCRIPTION
1	TITLE SHEET
2	STANDARD PLANS SUMMARY
3	GENERAL NOTES & LEGEND
4 - 5	WATER POLLUTION AND EROSION CONTROL NOTES
6 - 8	TYPICAL SECTIONS
9 - 11	ROADWAY PLAN
12	PAVEMENT MARKING, NOTES, LEGEND, AND SIGN DETAILS
13 - 15	PAVEMENT MARKING AND TRAFFIC SIGNING PLAN
16	SIGN DETAILS
17	LOOP DETECTOR PLAN
18	HIGH SPEED UNDIVIDED HIGHWAY WORK ZONE SIGNING PLAN, NOTES & DETAILS

STATE OF HAWAII

DEPARTMENT OF TRANSPORTATION

HIGHWAYS DIVISION

HONOLULU, HAWAII

"AS-BUILT"

PLANS FOR


AHUKINI ROAD RESURFACING

KUHIO HIGHWAY TO KAPULE HIGHWAY



PROJECT NO. 570A-01-11MR

DISTRICT OF LIHUE

ISLAND OF KAUAI

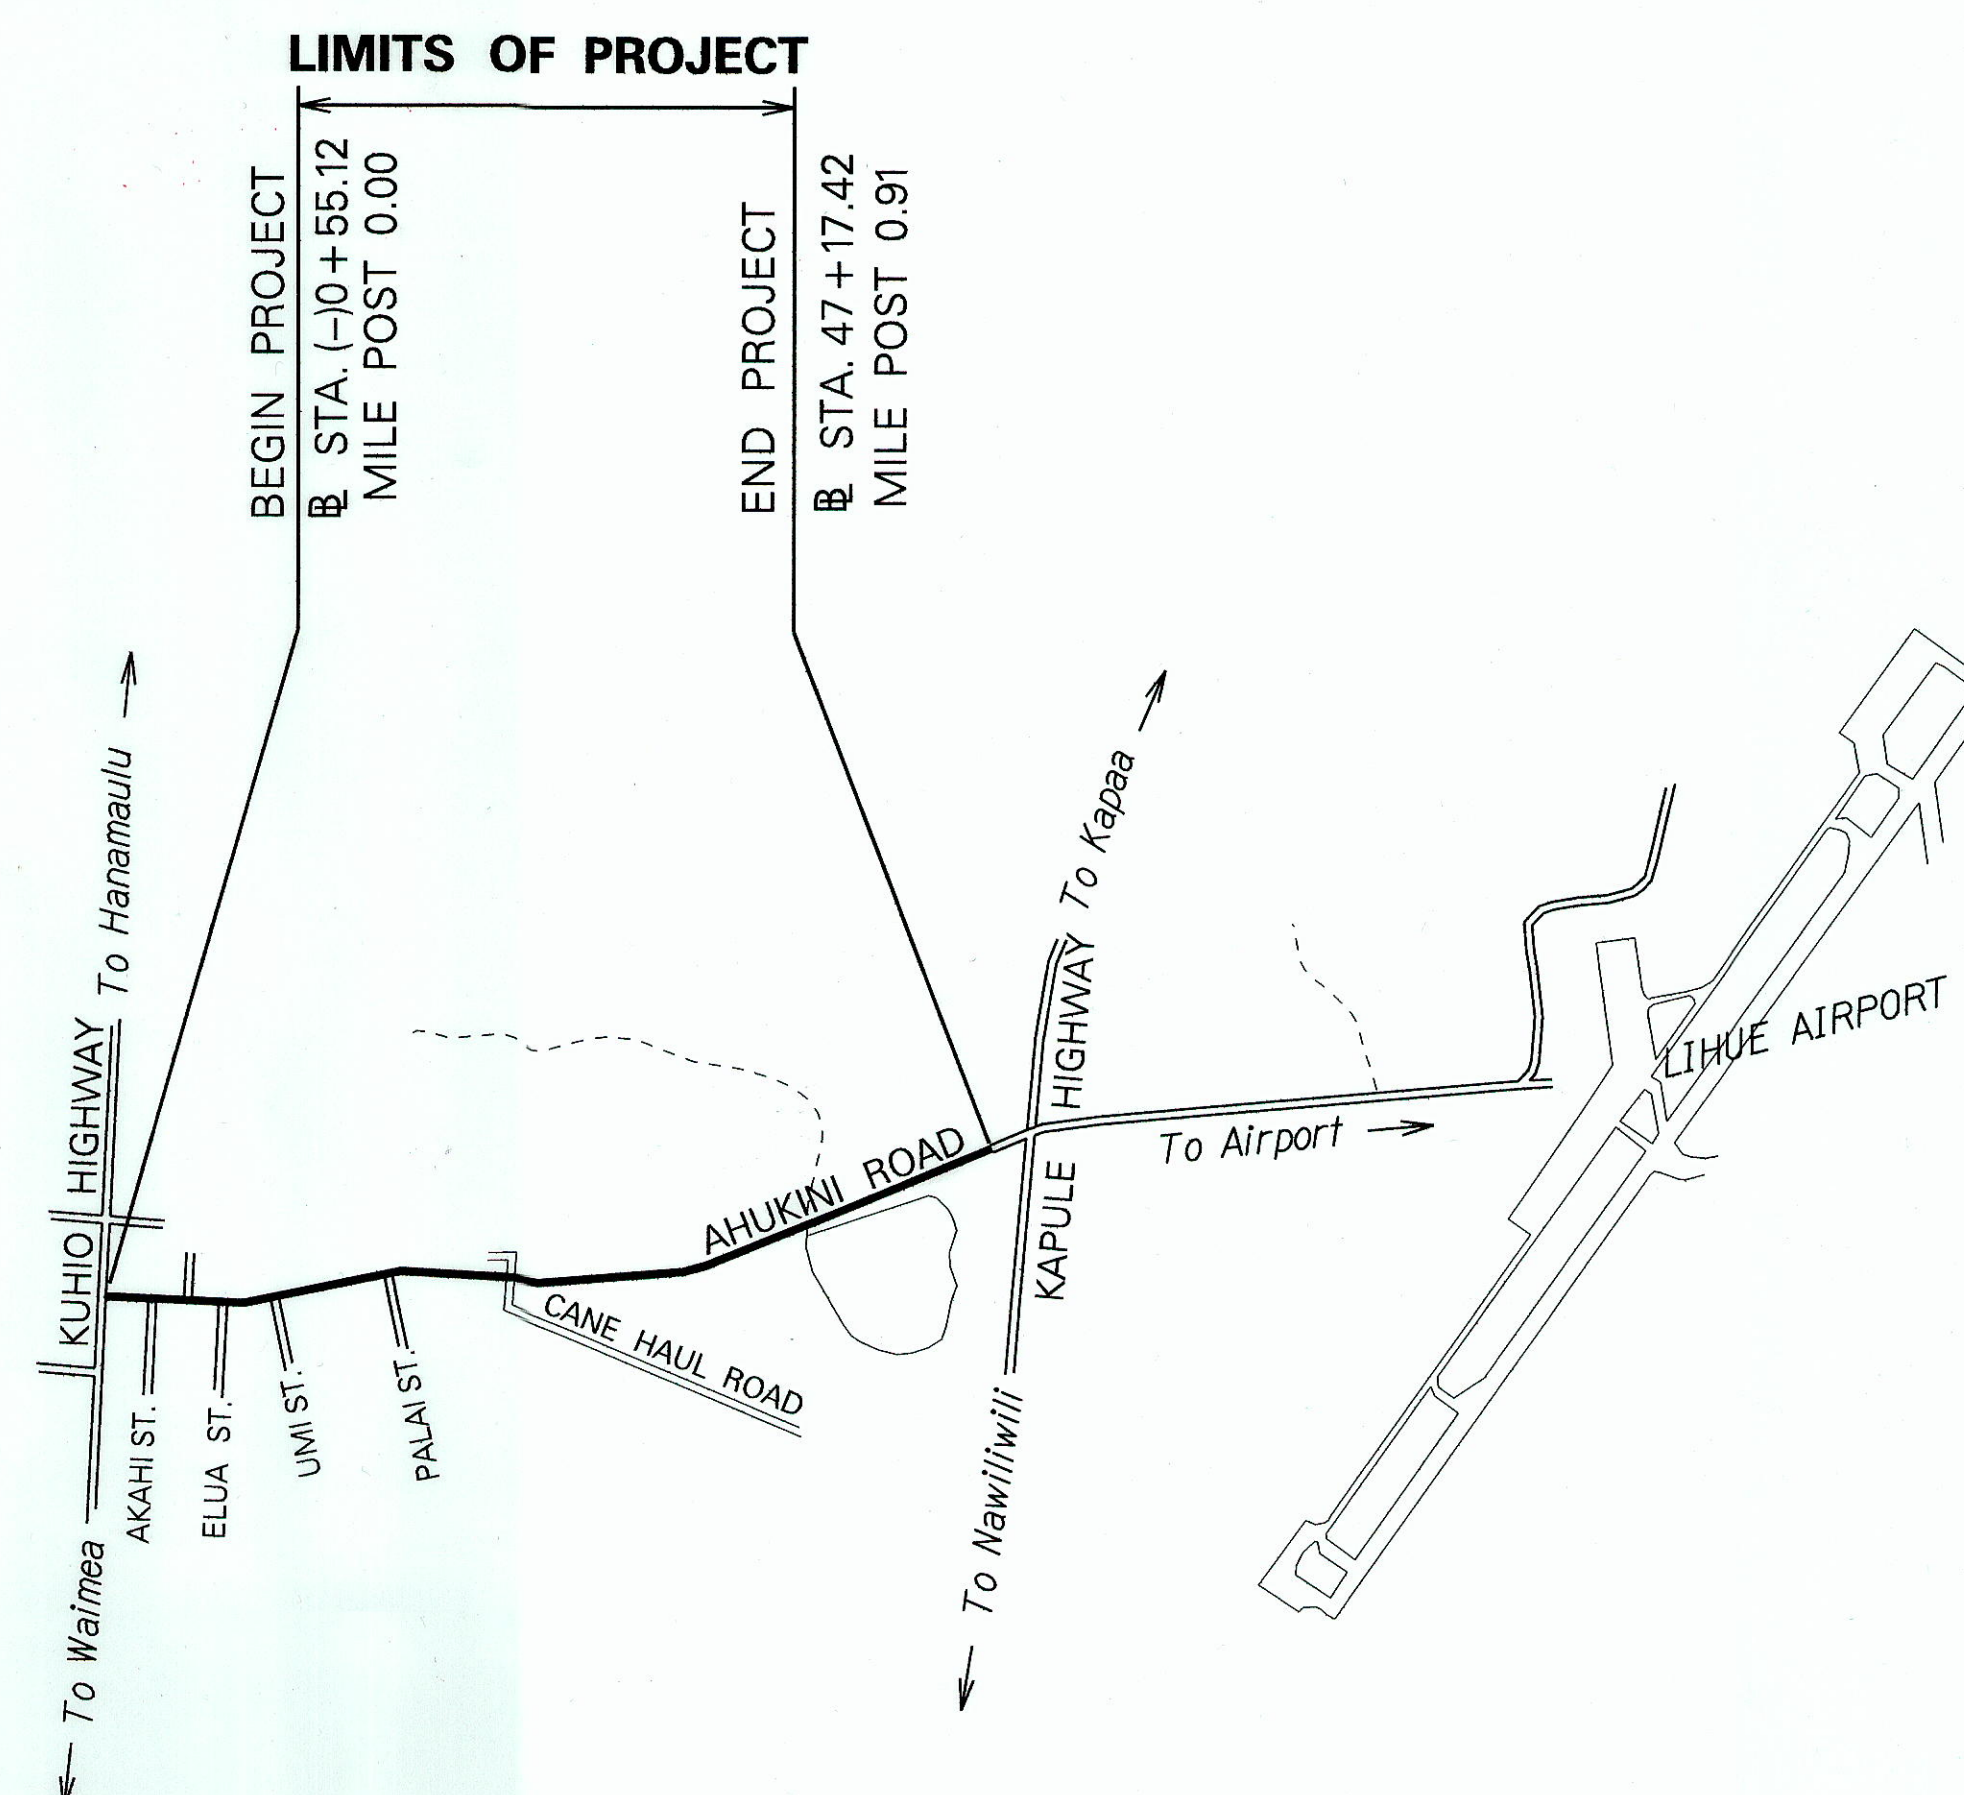

FED. ROAD DIST. NO.	STATE	PROJ. NO.	FISCAL YEAR	SHEET NO.	TOTAL SHEETS
HAWAII	HAW.	570A-01-11MR	2013	1	18

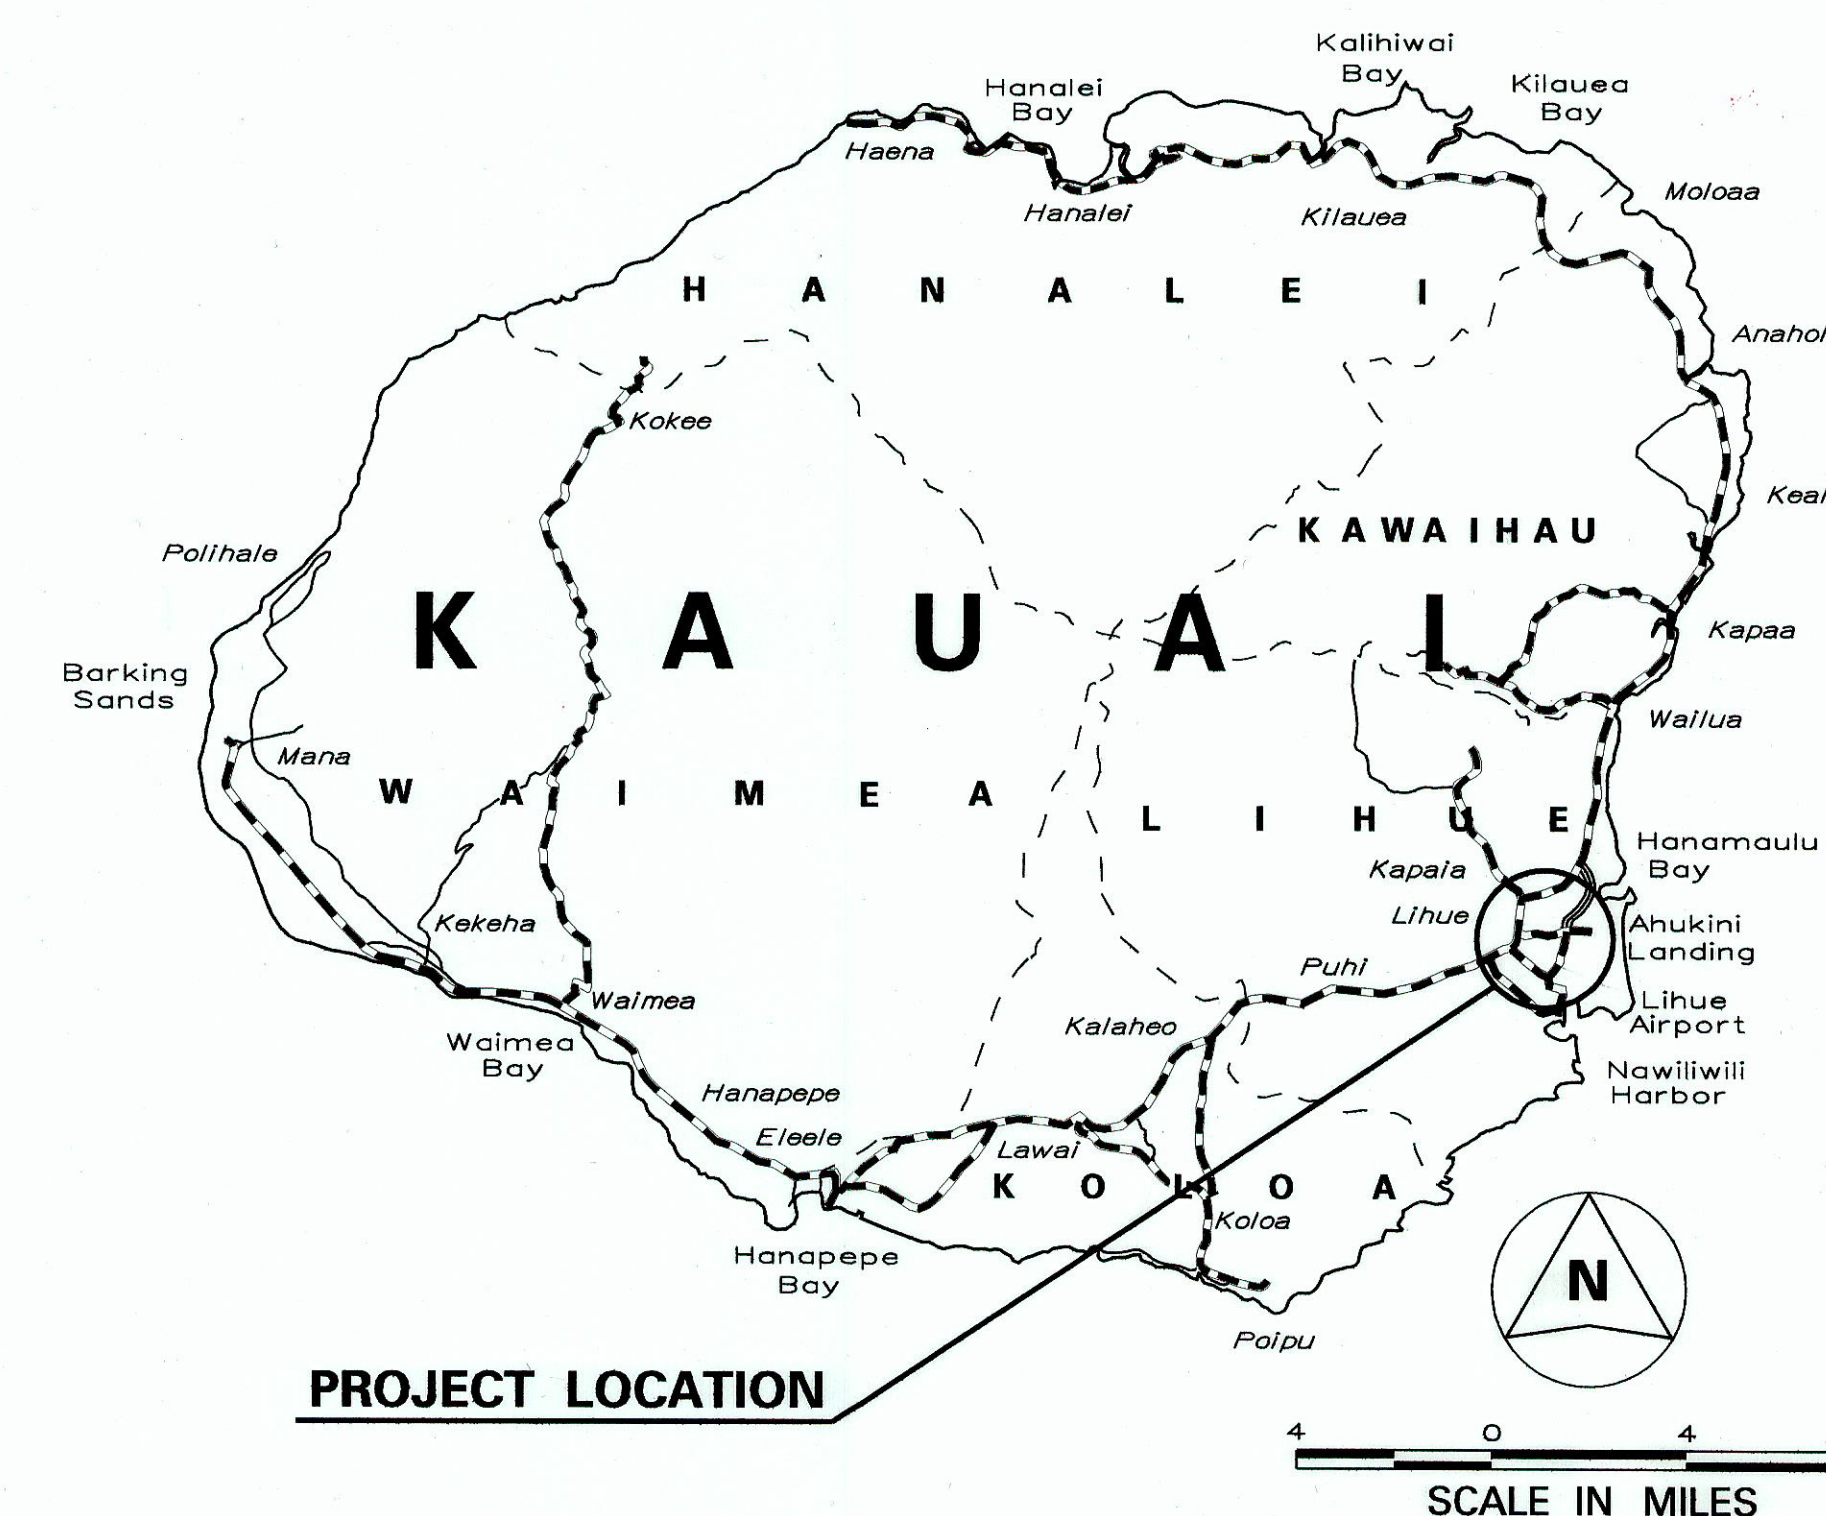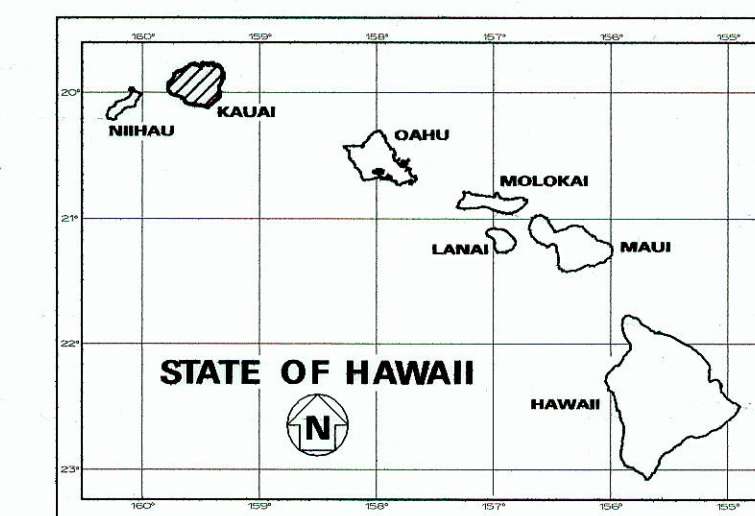

FEDERAL AID PROJECTS PREVIOUSLY CONSTRUCTED OR UNDER CONSTRUCTION

MILE POST 0.00 TO MILE POST 0.91

CHANGES MADE DURING CONSTRUCTION HAVE BEEN INCORPORATED ON THESE PLANS EXCEPT CHANGES IN THE ORIGINAL THEORETICAL QUANTITIES. FOR ACTUAL QUANTITIES, REFER TO PROJECT LEDGER AND/OR COMPUTATION BOOK.

*[Signature]* 6/28/16  
RESIDENT ENGINEER DATE

DEPARTMENT OF TRANSPORTATION  
STATE OF HAWAII

APPROVED:  
*[Signature]* 2/14/13  
DIR. OF TRANSPORTATION DATE

DESIGNED BY  
HWY-K

MANAGED BY  
HWY-KE

PHONE  
241-3000

DATE  
FEB. 2013

