




FED. ROAD DIST. NO.	STATE	PROJ. NO.	FISCAL YEAR	SHEET NO.	TOTAL SHEETS
HAWAII	HAW.	570A-01-IIMR	2013	6	18

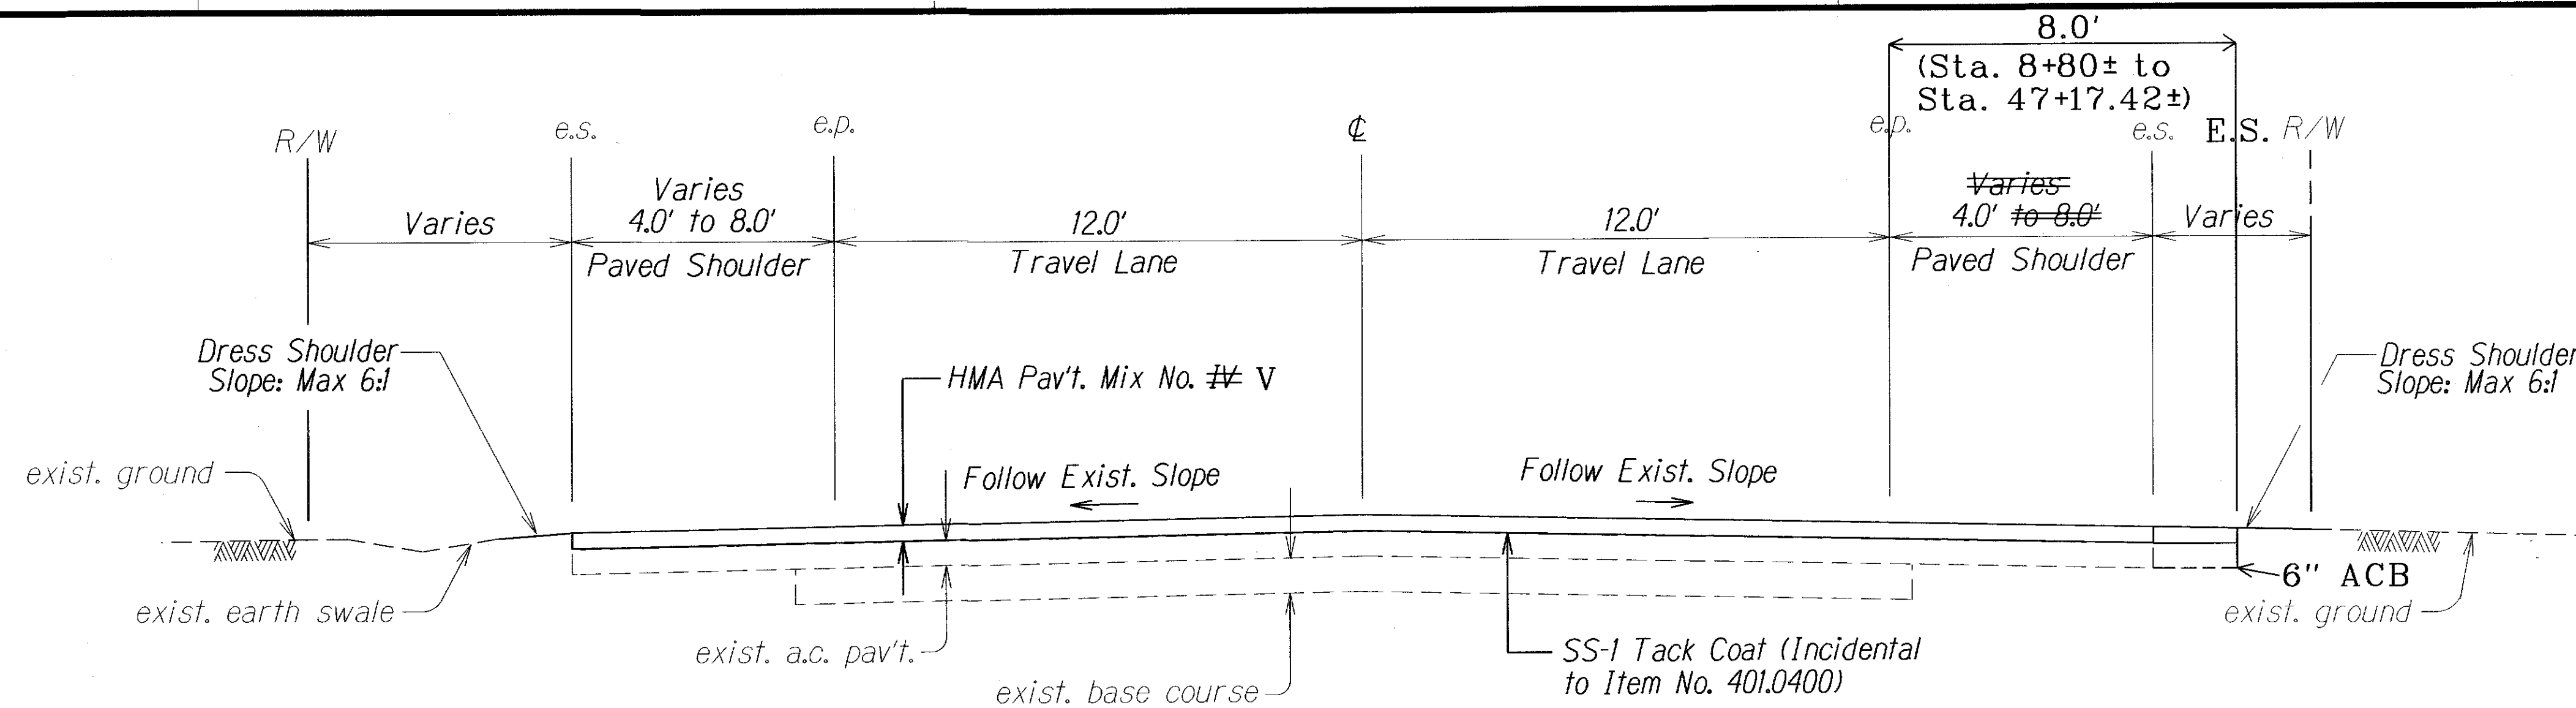

TYPICAL TANGENT SECTION

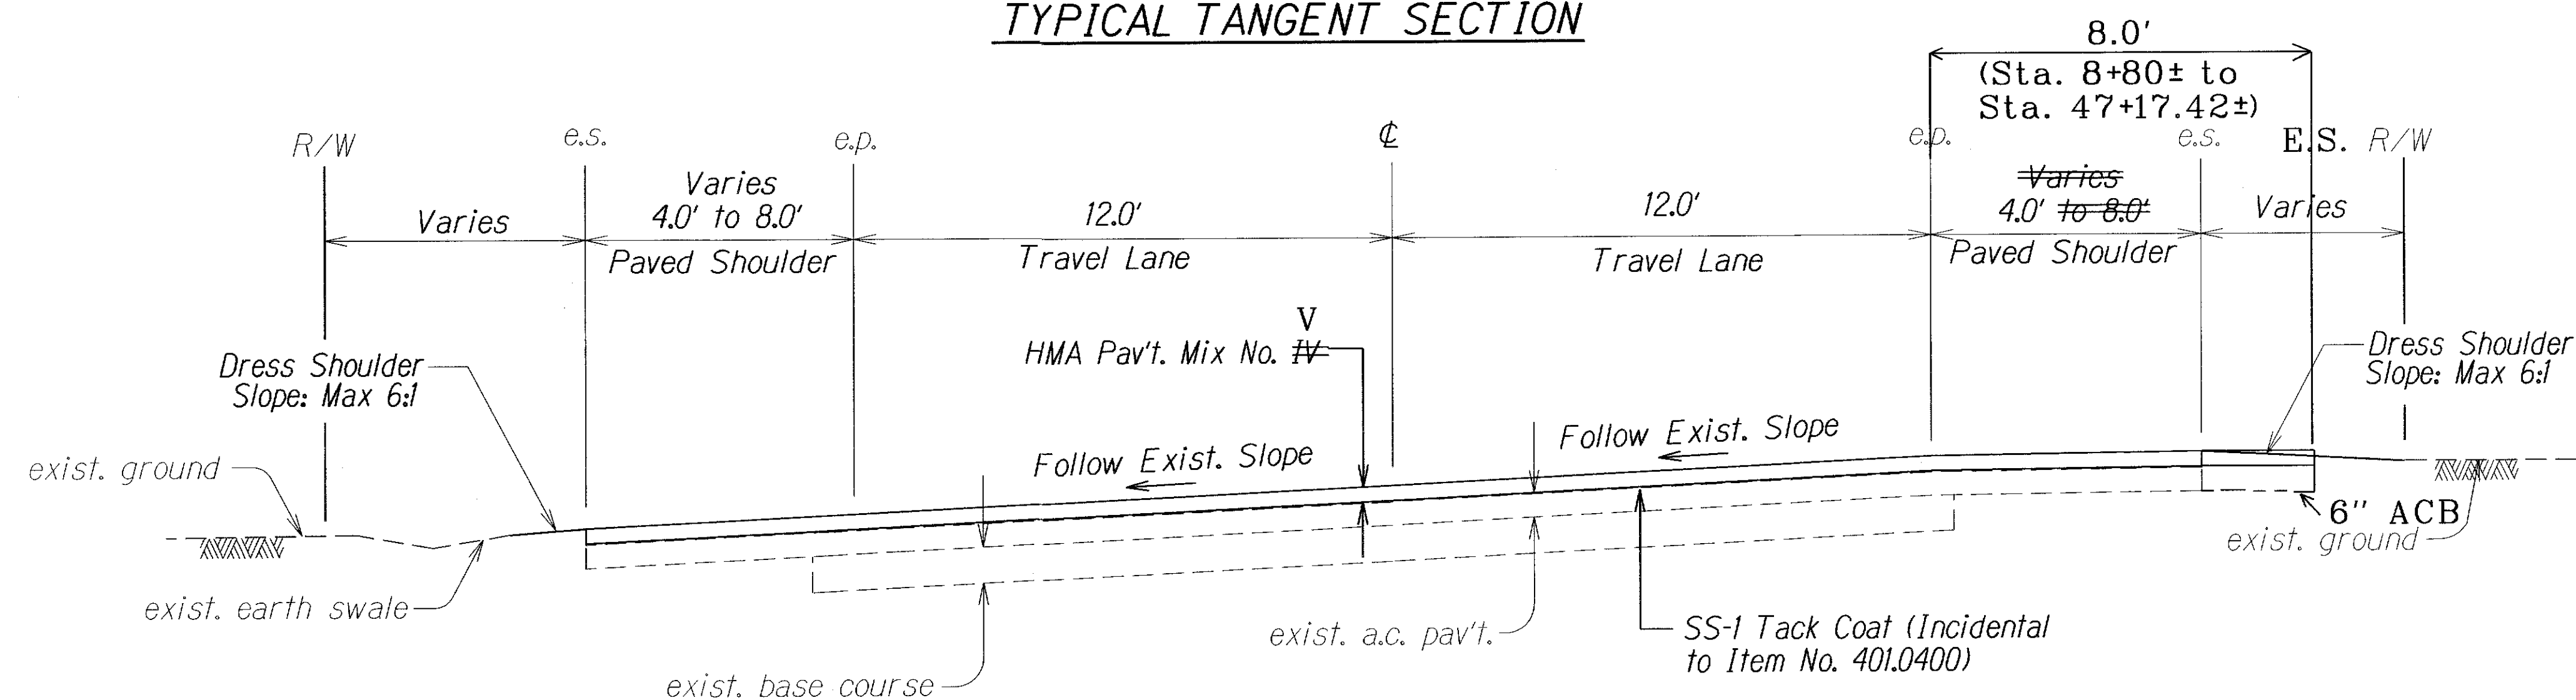

TYPICAL SUPERELEVATED SECTION

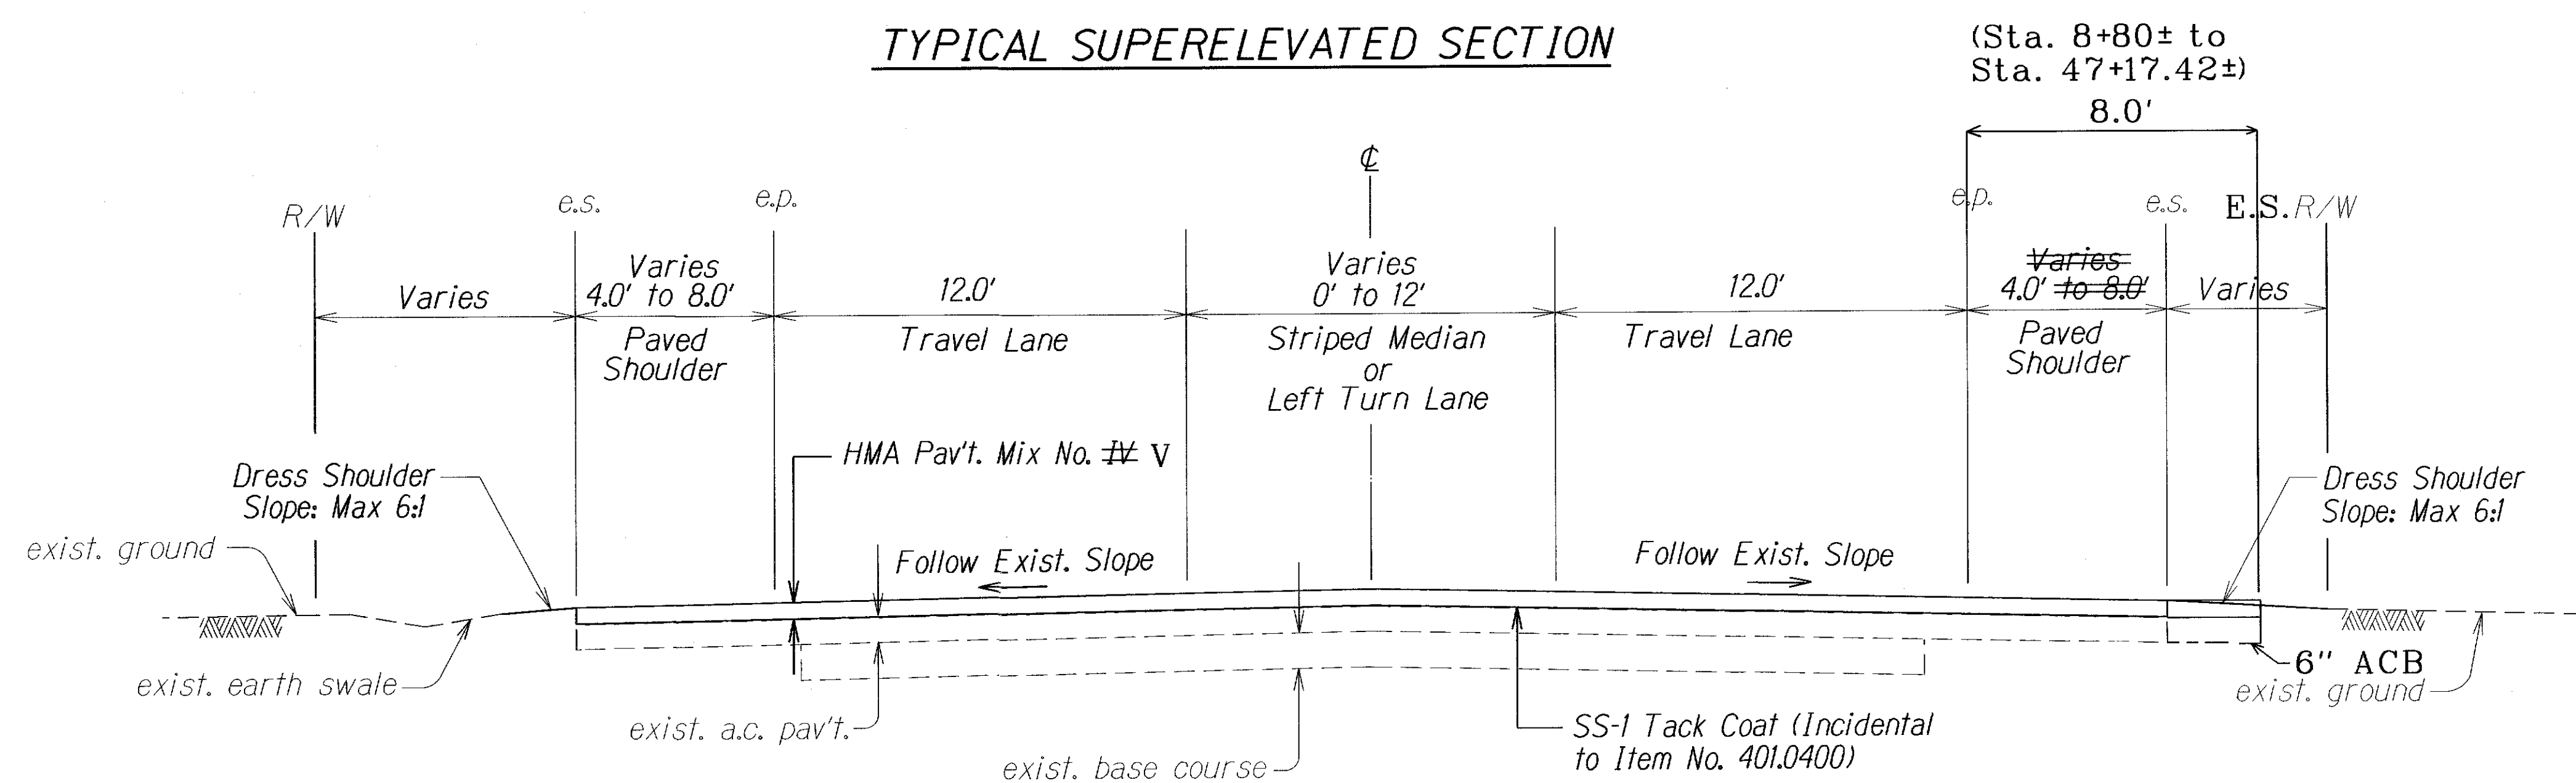

TYPICAL ROADWAY SECTION @ MULTIPLE LANE

LEGEND FOR AS-BUILT POSTINGS	
	Squiggly line for as-built deletion
	Double line for as-built deletion
Roadway	Text for as-built posting

STATE OF HAWAII
DEPARTMENT OF TRANSPORTATION
HIGHWAYS DIVISION

TYPICAL SECTIONS


AHUKINI ROAD RESURFACING
Kuhio Highway to Kapule Highway
Project No. 570A-01-IIMR

Not to Scale Date: Feb. 2013


SHEET No. 1 OF 3 SHEETS

"AS-BUILT"

FED. ROAD DIST. NO.	STATE	PROJ. NO.	FISCAL YEAR	SHEET NO.	TOTAL SHEETS
HAWAII	HAW.	570A-01-11MR	2013	ADD.7	18

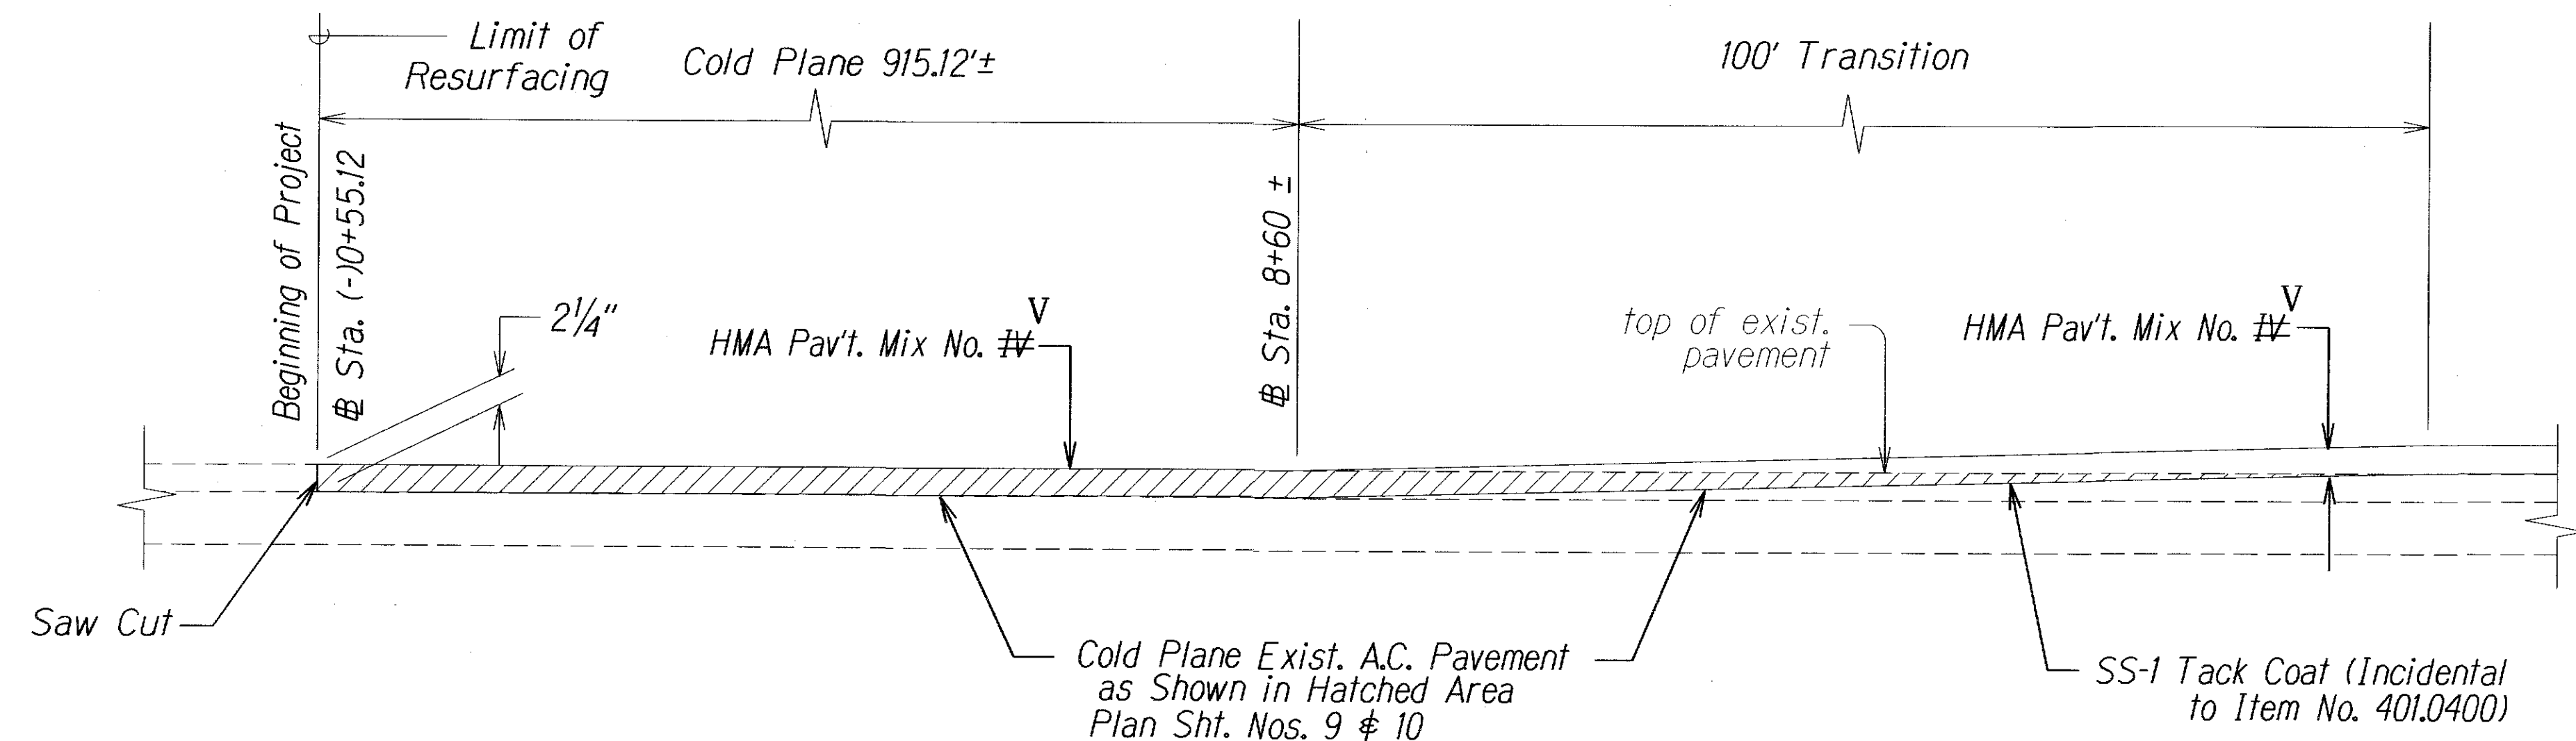


COLD PLANED TRANSITION TO EXISTING A.C. PAVEMENT AT THE BEGINNING OF PROJECT

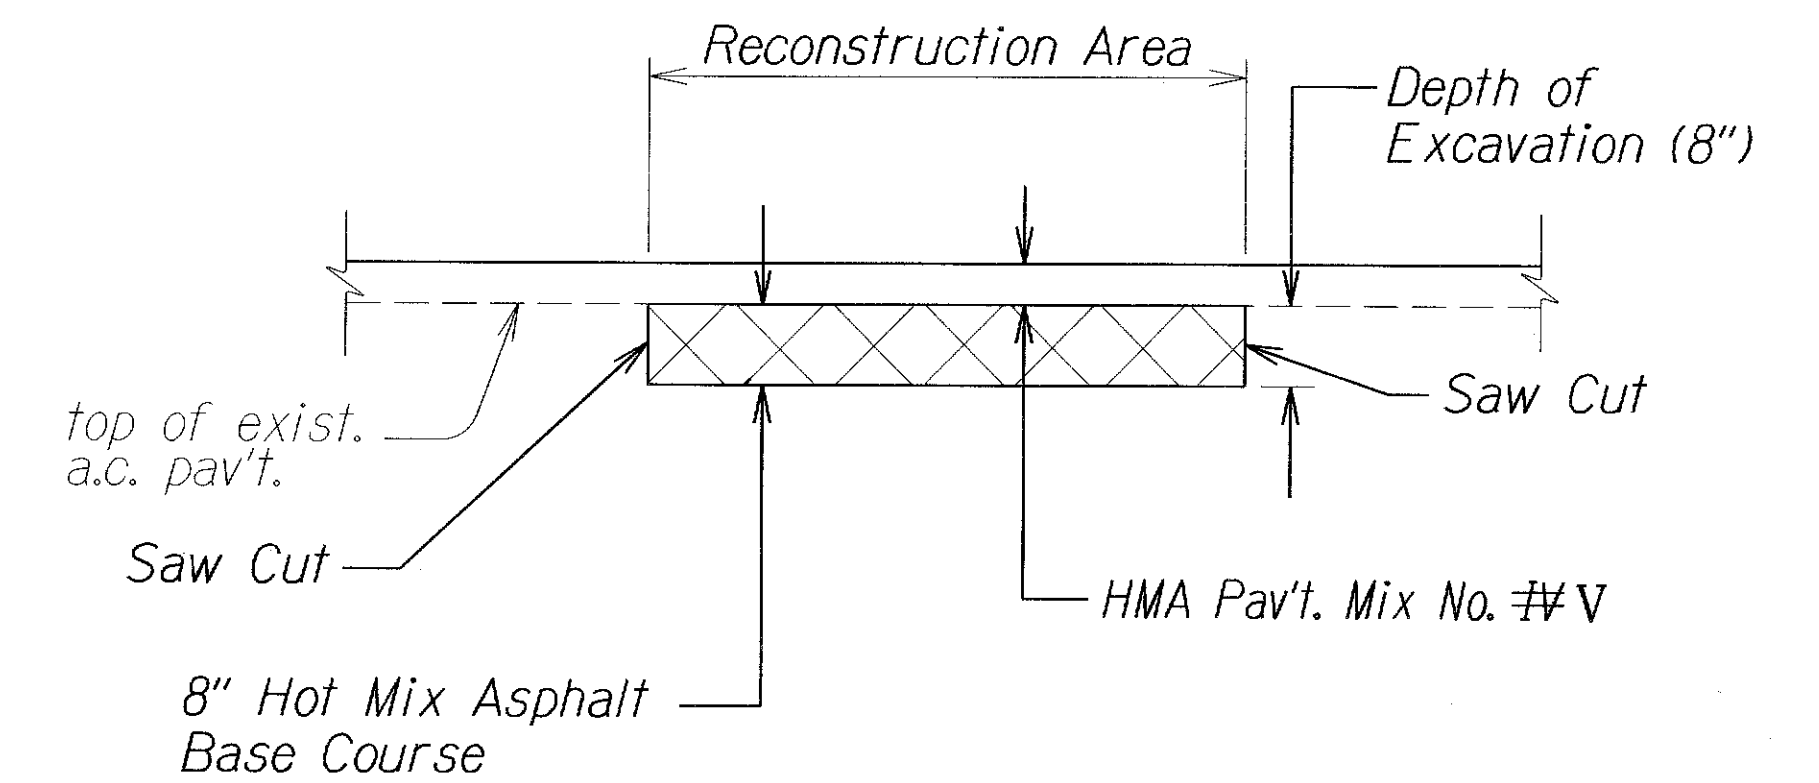


A.C. PAVEMENT RECONSTRUCTION DETAIL
Not to Scale


LEGEND FOR AS-BUILT POSTINGS	
	Squiggly line for as-built deletion
	Double line for as-built deletion
Roadway	Text for as-built posting

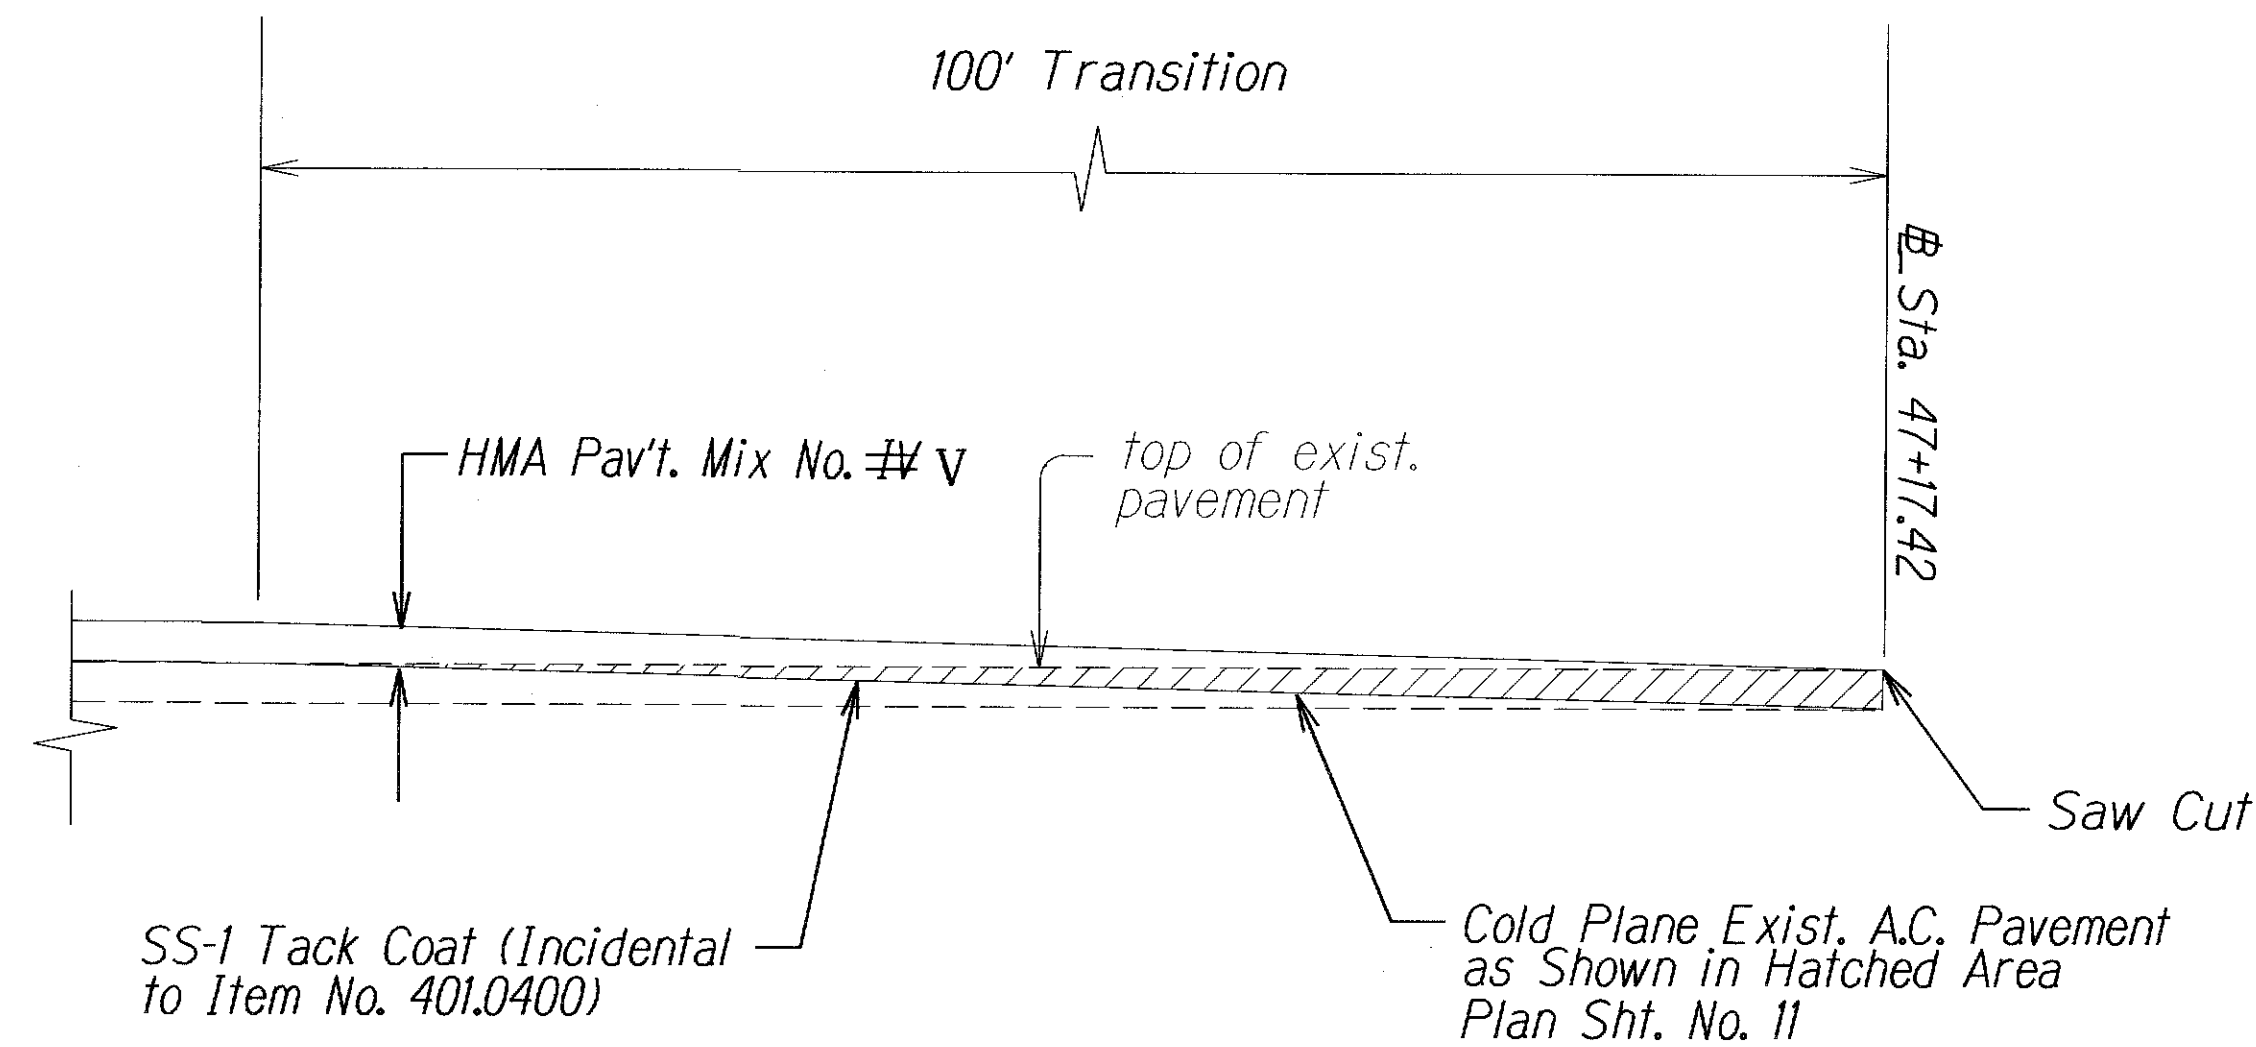

COLD PLANED TRANSITION TO EXISTING A.C. PAVEMENT AT THE END OF PROJECT

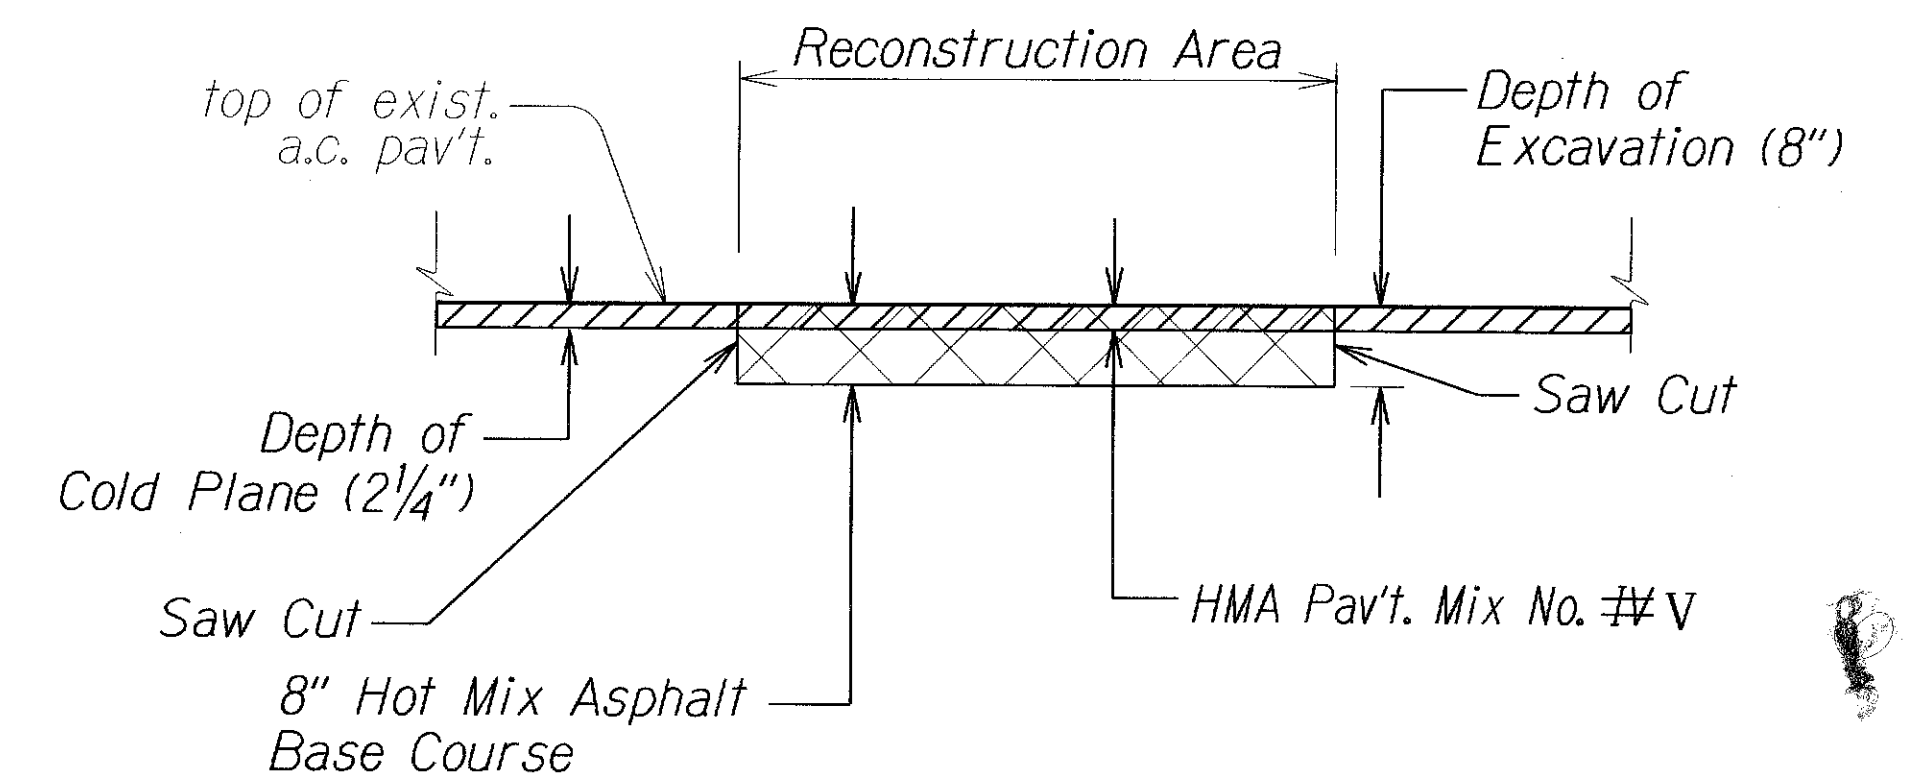

A.C. PAVEMENT RECONSTRUCTION DETAIL
@ COLD PLANED AREAS
Not to Scale

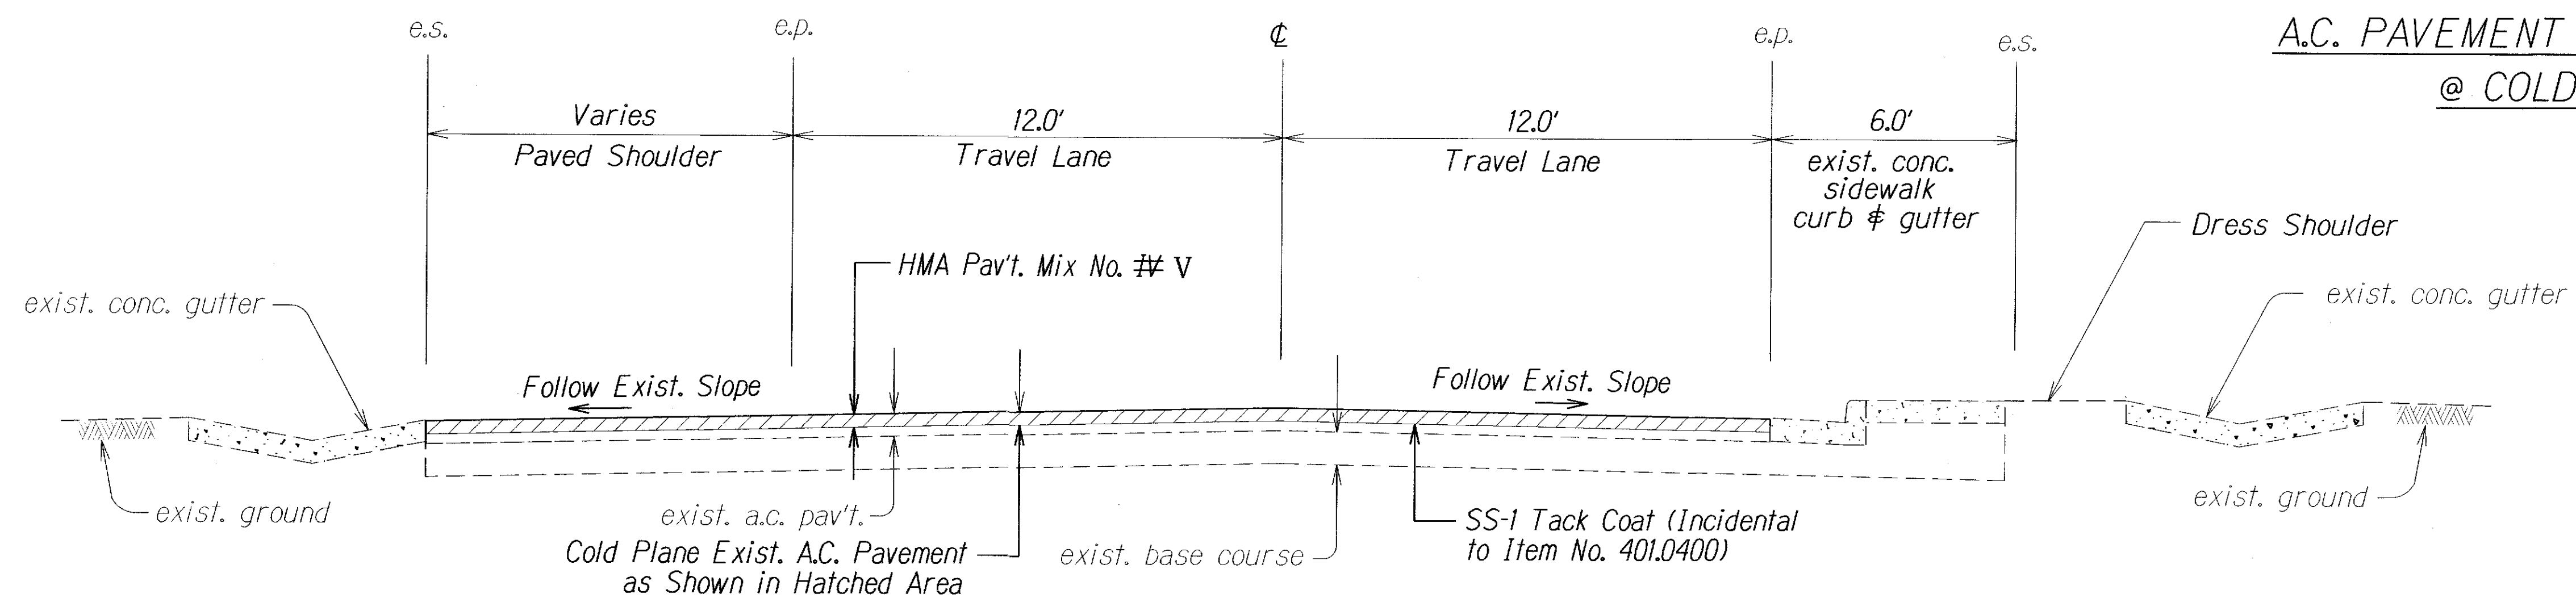


TYPICAL ROADWAY SECTION @ Sta. (-10+55.12 TO @ Sta. 8+60

DATE	04/16/13	Revise Typical Roadway Section
DATE		REVISION
STATE OF HAWAII		DEPARTMENT OF TRANSPORTATION
HIGHWAYS DIVISION		TYPICAL SECTIONS
AHUKINI ROAD RESURFACING		Kuhio Highway to Kapule Highway
Project No. 570A-01-11MR		Not to Scale
SHEET No. 2 OF 3 SHEETS		Date: April 2013


"AS-BUILT"

ADD.7


FED. ROAD DIST. NO.	STATE	PROJ. NO.	FISCAL YEAR	SHEET NO.	TOTAL SHEETS
HAWAII	HAW.	570A-01-11MR	2013	8	18

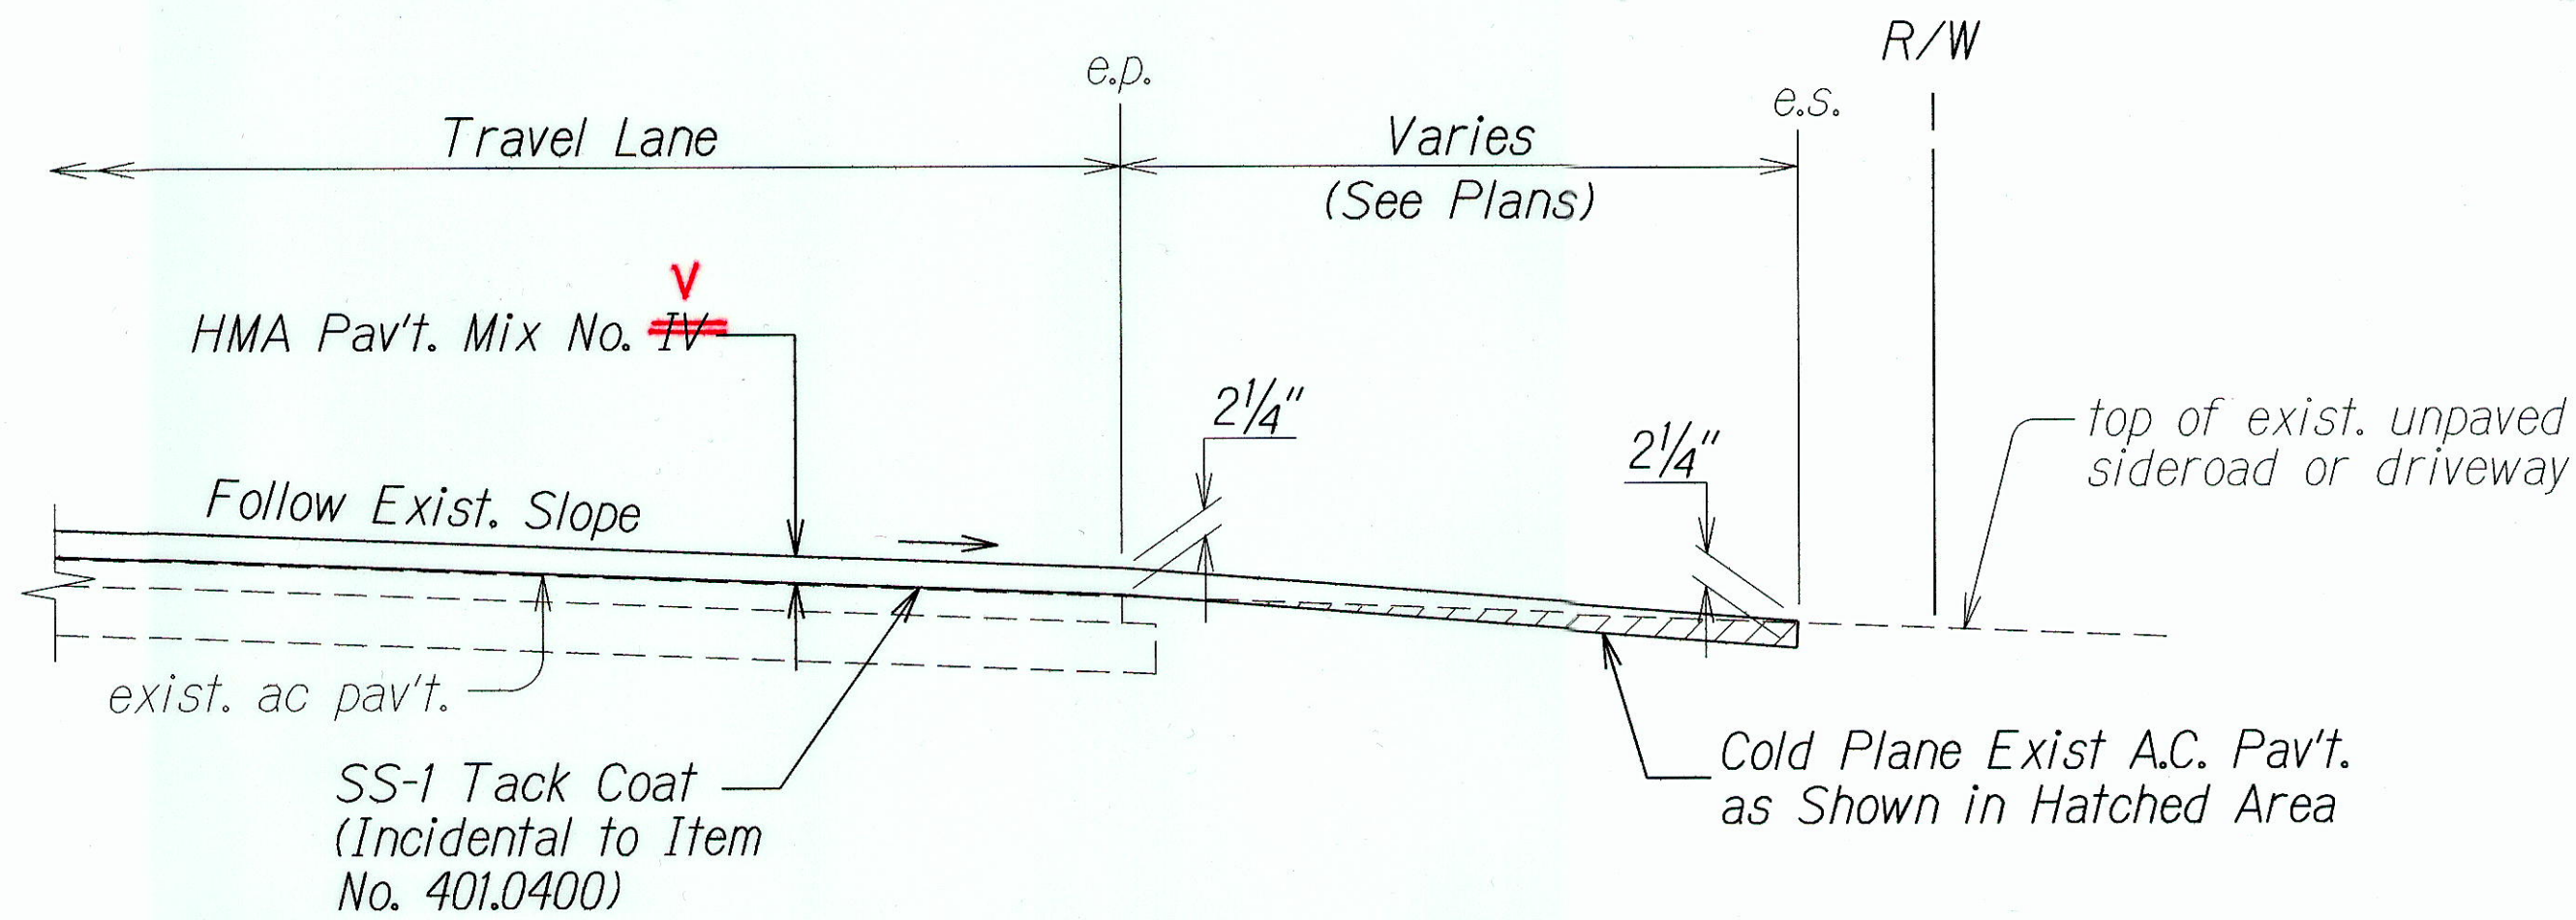

RESURFACING AT PAVED SIDEROADS & DRIVEWAYS
Not to Scale

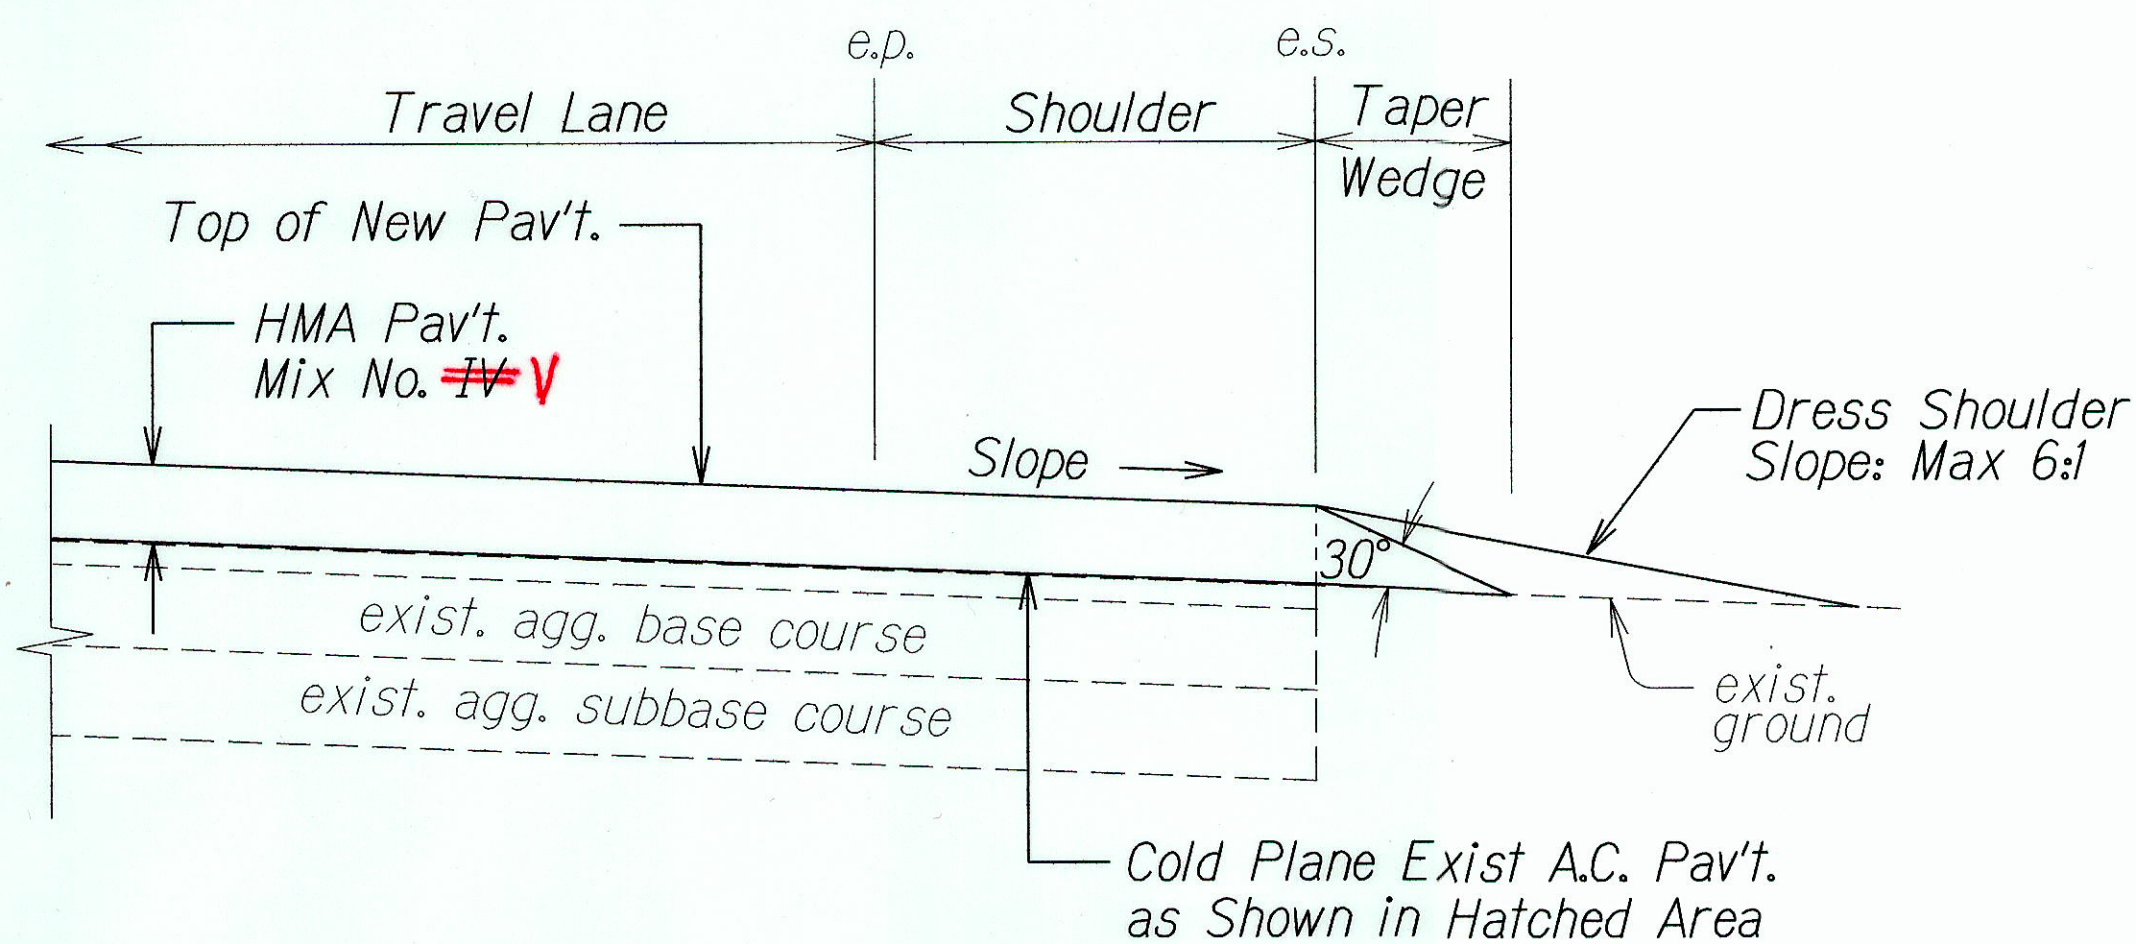


Typical Pavement Edge Detail (Cold Planed Areas)
Not to Scale

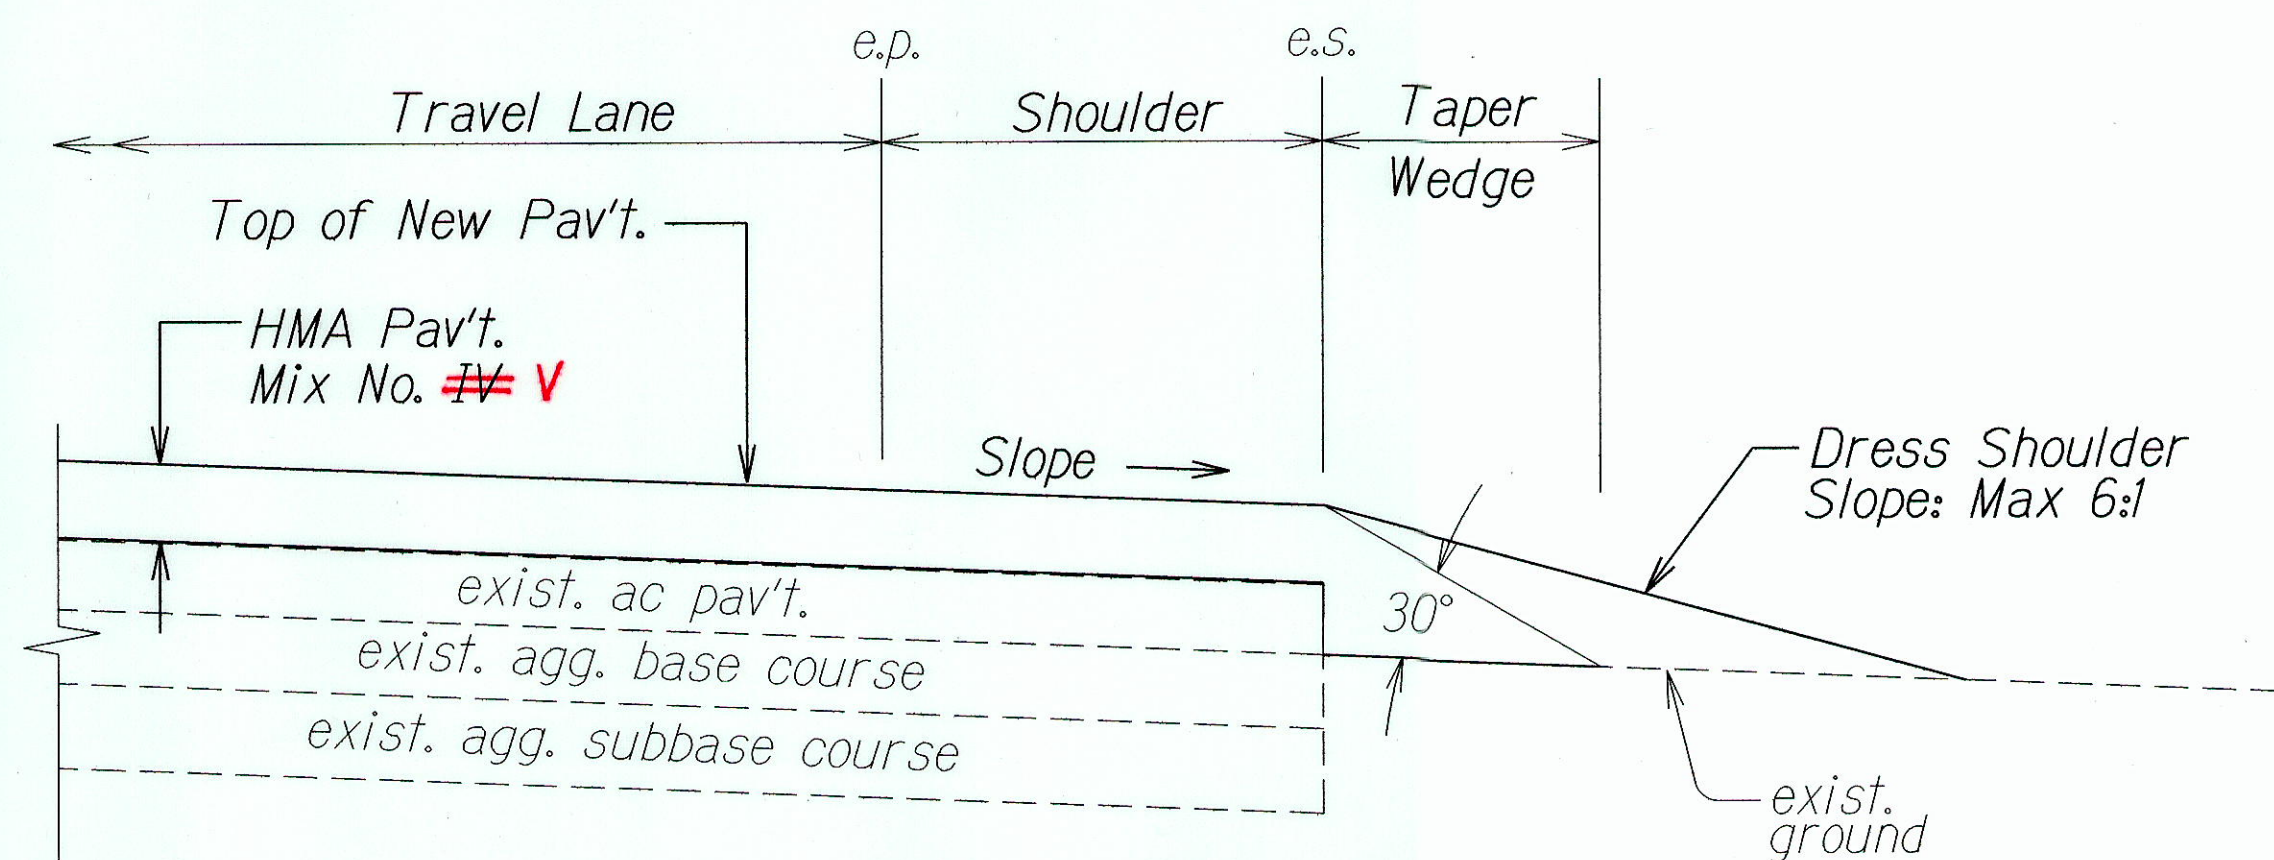


Typical Pavement Edge Detail (Asphalt Overlay Areas)
Not to Scale

Note: Contractor shall mount a device directly on the paver screed extension to provide a 30° beveled shoulder edge.

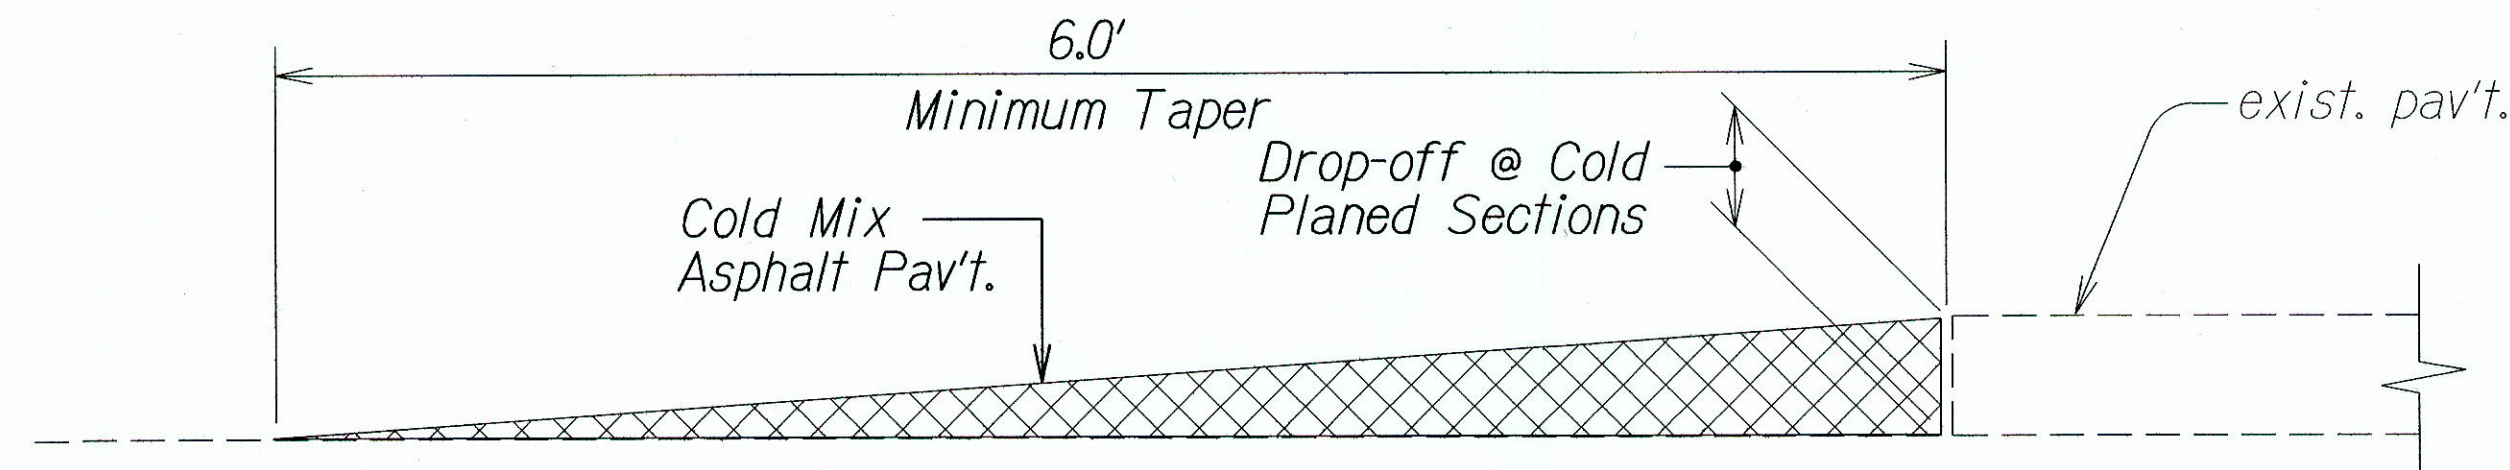

TEMPORARY TRANSITION AT COLD PLANED AREAS
Not to Scale

Note: Contractor shall construct temporary pavement taper to prevent sharp pavement drop-offs at all cold planed sections. Prior to final Asphalt Pavement placement, temporary pavement taper shall be removed.

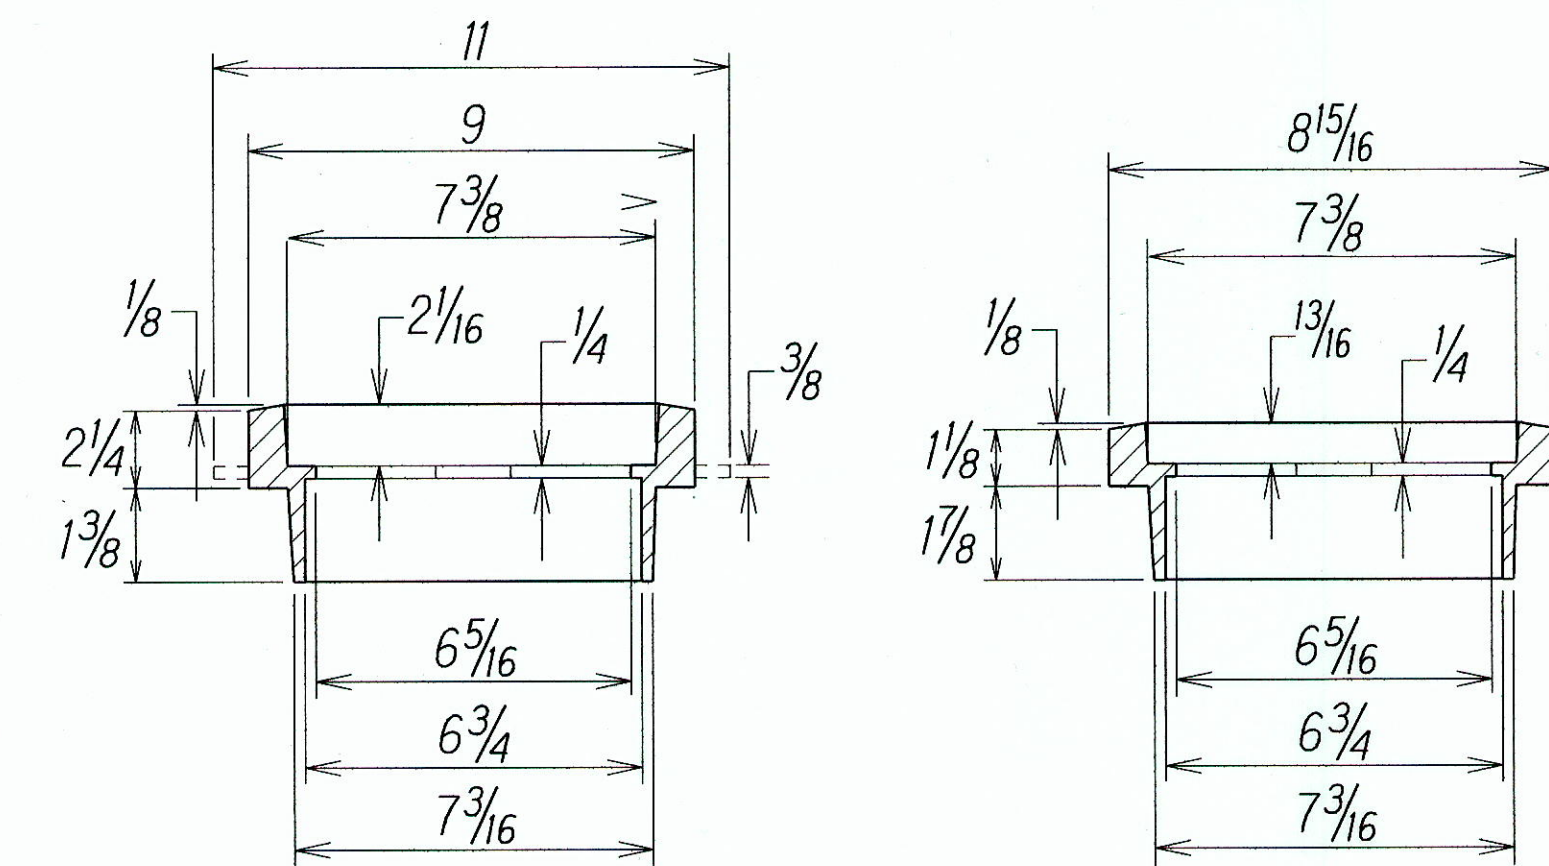

5 1/4" x 2 1/4" Riser
(Uses Standard 5 1/4" Drop Lid)

5 1/4" x 1 1/8" Riser
(Requires 1 1/8" Riser Lid)

RISERS			
Item/Description	UPCode	Height Increase	Weight
5 1/4x 1 1/8 Slip-In*	145554	1 1/8"	8
5 1/4x 2 1/4 Slip-In	145547	2 1/4"	14

*Use with 1 1/8" Lid only

FIXED CAST IRON RISER FOR ALL 5-1/4" SHAFT VALVE BOXES
Not to Scale

APPROVED:

for *[Signature]*
Manager & Chief Engineer
Department of Water

2/22/13
Date

STATE OF HAWAII
DEPARTMENT OF TRANSPORTATION
HIGHWAYS DIVISION
TYPICAL SECTIONS
AHUKINI ROAD RESURFACING
Kuhio Highway to Kapule Highway
Project No. 570A-01-11MR
Not to Scale
Date: Feb. 2013
SHEET No. 3 OF 3 SHEETS

8