

INDEX TO DRAWINGS	
SHEET NO.	DESCRIPTION
1	Title Sheet
2-4	Typical Sections
5-8	Plan and Profile
9	Junction Detail
10-13	Drainage Plans Waterline Plans
14	Waterline Standard Details
15	Irrigation and Drainage Summary
16-21	Siphon and Irrigation Details
22	Manhole and C.D.I. Details
23-25	Standard Details - Highway
26-28	Standard Details - Traffic
29-47	Cross Sections

CONVENTIONAL SIGNS	
Baseline	
Boundary Line	
Fences (Named)	
Existing Roadway	
Pipe Culvert	
Box Culvert	
Telephone Line & Pole	
Electric Line & Pole	
Water Main	

STATE OF HAWAII

DEPARTMENT OF TRANSPORTATION

HIGHWAYS DIVISION

"AS BUILT" PLANS OF


AHUKINI ROAD

FEDERAL AID SECONDARY PROJECT NO. S-0570 (I)

DISTRICT OF LIHUE


ISLAND OF KAUAI

SCALES	
PLAN	1 INCH = 100 FT.
PROFILE	HOR. 1 INCH = 100 FT.
	VER. 1 INCH = 10 FT.
CROSS SECTION	HOR. 1 INCH = 10 FT.
	VER. 1 INCH = 10 FT.

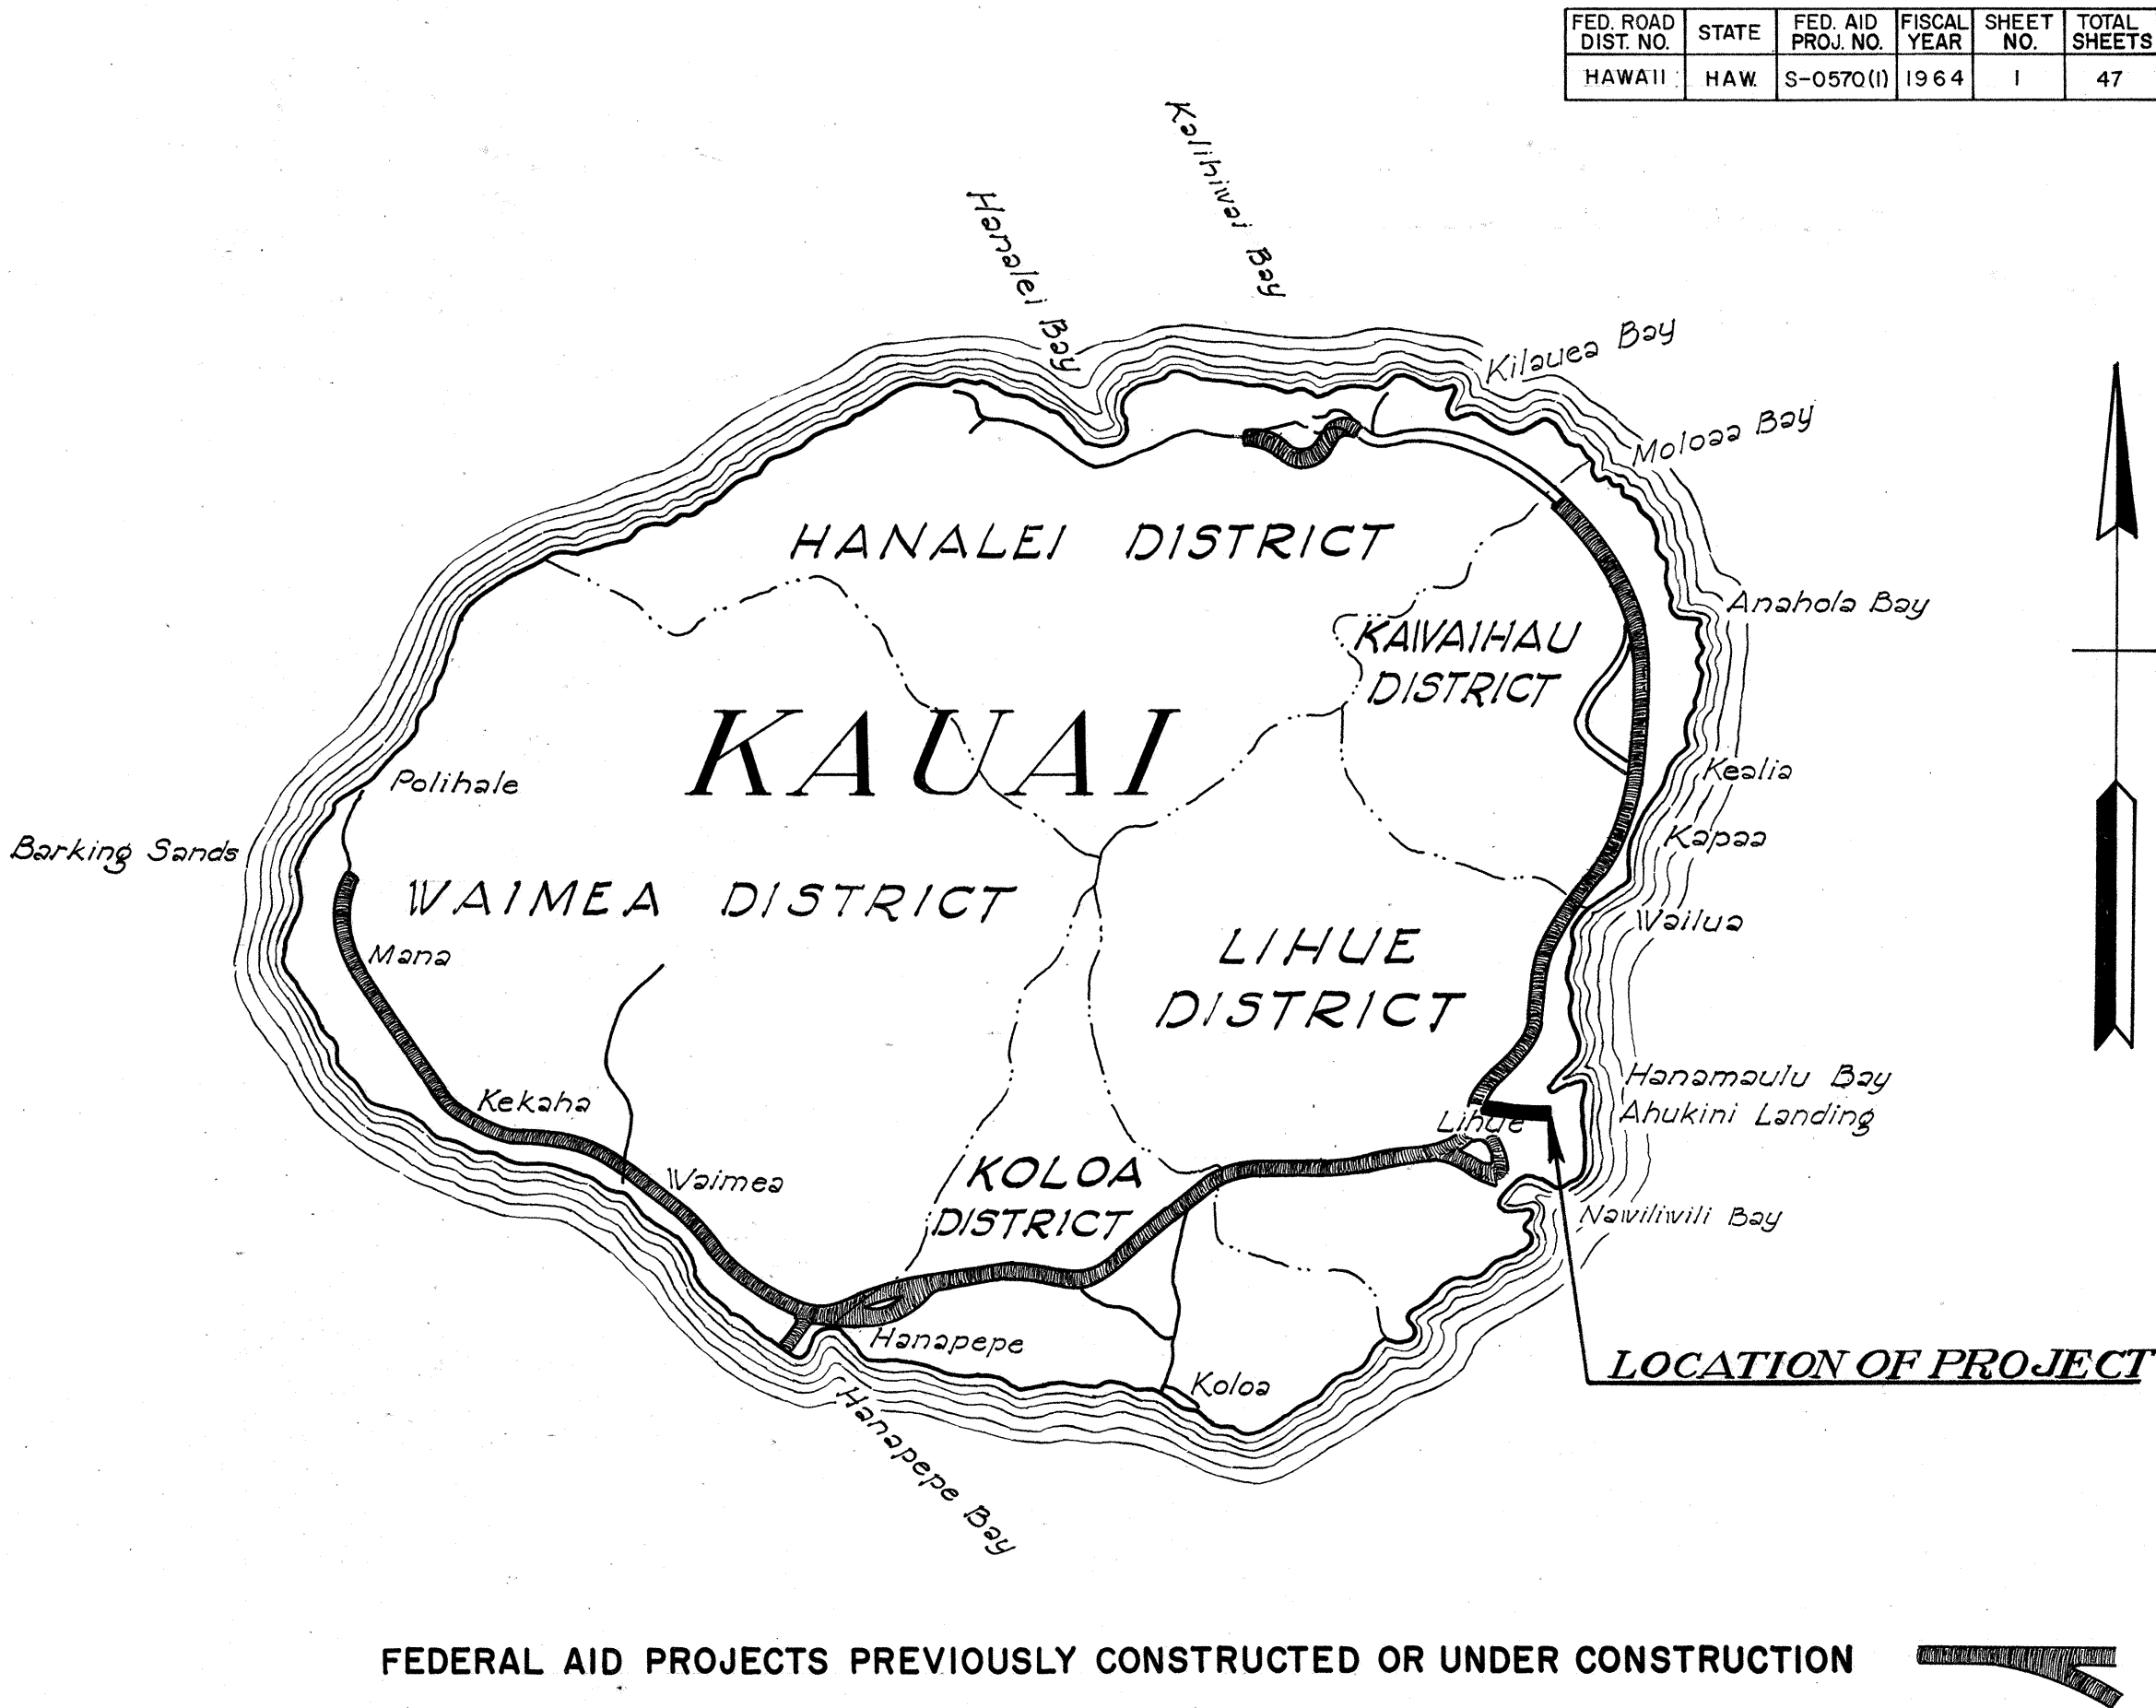

NOTE:
ALL CHANGES MADE DURING CONSTRUCTION HAVE BEEN NOTED IN RED ON THESE TRACINGS AND CHECKED BY:

Shigeto Yamauchi
PROJECT ENGINEER
April 13, 1967
DATE

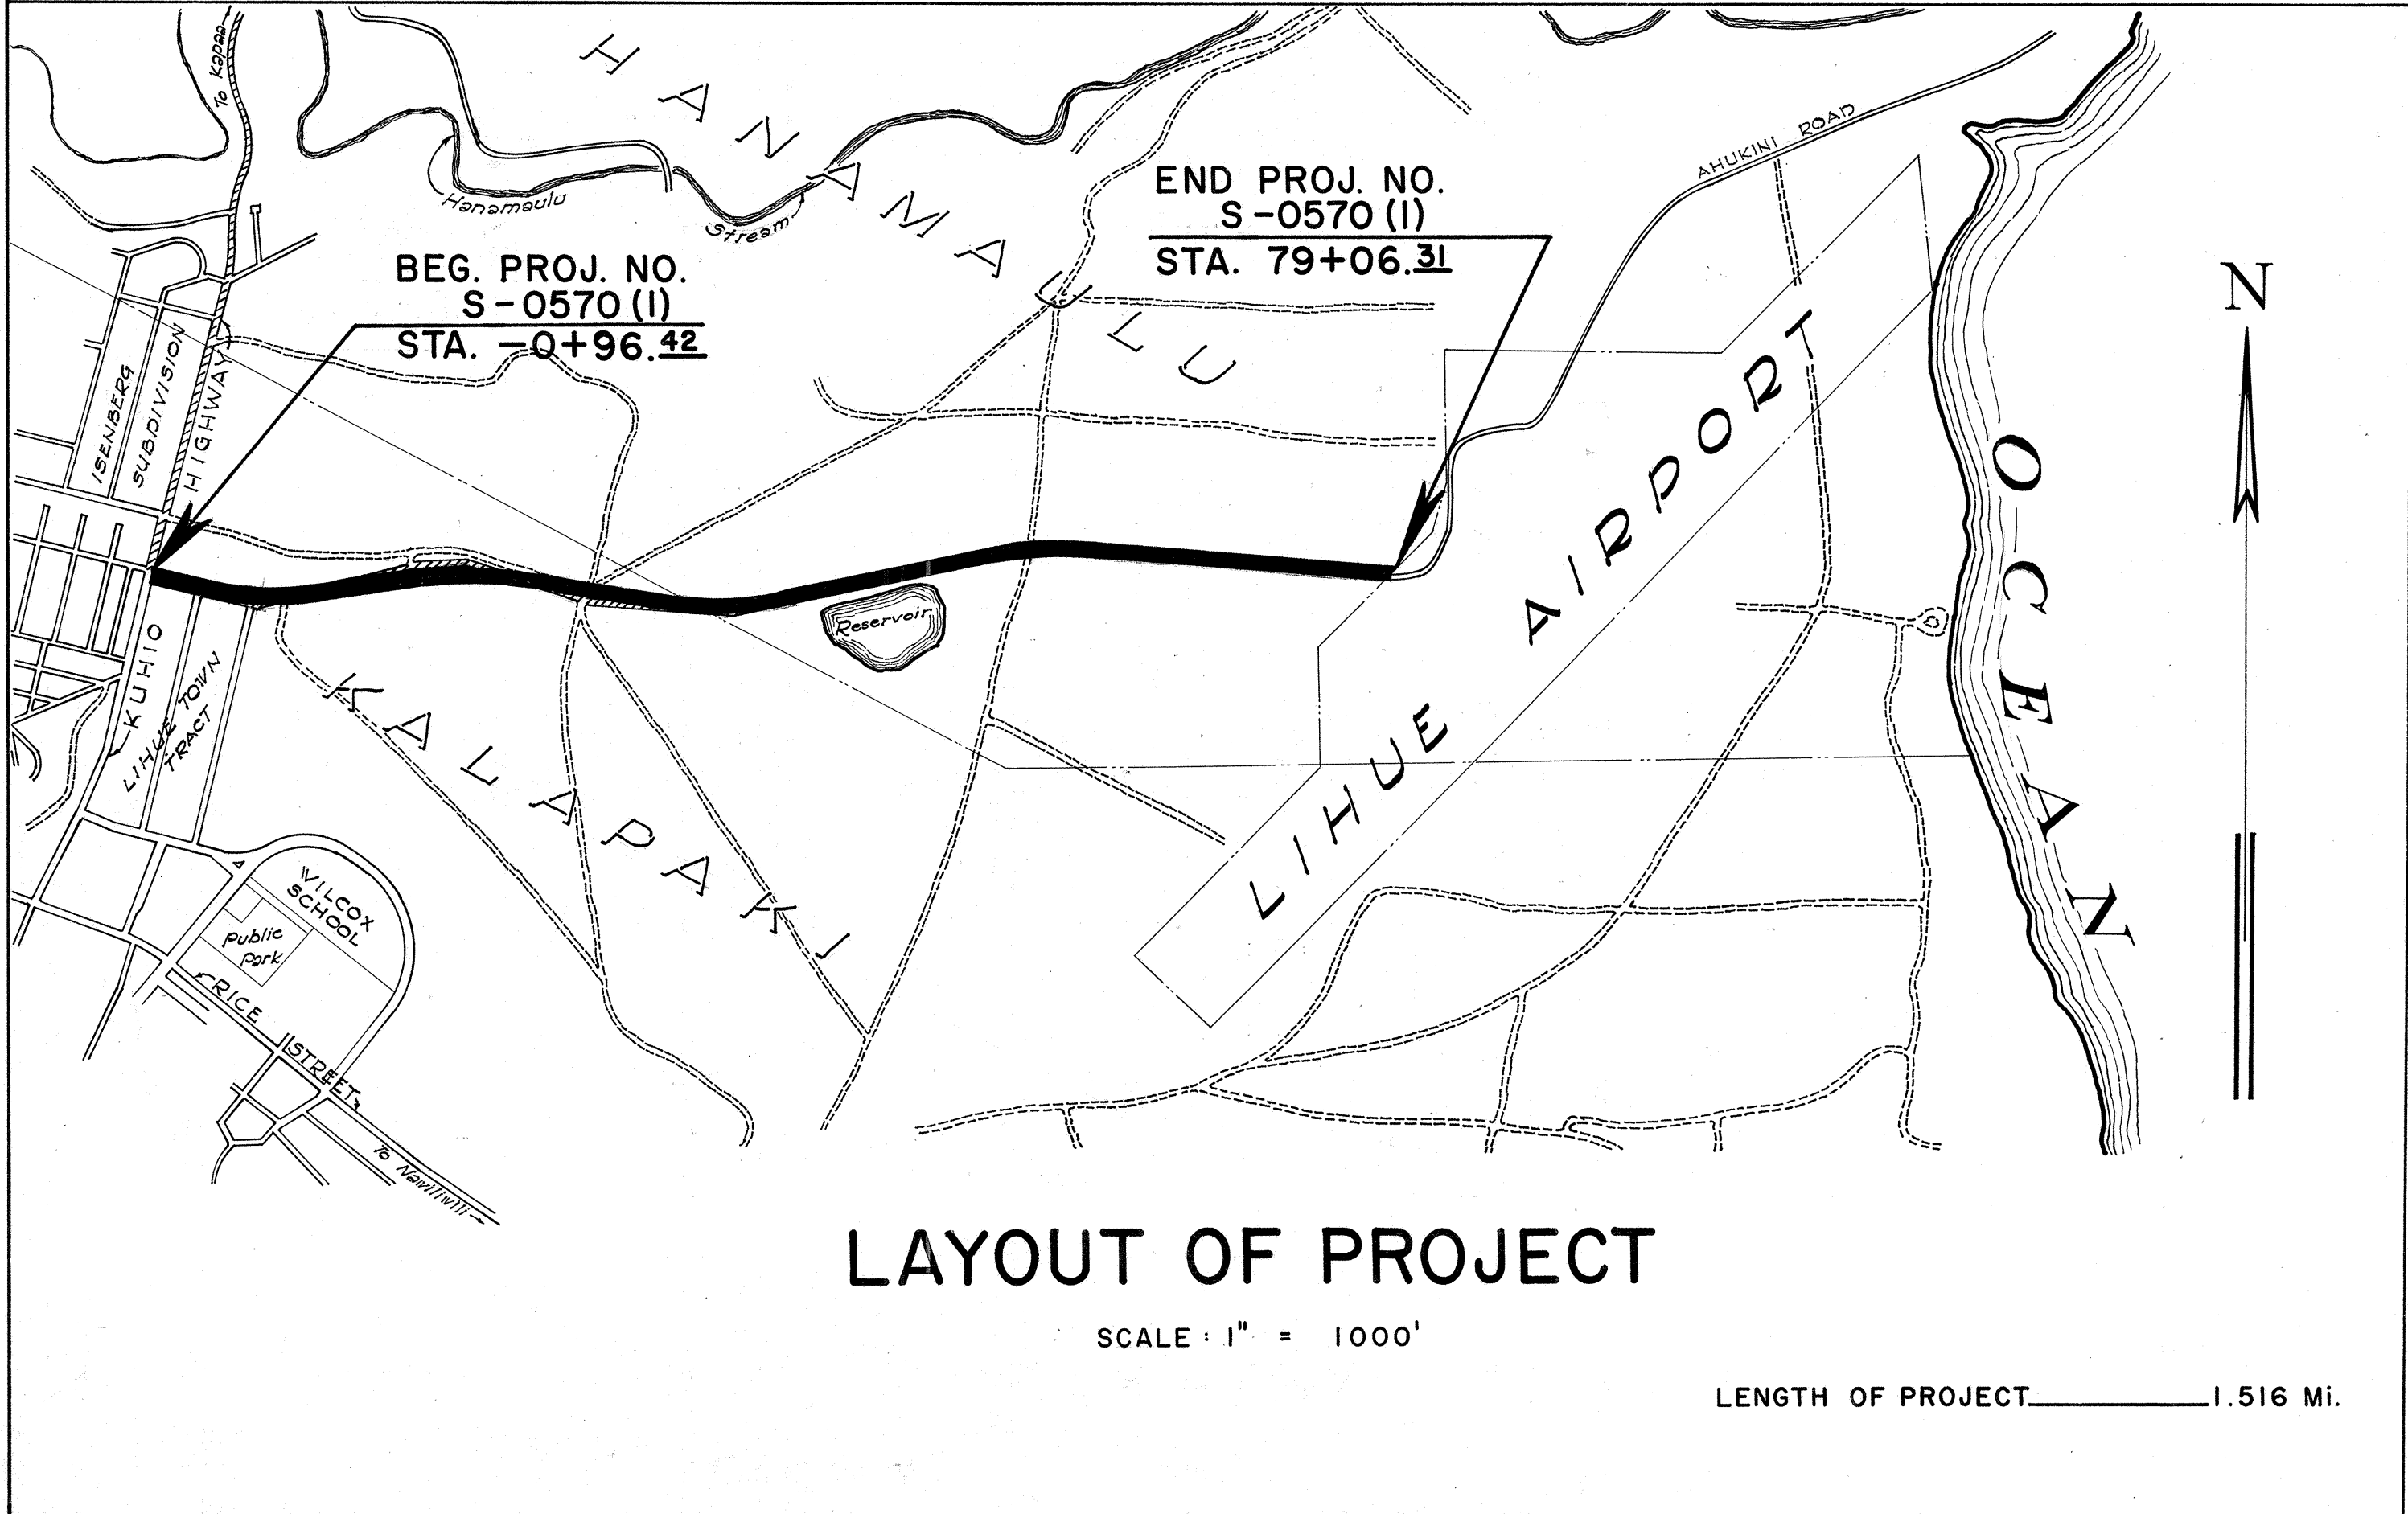

DESIGN CLASSIFICATION	
ADT (1962)	1968
ADT (1982)	7300
DHV	11%
D	60/40
T	3%
V	50mph.

APPROVED: *Kaipo F. Kauba*
Acting DIRECTOR OF TRANSPORTATION

DATE 12-8-63

DEPARTMENT OF COMMERCE
BUREAU OF PUBLIC ROADS

APPROVED: _____
DIVISION ENGINEER

DATE _____