

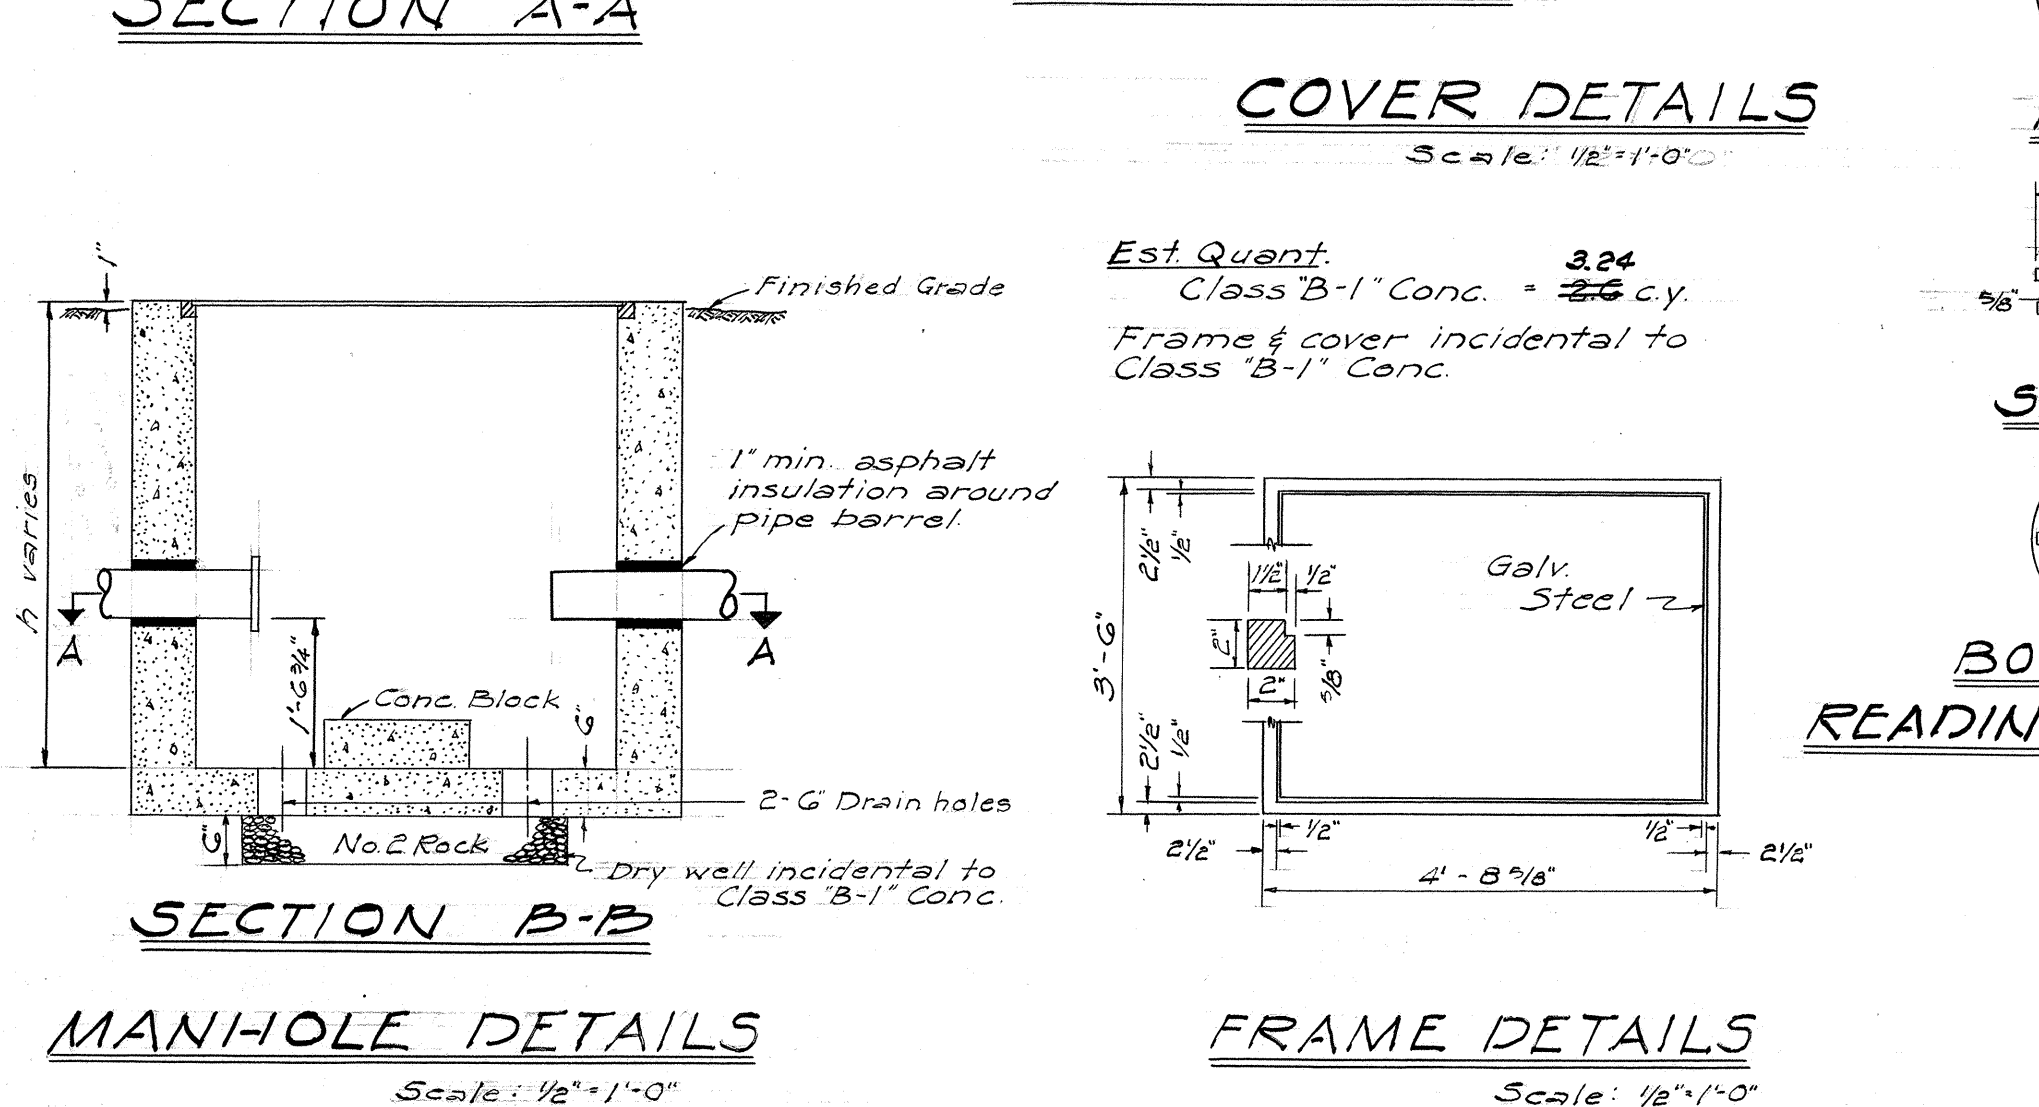


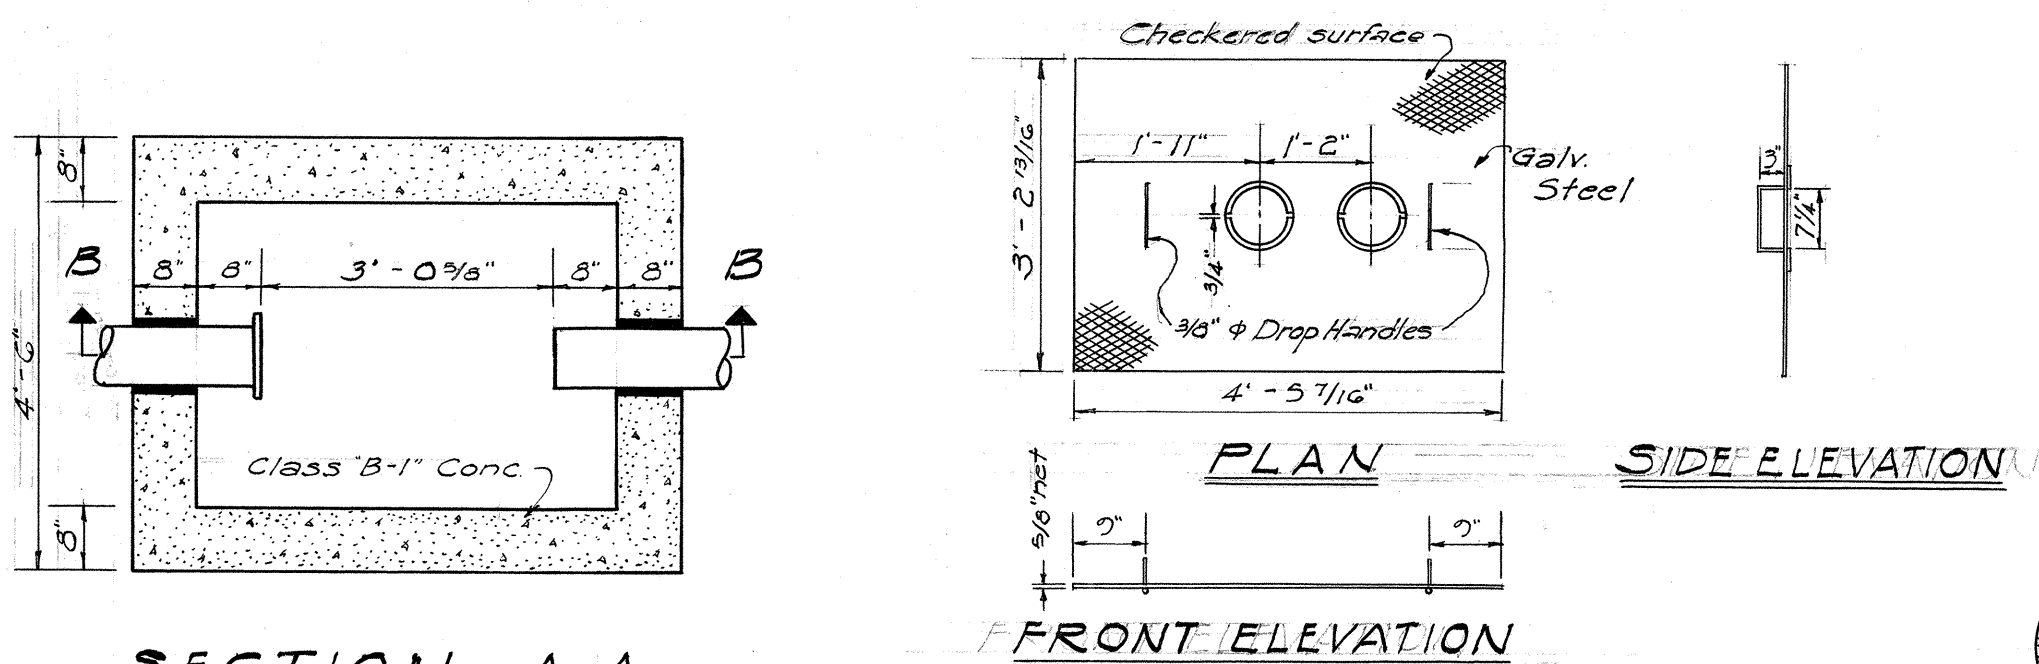

### DETAILS OF MANHOLE FOR TRIDENT METER



STA. 37+18.5  
Scale: As shown

Note: For underground telephone & electrical service line locations see sheet no. 9.

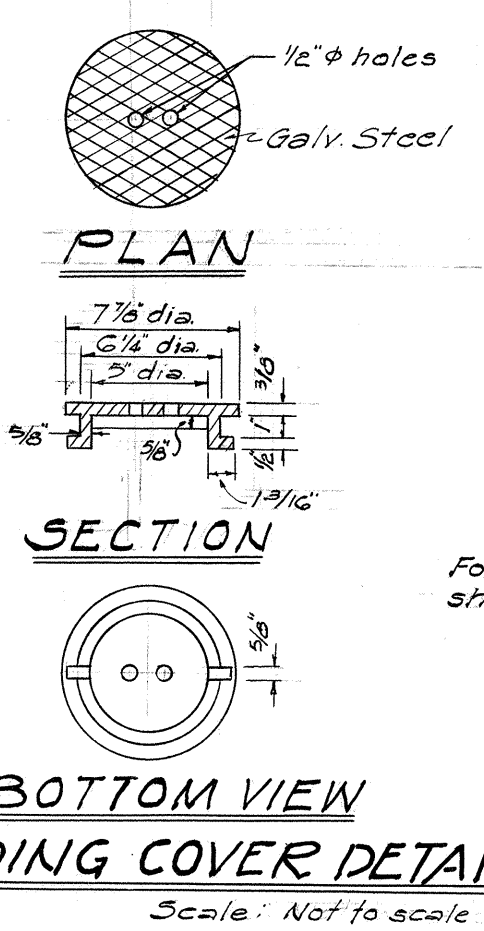



READING COVER DETAILS  
Scale: Not to scale

Sta. -0+70 to 12+00  
Existing 6" pipeline located along Ahukini Road shall be removed. This work shall be considered incidental to Roadway Exc. & shall not be paid for separately.

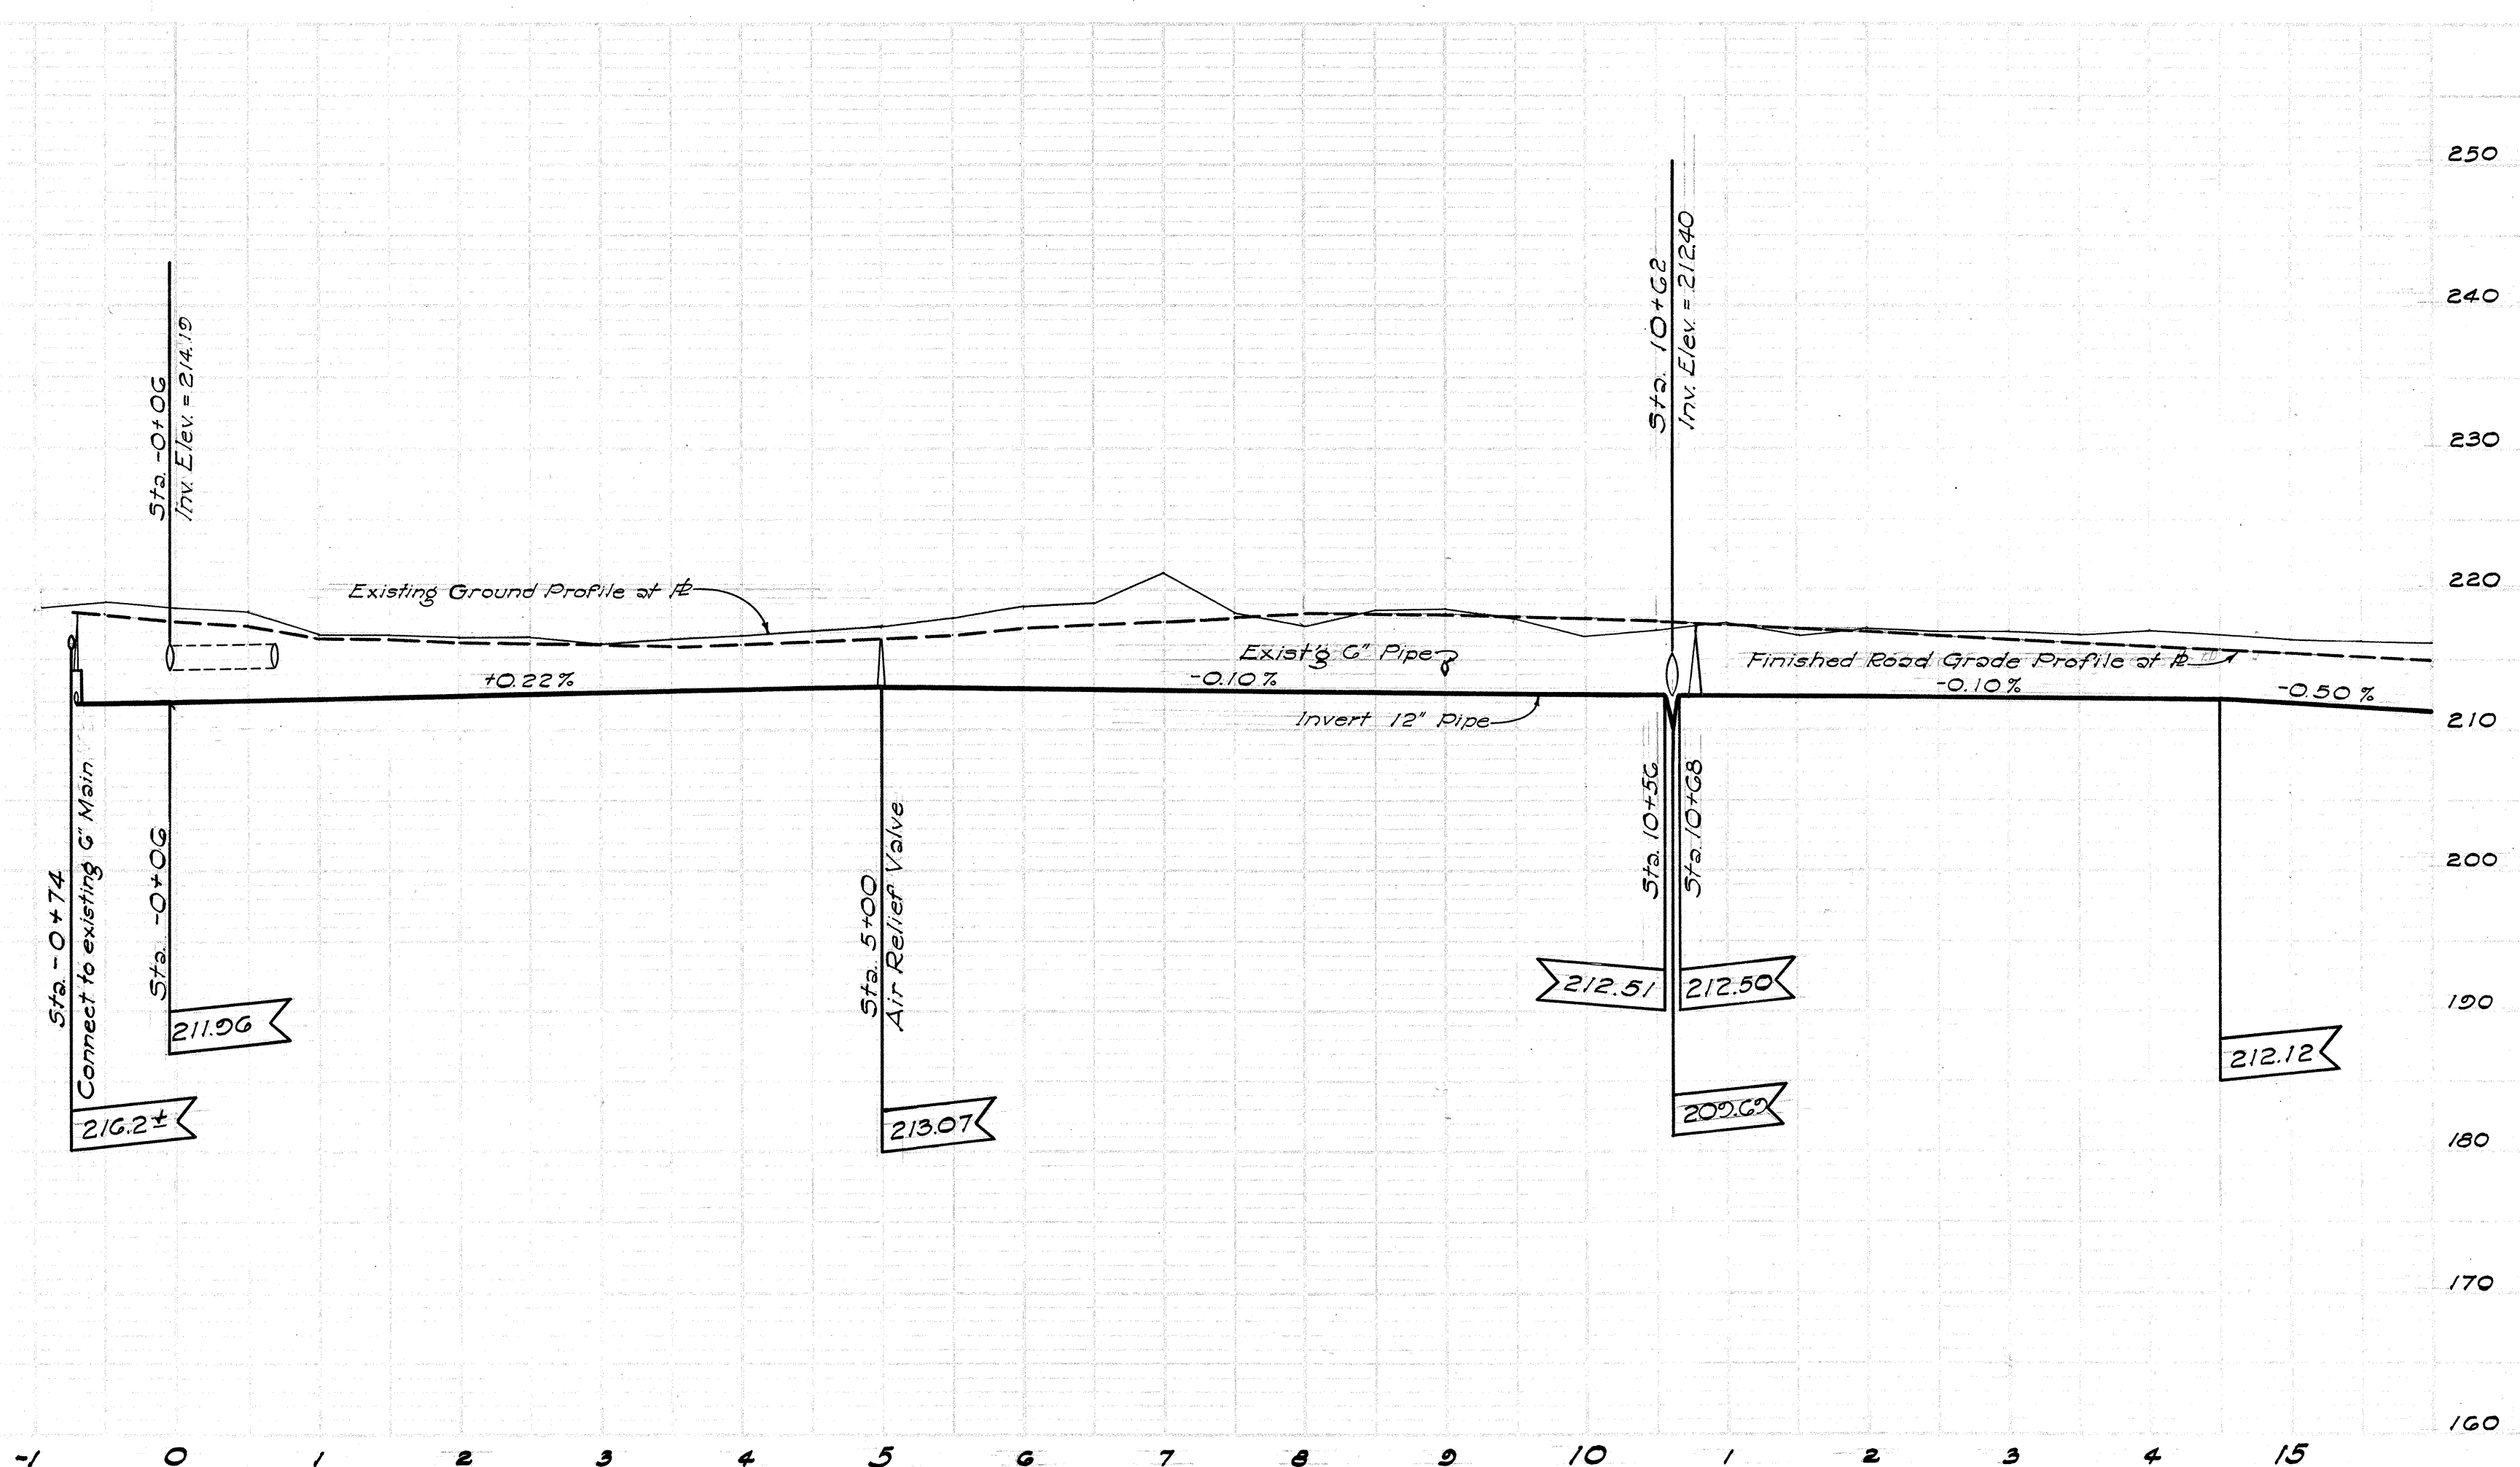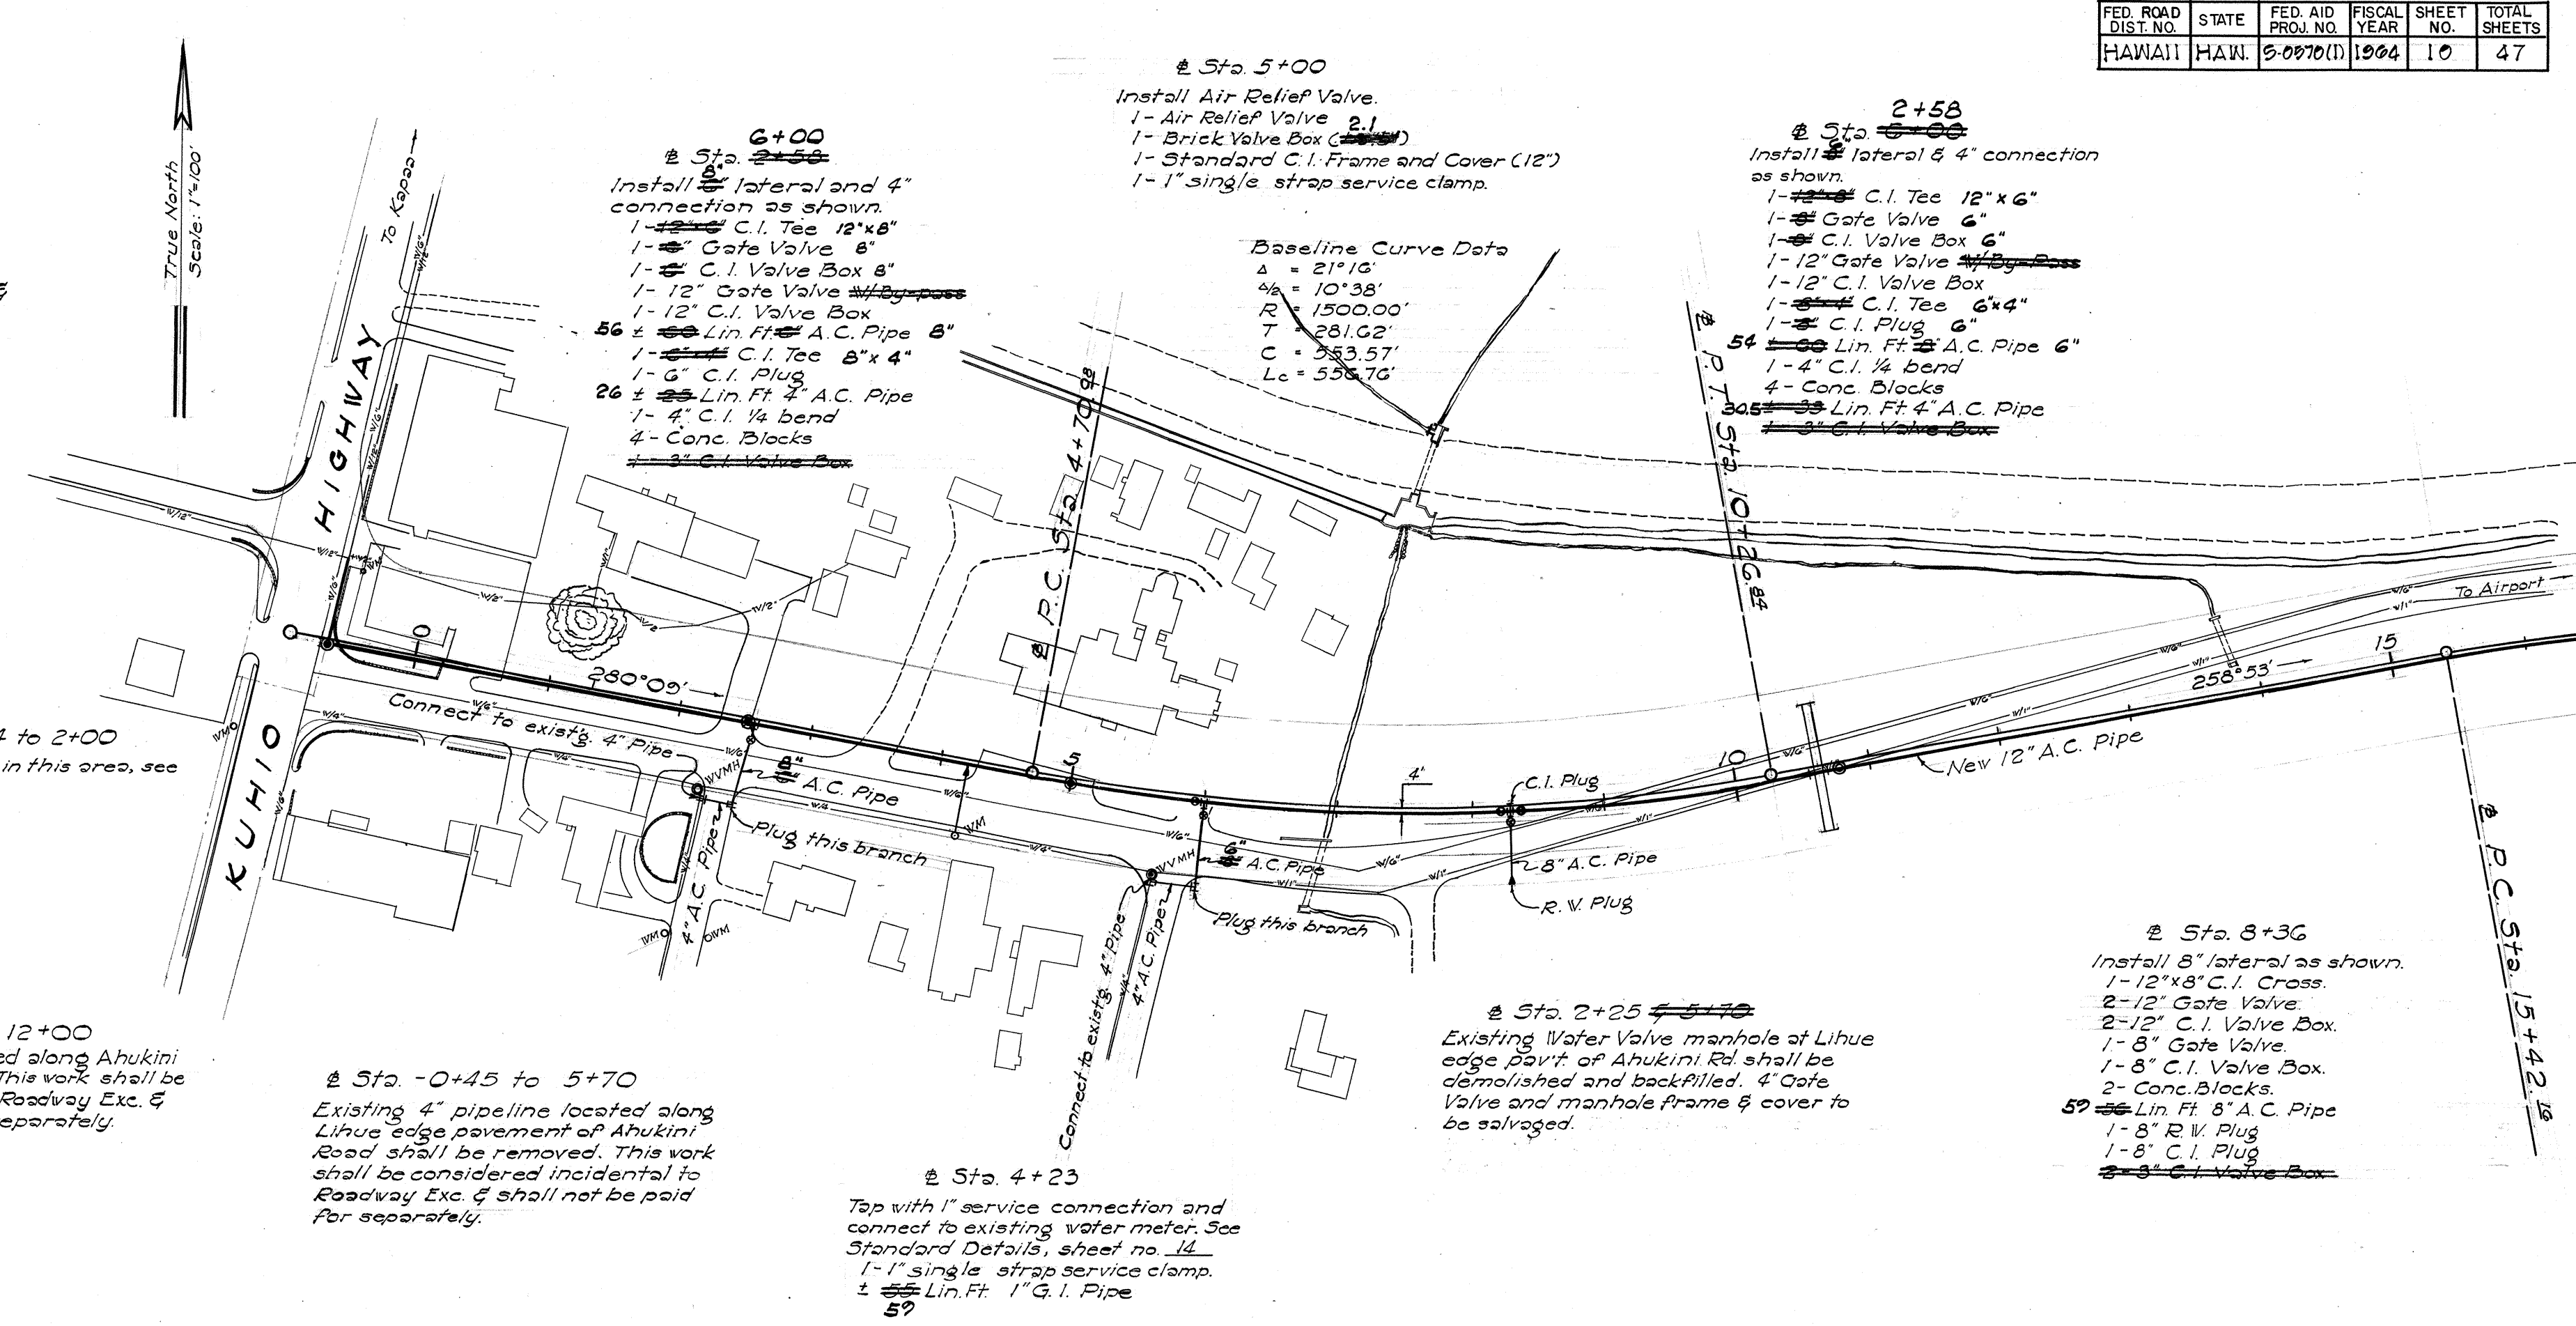



|             |                         |          |            |
|-------------|-------------------------|----------|------------|
| <b>PLAN</b> | SURVEYED.....           | BY ..... | DATE ..... |
|             | PLOTTED.....            |          |            |
|             | NOTE BOOK               |          |            |
|             | ALIGNMENT CHECKED.....  |          |            |
| NO.....     | RT. OF WAY CHECKED..... |          |            |

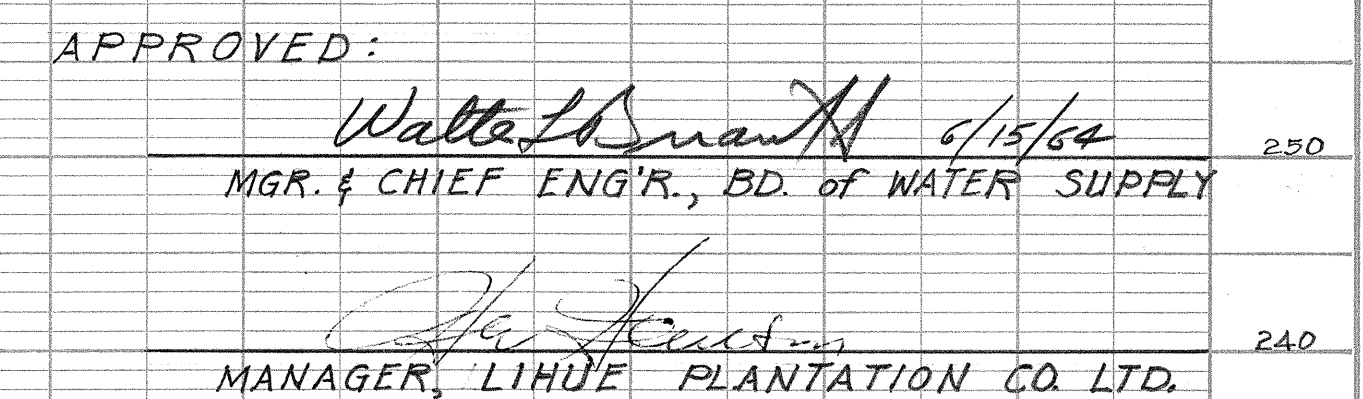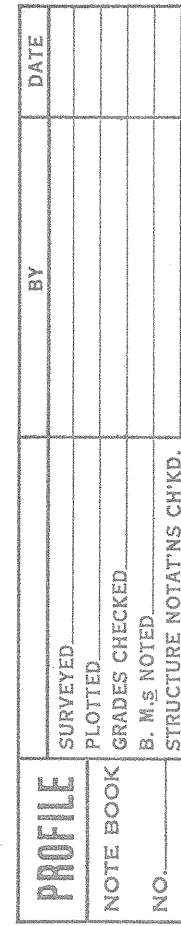

PLAN  
DATE  
BY  
SURVEYED  
CHECKED  
ALIGNED  
NOTED  
RT. OF WAY CHECKED  
H.P.

PROFILE  
DATE  
BY  
SURVEYED  
CHECKED  
NOTED  
H.P.

