	INDEX TO DRAWINGS
SHEET NO.	DESCRIPTION
1	TITLE SHEET
2	PLAN AND SECTION
3	SECTION AND GENERAL NOTES
4-6	MISCELLANEOUS DETAILS
7	STANDARD DETAIL
7	



STATE OF HAWAII



DEPARTMENT OF TRANSPORTATION

HIGHWAYS DIVISION


"AS-BUILT"

PLANS FOR

DRAINAGE IMPROVEMENTS ON AHUKINI ROAD

PROJECT NO. 570A-01-82


DISTRICT OF LIHUE
ISLAND OF KAUAI

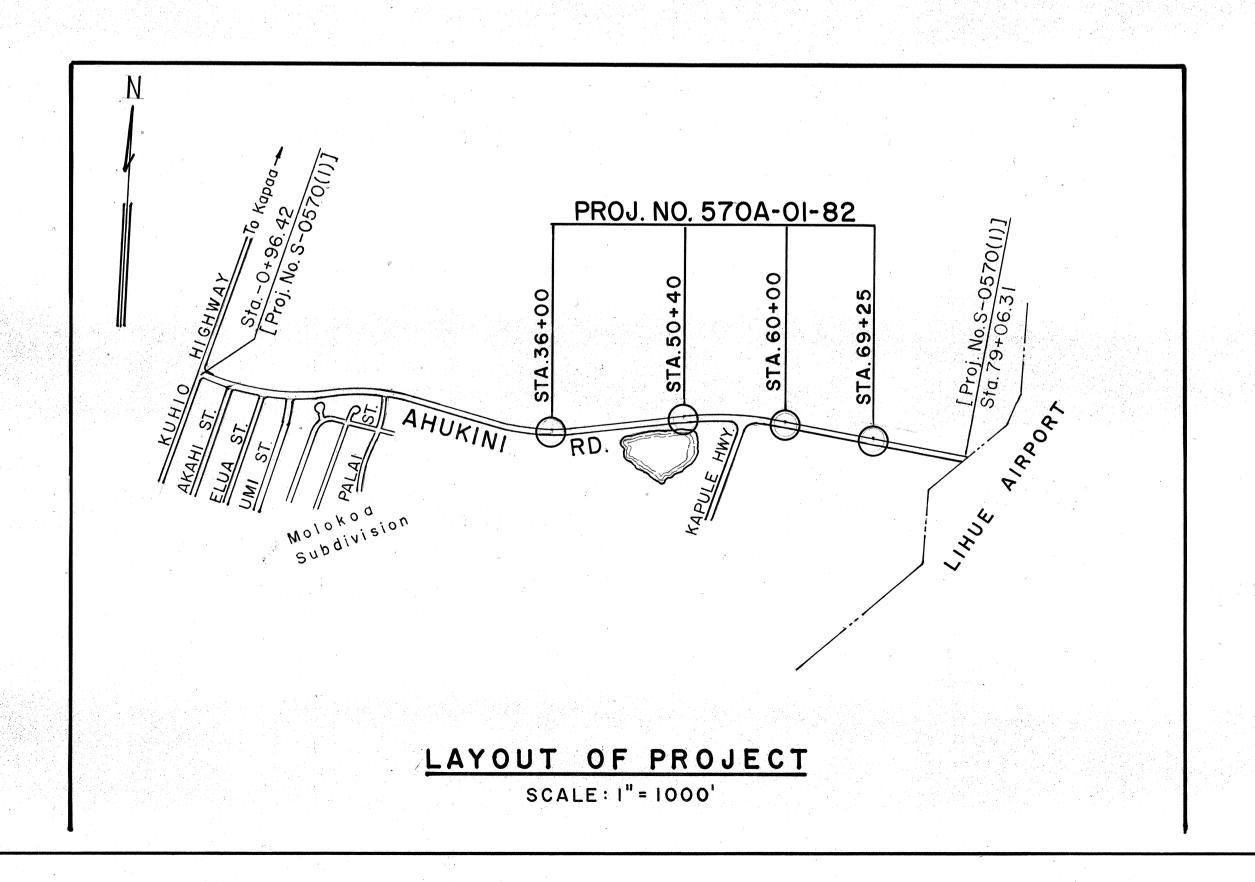


FED. ROAD DIST. NO. STATE PROJ. NO. FISCAL SHEET TOTAL YEAR NO. SHEETS

HAWAII HAW. 570A-01-82 1982 1 7



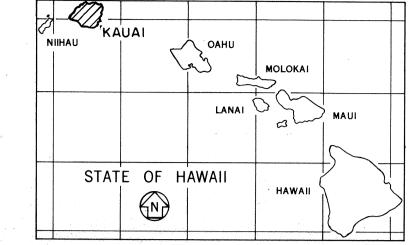

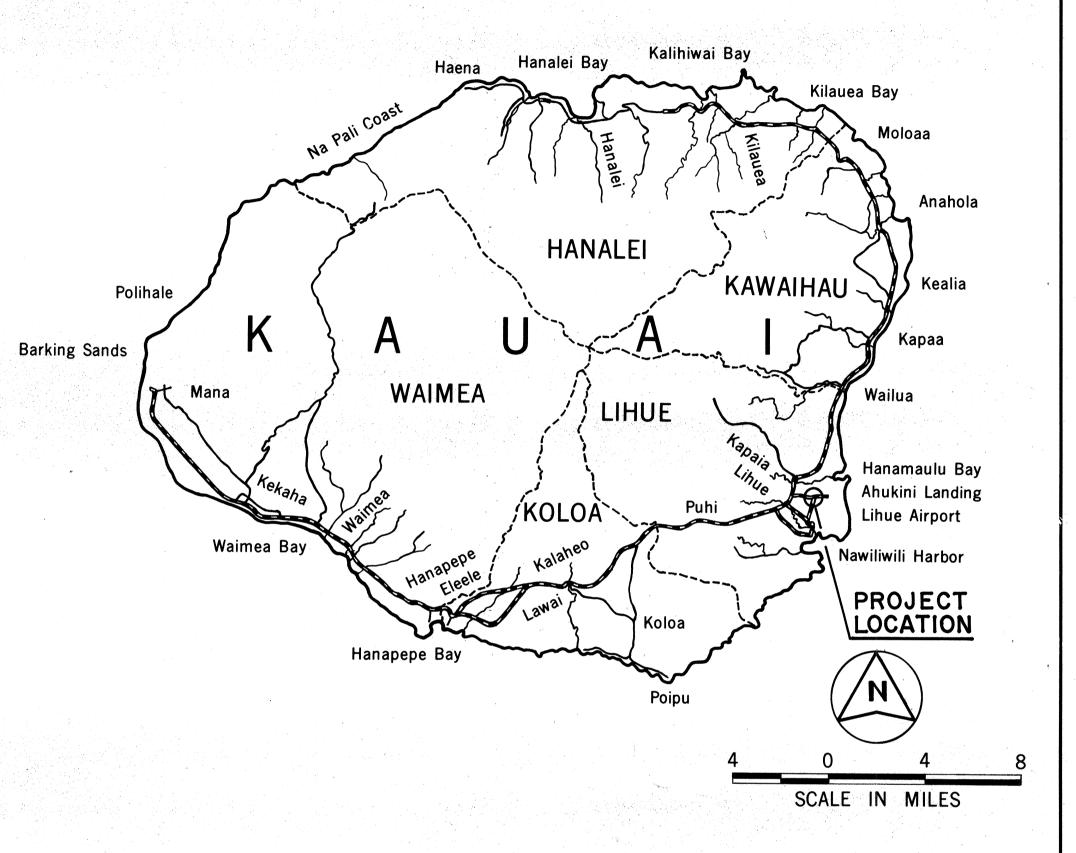

FEDERAL AID PROJECTS PREVIOUSLY CONSTRUCTED OR UNDER CONSTRUCTION

ALL CHANGES MADE DURING CONSTRUCTION HAVE BEEN INCORPORATED ON THESE PLANS IN RED EXCEPT CHANGES IN THE ORIGINAL THEORETICAL QUANTITIES. FOR ACTUAL QUANTITIES, REFER TO PROJECT LEDGER AND/OR COMPUTATION BOOK.

Ponald Magamine

RESIDENT ENGINEER

12-29-82 DATE

DEPARTMENT OF TRANSPORTATION
STATE OF HAWAII

APPROVED:

James R. Carras 3/18/82

Lander DIR. OF TRANSPORTATION DATE

8-6-0-9-3

548-4125 PHONE

KAUAI DISTRICT DESIGNED BY