



FED. ROAD DIST. NO.	STATE	FED. AID PROJ. NO.	FISCAL YEAR	SHEET NO.	TOTAL SHEETS
HAWAII	HAW.	R0-0570(3)	1987	4	4

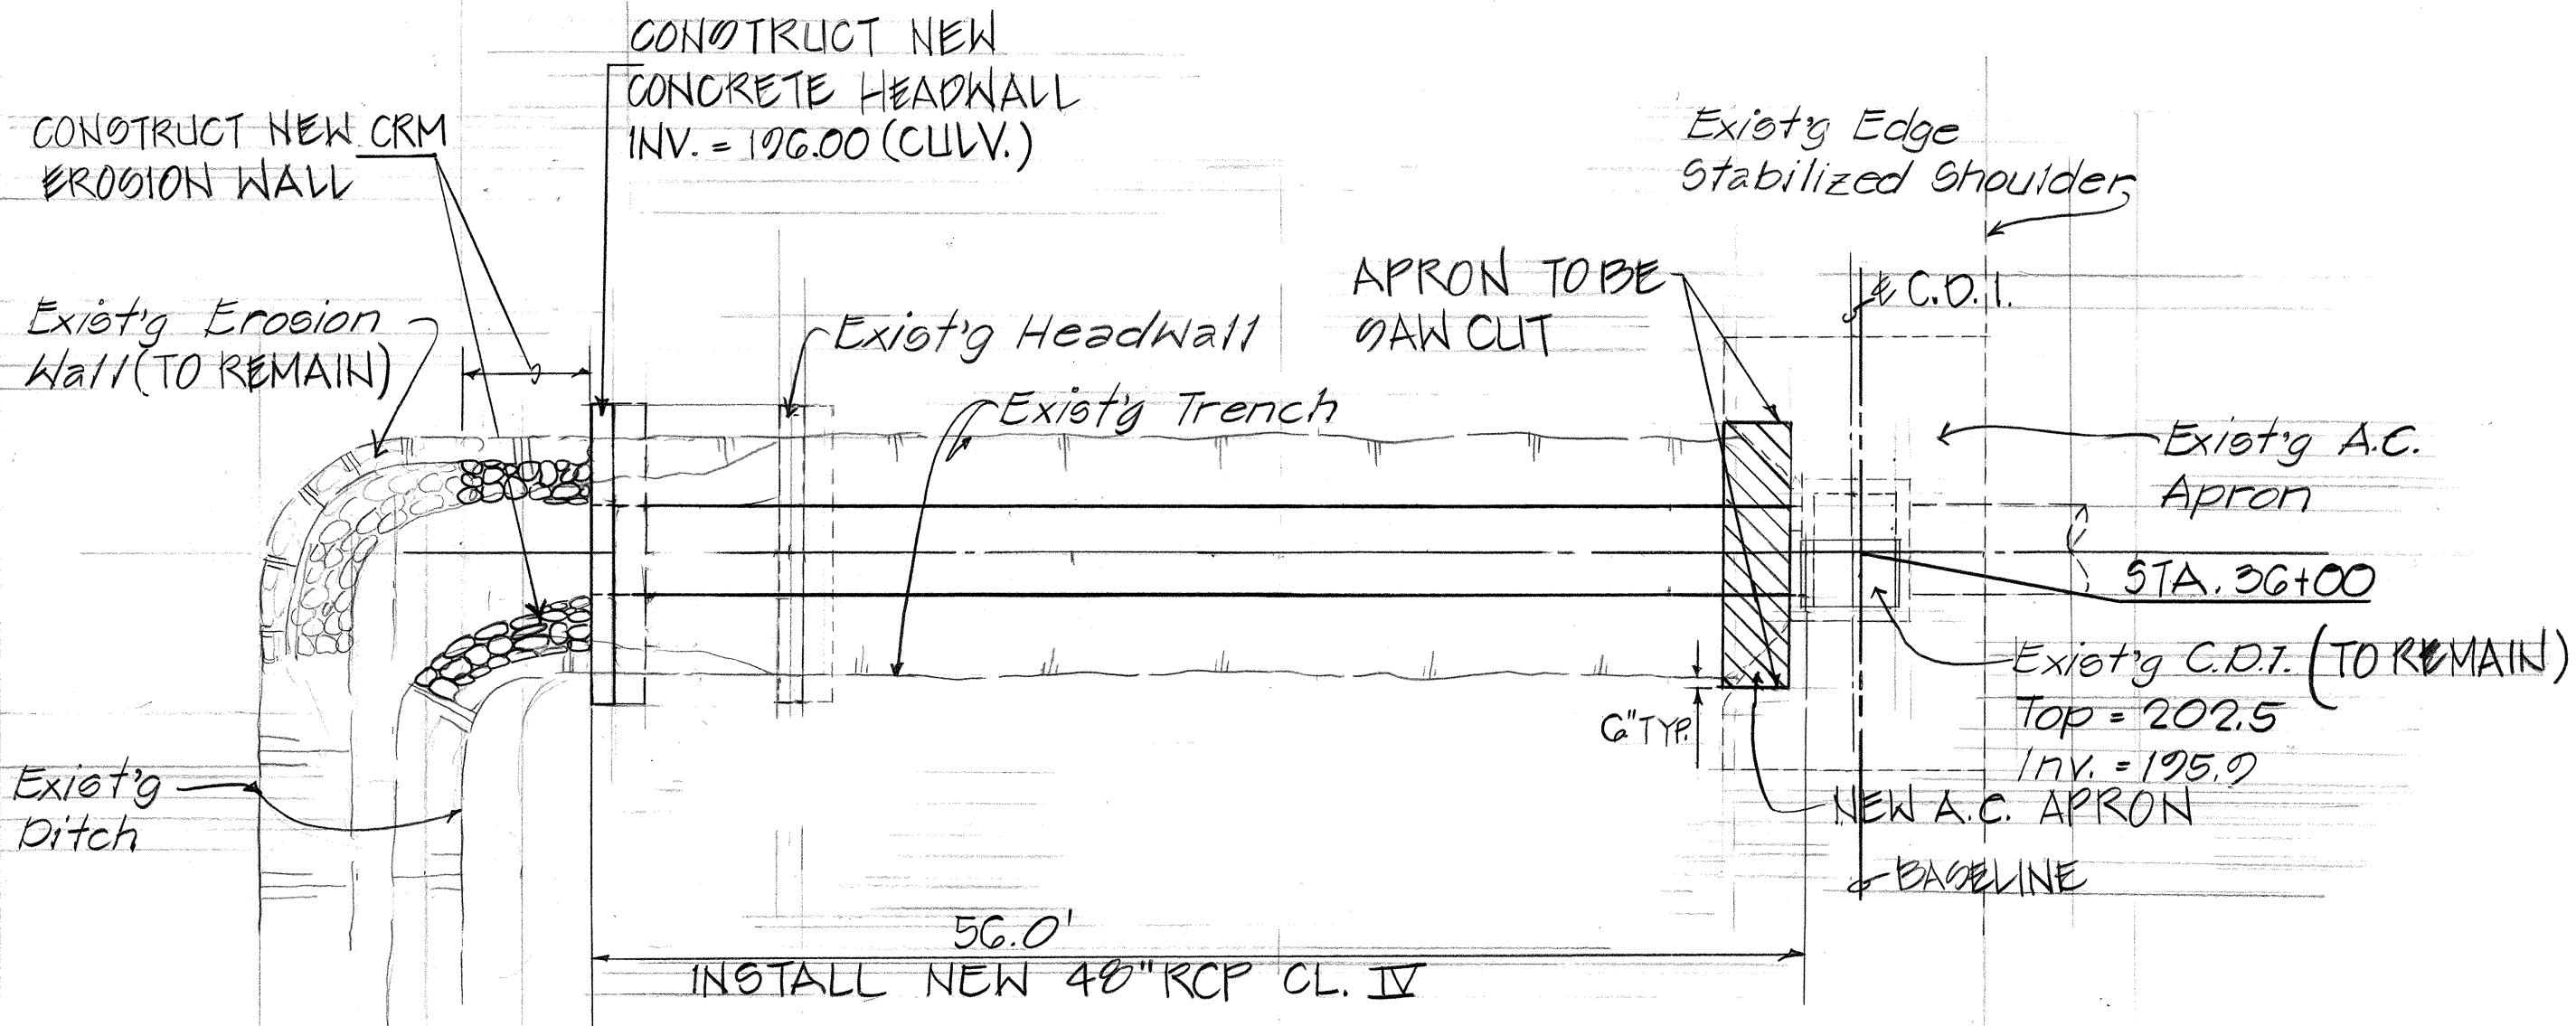


PLAN
Scale: 1/8" = 1'-0"

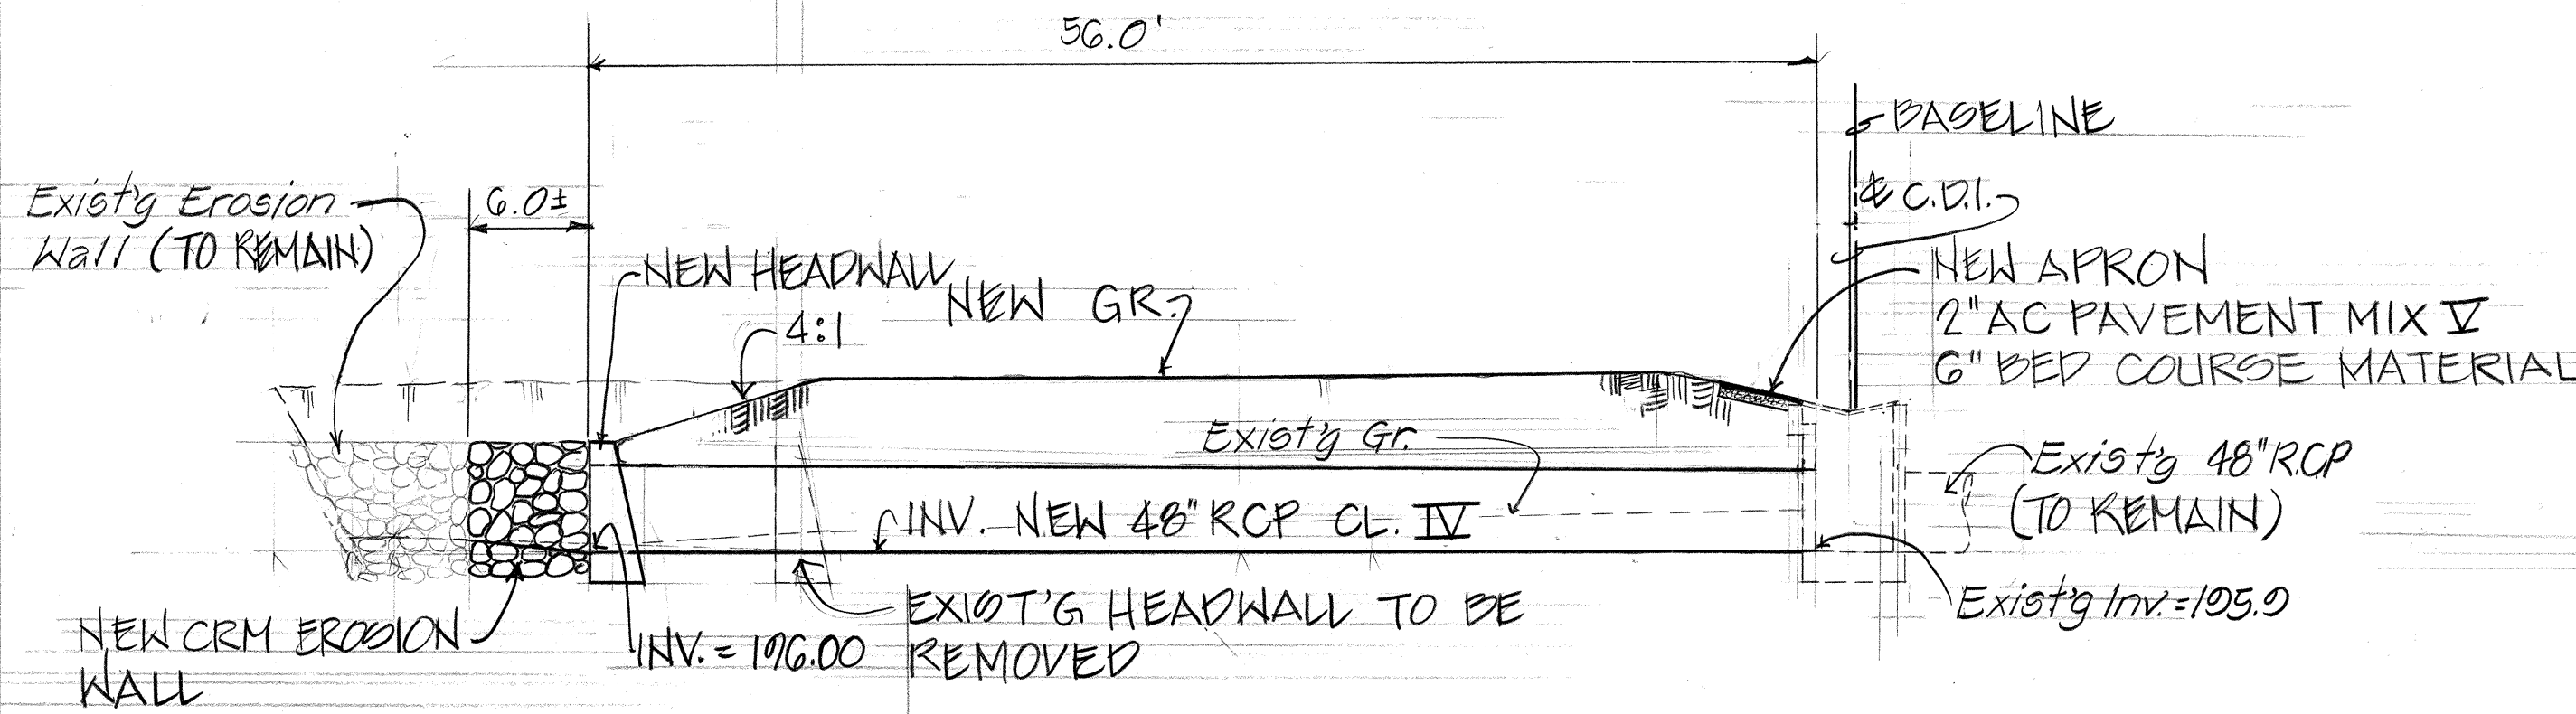


SECTION
Scale: 1/8" = 1'-0"
STA. 36+00 LT.

STA. 36+00 LT.
Est. Quant.

Struct. Exc.	= 50 CY 51
A.C. Pav't Mix V	= 0.7 Ton 0.9
Class A Concrete	= 5 CY
Reinf. Steel	= 78 LBS.
C.R.M.	= 5.3 CY 5.3
Bed Course Material	= 12.8 CY 12.8
48 inch R.C.P. Class IV	= 56 L.F.

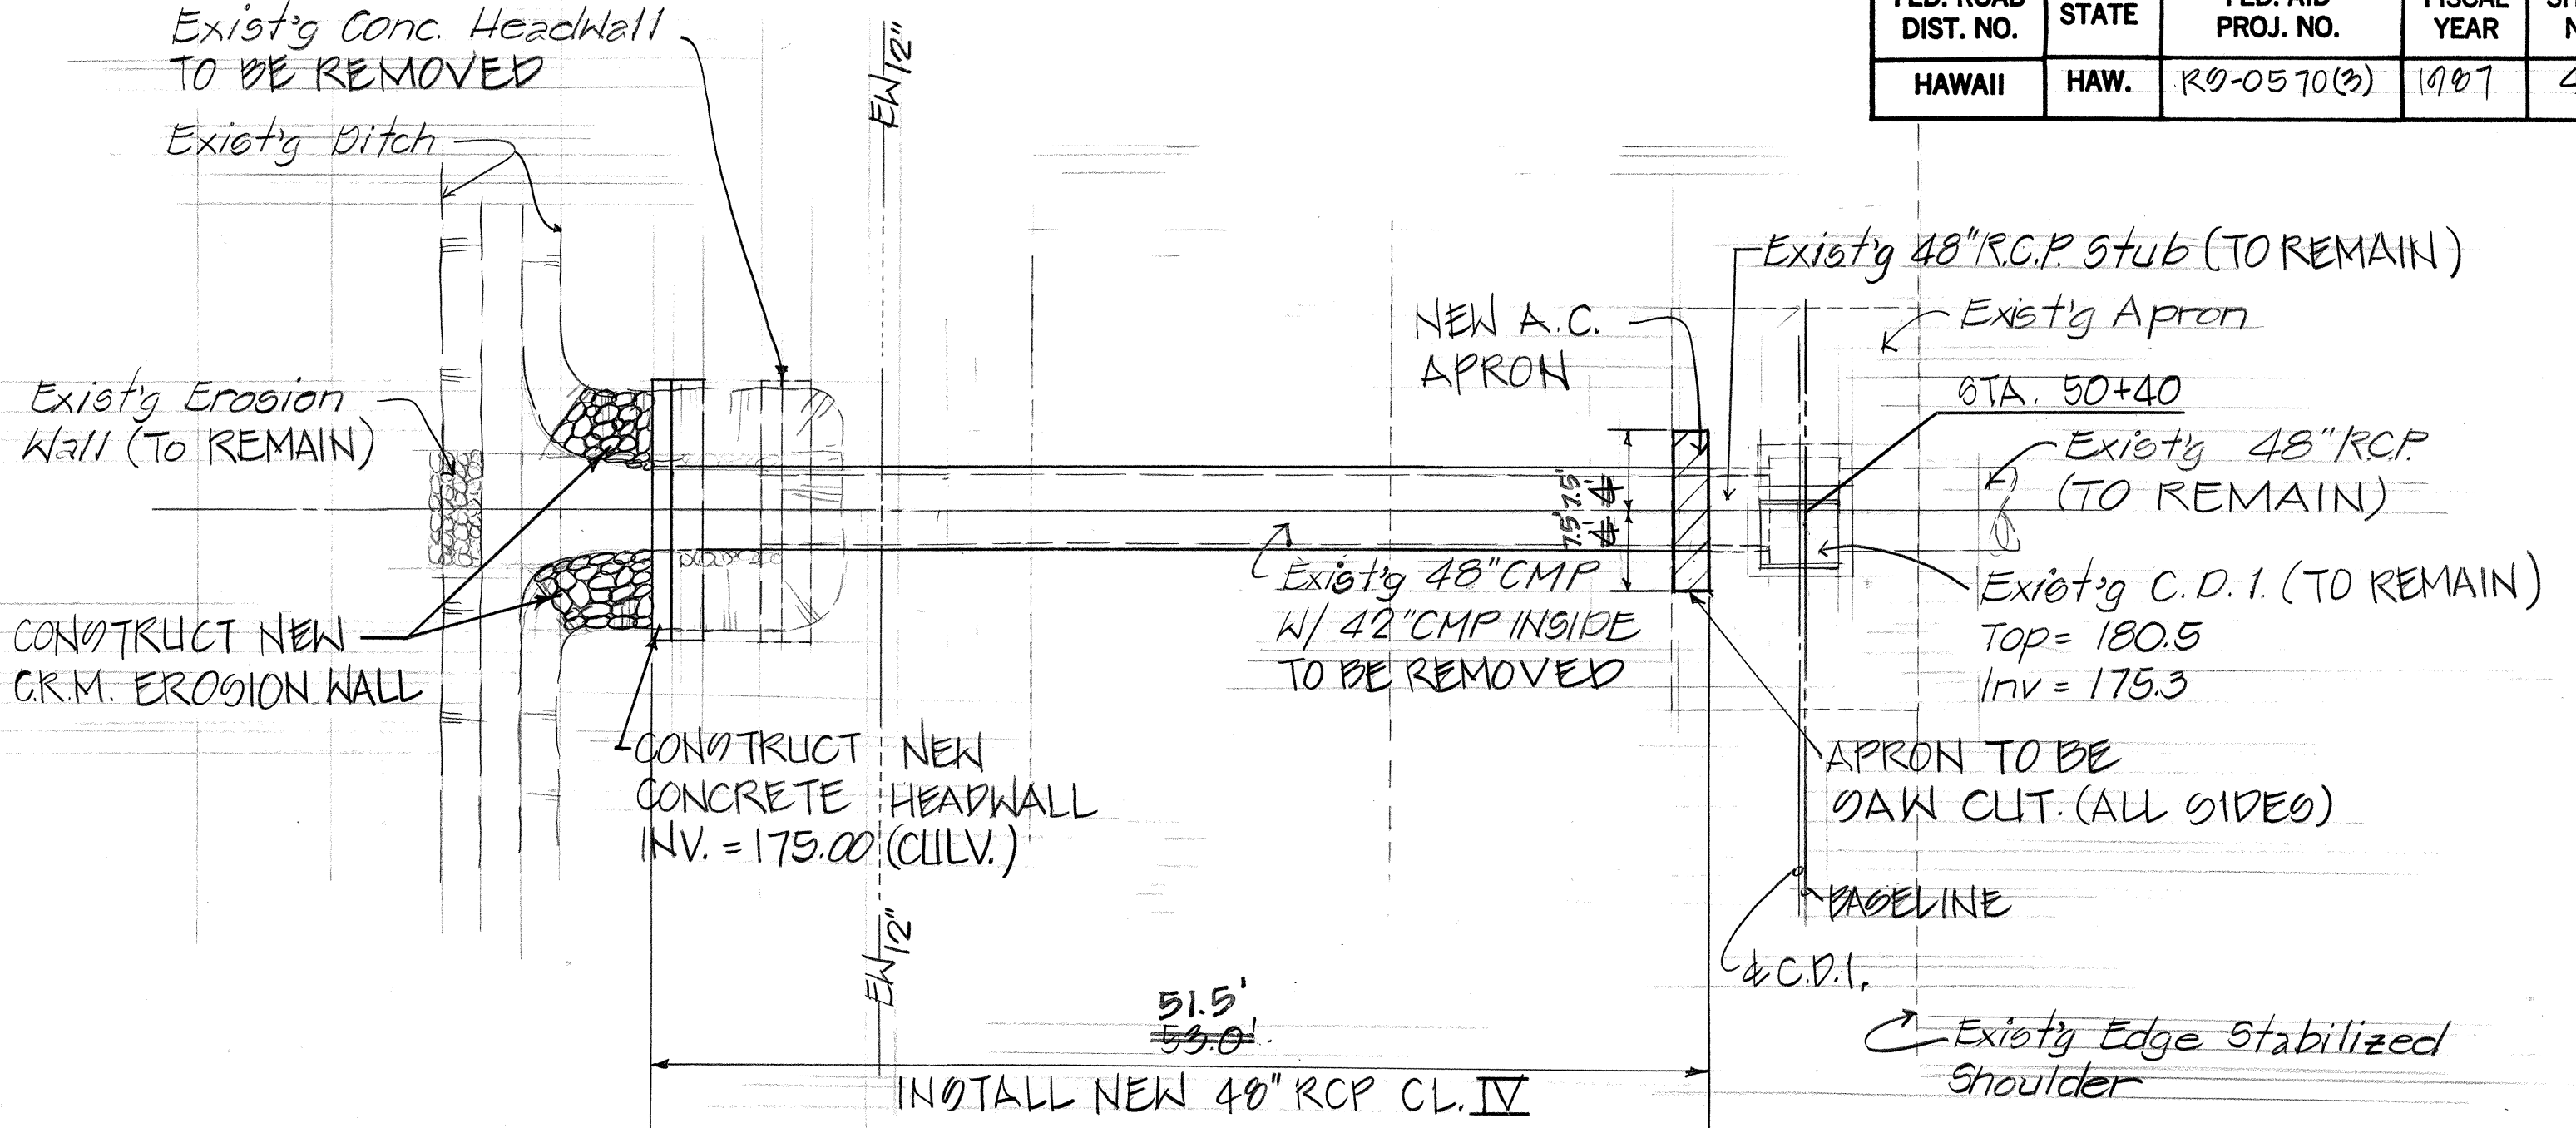

PLAN
Scale: 1/8" = 1'-0"

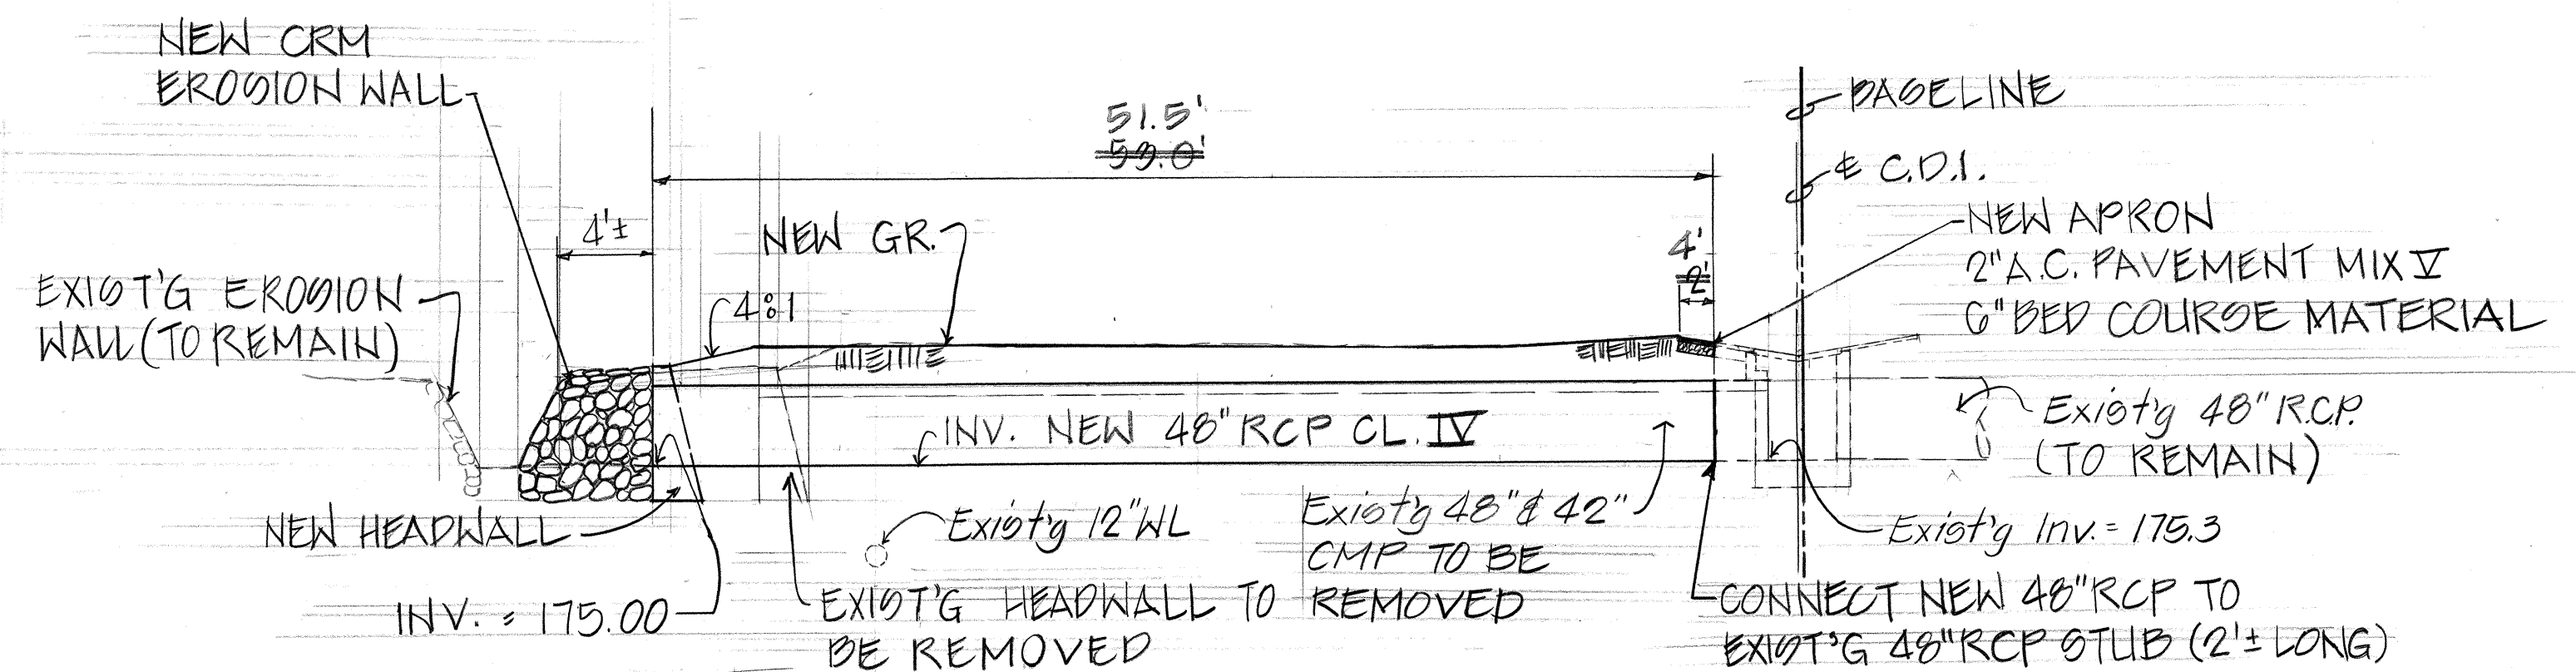

SECTION
Scale: 1/8" = 1'-0"
STA. 50+40 LT.

STA. 50+40 LT.
Est. Quant.

Struct. Exc.	= 101.4 CY 101.4
A.C. Pav't Mix V	= 0.7 Ton 0.7
Class A Concrete	= 5.0 CY
Reinf. Steel	= 78 LBS.
C.R.M.	= 2 CY 2
Bed Course Material	= 11.7 CY 11.7
48 inch R.C.P. Class IV	= 51.5 L.F. 51.5

STATE OF HAWAII

DEPARTMENT OF TRANSPORTATION

HIGHWAYS DIVISION

ROUTE 570 : AHUKINI ROAD

DRAINAGE IMPROVEMENTS

PROJECT NO. R0-0570(3)

PLAN

Scale: As Shown

SHEET NO. 1 OF 1 SHEETS

SURVEY PLOTTED BY	DATE
DRAWN BY	
TRACED BY	
QUANTITIES BY	
CHECKED BY	
ORIGINAL PLAN	
NOTE BOOK	
No.	