	INDEX TO DRAWINGS
SHEET NO.	DESCRIPTION
1	TITLE SHEET
2	STANDARD PLAN SUMMARY
3	GENERAL NOTES &
	MISCELLANEOUS DETAILS
4	PLAN


STATE OF HAWAII

DEPARTMENT OF TRANSPORTATION HIGHWAYS DIVISION


PLANS FOR


ROUTE 570: AHUKINI ROAD DRAINAGE IMPROVEMENTS


FEDERAL AID PROJECT NO. RS-0570 (3) DISTRICT OF LIHUE ISLAND OF KAUAI

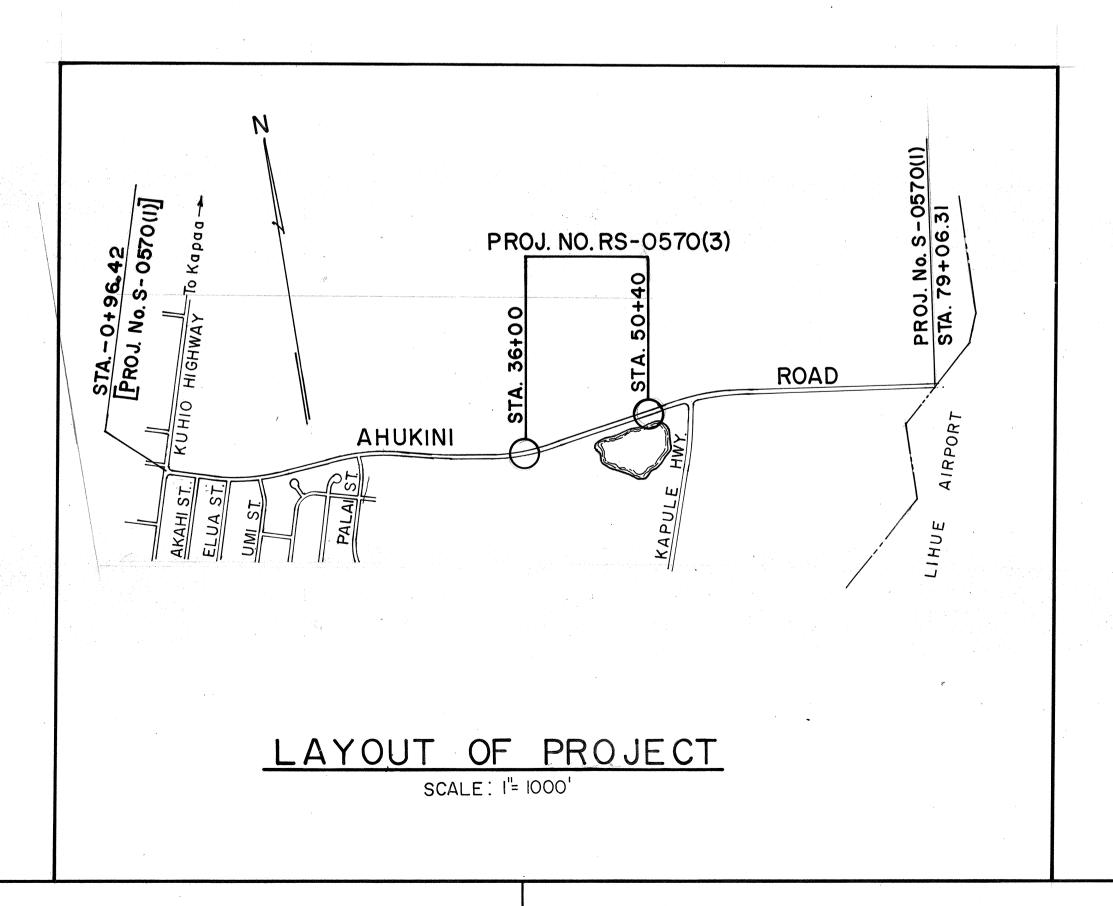

FISCAL YEAR FED AID PROJ. NO. RS-0570 (3)

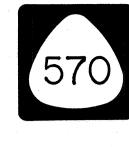

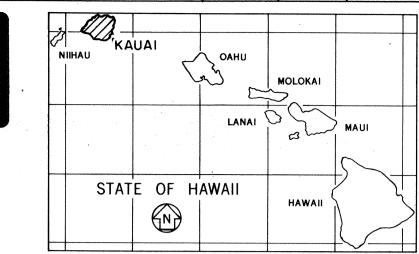

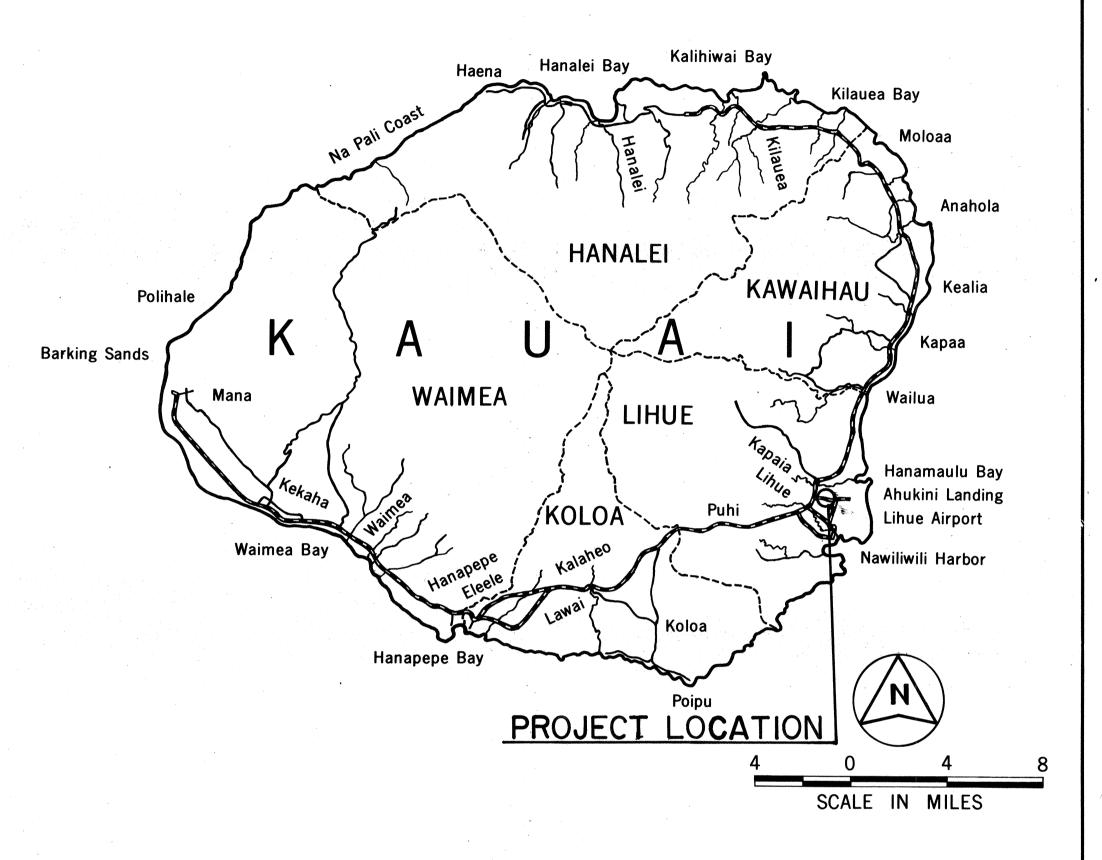


CHANGES MADE DURING CONSTRUCTION HAVE BEEN NOTED ON THESE PLANS AND CHECKED BY:

Danyl H. Maeda RESIDENT ENGINEER

FEDERAL AID PROJECTS PREVIOUSLY CONSTRUCTED

OR UNDER CONSTRUCTION

DATE

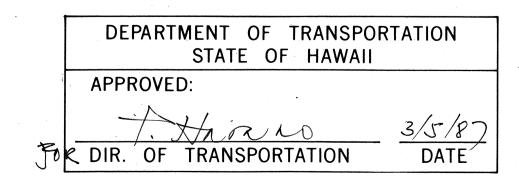

2/24/87 DATE 548-7534 PHONE

YAMAGUCHI P. S. & E. BY KAUAI DISTRICT DESIGNED BY