


FED. ROAD DIST. NO.	STATE	PROJ. NO.	FISCAL YEAR	SHEET NO.	TOTAL SHEETS
HAWAII	HAW.	LT-K-05-78		18	22

PHASE III

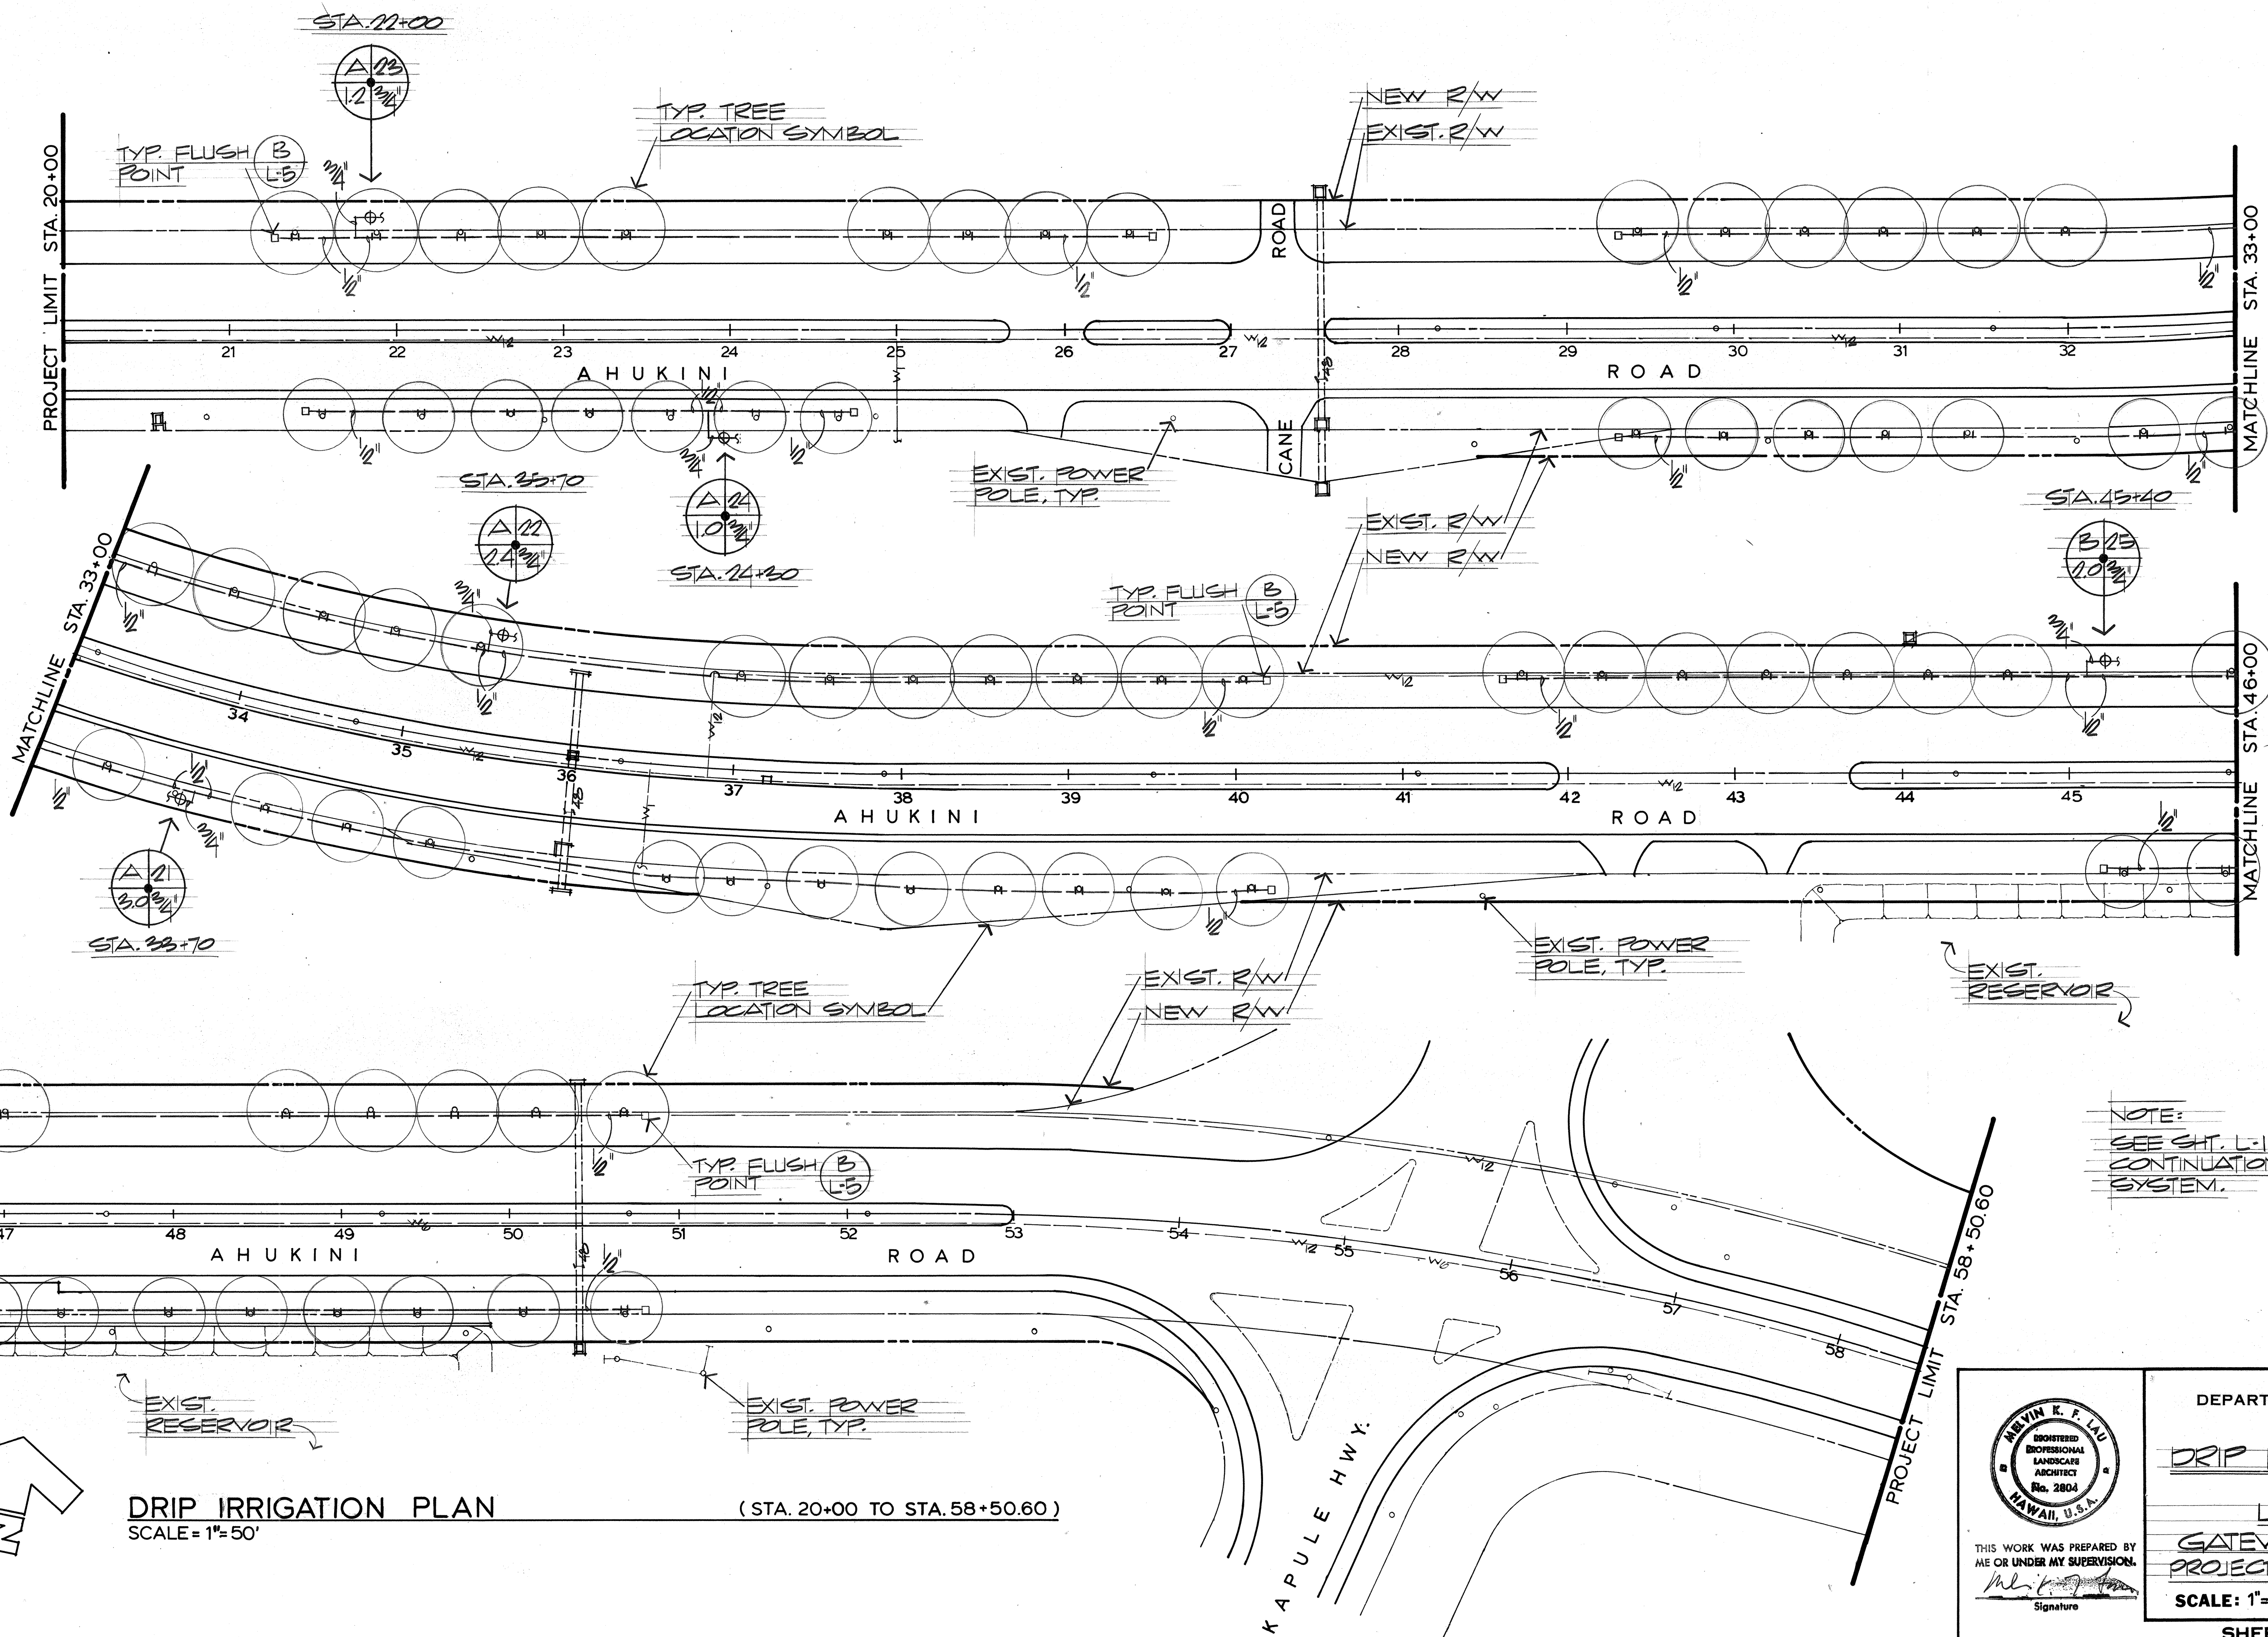

NOTE:
SEE SHT. L-1 & L-2 FOR
CONTINUATION OF IRRIGATION
SYSTEM.

ORIGINAL PLAN	DATE
DRAWN BY	
TRACED BY	
NOTES BY	
CHECKED BY	

DRIP IRRIGATION PLAN
SCALE = 1" = 50'
(STA. 20+00 TO STA. 58+50.60)



THIS WORK WAS PREPARED BY
ME OR UNDER MY SUPERVISION.
Kevin K. F. Lau
Signature

STATE OF HAWAII
DEPARTMENT OF TRANSPORTATION
HIGHWAYS DIVISION

DRIP IRRIGATION PLAN

LIHUE AIRPORT
GATEWAY BEAUTIFICATION
PROJECT NO. LT-K-05-78 PHASE II

SCALE: 1" = 50' DATE:

SHEET NO. L-3 OF 7 SHEETS