



| FED. ROAD DIST. NO. | STATE | PROJ. NO.  | FISCAL YEAR | SHEET NO. | TOTAL SHEETS |
|---------------------|-------|------------|-------------|-----------|--------------|
| HAWAII              | HAW.  | LT-K-05-78 |             | 14        | 18           |

PHASE II-A

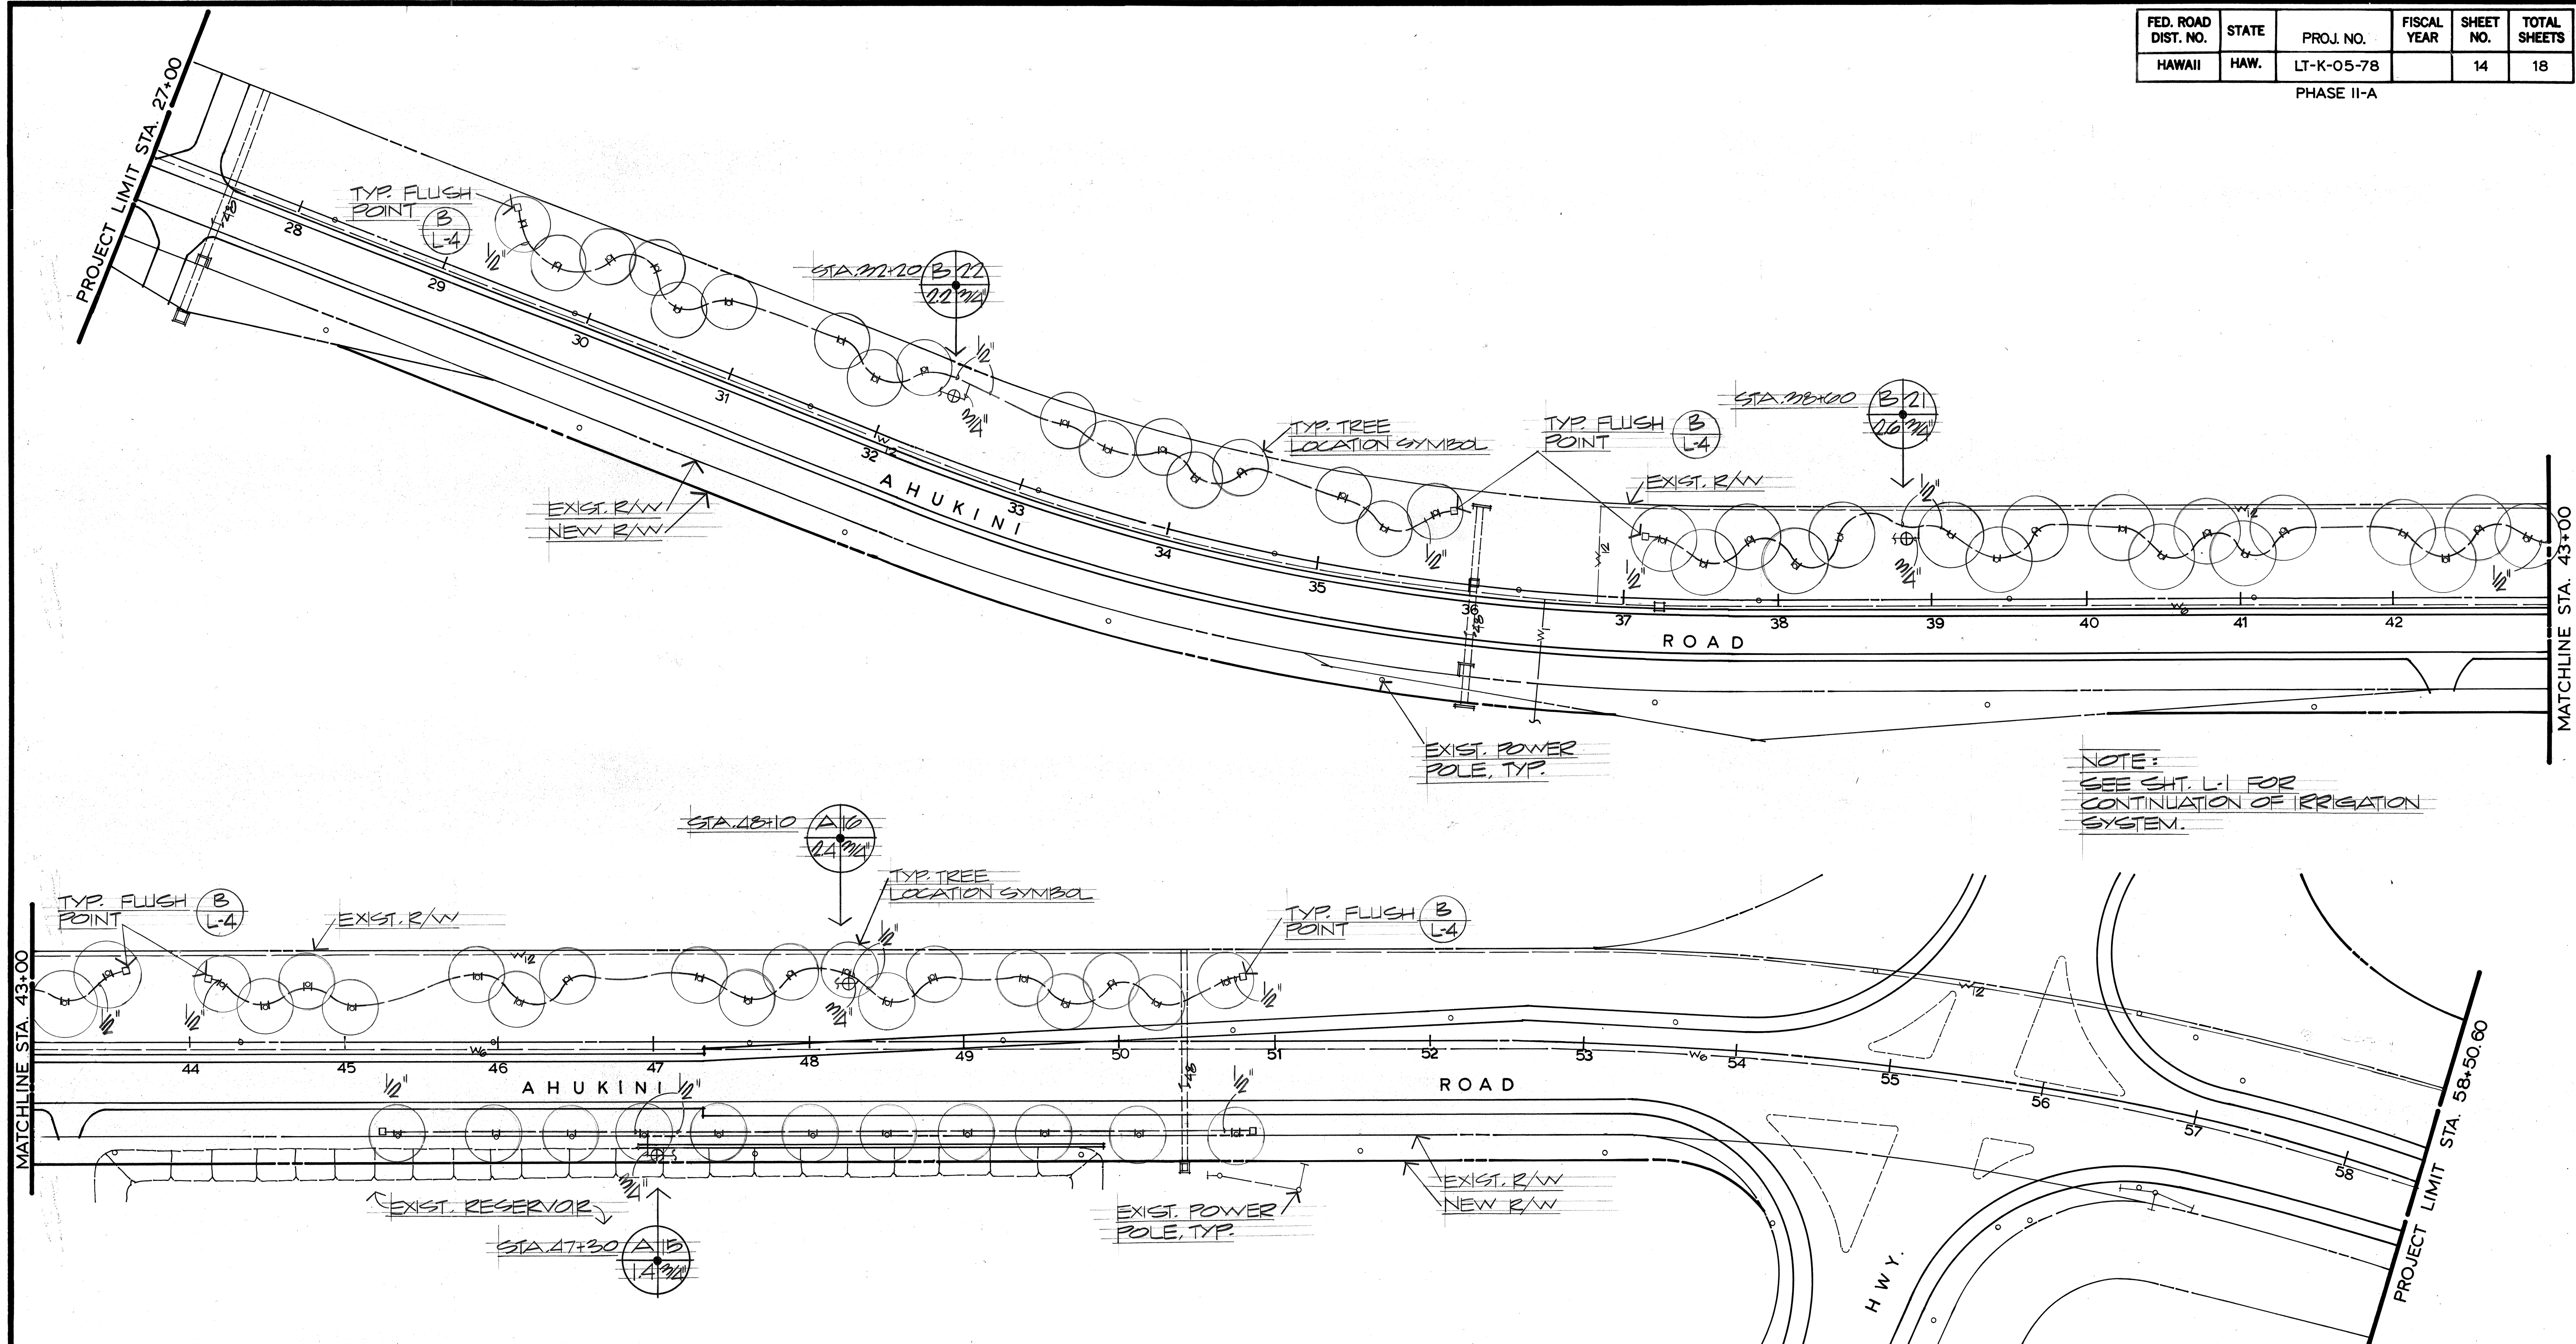

|               |                   |      |
|---------------|-------------------|------|
| ORIGINAL PLAN | SURVEY PLOTTED BY | DATE |
| NOTE BOOK     | DRAWN BY          |      |
|               | DESIGNED BY       |      |
|               | CHECKED BY        |      |

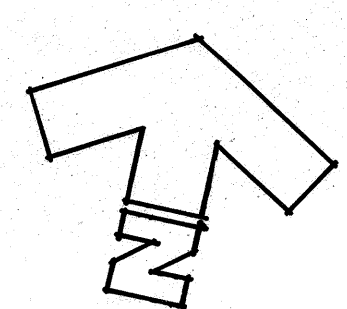

**DRIP IRRIGATION PLAN**  
SCALE = 1" = 50'  
(STA. 20+70 TO STA. 58+50.60)

THIS WORK WAS PREPARED BY ME OR UNDER MY SUPERVISION.  
*Melvin K. F. Liu*  
Signature

STATE OF HAWAII  
DEPARTMENT OF TRANSPORTATION  
HIGHWAYS DIVISION

**DRP IRRIGATION PLAN**

LIHUE AIRPORT  
GATEWAY BEAUTIFICATION  
PROJECT NO. LT-K-05-78 PHASE II-A

SCALE: 1" = 50'      DATE:

SHEET No. L-2 OF 6 SHEETS