


FED. ROAD DIST. NO.	STATE	PROJ. NO.	FISCAL YEAR	SHEET NO.	TOTAL SHEETS
HAWAII	HAW.	LT-K-05-78		13	18


PHASE II-A

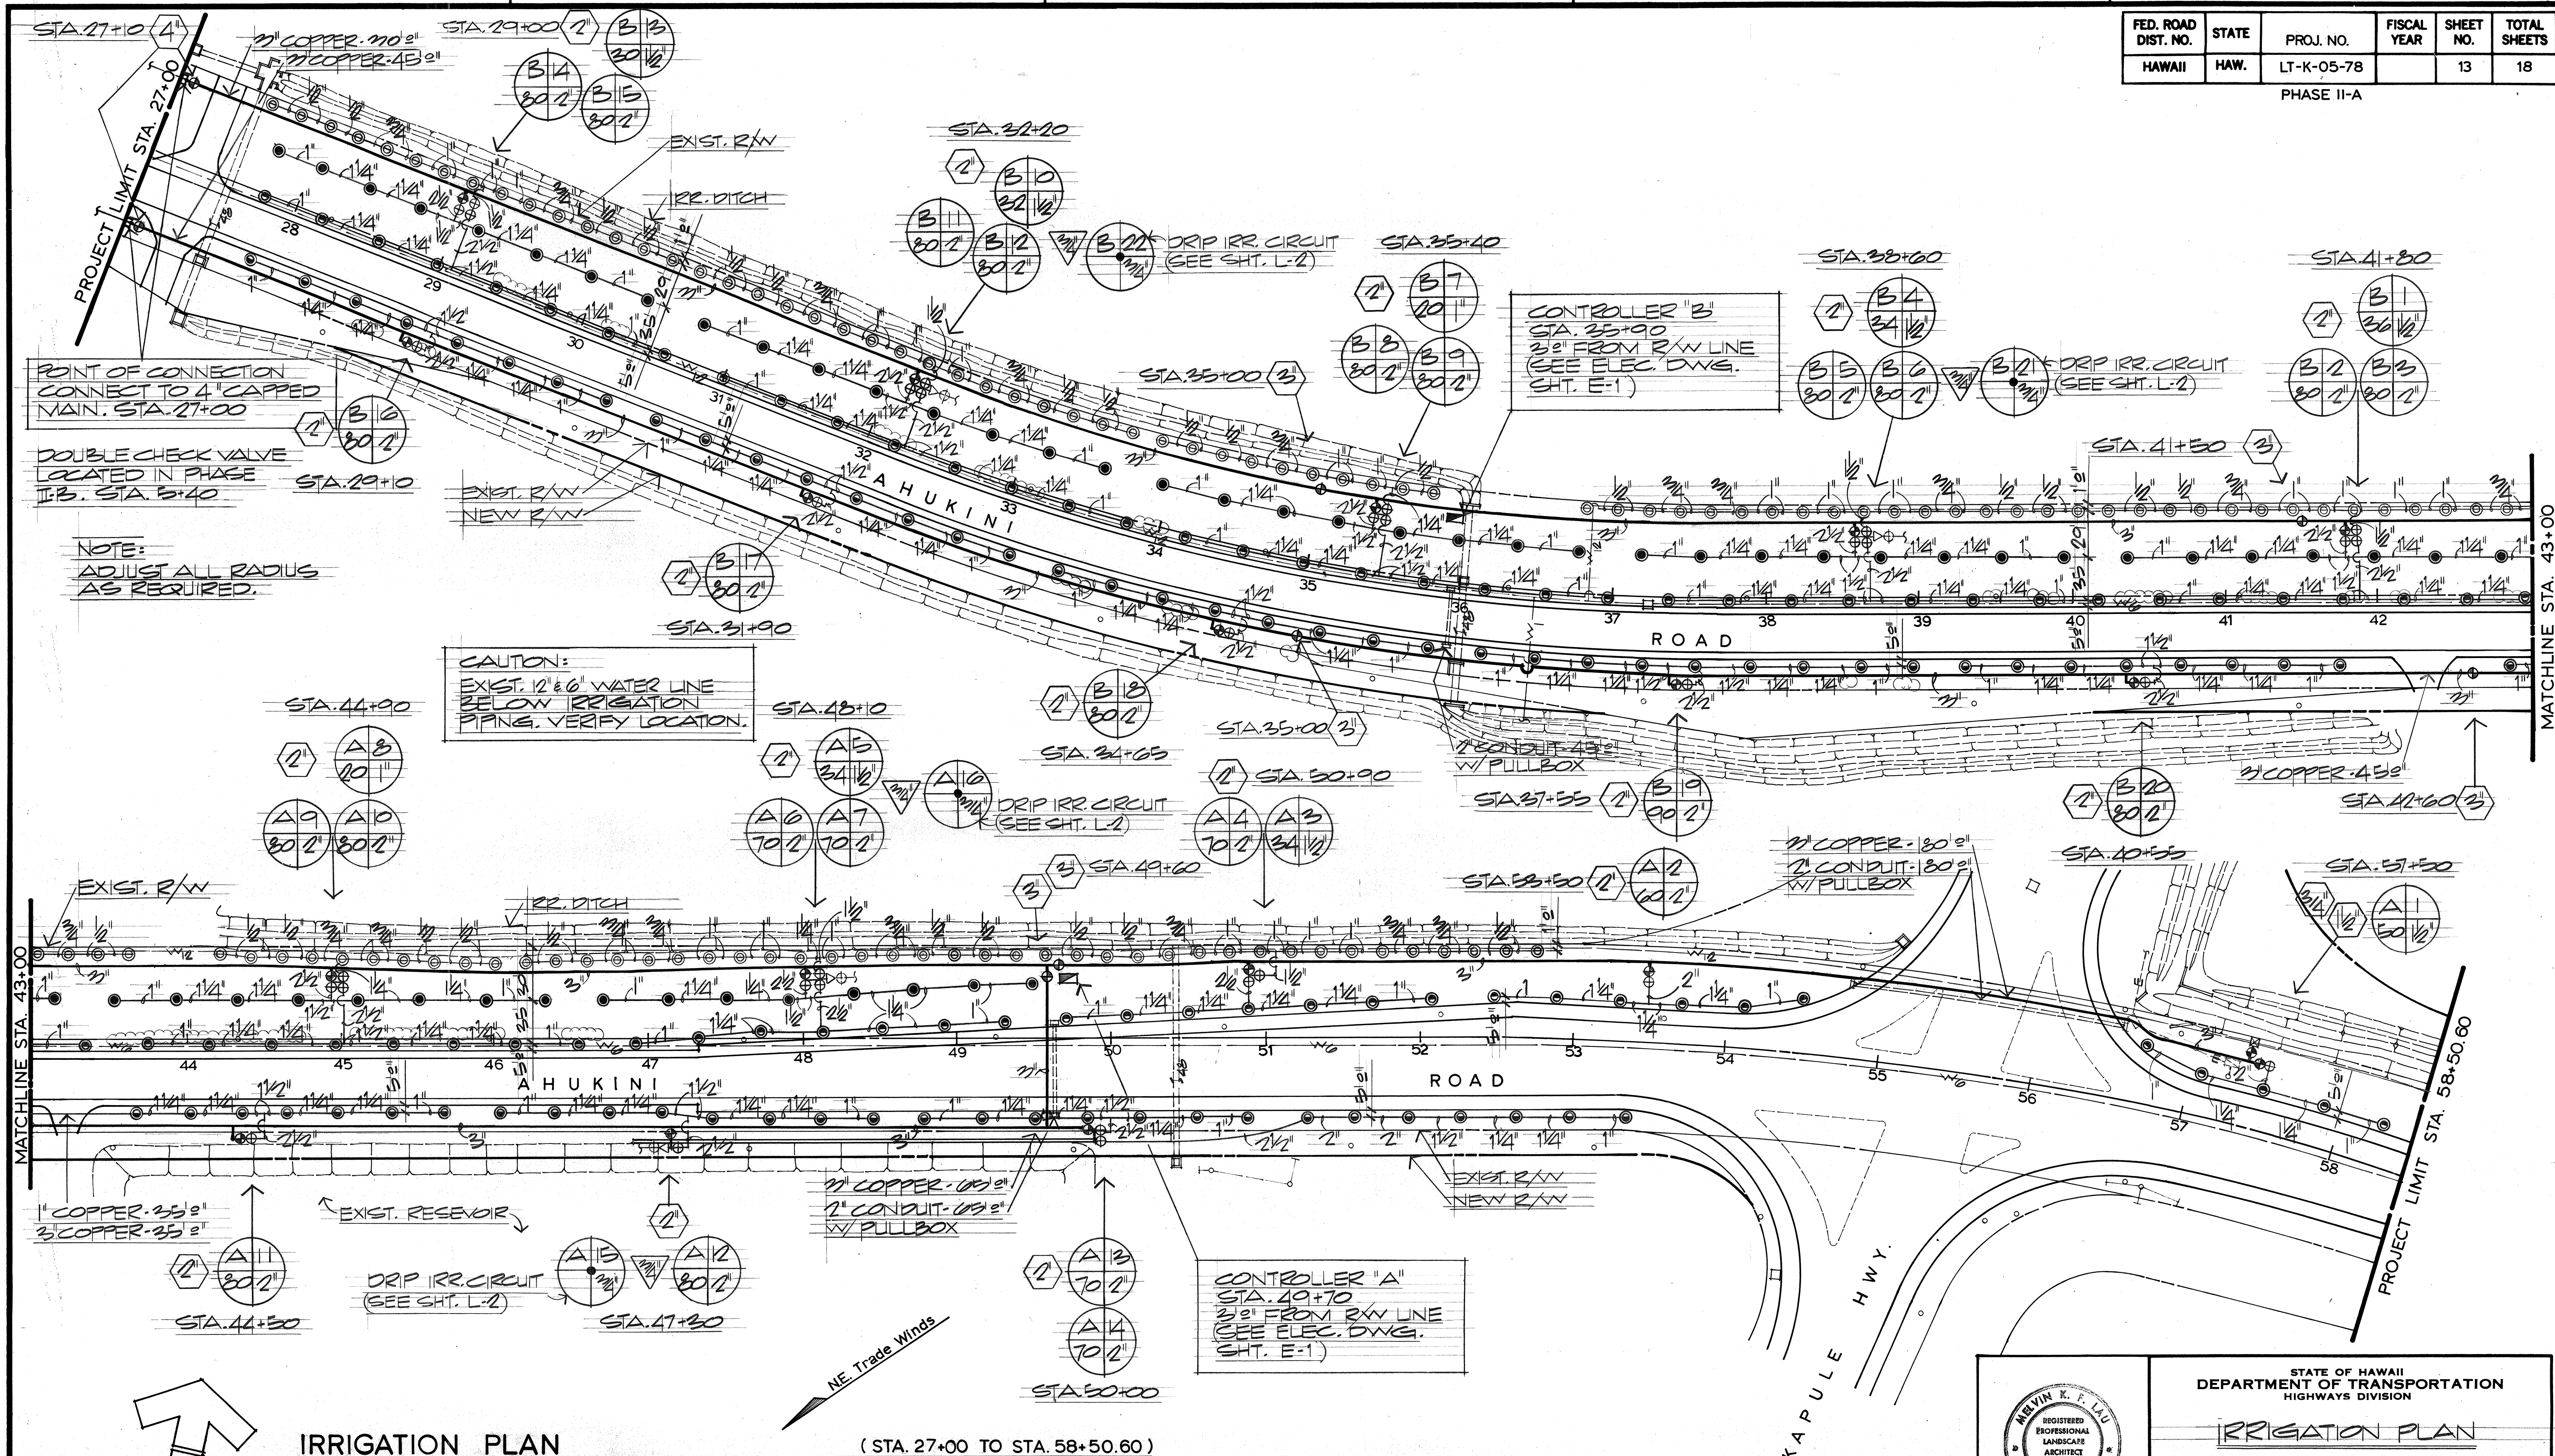

DATE	
SURVEY PLATTED BY	
DRAWN BY	
DESIGNED BY	
NOTED BY	
CHECKED BY	

IRRIGATION PLAN
SCALE = 1" = 50'

(STA. 27+00 TO STA. 58+50.60)

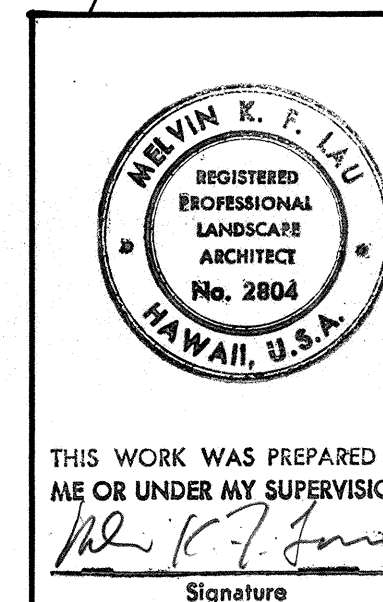

THIS WORK WAS PREPARED BY ME OR UNDER MY SUPERVISION.
Signature

STATE OF HAWAII
DEPARTMENT OF TRANSPORTATION
HIGHWAYS DIVISION

IRRIGATION PLAN

LIHUE AIRPORT
GATEWAY BEAUTIFICATION
PROJECT NO. LT-K-05-78 PHASE II-A
SCALE: 1" = 50' DATE: _____

SHEET NO. L-1 OF 6 SHEETS