

PHASE II-A



- A. CONCRETE FOUNDATION TO BE 6" AWAY FROM CURBING.
THIS APPLIES TO STREETS WITH CURB AND GUTTER CONSTRUCTION.
- B. CONCRETE FOUNDATION: 3000 PSI (28 DAYS COMPRESSIVE STRENGTH).
- C. ANCHOR RODS: SUPPLIED BY KAUAI ELECTRIC, UNLESS NOTED
ON CONSTRUCTION DRAWINGS.
- D. FOUNDATION: CONSTRUCTED BY CONTRACTOR.

(E4) NOT TO SCALE





SCALE: $1 \frac{1}{2}'' = 1' - 0''$



TYPE "A" BACKFILL: BEACH SAND, EARTH OR EARTH & GRAVEL. IF EARTH & GRAVEL IS USED, MAX ROCK SHALL BE SIZE 1" & MIXTURE SHALL CONTAIN NOT MORE THAN 50% OF ROCK PARTICLES BY VOLUME.

TYPE "B" BACKFILL: SAME AS "A" EXCEPT THAT IF EARTH & GRAVEL IS USED, MIXTURE MUST PASS A 1/2" MESH SCREEN & CONTAIN NOT MORE THAN 20% OF ROCK PARTICLES BY VOLUME.

1. IF THE NORMAL MATERIAL IN BOTTOM OF TRENCH IS NOT TYPE "B" AN ADDITIONAL 3" SHALL BE EXCAVATED & TYPE "B" BACKFILL SHALL BE PROVIDED.
2. CONCRETE JACKET SHALL BE 2500 P.S.I. COMPRESSIVE STRENGTH IN 28 DAYS.

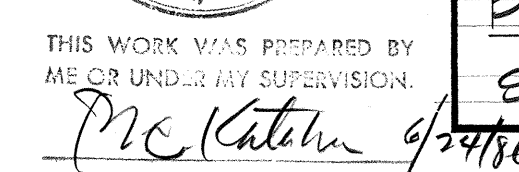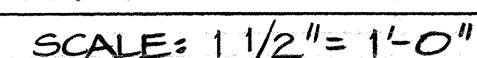

SHEET No. E-2 OF 2 SHEETS