



FED. ROAD DIST. NO.	STATE	PROJ. NO.	FISCAL YEAR	SHEET NO.	TOTAL SHEETS
HAWAII	HAW.	LT-K-05-78		17	18

PHASE II-A

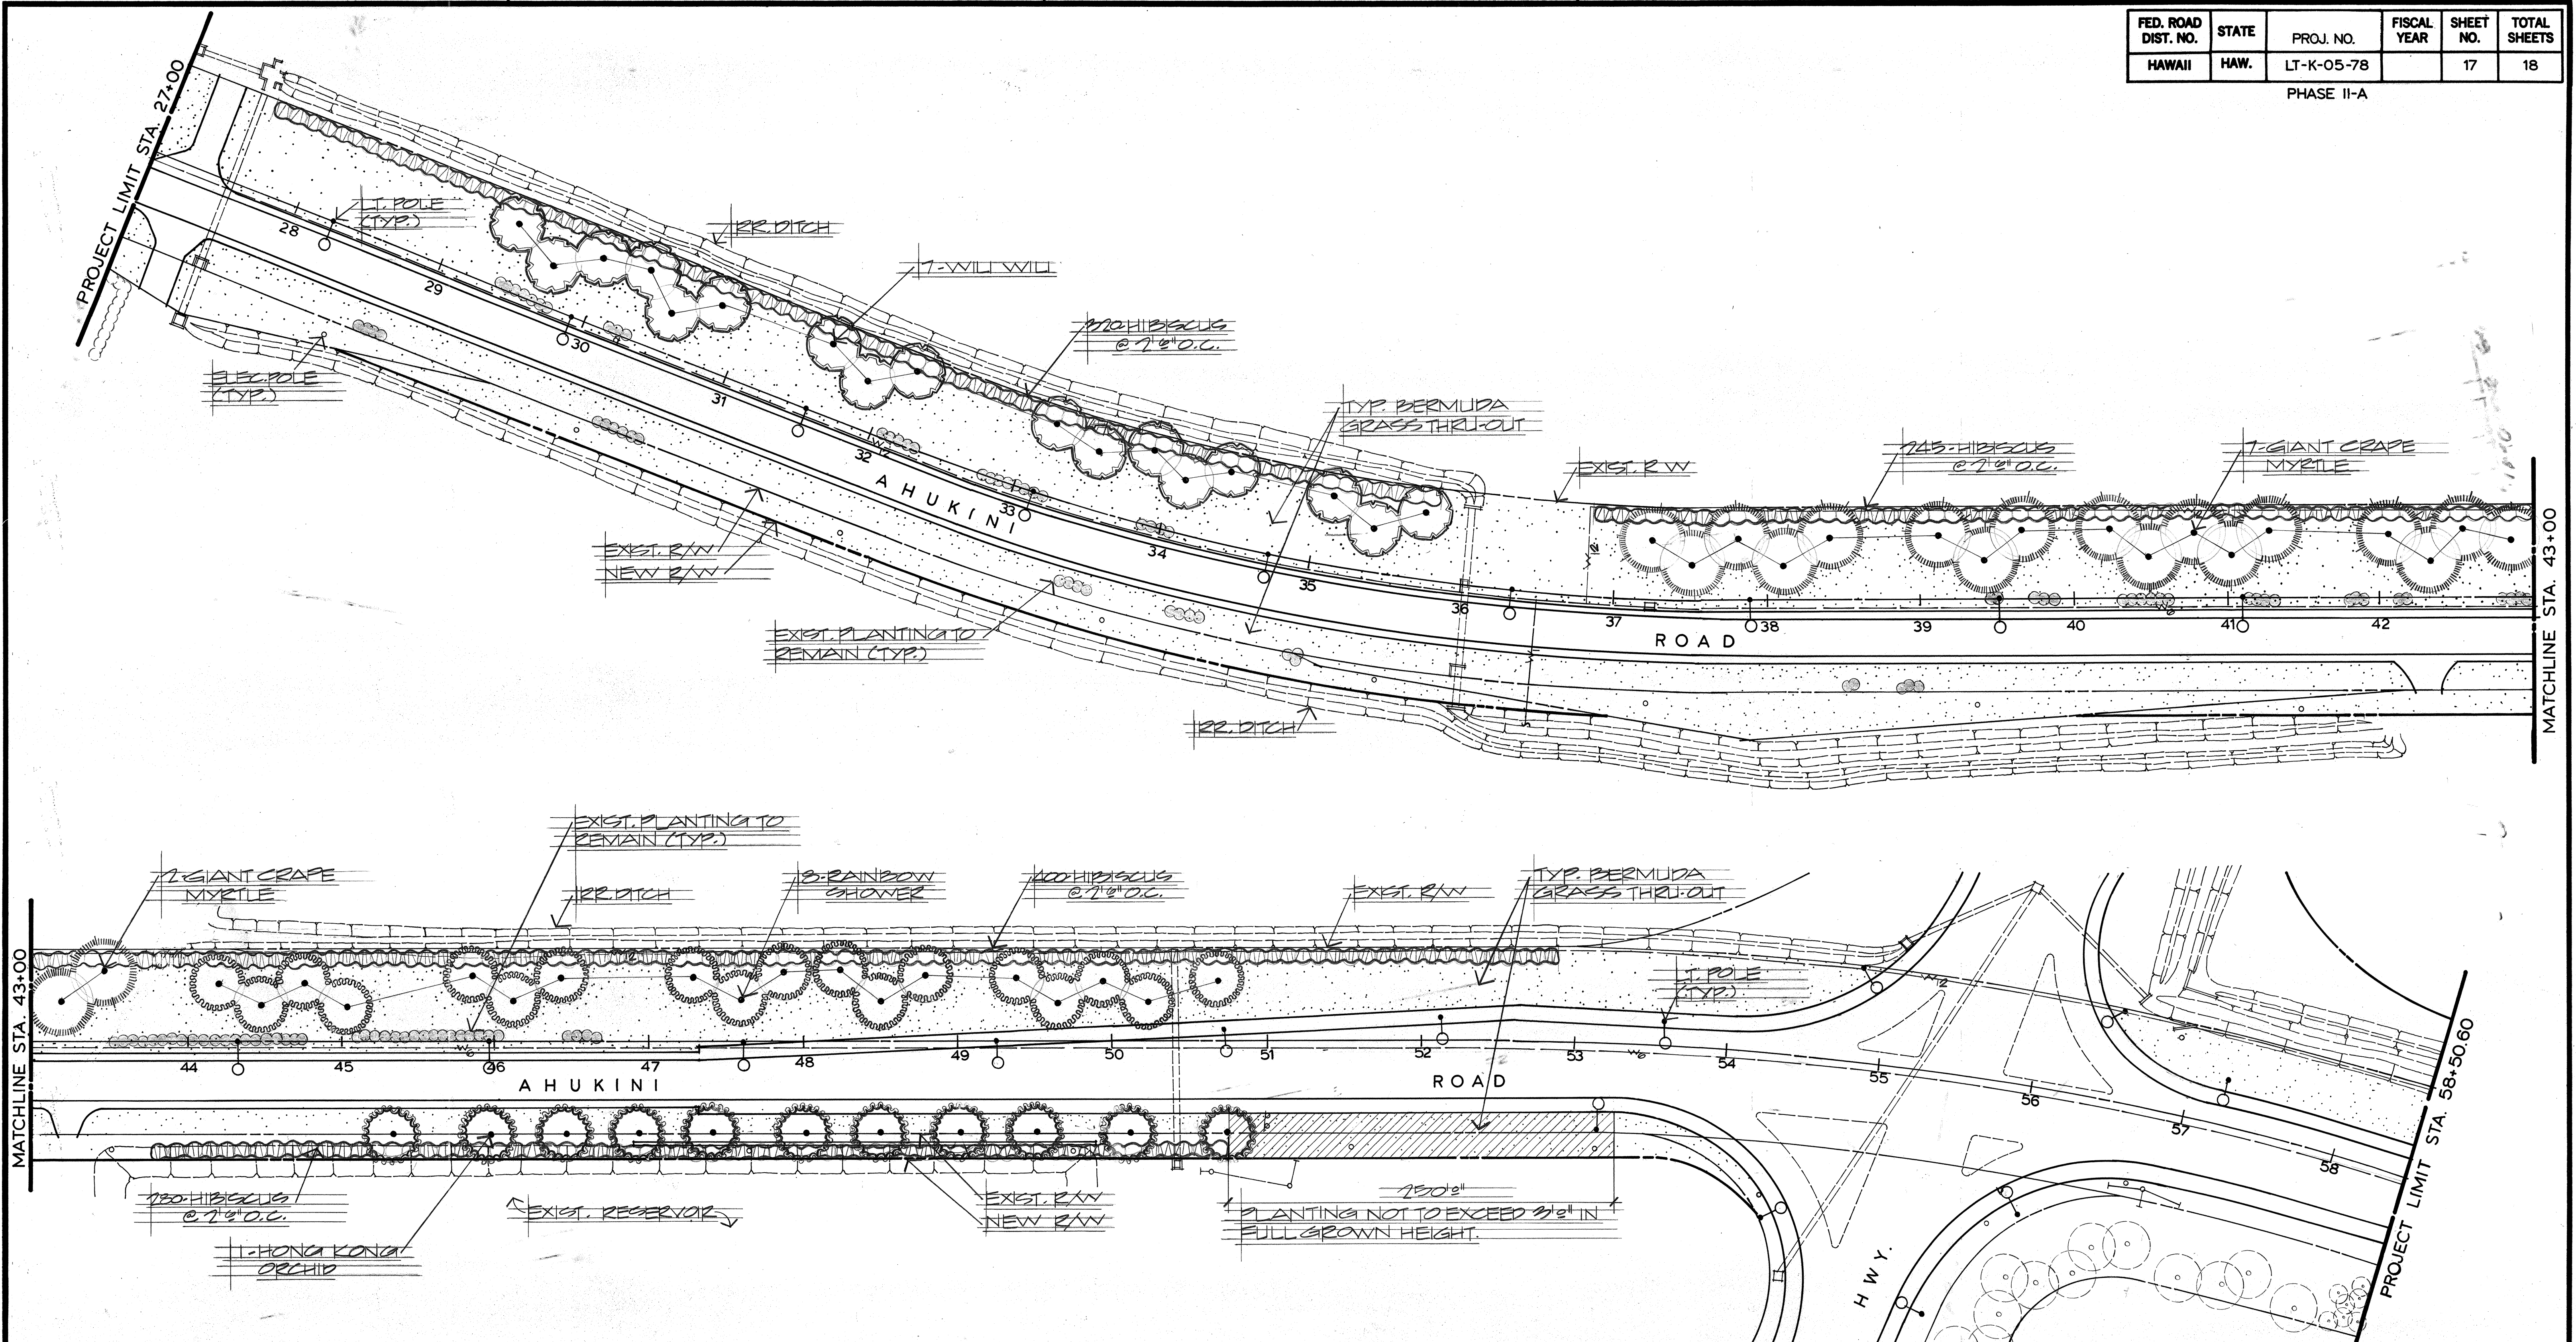


DATE	
SURVEY PLOTTED BY	
DRAWN BY	
TRACED BY	
REVISIONS BY	
CHECKED BY	
NO. BOOK	
NO.	

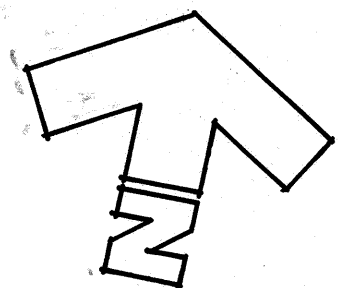

PLANTING PLAN
SCALE = 1" = 50'

(STA. 27+00 TO STA. 58+50.60)

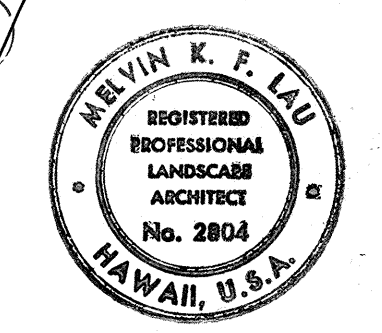

THIS WORK WAS PREPARED BY ME OR UNDER MY SUPERVISION.
Arvin K. F. Liu
Signature

STATE OF HAWAII
DEPARTMENT OF TRANSPORTATION
HIGHWAYS DIVISION

PLANTING PLAN

LIHUE AIRPORT
GATEWAY BEAUTIFICATION
PROJECT NO. LT-K-05-78 PHASE II-A

SCALE: 1" = 50' DATE:

SHEET NO. L-50F 6 SHEETS