



FED. ROAD DIST. NO.	STATE	PROJ. NO.	FISCAL YEAR	SHEET NO.	TOTAL SHEETS
HAWAII	HAW.	LT-K-05-78		3	16

PHASE II-B

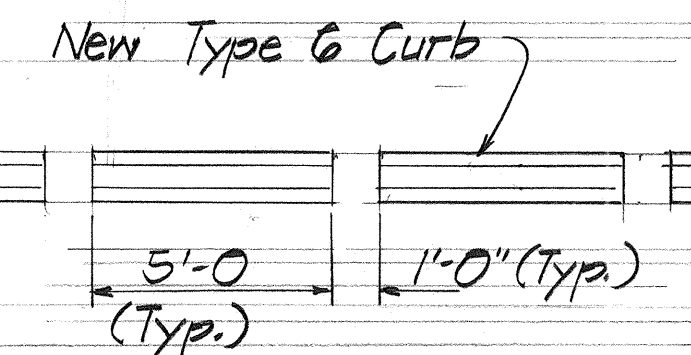

DATE	_____
DESIGNED BY	_____
CHECKED BY	_____
NOTED BY	_____
ORIGINAL PLAN	_____

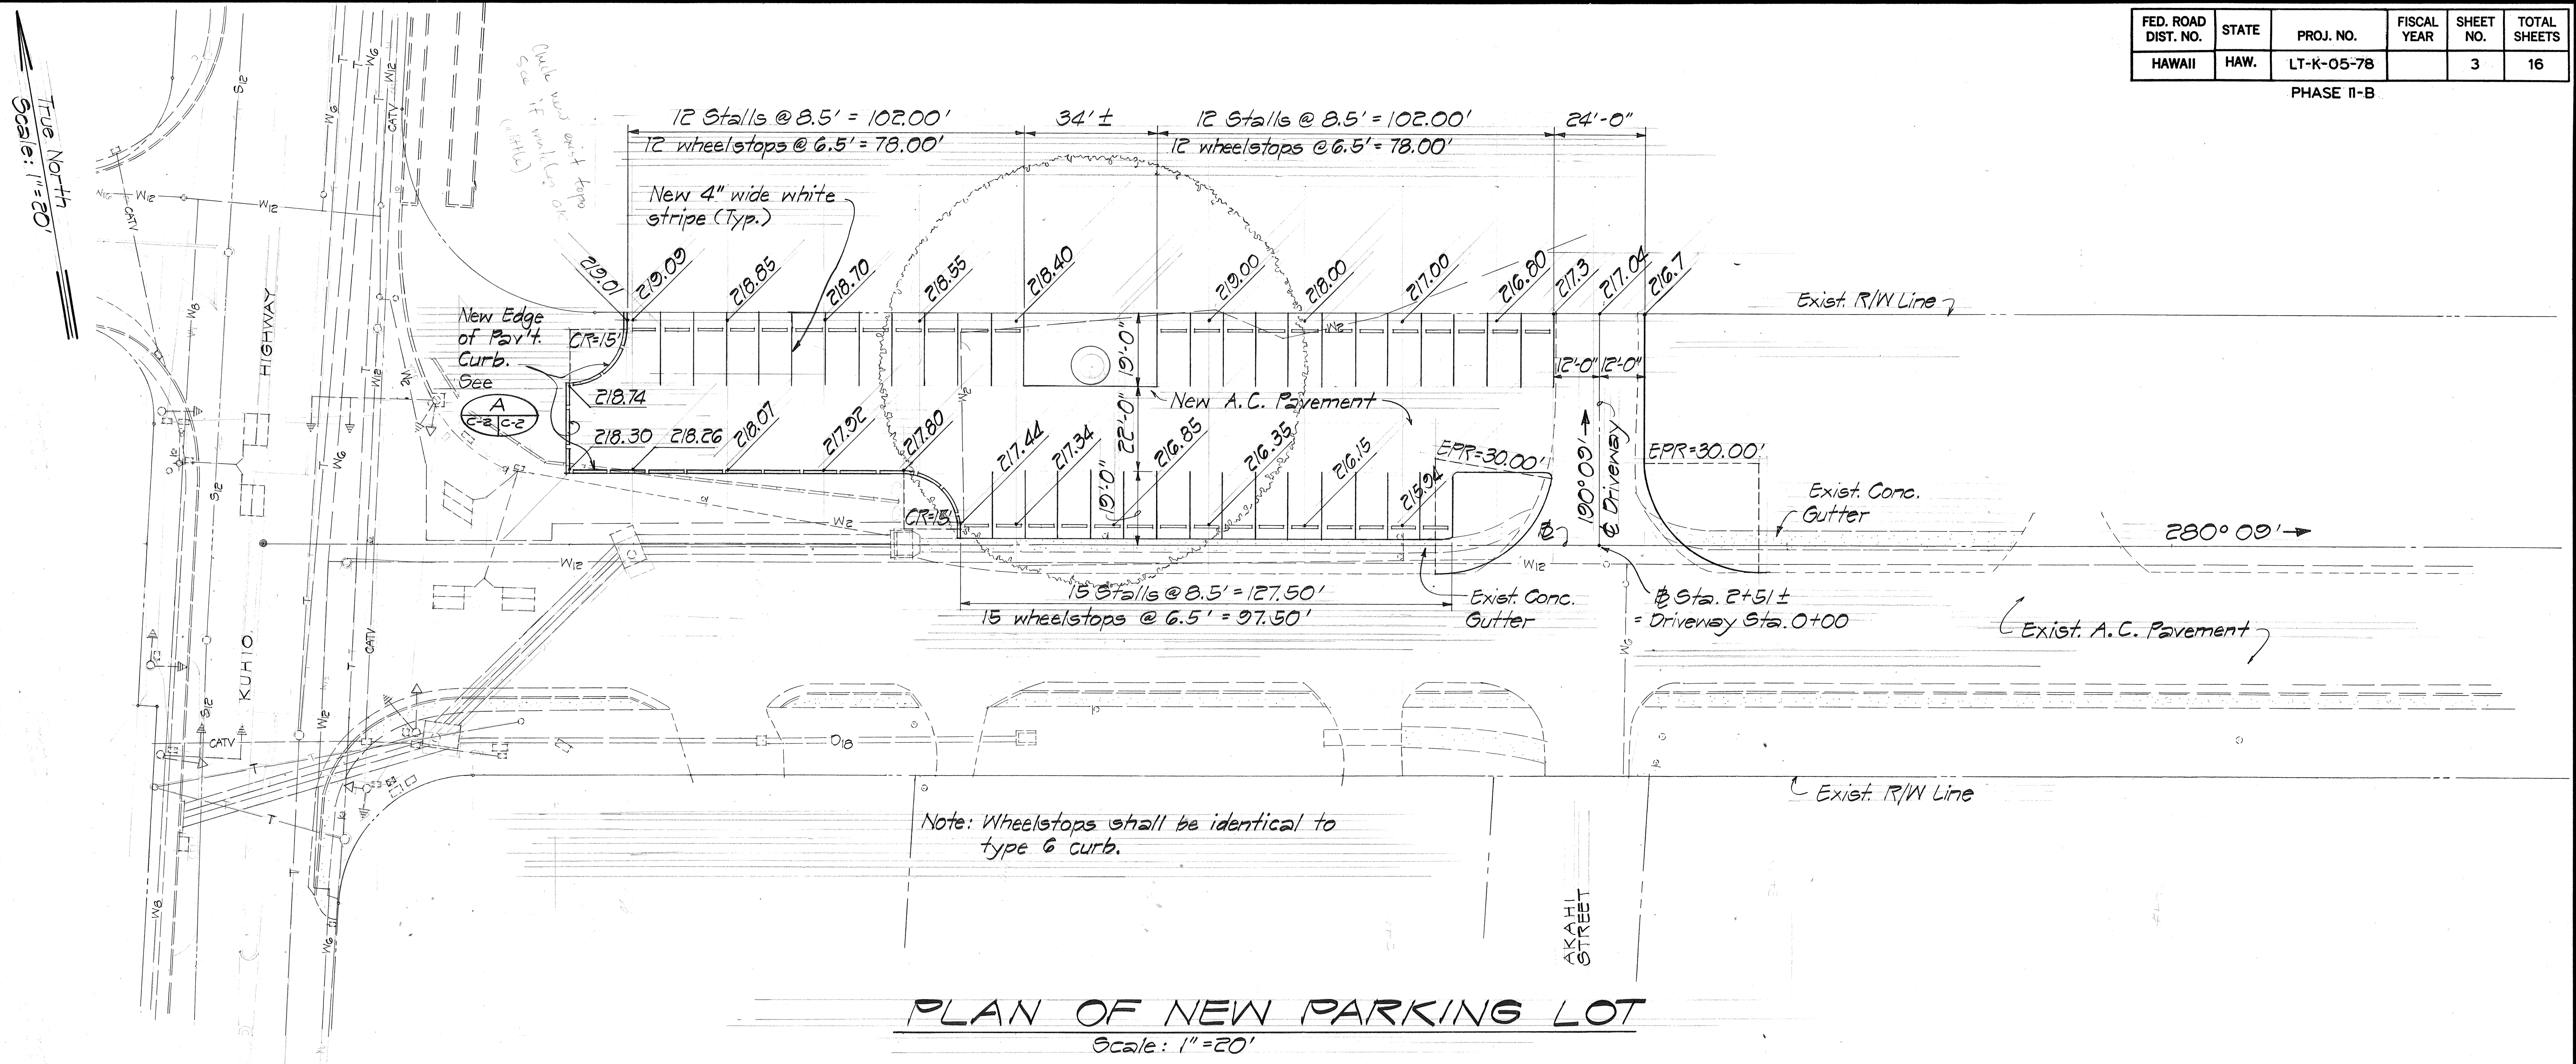

THIS WORK WAS PREPARED BY ME OR UNDER MY SUPERVISION.
Paul T. Taniguchi

STATE OF HAWAII
DEPARTMENT OF TRANSPORTATION
HIGHWAYS DIVISION

**PLAN OF NEW
PARKING LOT**
LIHUE AIRPORT
GATEWAY BEAUTIFICATION
PROJECT NO. LT-K-05-78 PHASE II-B
SCALE: AS SHOWN DATE: _____
SHEET No. C-2 OF 5 SHEETS