


FED. ROAD DIST. NO.	STATE	PROJ. NO.	FISCAL YEAR	SHEET NO.	TOTAL SHEETS
HAWAII	HAW.	570A-01-15M	2016	15	18

TRUE NORTH
SCALE: 1" = 40'

BEGIN PROJECT
KAPULE HIGHWAY
Project No. 570A-01-15M
Sta. 56+29±

END PROJECT
AHUKINI ROAD
Project No. 570-01-15m
Sta. 59+58.38±

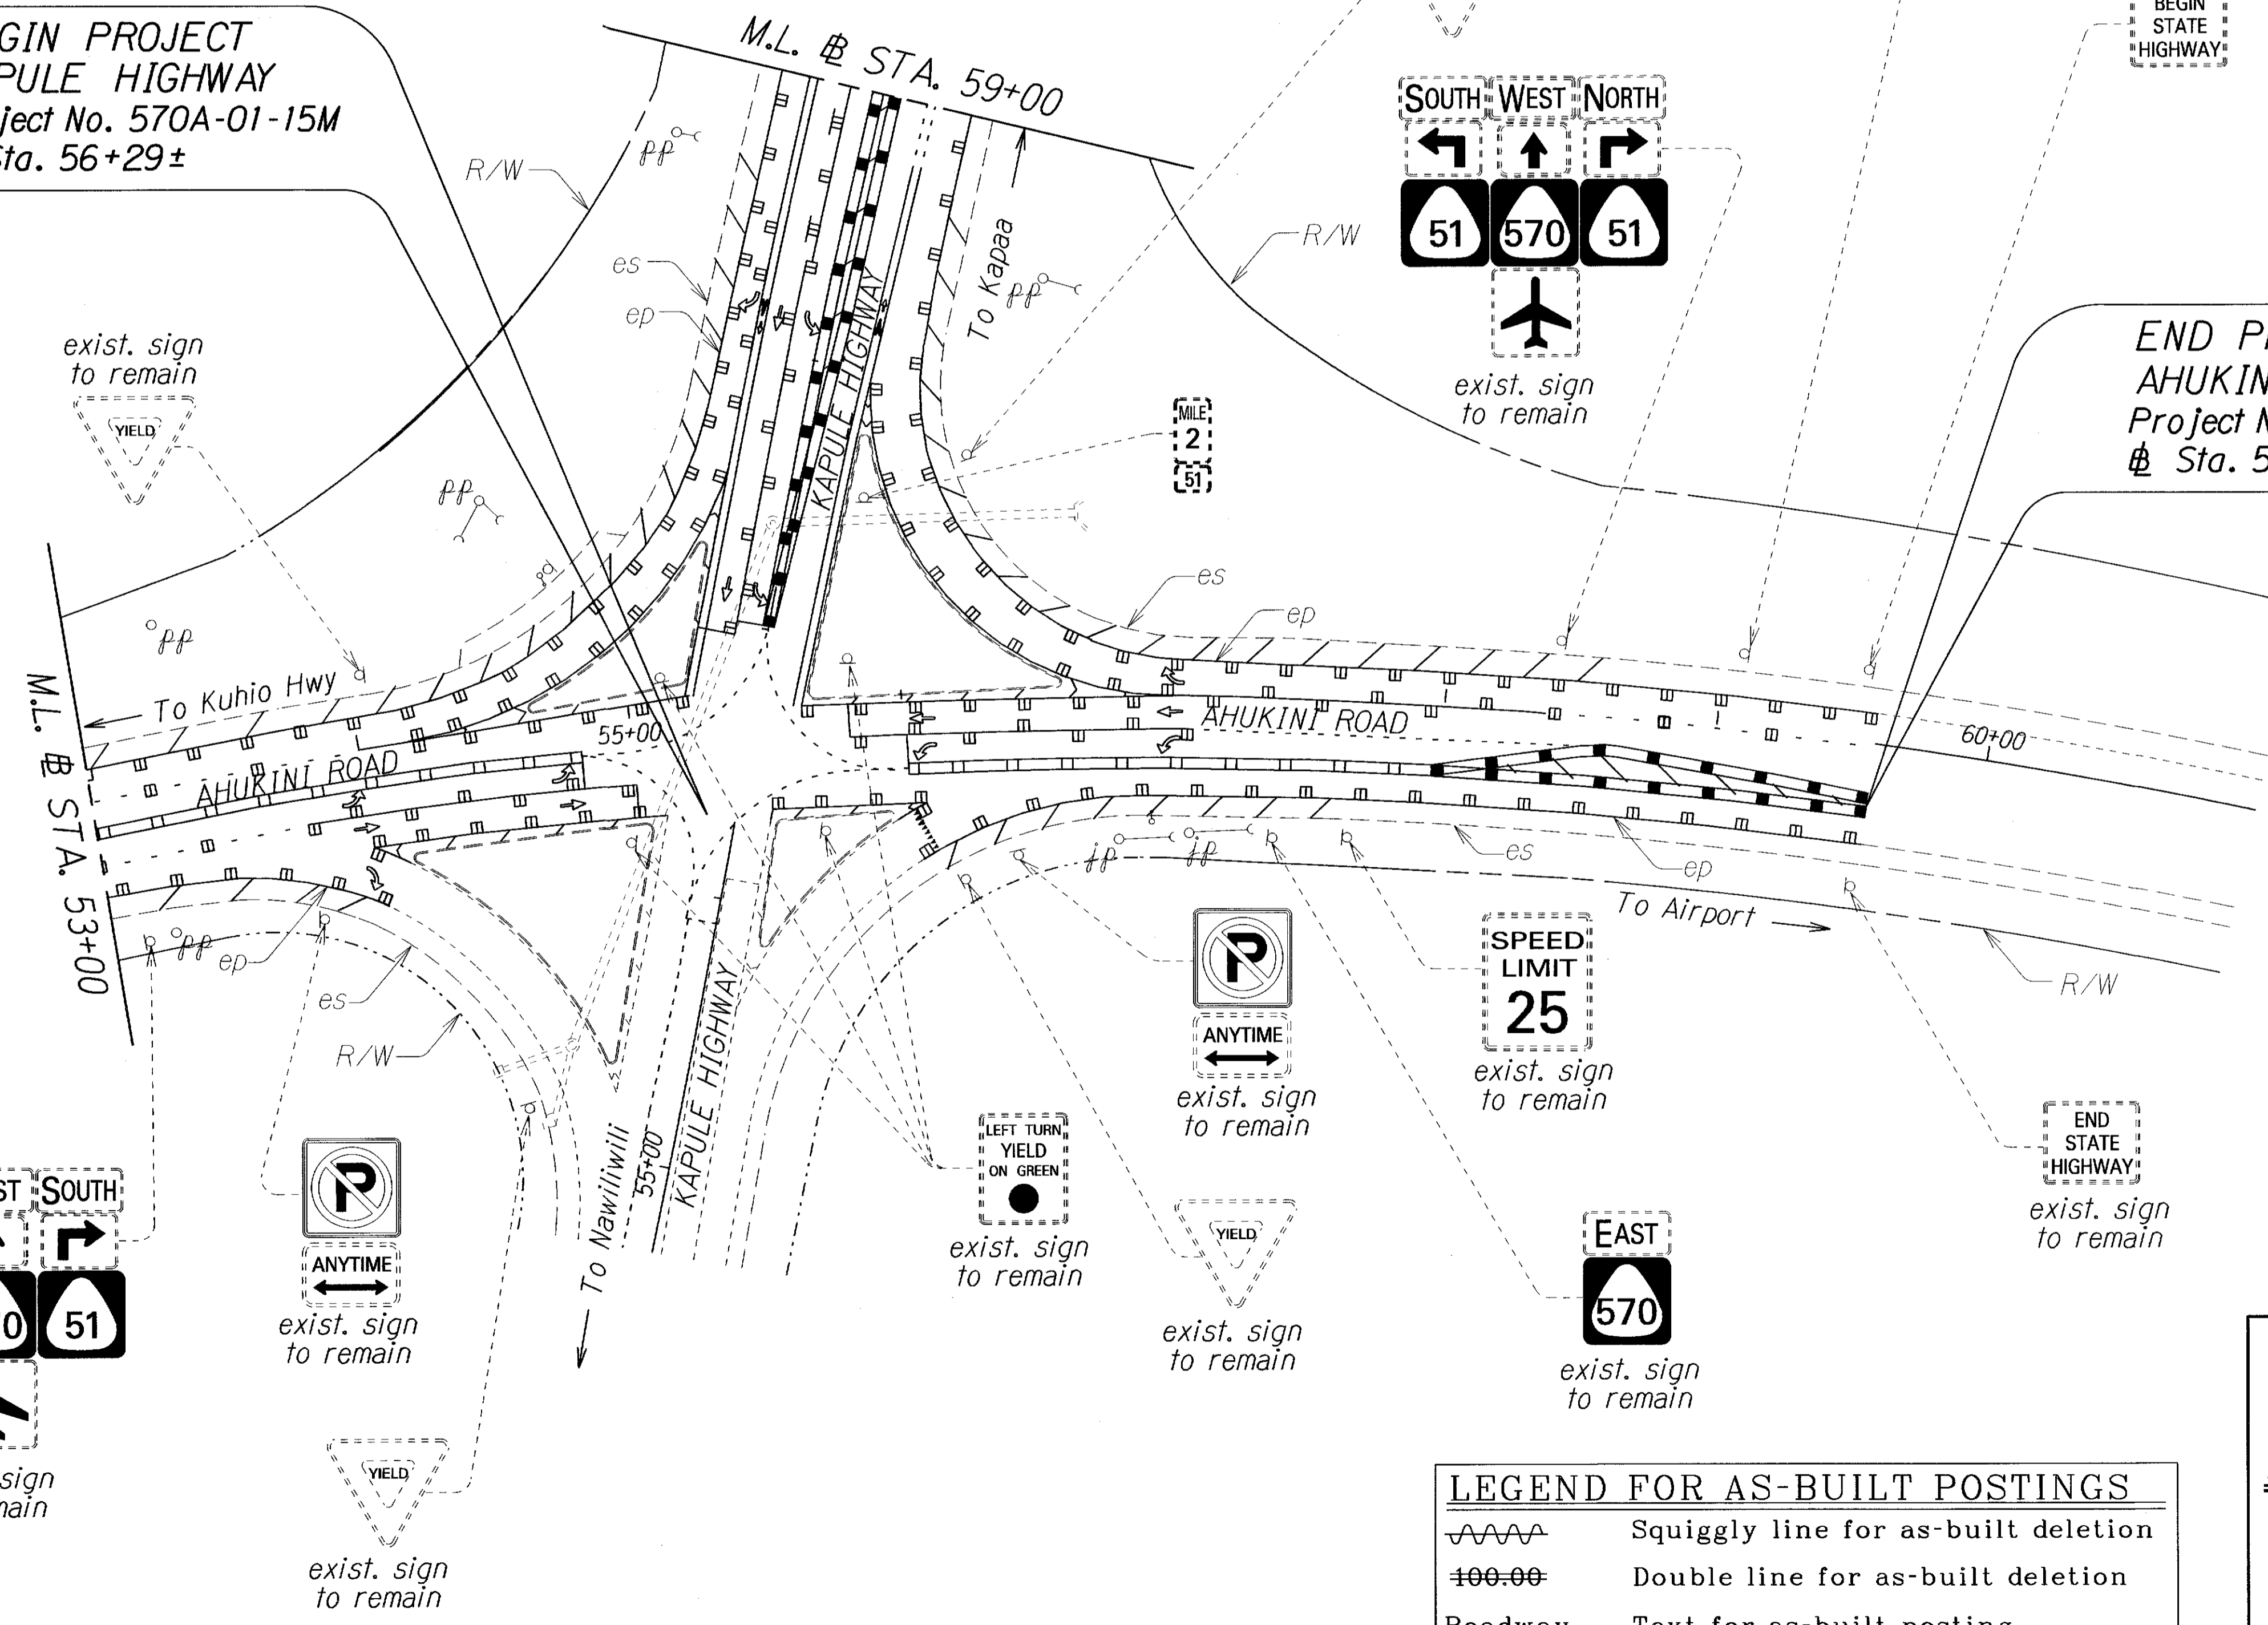

SURVEY PLOTTED BY	DATE
DESIGNED BY	
TRACED BY	
NOTED BY	
QUANTITIES BY	
CHECKED BY	

LEGEND FOR AS-BUILT POSTINGS

	Squiggly line for as-built deletion
	Double line for as-built deletion
Roadway	Text for as-built posting

STATE OF HAWAII
DEPARTMENT OF TRANSPORTATION
HIGHWAYS DIVISION

**PAVEMENT MARKING
AND TRAFFIC SIGNING PLAN**


AHUKINI ROAD RESURFACING
Vicinity of Kapule Highway
Proj. No. 570A-01-15M
Scale: 1"=40' Date: April 2015

SHEET No. 73 OF 4 SHEETS

"AS-BUILT"

FED. ROAD DIST. NO.	STATE	PROJ. NO.	FISCAL YEAR	SHEET NO.	TOTAL SHEETS
HAWAII	HAW.	570A-01-15M	2016	16	18

TRUE NORTH
SCALE: 1" = 40'

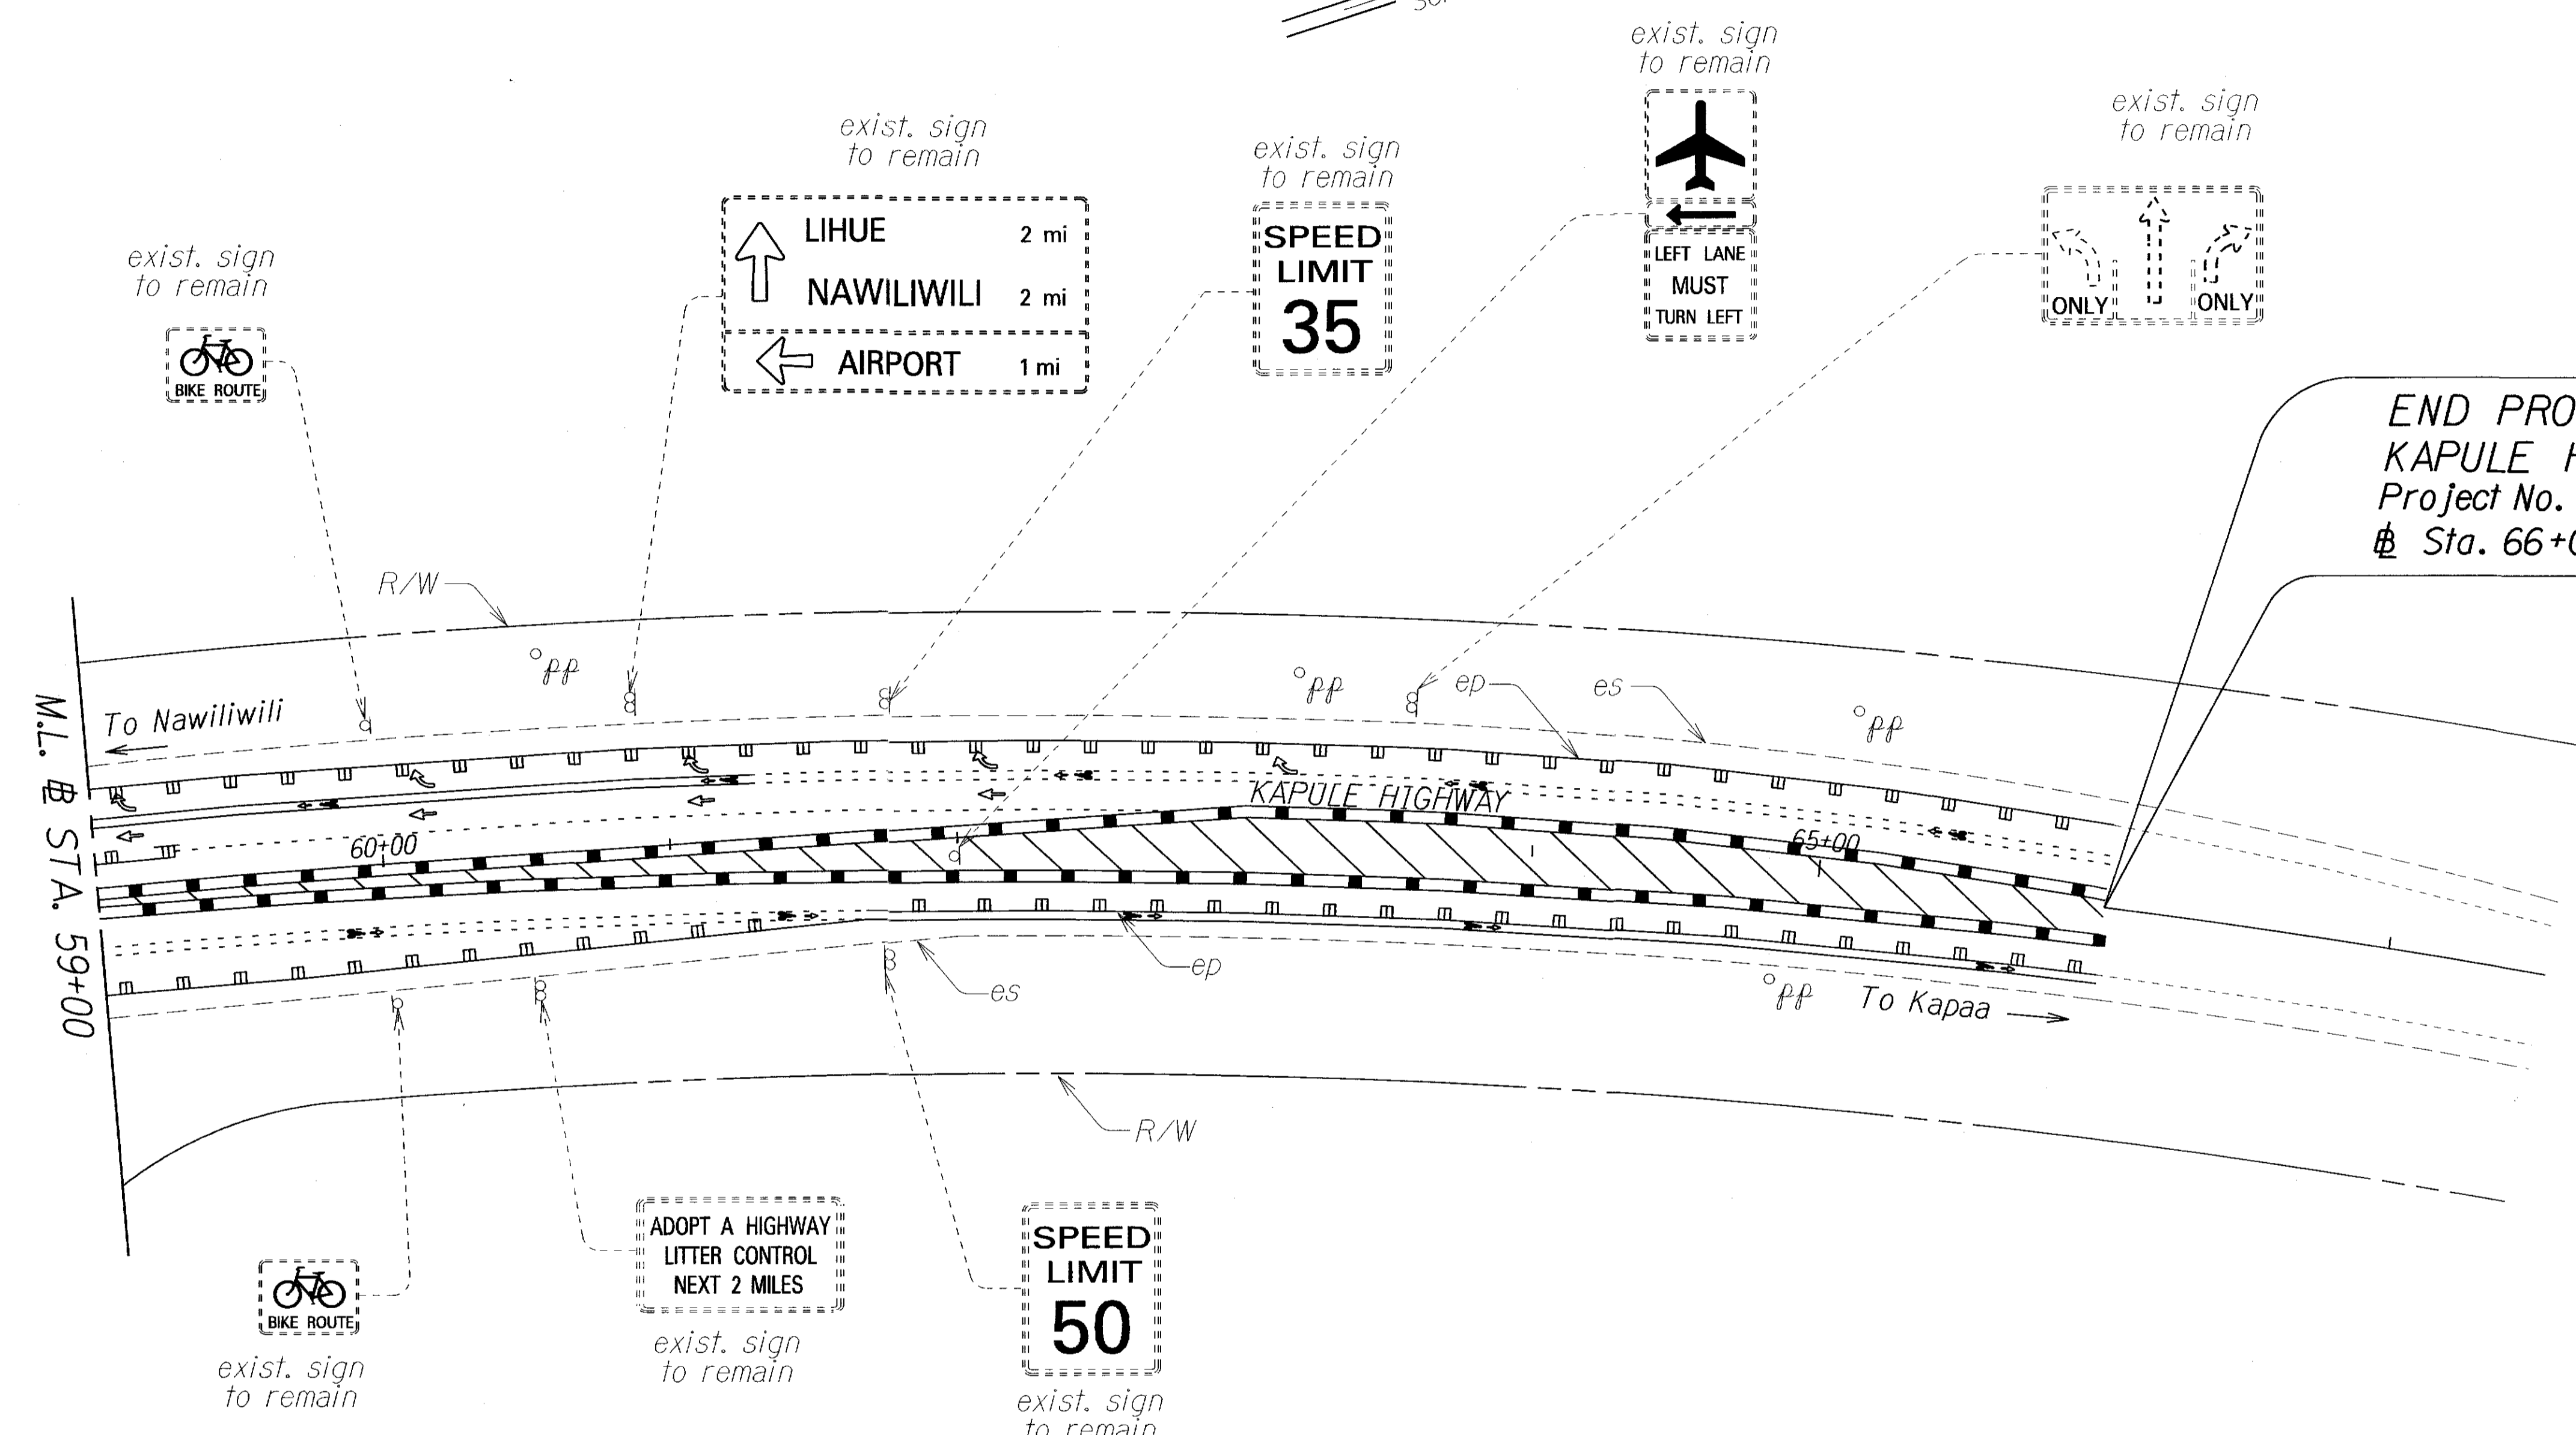

END PROJECT
KAPULE HIGHWAY
Project No. 570A-01-15M
Sta. 66+00±

ORIGINAL PLAN	DATE
SURVEY PLOTTED BY	
TRACED BY	
DESIGNED BY	
QUANTITIES BY	
CHECKED BY	

LEGEND FOR AS-BUILT POSTINGS

	Squiggly line for as-built deletion
	Double line for as-built deletion
Roadway	Text for as-built posting

STATE OF HAWAII
DEPARTMENT OF TRANSPORTATION
HIGHWAYS DIVISION

**PAVEMENT MARKING
AND TRAFFIC SIGNING PLAN**

AHUKINI ROAD RESURFACING
Vicinity of Kapule Highway
Proj. No. 570A-01-15M
Scale: 1"=40' Date: April 2015

SHEET No. 74 OF 4 SHEETS

"AS-BUILT"