


FED. ROAD DIST. NO.	STATE	PROJ. NO.	FISCAL YEAR	SHEET NO.	TOTAL SHEETS
HAWAII	HAW.	570A-01-15M	2016	10	18

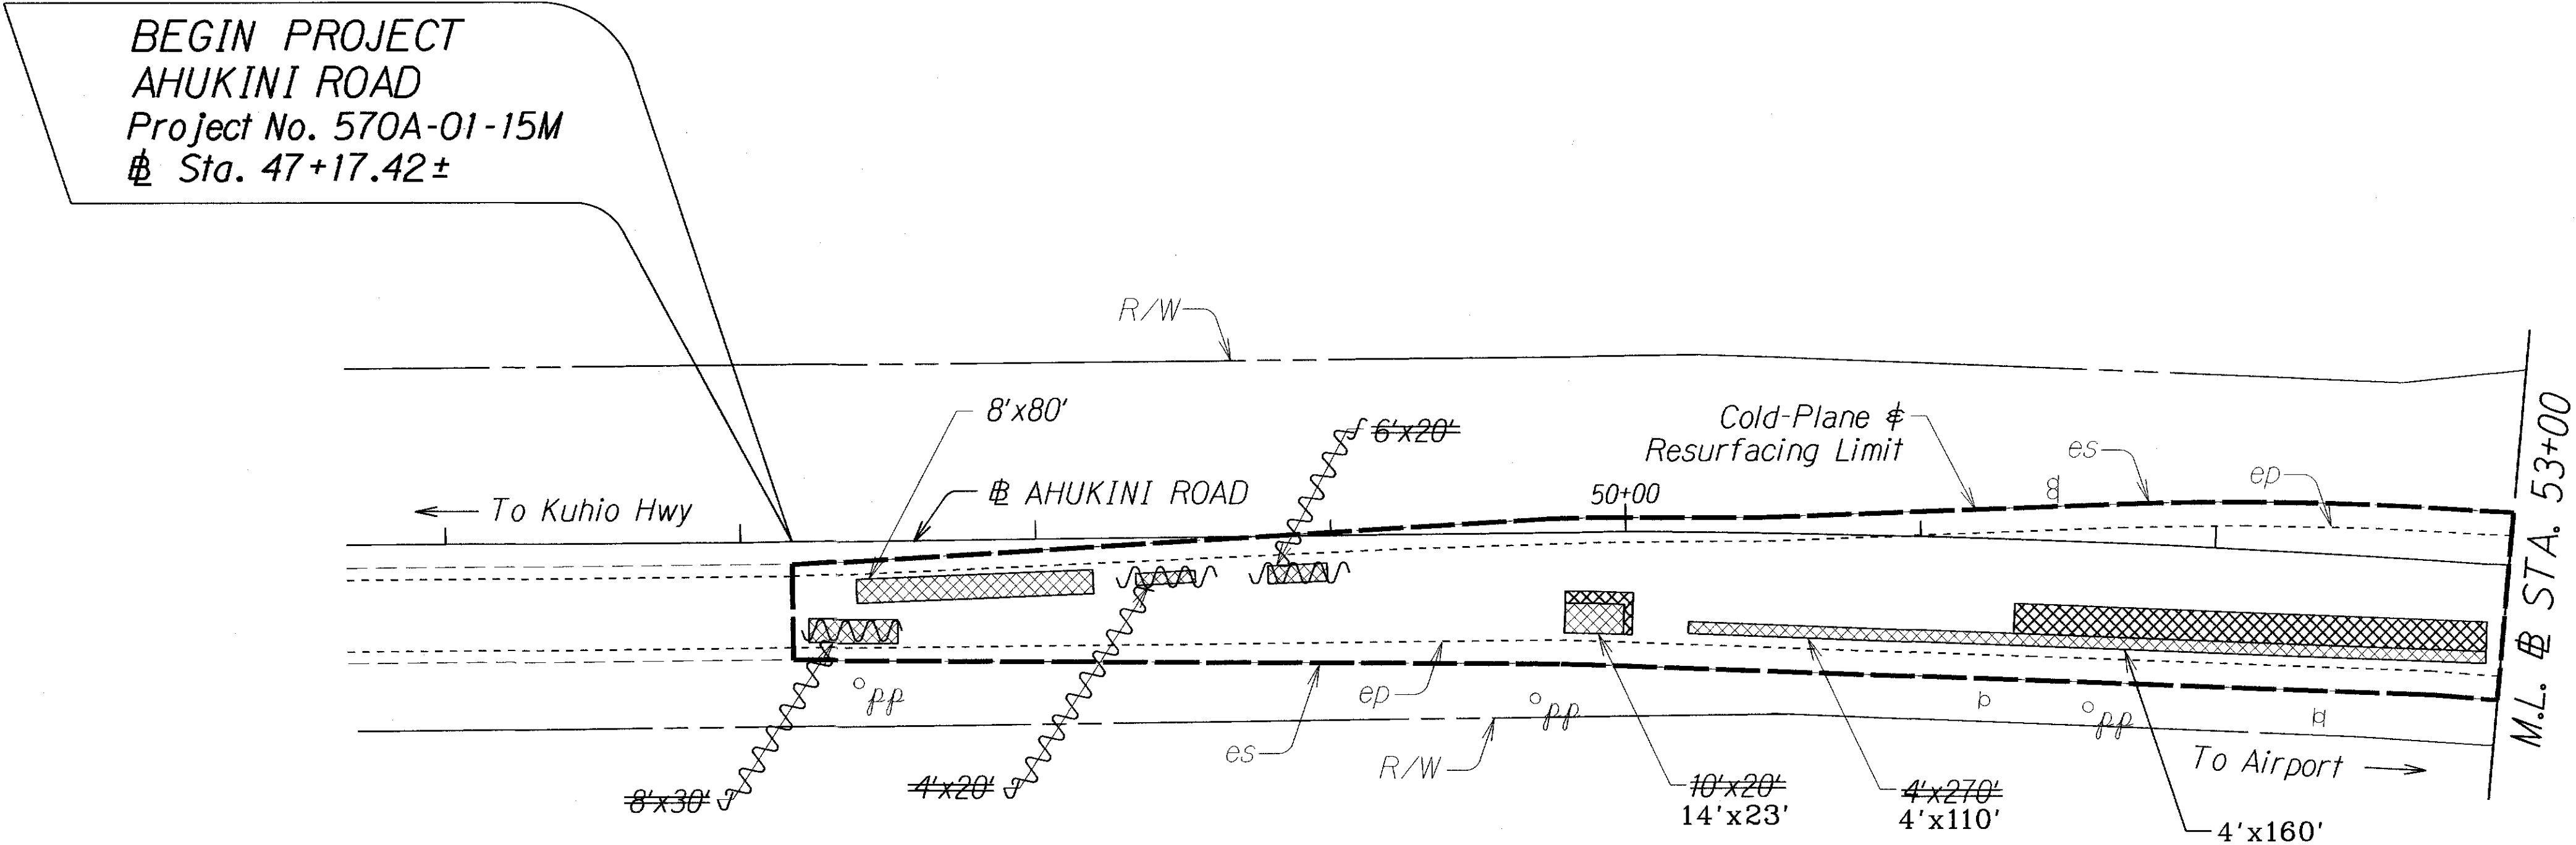

SURVEY PLOTTED BY	DATE
DRAWN BY	
DESIGNED BY	
QUANTITIES BY	
CHECKED BY	

LEGEND FOR AS-BUILT POSTINGS	
	Squiggly line for as-built deletion
	Double line for as-built deletion
Roadway	Text for as-built posting

STATE OF HAWAII
DEPARTMENT OF TRANSPORTATION
HIGHWAYS DIVISION

ROADWAY PLAN

AHUKINI ROAD RESURFACING


Vicinity of Kapule Highway

Proj. No. 570A-01-15M

Scale: 1"=40' Date: April 2015

SHEET No. 1 OF 3 SHEETS

FED. ROAD DIST. NO.	STATE	PROJ. NO.	FISCAL YEAR	SHEET NO.	TOTAL SHEETS
HAWAII	HAW.	570A-01-15M	2016	11	18

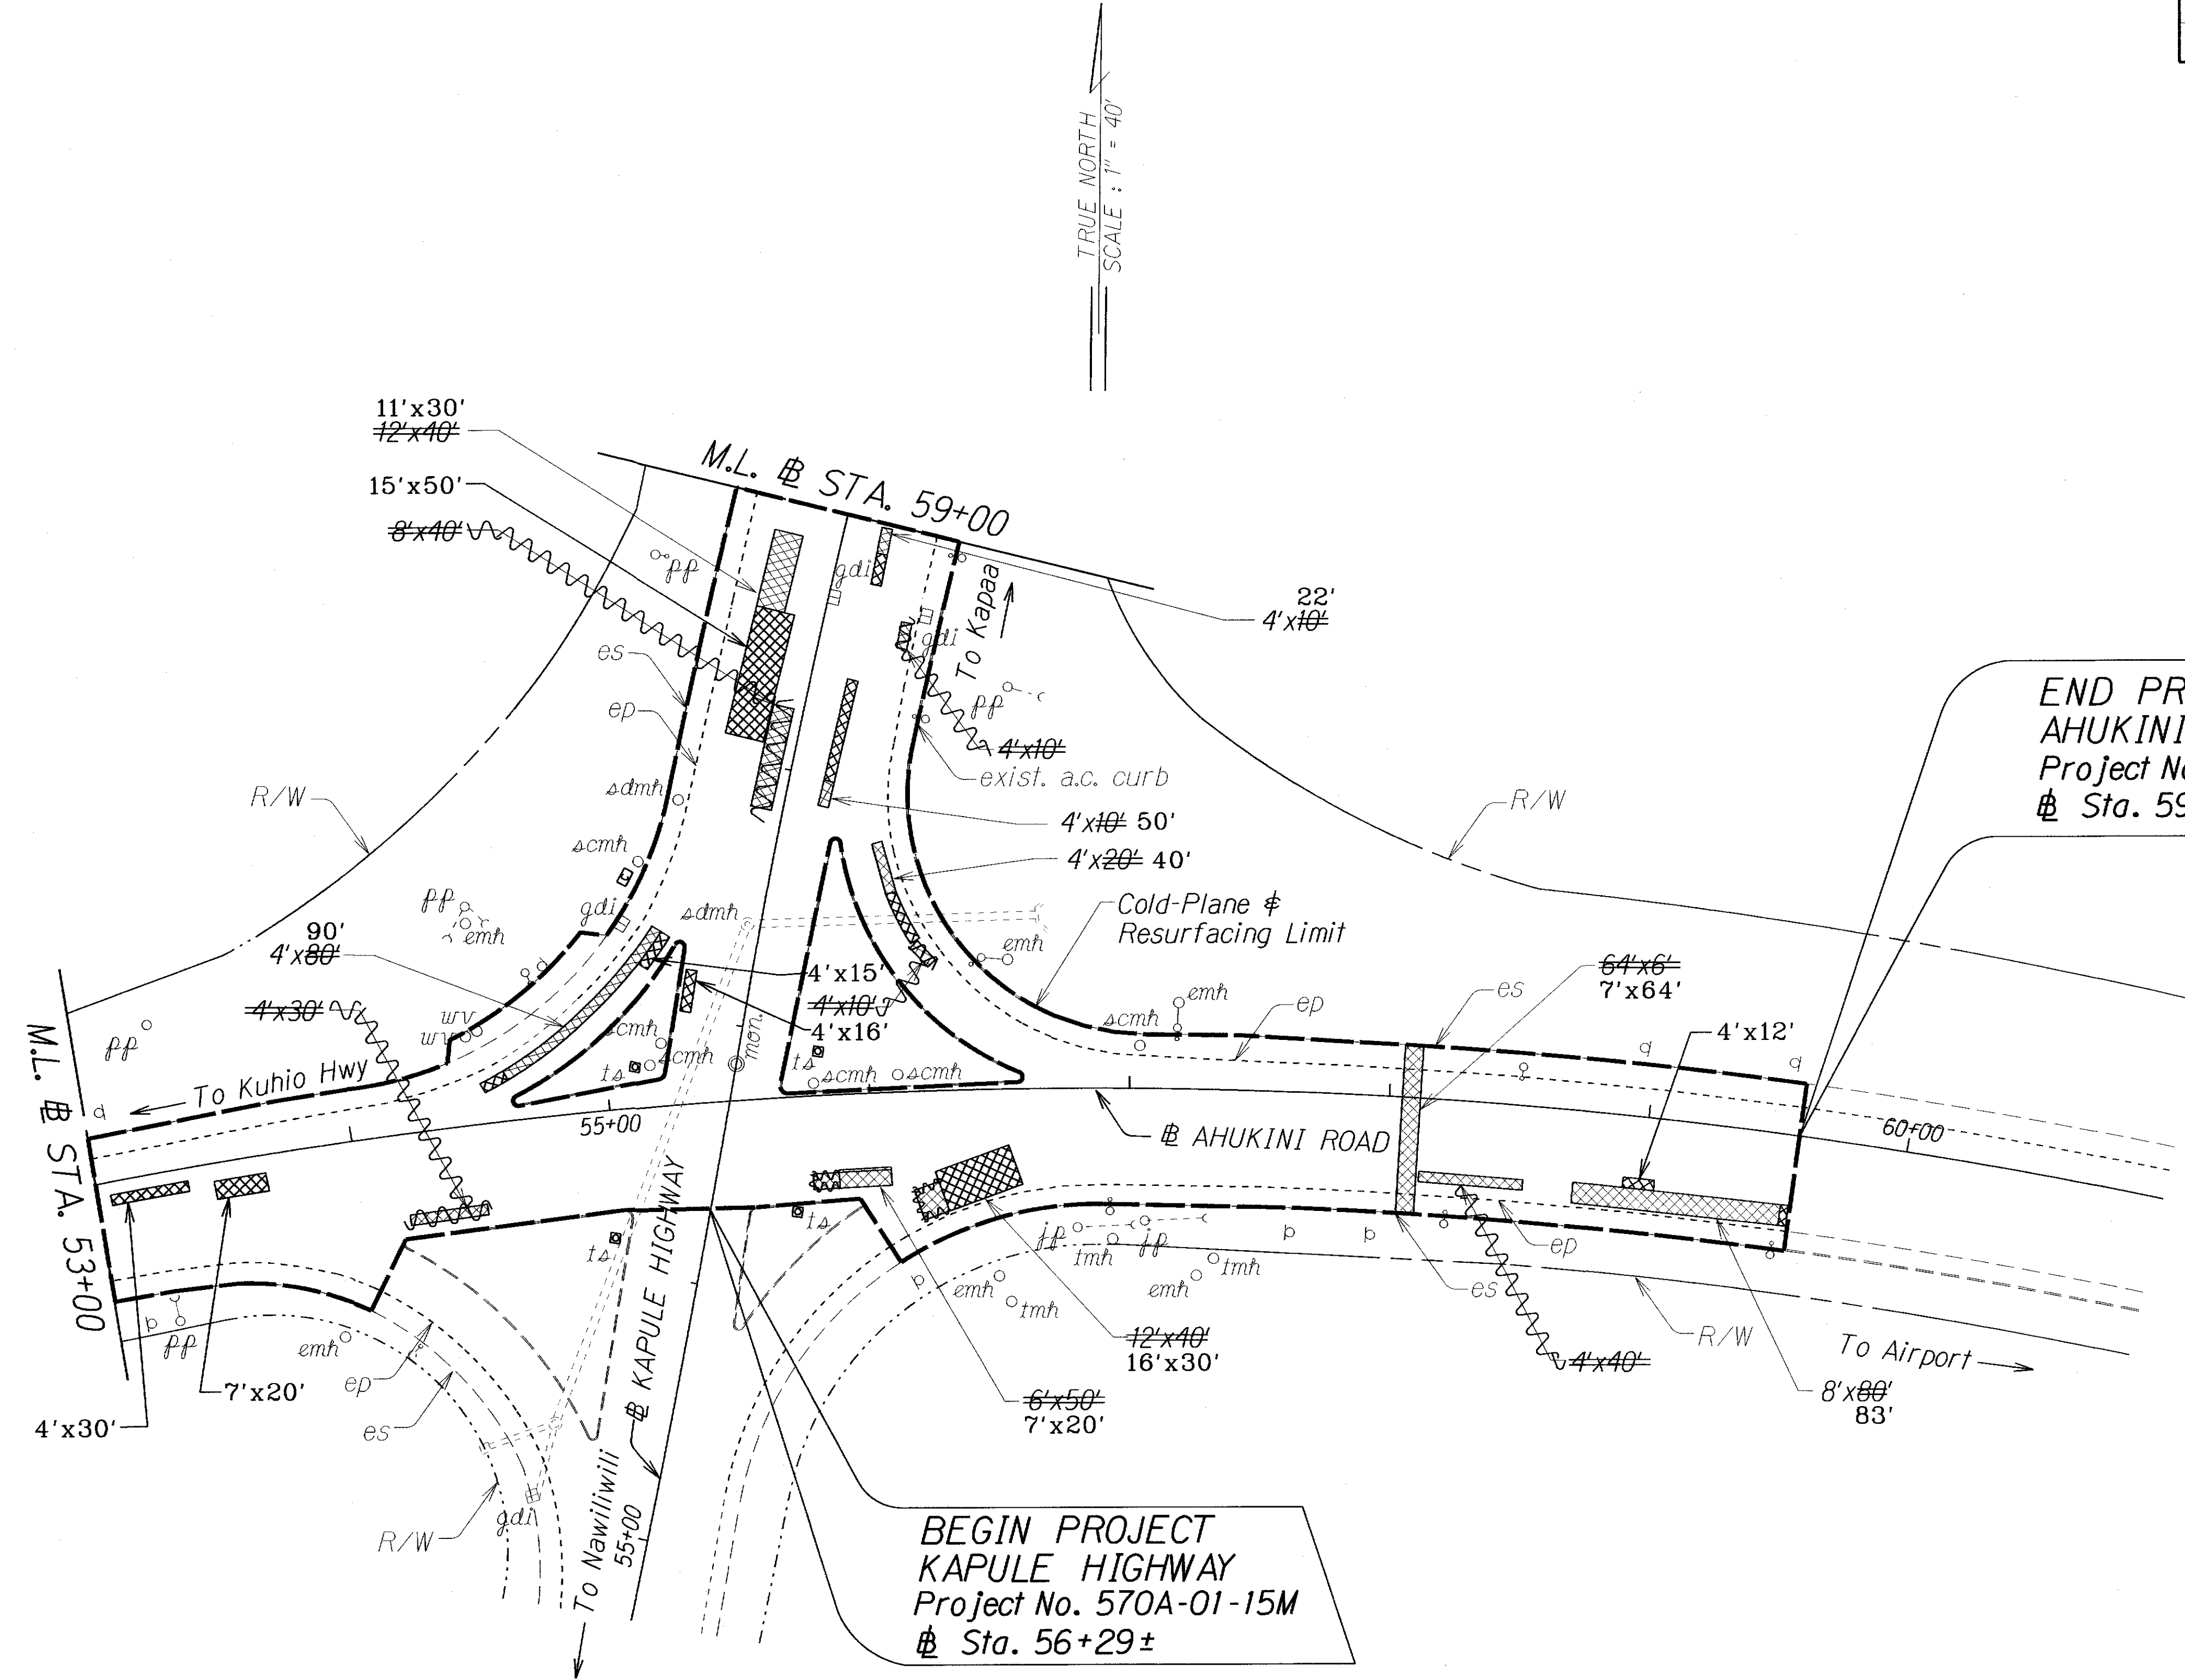

END PROJECT
AHUKINI ROAD
Project No. 570A-01-15M
Sta. 59+58.38±

BEGIN PROJECT
KAPULE HIGHWAY
Project No. 570A-01-15M
Sta. 56+29±

LEGEND FOR AS-BUILT POSTINGS	
	Squiggly line for as-built deletion
	Double line for as-built deletion
Roadway	Text for as-built posting

STATE OF HAWAII
DEPARTMENT OF TRANSPORTATION
HIGHWAYS DIVISION

ROADWAY PLAN

AHUKINI ROAD RESURFACING
Vicinity of Kapule Highway
Proj. No. 570A-01-15M


Scale: 1"=40' Date: April 2015

SHEET No. 2 OF 3 SHEETS

ORIGINAL PLAN	SURVEY PLOTTED BY	DATE
NOTE BOOK	DRAWN BY	
DESIGNED BY	CHECKED BY	
CHECKED BY		

"AS-BUILT"

FED. ROAD DIST. NO.	STATE	PROJ. NO.	FISCAL YEAR	SHEET NO.	TOTAL SHEETS
HAWAII	HAW.	570A-01-15M	2016	12	18

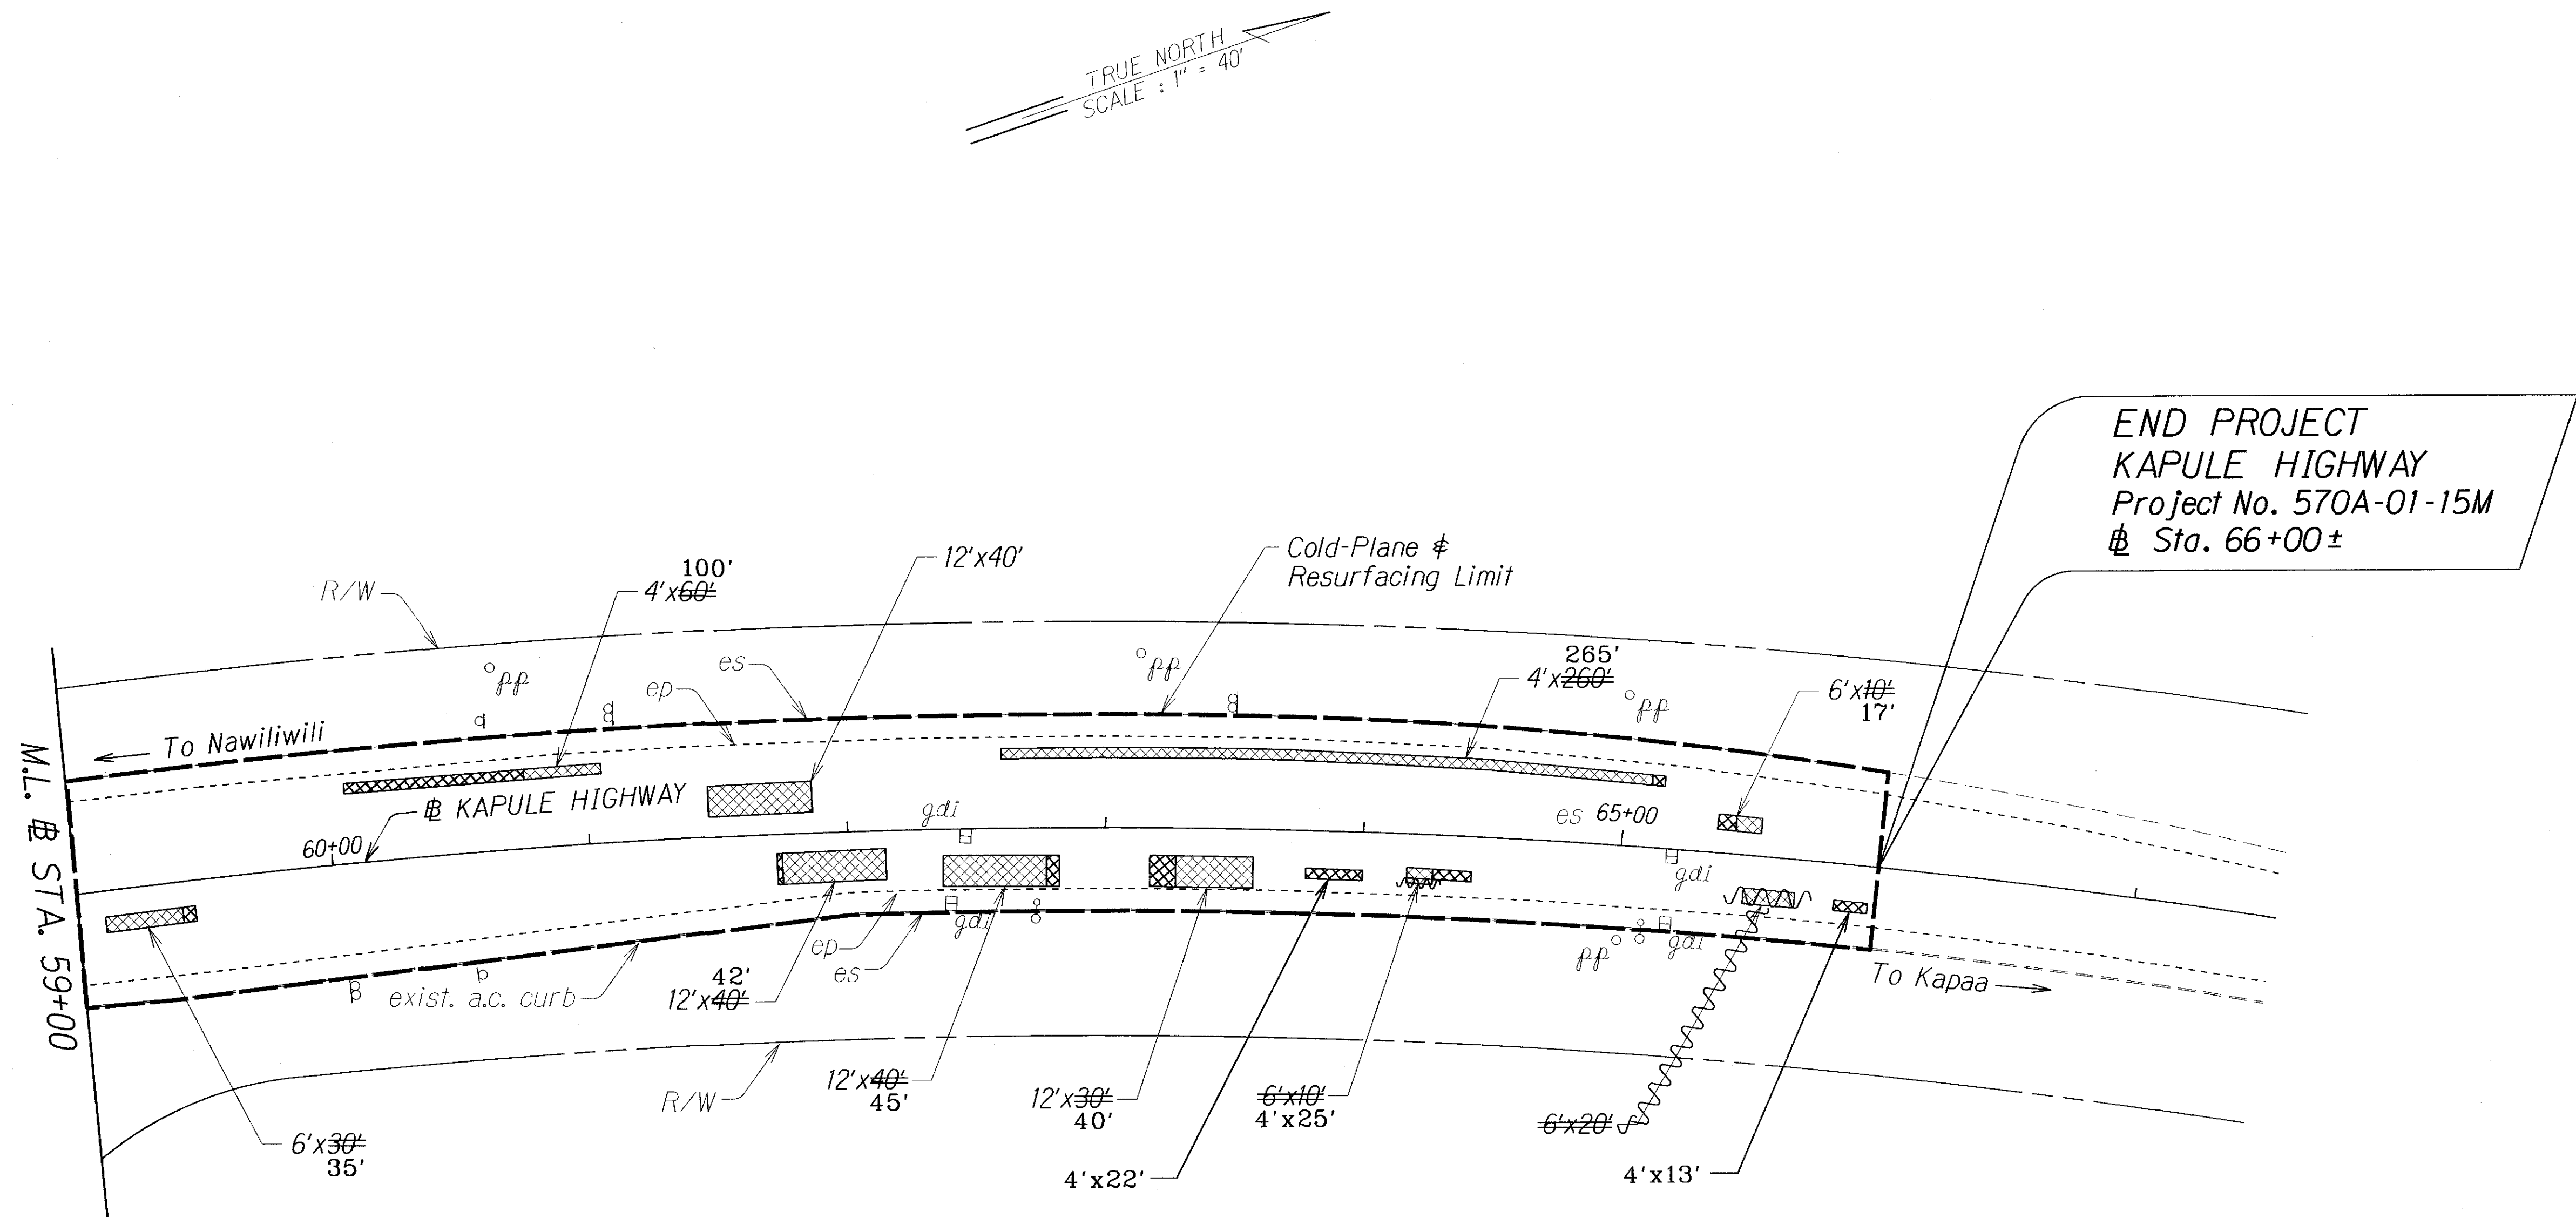

ORIGINAL PLAN	SURVEY PLOTTED BY	DATE
NOTED BOOK	DRAWN BY	
3/2/01/03/09	DESIGNED BY	
N	QUANTITIES BY	
	CHECKED BY	

LEGEND FOR AS-BUILT POSTINGS	
	Squiggly line for as-built deletion
	Double line for as-built deletion
Roadway	Text for as-built posting

STATE OF HAWAII DEPARTMENT OF TRANSPORTATION HIGHWAYS DIVISION	
ROADWAY PLAN	
AHUKINI ROAD RERSURFACING	
Vicinity of Kapule Highway	
Proj. No. 570A-01-15M	
Scale: 1"=40'	Date: April 2015
SHEET No. 3 OF 3 SHEETS	

"AS-BUILT"