



| FED. ROAD DIST. NO. | STATE | PROJ. NO.   | FISCAL YEAR | SHEET NO. | TOTAL SHEETS |
|---------------------|-------|-------------|-------------|-----------|--------------|
| HAWAII              | HAW.  | 570A-01-15M | 2016        | 7         | 18           |

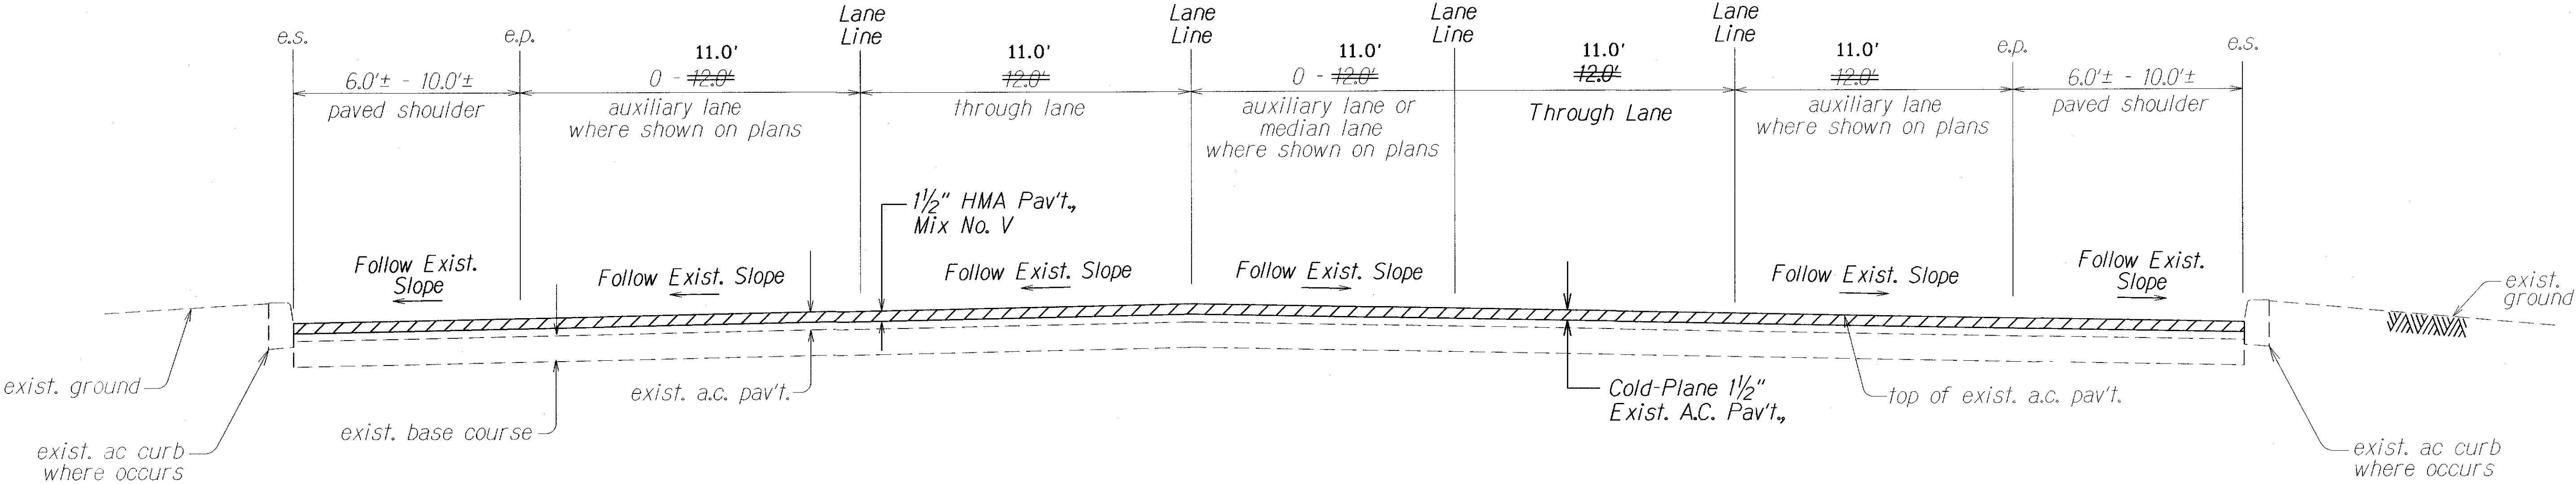

**TYPICAL SECTION AT KAPULE HIGHWAY**  
*Not to scale*

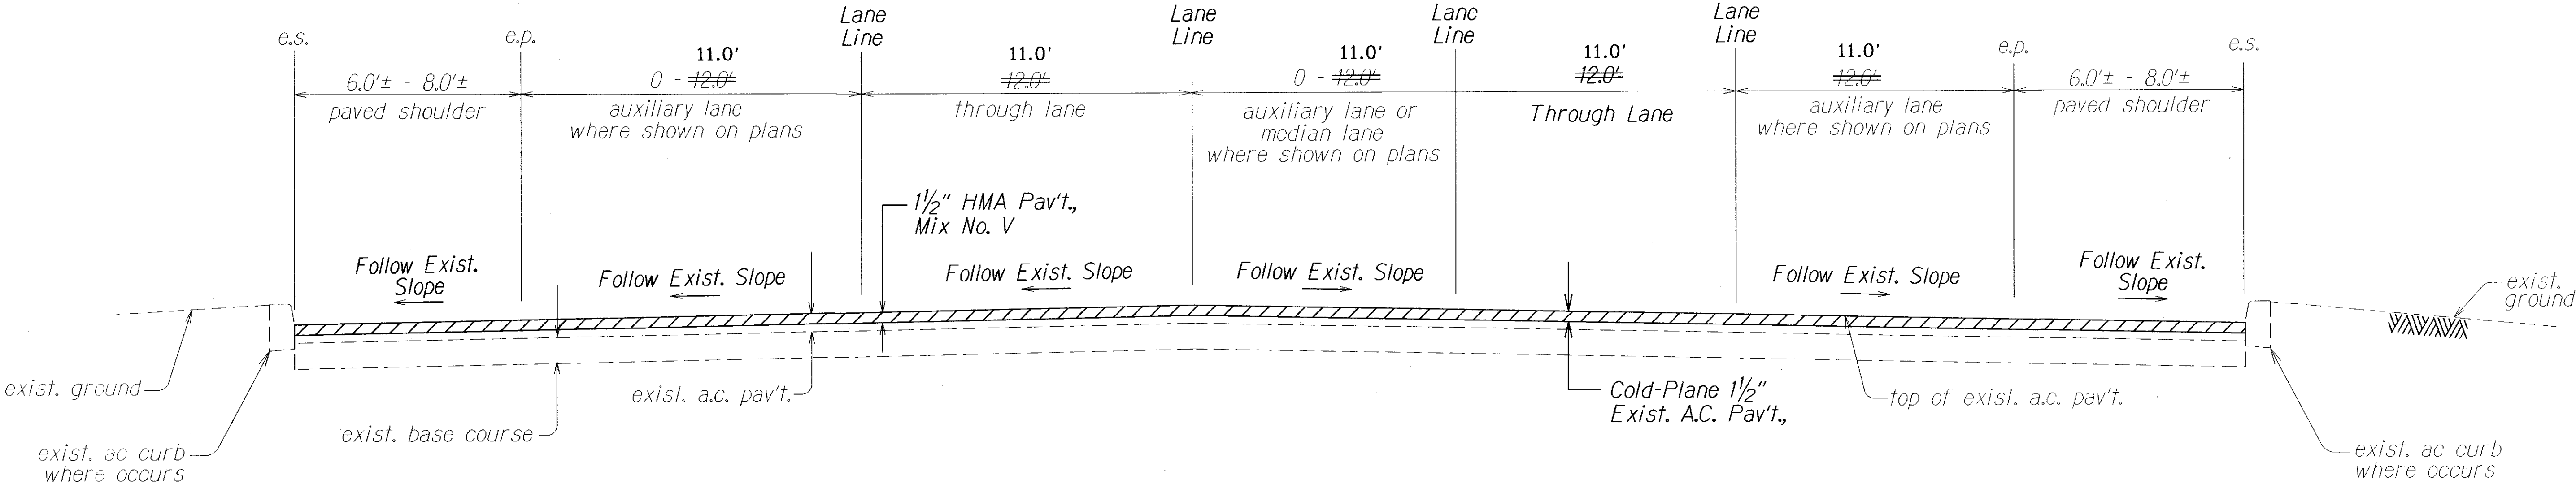

**TYPICAL SECTION AT AHUKINI ROAD**  
*Not to scale*

| LEGEND FOR AS-BUILT POSTINGS |                                     |
|------------------------------|-------------------------------------|
|                              | Squiggly line for as-built deletion |
|                              | Double line for as-built deletion   |
| Roadway                      | Text for as-built posting           |


STATE OF HAWAII  
DEPARTMENT OF TRANSPORTATION  
HIGHWAYS DIVISION

**TYPICAL SECTIONS**  
**AHUKINI ROAD RESURFACING**  
**Vicinity of Kapule Highway**  
**Project No. 570A-01-15M**  
*Not to scale*

Date: April 2015  
SHEET No. 1 OF 3 SHEETS


|                   |      |
|-------------------|------|
| SURVEY PLOTTED BY | DATE |
| DRAWN BY          |      |
| DESIGNED BY       |      |
| QUANTITIES BY     |      |
| CHECKED BY        |      |
| ORIGINAL PLAN     |      |
| NOTE BOOK         |      |
| No.               |      |

| FED. ROAD DIST. NO. | STATE | PROJ. NO.   | FISCAL YEAR | SHEET NO. | TOTAL SHEETS |
|---------------------|-------|-------------|-------------|-----------|--------------|
| HAWAII              | HAW.  | 570A-01-15M | 2016        | 8         | 17           |

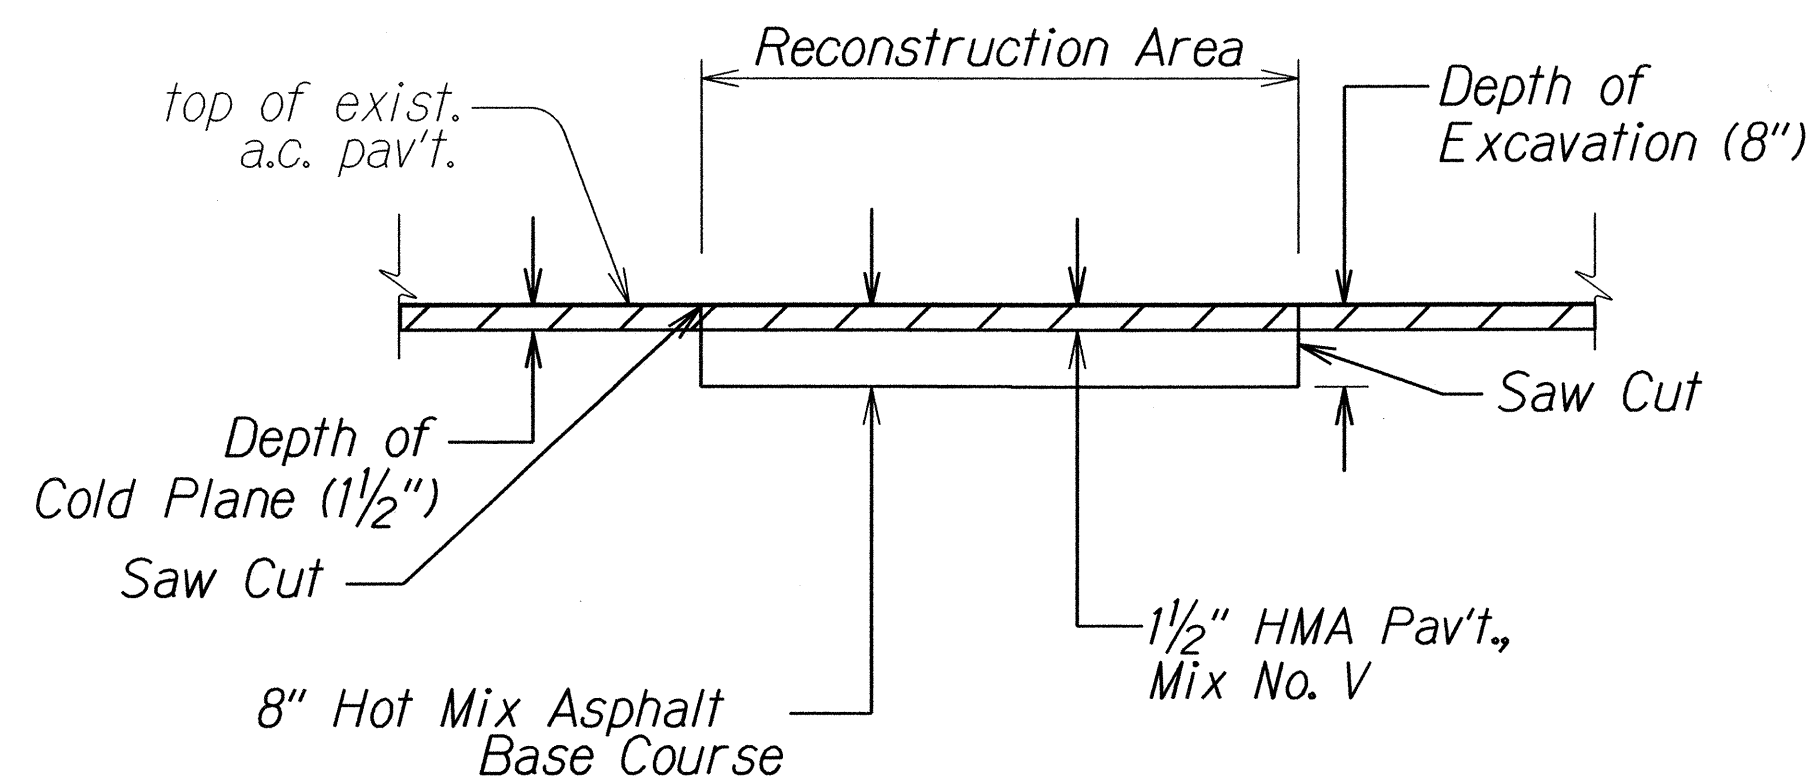


A.C. PAVEMENT RECONSTRUCTION DETAIL  
Not to Scale

Note:  
Reconstruct weakened pavement areas prior to cold plane. The exposed remaining base course or subbase materials should be properly recompact to dense and unyielding conditions prior to placement of the asphalt concrete base layer.

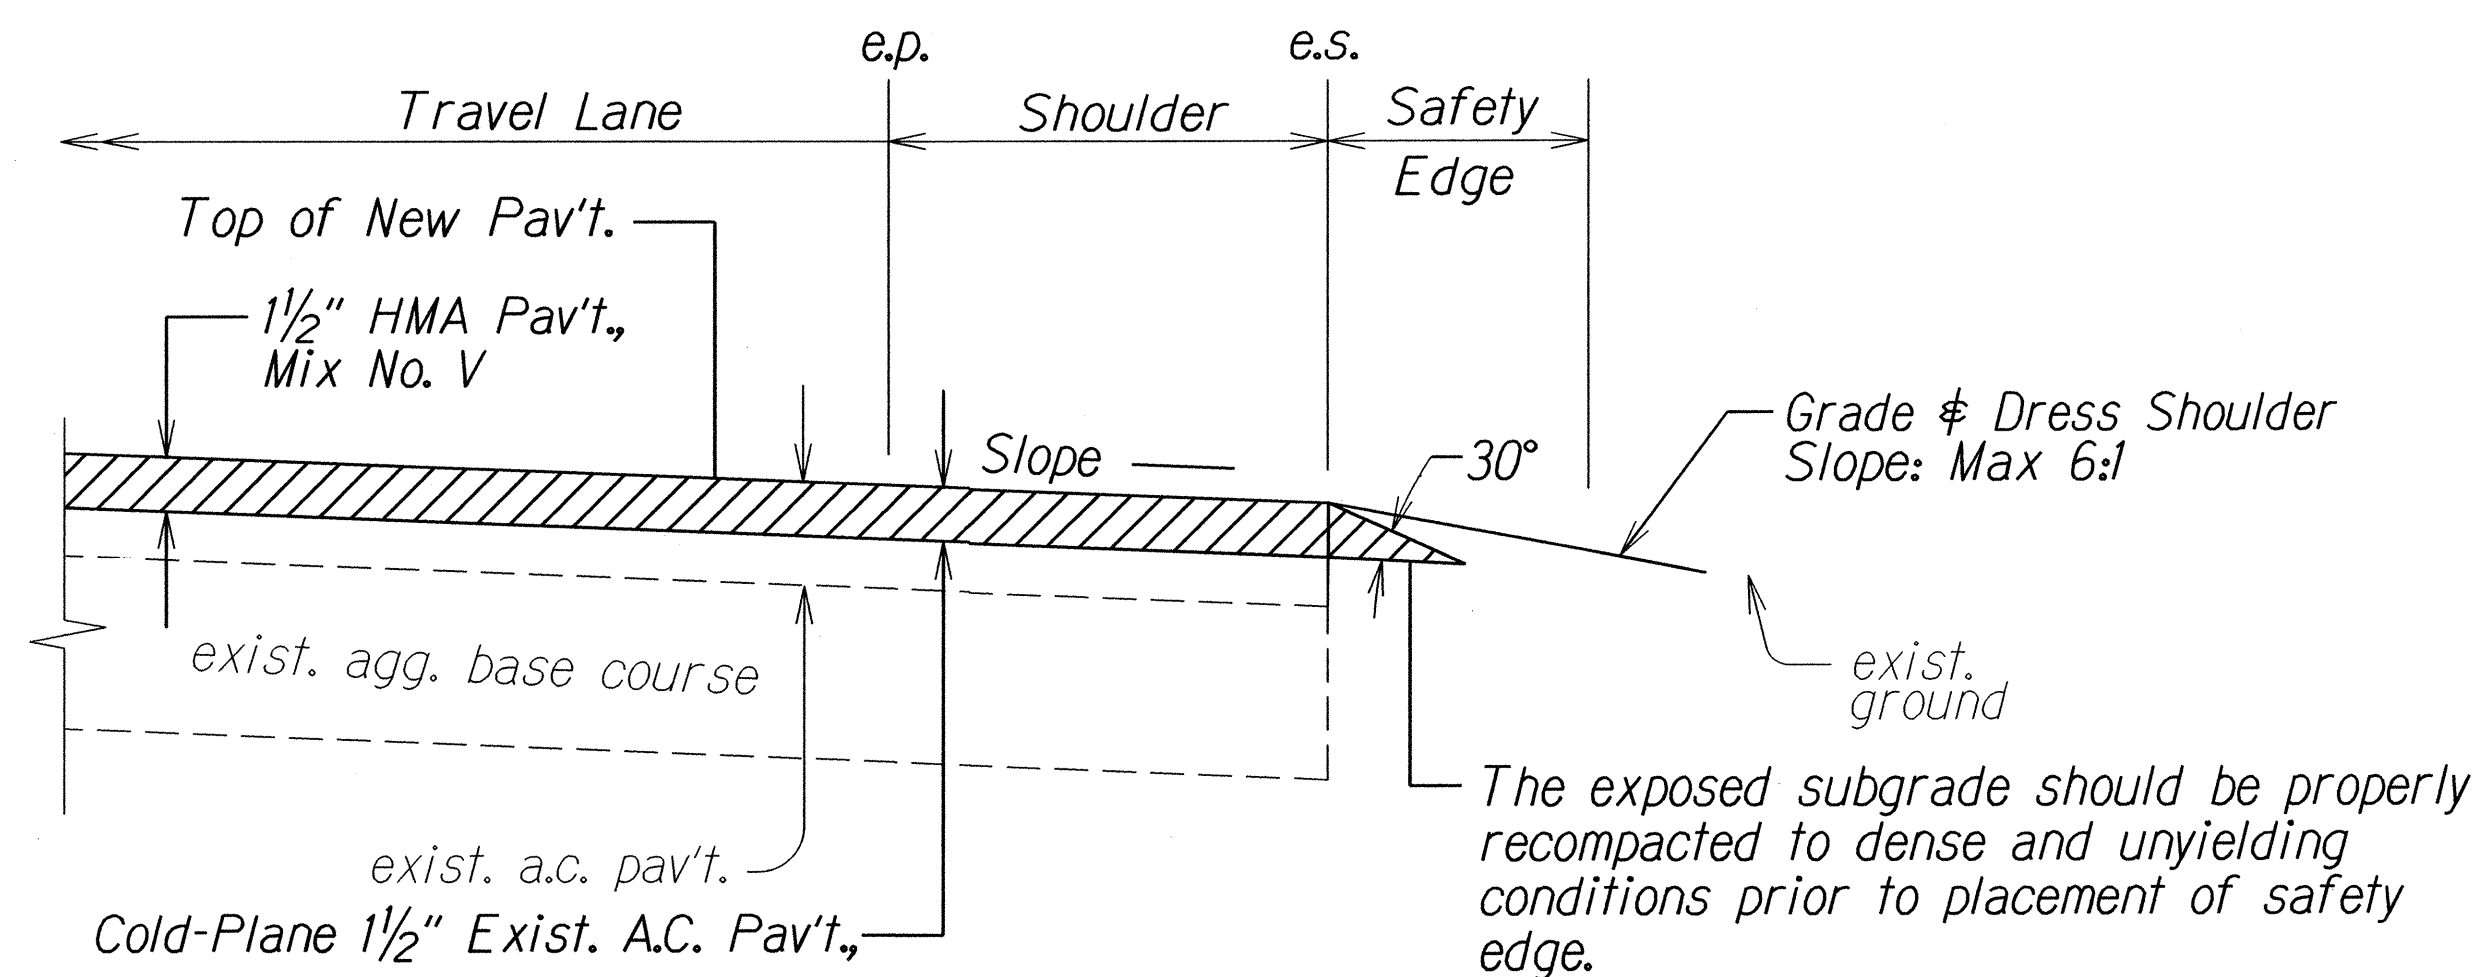


TYPICAL PAVEMENT EDGE DETAIL  
Not to Scale

- Note:
- Contractor shall mount a device directly on the paver screed extension to provide a 30° beveled shoulder edge.
  - Construct safety edge at all edges of a.c. pavement. This work shall be considered incidental to Item No. 401.0400 - HMA Pavement Mix no. V.

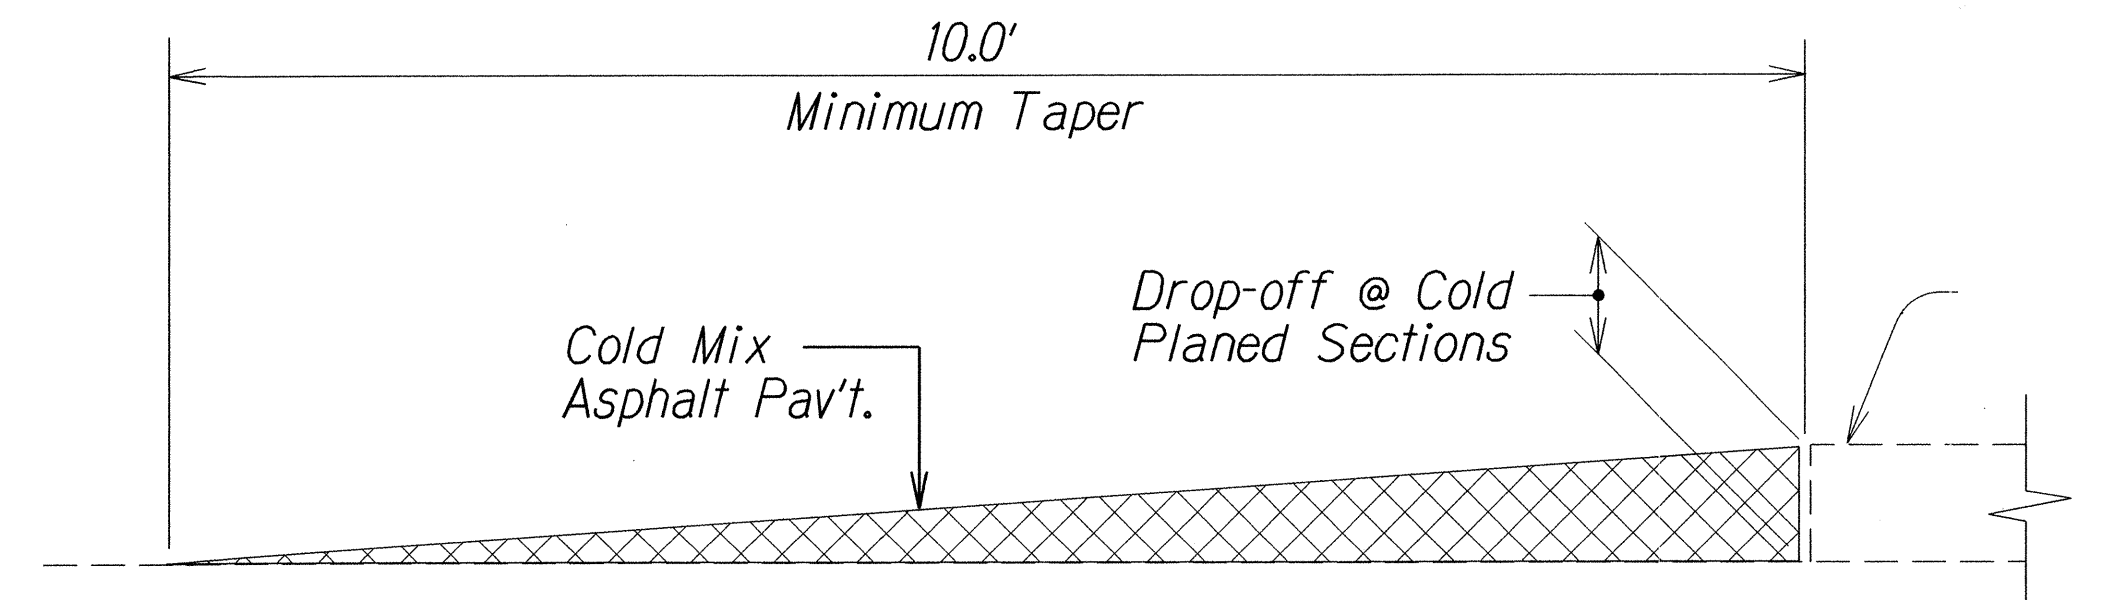

TEMPORARY TRANSITION AT COLD PLANED AREAS  
Not to Scale

Note: Contractor shall construct temporary pavement taper to prevent sharp pavement drop-offs at all cold planed sections. Prior to final Hot Mix Asphalt Pavement, Mix No. V placement, temporary pavement taper shall be removed.

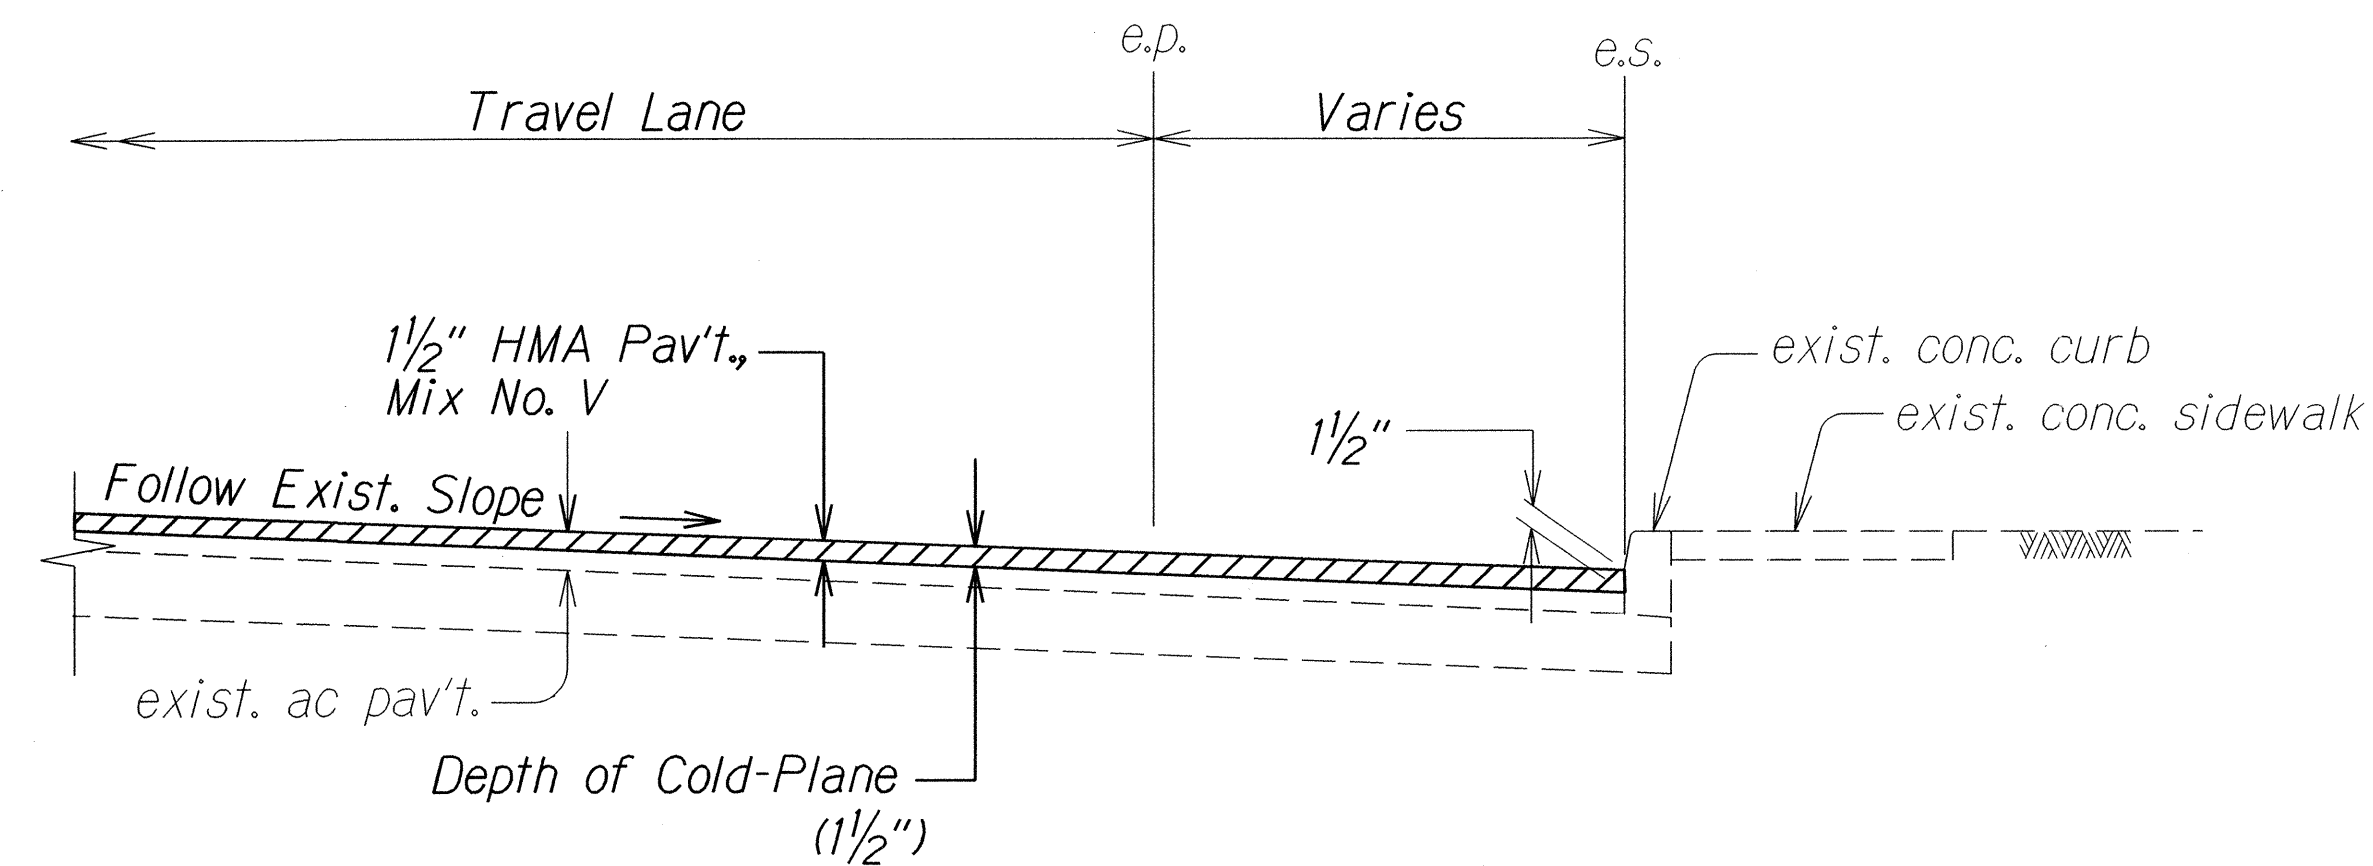

RESURFACING AT ASPHALT CONCRETE CURB  
Not to Scale


|               |      |
|---------------|------|
| ORIGINAL PLAN | DATE |
| DESIGNED BY   | DATE |
| CHECKED BY    | DATE |
| NOTED BY      | DATE |
| QUANTITIES BY | DATE |
| CHECKED BY    | DATE |

STATE OF HAWAII  
DEPARTMENT OF TRANSPORTATION  
HIGHWAYS DIVISION

TYPICAL SECTIONS  
AHUKINI ROAD RESURFACING  
Vicinity of Kapule Highway  
Project No. 570A-01-15M  
Not to Scale  
Date: April 2015


SHEET No. 2 OF 3 SHEETS

| FED. ROAD DIST. NO. | STATE | PROJ. NO.   | FISCAL YEAR | SHEET NO. | TOTAL SHEETS |
|---------------------|-------|-------------|-------------|-----------|--------------|
| HAWAII              | HAW.  | 570A-01-15M | 2016        | 9         | 18           |

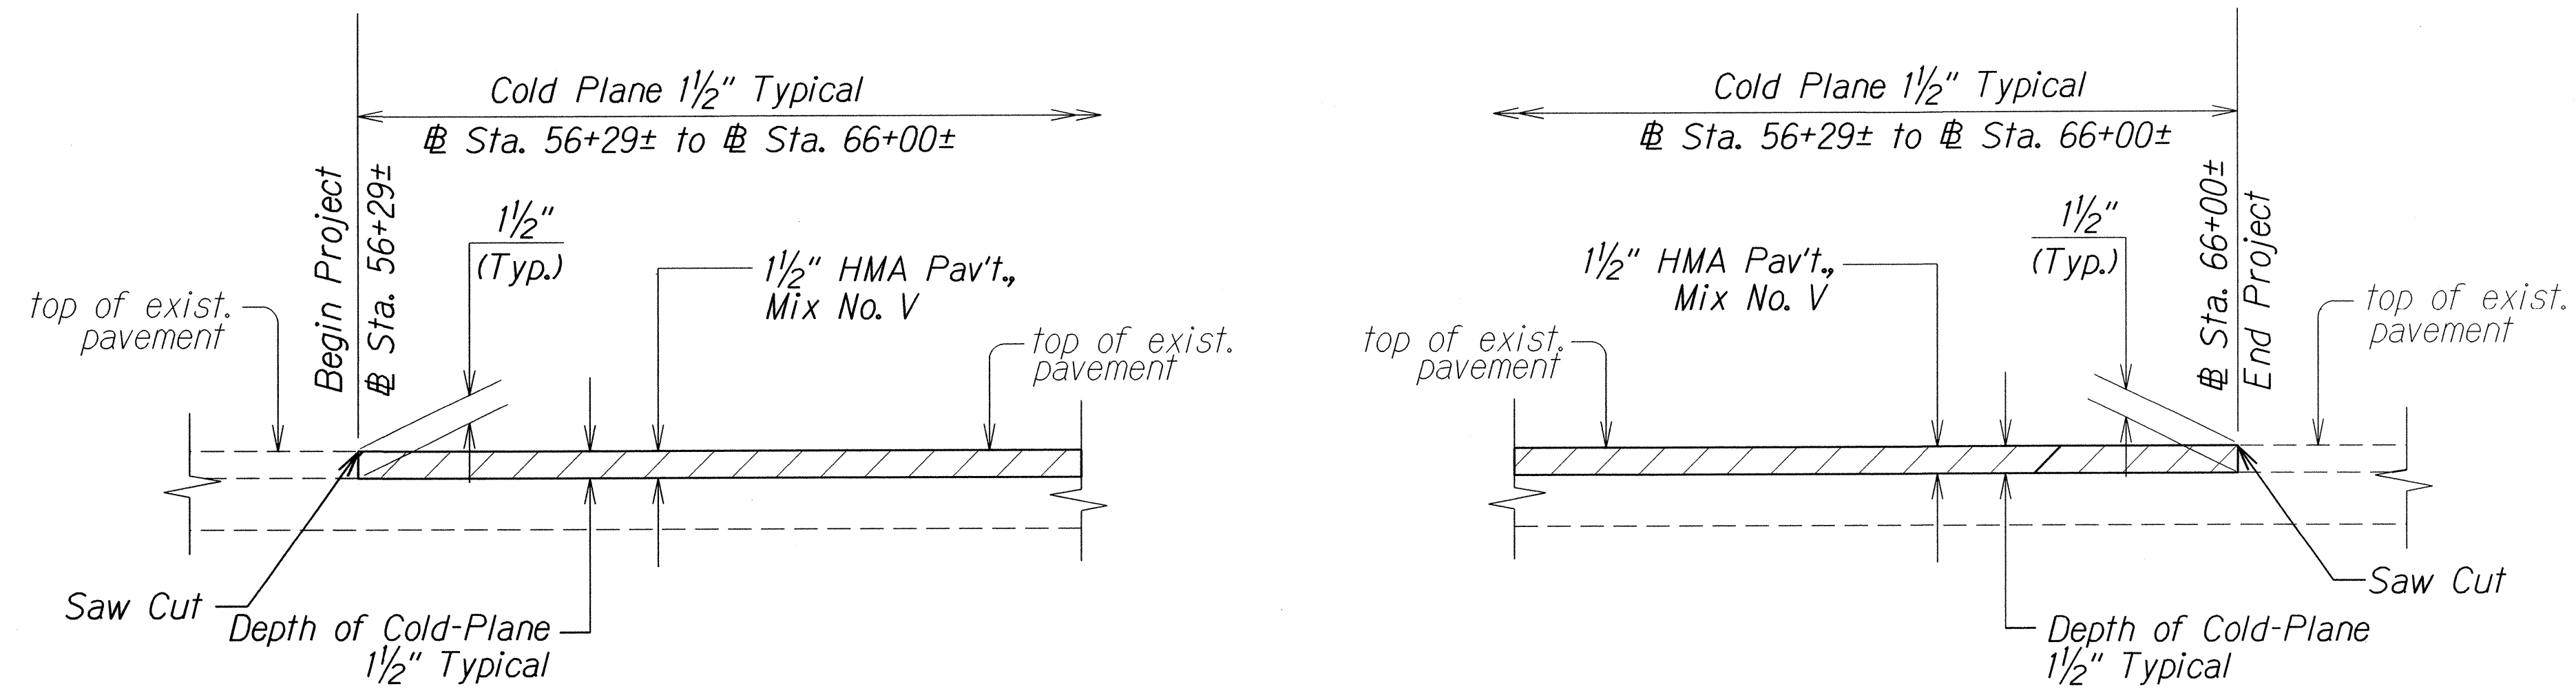

COLD PLANED TRANSITION TO EXISTING A.C. PAVEMENT AT THE BEGINNING AND END OF PROJECT AT KAPULE HIGHWAY

Not to Scale

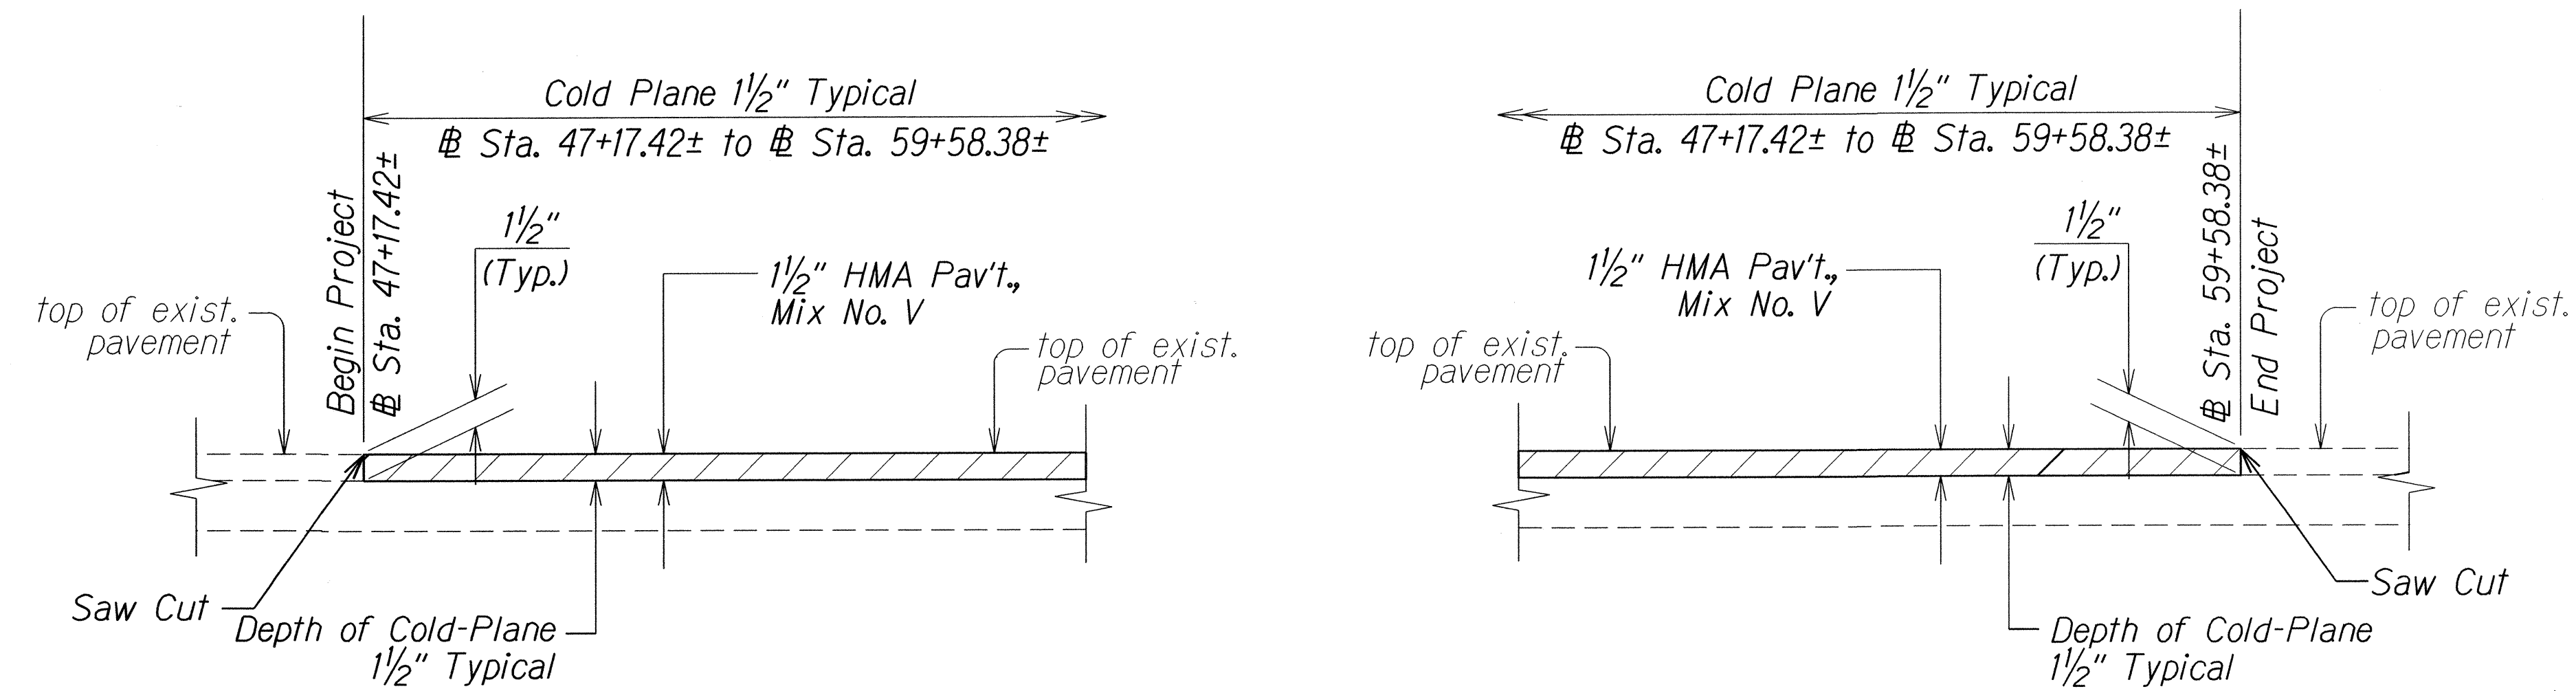

COLD PLANED TRANSITION TO EXISTING A.C. PAVEMENT AT THE BEGINNING AND END OF PROJECT AT AHUKINI ROAD

Not to Scale

|               |                   |      |
|---------------|-------------------|------|
| ORIGINAL PLAN | SURVEY PLOTTED BY | DATE |
| NOTE BOOK     | DESIGNED BY       |      |
| QUANTITIES BY | CHECKED BY        |      |
| N.            |                   |      |

STATE OF HAWAII  
DEPARTMENT OF TRANSPORTATION  
HIGHWAYS DIVISION

**TYPICAL SECTIONS**

**AHUKINI ROAD RESURFACING**  
**Vicinity of Kapule Highway**  
**Project No. 570A-01-15M**

Not to scale Date: April 2015

SHEET No. 3 OF 3 SHEETS