

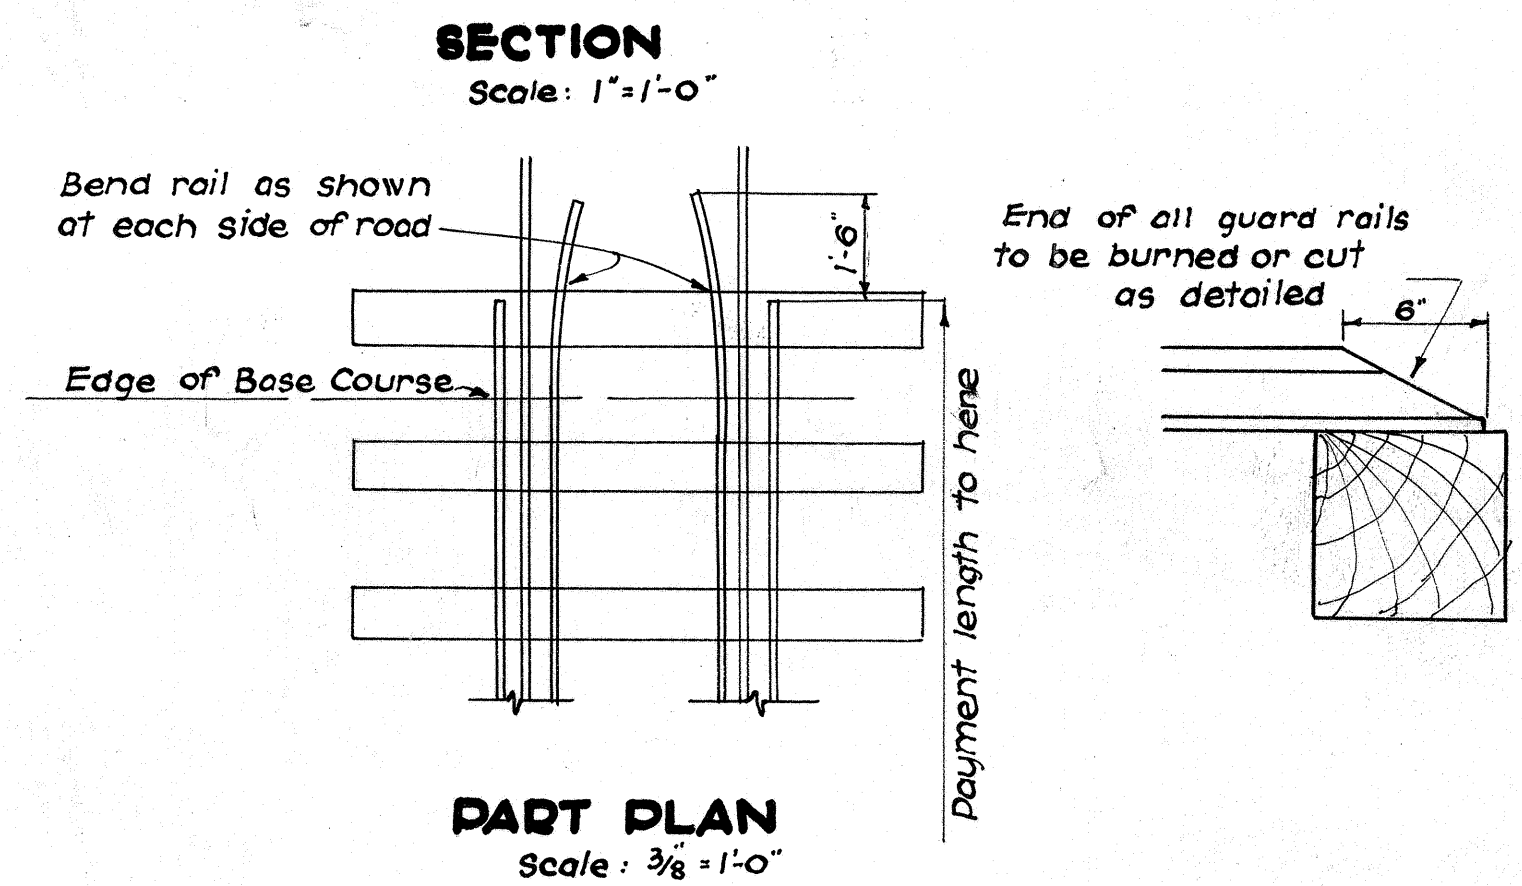



FED. ROAD DIST. NO.	STATE	FED. AID PROJ. NO.	FISCAL YEAR	SHEET NO.	TOTAL SHEETS
HAWAII	HAW.	F.A.S. 440	1938	2	7

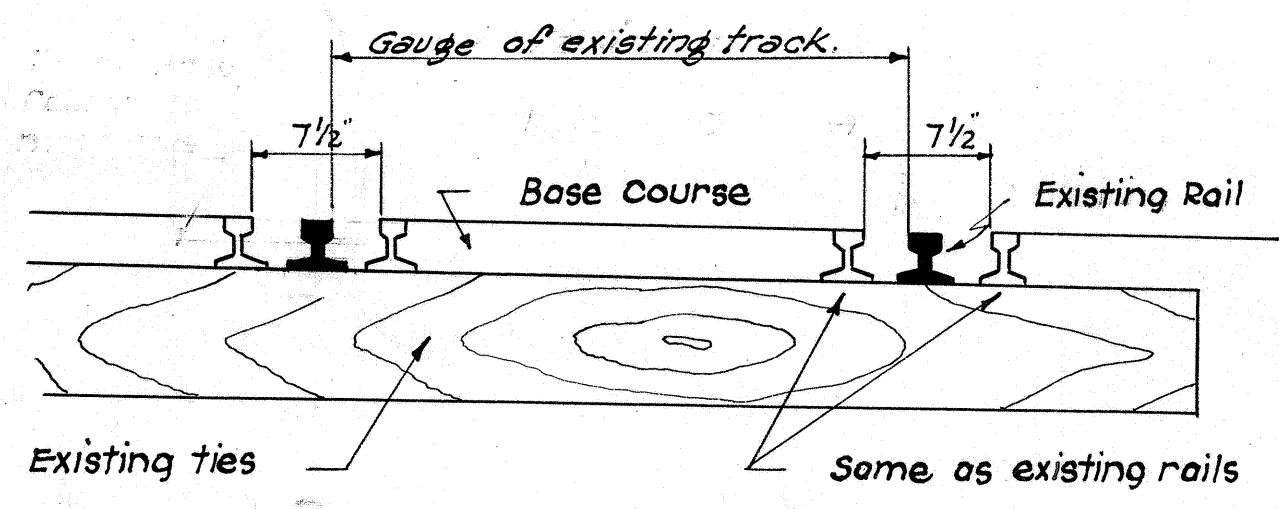


INDUSTRIAL TRACK CROSSING DETAILS

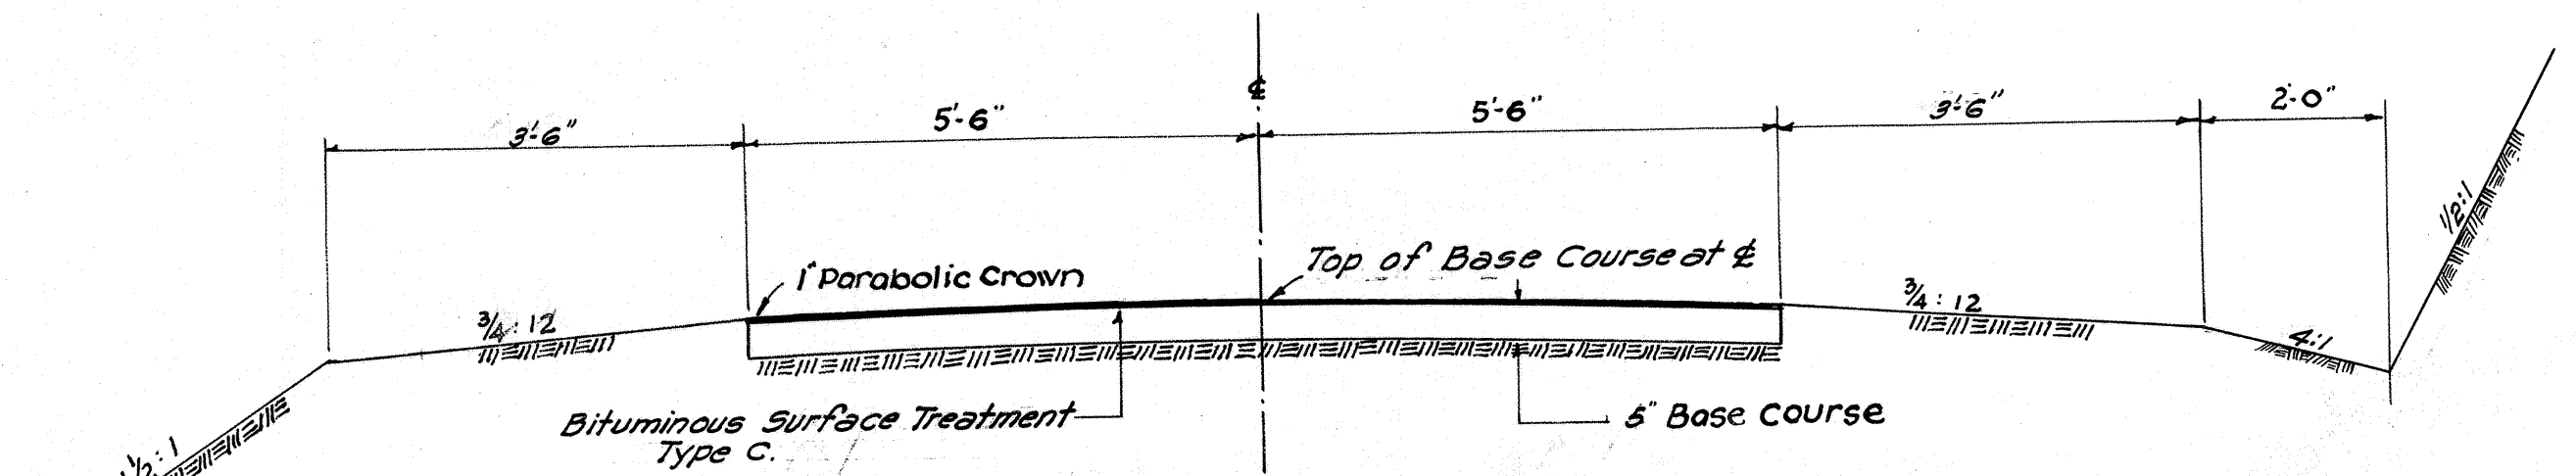

TYPICAL ROAD SECTION ON TANGENTS
Scale: 1/2"=1'-0"

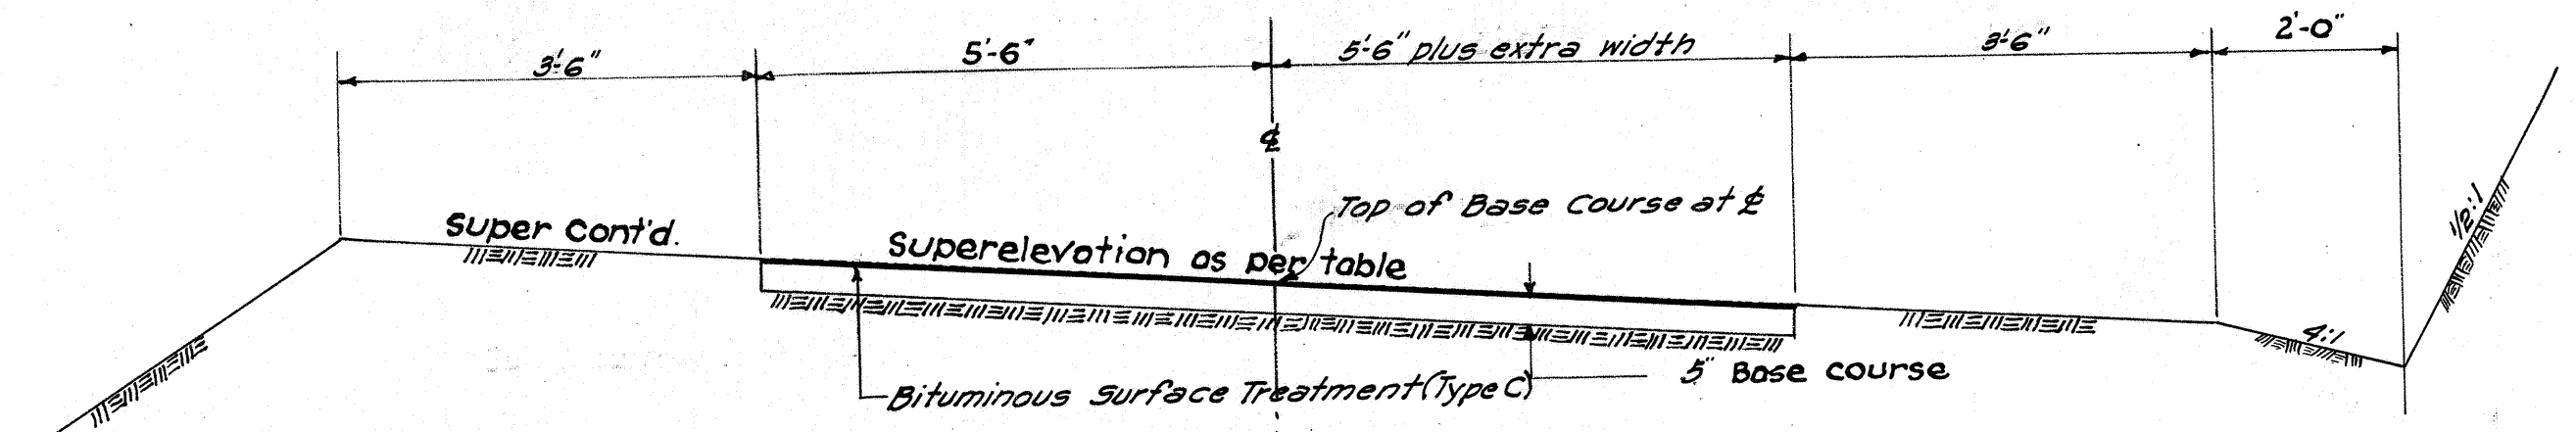

TYPICAL ROAD SECTION ON CURVES
Scale: 1/2"=1'-0"

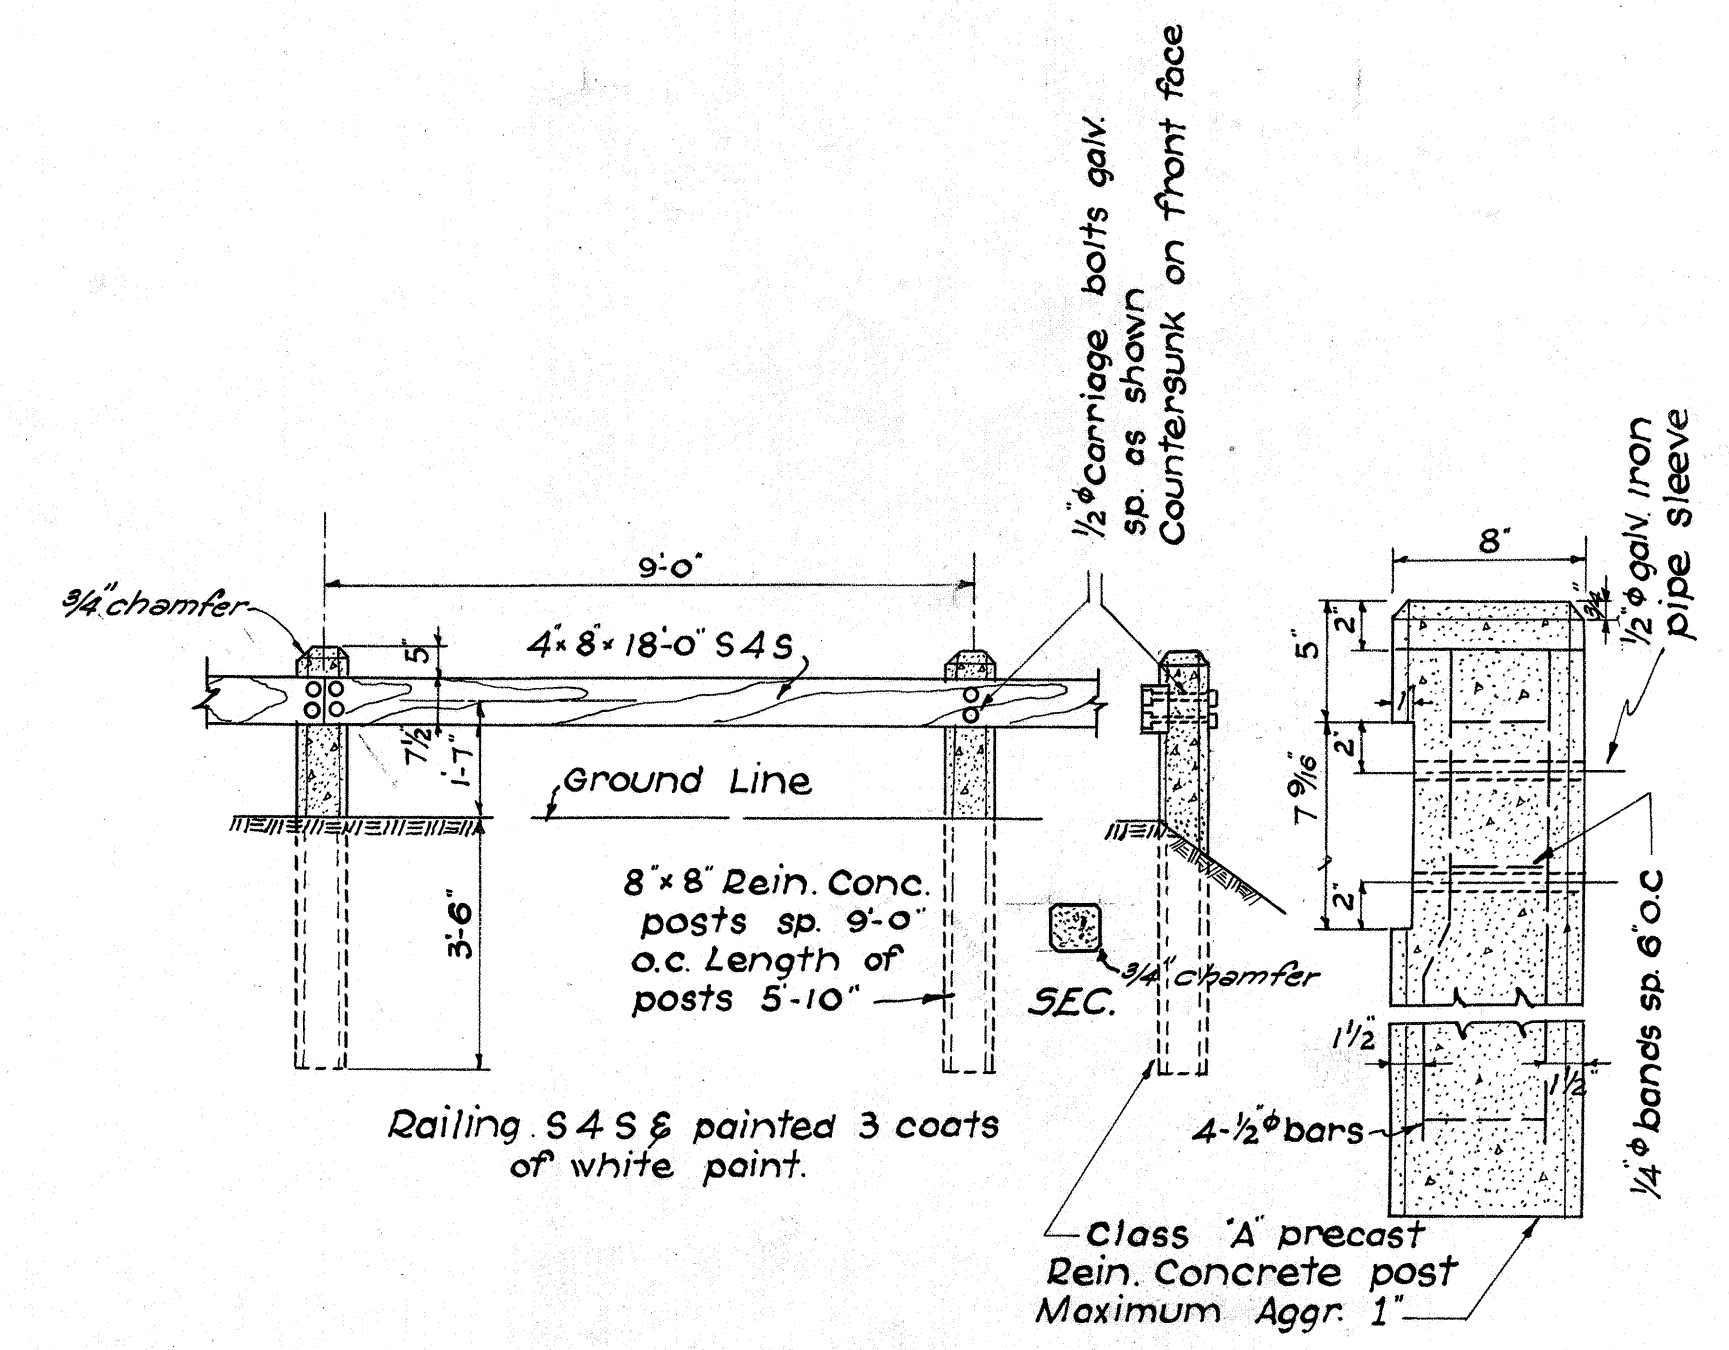

STANDARD WOODEN GUARD RAILING
Scale: 3/8" & 1 1/2"=1'-0"
This detail supercedes Guard Rail Details on Standard Detail Sheet.

TERRITORIAL HIGHWAY DEPARTMENT
TERRITORY OF HAWAII

TYPICAL SECTIONS

POLIAHU ROAD

F.A.S. 4-A

ORIGINAL PLAN	DATE
DESIGNED BY	
DRAWN BY	
CHECKED BY	
NOTED BY	
QUANTITIES CHECKED BY	
QUANTITIES BY	
NO.	