

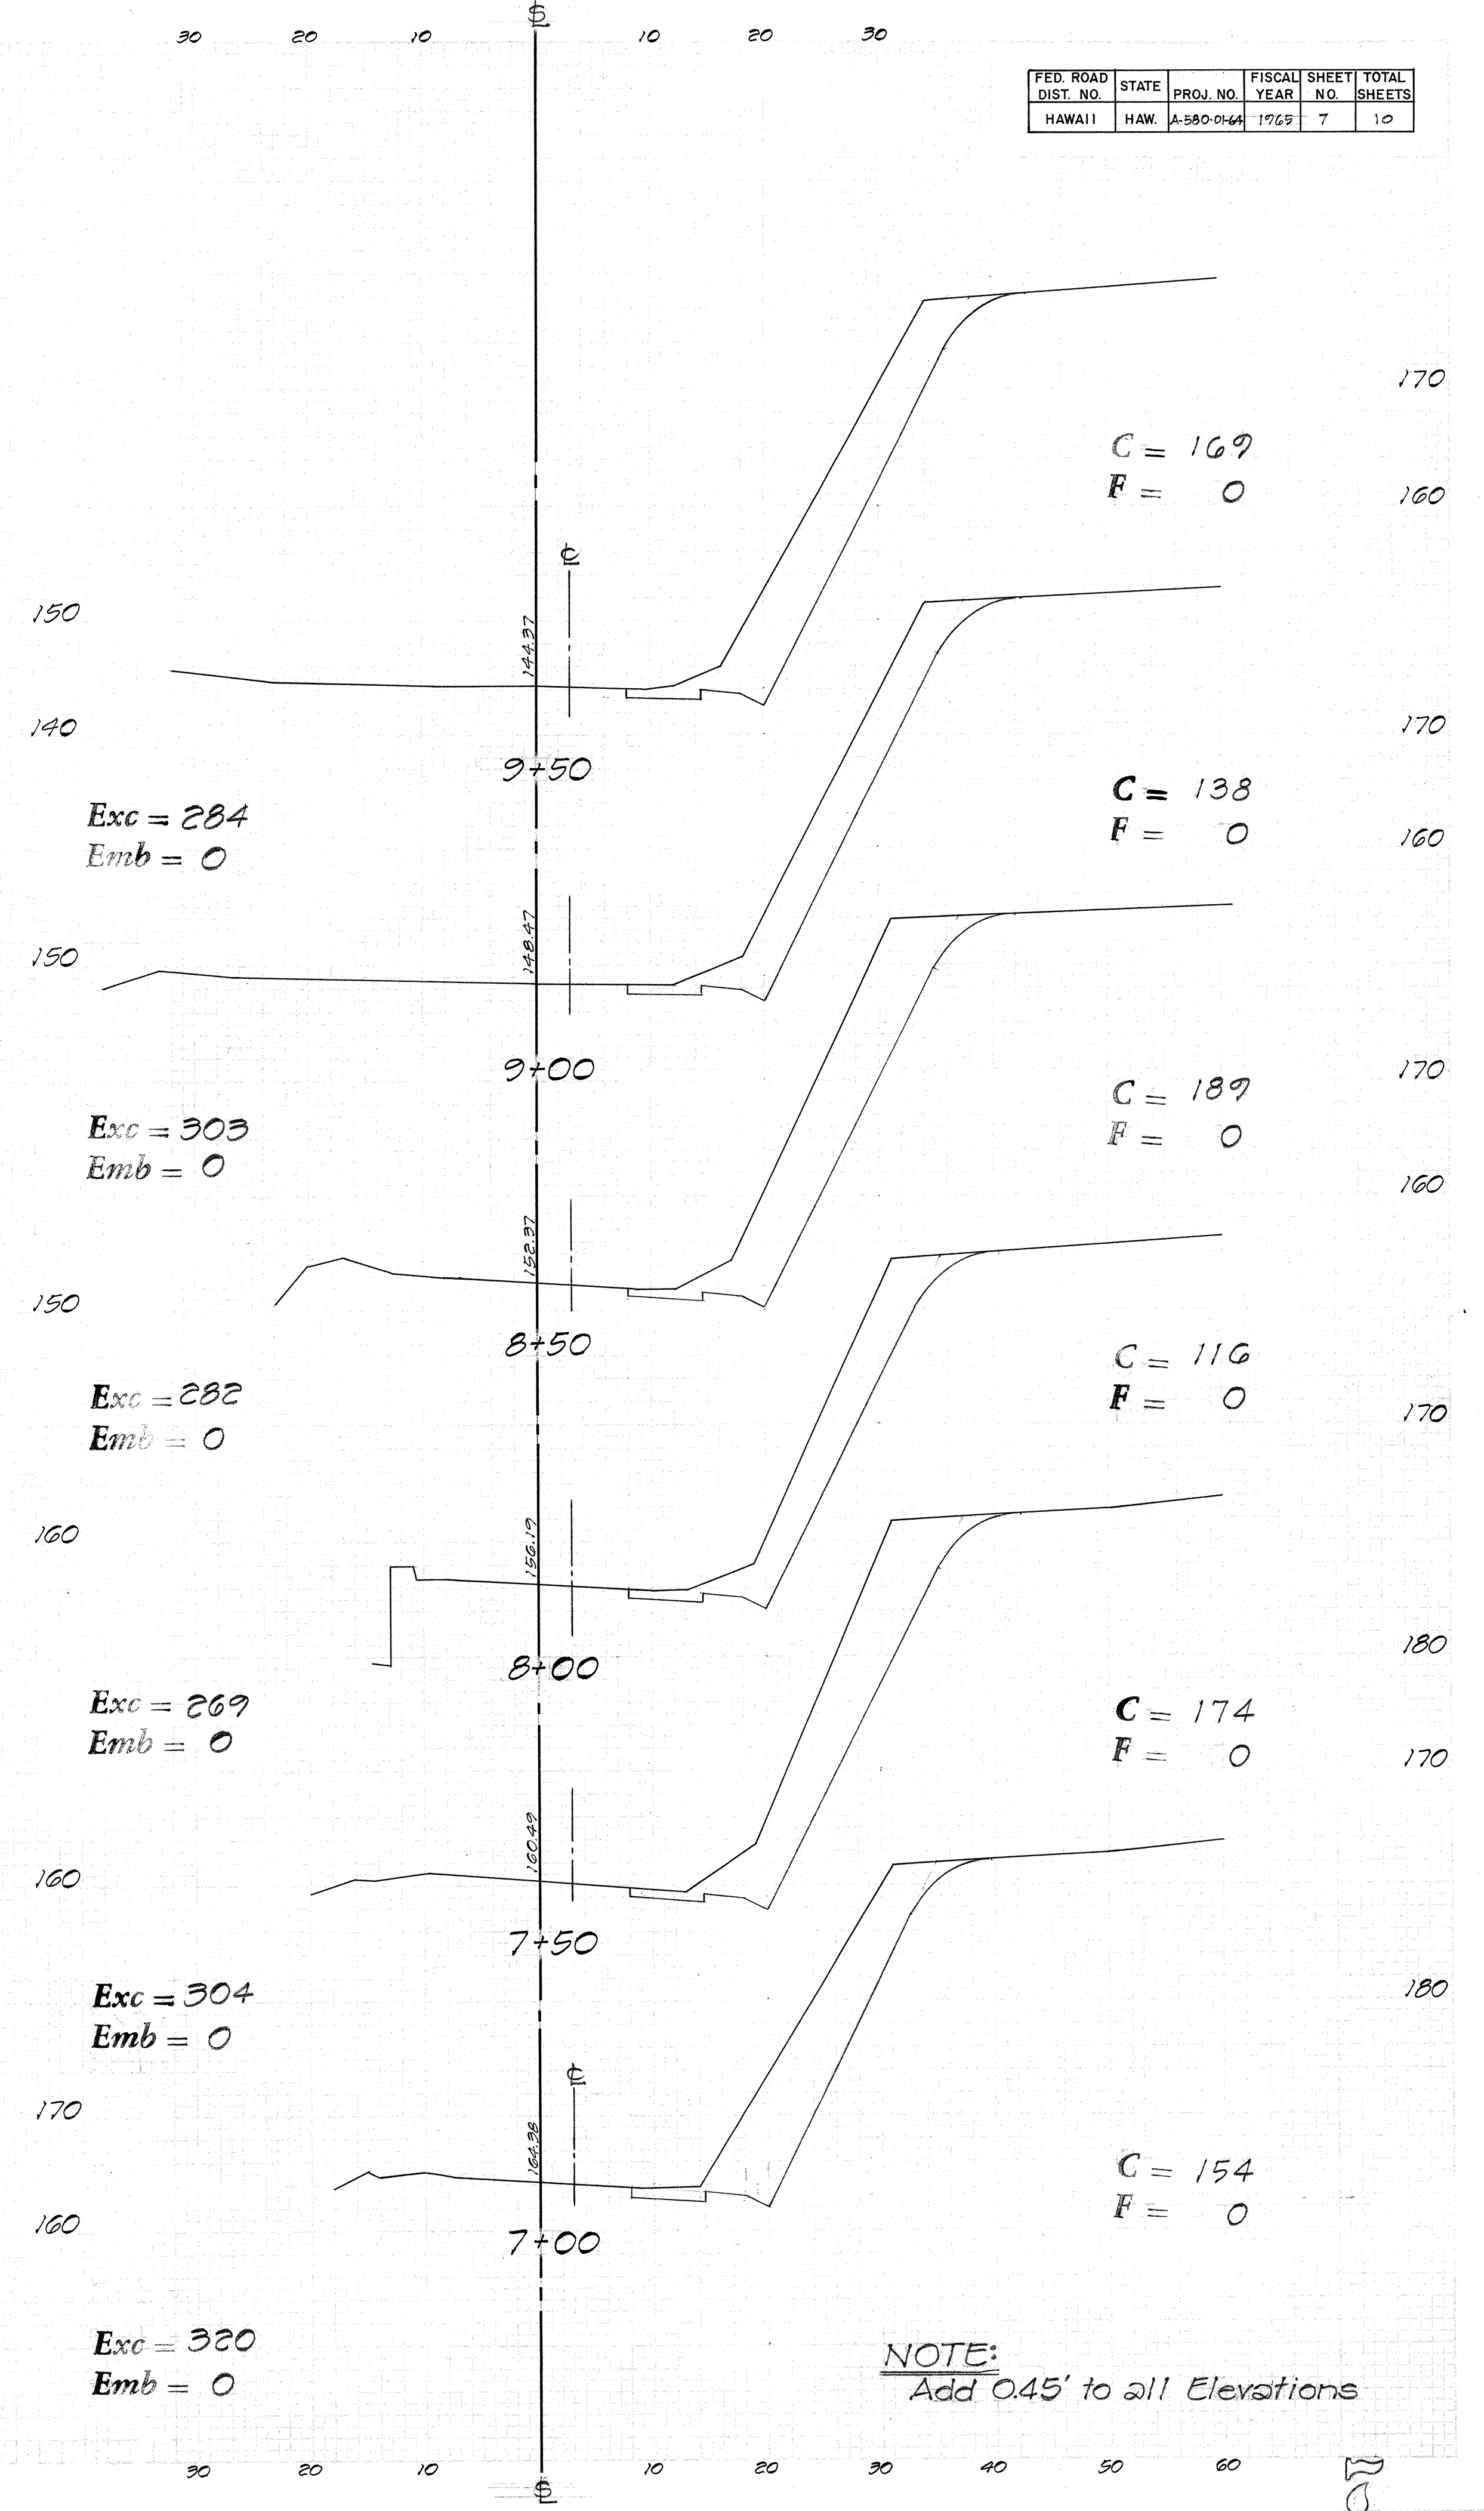
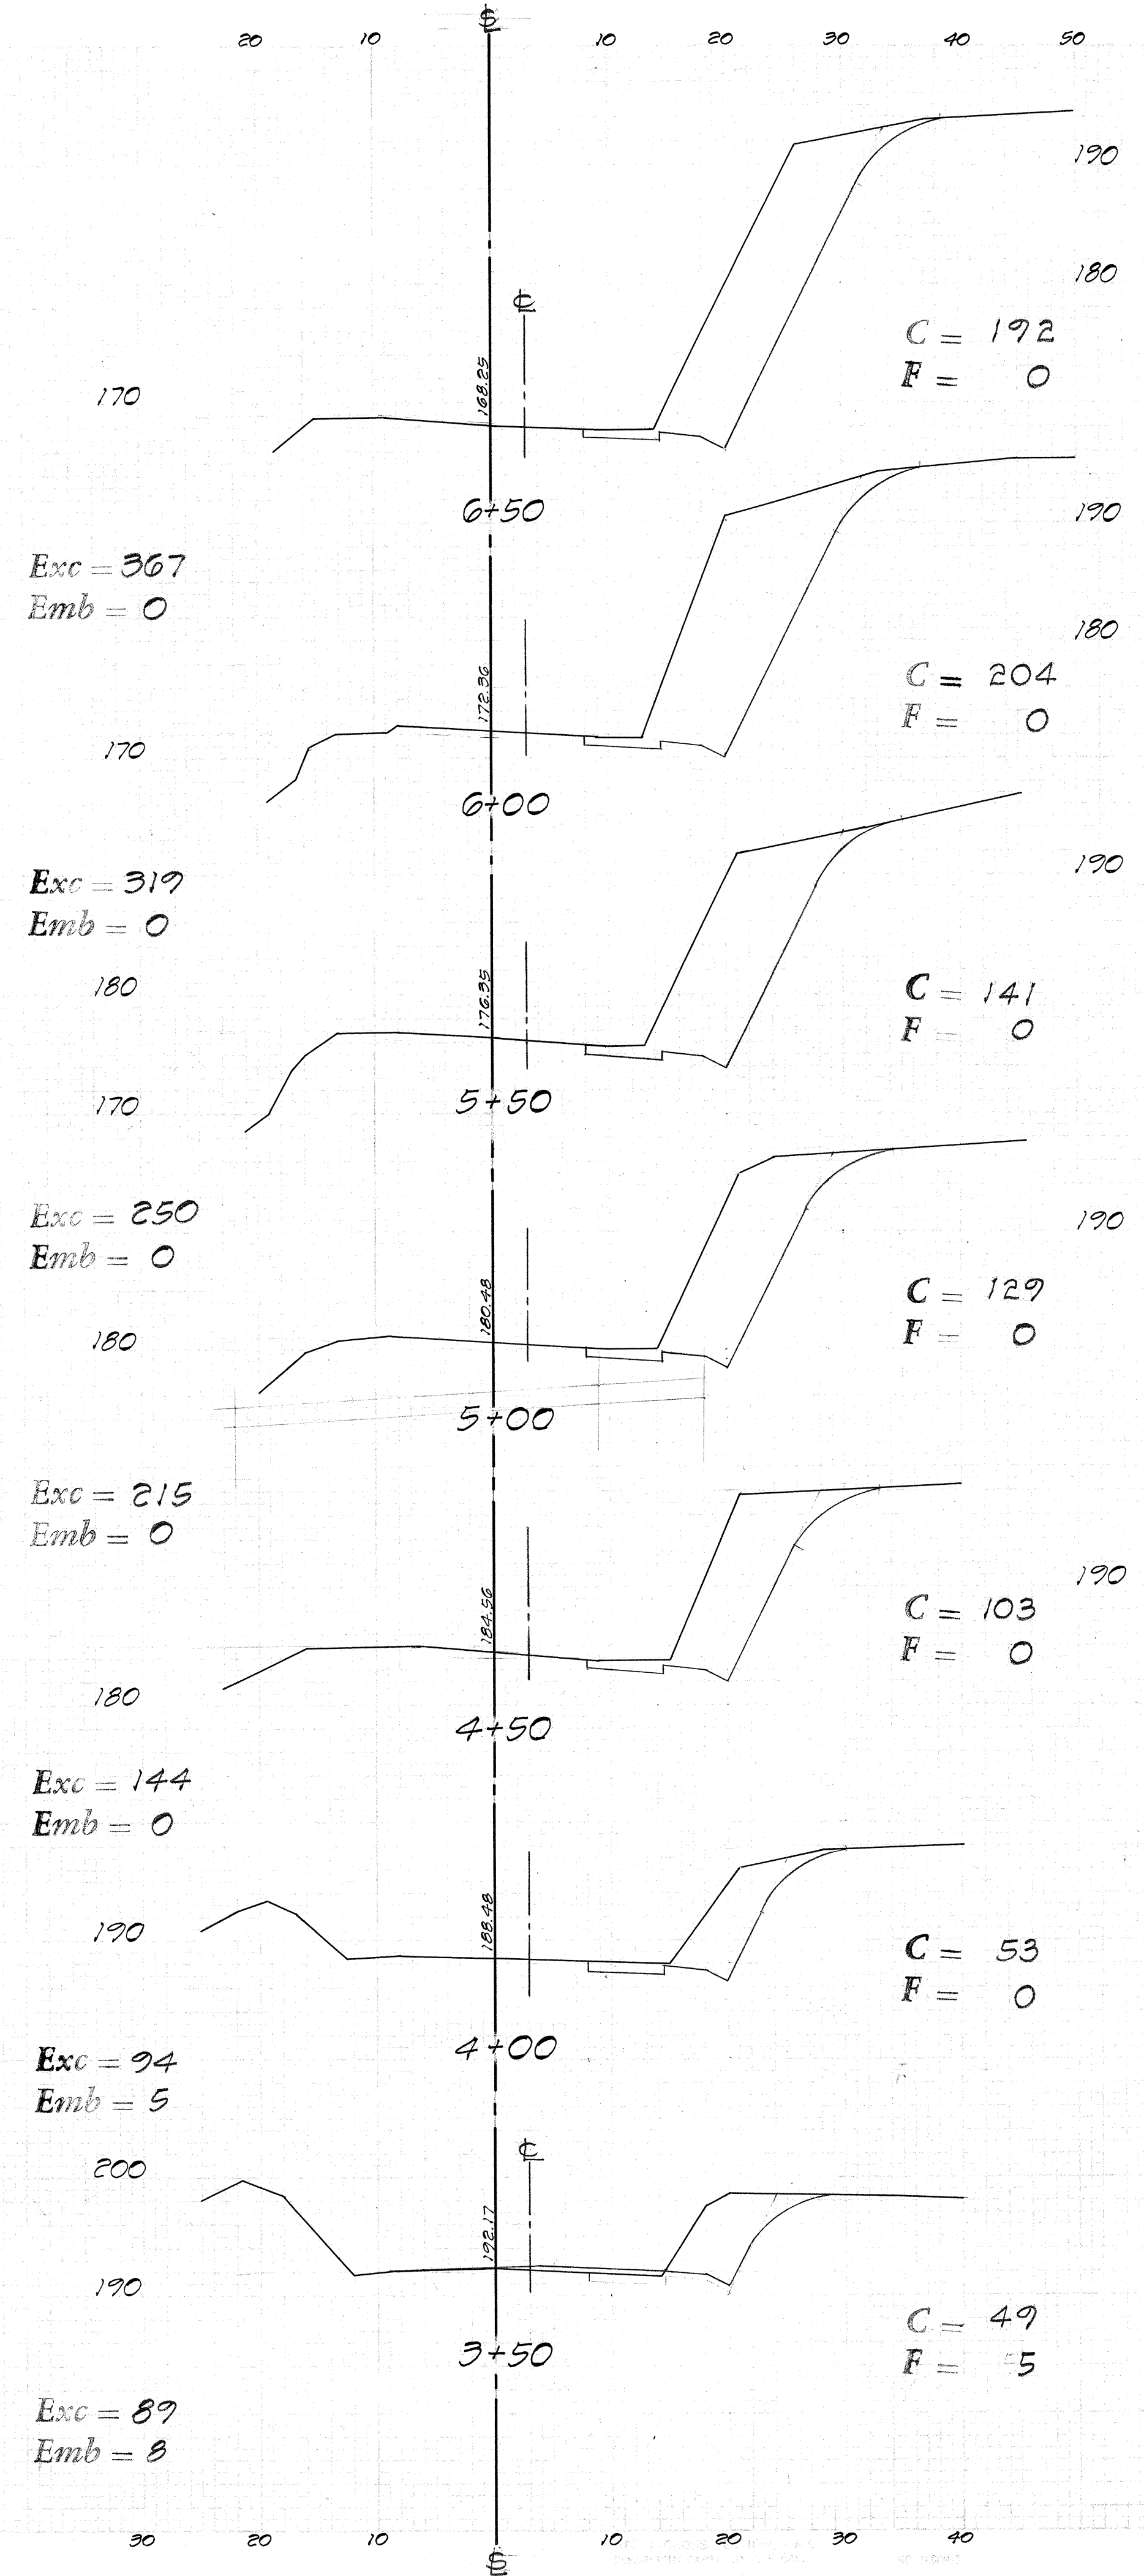
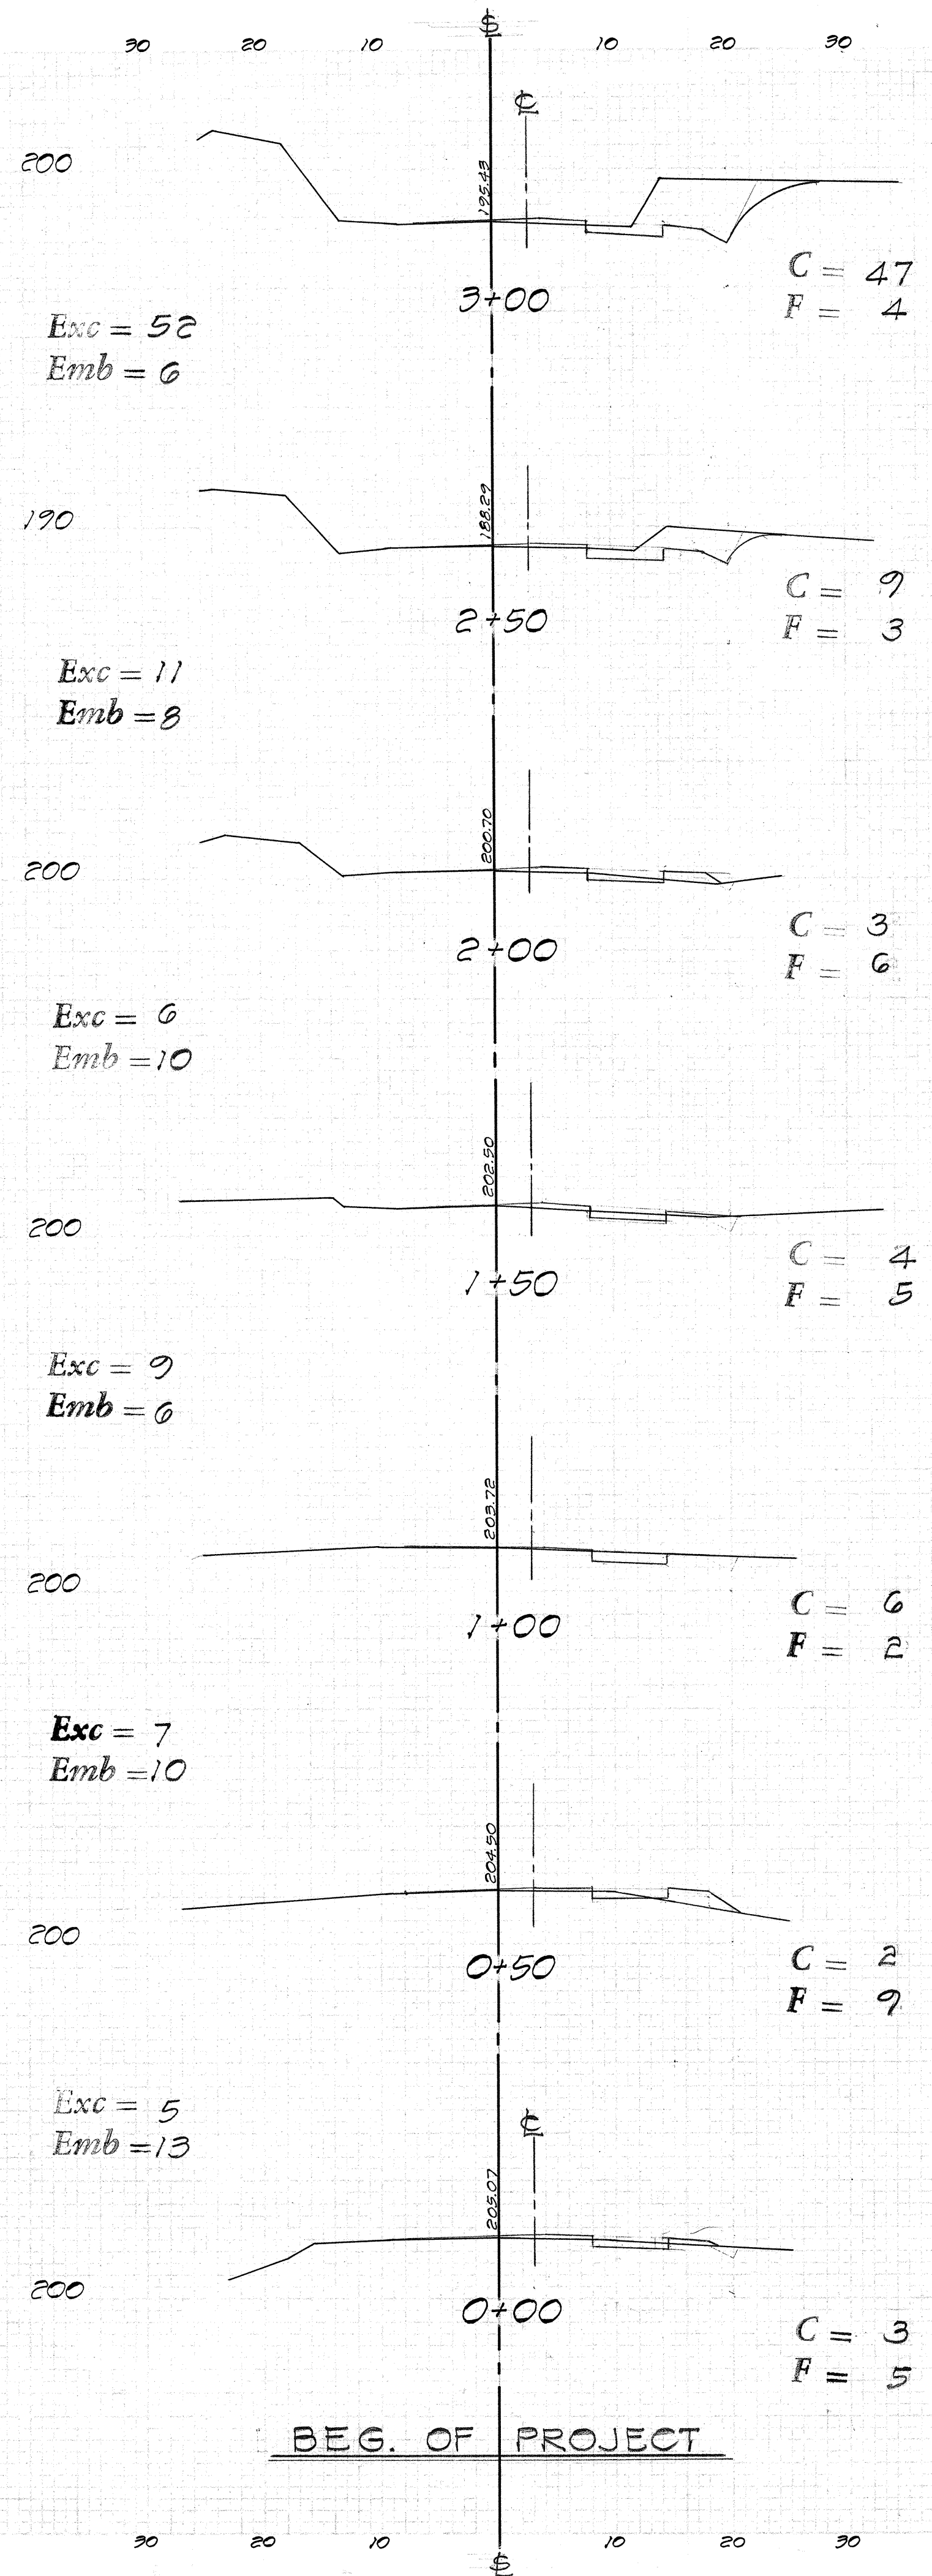
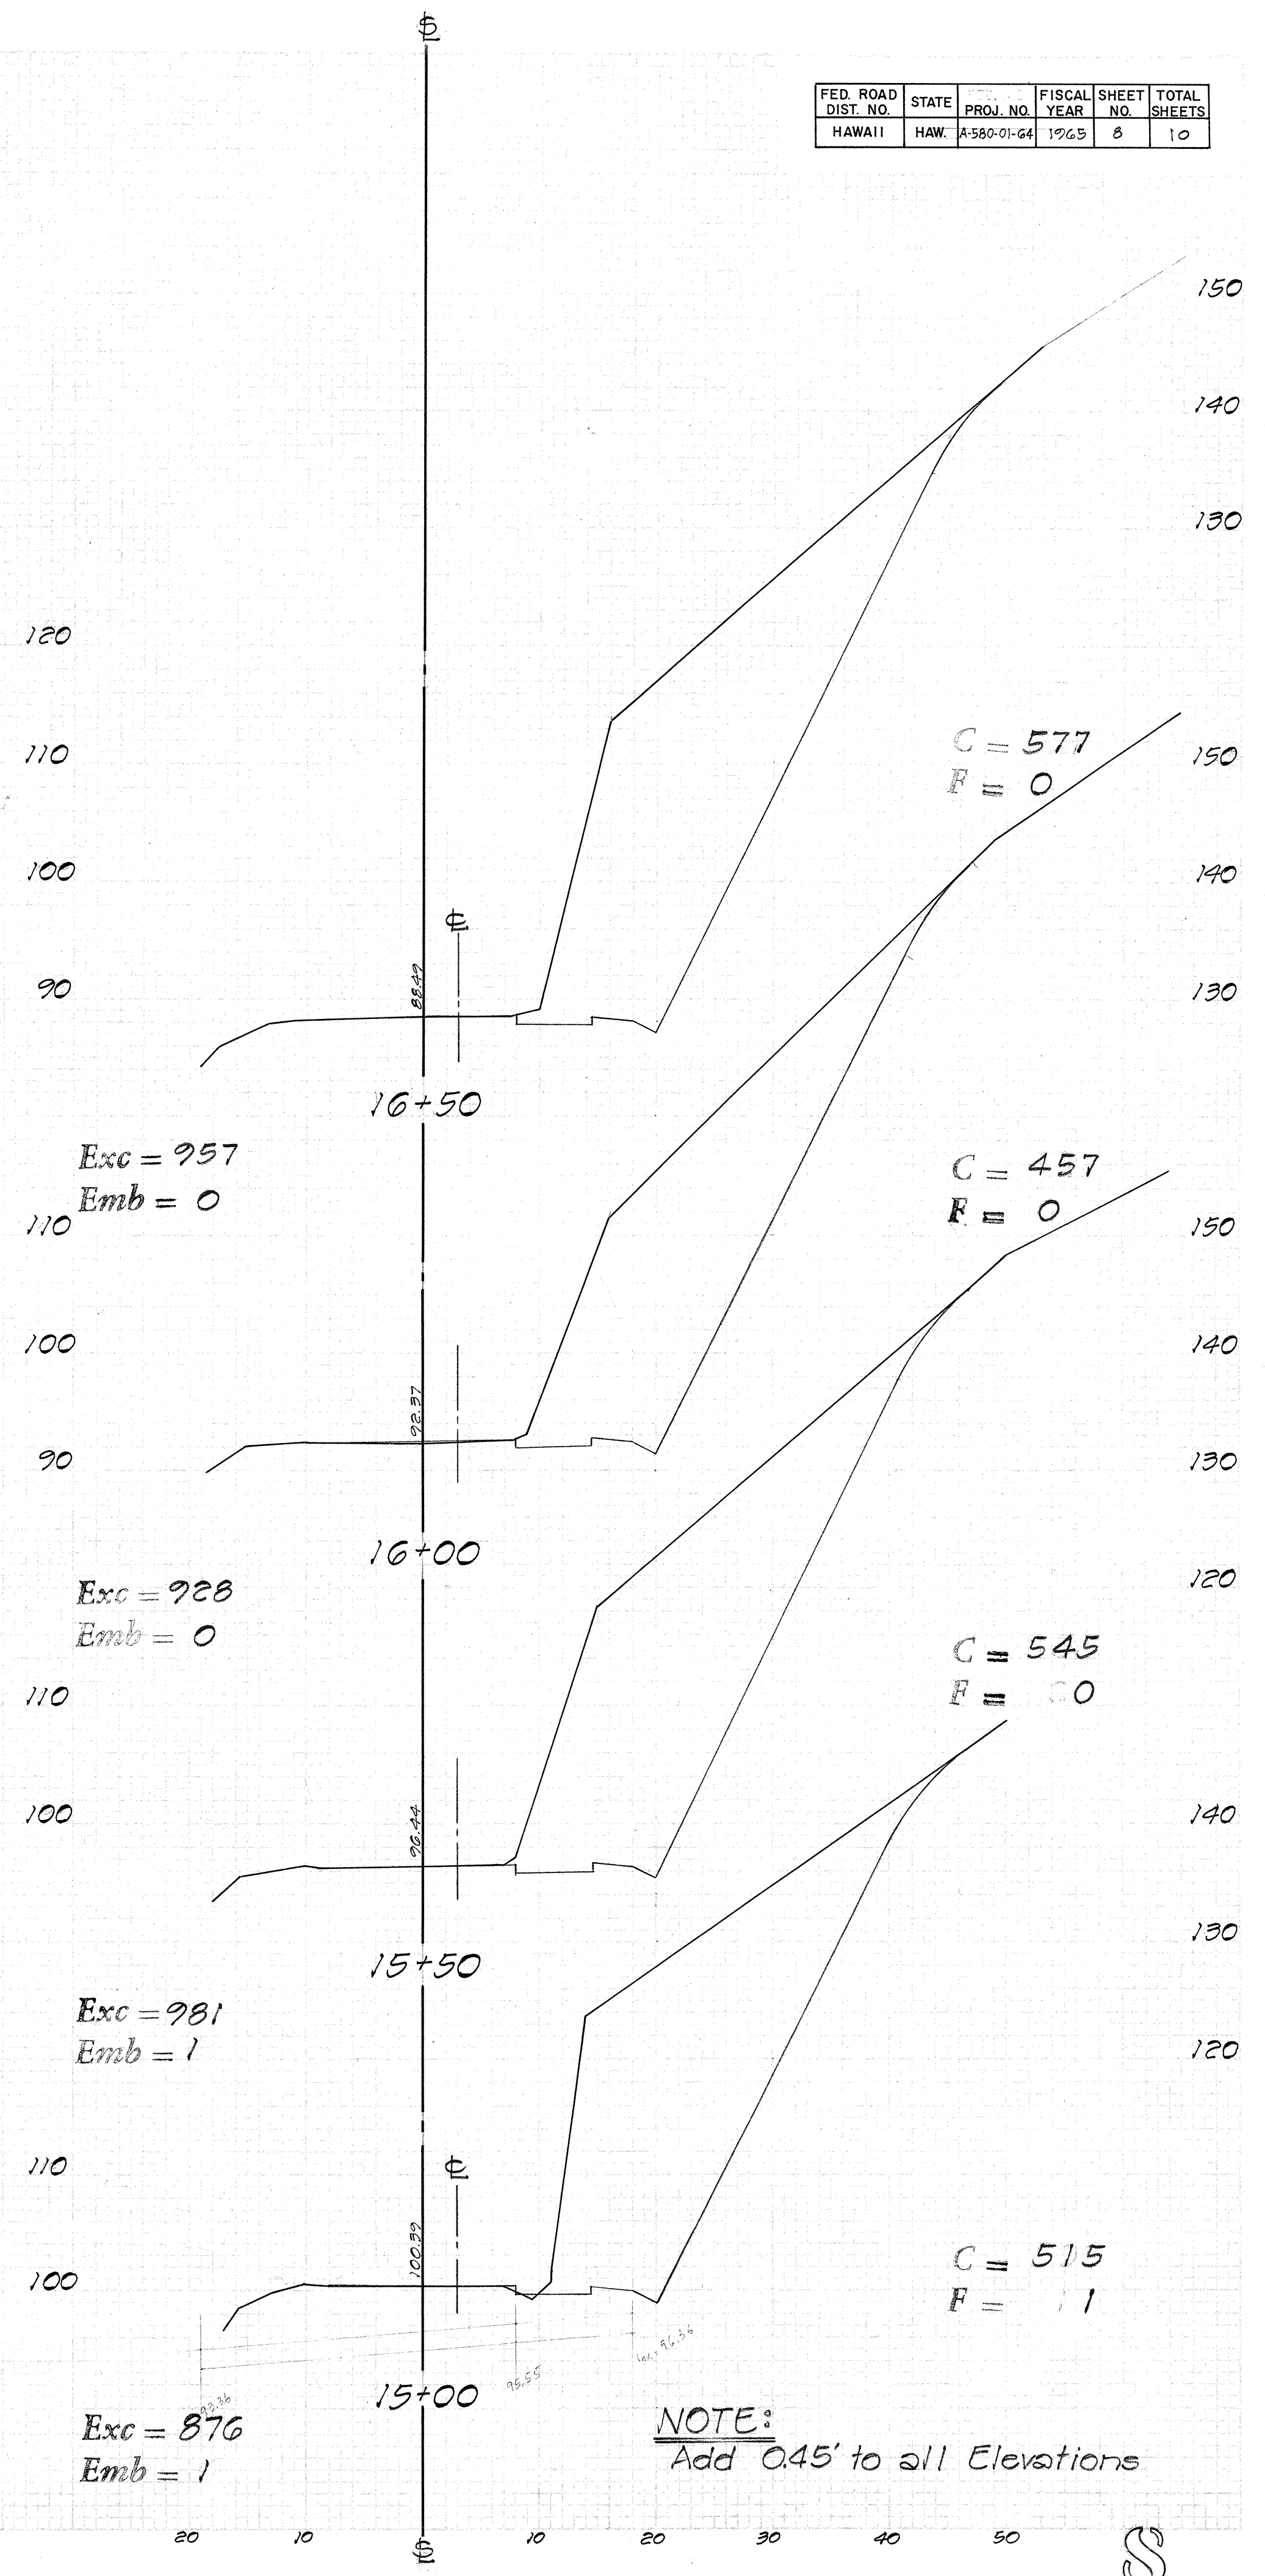


FED. ROAD DIST. NO.	STATE	PROJ. NO.	FISCAL YEAR	SHEET NO.	TOTAL SHEETS
HAWAII	HAW.	A-580-01-64	1963	7	10

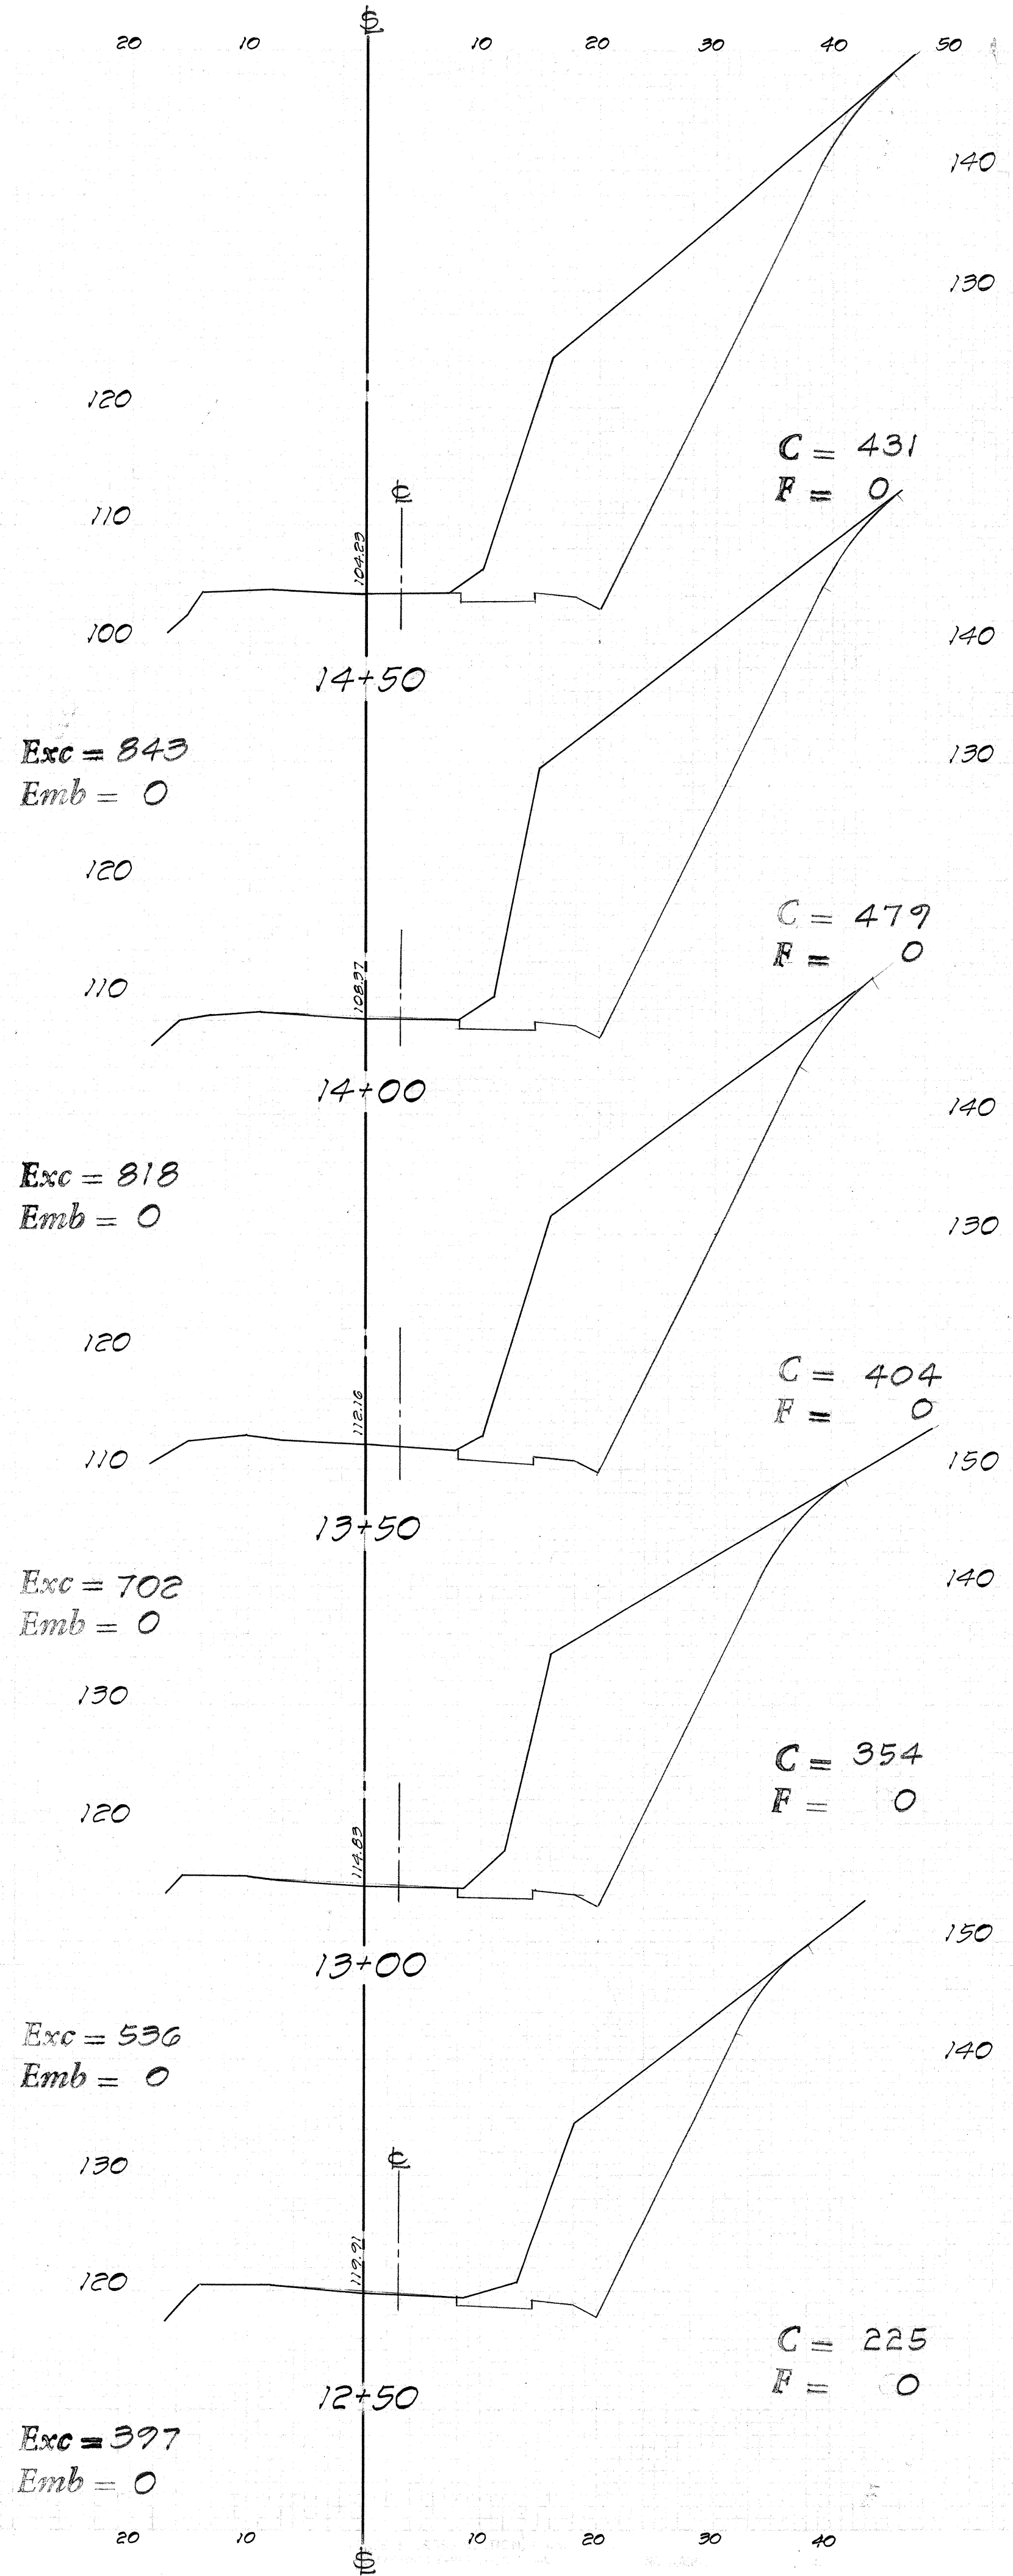


NOTE:
Add 0.45' to all Elevations

FED. ROAD DIST. NO.	STATE	PROJ. NO.	FISCAL YEAR	SHEET NO.	TOTAL SHEETS
HAWAII	HAW.	A-580-01-64	1963	8	10

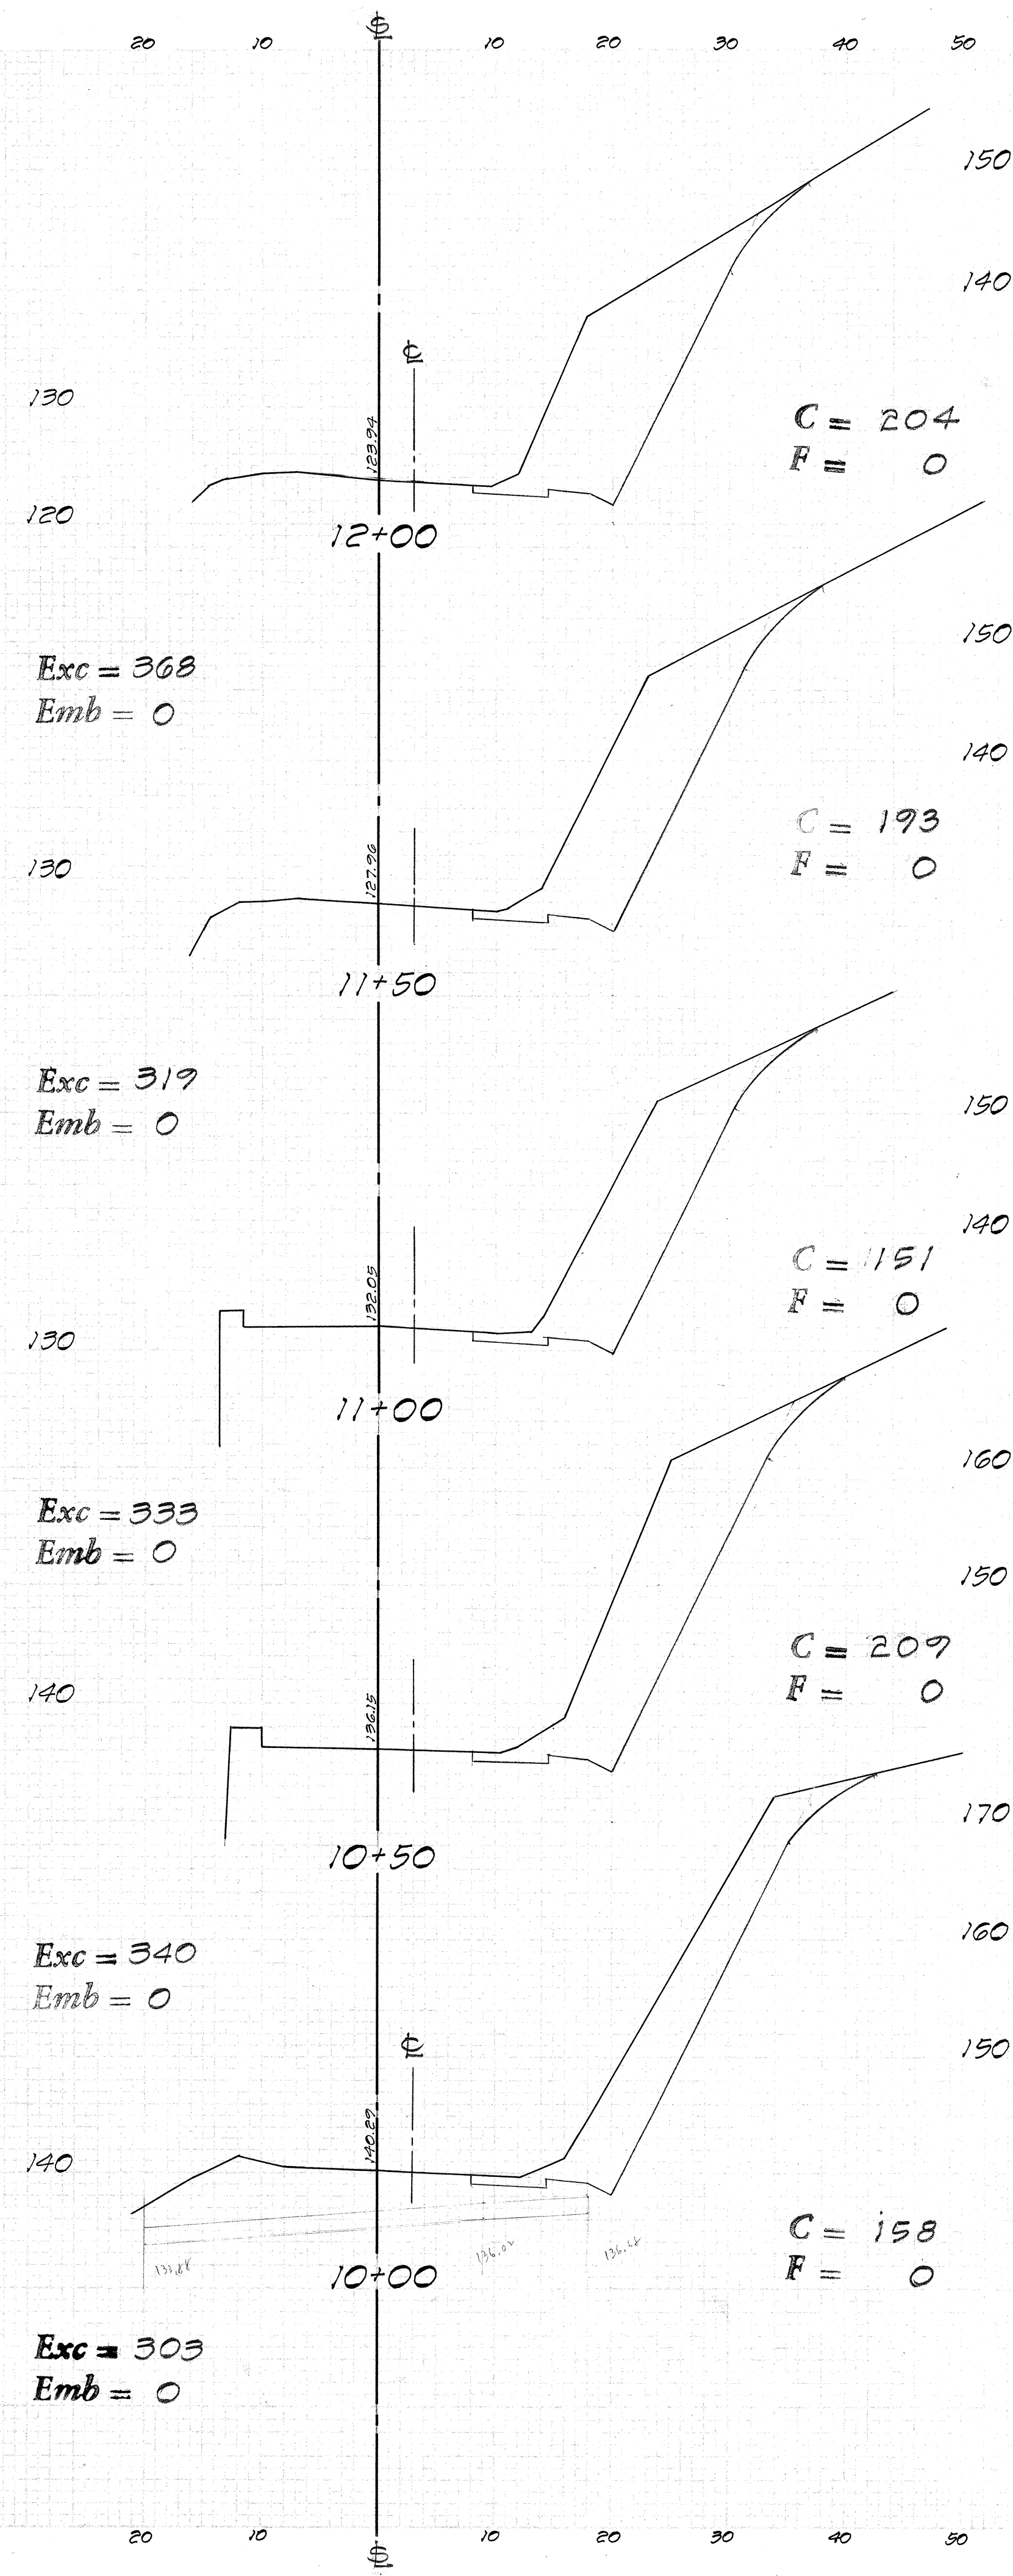

NOTE:
Add 0.45' to all Elevations

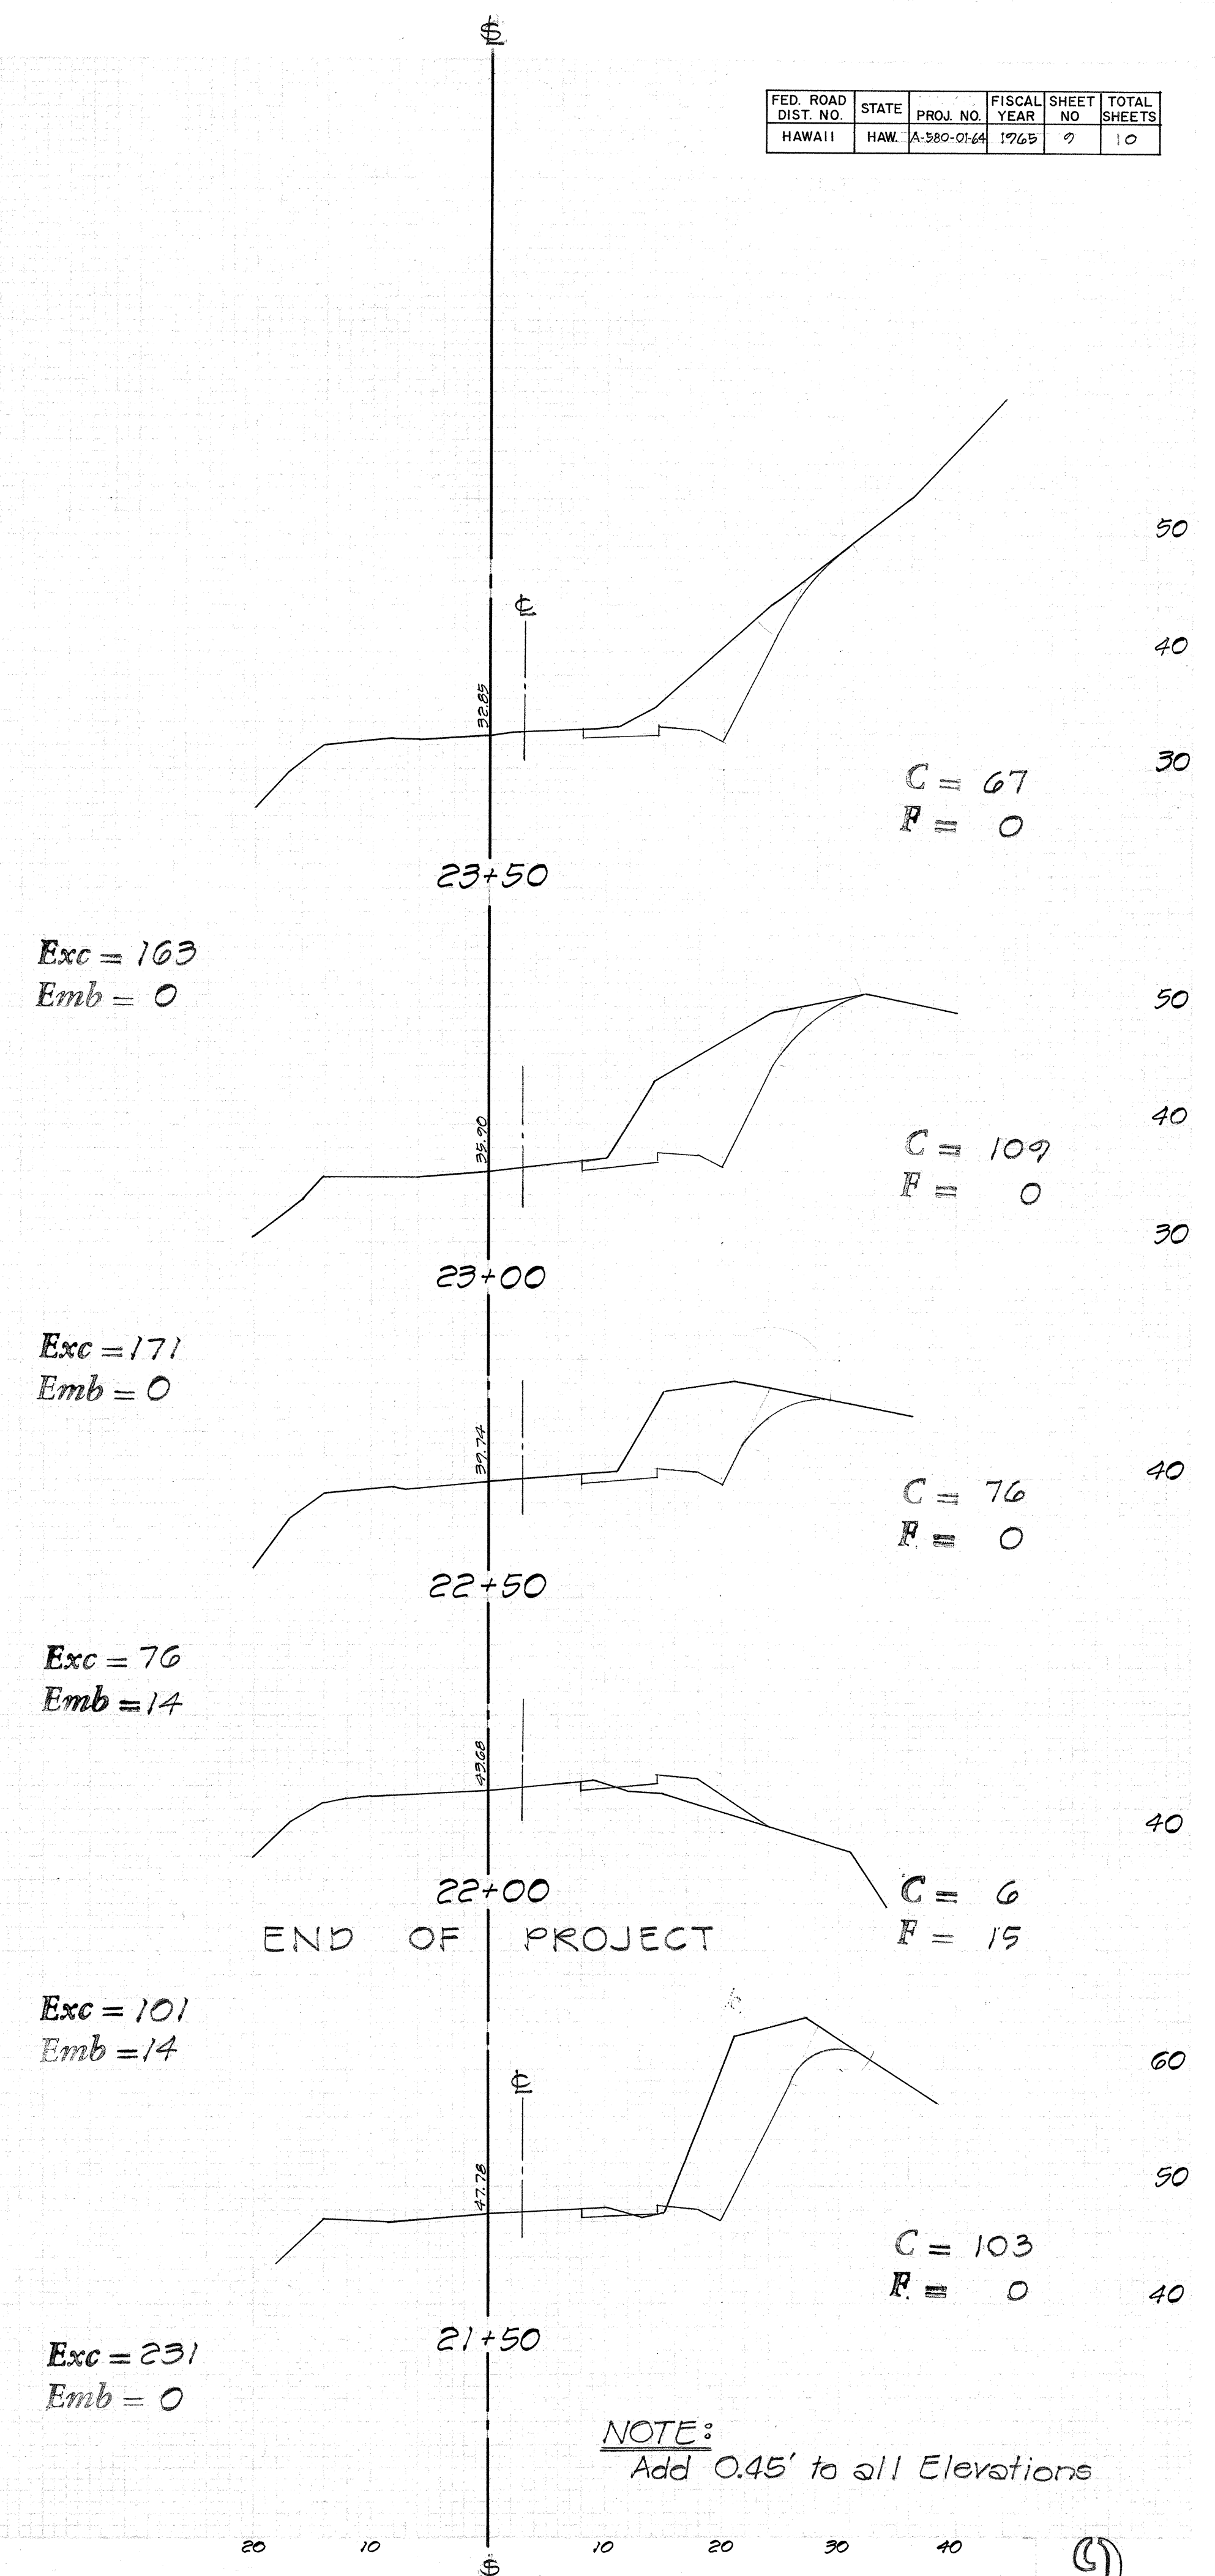

FED. ROAD DIST. No.	STATE	PROJ. No.	FISCAL YEAR	SHEET No.	TOTAL SHEETS
HAWAII	HAW.	A-580-0165	1965	10	10

DESIGNED BY	DATE
CHECKED BY	DATE
NOTED BY	DATE
APPROVED BY	DATE

DESIGNED BY	DATE
CHECKED BY	DATE
NOTED BY	DATE
APPROVED BY	DATE

