
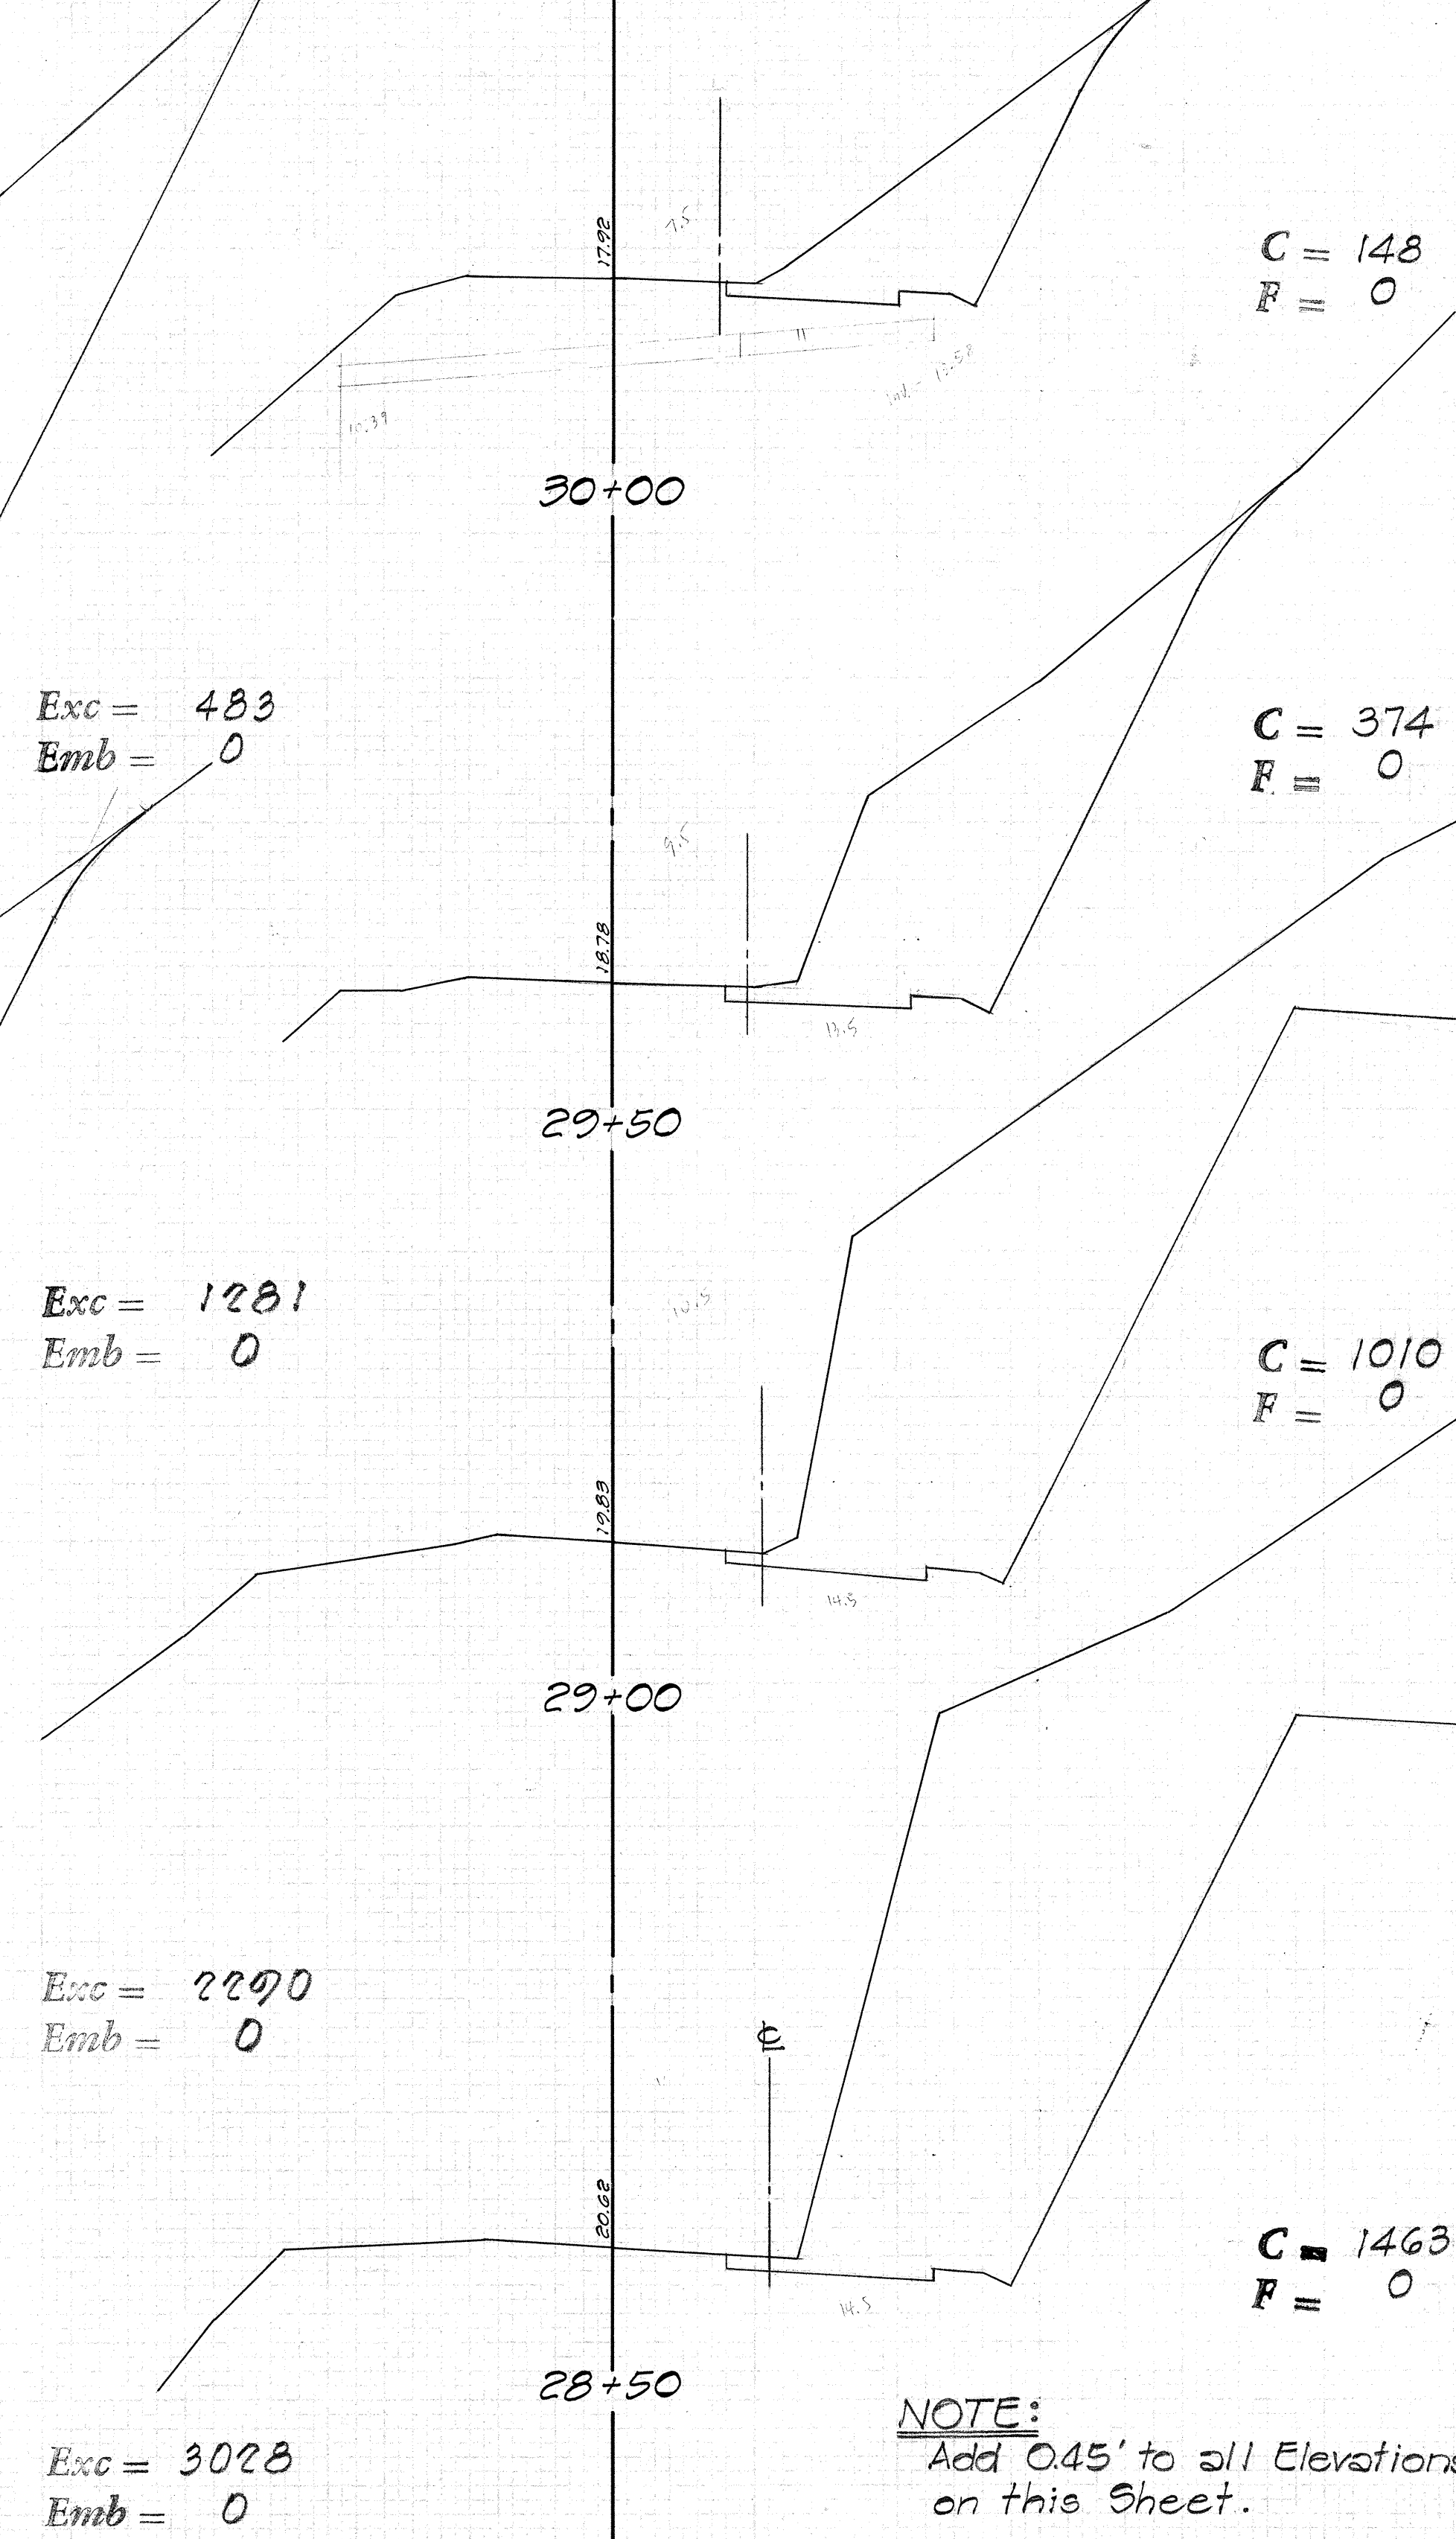
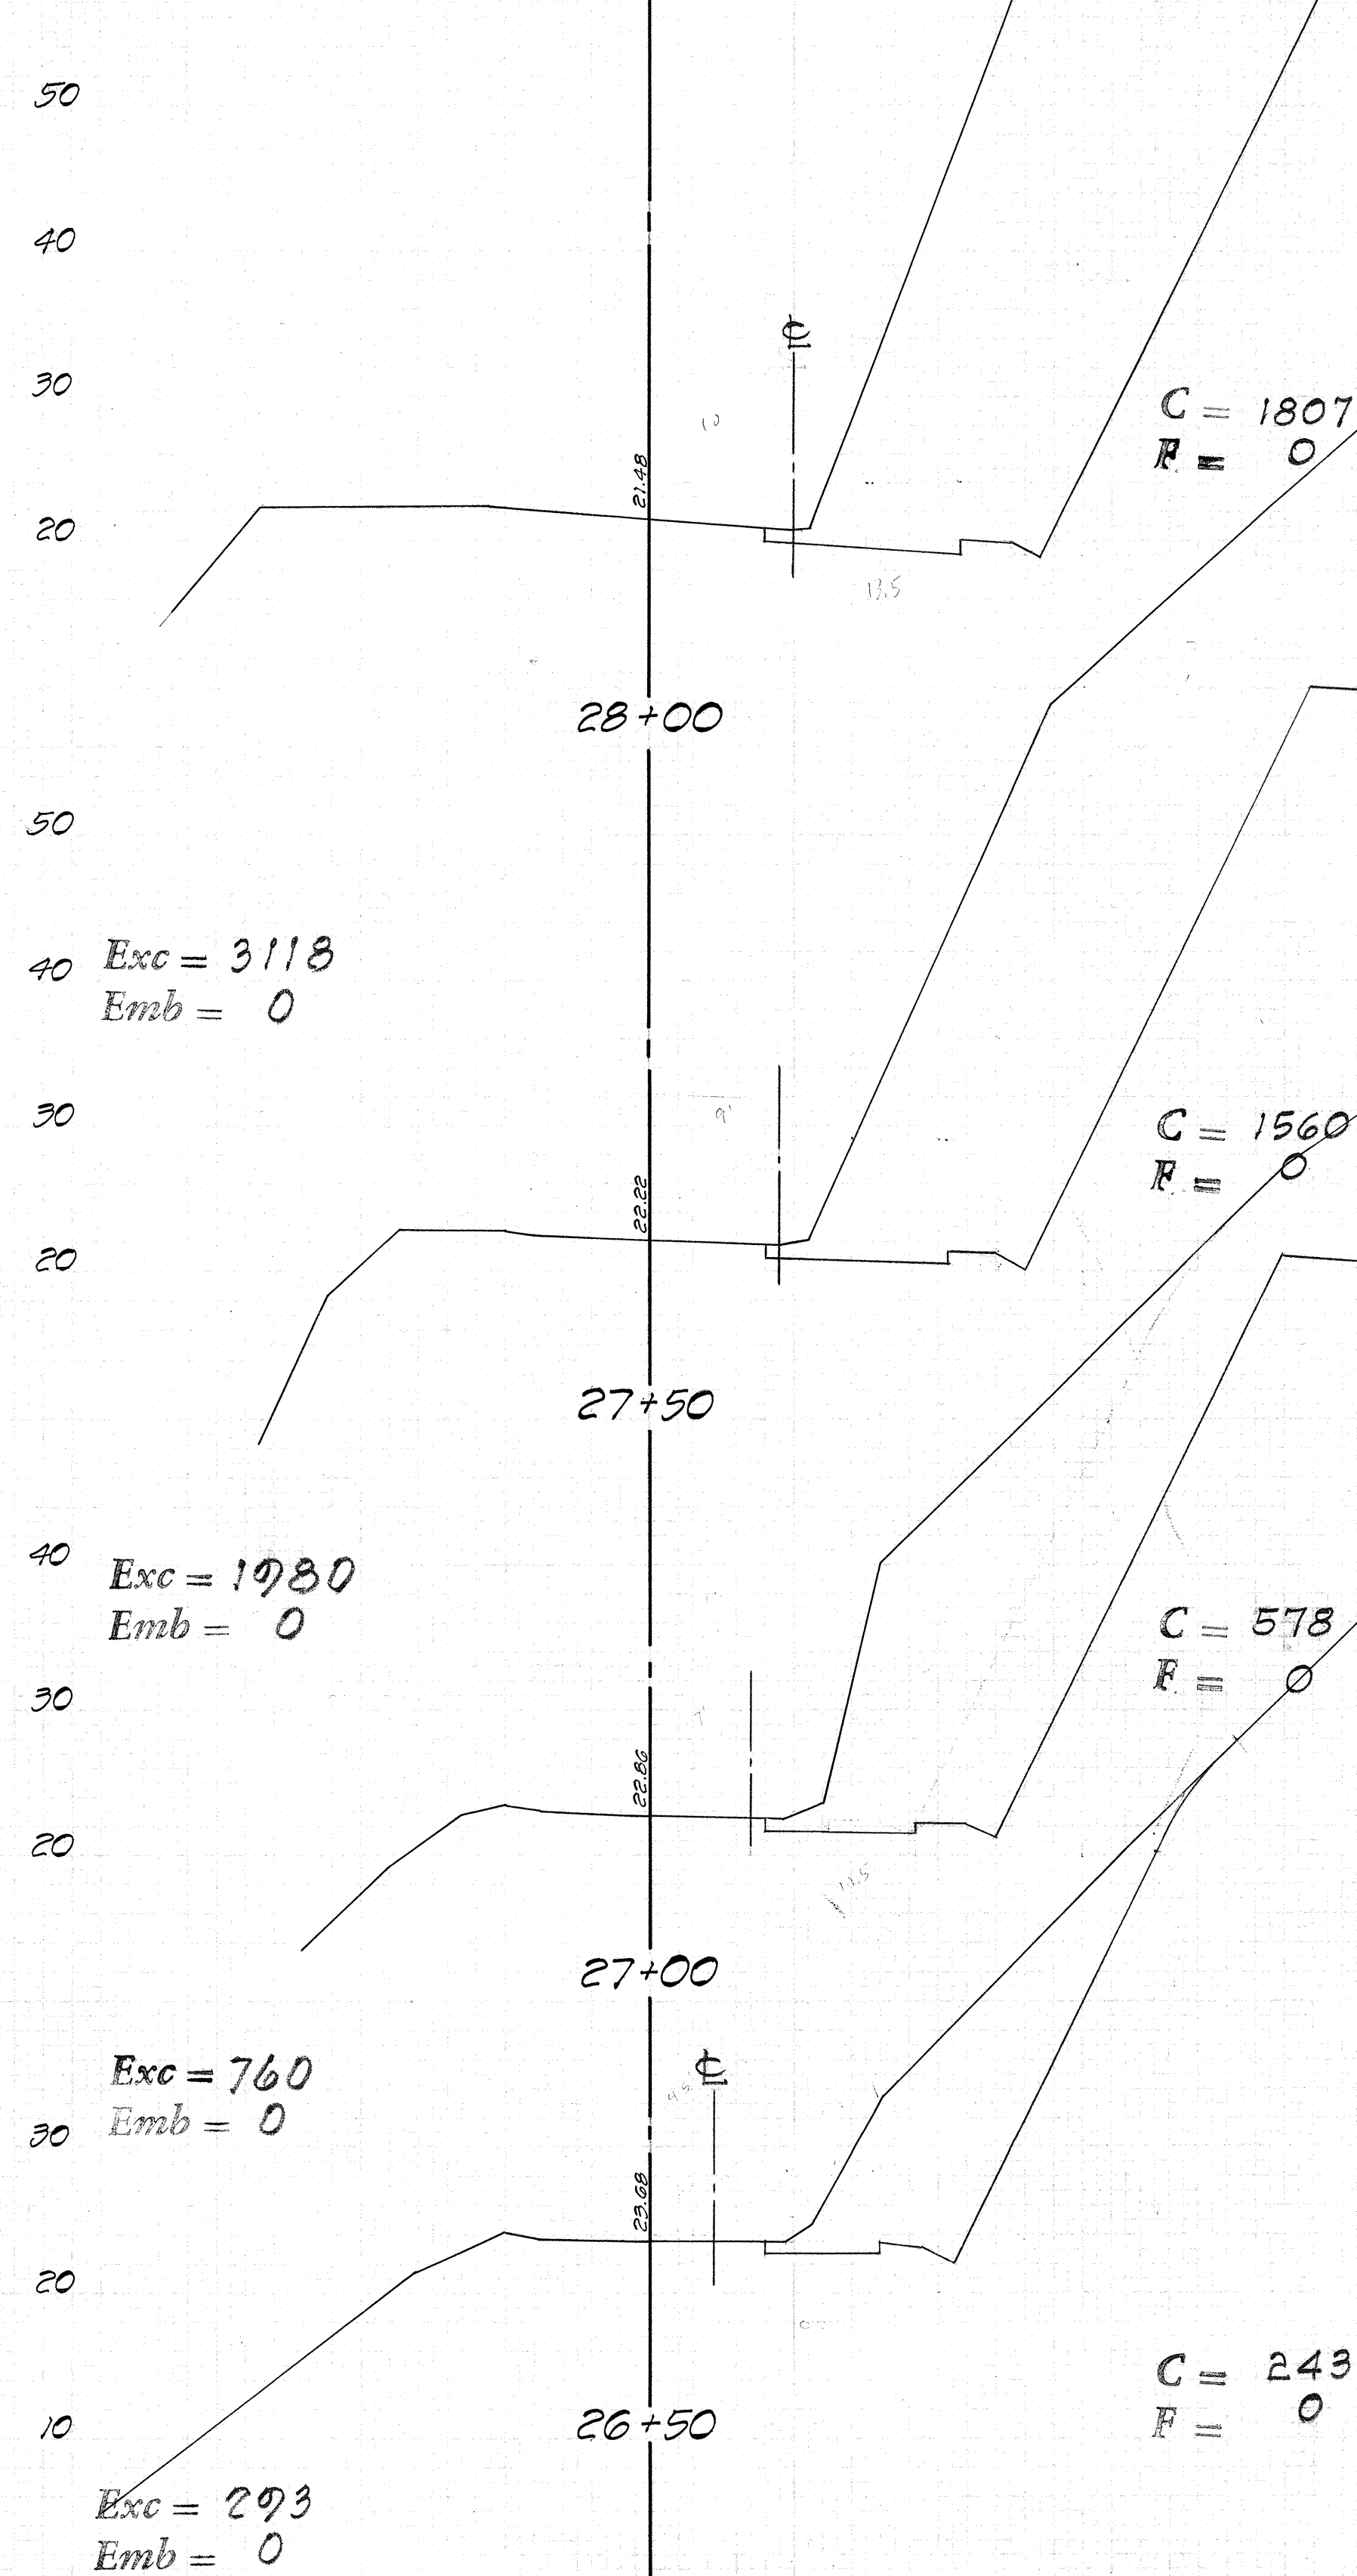


FED. ROAD DIST. NO.	STATE	PROJ. NO.	FISCAL YEAR	SHEET NO.	TOTAL SHEETS
HAWAII	HAW.	A-580-01-64	1966	10	15


DATE	BY	REVISION

DATE	BY	REVISION

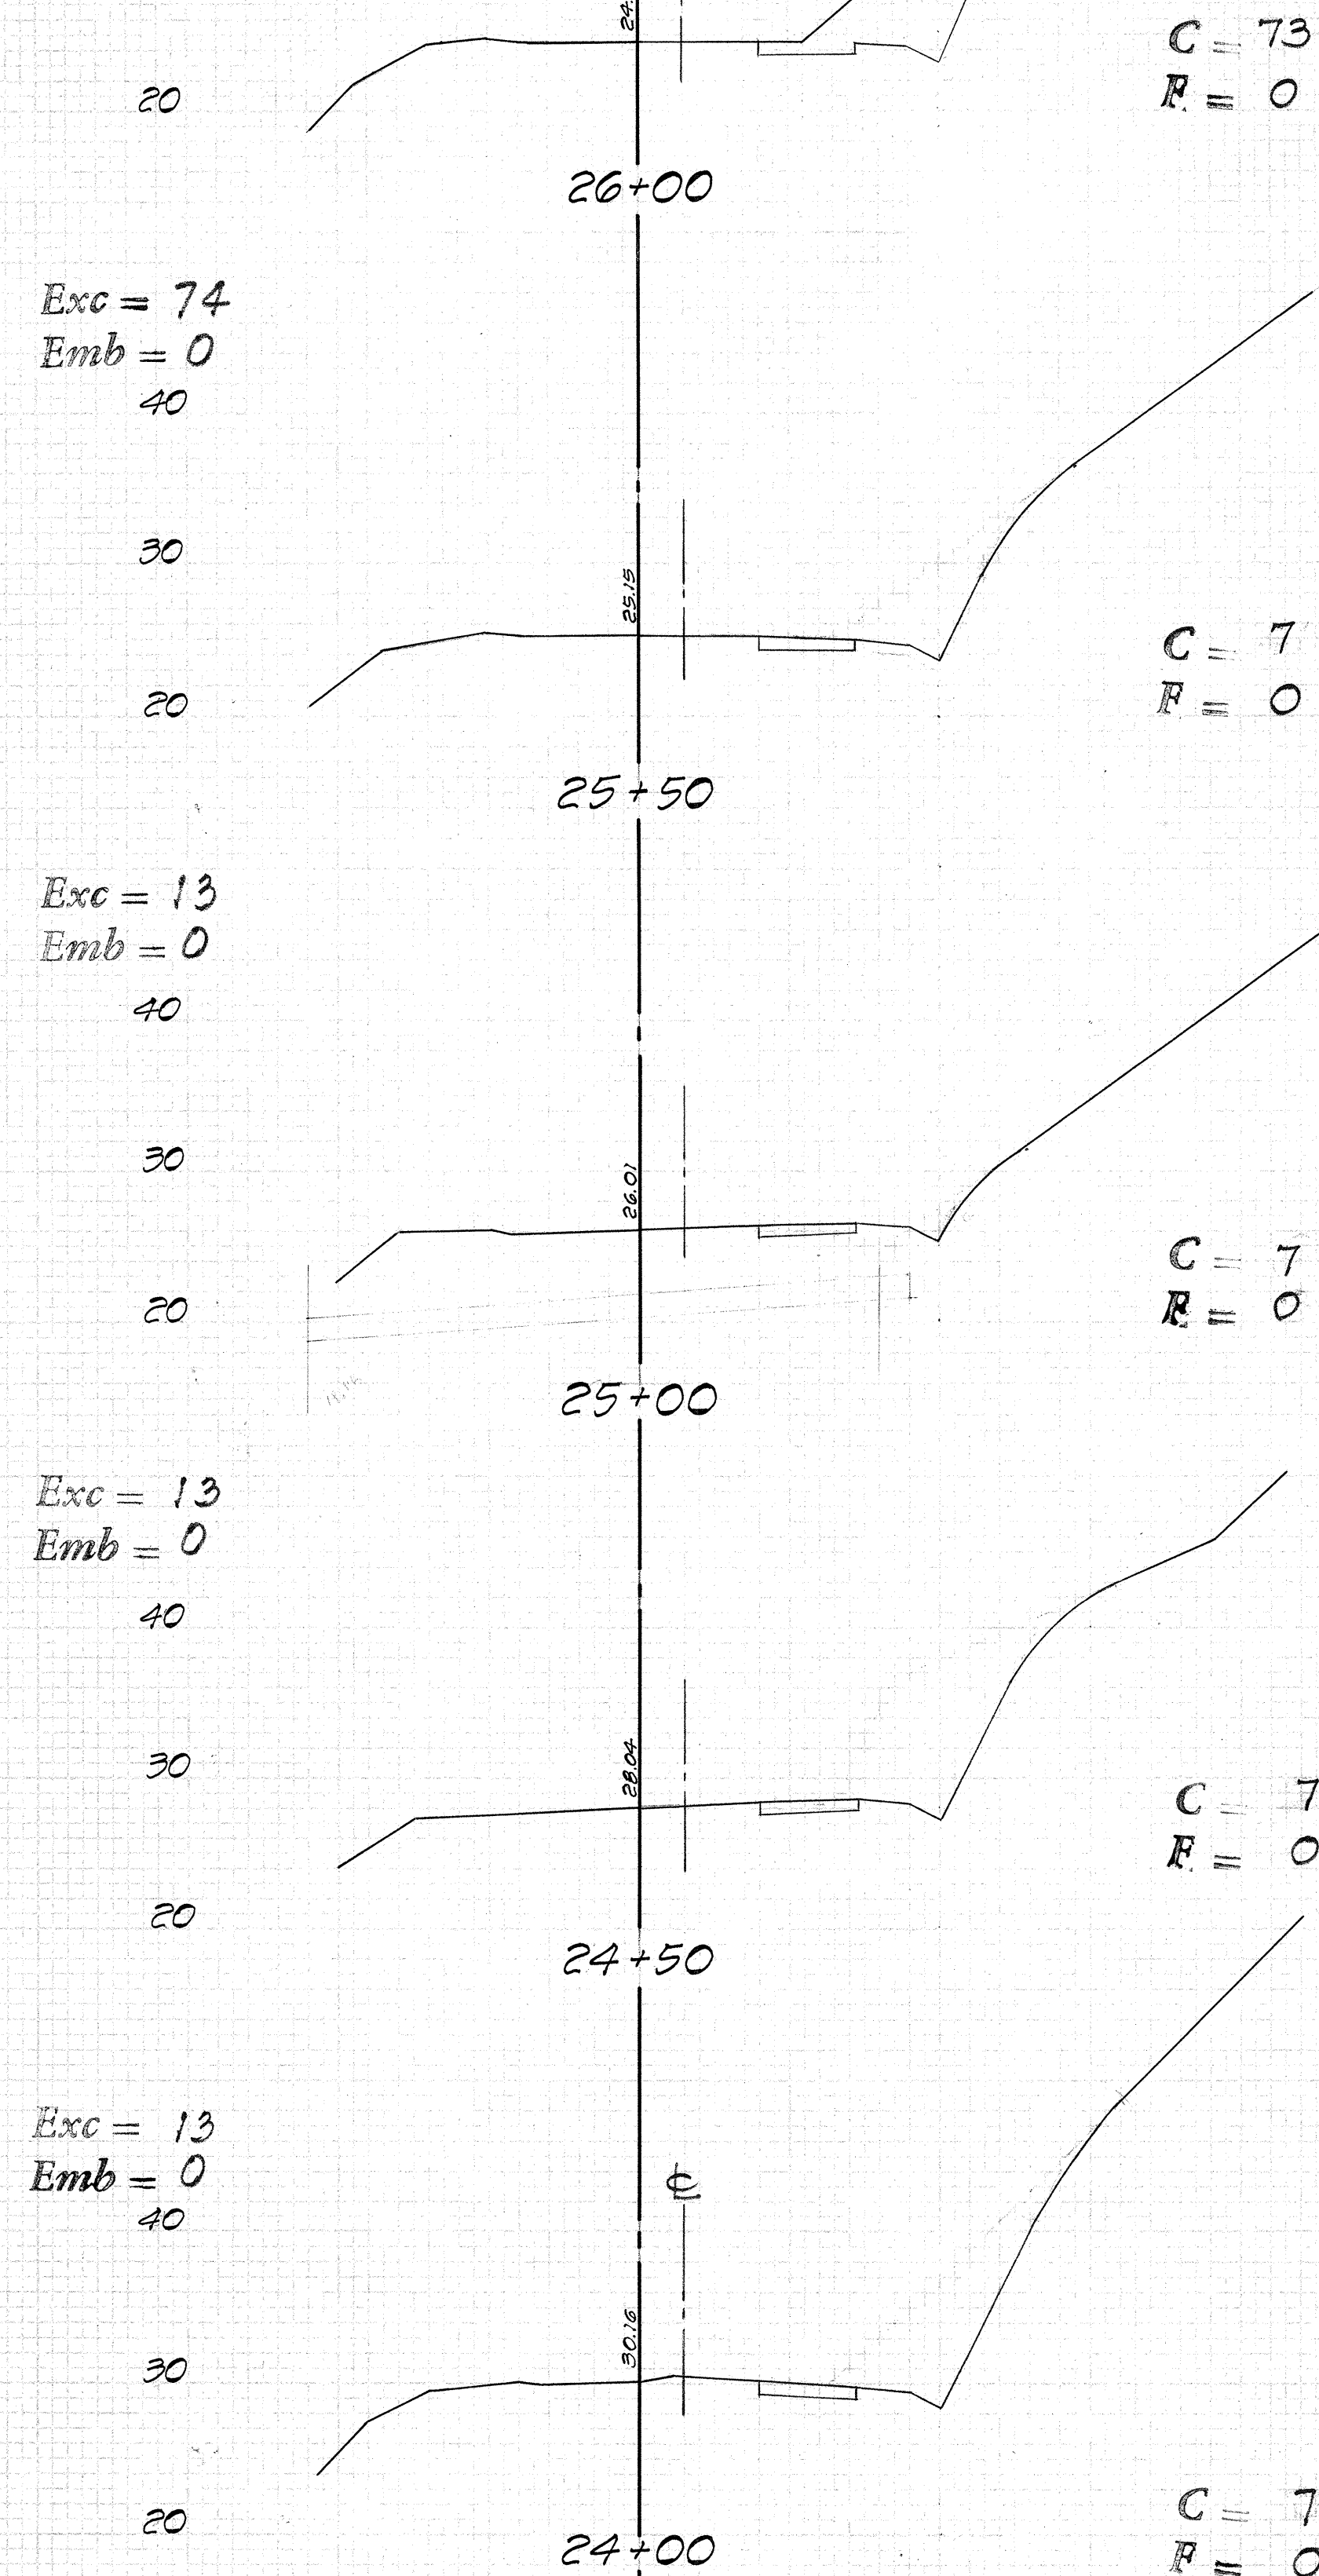

NOTE:
Add 0.45' to all Elevations
on this Sheet.




FED. ROAD DIST. NO.	STATE	PROJ. NO.	FISCAL YEAR	SHEET NO.	TOTAL SHEETS
HAWAII	HAW.	A-580-01-64	1966	11	15

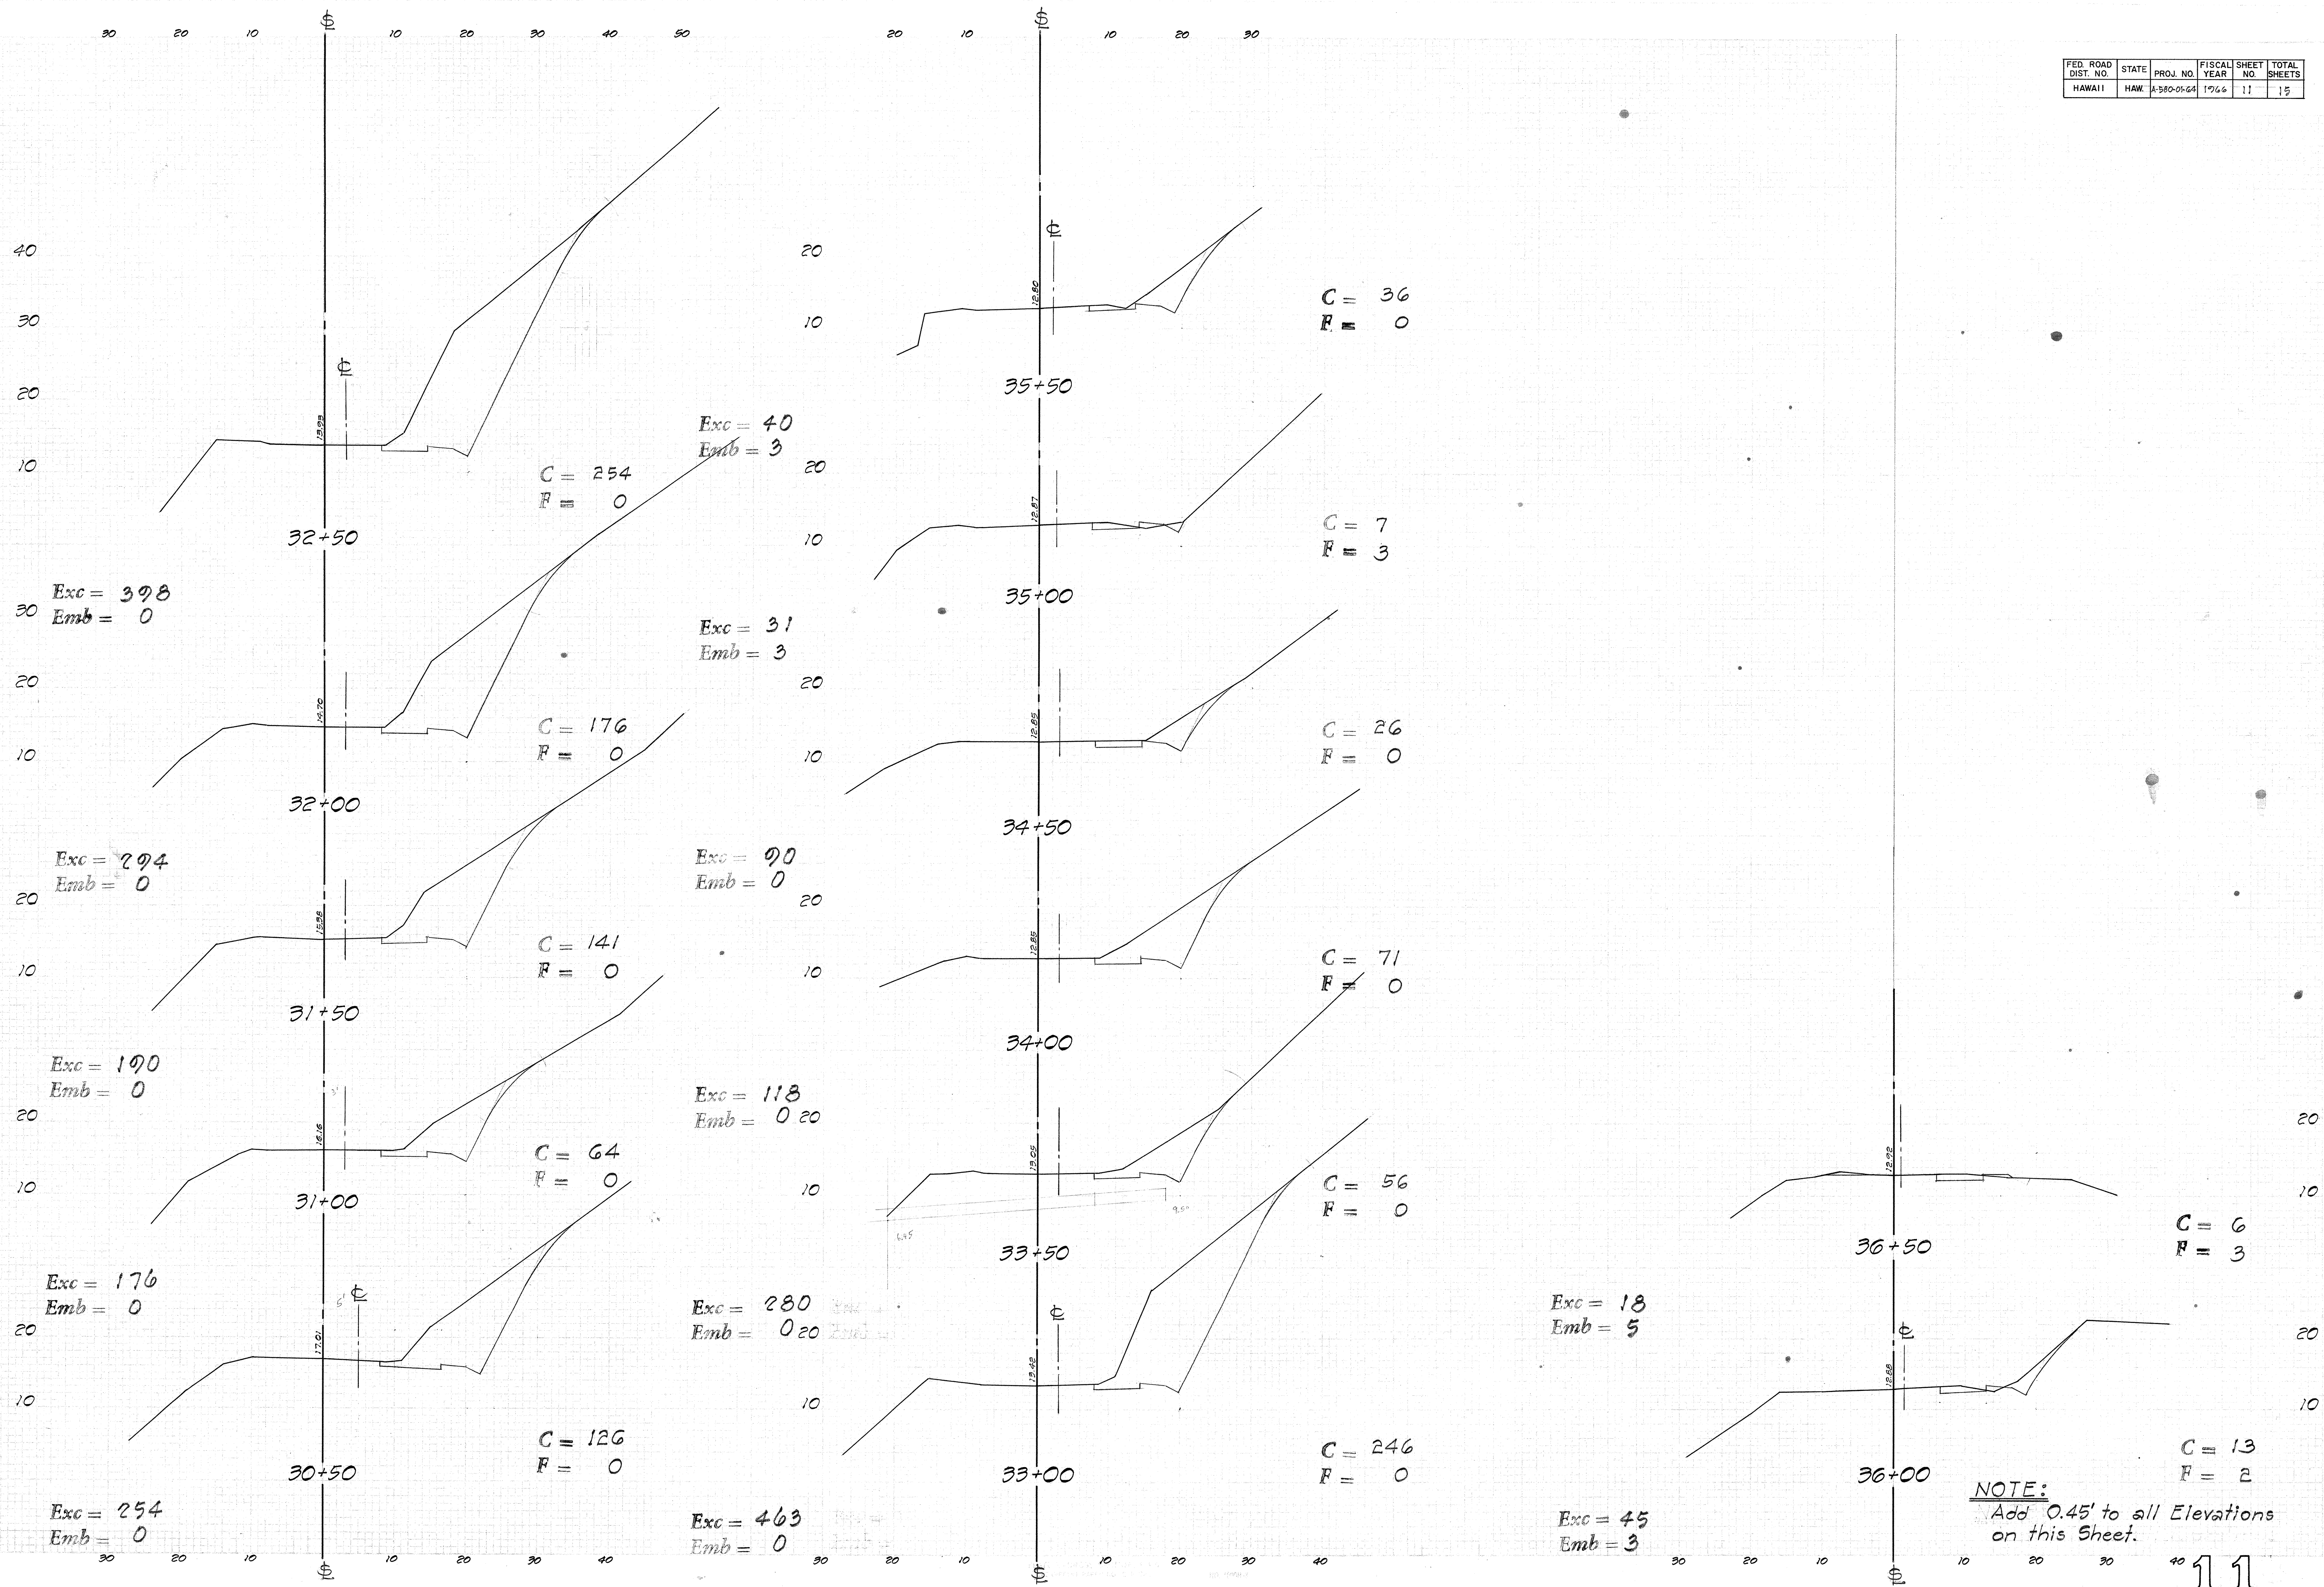



NOTE:
Add 0.45' to all Elevations
on this Sheet.

FINAL
 SURVEY
 PLANNING
 ROUTE BOOK
 NO.

ORIGINAL
 SURVEY
 PLANNING
 ROUTE BOOK
 NO.

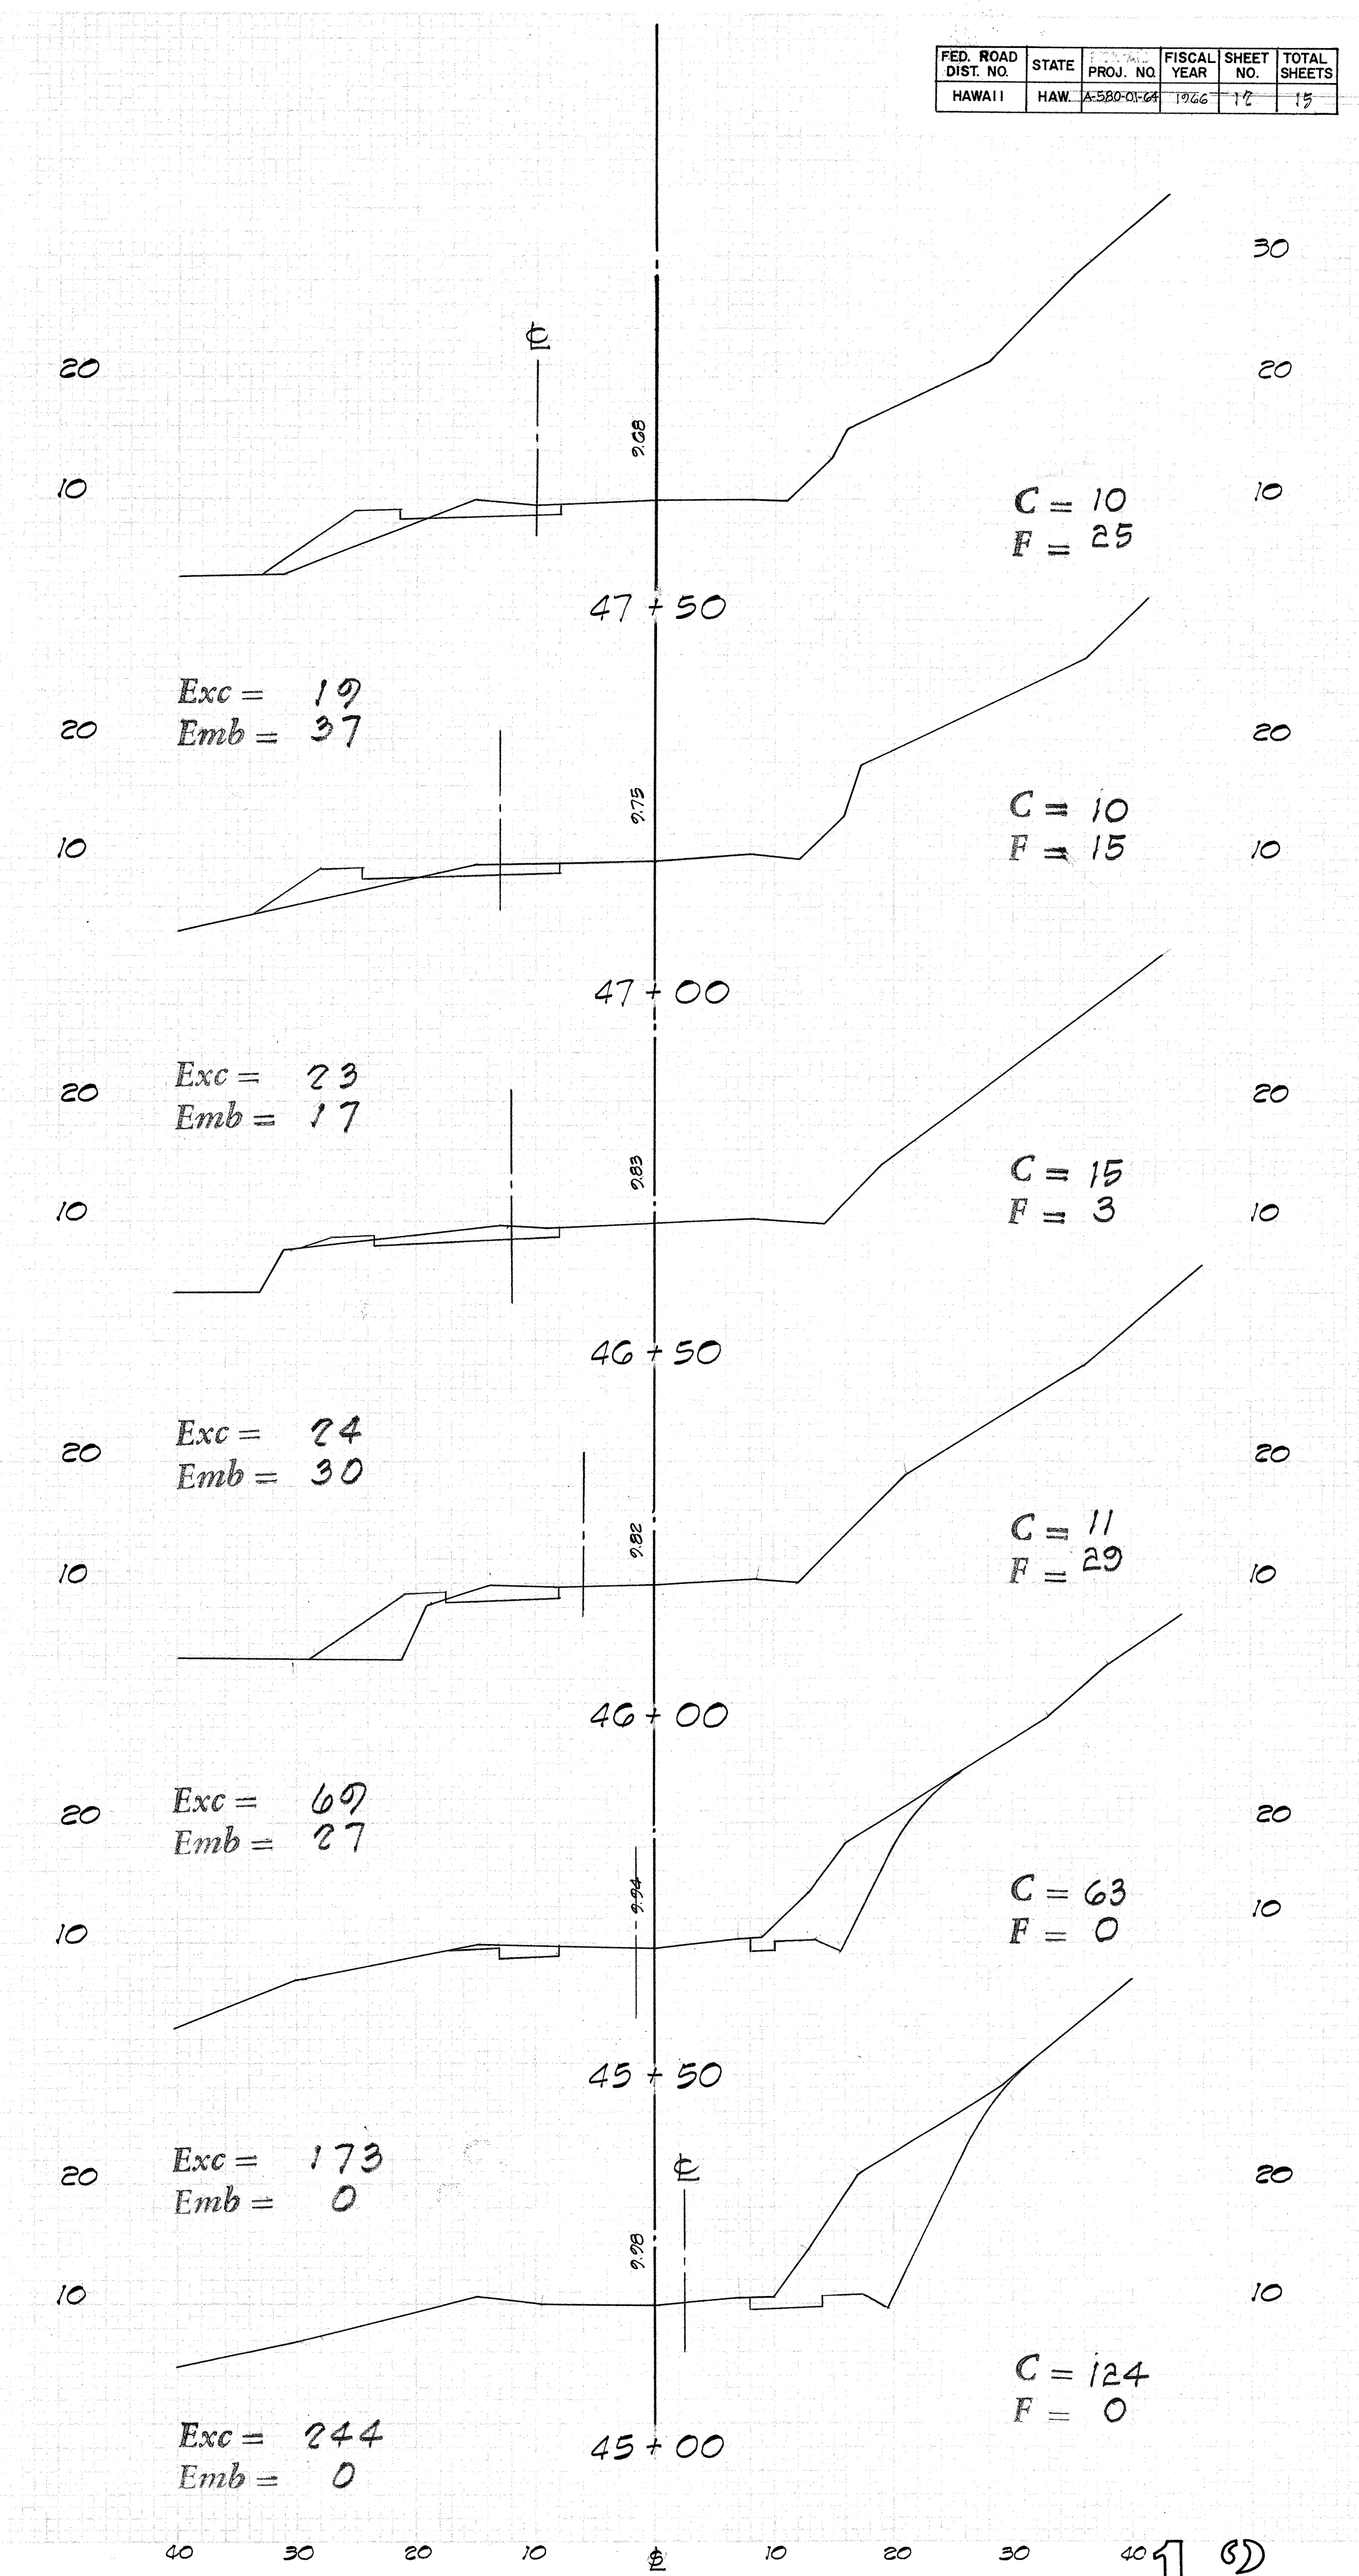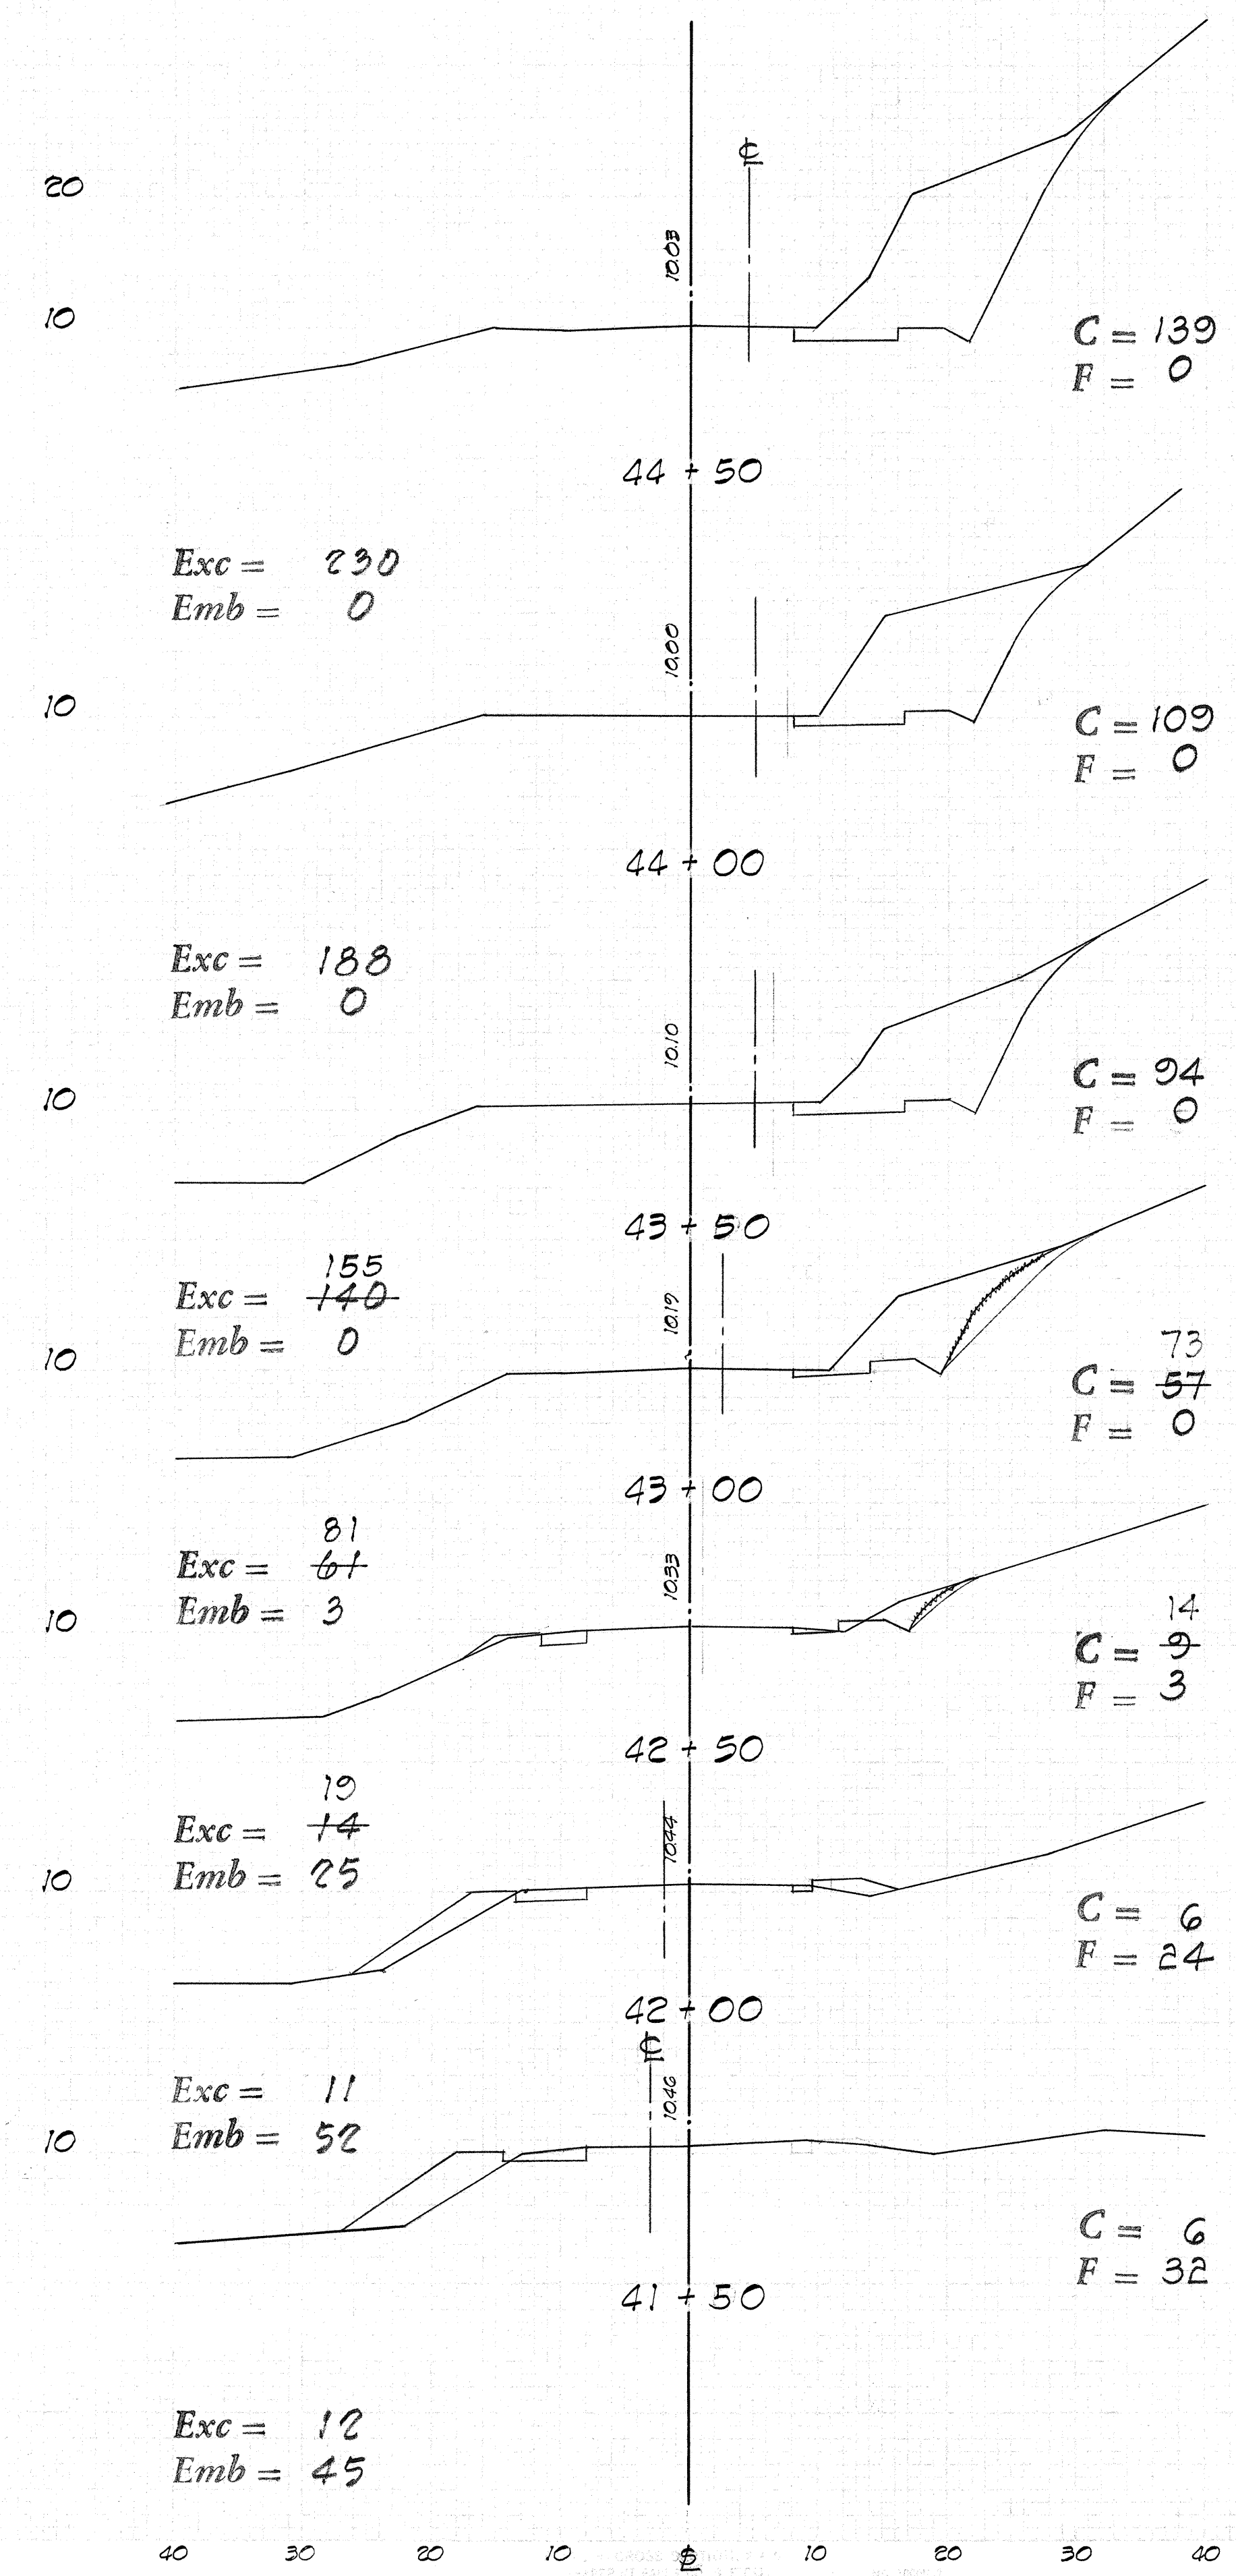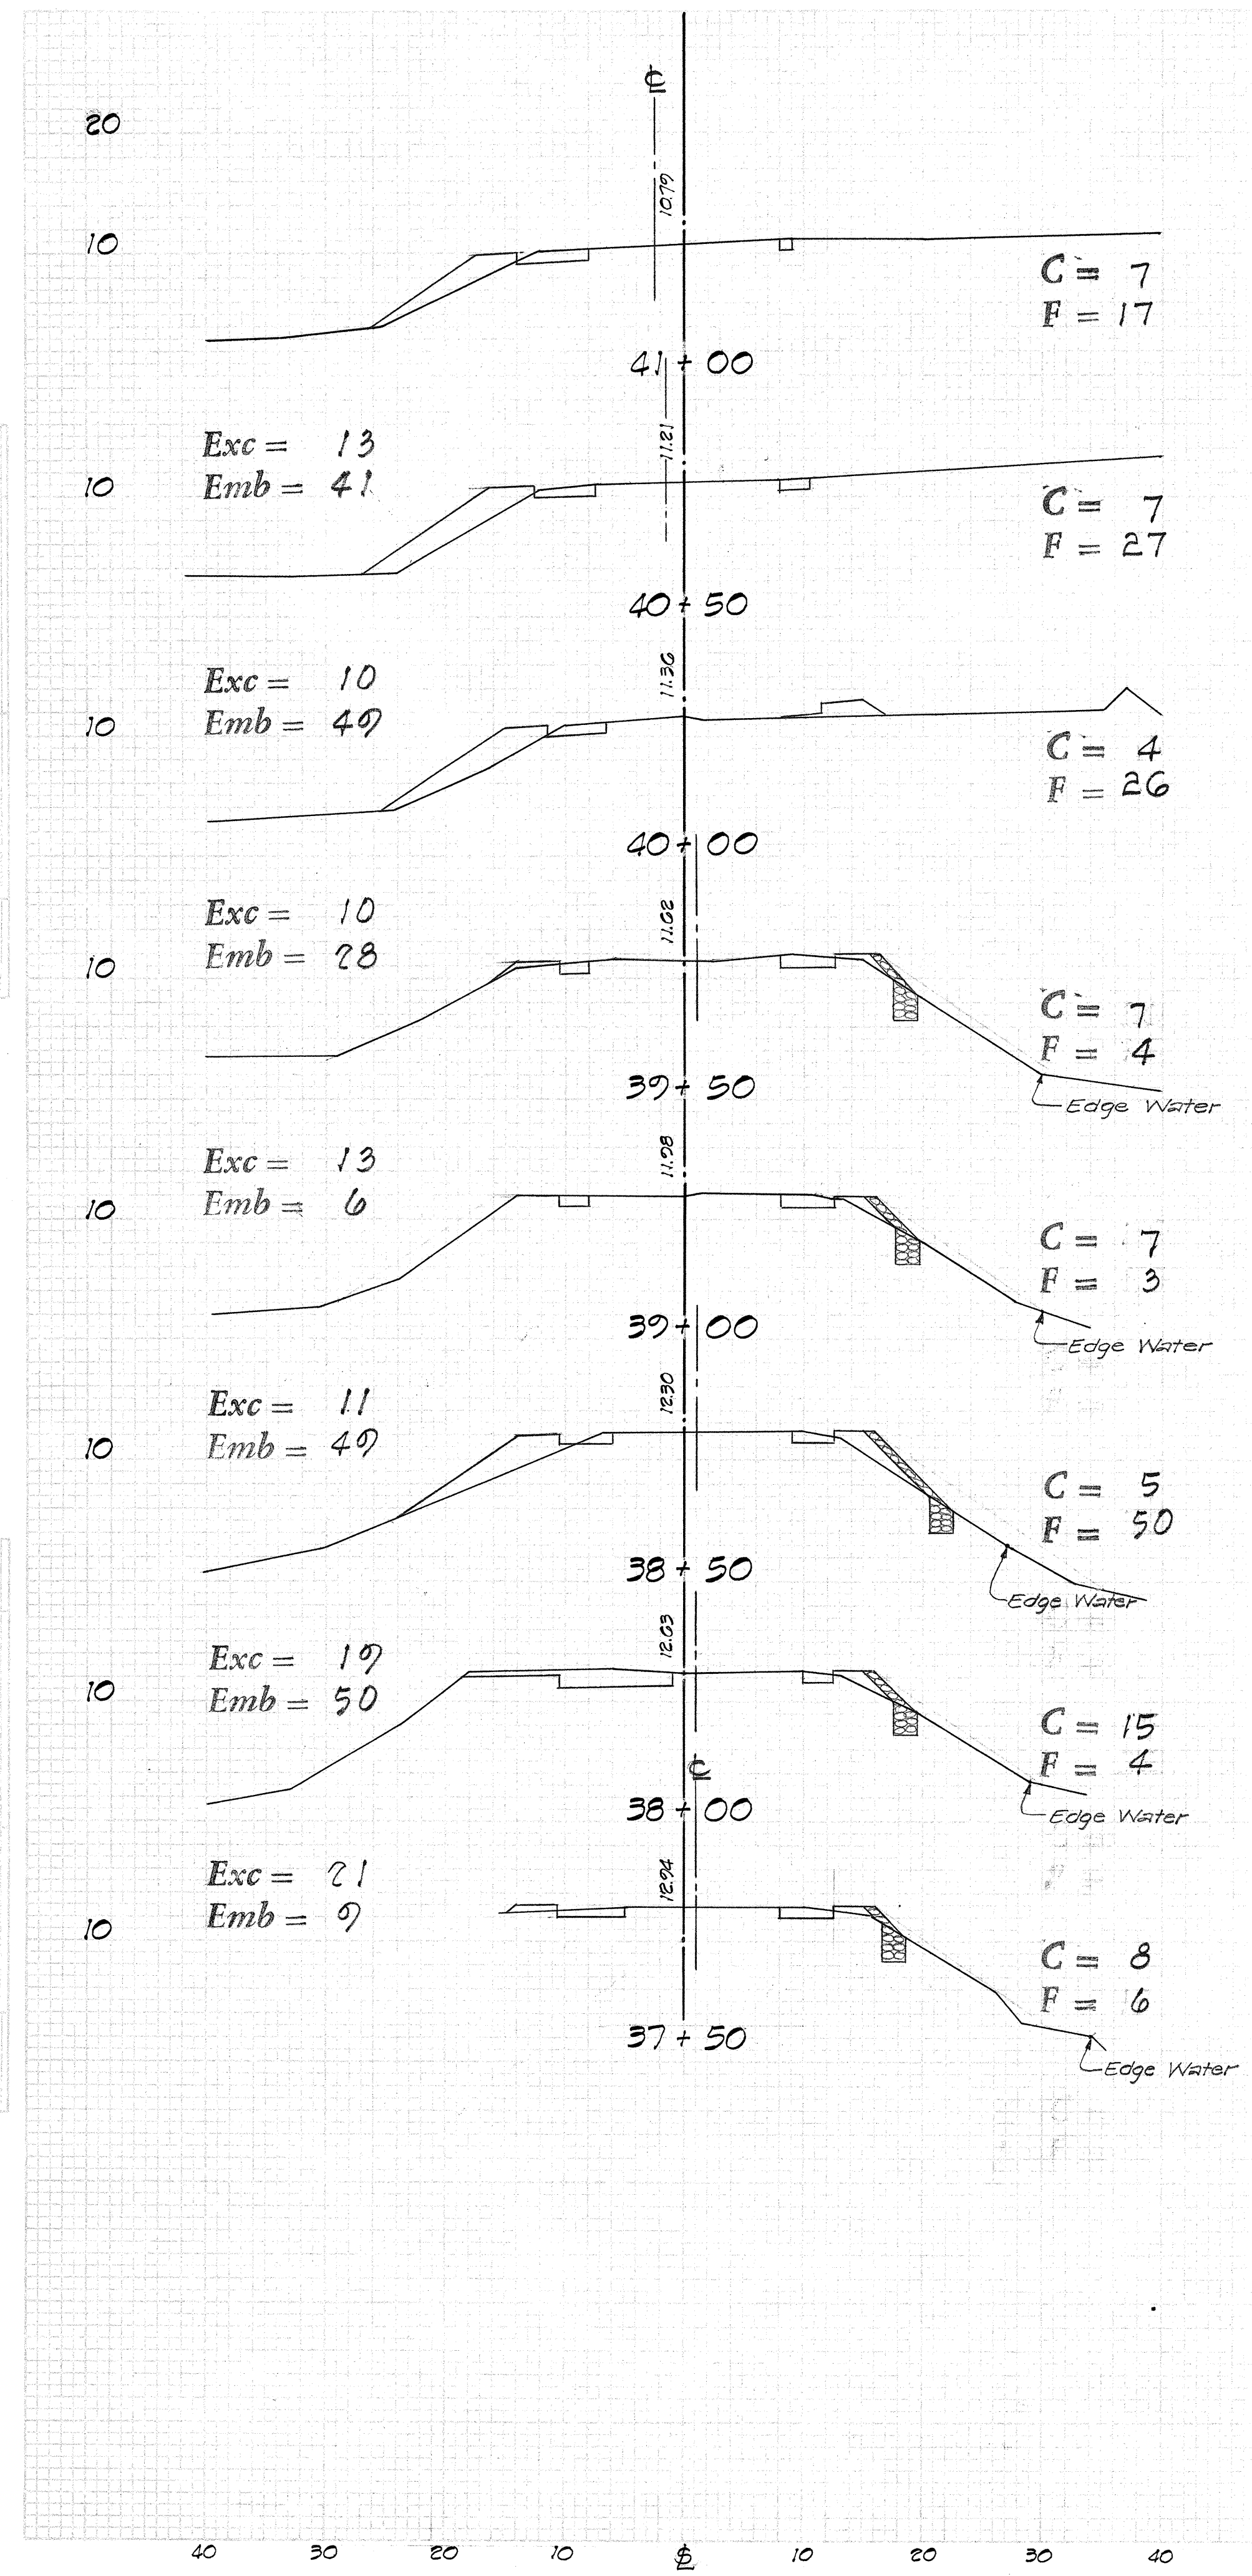

FED. ROAD DIST. NO.	STATE	PROJ. NO.	FISCAL YEAR	SHEET NO.	TOTAL SHEETS
HAWAII	HAW.	A-980-01-64	1964	13	15

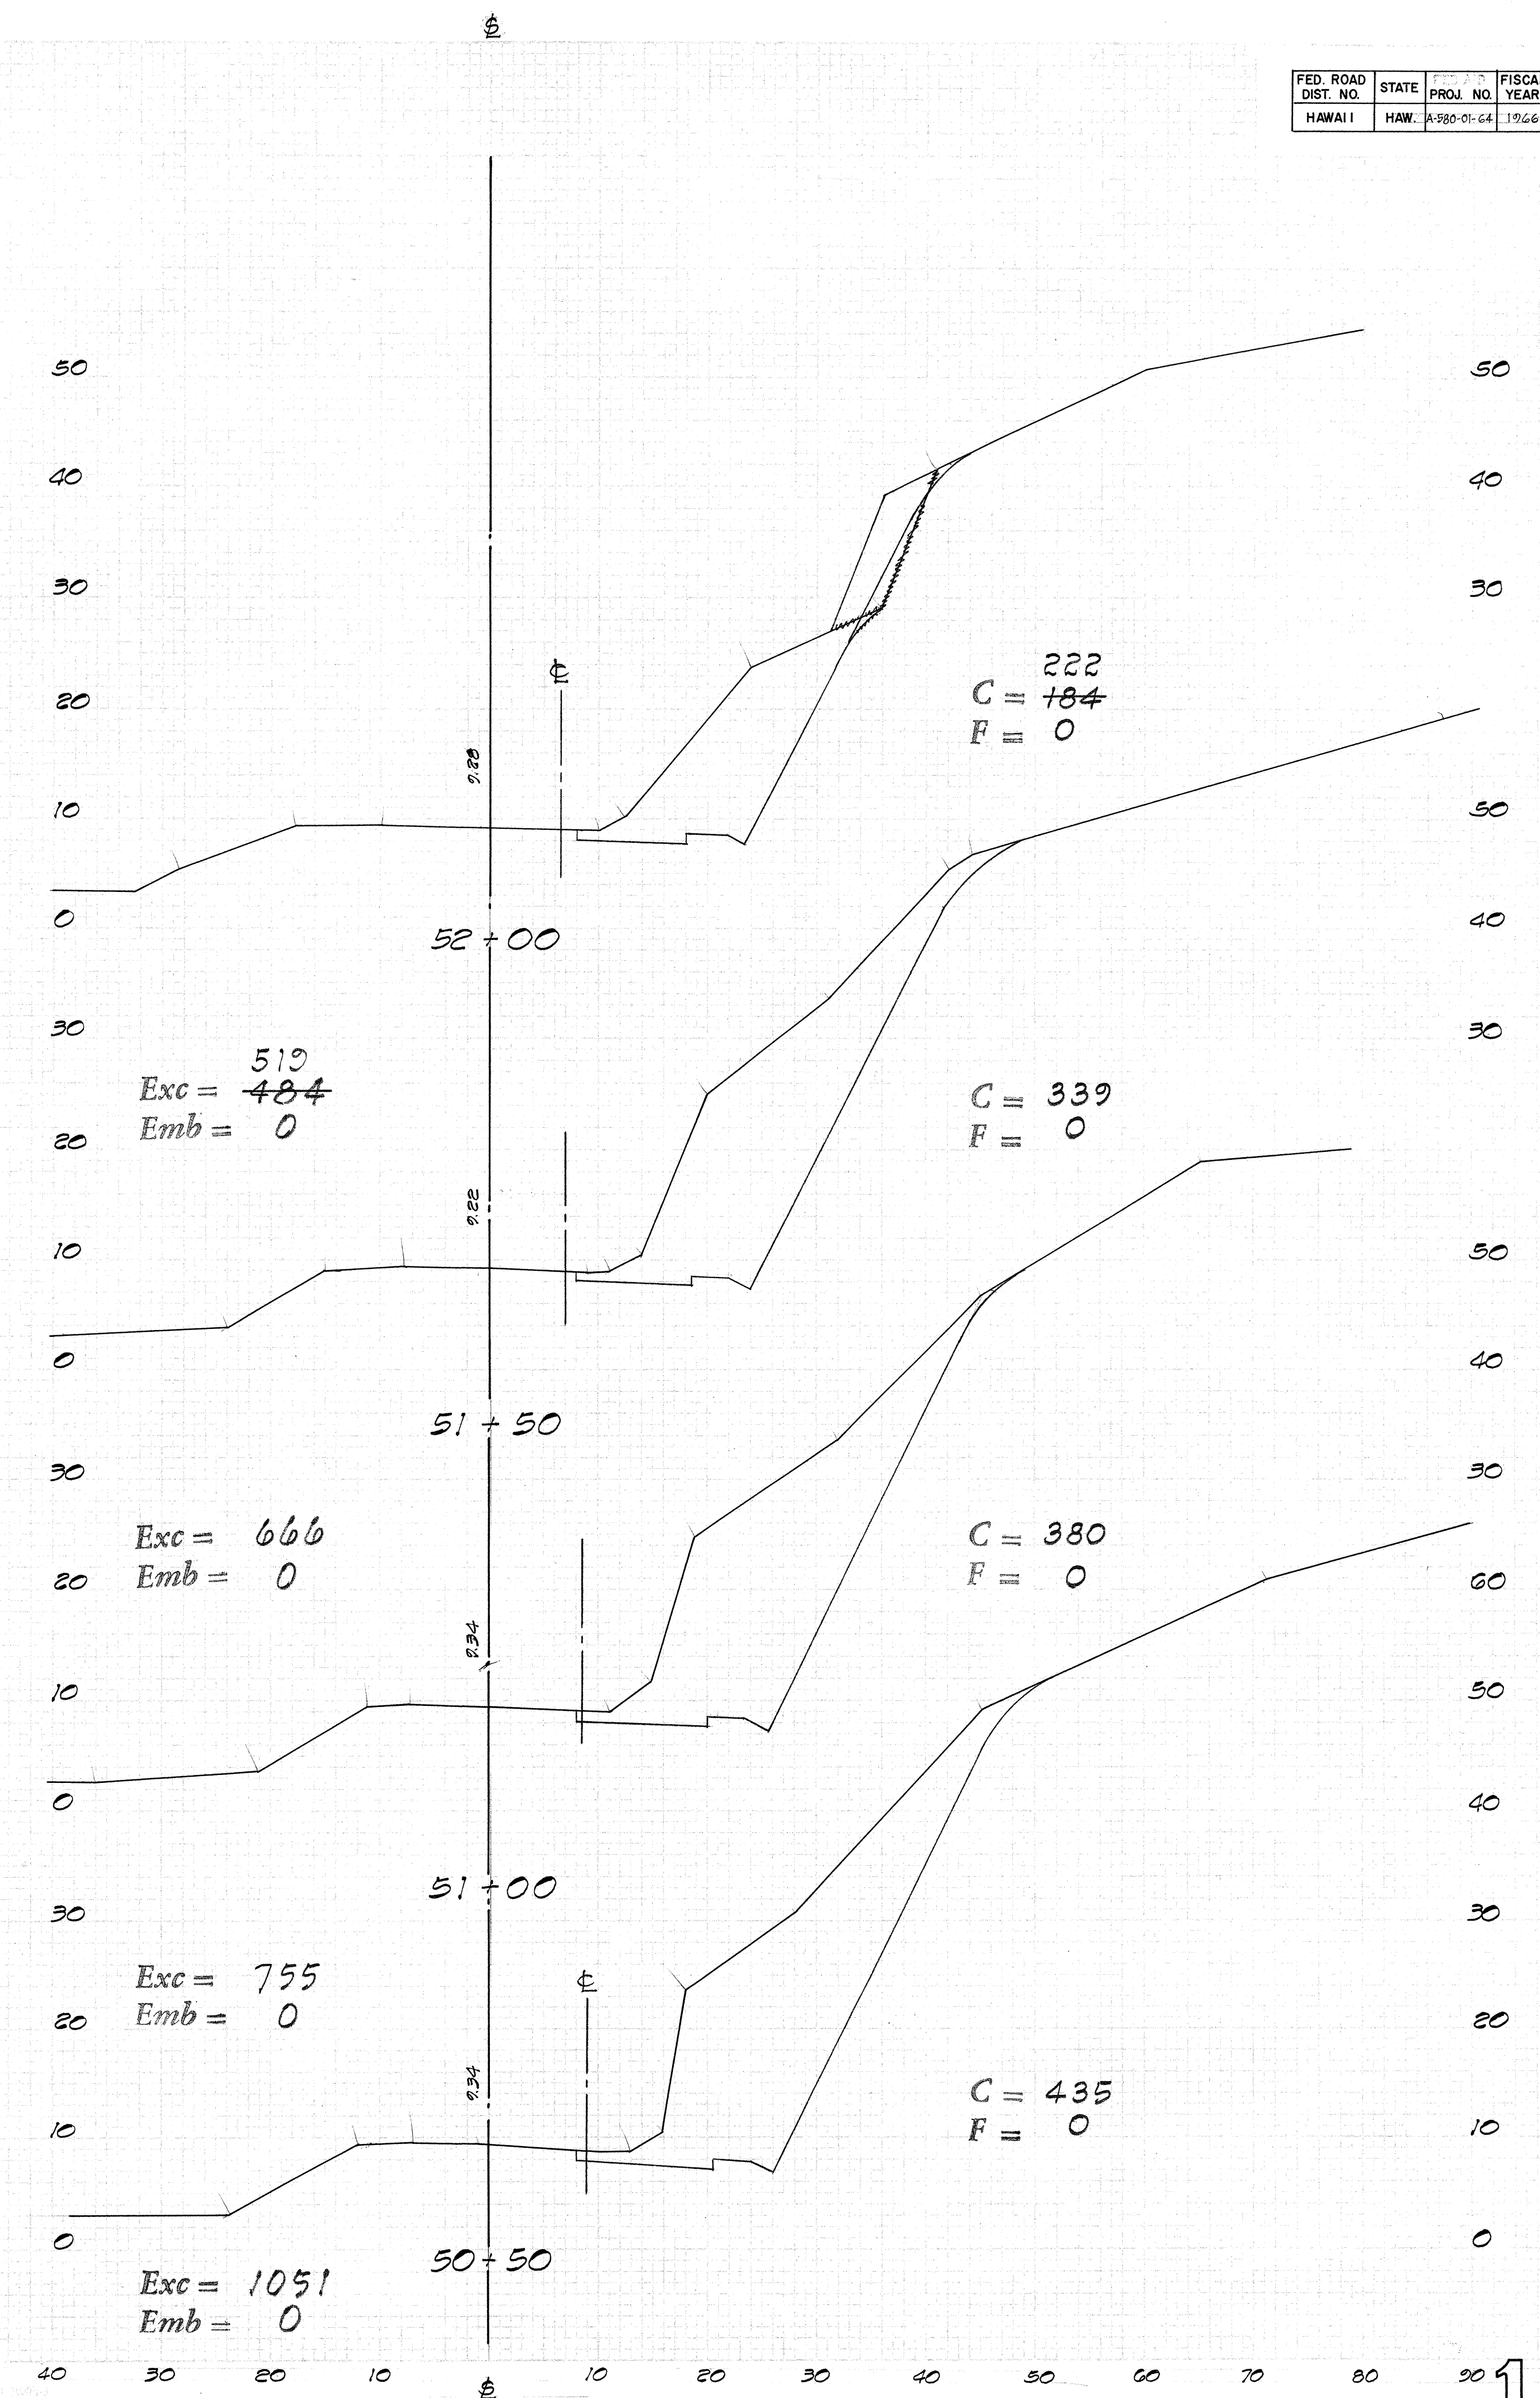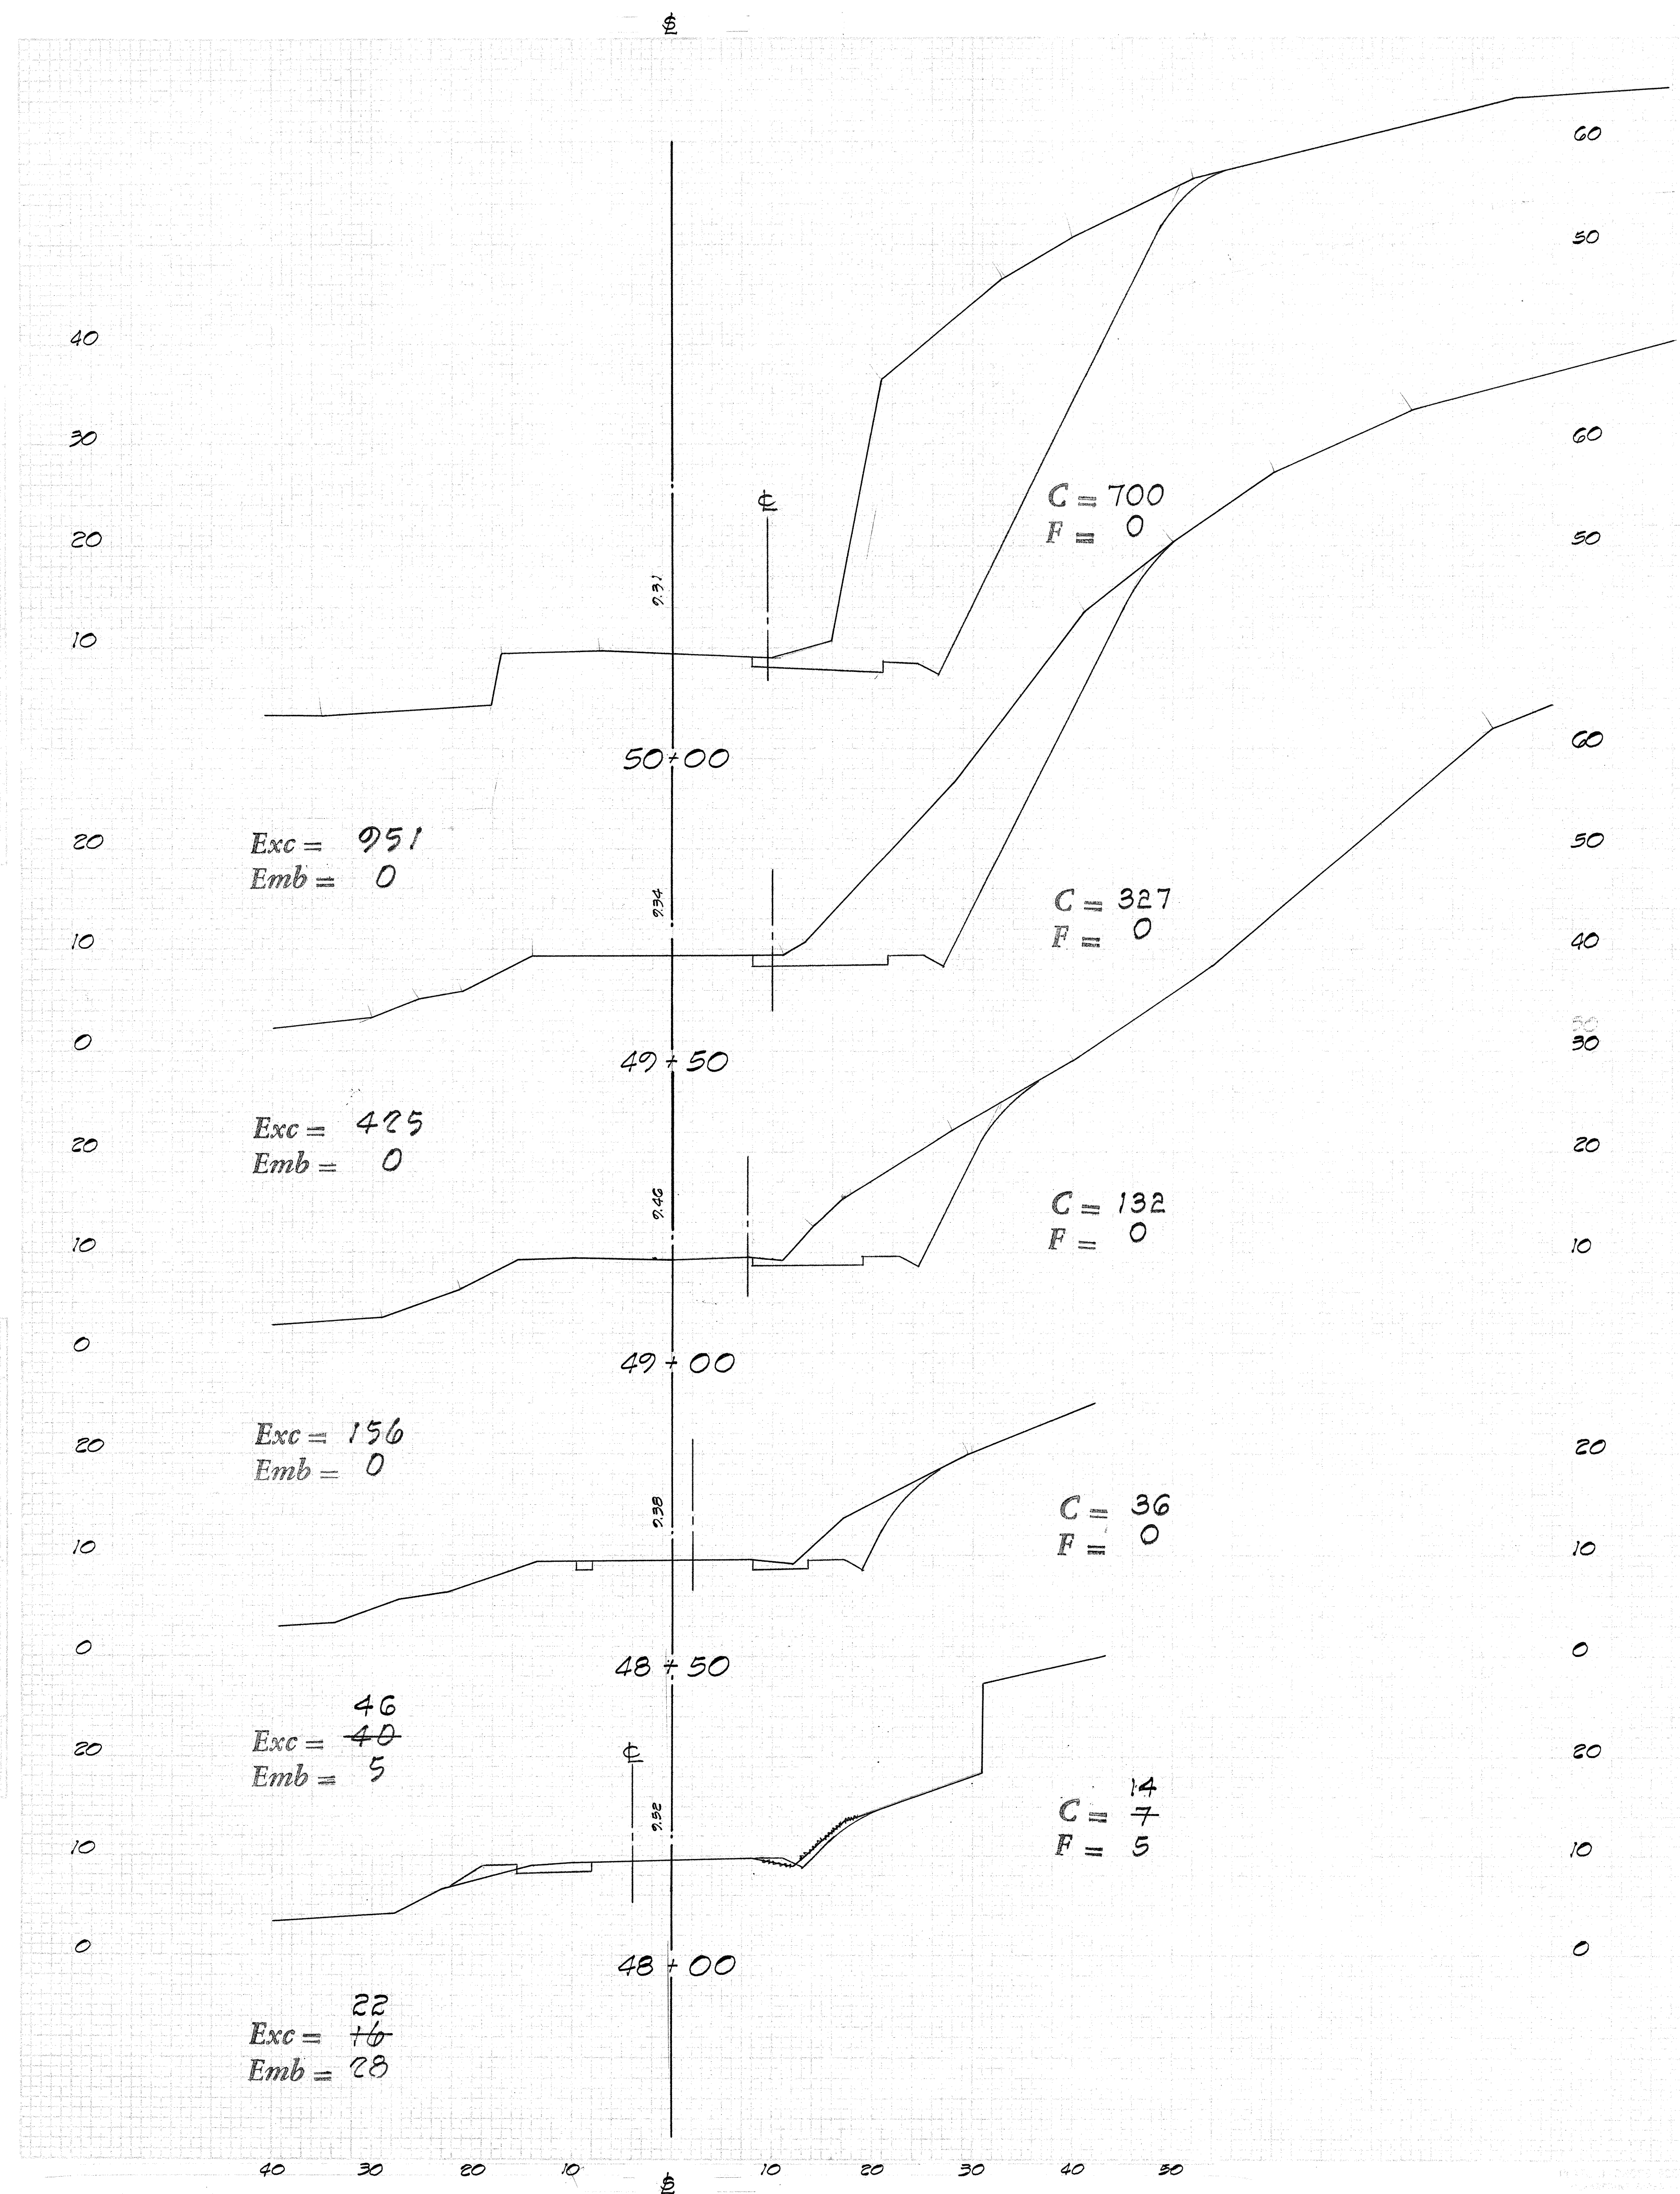

FED. ROAD DIST. NO.	STATE	PROJ. NO.	FISCAL YEAR	SHEET NO.	TOTAL SHEETS
HAWAII	HAW.	A-580-0164	1966	14	15

DATE	NO.
DESIGNED	
CHECKED	
APPROVED	
NOTED	
DATE	

DATE	NO.
DESIGNED	
CHECKED	
APPROVED	
NOTED	
DATE	

