INC	EX TO DRAWINGS
SHEET NO	DESCRIPTION
	TITLE SHEET
2	TYPICAL SECTION
3 - 6	PLAN & PROFILE
. 7 - 9	STANDARD DETAILS
10 - 15	CROSS SECTIONS

PRINTED ON DIETZGEN 198M AGEPROOF

DEPARTMENT OF HAWAII


HIGHWAYS DIVISION


"AS BUILT" PLANS FOR

REALIGNING, WIDENING, AND RESURFACING OF KUAMOO ROAD PHASE II

PROJECT NO. A-580-01-64

DISTRICT OF KAWAIHAU
ISLAND OF KAUAI

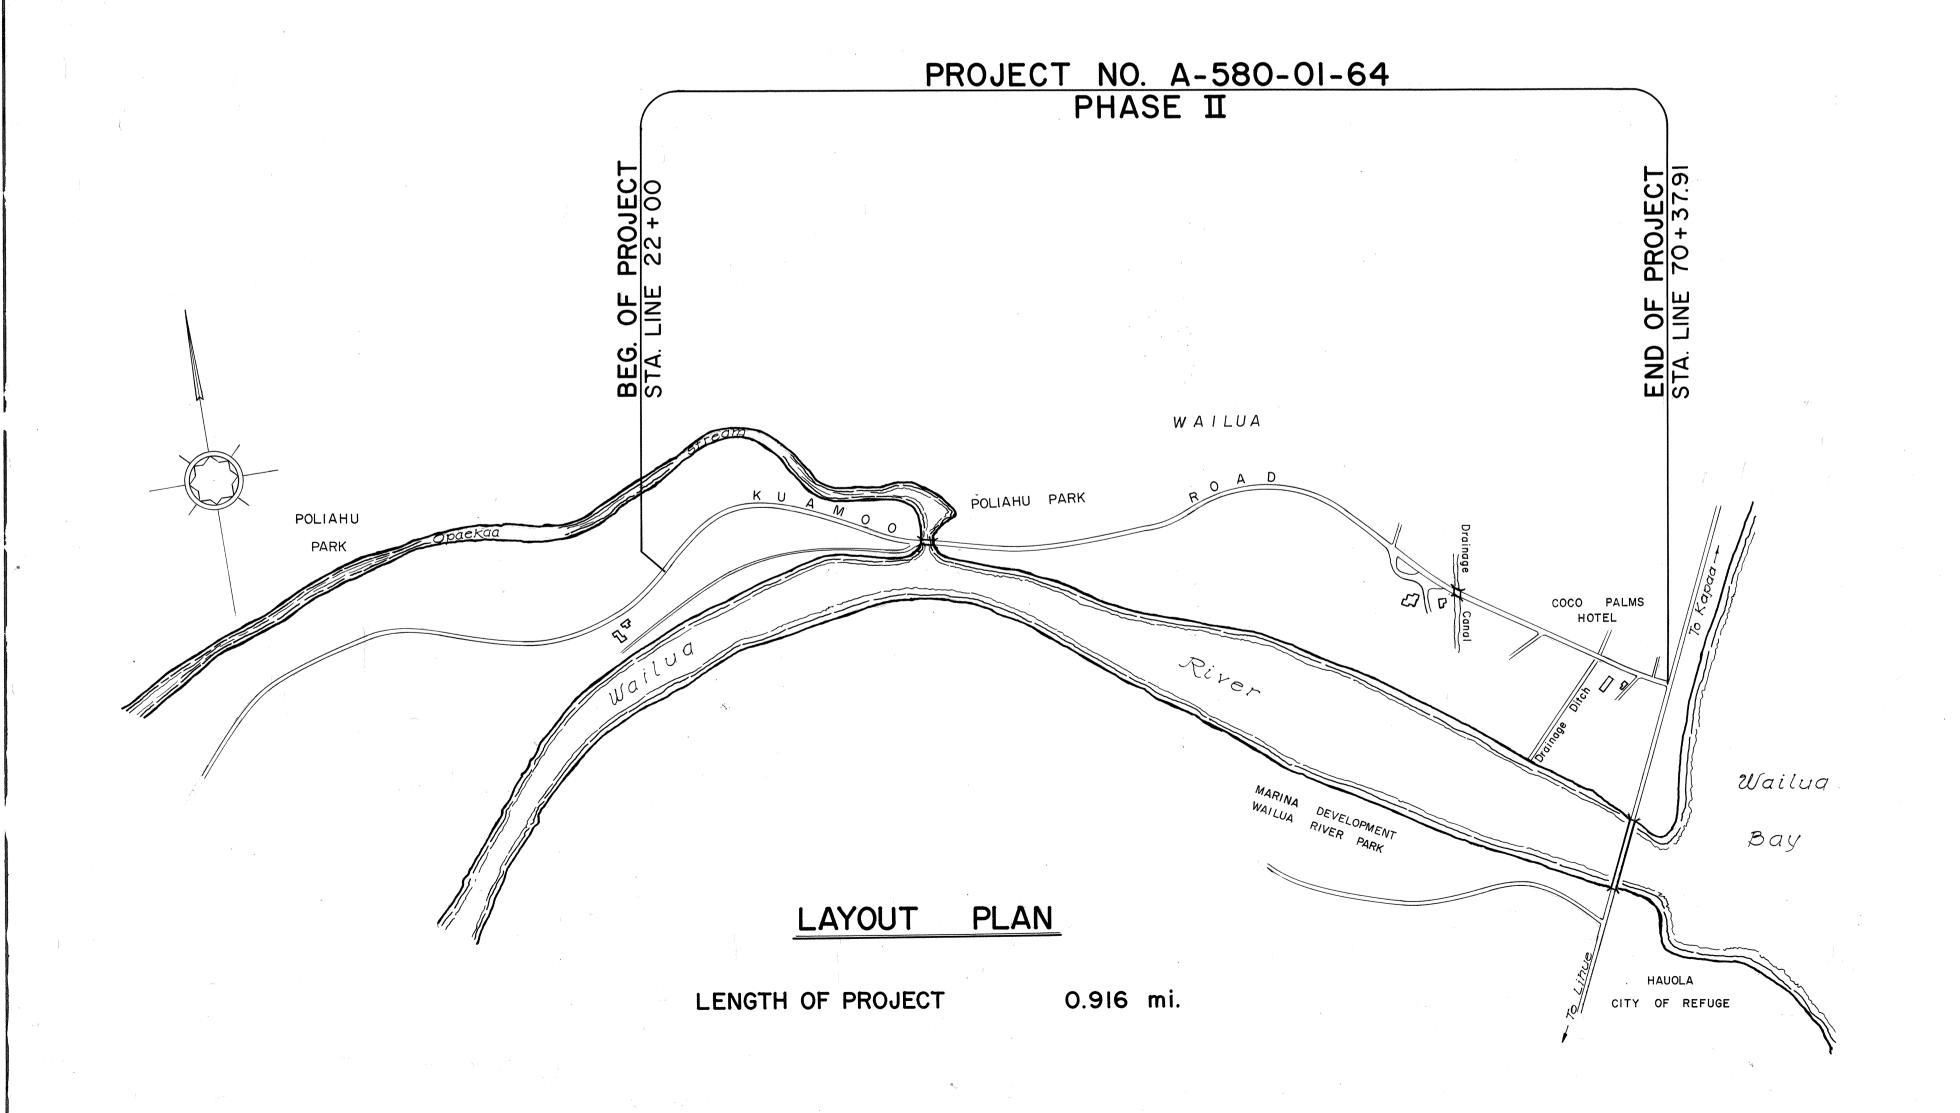

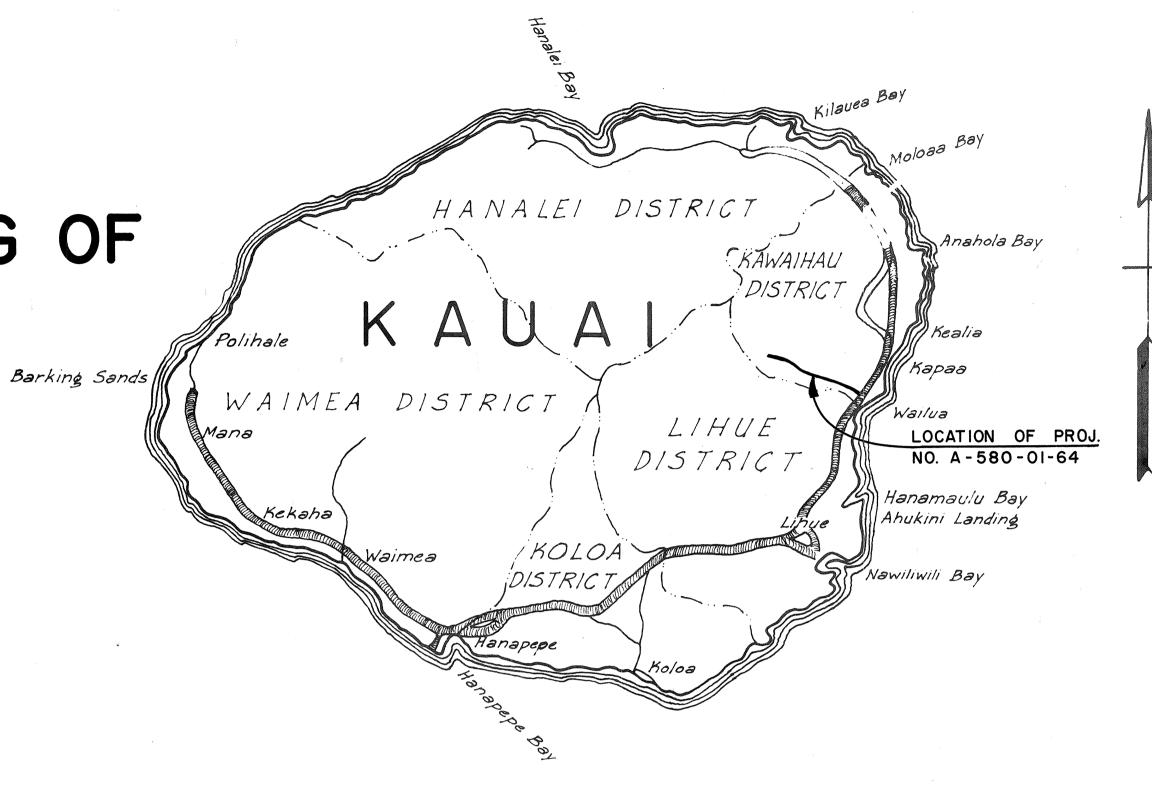

FEDERAL AID PROJECTS PREVIOUSLY CONSTRUCTED OR UNDER CONSTRUCTION

NOTE

ALL CHANGES MADE DURING CONSTRUCTION HAVE BEEN NOTED ON THESE TRACINGS IN RED AND CHECKED BY:

PROJECT ENGINEER

3/14/68 DATE

APPROVED: DATE 3/3/66

Shw MM Sun

FOR DIRECTOR OF TRANSPORTATION

4