



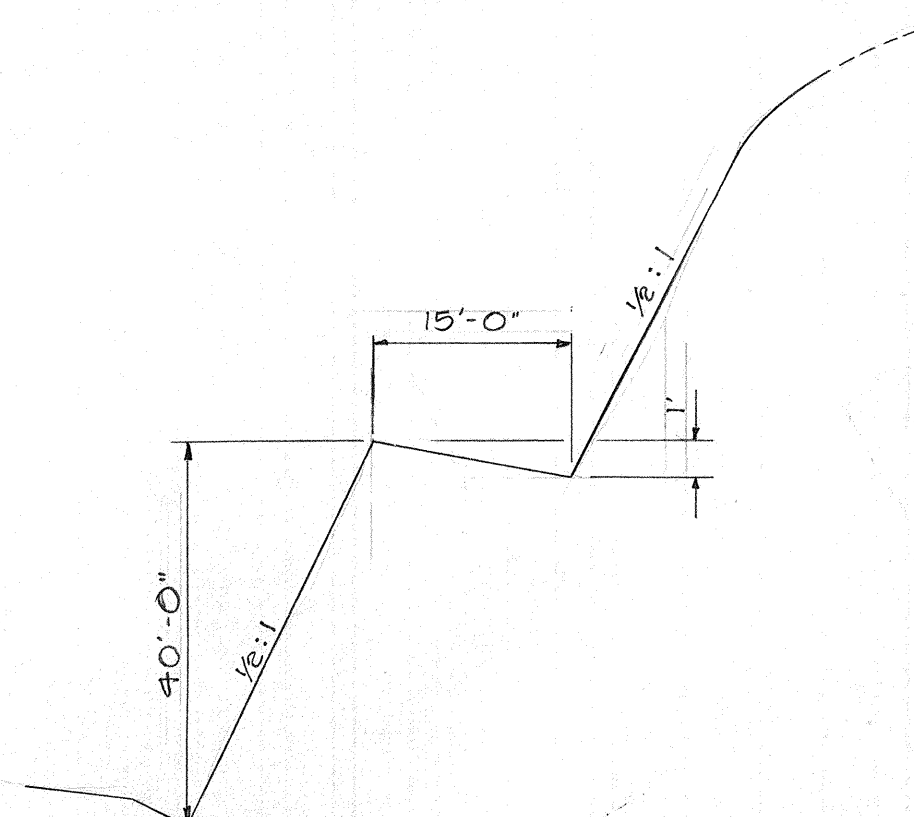


TYPICAL BENCH DETAIL
 Not to Scale

A.C. PAVEMENT THICKNESS SCHEDULE			
STATION		A.C.	A.C.
FROM	TO	MIX NO. III	MIX NO. IV
22+00	24+00		3 1/4"
24+00	27+50	2"	3 1/4"
27+50	28+50	2"	3 1/4"

NOTE:
 Provide smooth transition between varying pavement thicknesses.

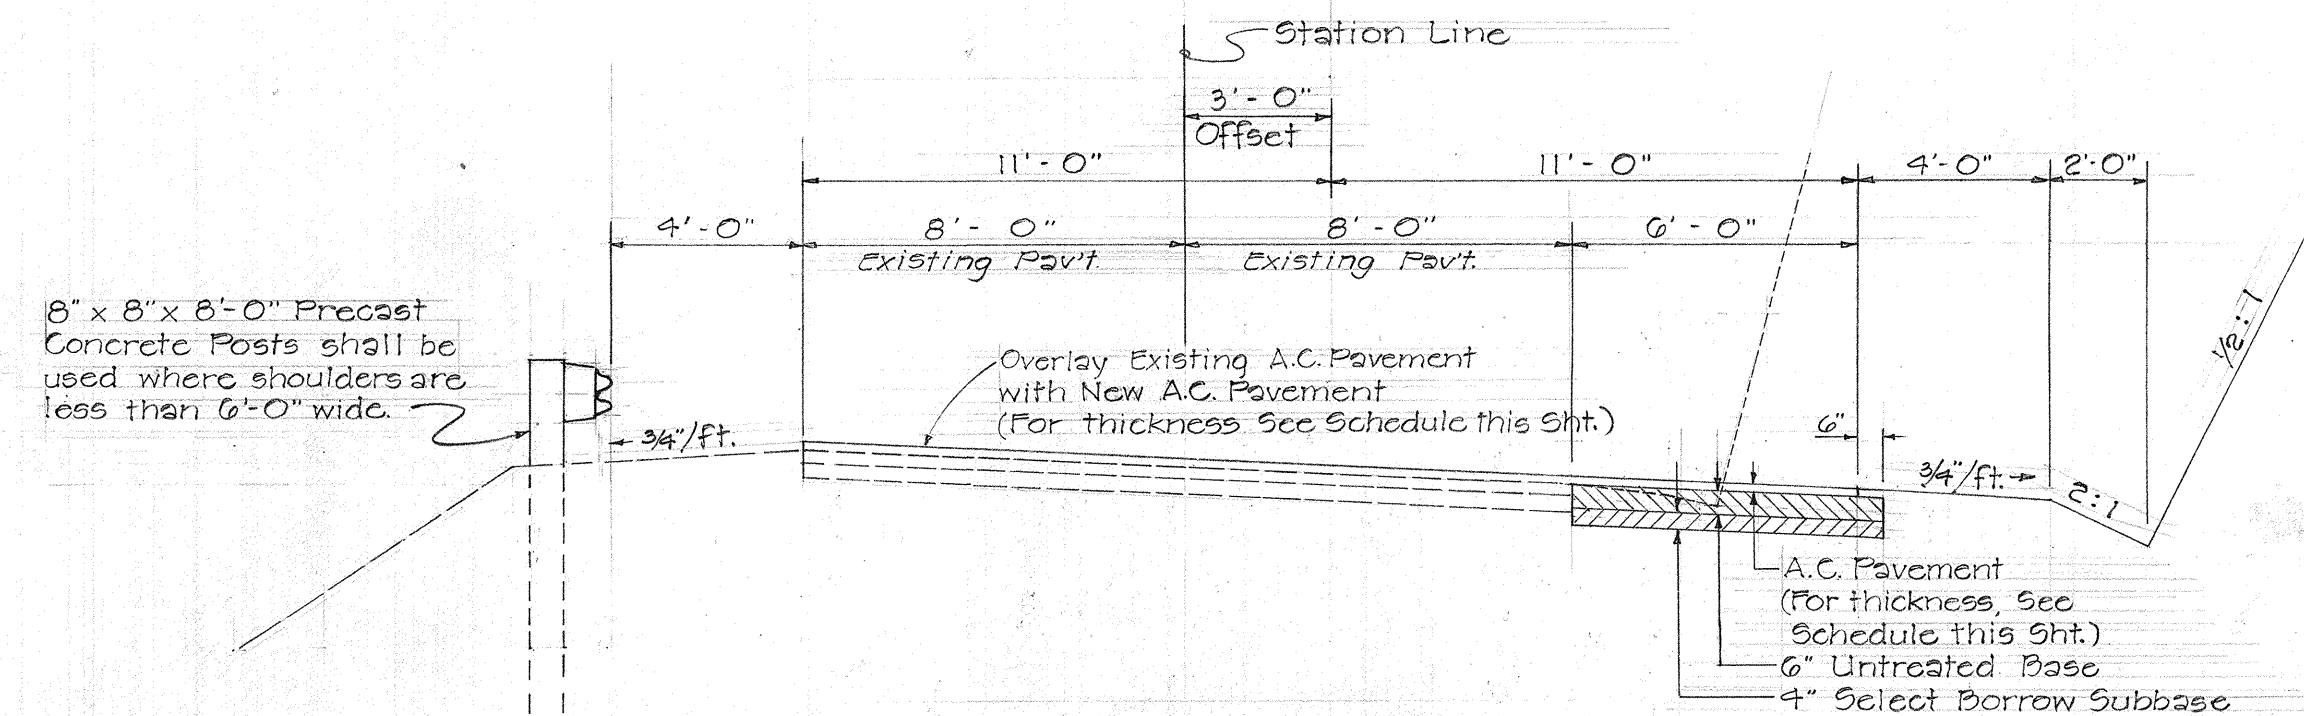

TYPICAL SECTION
 Scale: 1/4"=1'-0"
 BEGINNING TO STA. 26+07.88
 STA. 30+84.37 TO STA. 34+41.42

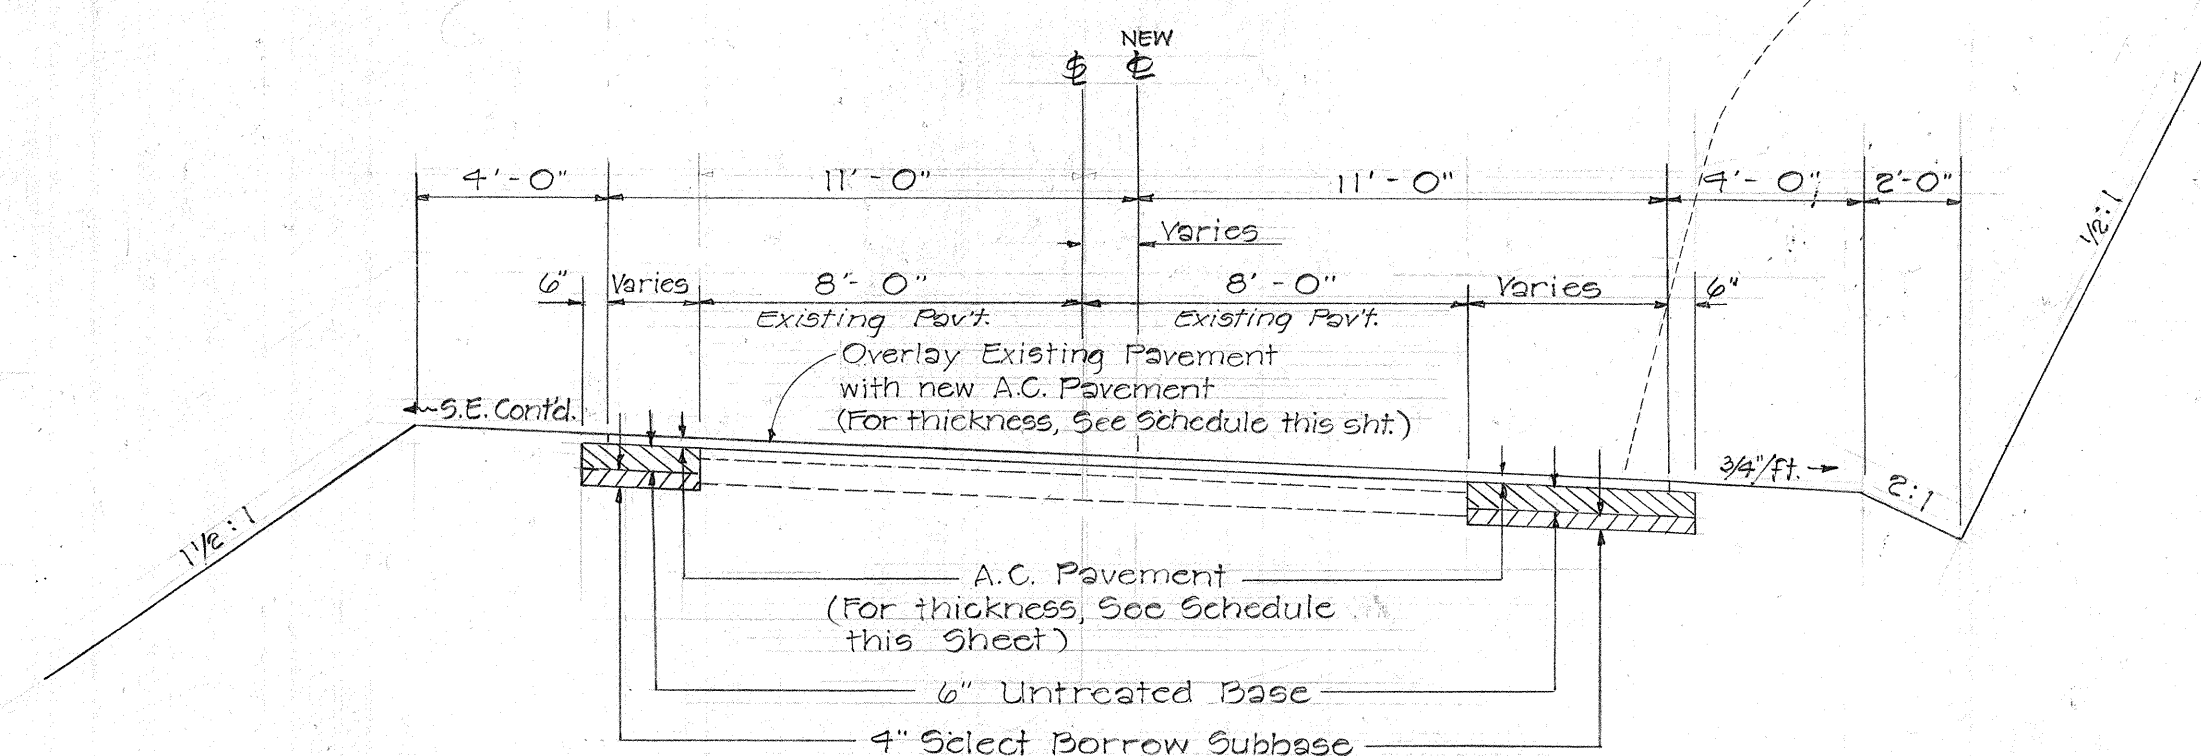

TYPICAL SECTION
 Scale: 1/4"=1'-0"
 STA. 26+07.88 TO STA. 30+84.37
 STA. 34+41.42 TO END OF PROJECT

Alternate Waste Area S

1. Excess material shall be deposited at Alternate Waste Area S.
2. Excess material shall be deposited at Alternate Waste Area only when directed by the Engineer.