

INDEX TO DRAWINGS	
SHEET NO.	DESCRIPTION
1	TITLE SHEET
2 - 3	TYPICAL SECTIONS, GENERAL NOTES AND SUMMARIES
4 - 15	PLAN AND PROFILE
16 - 24	STANDARD DETAILS

DEC. 1970

Date

548-7537

Phone-Loc

D. BEVIER

By

PS8E

Kauai District

Designed By

SURVEY PLOTTED BY	DATE
DRAWN BY	
TRACED BY	
CHECKED BY	
QUANTITIES CHECKED BY	
CHECKED BY	
ORIGINAL PLAN	
NOTE BOOK	
No.	

STATE OF HAWAII

DEPARTMENT OF TRANSPORTATION

HIGHWAYS DIVISION

"AS BUILT"

PLANS FOR

KUAMOO ROAD



RESURFACING FROM POLIAHU PARK

TOWARD UNIVERSITY OF HAWAII STATION

PROJECT NO. 580A-01-70

DISTRICT OF KAWAIHAU

ISLAND OF KAUAI

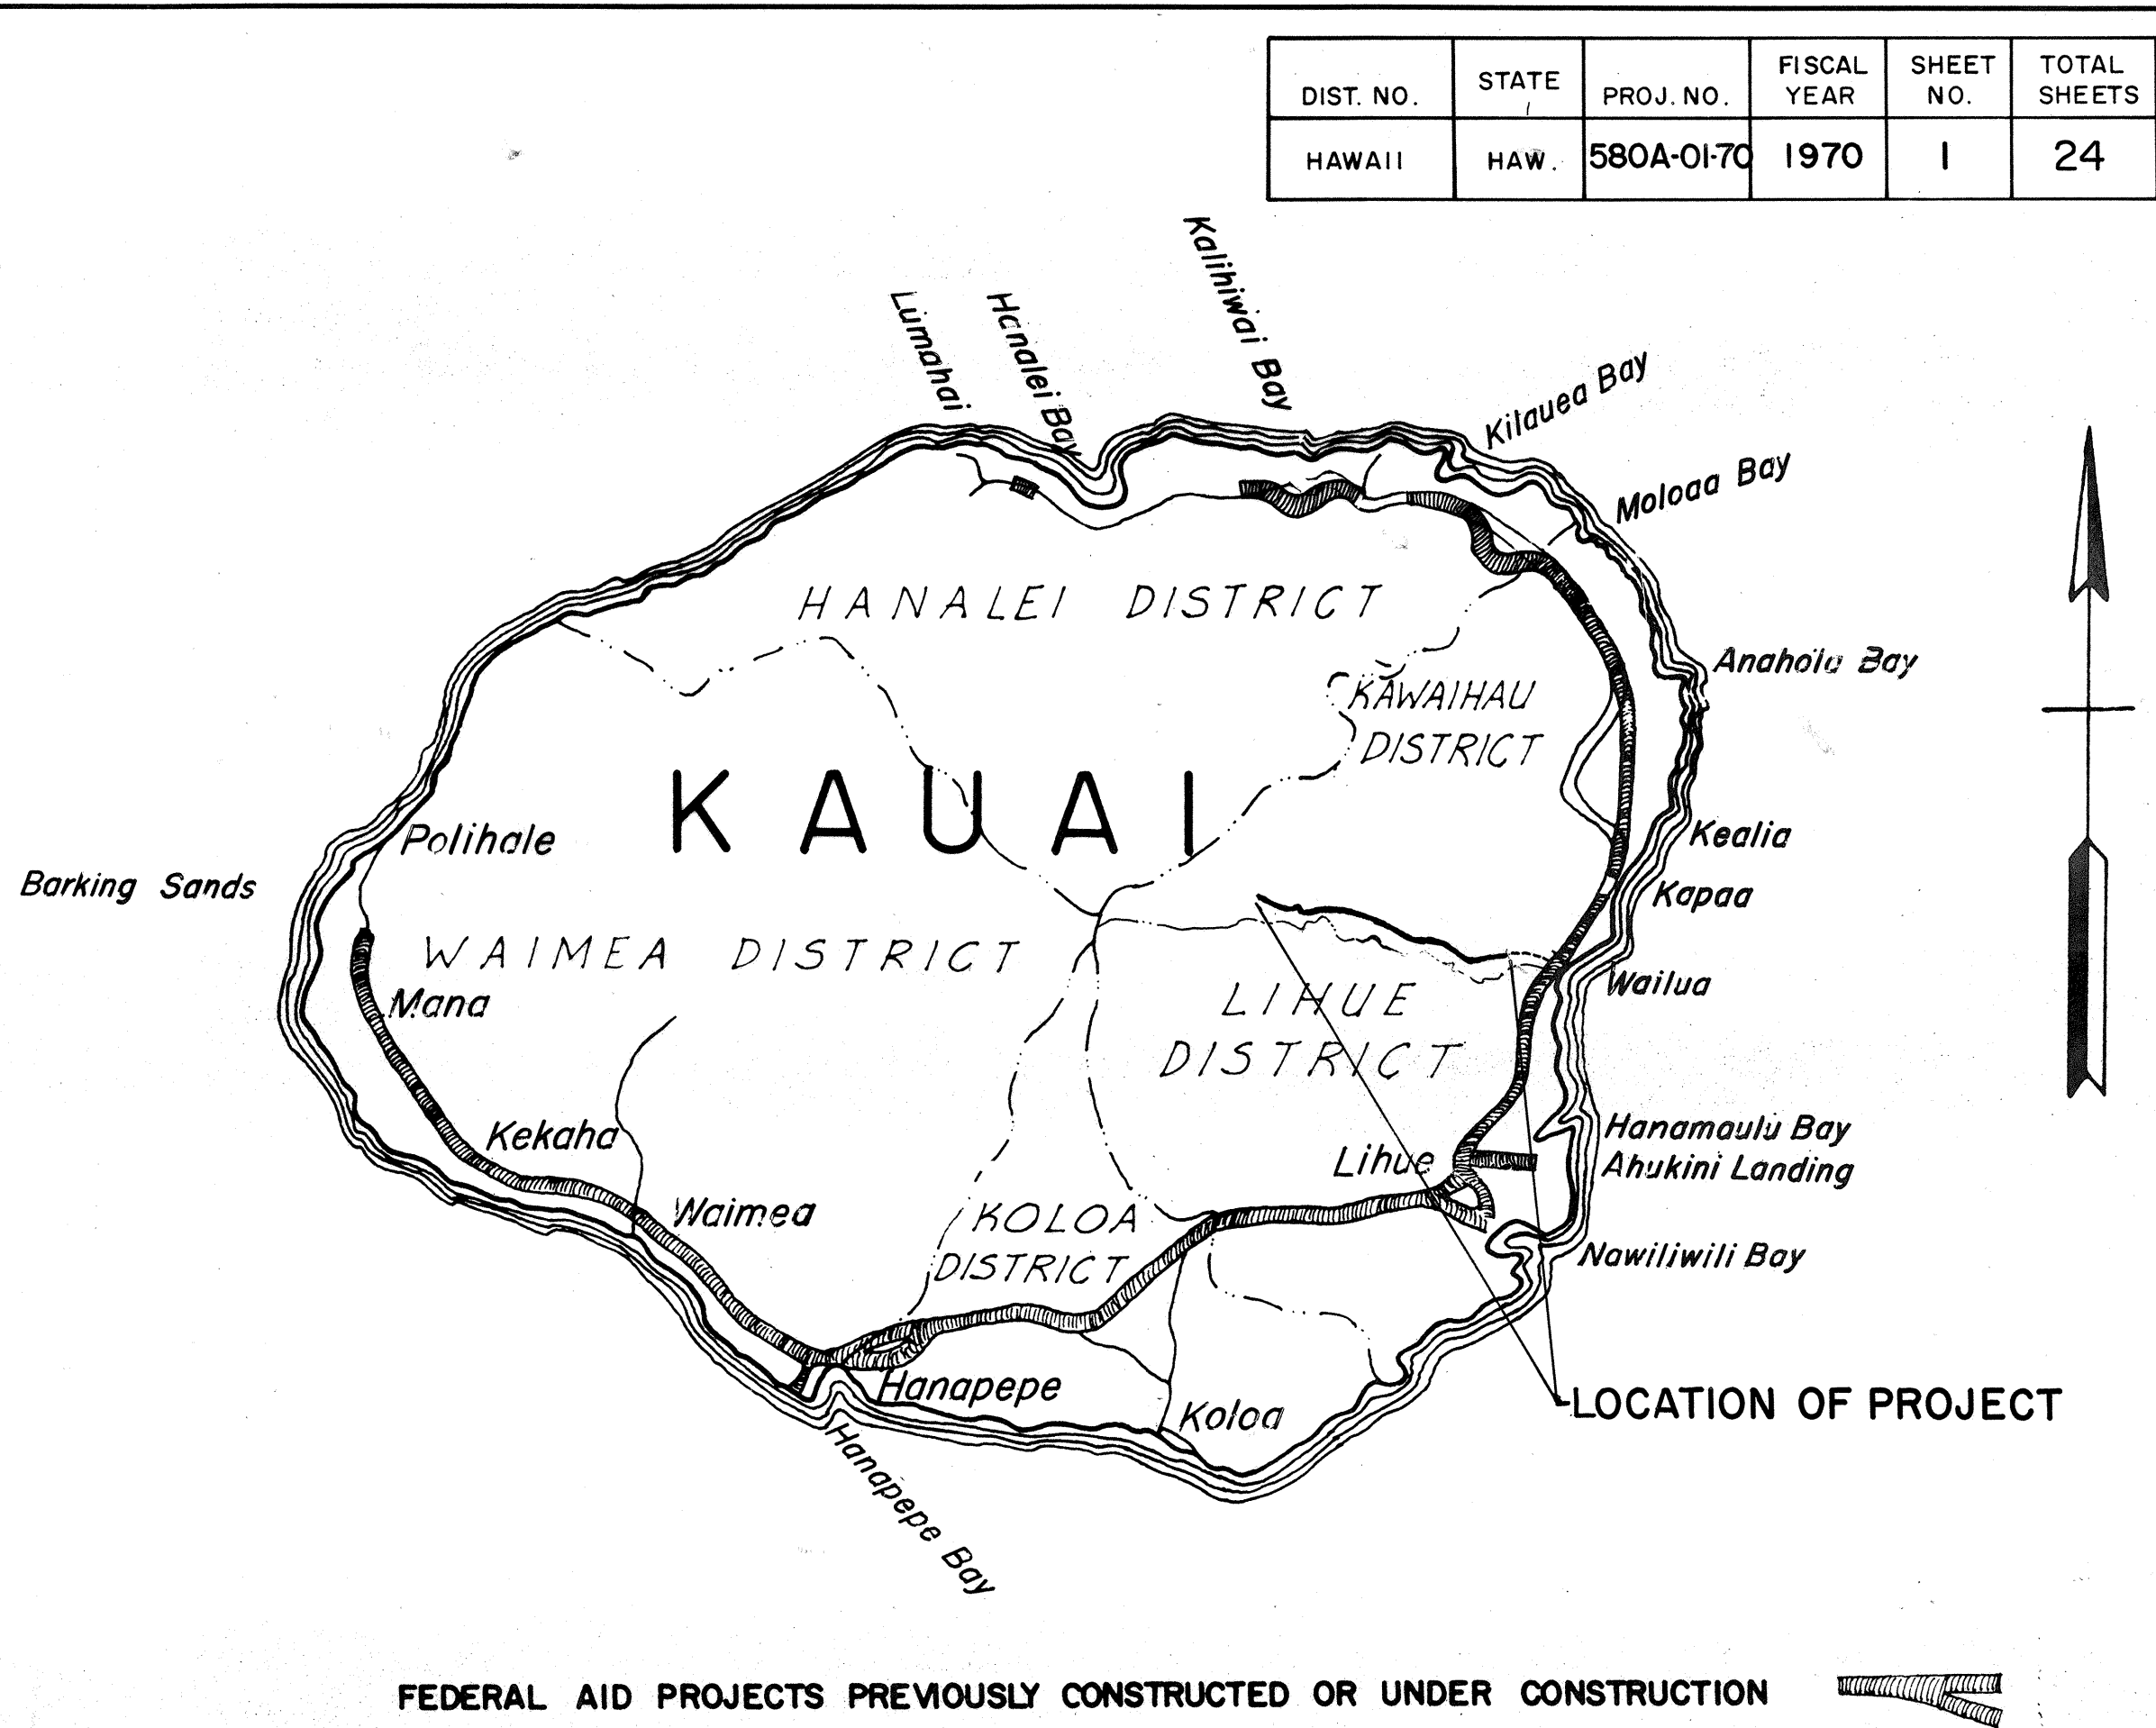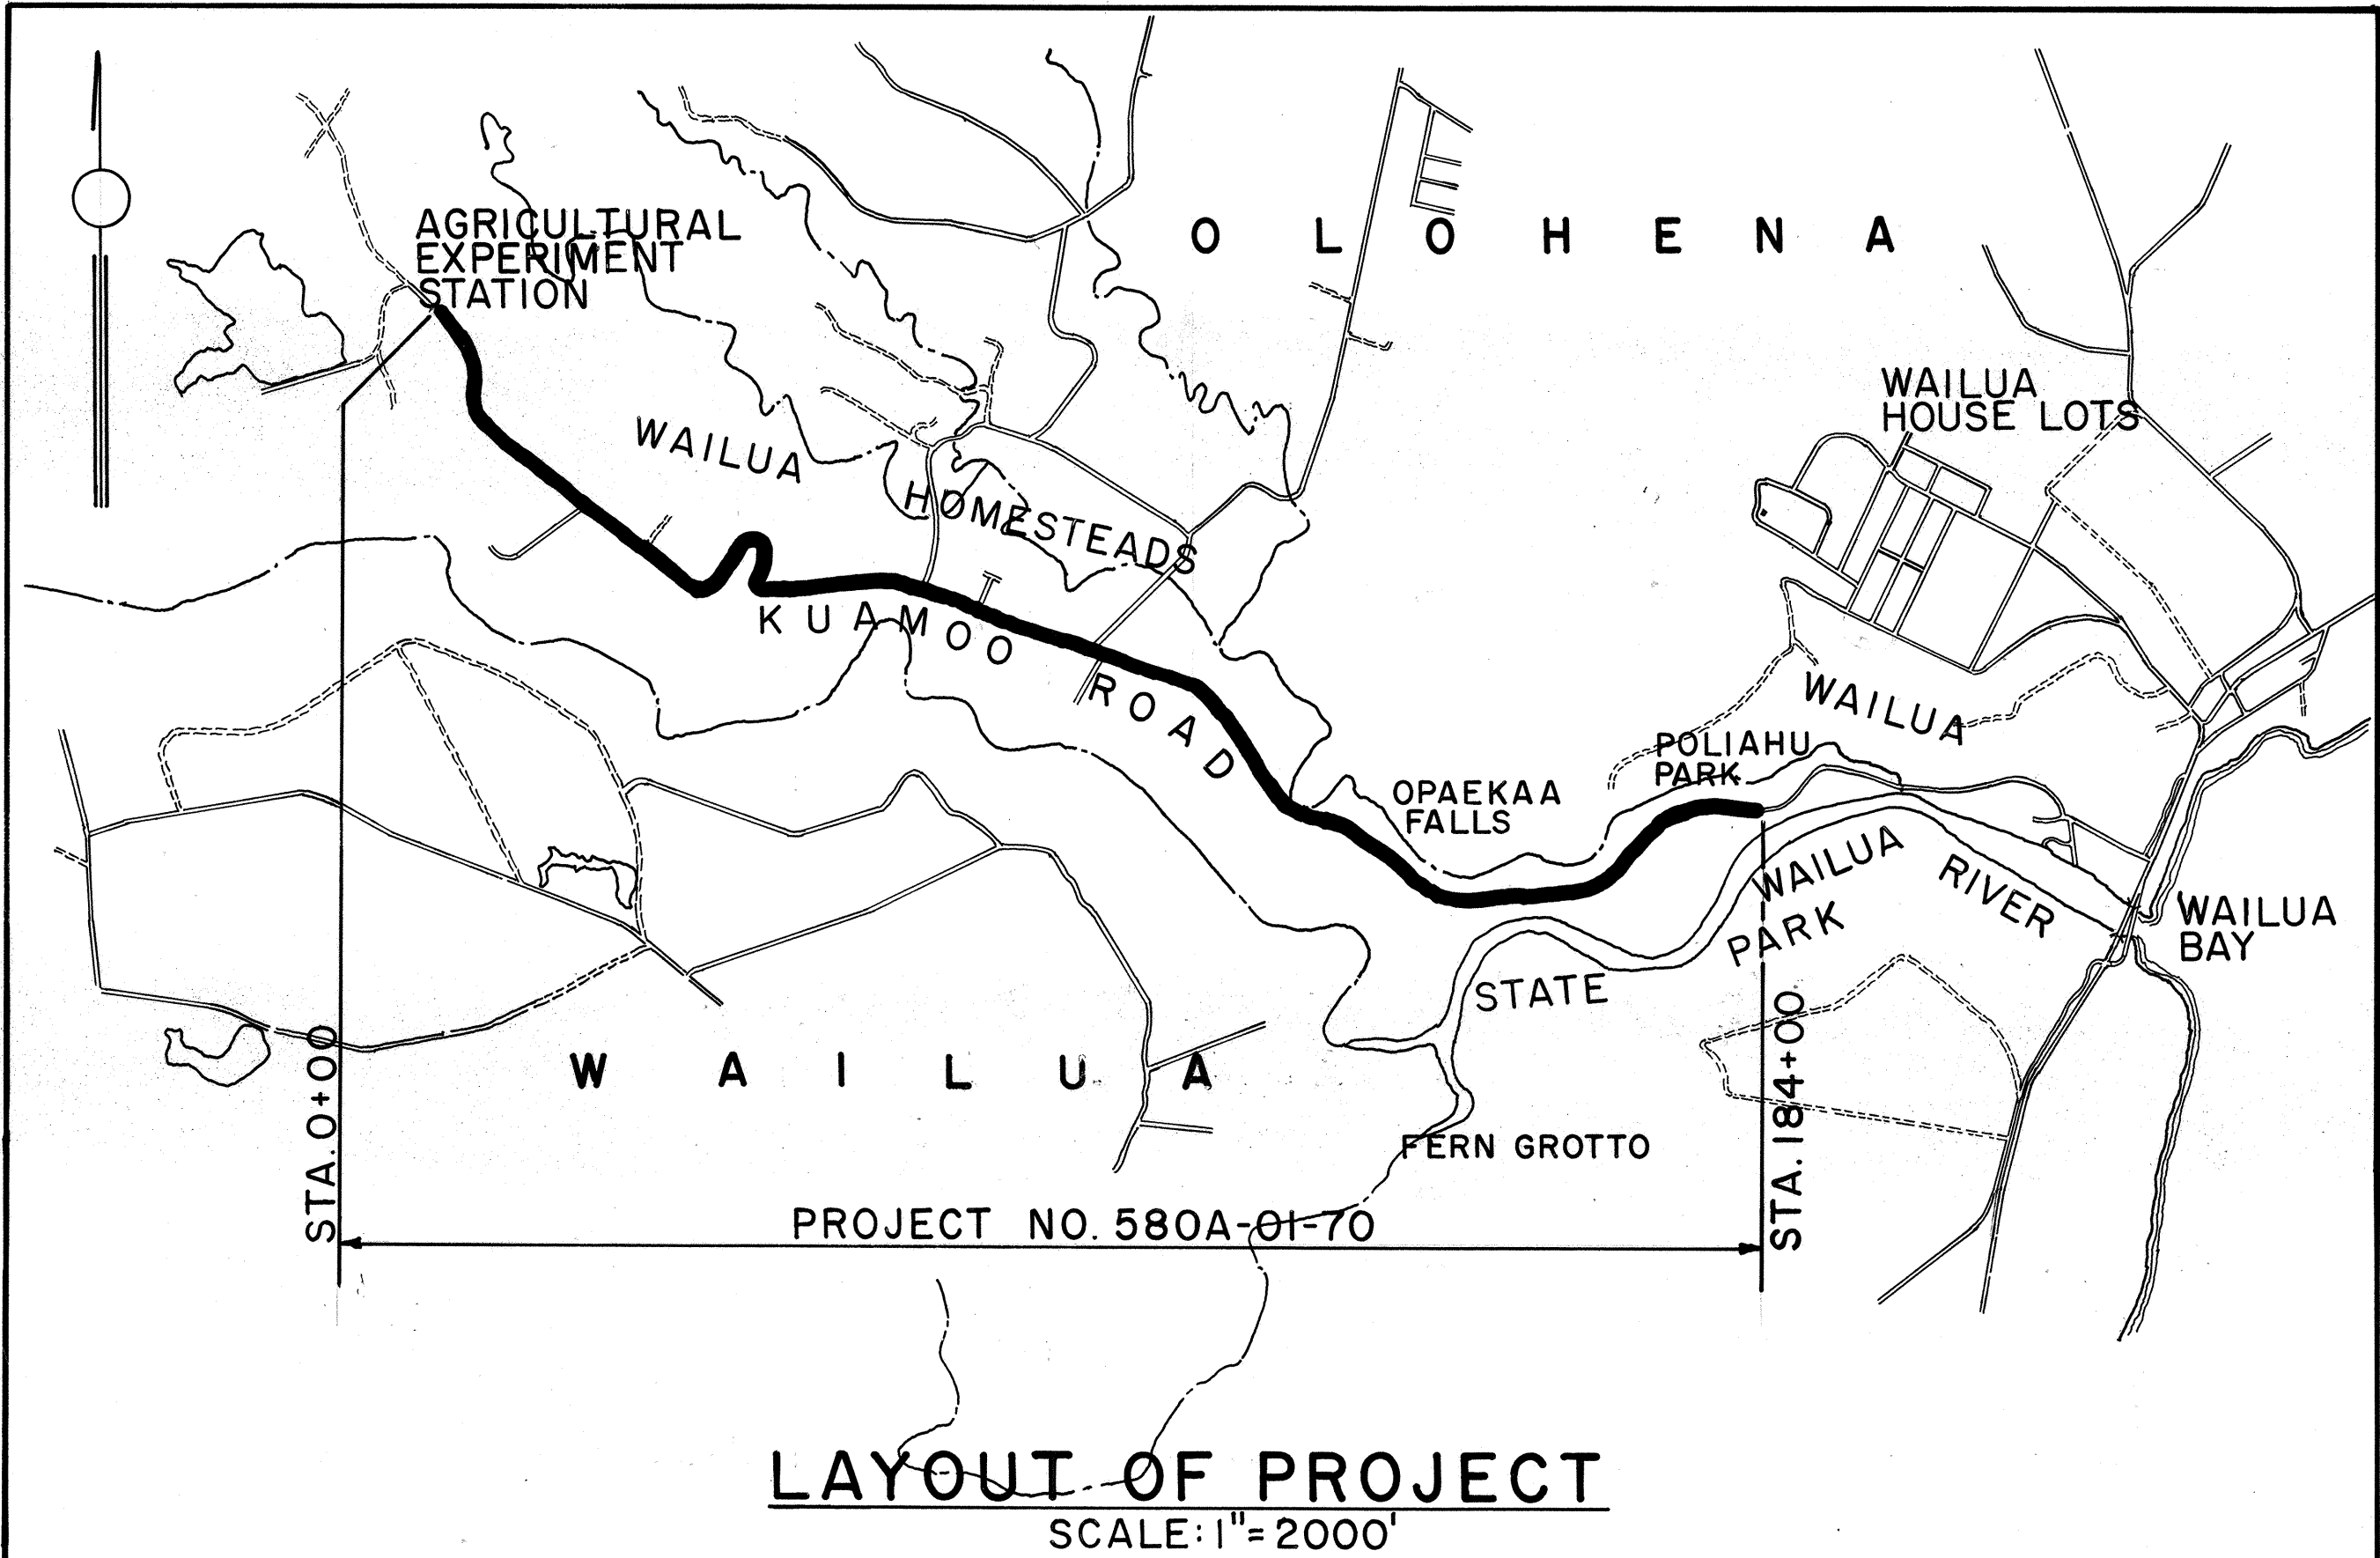

NOTE:

ALL CHANGES MADE DURING CONSTRUCTION

HAVE BEEN INCORPORATED ON THESE

PLANS IN RED EXCEPT CHANGES IN THE

ORIGINAL THEORETICAL QUANTITIES.

Donald Nagamine

PROJECT ENGINEER

8-11-81

DATE

DEPARTMENT OF TRANSPORTATION STATE OF HAWAII	
APPROVED:	
<i>Alvey Wright</i>	12/8/70
for DIR. OF TRANSPORTATION	DATE