

INDEX TO DRAWINGS	
SHEET NO.	DESCRIPTION
1	TITLE SHEET
2-4	PLANS
5	SPECIAL END SHOE CONNECTION TO CRM WALL
6-11	STANDARD DETAILS

STATE OF HAWAII

DEPARTMENT OF TRANSPORTATION

LAND TRANSPORTATION FACILITIES DIVISION

"AS BUILT"

PLANS FOR

KUAMOO ROAD,



SAFETY IMPROVEMENTS

PROJECT NO. 580A-01-76

PHASE I

DISTRICT OF KAWAIHAU

ISLAND OF KAUAI

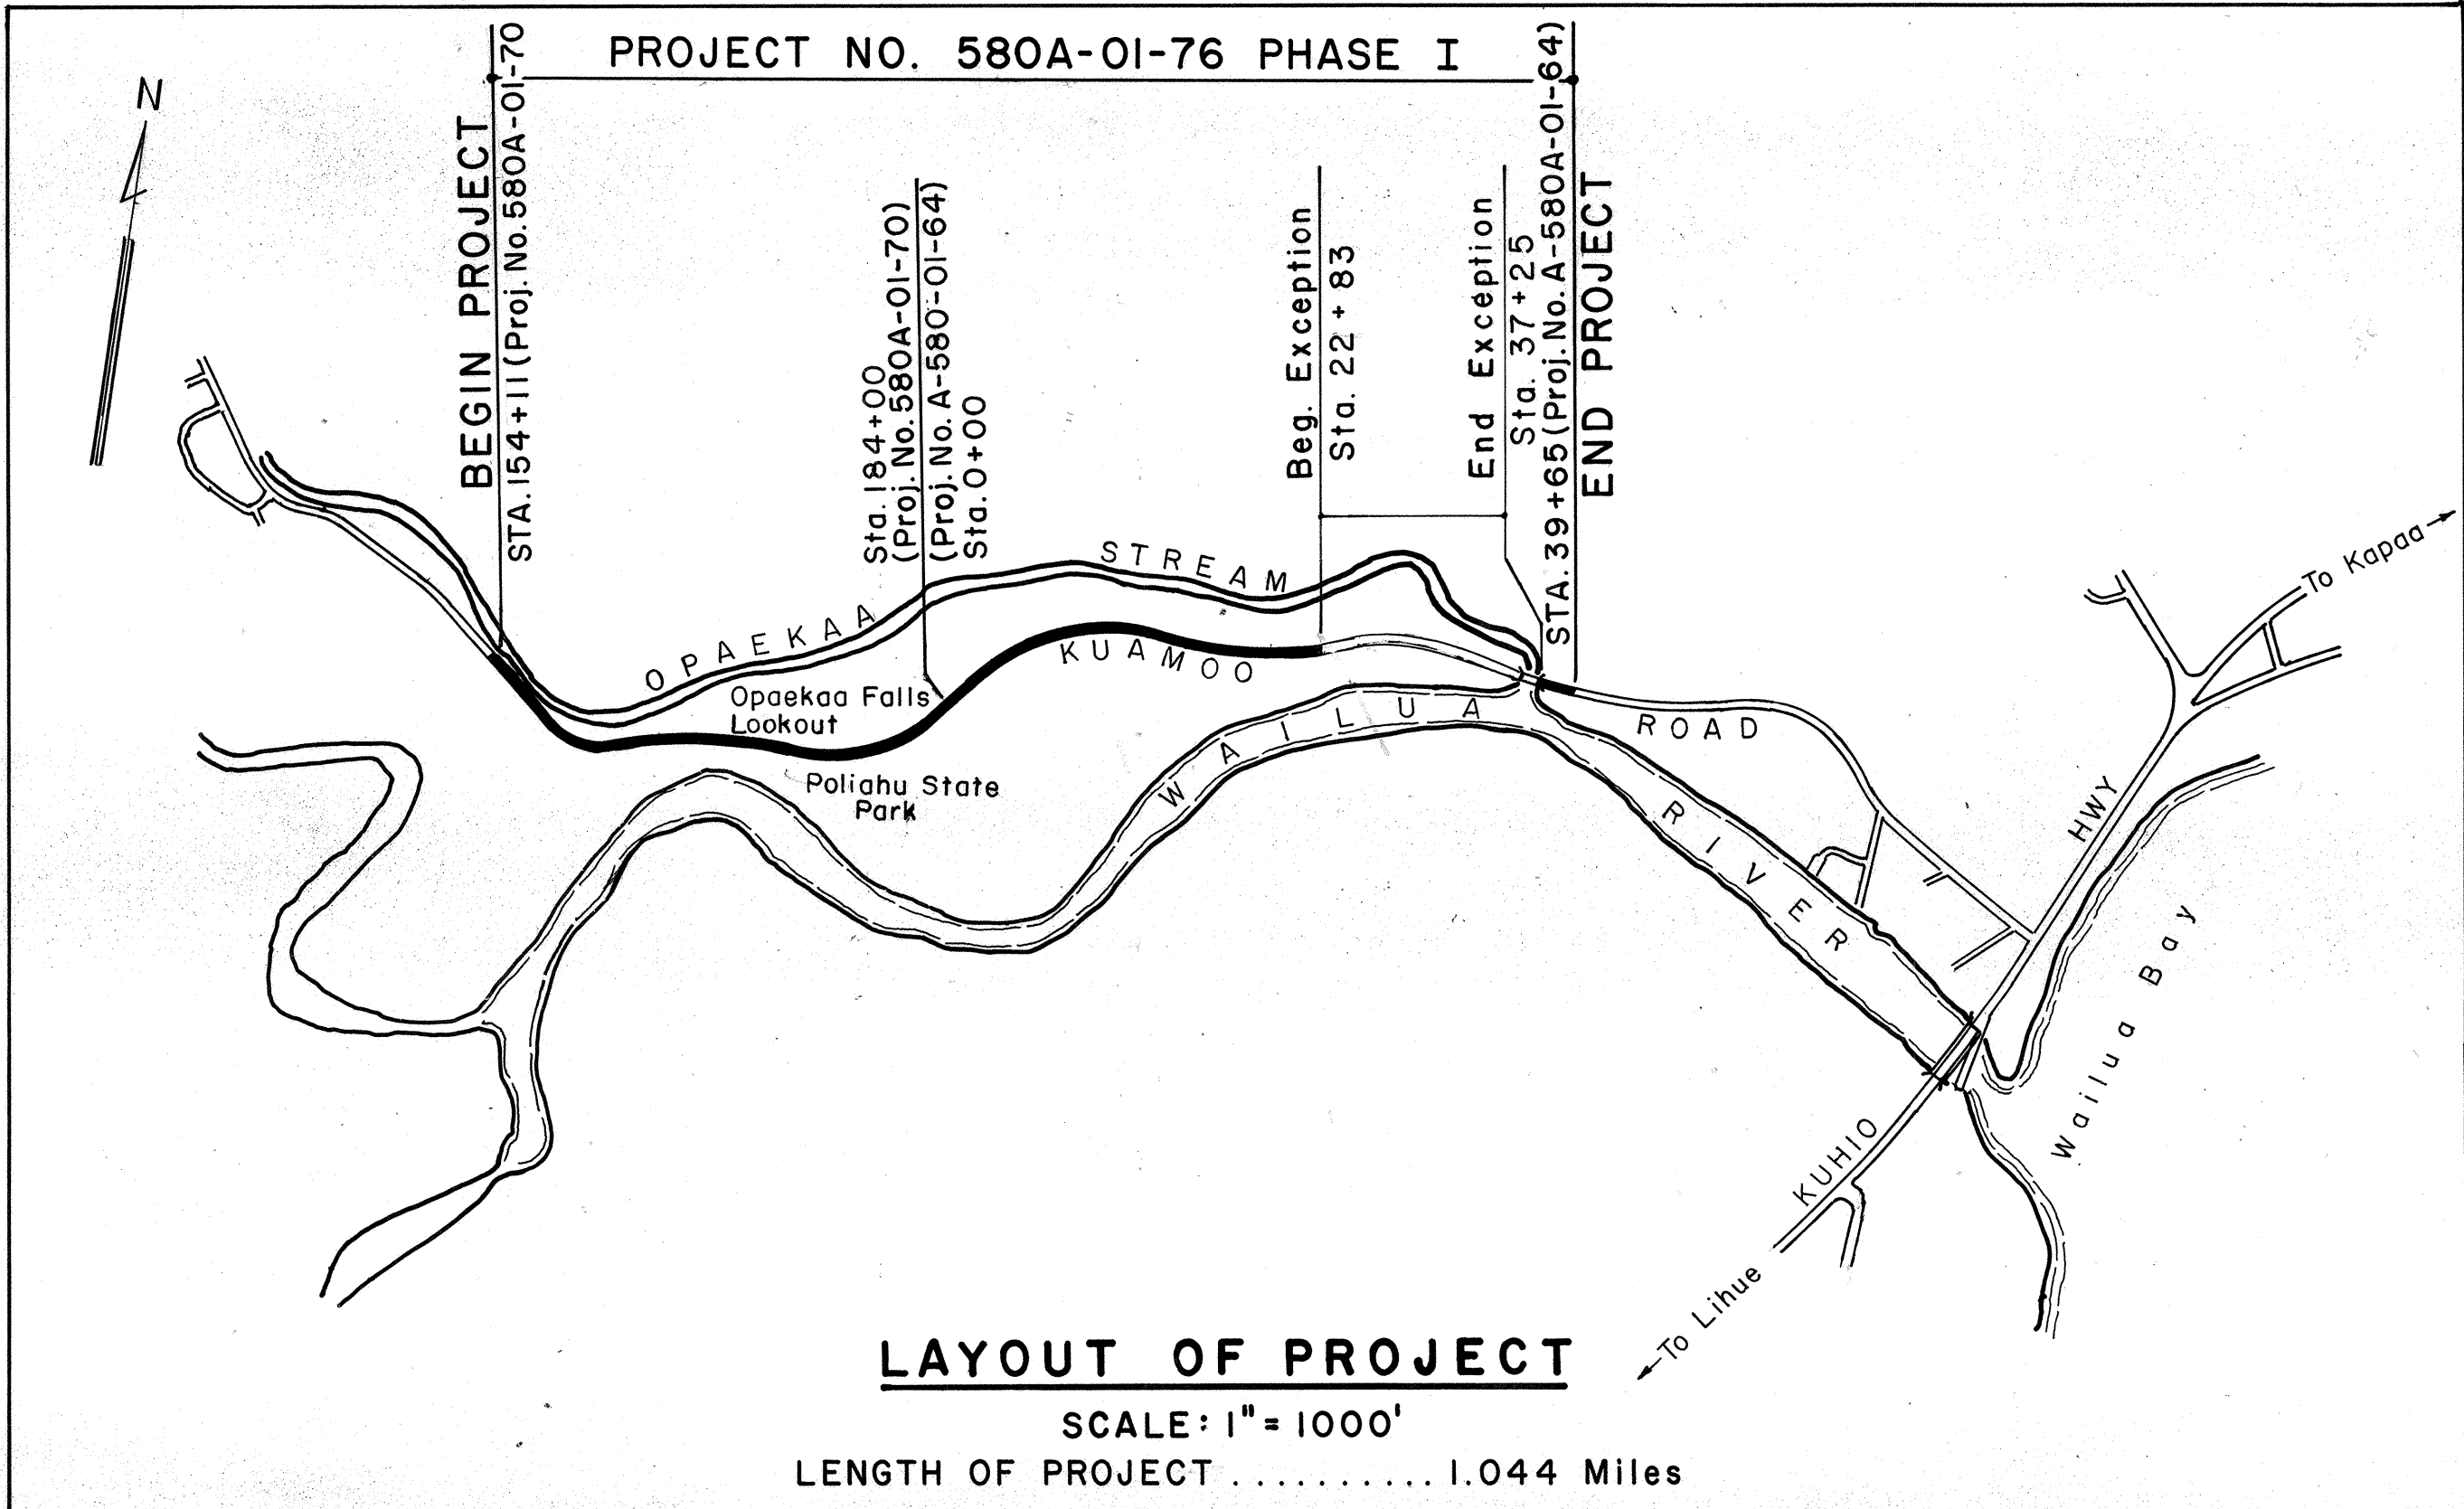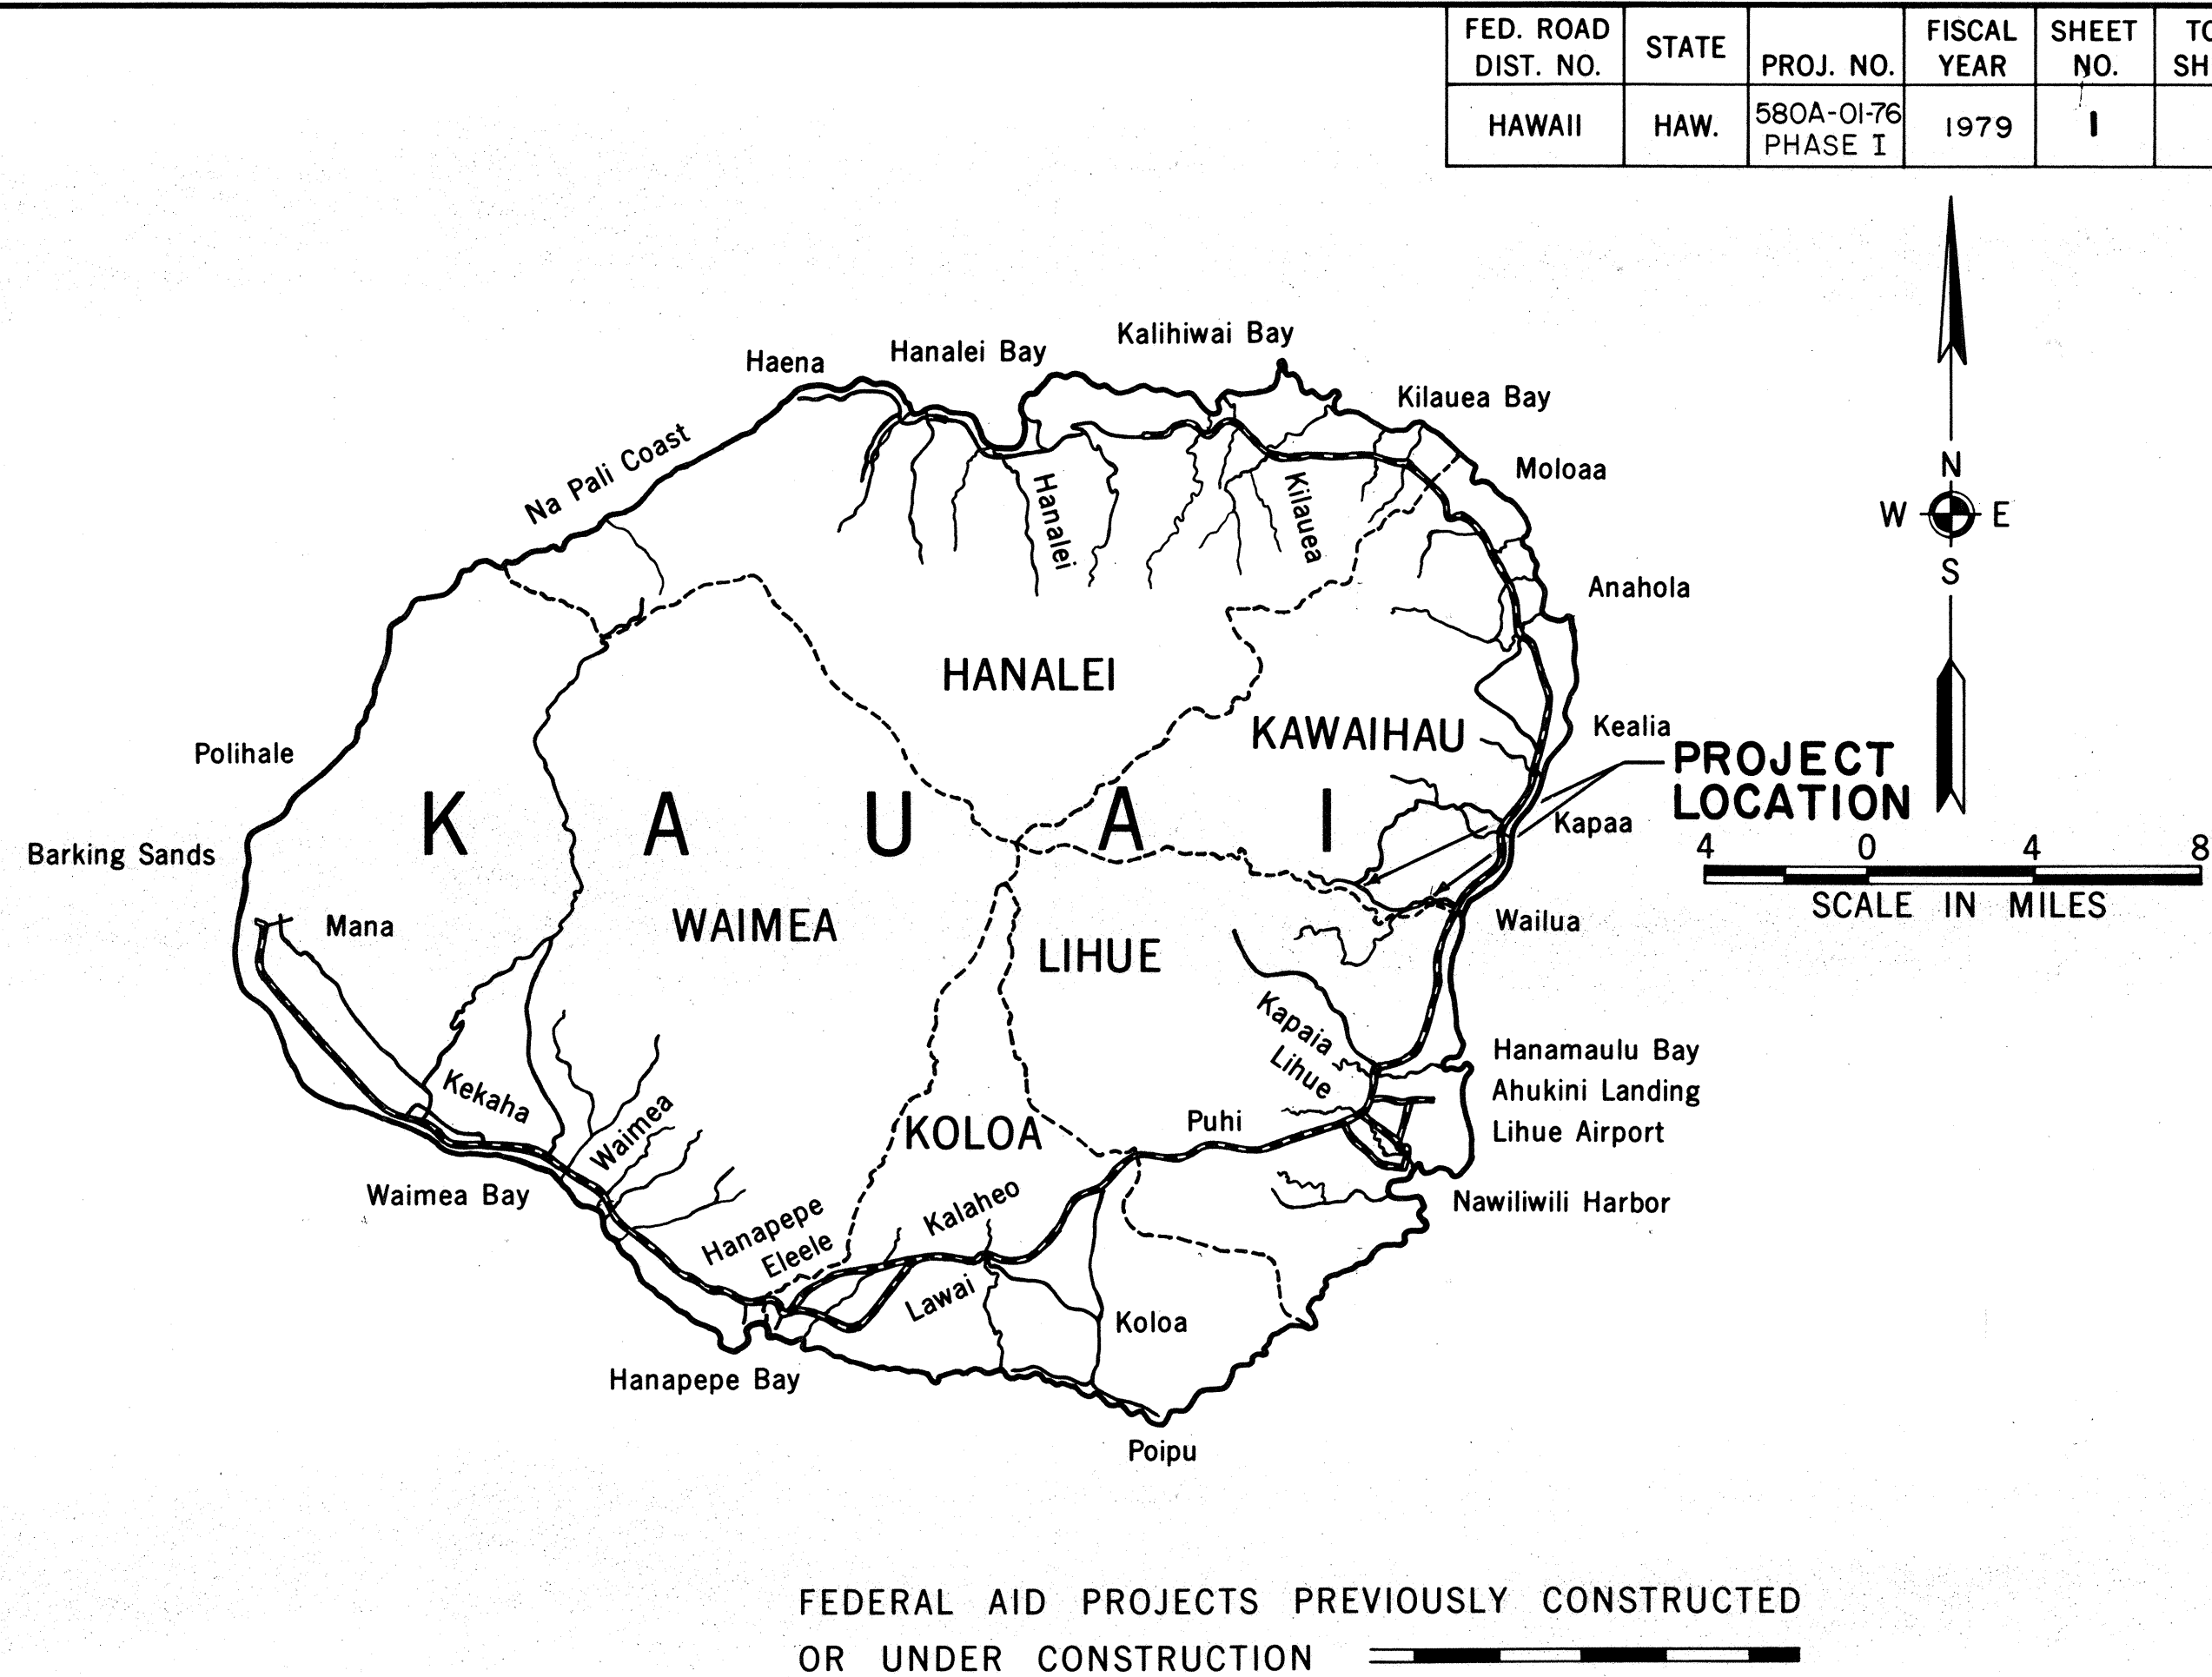

ALL CHANGES MADE DURING CONSTRUCTION HAVE BEEN INCORPORATED ON THESE PLANS EXCEPT CHANGES IN THE ORIGINAL THEORETICAL QUANTITIES.



PROJECT ENGINEER


10-10-79

DATE

DEPARTMENT OF TRANSPORTATION

STATE OF HAWAII

APPROVED:

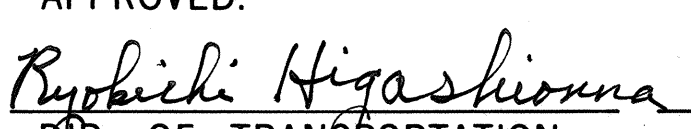

9/14/78

DATE

KAUAI DIVISION

DESIGNED BY

D. BEVIER

548-7537

9/13/78

PHONE

DATE