
	INDEX TO DRAWINGS
SHEET NO.	DESCRIPTION
1	TITLE SHEET
2	TYPICAL SECTIONS, GENERAL
	NOTES & MISC. DETAILS
3-4	PLANS
5 - 14	STANDARD DETAILS
1	

KAUAI DISTRICT DESIGNED BY



STATE OF HAWAII

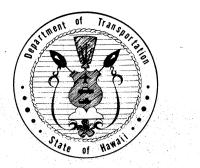

DEPARTMENT OF TRANSPORTATION

HIGHWAYS DIVISION

"AS BUILT"


PLANS FOR

KUAMOO ROAD, SAFETY IMPROVEMENTS AND RESURFACING

FEDERAL ADDEPROJECT NO. RS-0580(2)

DISTRICT OF KAWAIHAU

ISLAND OF KAUAI

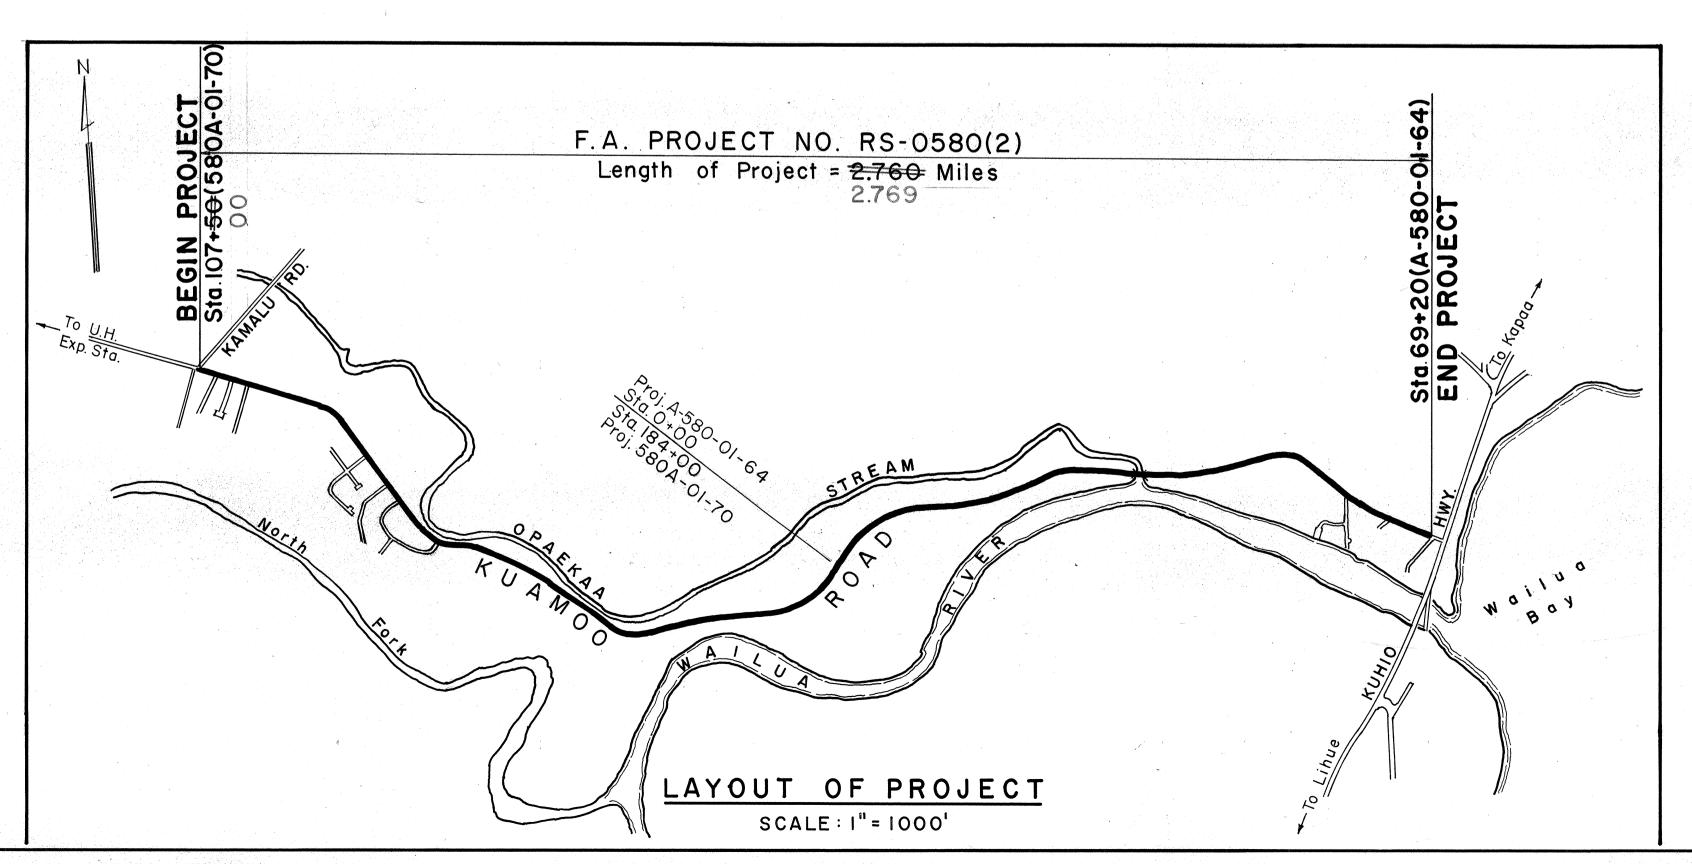


FED. ROAD DIST. NO.


STATE FED. AID PROJ. NO.


FISCAL SHEET TOTAL YEAR NO.

SHEETS

HAWAII HAW. RS-0580(2) 1980 1 14

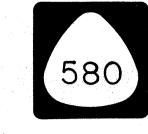

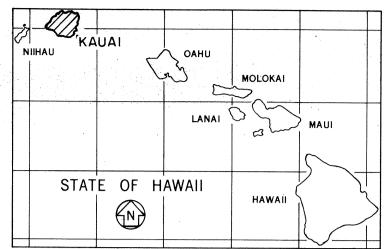

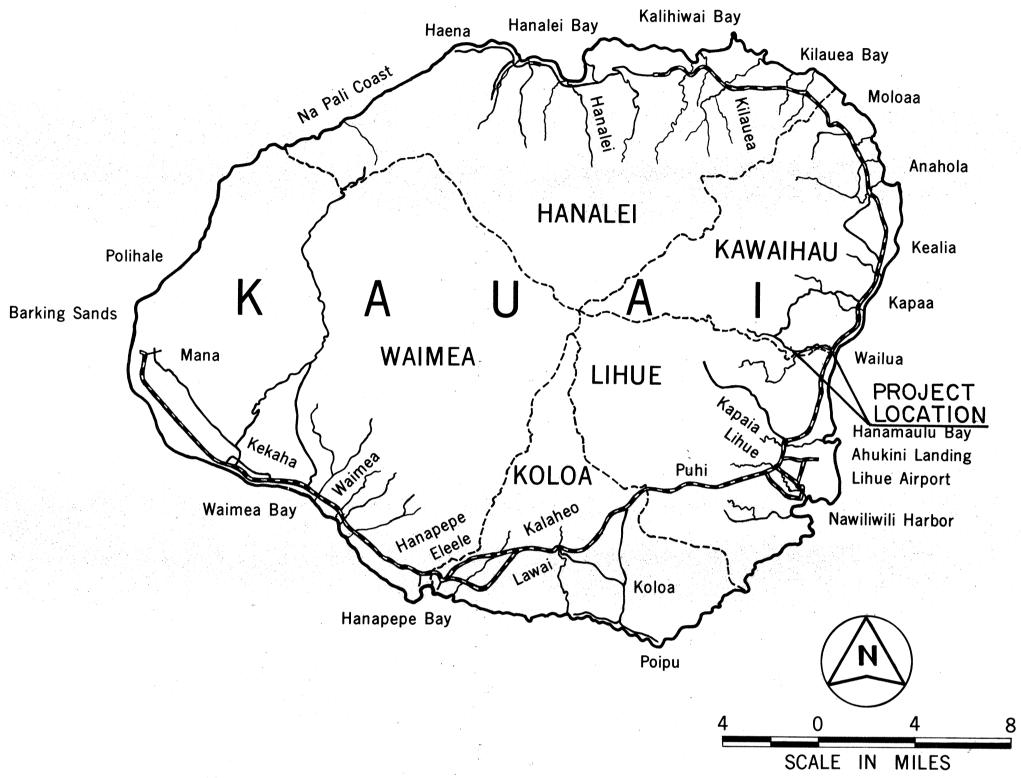

FEDERAL AID PROJECTS PREVIOUSLY CONSTRUCTED OR UNDER CONSTRUCTION

DESIGN CLASSIFICATION

ALL CHANGES MADE DURING CONSTRUCTION

HAVE BEEN INCORPORATED ON THESE PLANS

EXCEPT CHANGES IN THE ORIGINAL THEORETICAL

QUANTITIES.

PROJECT ENGINEER

1-22-8/ DATE

DEPARTMENT OF TRANSPORTATION
STATE OF HAWAII
APPROVED:

TRANSPORTATION DATE