
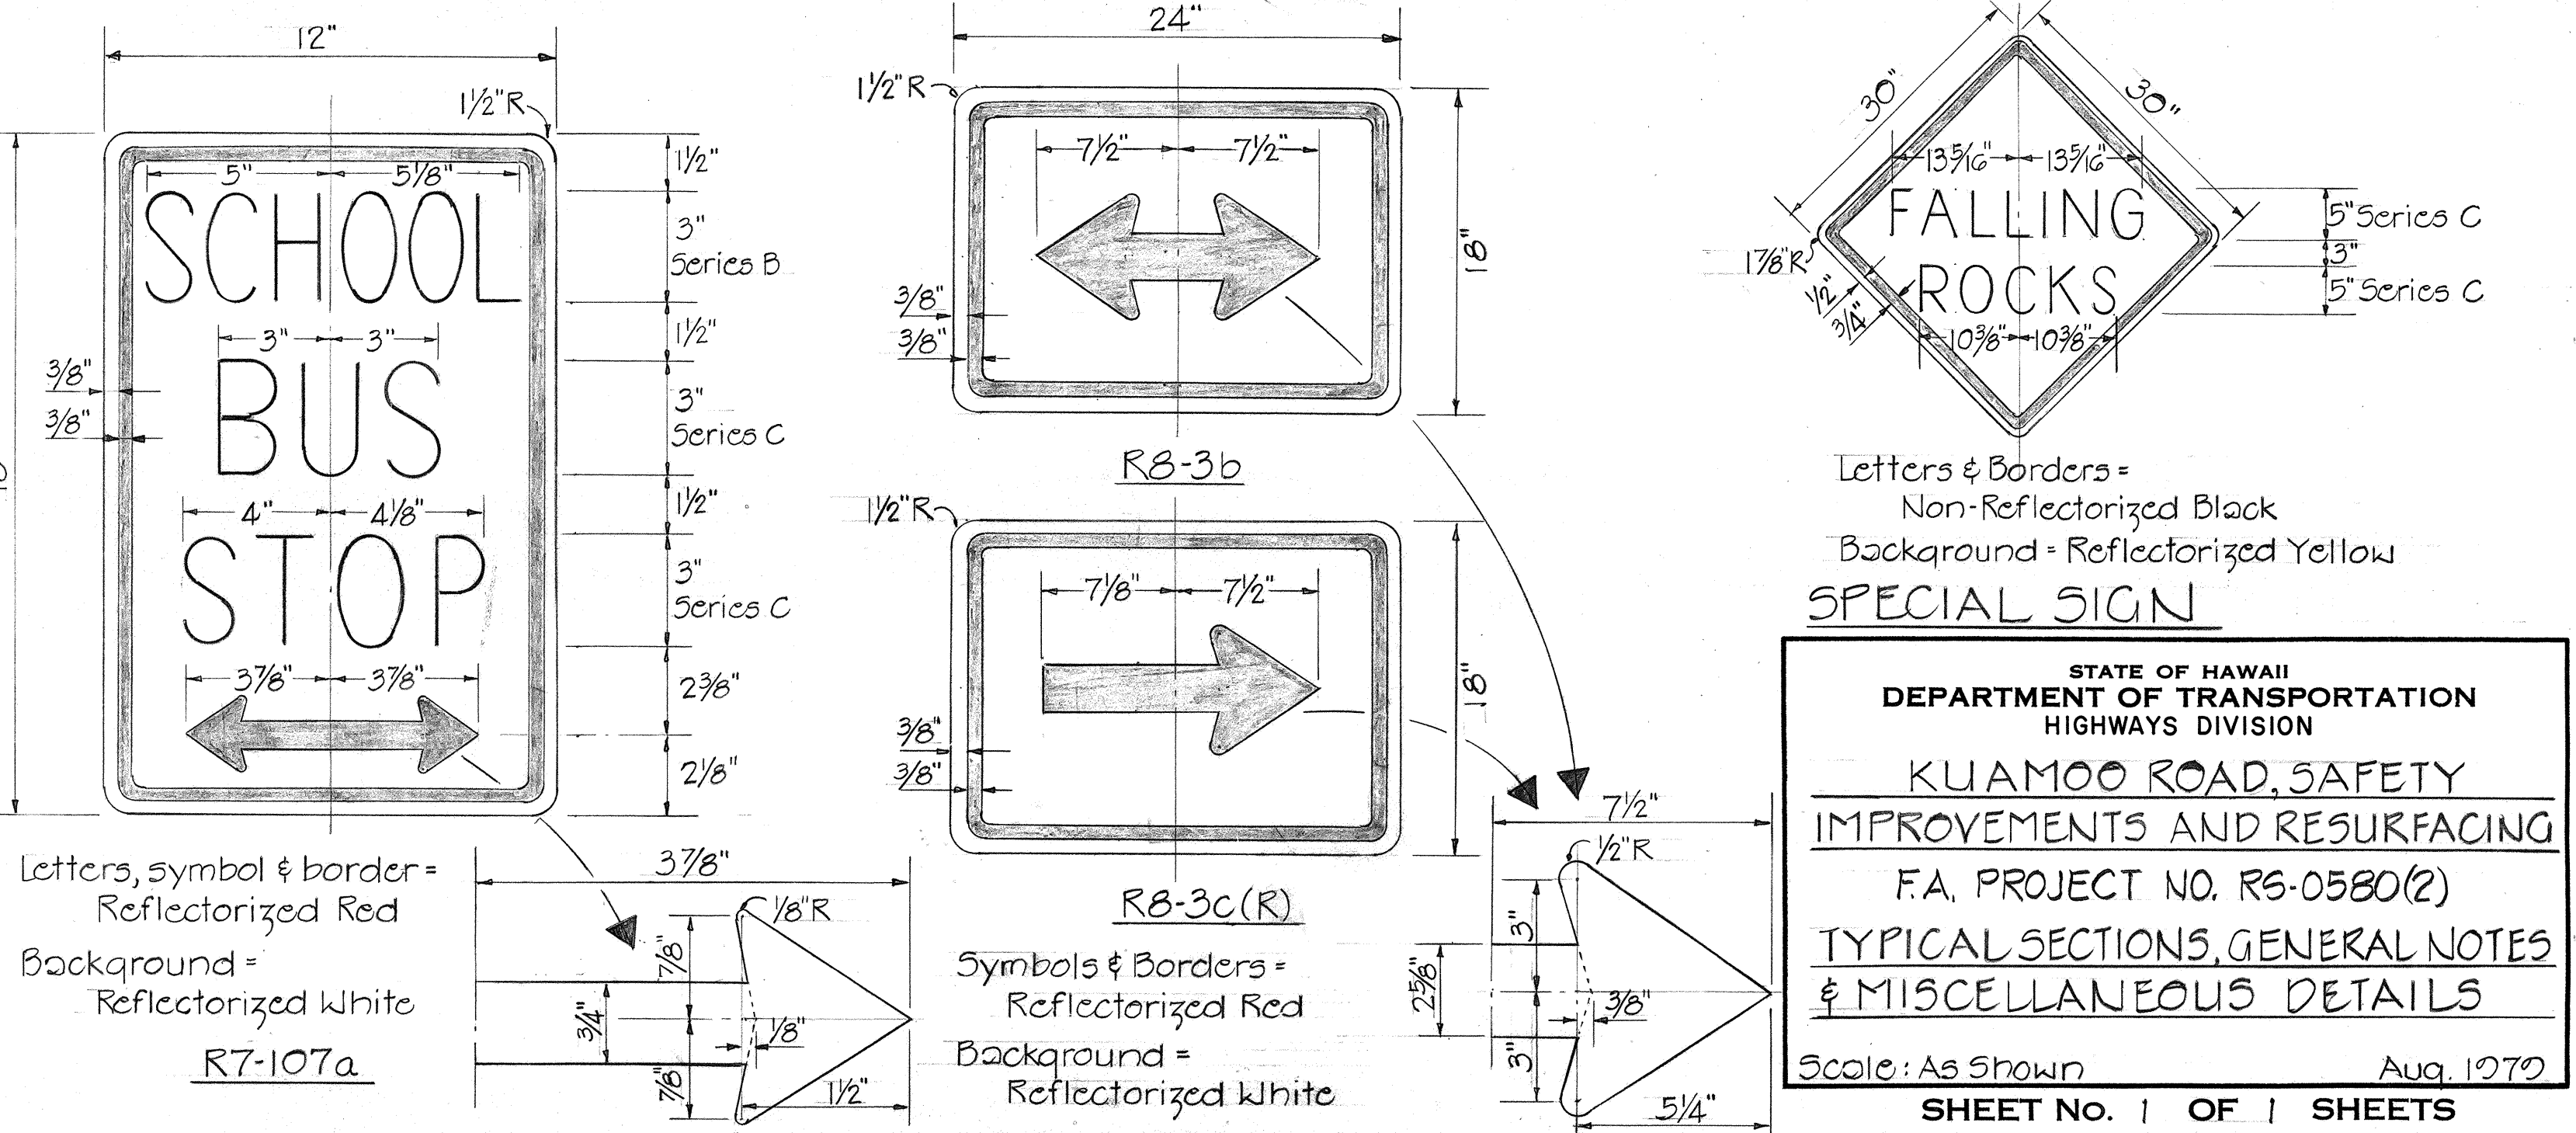
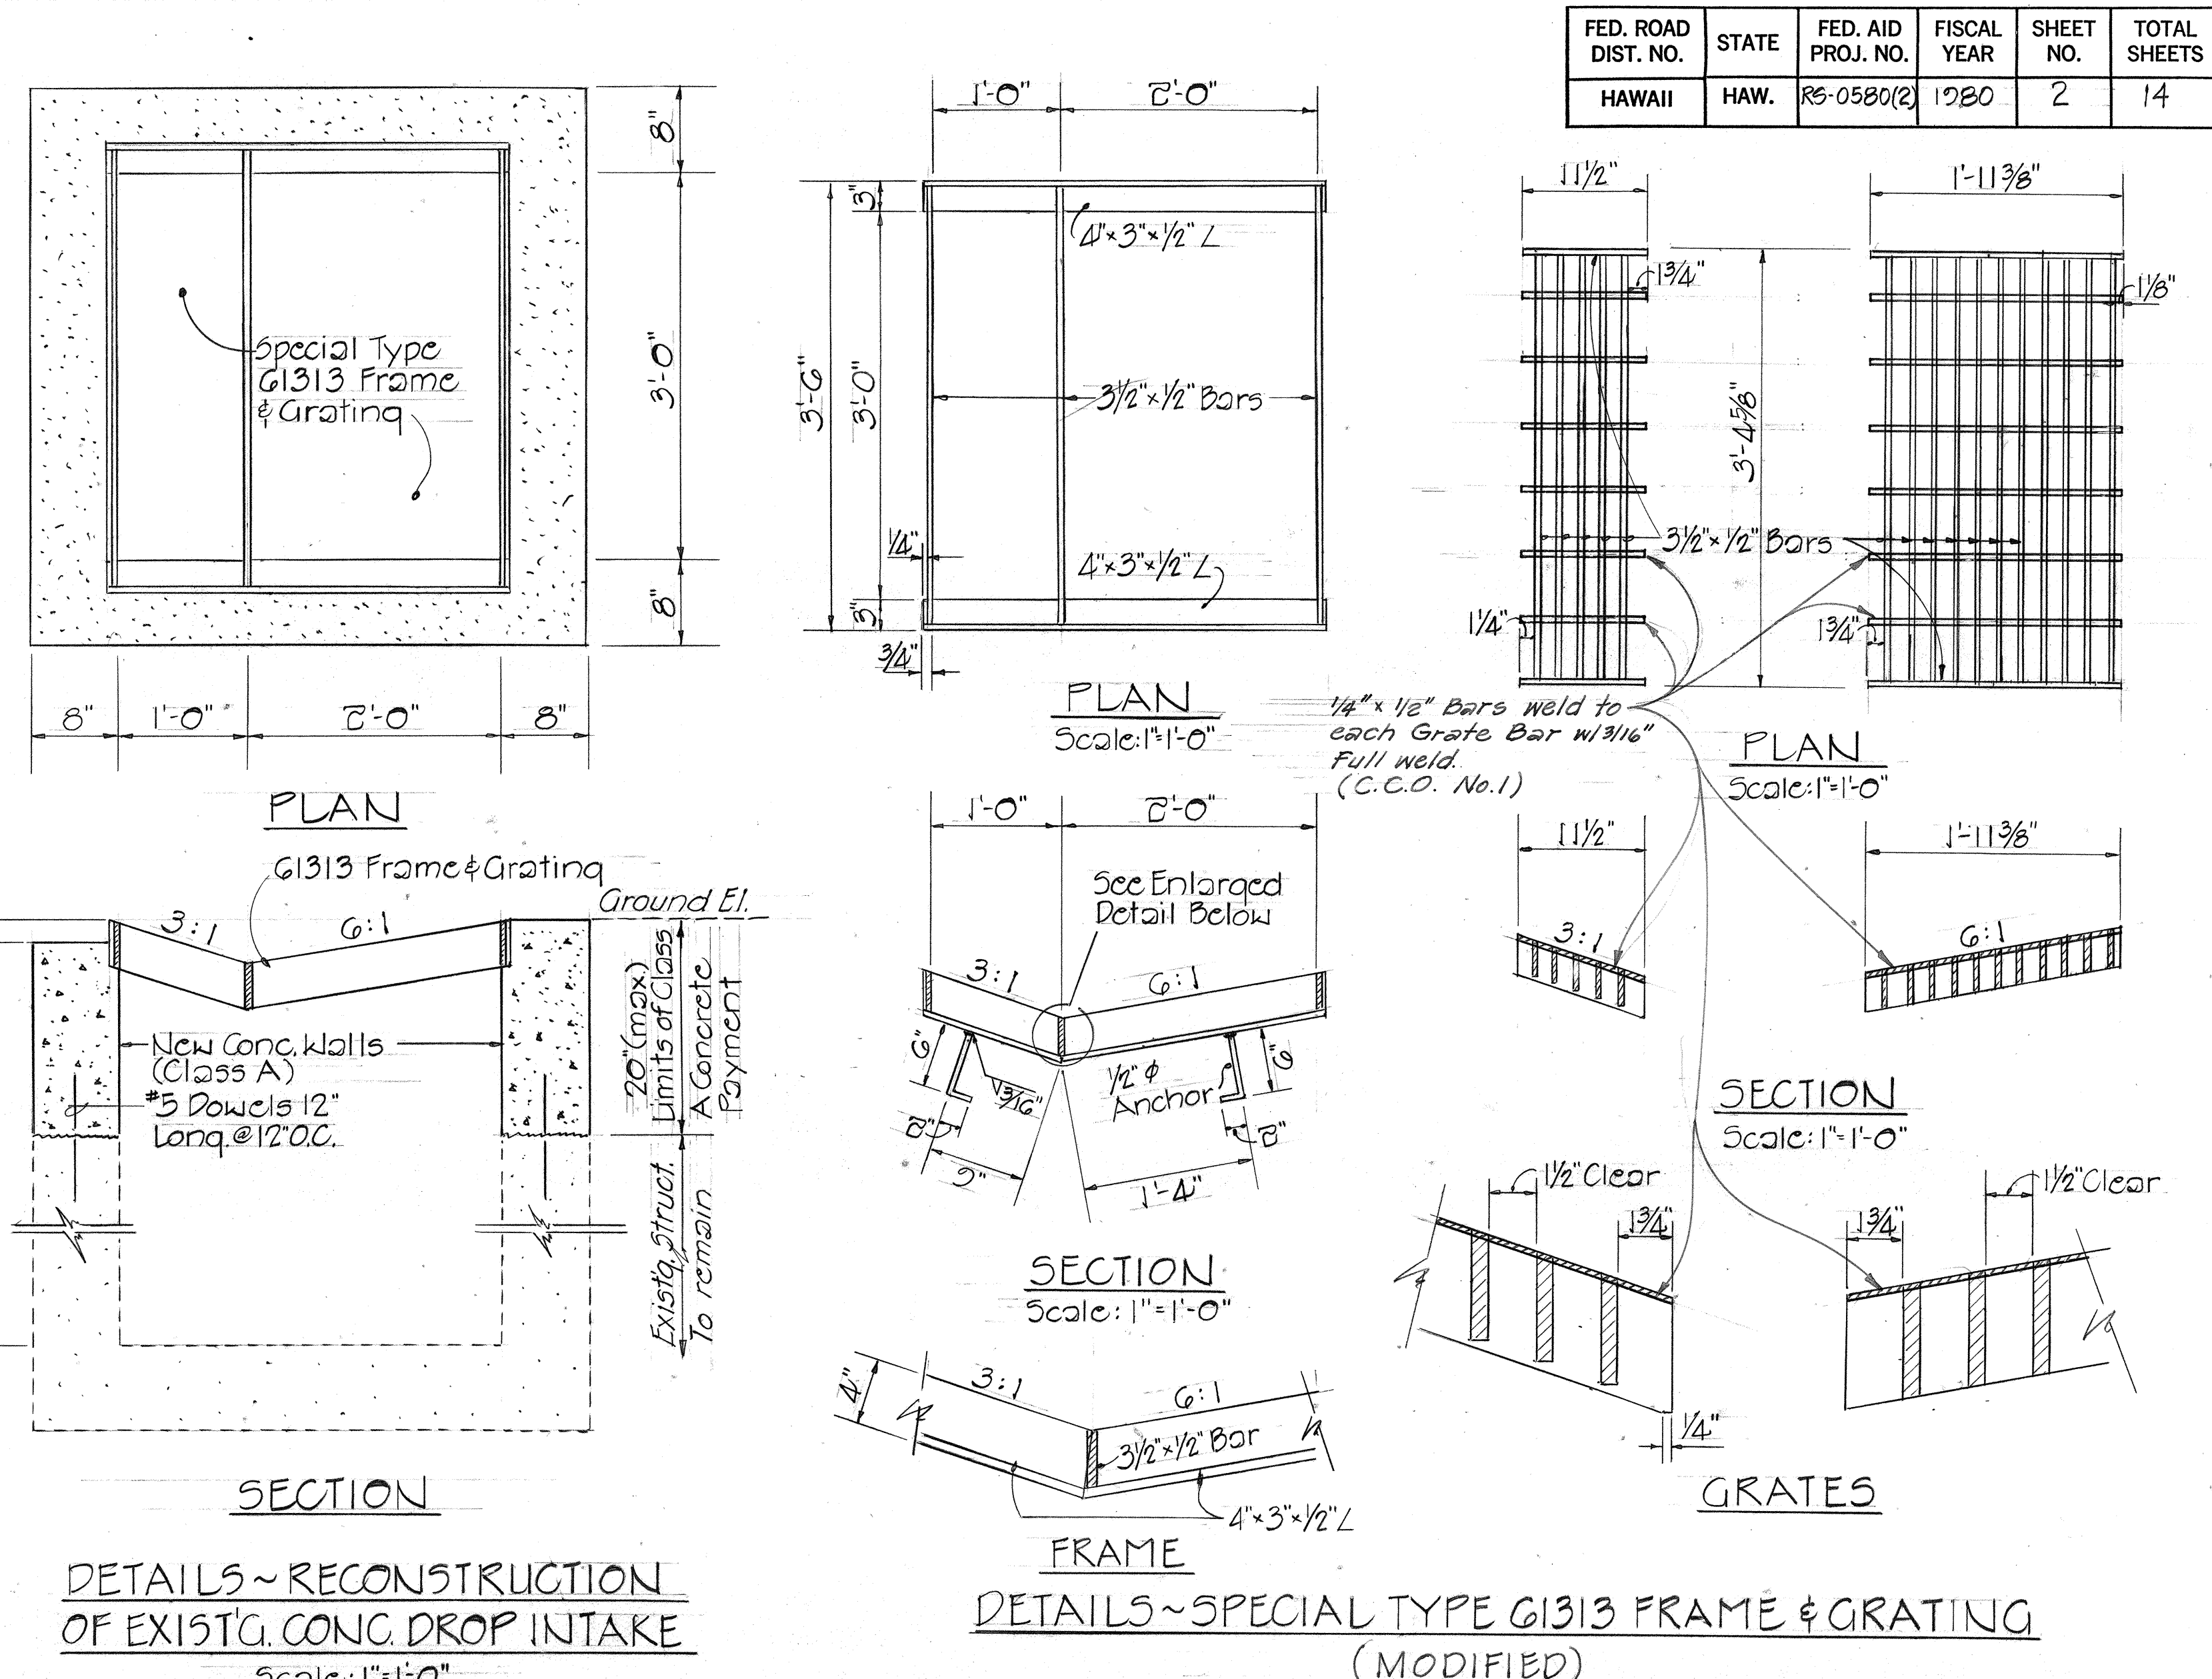


FED. ROAD DIST. NO.	STATE	FED. AID PROJ. NO.	FISCAL YEAR	SHEET NO.	TOTAL SHEETS
HAWAII	HAW.	RS-0580(2)	1980	2	14

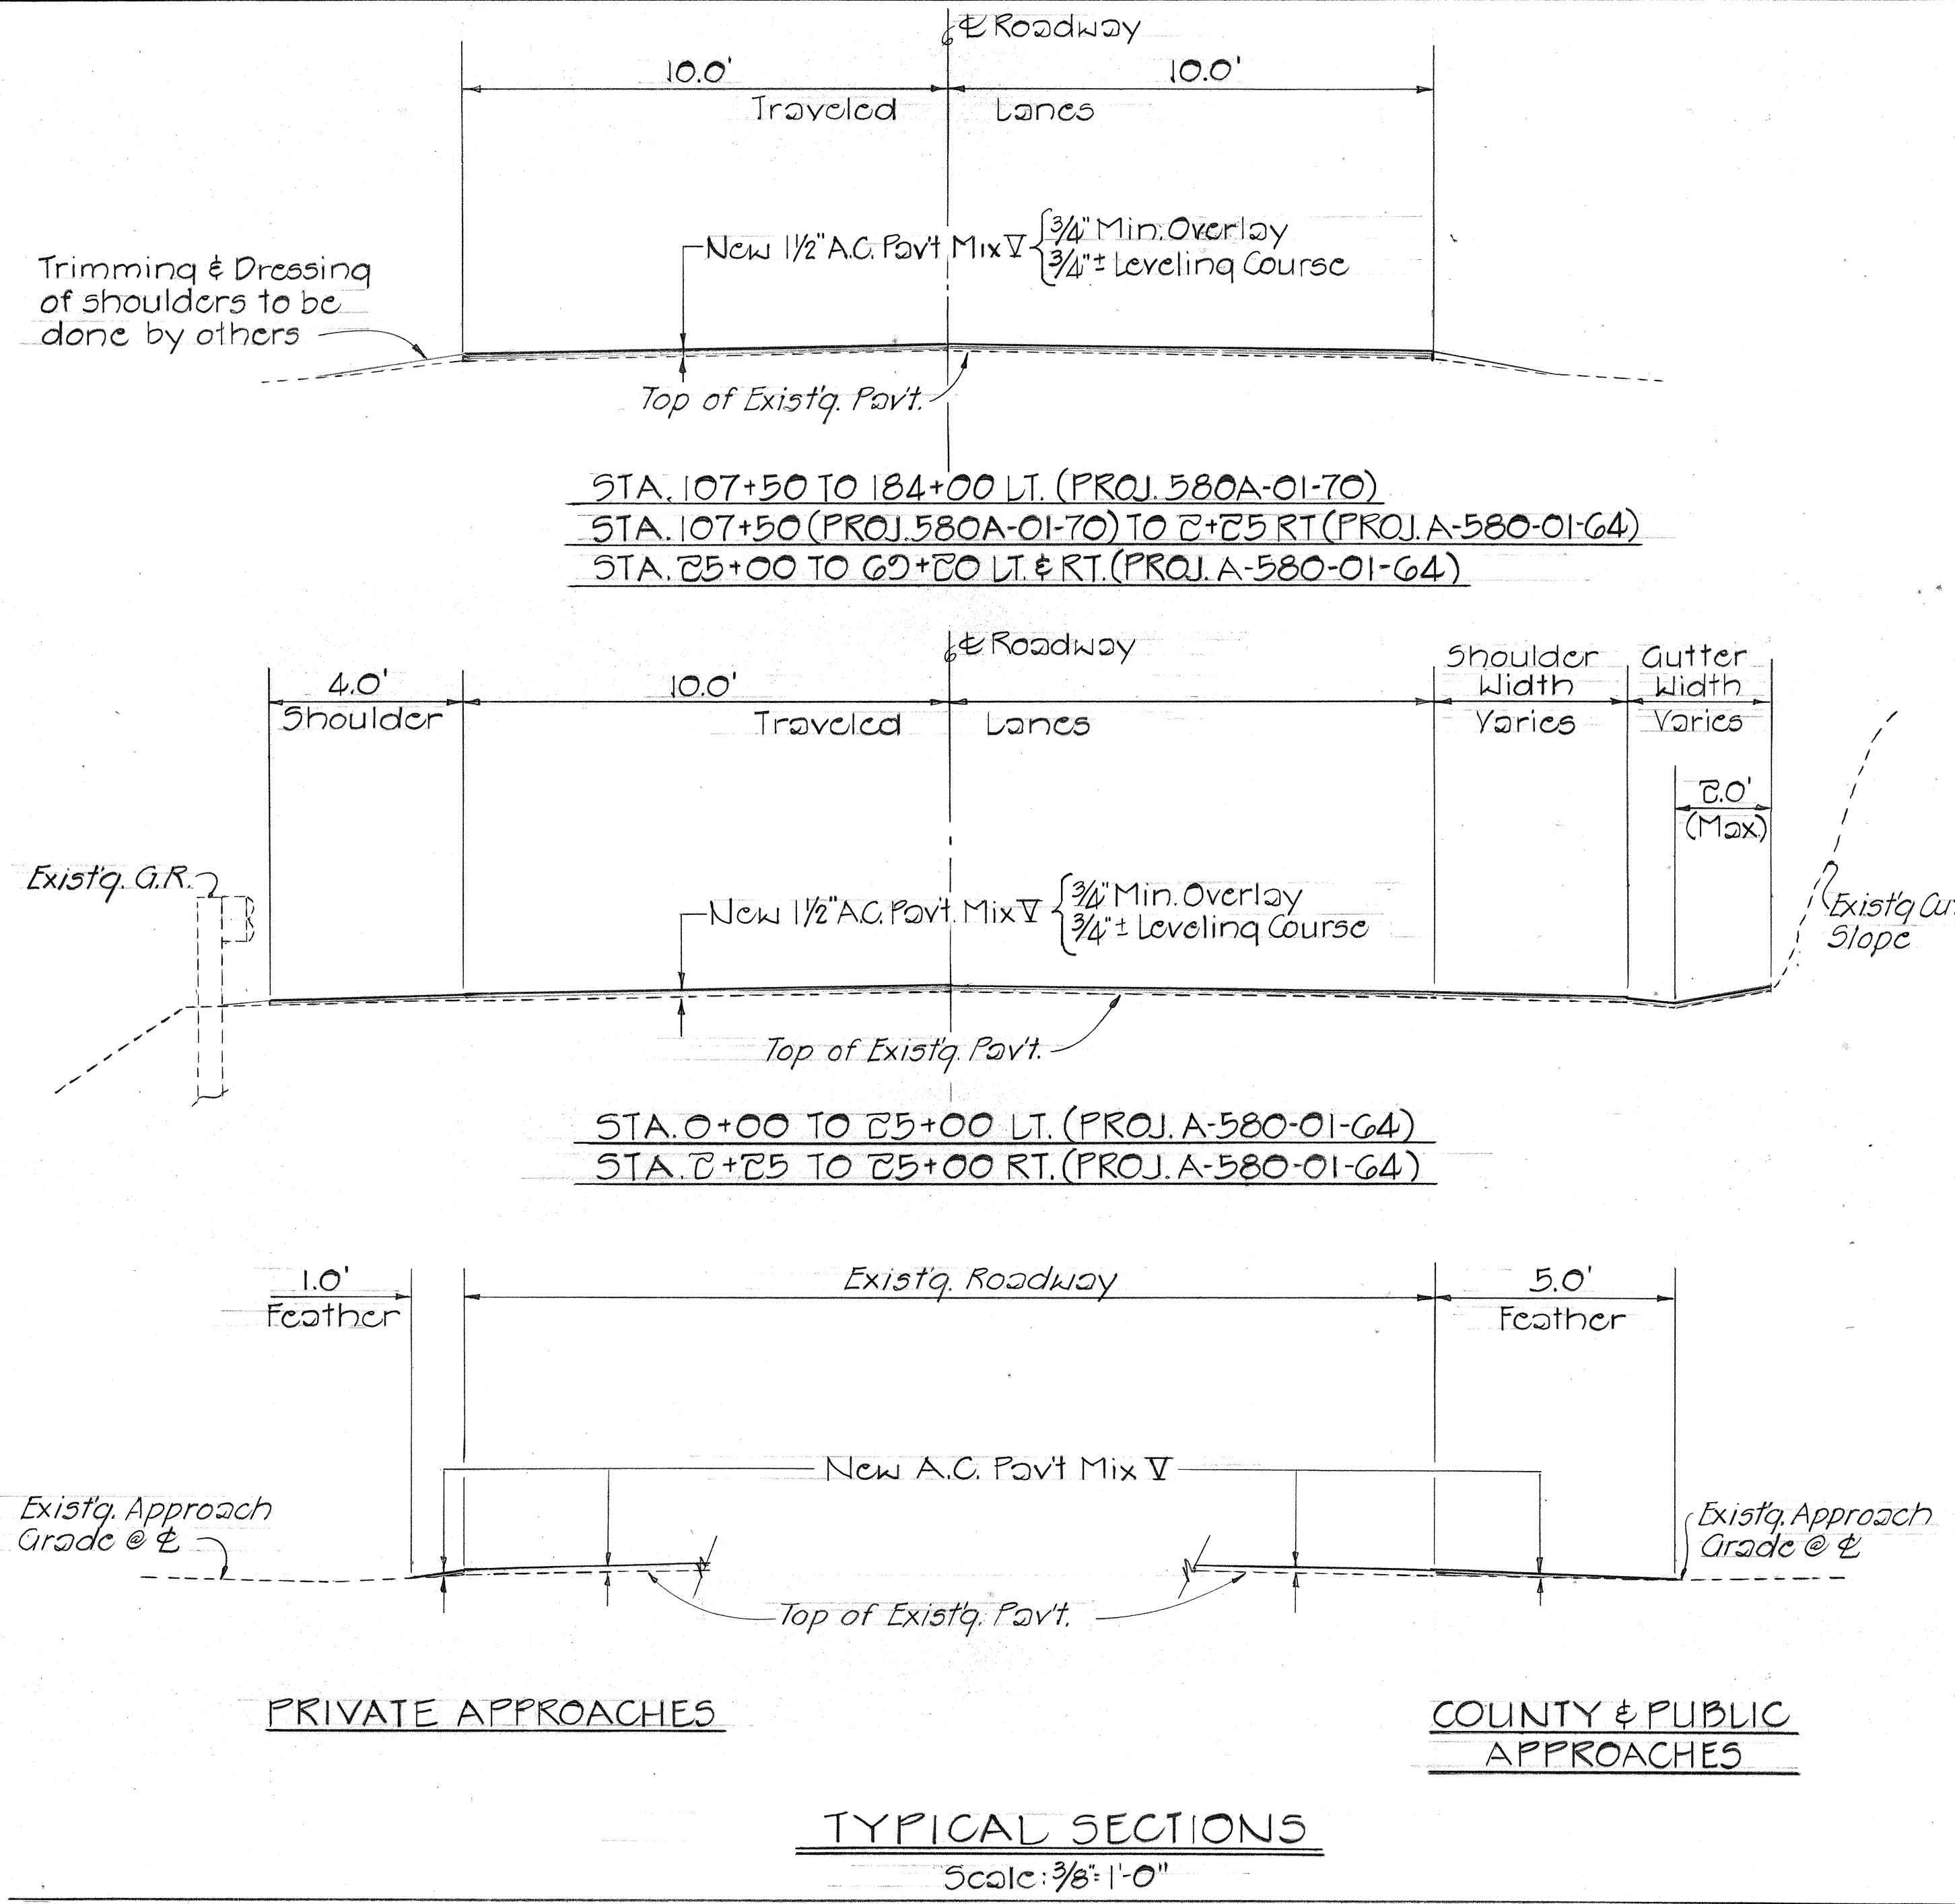

GENERAL NOTES:

- 1-All lanes shall be open to traffic during the morning peak hours from 6:30 am. to 8:00 am. and during the afternoon peak hours from 3:30 pm. to 5:00 pm. and during off work hours. Only one lane of Highway shall be closed at any other time.
- 2-Existing wearing surface indicated in Typical Section varies. Surface indicated is entirely imaginary and not intended to represent any specific location.
- 3-Provide smooth riding transition at the beginning and end of each section, at structures and at all connecting driveways and approaches as directed by the Engineer
- 4-The item "Brooming Off" will not be measured or paid for separately but shall be considered incidental to A.C. Pavement Mix V.
- 5-Patching of existing pavement prior to resurfacing will not be required.

- 6-No materials or equipments shall be stockpiled or parked within the Highway Rights-of-Way except at locations designated by the Engineer.
 - 7-Contractor shall verify all utilities prior to commencement of any construction activities.
- SPECIAL TYPE G1313 GRATED DROP INTAKE**
- 1-Grates and Frames shall be hot dip galvanized after fabrication, see Specifications.
 - 2-All welds 3/8" unless otherwise noted.
 - 3-The frame and grate materials shall conform to the specifications of ASTM. Designation Structural Steel A283, Grade D and the Standard Specification.
- SIGN/SYMBOL SIGN**
- 1-Sign message shall be lettered in upper case according to "Standard Alphabets for Highway Signs" Bureau of Public Roads, 1966.
 - 2-Letters (series), symbols, borders and backgrounds shall conform with details as shown.

DATE	_____
SURVEY PLOTTED BY	_____
DRAWN BY	_____
DESIGNED BY	_____
CHECKED BY	_____
NOTE BOOK	_____
NO.	_____