


GENERAL NOTES:

- 1-All Stations refer to Kuamoo Road, Project Nos. 580A-01-70, A-580-01-64 Phase I and A-580-01-64 Phase II
- 2-The Contractor shall leave at least one lane open to traffic during working hours and both lanes open to traffic during non-working hours.
- 3-Removal of trees and other obstructions for proper layout of drape will not be paid for separately but shall be considered incidental to Chain Link Drape.
- 4-Structural Exc., Class A Concrete, Reinf. Steel, Galv. Steel Pipe Rail, Safety Clips, Tie Wire and Wire Rope shall be considered incidental to Chain Link Drape.


FED. ROAD DIST. NO.	STATE	PROJ. NO.	FISCAL YEAR	SHEET NO.	TOTAL SHEETS
HAWAII	HAW.	580A-01-70 PHASE II	1980	2	9

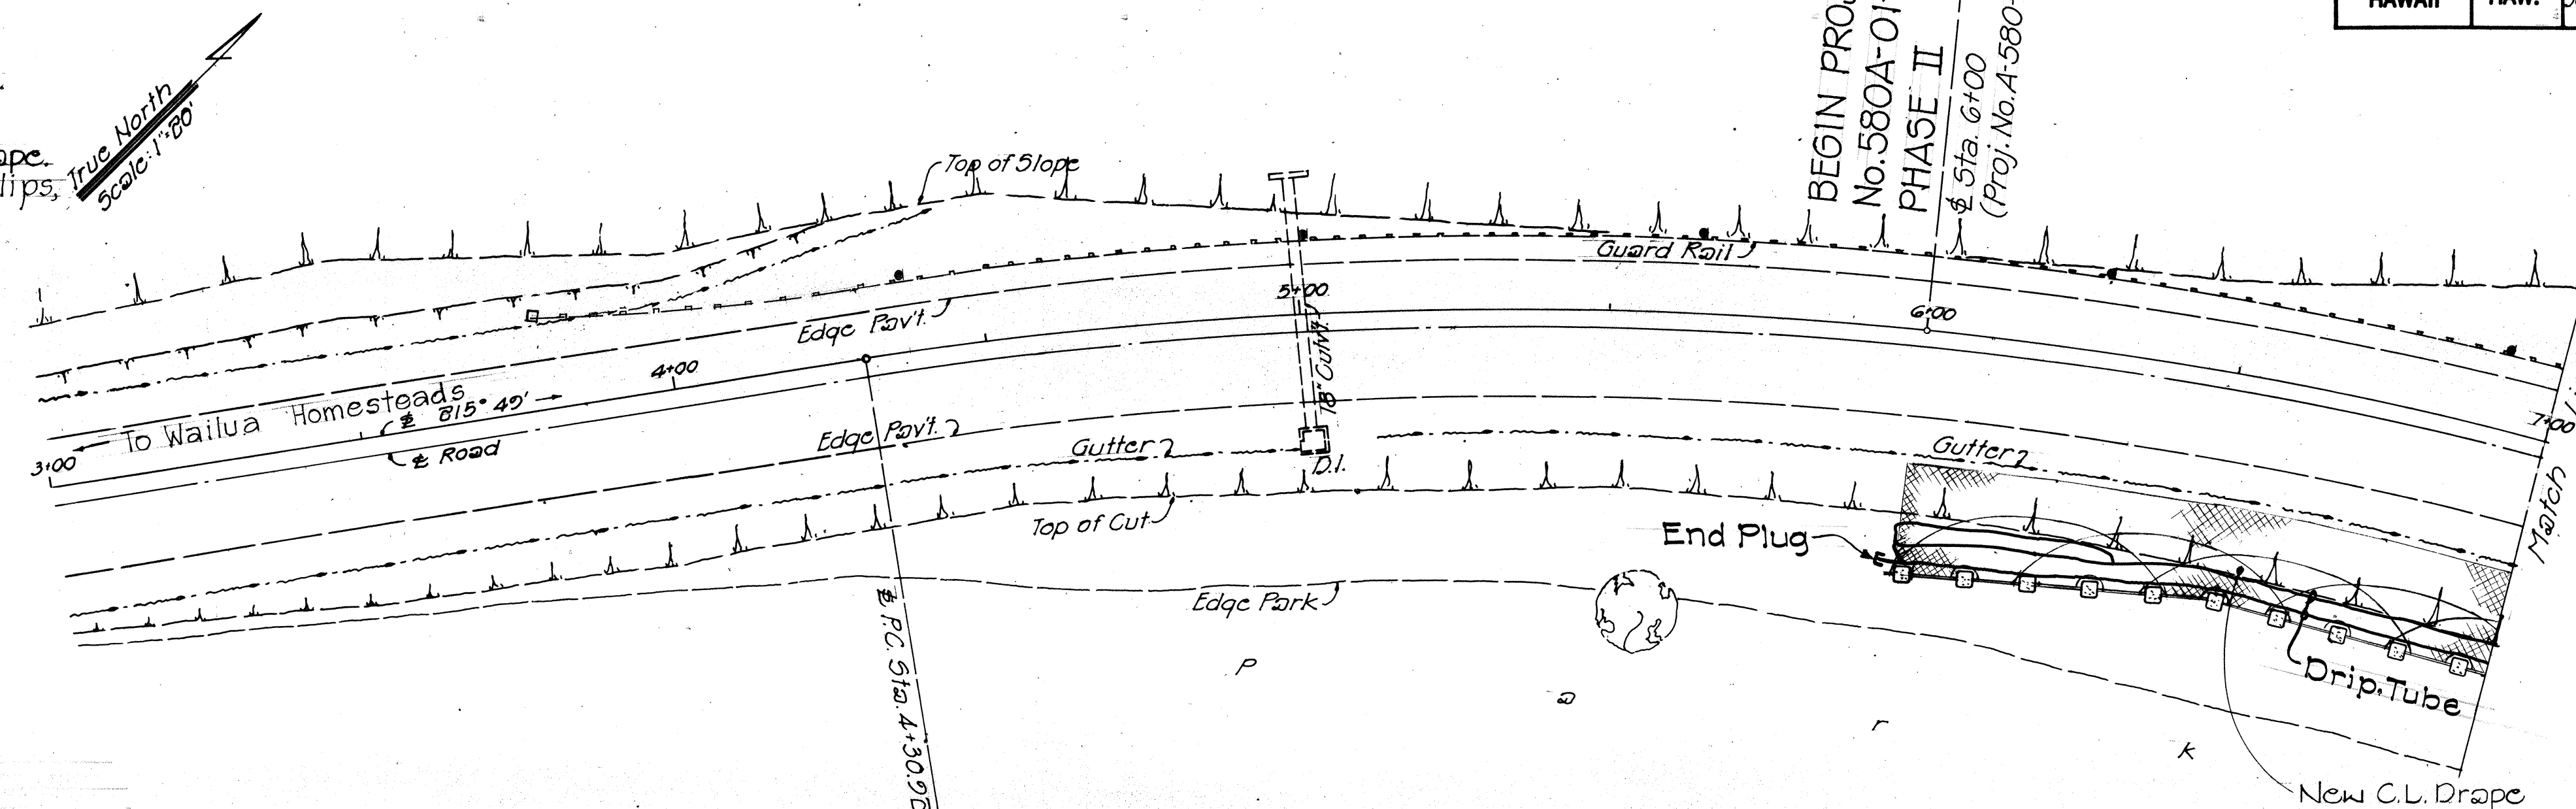

CURVE DATA
 $\Delta = 33^\circ 55' 00''$
 $R = 650.00'$
 $T = 198.21'$
 $C = 379.18'$
 $LC = 384.77'$

LANDSCAPE IRRIGATION NOTES:

1. Irrigation Main shall be class 200 PVC.
2. Drip Tube shall be manufactured from polybutylene (PB 2110) resin. With internal diameter of 0.580 inches, minimum wall thickness of 0.038 inches and designed for 100 psi working pressure at 73.4°F.

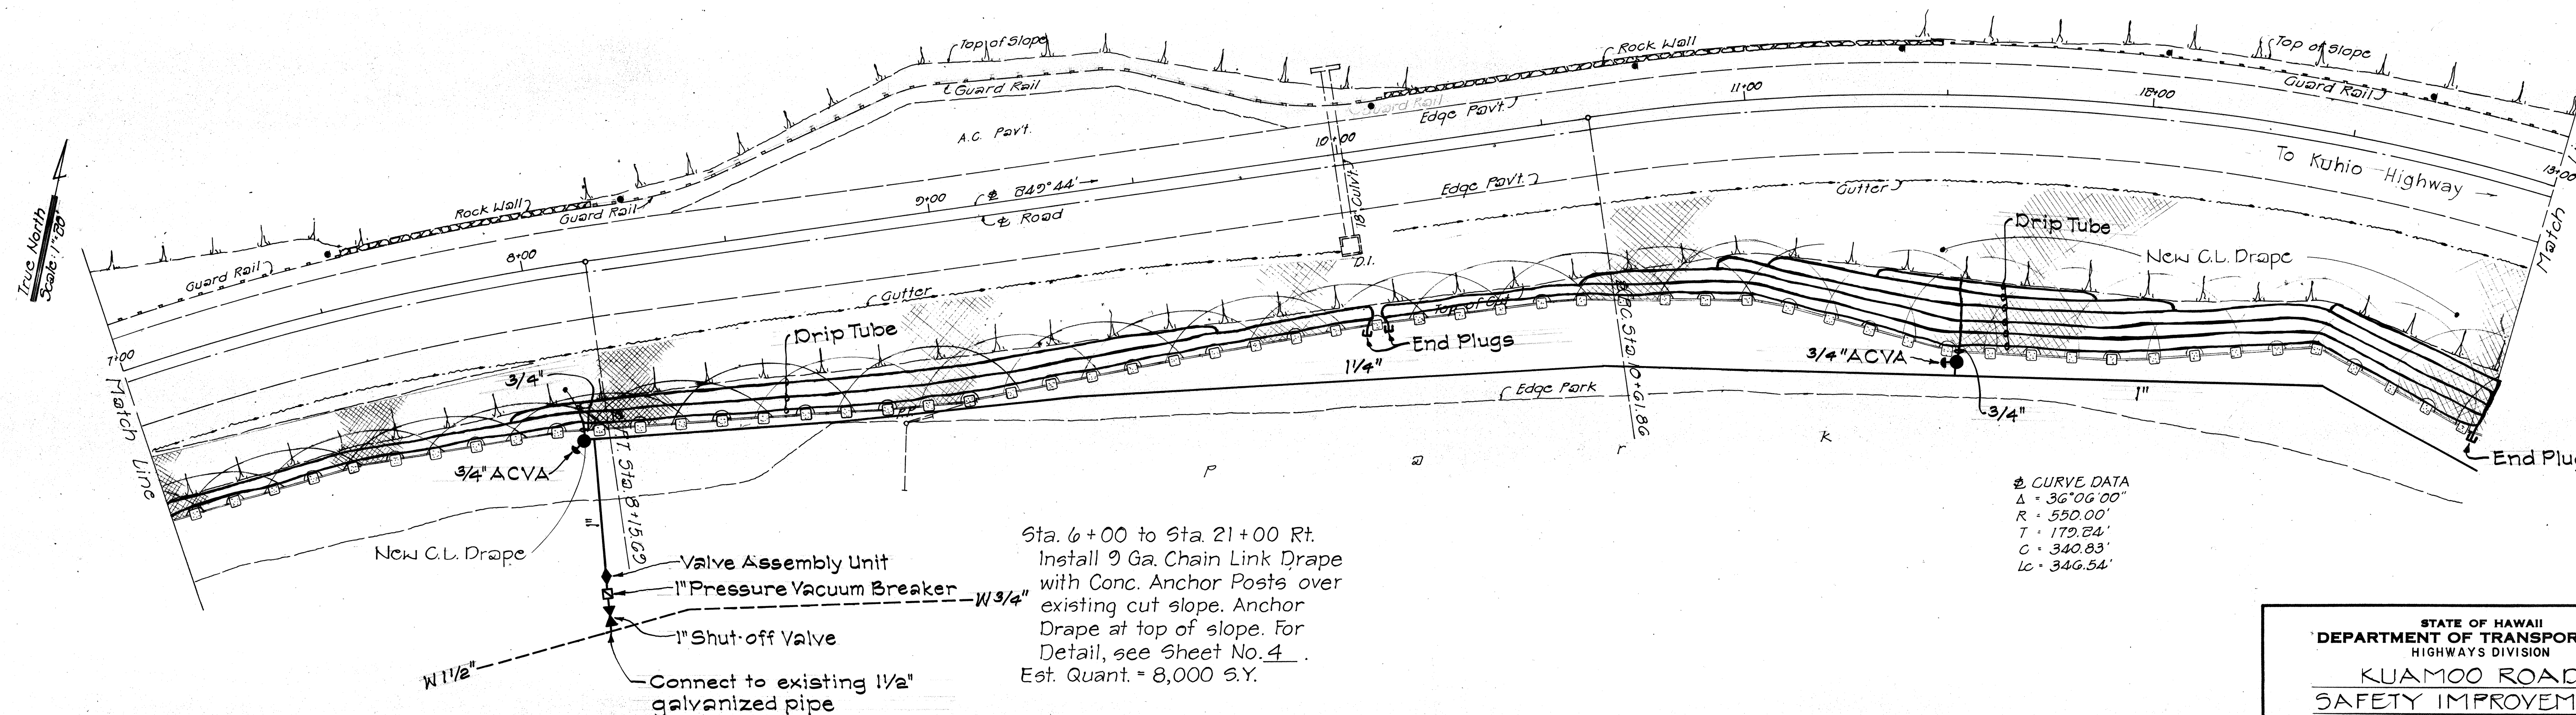

CURVE DATA
 $\Delta = 36^\circ 06' 00''$
 $R = 550.00'$
 $T = 179.24'$
 $C = 340.83'$
 $LC = 346.54'$

Sta. 6+00 to Sta. 21+00 Rt.
 Install 2 Ga. Chain Link Drape
 with Conc. Anchor Posts over
 existing cut slope. Anchor
 Drape at top of slope. For
 Detail, see Sheet No. 4
 Est. Quant. = 8,000 S.Y.

STATE OF HAWAII
 DEPARTMENT OF TRANSPORTATION
 HIGHWAYS DIVISION
 KUAMOO ROAD
 SAFETY IMPROVEMENTS
 PROJ. No. 580A-01-70
 PHASE II
 PLAN & GENERAL NOTES

Scale: As Shown
 SHEET NO. 1 OF 2 SHEETS

FED. ROAD DIST. NO.	STATE	PROJ. NO.	FISCAL YEAR	SHEET NO.	TOTAL SHEETS
HAWAII	HAW.	580A-01-76 PHASE II	1980	3	9

Δ CURVE DATA
 Δ = 64°36'00"
 R = 785.00'
 T = 496.86'
 C = 838.93'
 Lc = 885.07'



STATE OF HAWAII
 DEPARTMENT OF TRANSPORTATION
 HIGHWAYS DIVISION
 KUAMOO ROAD
 SAFETY IMPROVEMENTS
 PROJ. No. 580A-01-76
 PHASE II
 PLAN

Scale: As Shown
 SHEET NO. 2 OF 2 SHEETS

Sept. 1978

ORIGINAL PLAN	DATE
DRAWN BY	
DESIGNED BY	
QUANTITIES BY	
CHECKED BY	