



FED. ROAD DIST. NO.	STATE	FED. AID PROJ. NO.	FISCAL YEAR	SHEET NO.	TOTAL SHEETS
HAWAII	HAW.	580A-01-02	2005	ADD.7	25

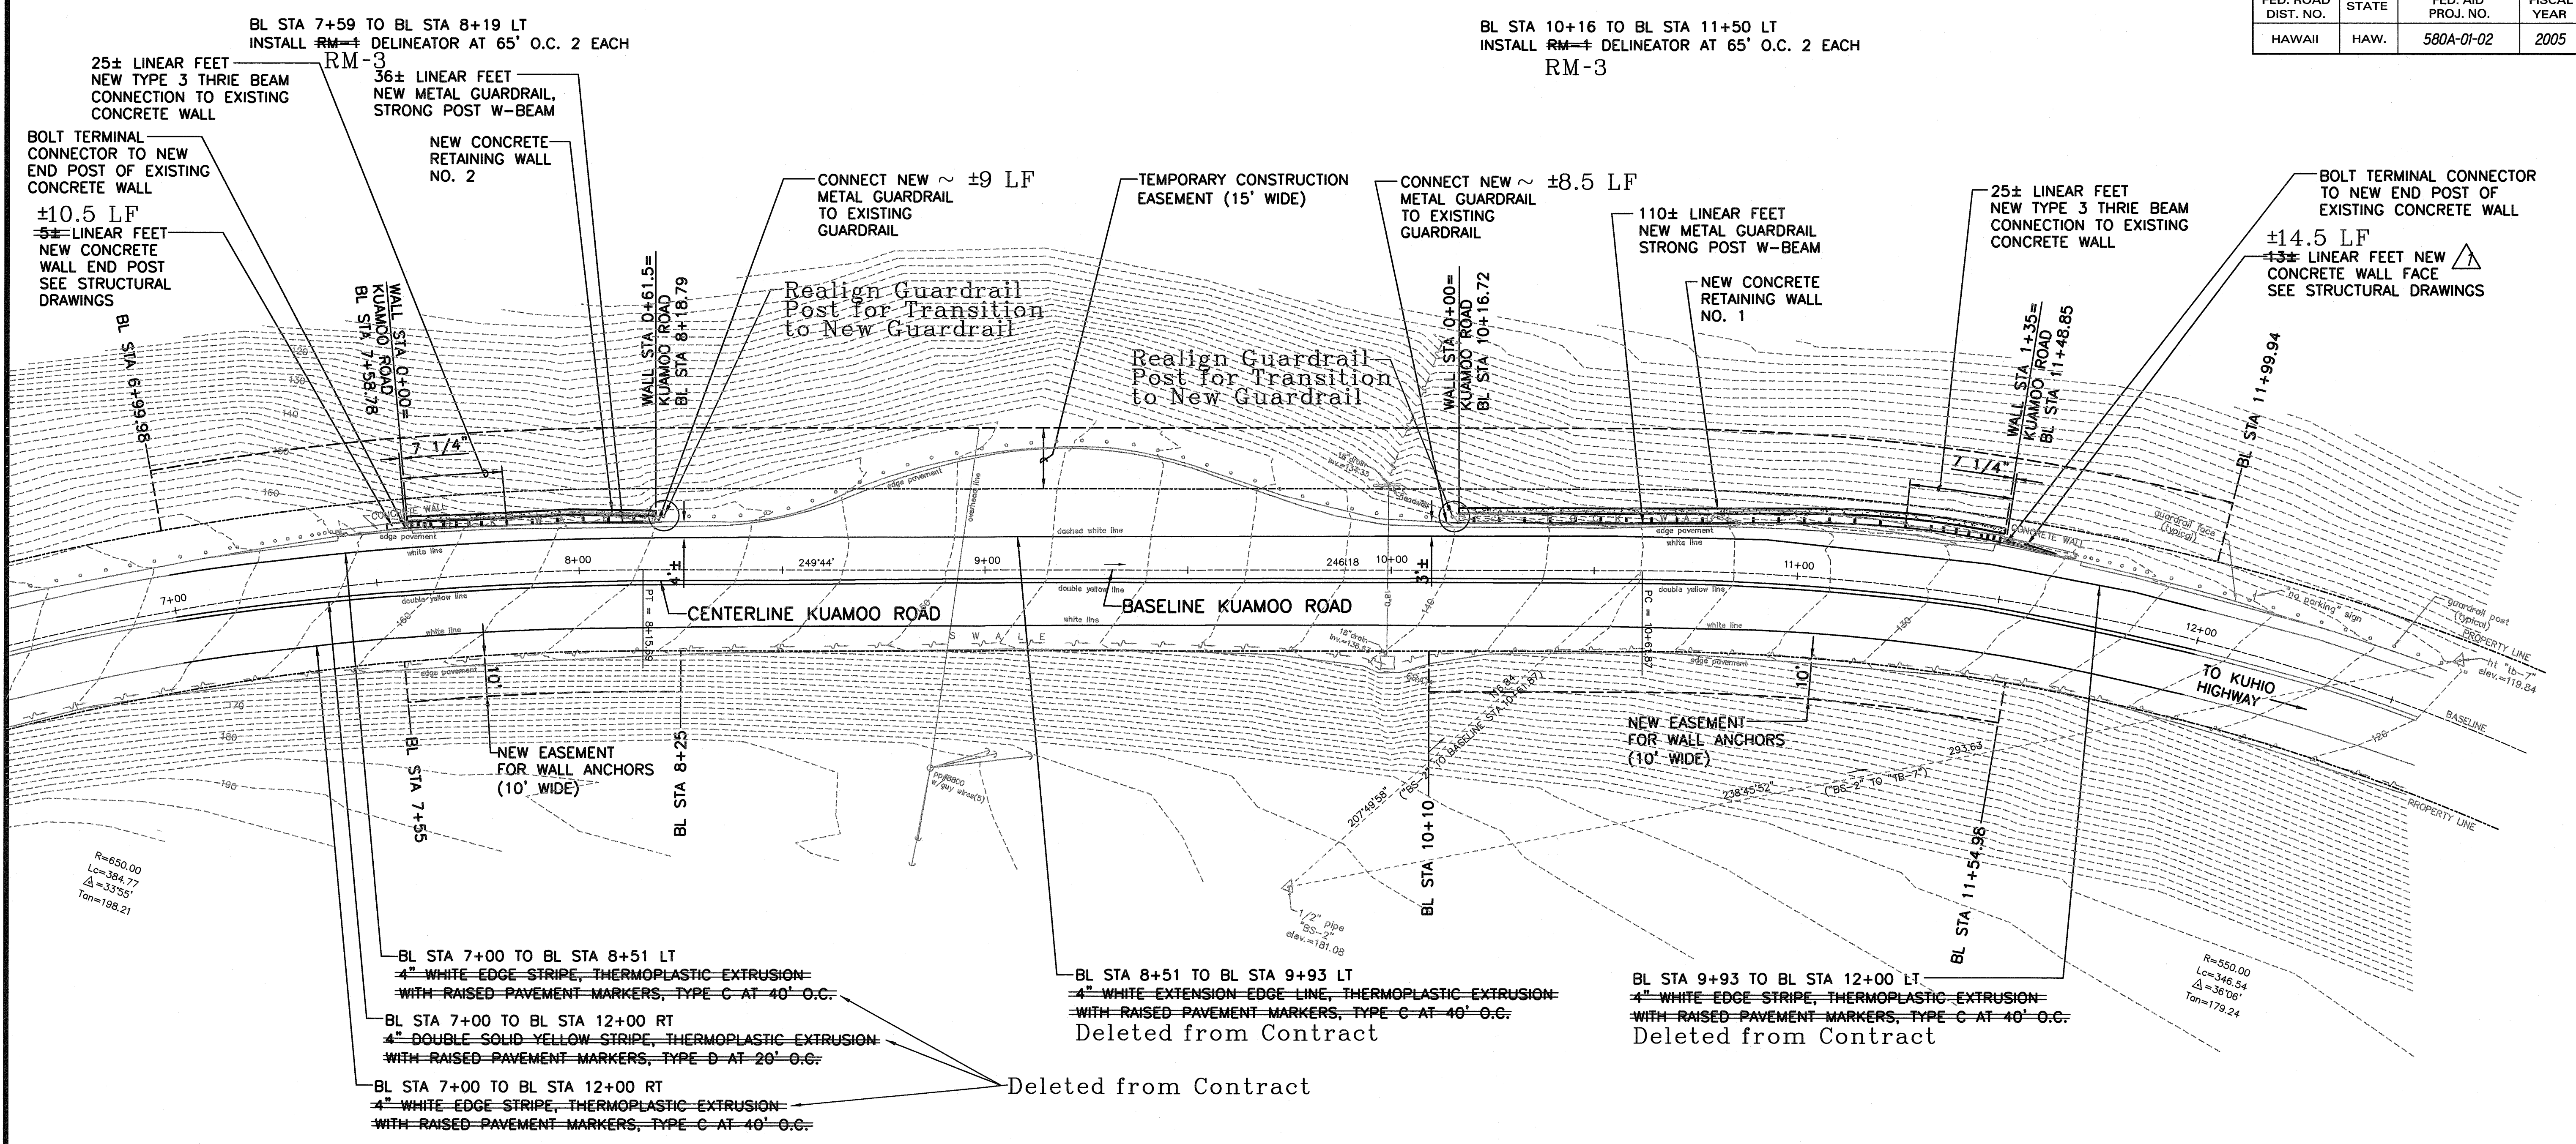

ORIGINAL PLAN	DATE
DRAWN BY	
TRACED BY	
DESIGNED BY	
QUANTITIES BY	
CHECKED BY	

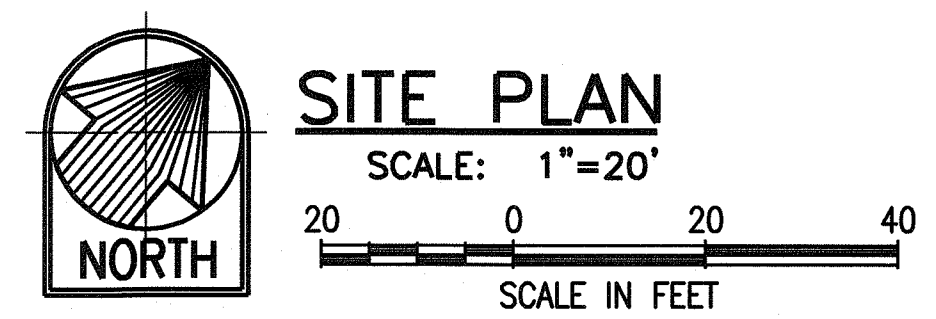

LEGEND FOR AS-BUILT POSTINGS	
	Squiggly line for as-built deletion
	Double line for as-built deletion
Roadway	Text for as-built posting

EXPIRATION DATE OF THE LICENSE (4/30/10)

PLAN M. KATO
LICENSED PROFESSIONAL ENGINEER
No. 7552-C
HAWAII, U.S.A.

THIS WORK WAS PREPARED BY ME OR UNDER MY SUPERVISION

2/02/06		Revised Wall Construction Note
DATE		REVISION
STATE OF HAWAII DEPARTMENT OF TRANSPORTATION HIGHWAYS DIVISION		
SITE PLAN		
KUAMOO ROAD RETAINING WALL IN THE VICINITY OF M.P. 11 PROJECT NO. 580A-01-02		
SCALE: AS NOTED		DATE: SEPT 2005
SHEET No. 1 OF 1 SHEETS		