

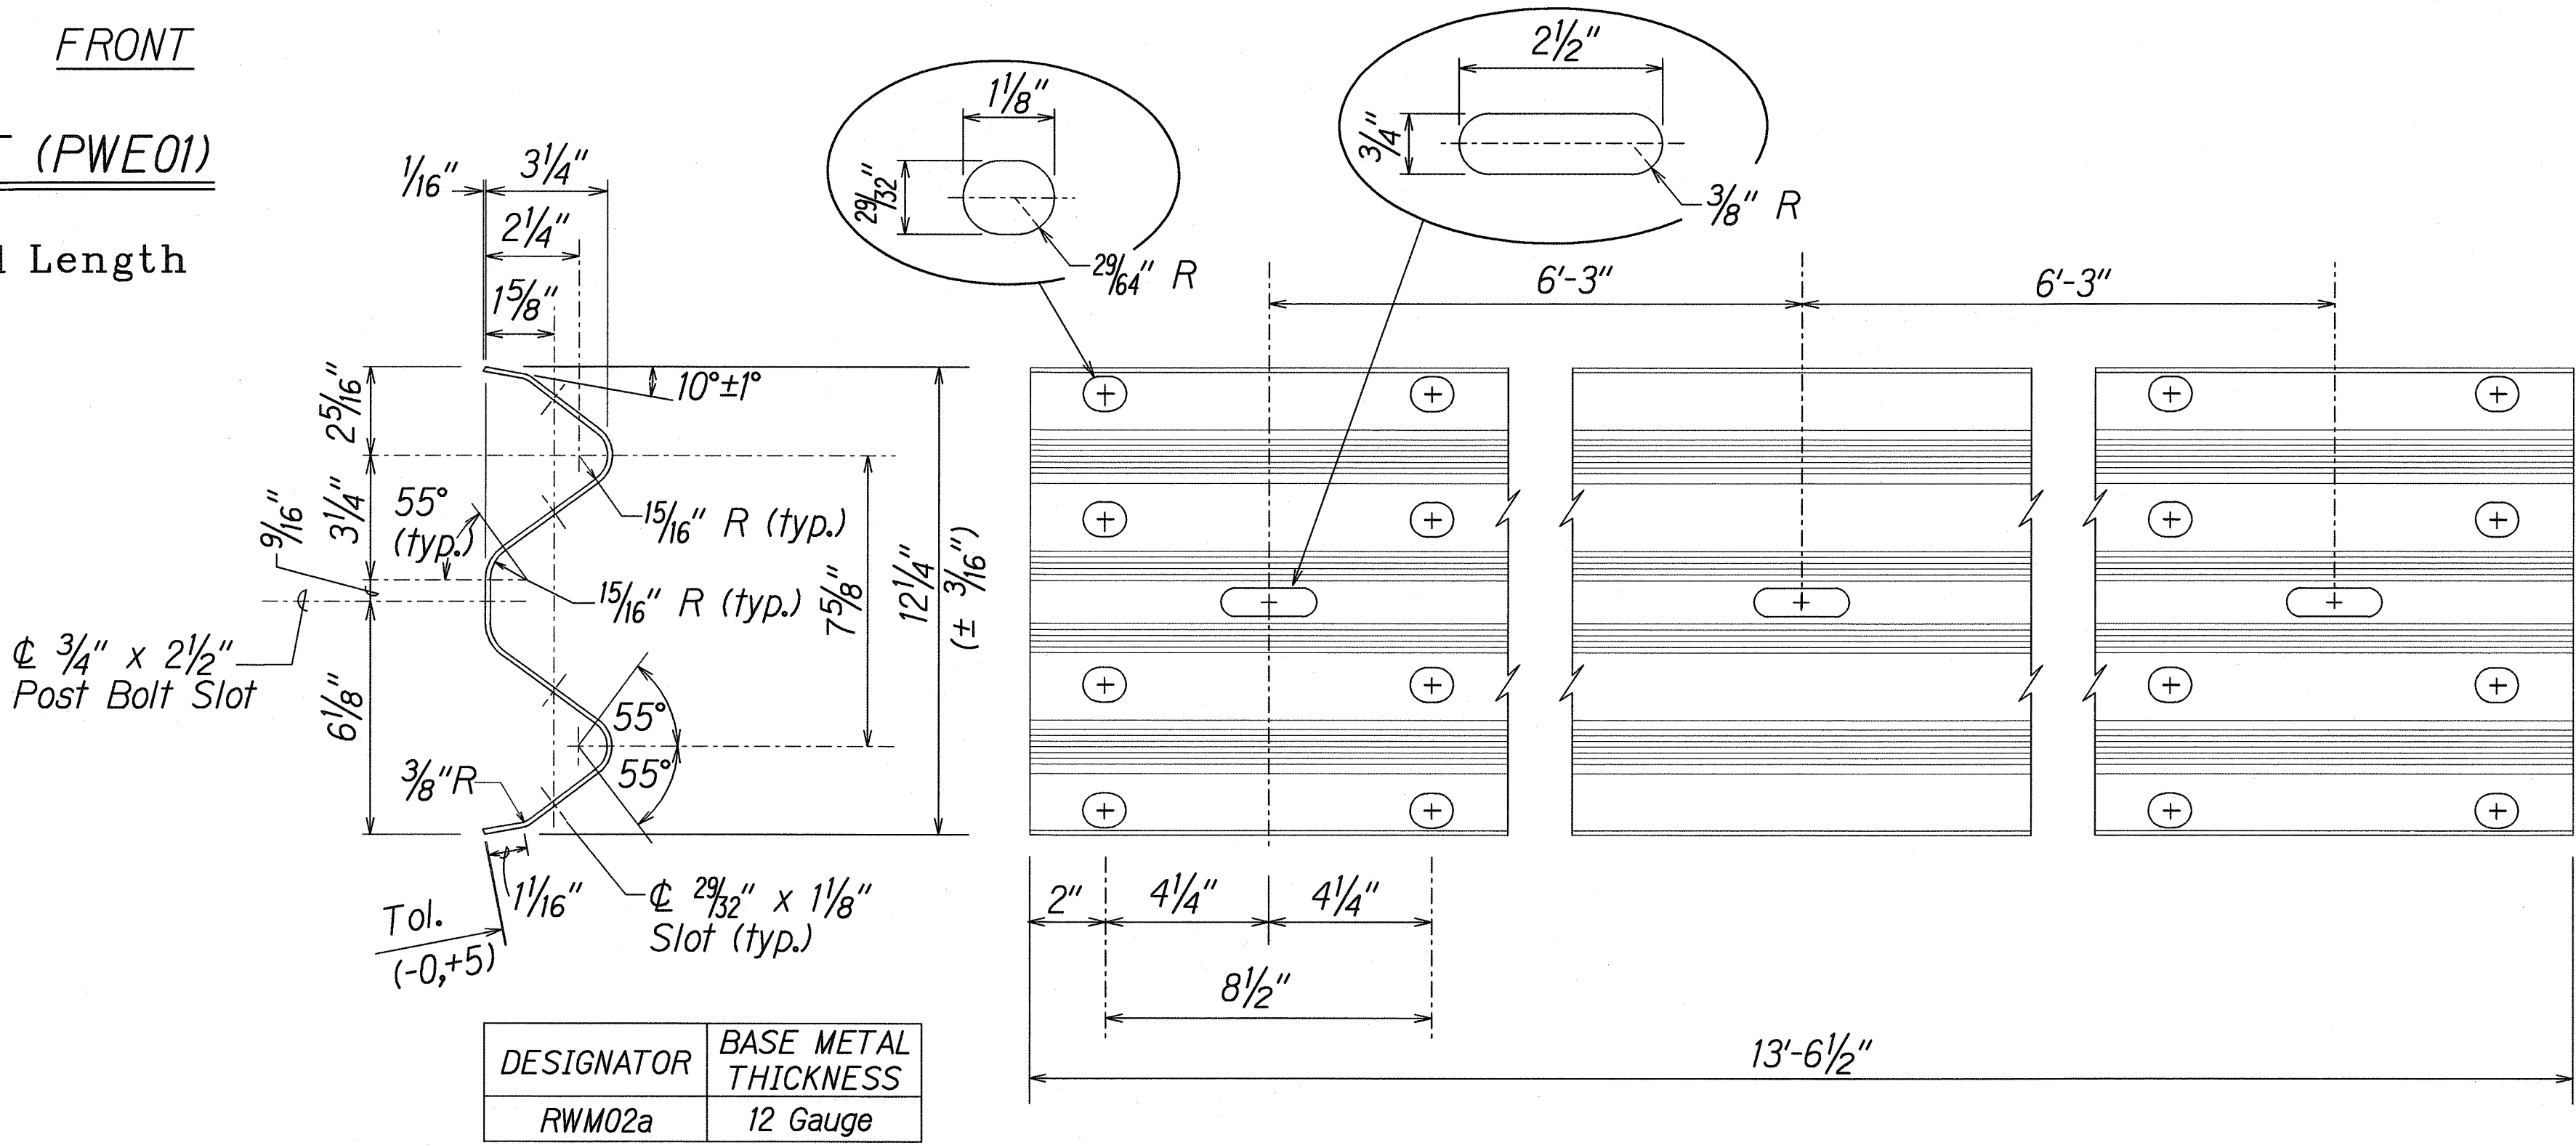
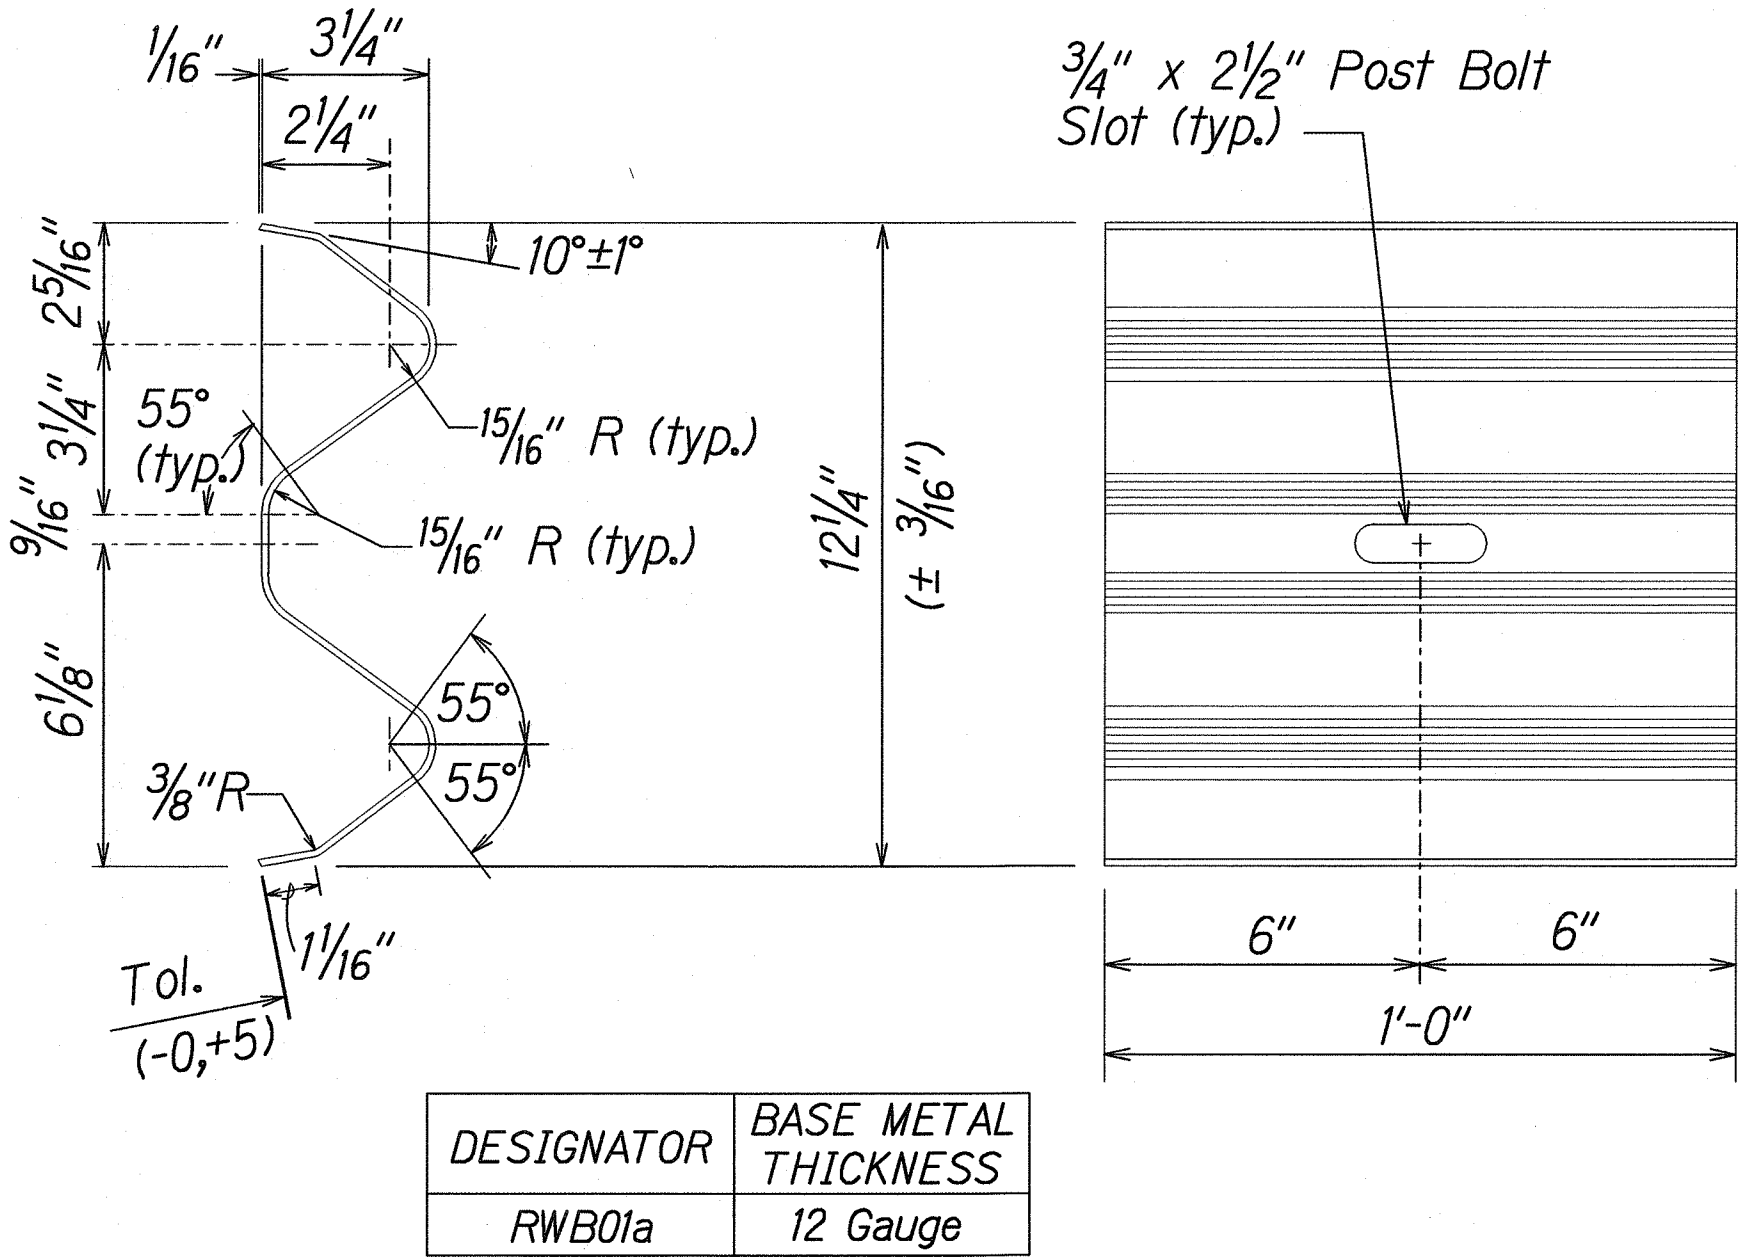


FED. ROAD DIST. NO.	STATE	FED. AID PROJ. NO.	FISCAL YEAR	SHEET NO.	TOTAL SHEETS
HAWAII	HAW.	580A-01-02	2005	14	25

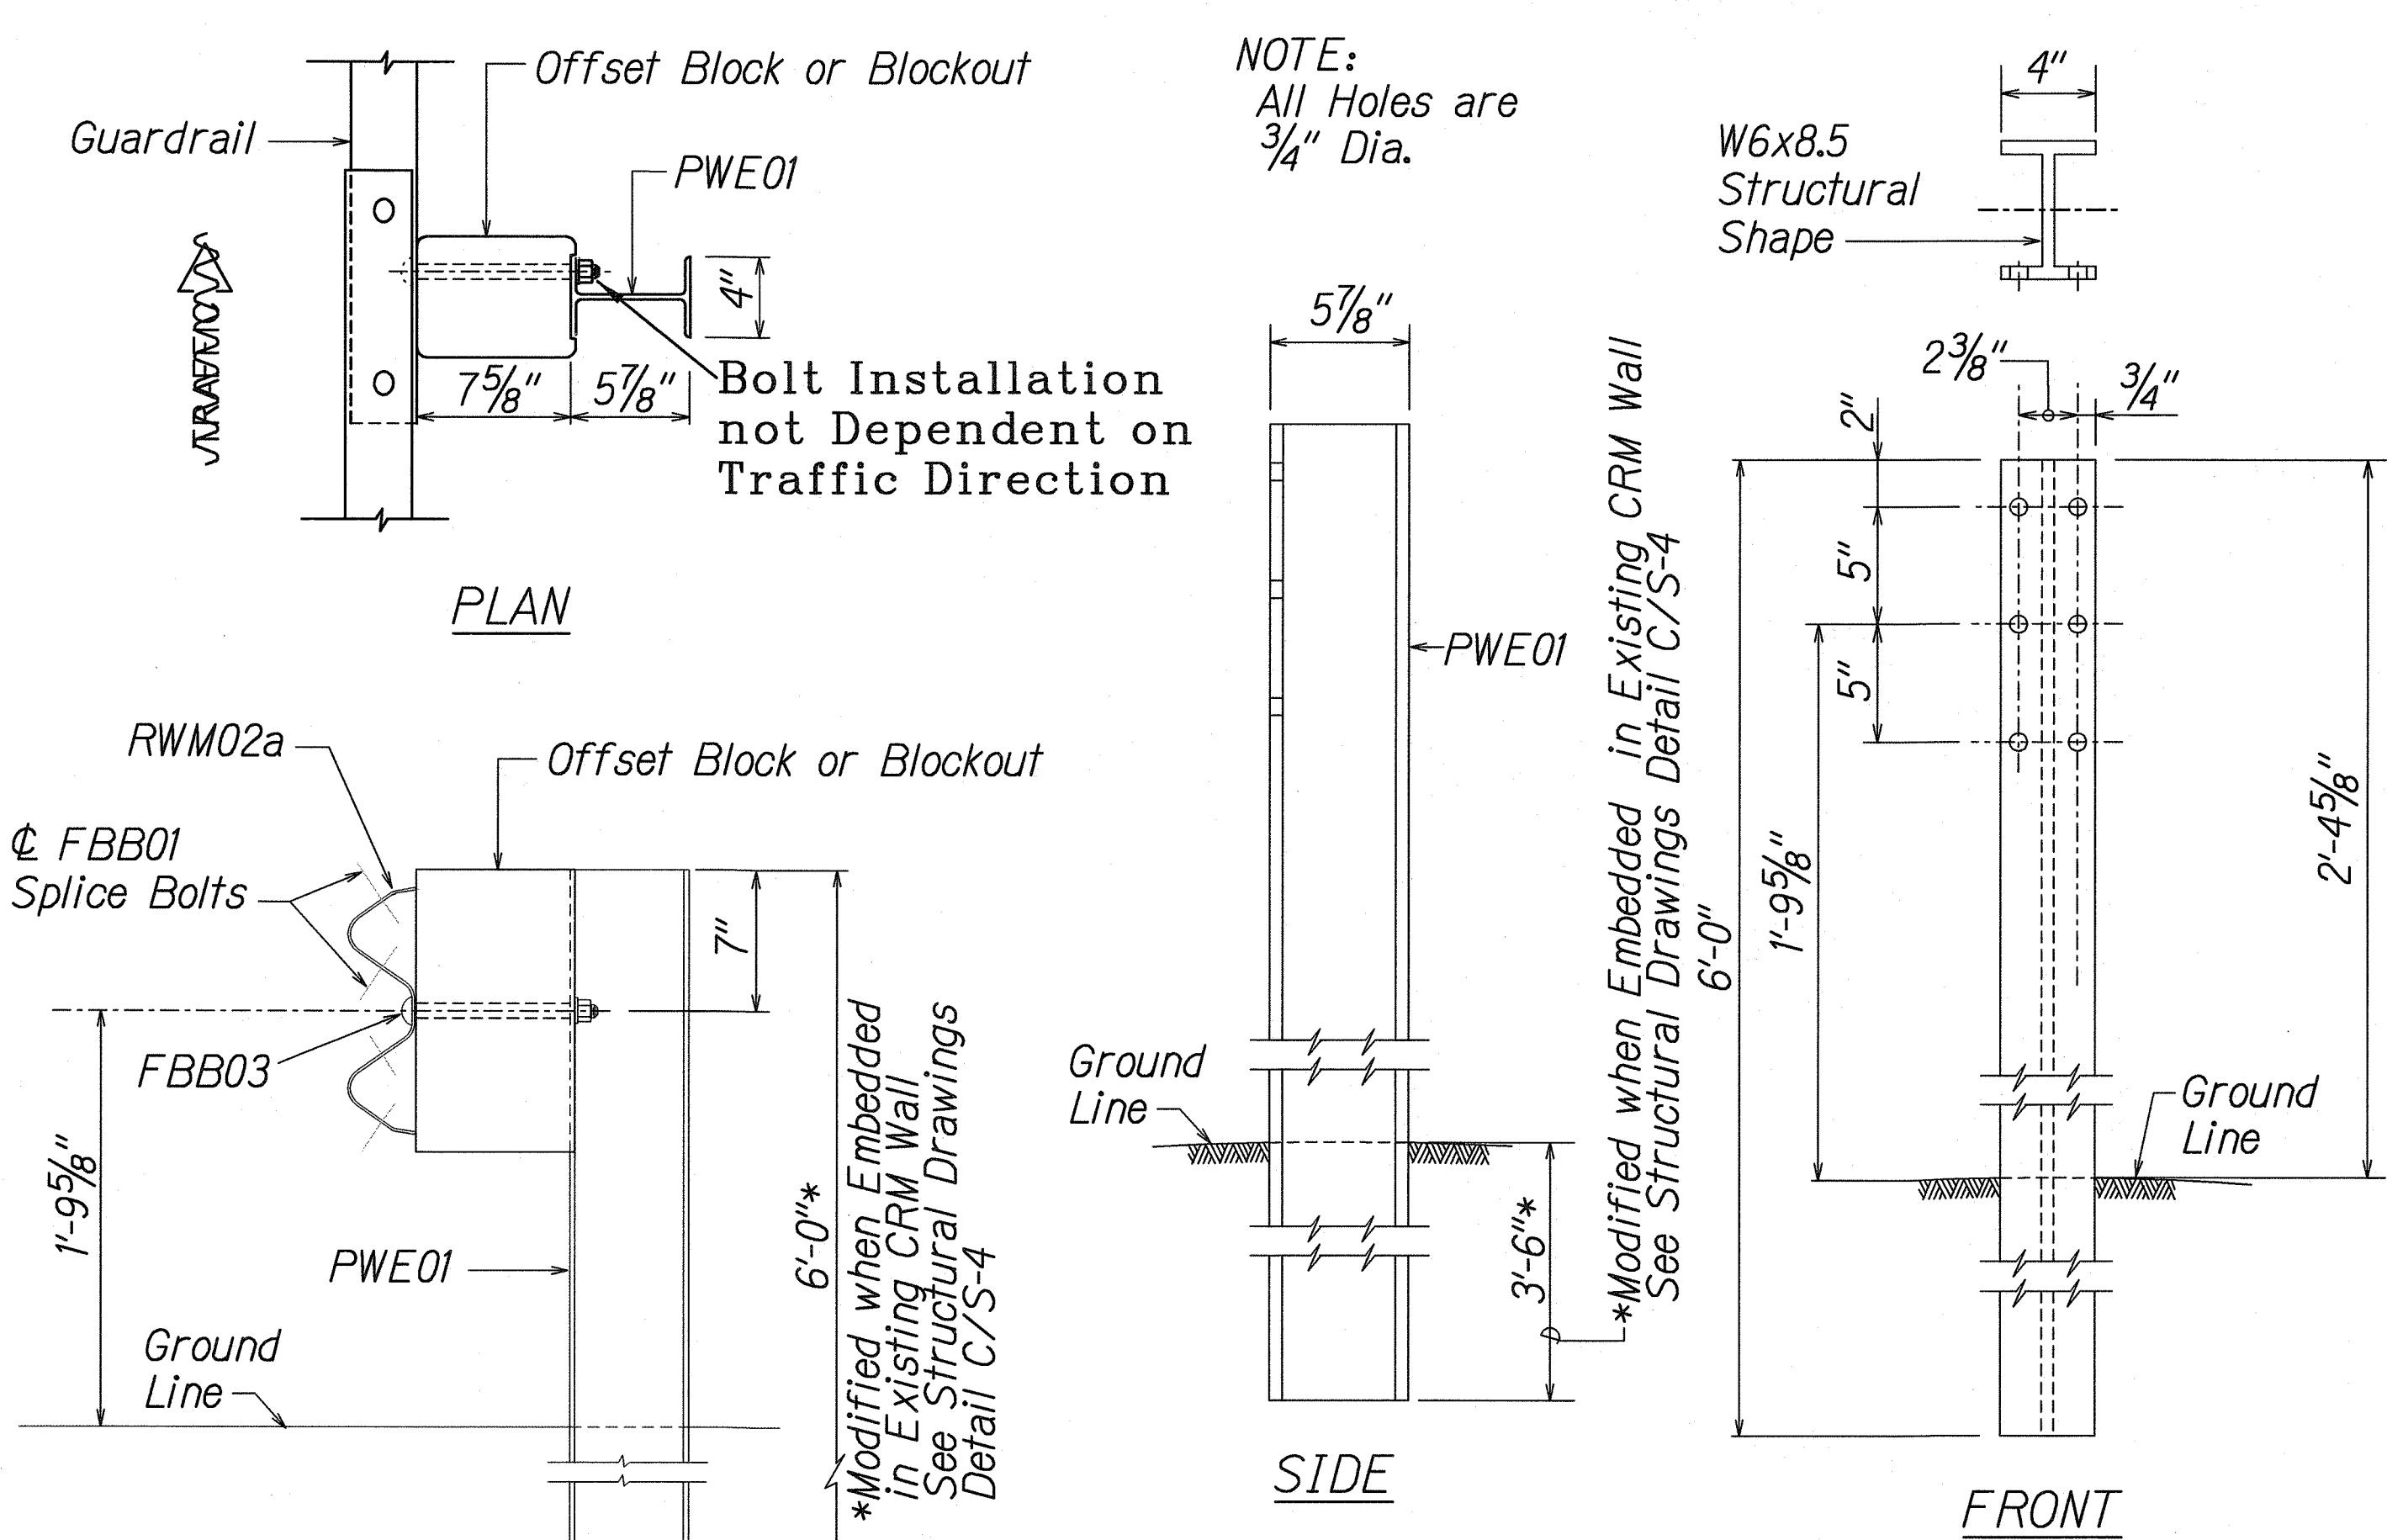

2 SPACE W-BEAM GUARDRAIL (RWM02a)

LEGEND FOR AS-BUILT POSTINGS	
	Squiggly line for as-built deletion
	Double line for as-built deletion
	Text for as-built posting

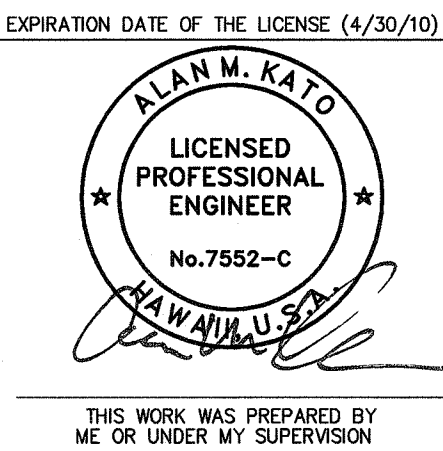

STATE OF HAWAII
DEPARTMENT OF TRANSPORTATION
HIGHWAYS DIVISION

STRONG POST W-BEAM GUARDRAIL

KUAMOO ROAD RETAINING WALL
IN THE VICINITY OF M.P. 11
PROJECT NO. 580A-01-02

SCALE: NOT TO SCALE DATE: SEPT 2005

SHEET No. 1 OF 1 SHEETS