


FED. ROAD DIST. NO.	STATE	FED. AID PROJ. NO.	FISCAL YEAR	SHEET NO.	TOTAL SHEETS
HAWAII	HAW.	580A-01-02	2005	C.022	25

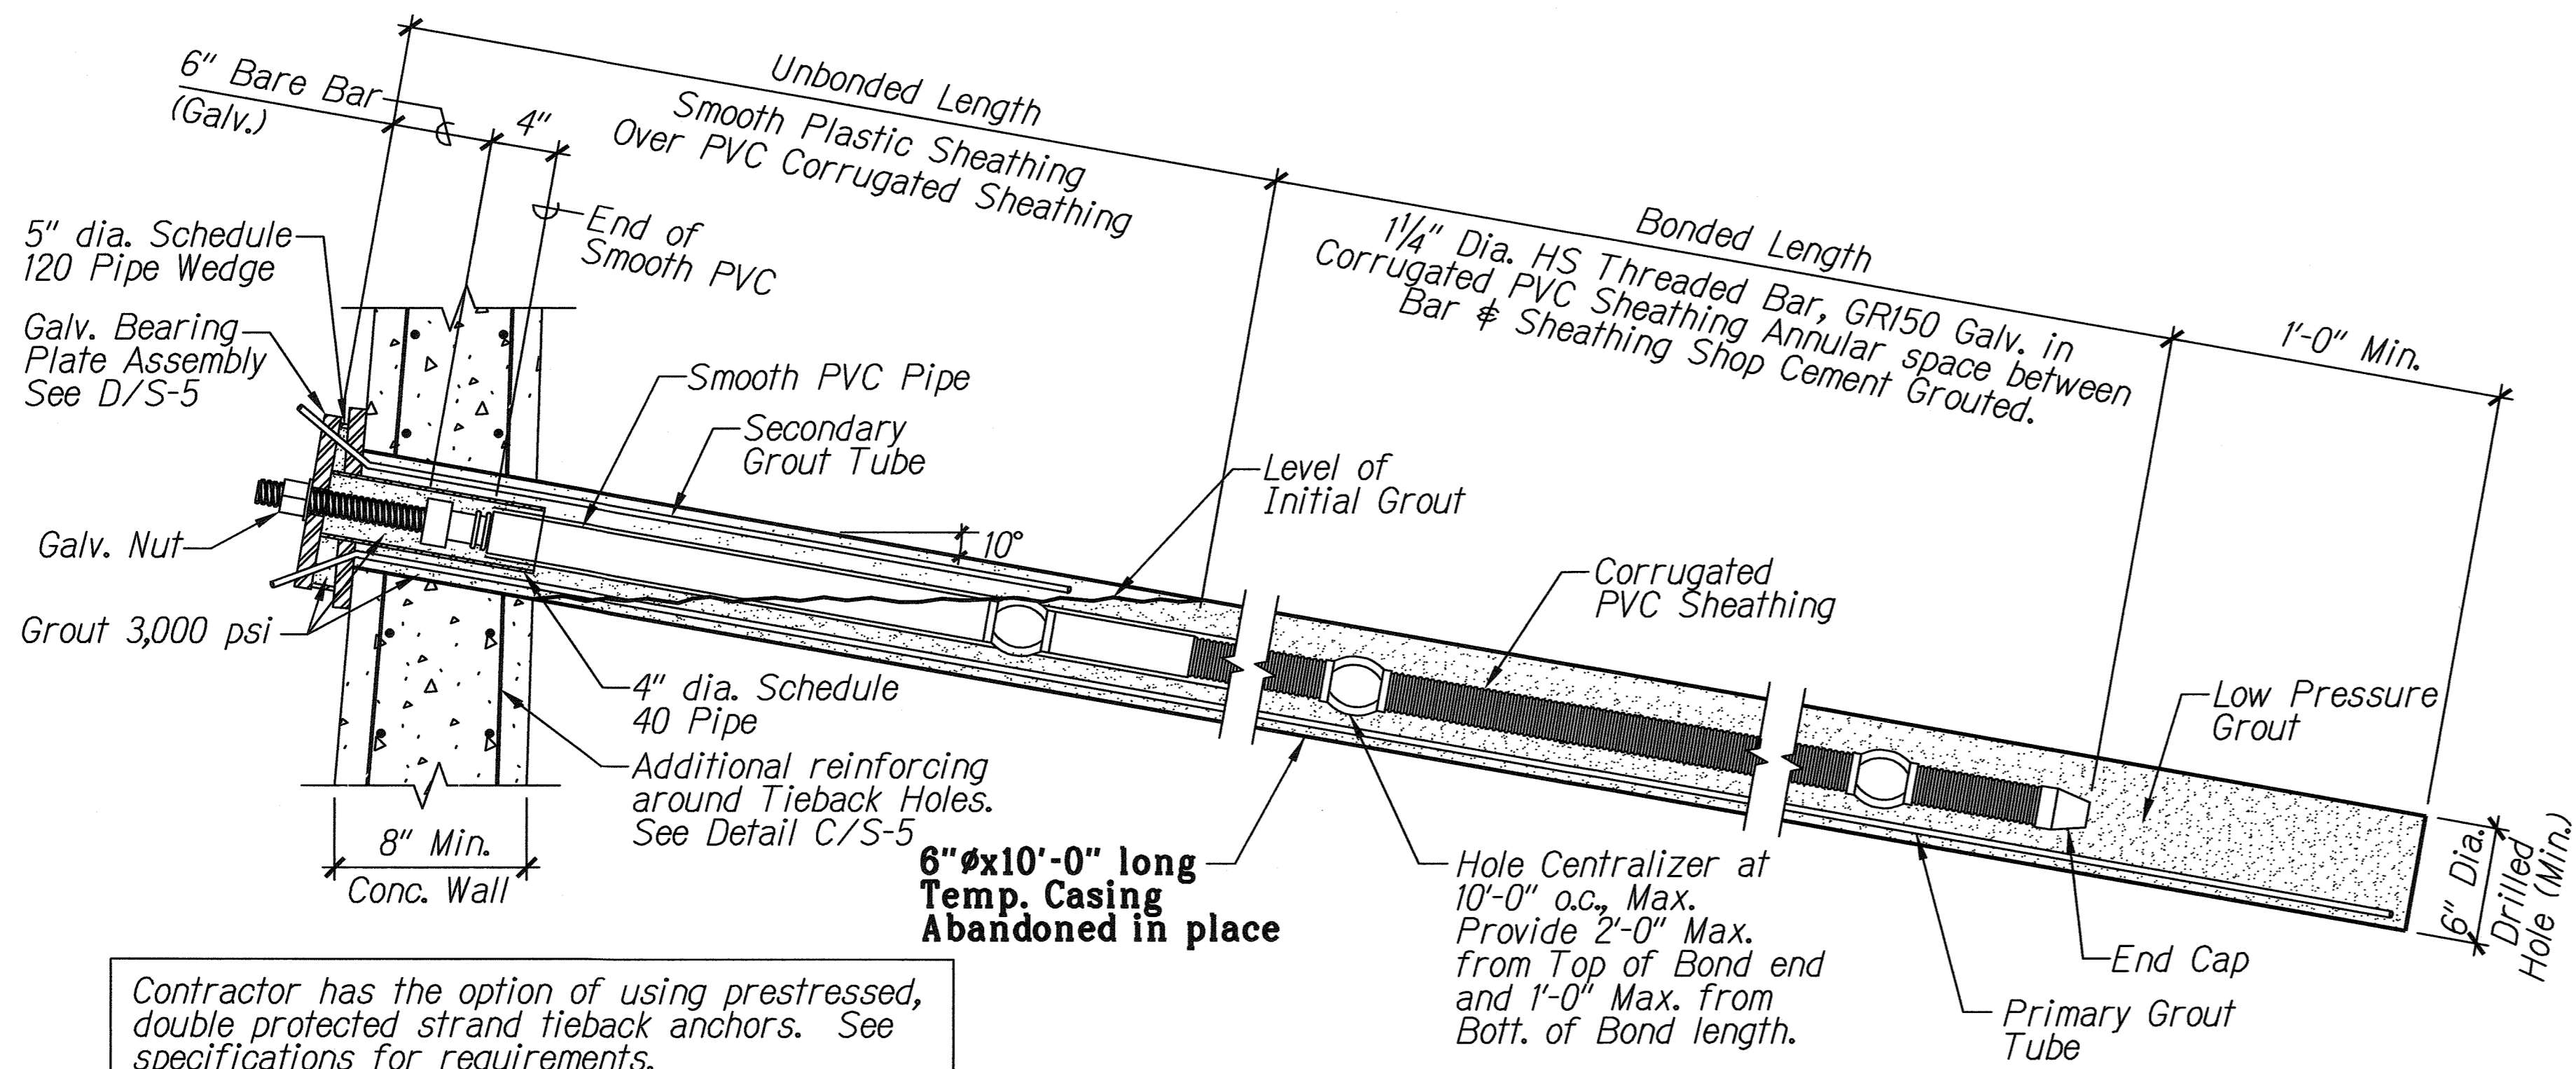


A TIEBACK ANCHOR DETAIL

S-4 S-5 Not To Scale


TIEBACK ANCHOR NOTES

- High strength threaded bar shall be 1-1/4" dia. per ASTM A722, Type II, Grade 150 (Bar Yield Point=150 kips and ultimate load=187.5 kips) and galvanized per ASTM A153. Yield strength shall not be reduced by more than 5% after galvanizing. In addition, anchor assembly, including angle compensating nuts or bevel washers shall be galvanized per ASTM A153.
- Design Criteria / Definitions
 - Static Load = Earth Pressure + Live Load Surcharge
 - Working Load = 1.0 Static Load Plus Vehicle Impact Load
 - Design Load = Factor of Safety (1.33) Times Working Load
 - Max. Test Load = 1.5 Time Design Load
 - Lock-Off Load = Factor of Safety (1.33) Times Static Load Plus Prestress Losses.or
Lock-Off Load = Impact Load Plus Static Load Plus Prestress Losses.
Whichever is greater
- Grout tubes shall be placed through the bearing steel plate. Size and locations shall ensure full grouting of hole. The Contractor shall submit grouting details for approval by the engineer.
- For High Strength Threaded Bar:
 - Do not weld bar.
 - Do not use bar as ground connection for welding.
 - Do not allow hot slag or sparks to touch bar.
 - Do not damage bar surface.
 - Do not use bars with kinks or sharp bends.
- See Tieback Stressing Schedule on Sheet S-3A for tieback stressing information.

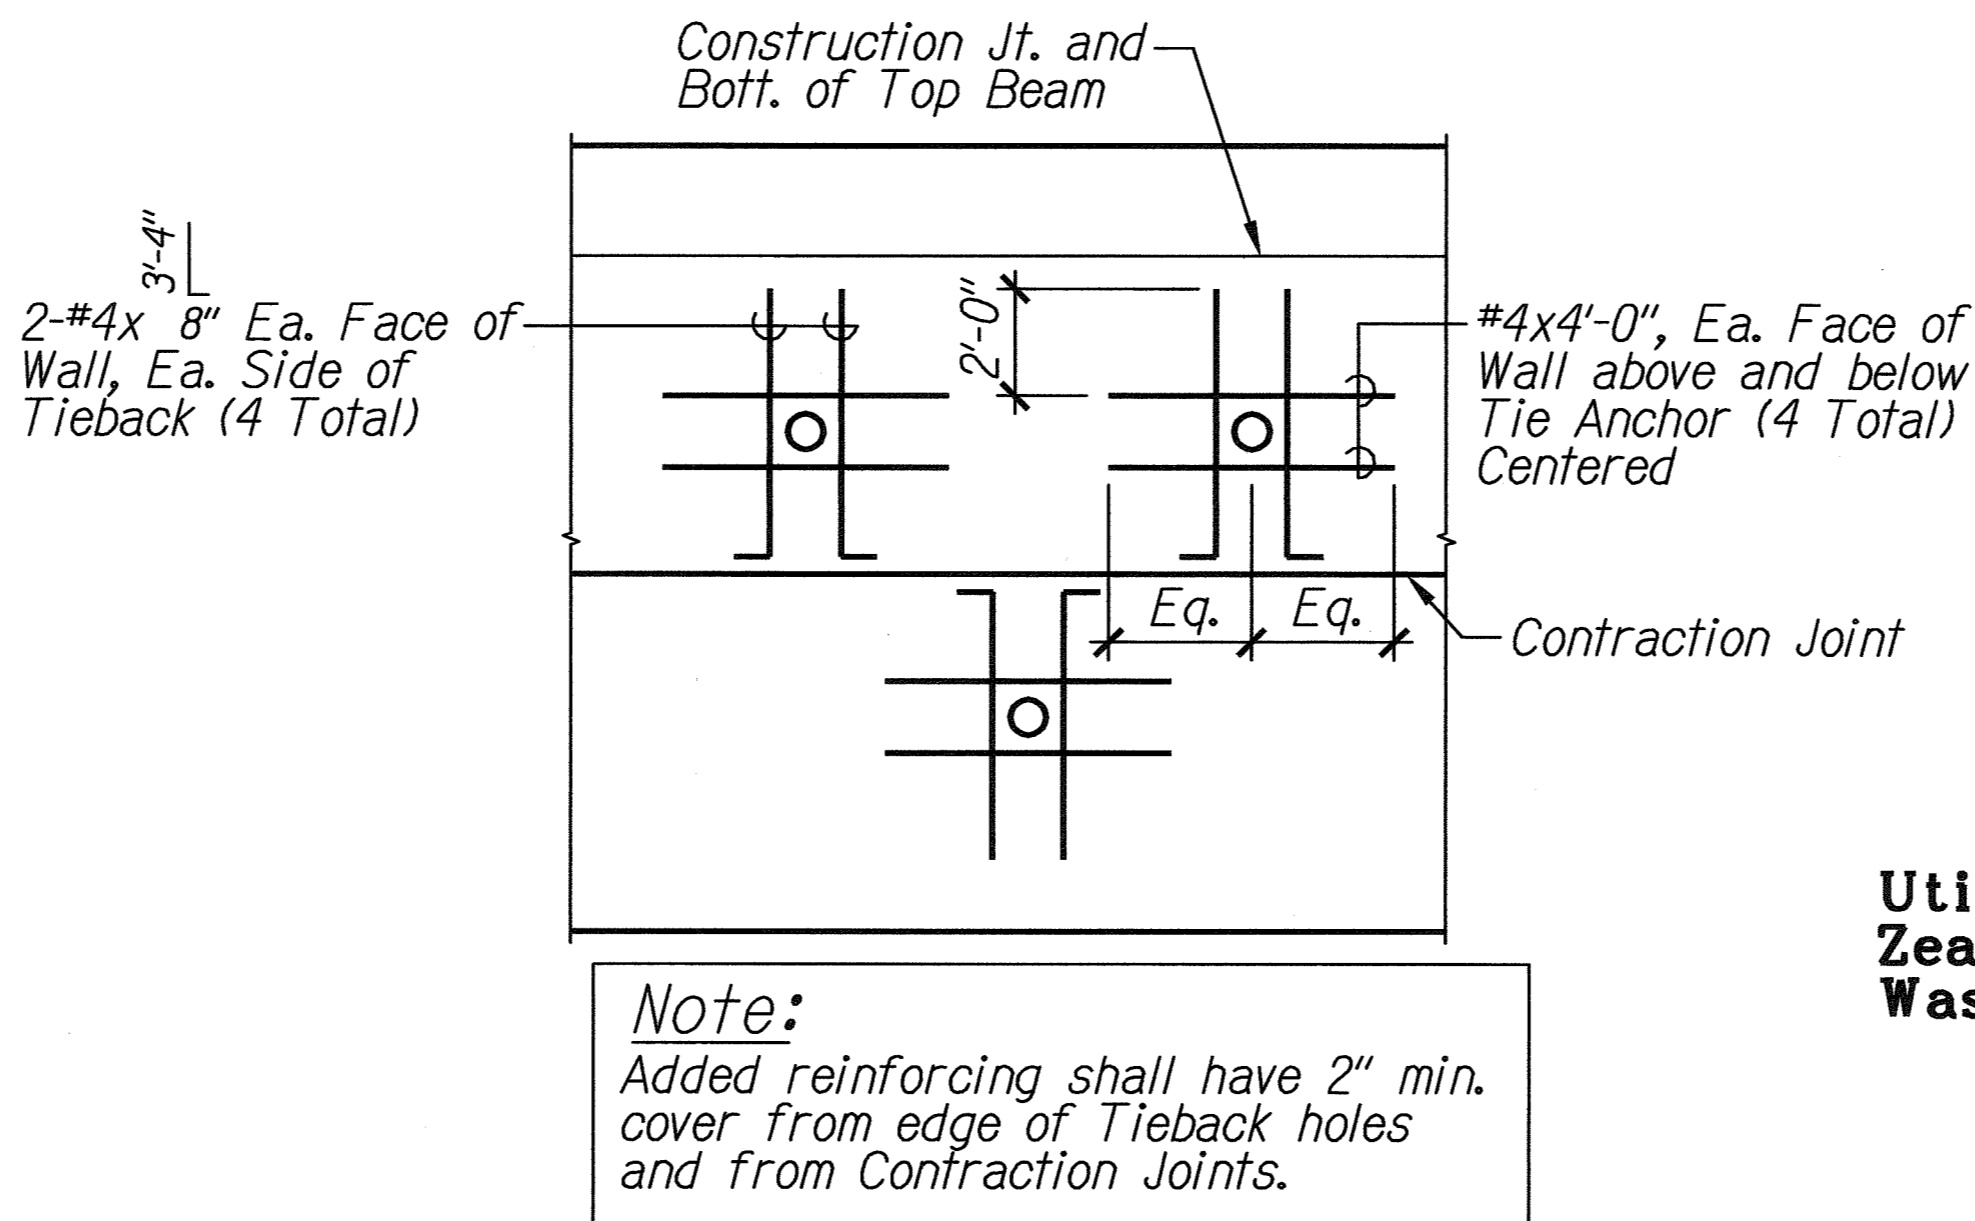

C ADDED WALL REINF. AT TIEBACKS

S-5 S-5 Not To Scale

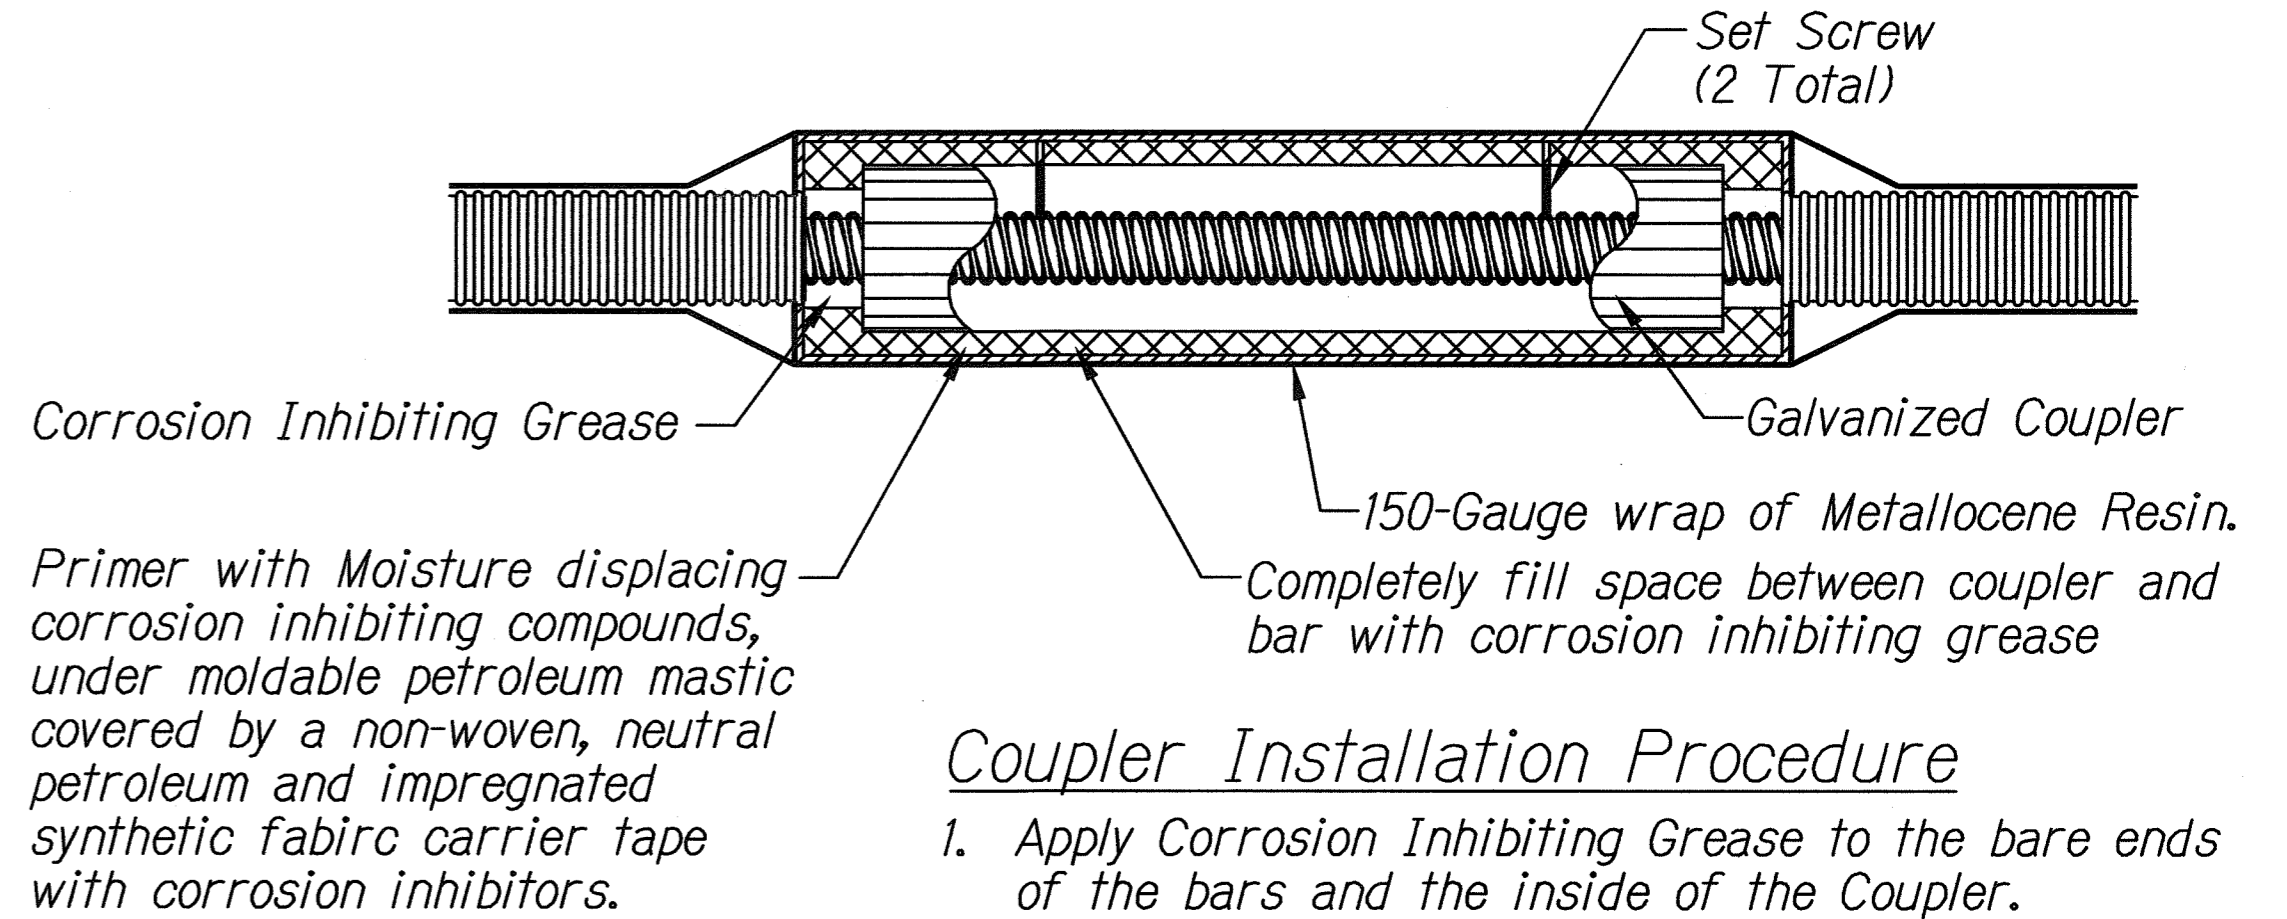


Coupler Installation Procedure

- Apply Corrosion Inhibiting Grease to the bare ends of the bars and the inside of the Coupler.
- Connect the two bar ends with the Coupler (Half the end of the Coupler).
- Torque two ends together with 200 ft.-lbs. minimum then tighten set screws.
- Coat Coupler with Corrosion Inhibiting Primer and cover with moldable mastic, rounding and reducing sharp edges.
- Spirally wrap Coupler assembly with synthetic fabric carrier tape, pressing out air pockets and smoothing all lap seams, wrap with 1" min. over lap.
- Cover Coupler assembly with wrap.
- Coupler used shall be capable of developing the full ultimate tensile strength capacity of the threadbar.

B DOUBLE CORROSION PROTECTED COUPLER FOR BOND LENGTH


S-5 S-5 Not To Scale

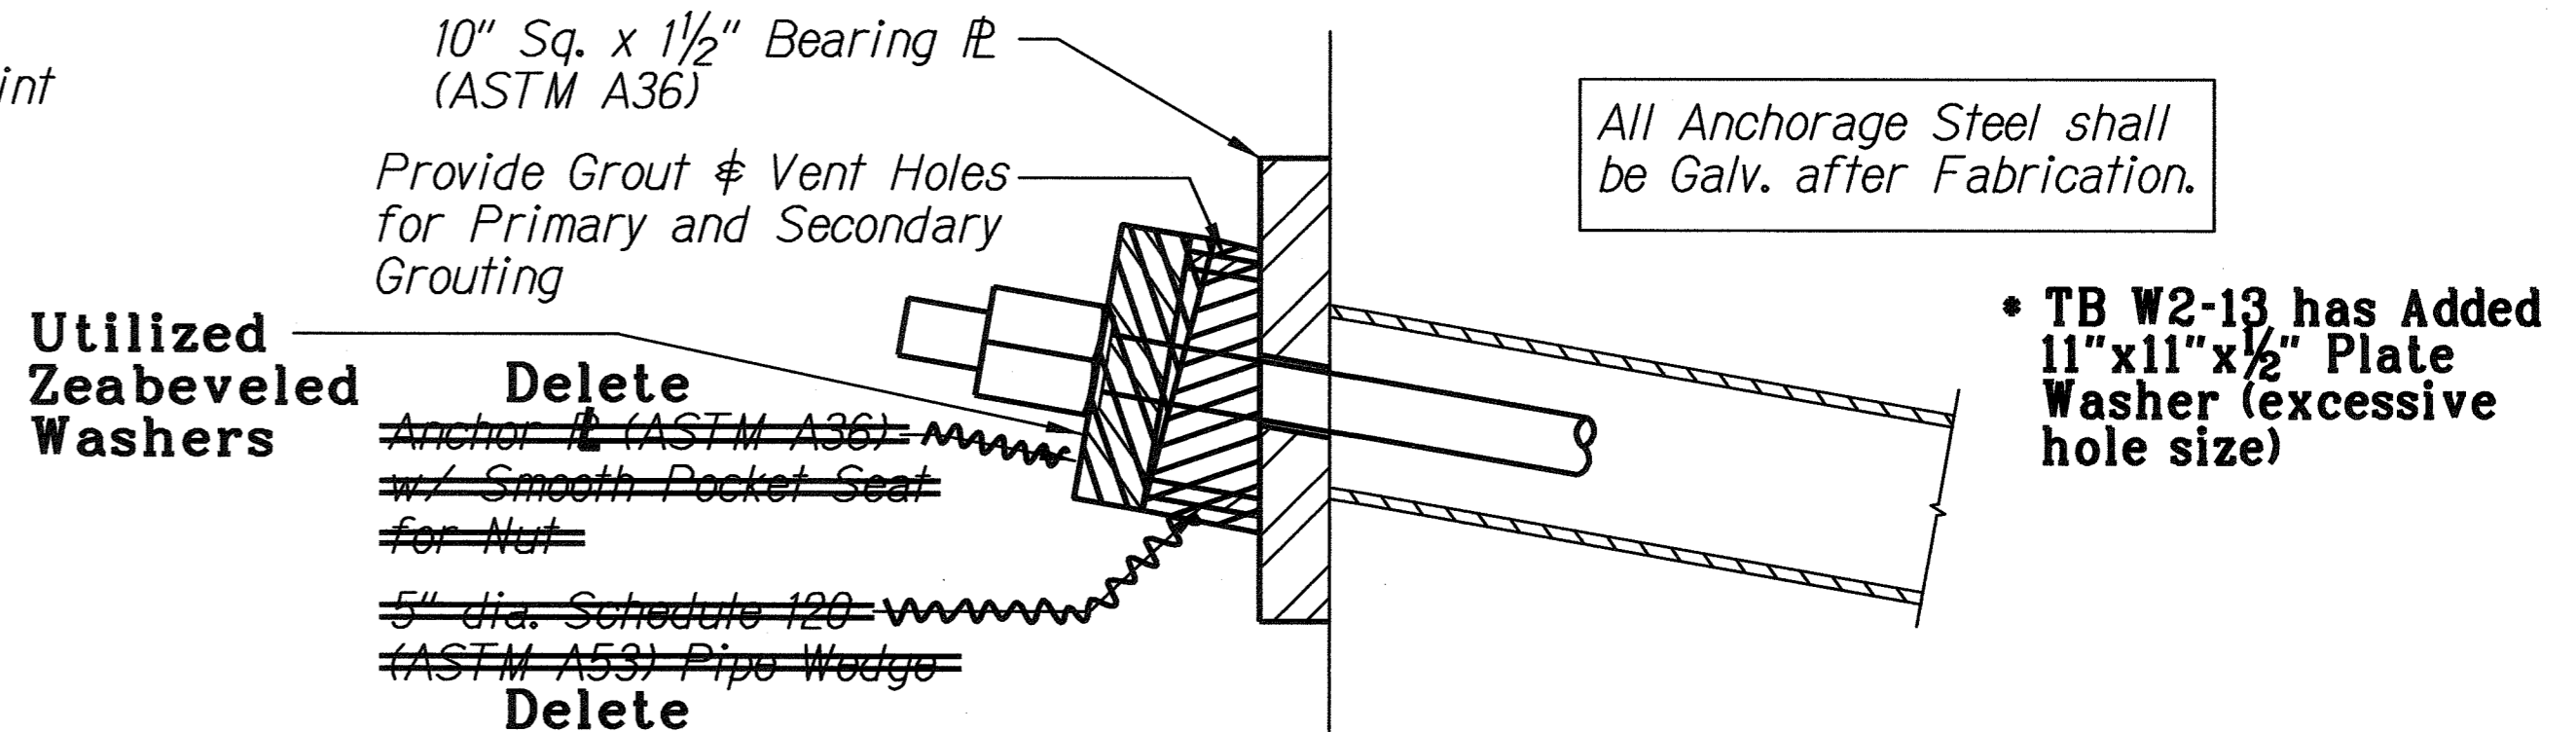

D BAR TIEBACK ANCHORAGE DETAIL

S-5 S-5 Not To Scale

LEGEND FOR AS-BUILT POSTINGS	
~~~~~	Squiggly line for as-built deletion
=====	Double line for as-built deletion
Roadway	Text for as-built posting

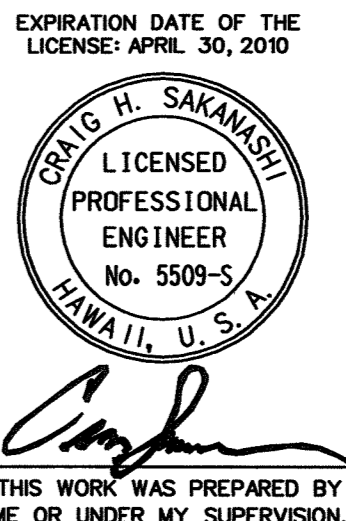

3/21/07	1	DELETED TIEBACK TABLE, ADDED NOTE 5
DATE		REVISION
STATE OF HAWAII DEPARTMENT OF TRANSPORTATION HIGHWAYS DIVISION		
<b>TIEBACK ANCHOR DETAIL</b>		
<b>KUAMOO ROAD RETAINING WALL IN THE VICINITY OF M.P. 1J PROJECT NO. 580A-01-02</b>		
Scale: As Noted	Date: September 2005	
SHEET No. S-5 OF 8 SHEETS		

"AS-BUILT"

C.022