

FED. ROAD DIST. NO.	STATE	FED. AID PROJ. NO.	FISCAL YEAR	SHEET NO.	TOTAL SHEETS
HAWAII	HAW.	580A-01-02	2005	C.O.20	25

LEGEND:


- Indicates Tieback Anchor Location
- ⊙ Indicates Tieback Anchor Requiring Performance and Creep Load Test.
- ↑ Approx. Location of Exploratory Probing to determine existing CRM footing elevation.
- ▨ Top Layer Shotcrete
- ▩ Bottom Layer Shotcrete

NOTES:


- For Location of Tiebacks in the Top Row, See Sht. S-2.
- For Contraction Joint Details, See Det. C/S-3.
- Where Exist'g CRM Wall has straight single batter, use Detail E/S-3A for the Shotcrete Batter. Where the CRM Wall is bent outward, use Detail D/S-3A.

NOTE:


Vertical Contraction Jt. shall not be spaced more than 30 feet apart.

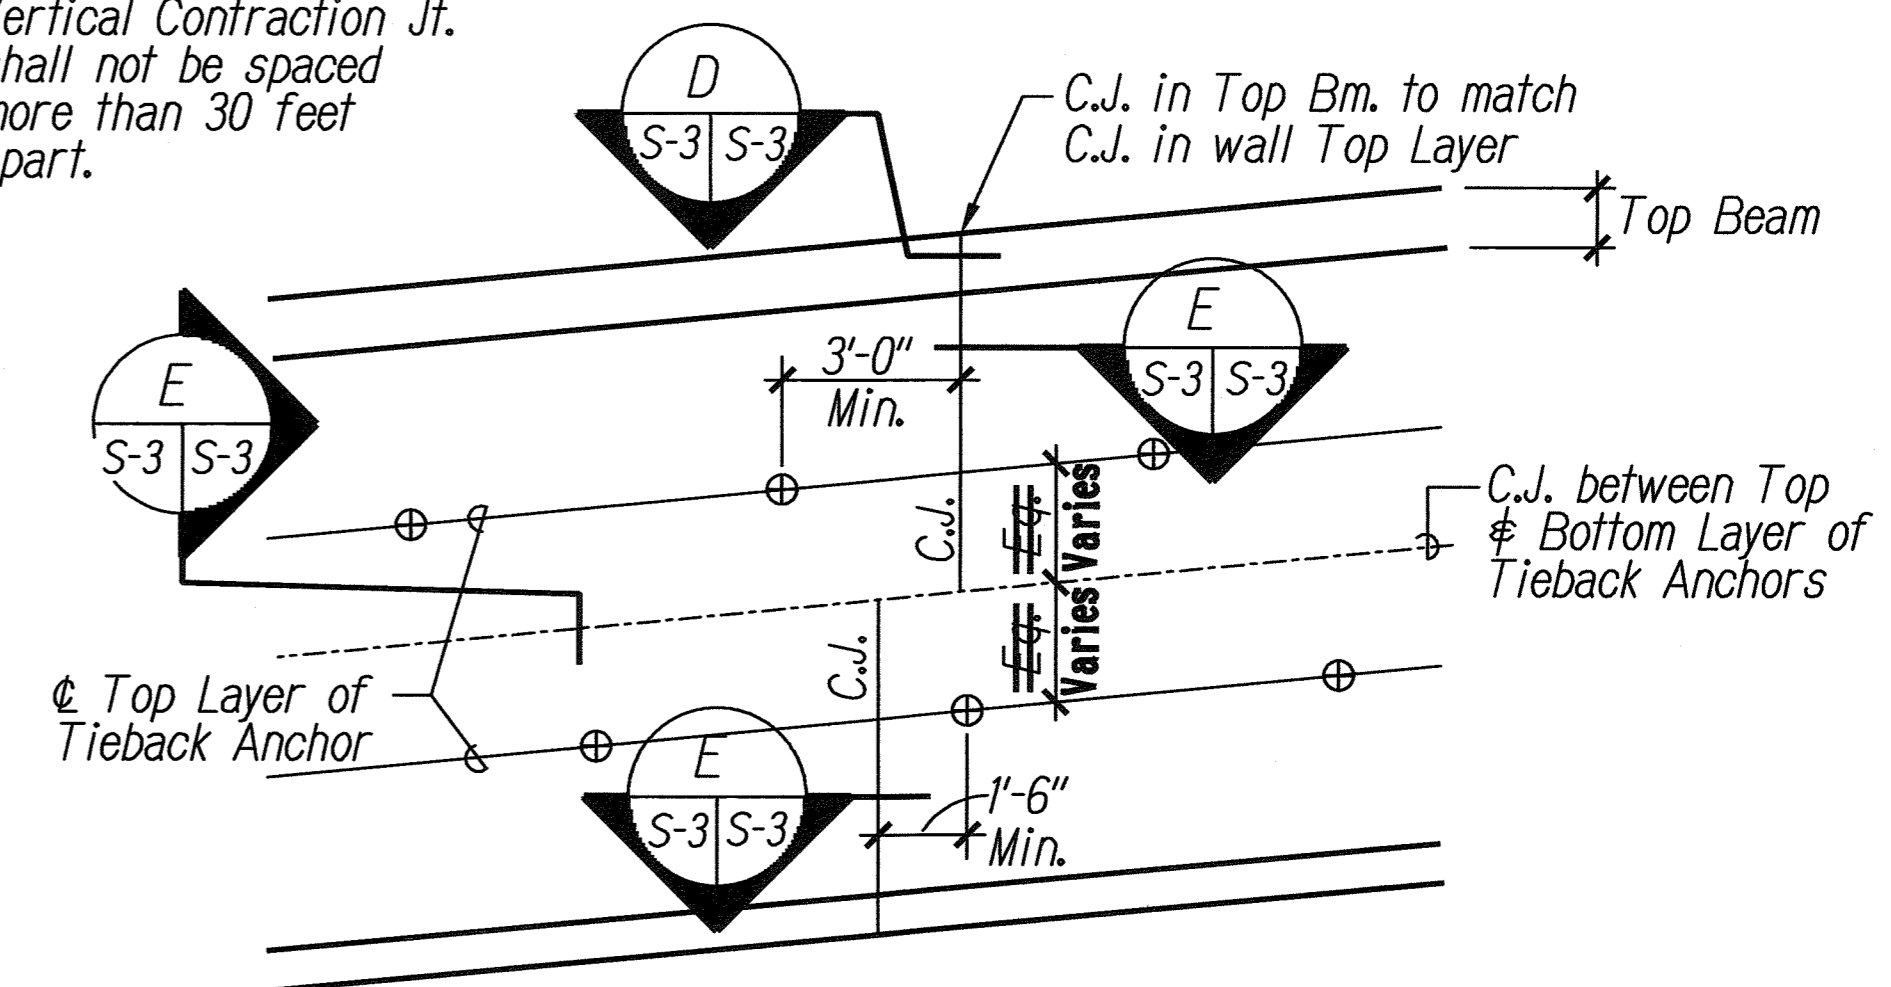


C CONTRACTION JT. LOCATION
S-3 | S-3 Not to Scale

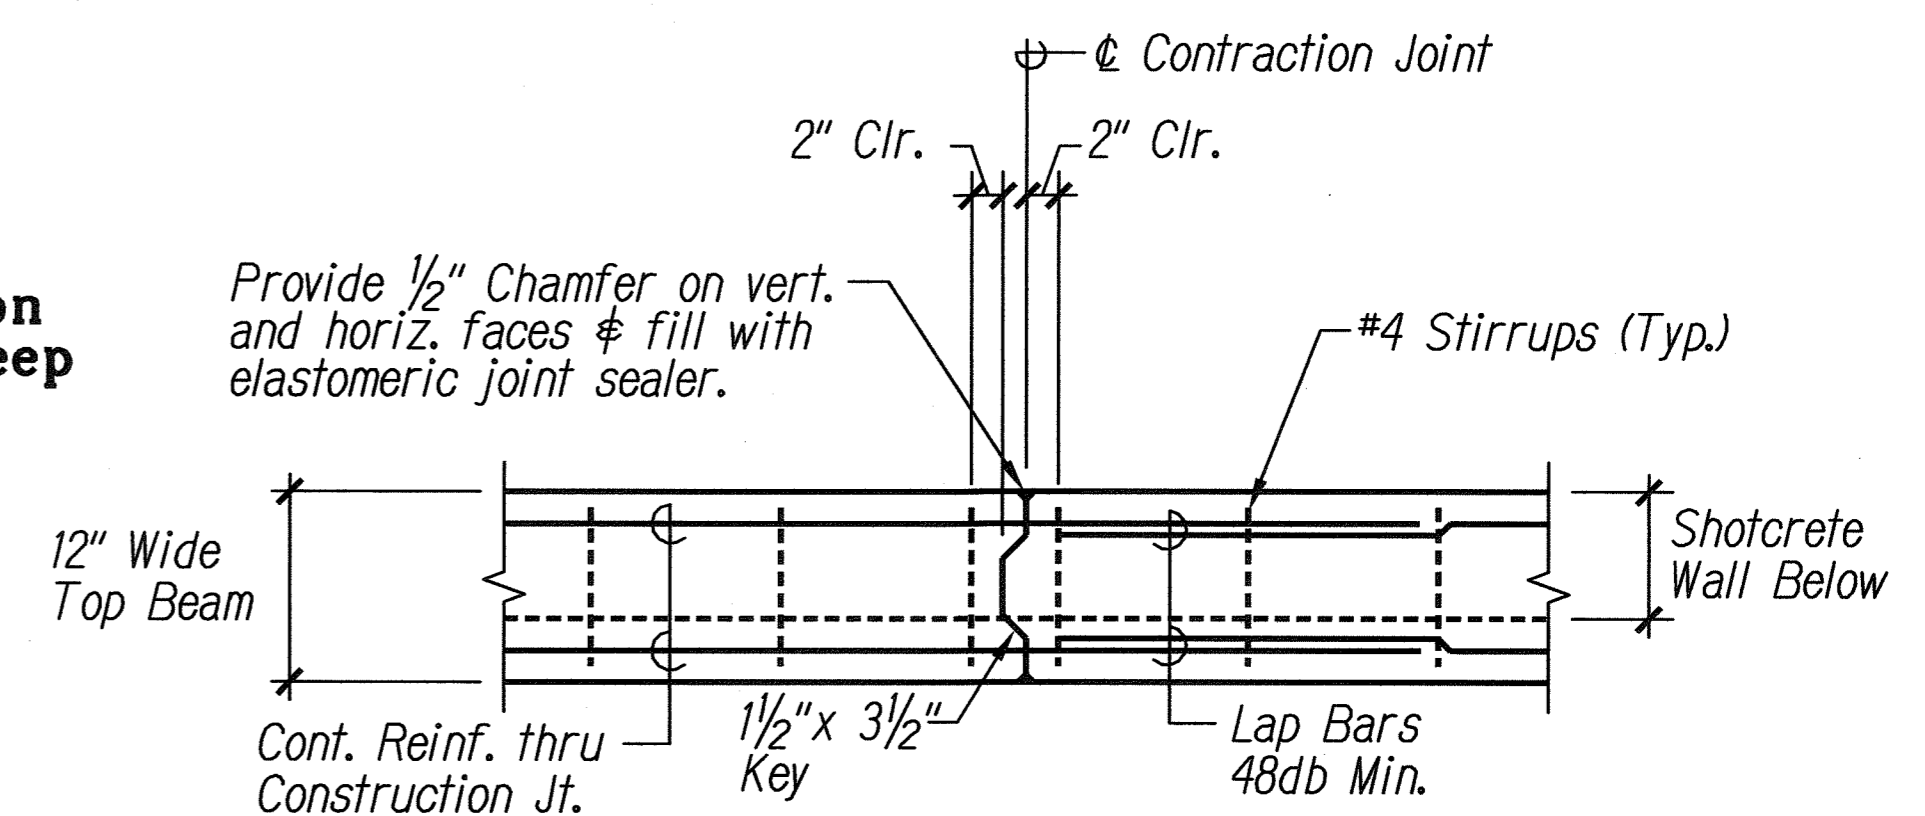

D CONTRACTION JT. THRU TOP BM.
S-3 | S-3 Not to Scale

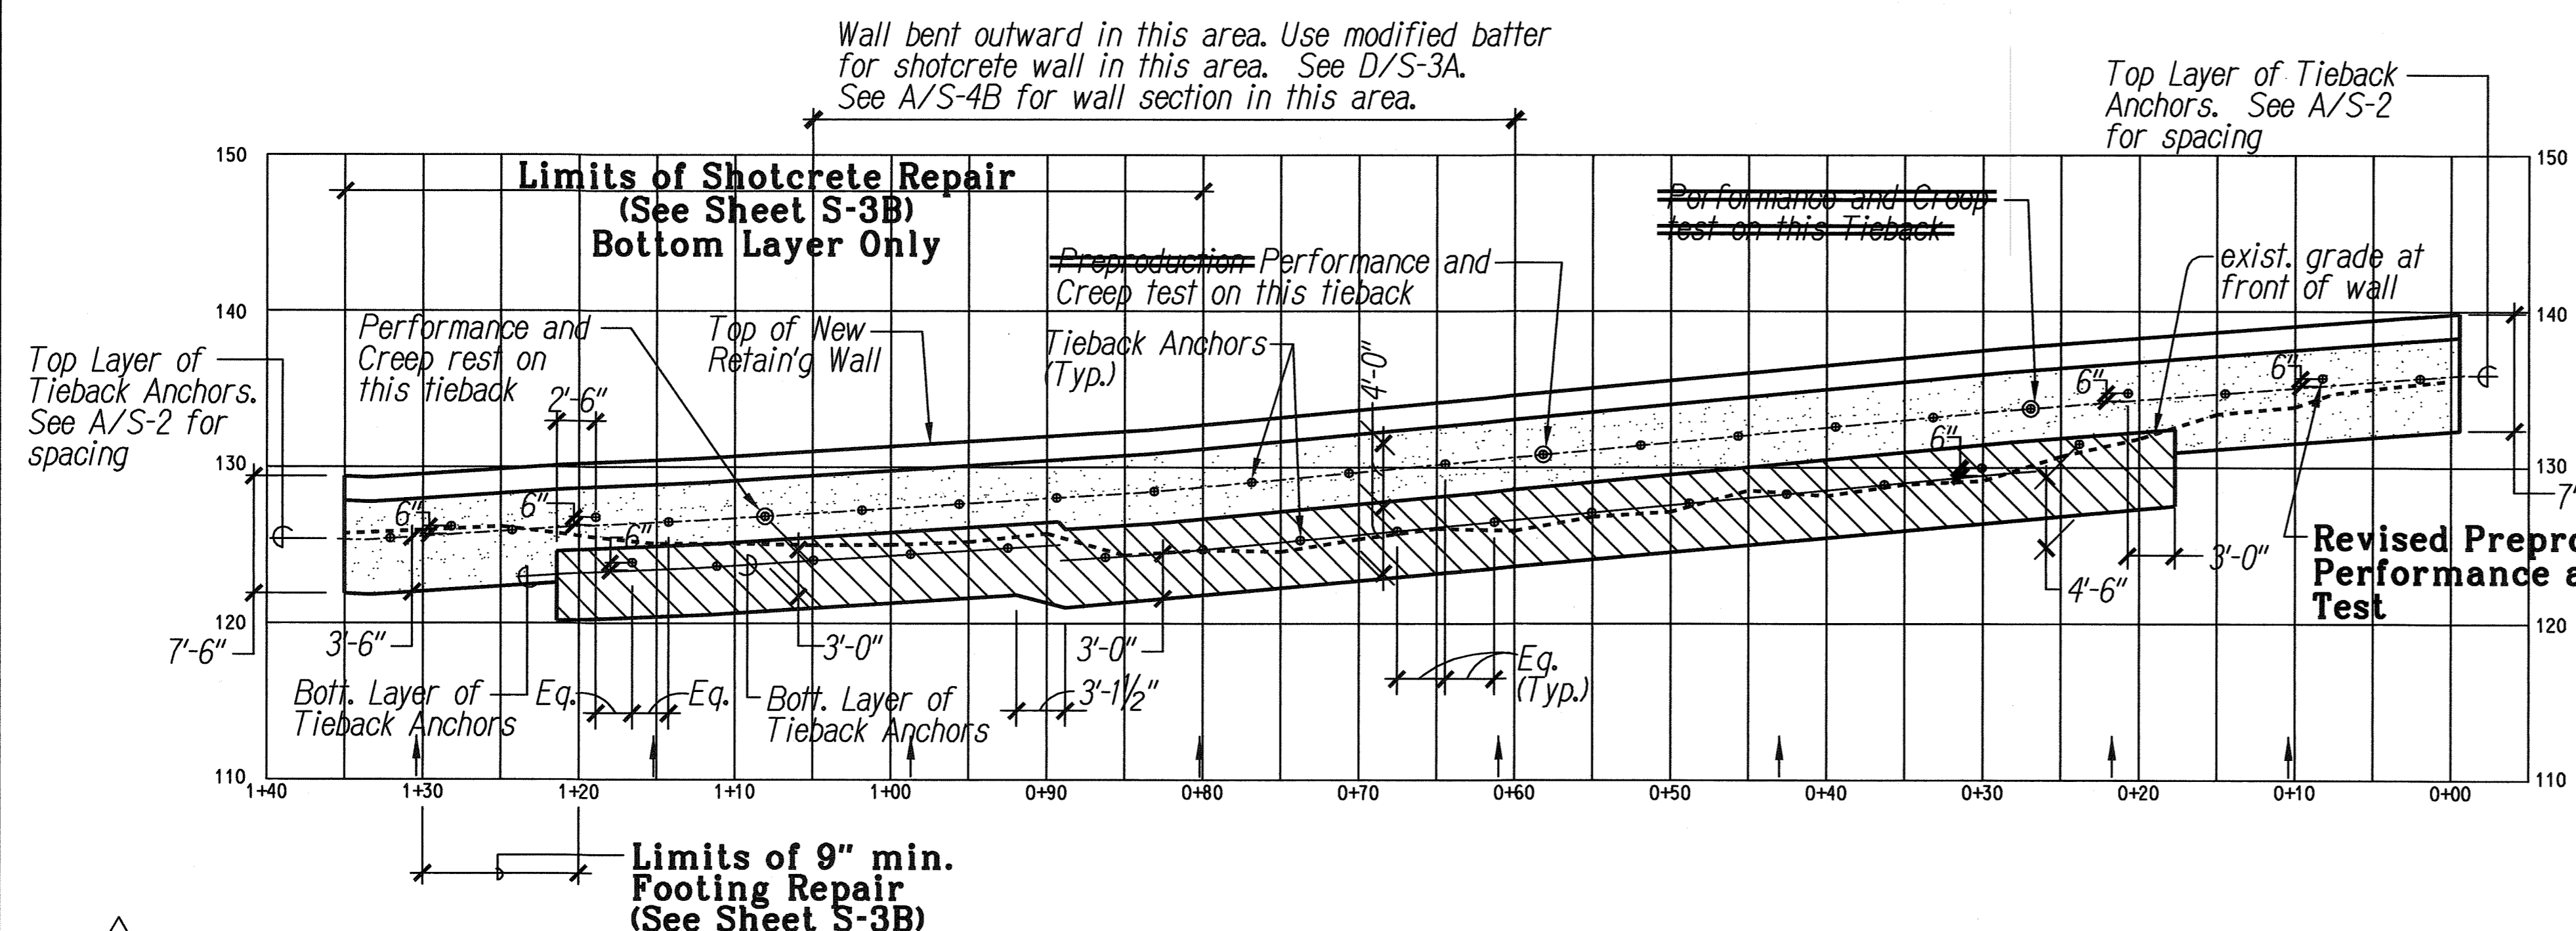


A WALL 1 ELEVATION
S-3 | S-3 Scale: 1/8" = 1'-0"

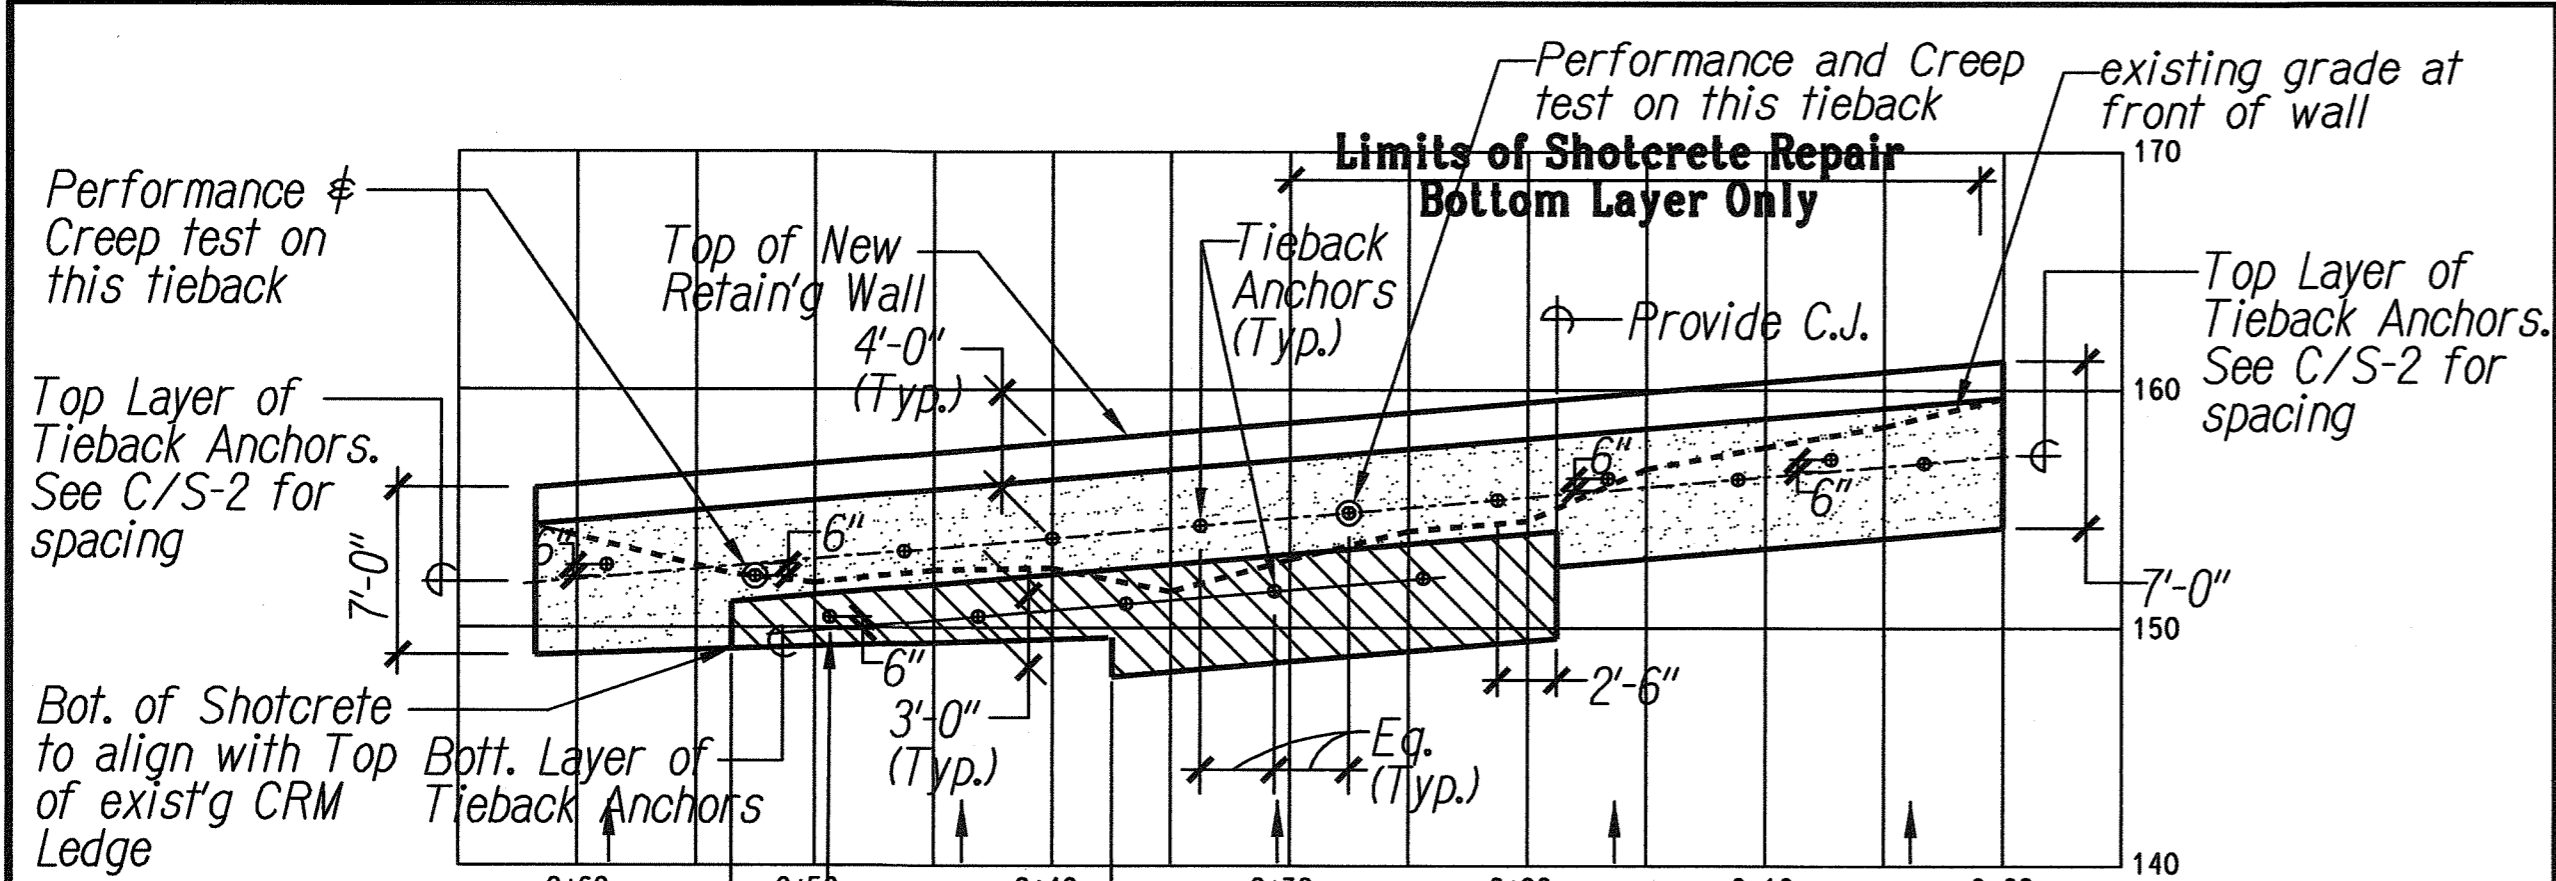

B WALL 2 ELEVATION
S-3 | S-3 Scale: 1/8" = 1'-0"

NOTE:

- Vertical Contraction Joints in Shotcrete shall not be spaced more than 30'-0" o.c.
- Vertical Joints shall not be located less than 1'-6" from Bottom Row Tiebacks or 3'-0" from Top Row Tiebacks.
- Contractor may submit alternative joint detail for approval.

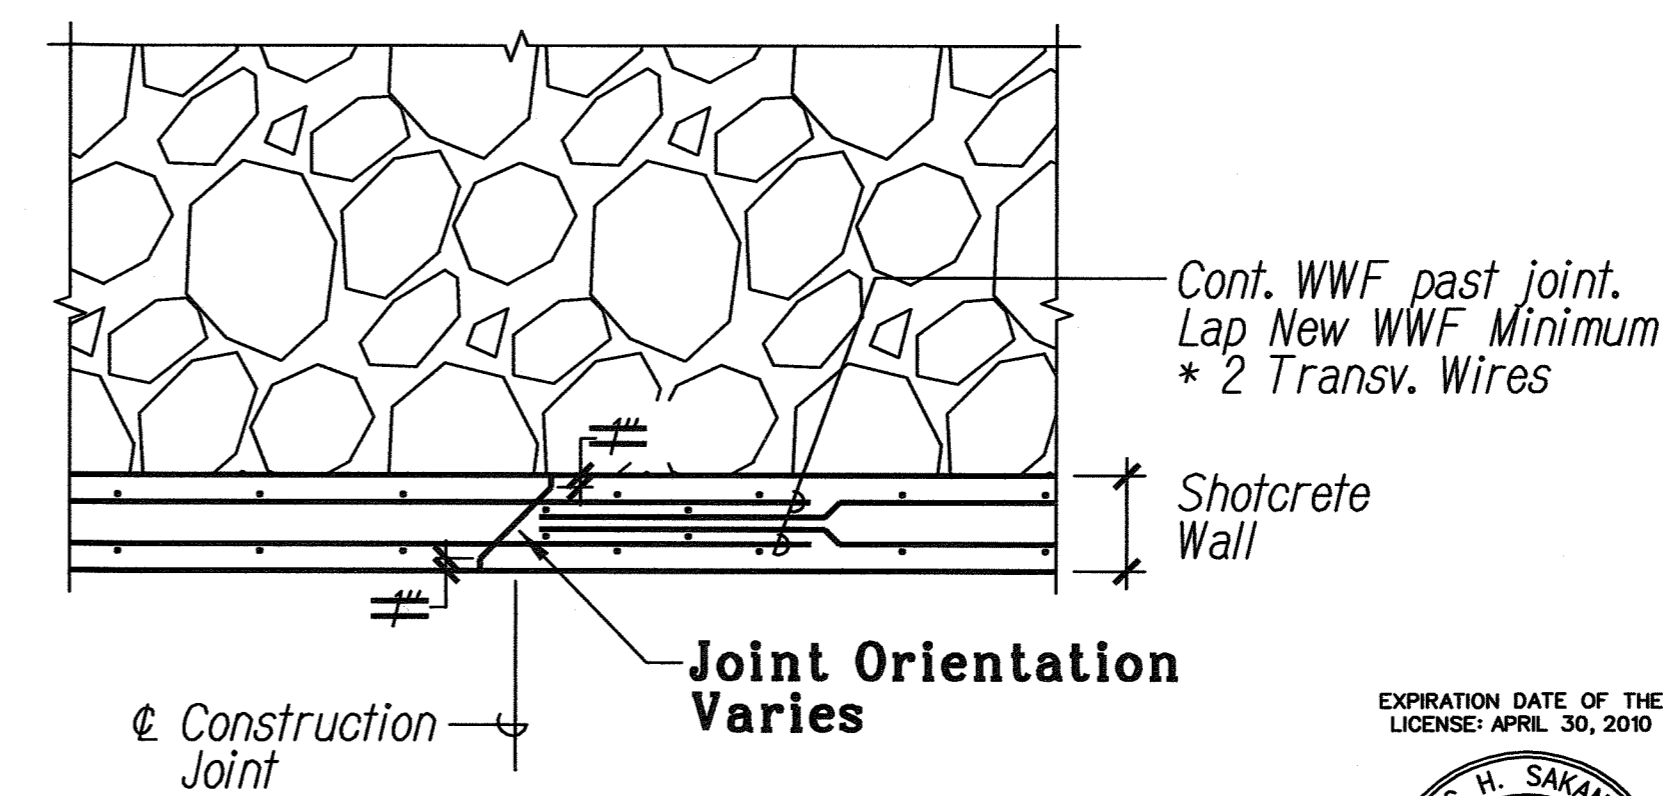


* Transverse Wire is defined as the wire running parallel to the joint.

E TYP. SHOTCRETE JT. DETAIL
S-3 | S-3 Not to Scale

LEGEND FOR AS-BUILT POSTINGS

AAA	Squiggly line for as-built deletion
AAA	Double line for as-built deletion
Roadway	Text for as-built posting

DATE	REVISION
3/21/07	2 Revised Detail B/S-3
	1 Revised Detail A/S-3, Legend & Notes

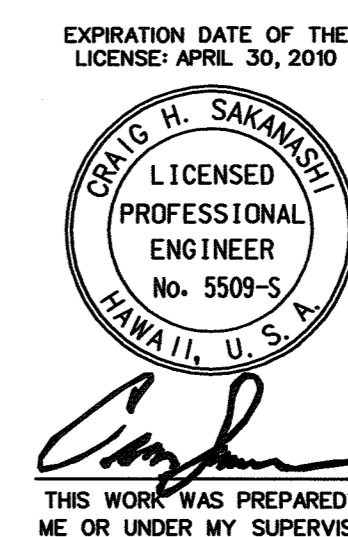

STATE OF HAWAII
DEPARTMENT OF TRANSPORTATION
HIGHWAYS DIVISION
TIEBACK WALL ELEVATIONS AND BOTTOM LAYER TIEBACK ANCHOR LOCATIONS
KUAMOO ROAD RETAINING WALL
IN THE VICINITY OF M.P. 1J
PROJECT NO. 580A-01-02

Scale: As Noted Date: September 2005
SHEET No. S-3 OF 8 SHEETS

DESIGNED BY	DATE	SCALE
TRACED BY		
NOTES CHECKED BY		
QUANTITIES BY		
CHECKED BY		
GENERAL PLAN		
NO. C.O.20.01		

"AS-BUILT"

C.O.20

LEGEND:

- Indicates Tieback Anchor Location
- ⊙ Indicates Tieback Anchor Requiring Performance and Creep Load Test.
- ⬡ Indicates construction sequence for Top Row of Tiebacks.
- Indicates construction sequence for Bottom Row of Tiebacks.
- "a" Indicates Tieback Stressing - See Tieback Stressing Schedule


NOTES:

- For Location of Tiebacks in the Top Row, See Sht. S-2.
- Tiebacks with higher construction sequence number shall not be constructed until final grouting up to anchor plate for lower construction sequence number has set and cured 24 hours minimum.
- Construction of Tiebacks for the bottom layer shall not commence until the Tiebacks in the top layer has been fully grouted and stressed.
- Contractor may modify construction sequence upon approval from the engineer.
- For Construction Joint Details, See Det. C/S-3.

Anchor Location	Design Load (KIPS) 0.53 f's Max.	Maximum Test Load (KIPS) 0.75 f's Max.	Transfer (LockOff) Load (KIPS) 0.70 f's Max.	Comment
Typ. Top Row	49.7	74.5	43.6	Typ. Unless Otherwise Noted
Typ. Bottom Row	24.0	36.0	30.0	Typ. Unless Otherwise Noted
"a"	25.5	38.2	25.4	
"b"	32.9	49.3	31.0	
"c"	37.0	55.5	34.1	
"d"	43.3	65.0	38.8	


f's = Ultimate Tensile Strength of the Tendon
Transfer (LockOff) Load shown is after Seating Loss.

See Sheet S-3B For Changes

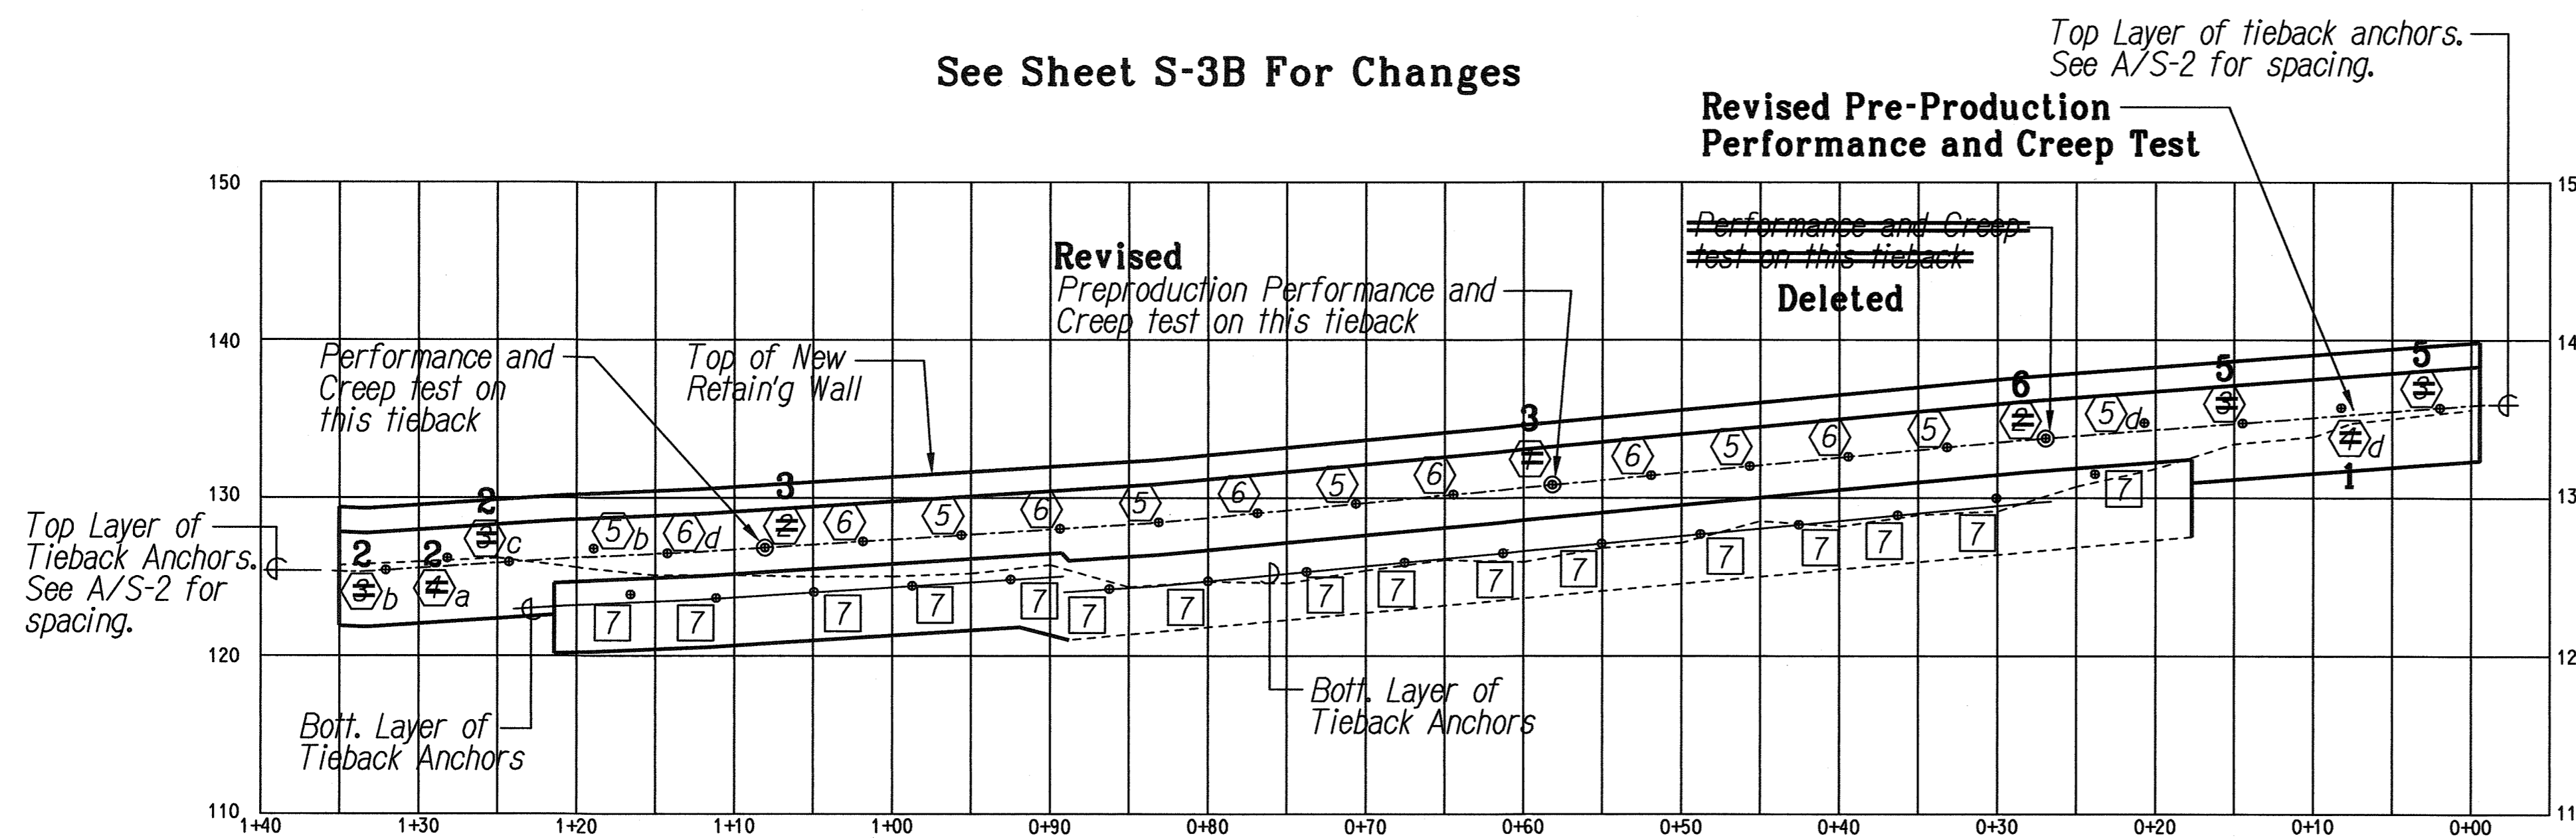


A WALL 1 TIEBACK INSTALLATION SEQUENCE AND STRESSING
S-3A S-3A Scale: 1/8" = 1'-0"

C TIEBACK STRESSING SCHEDULE
S-3A S-3A Not to Scale

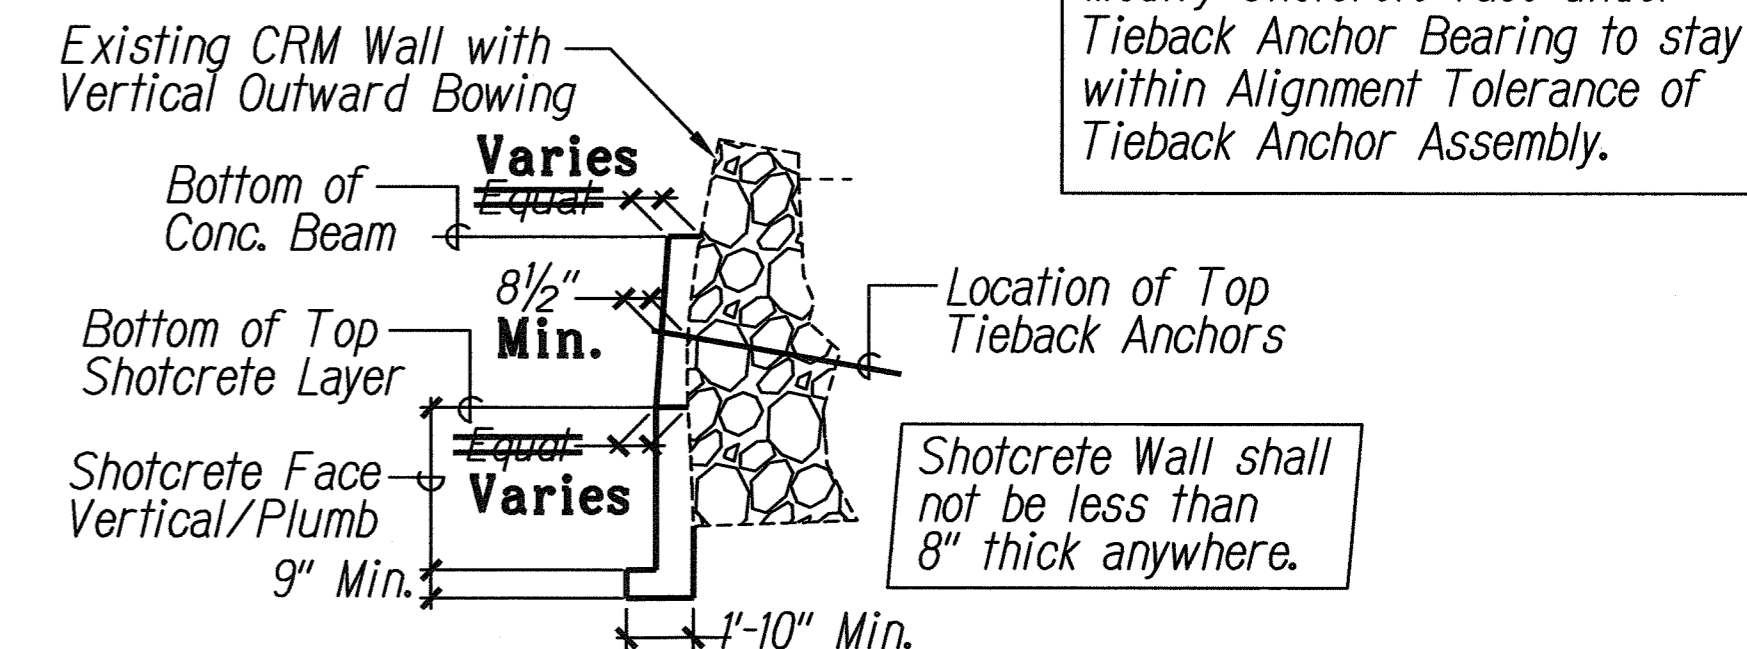


D WALL #1 - MODIFIED SHOTCRETE BATTER WHERE WALL BOWS OUTWARD
S-3 S-3A Not to Scale

DESIGNED BY	DATE
DRAWN BY	
CHECKED BY	
IN CHARGE BY	
PROJECT NO.	
DATE	

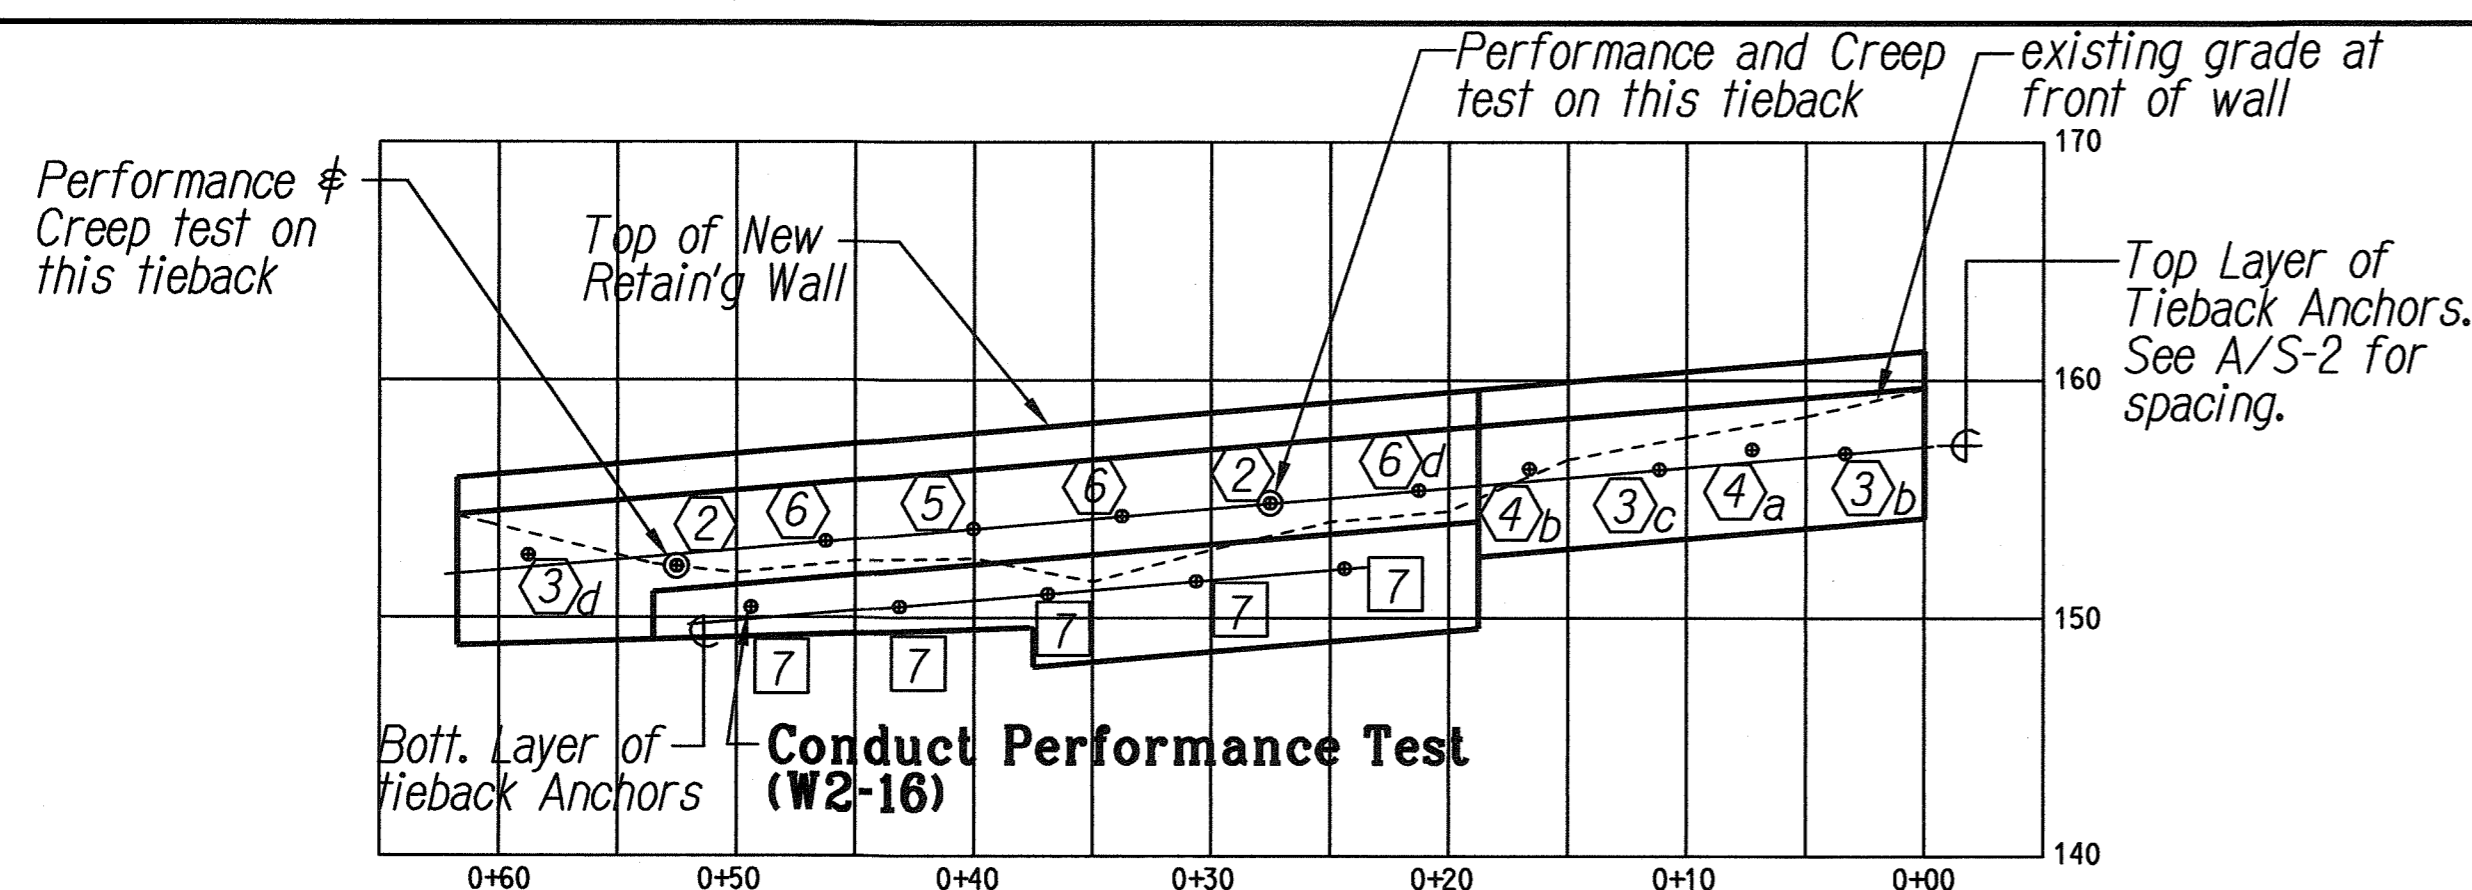

B WALL 2 TIEBACK INSTALLATION SEQUENCE AND STRESSING
S-3A S-3A Scale: 1/8" = 1'-0"

Stress Sequence 3, 4, 5 & 6 & All Done on the Same Day

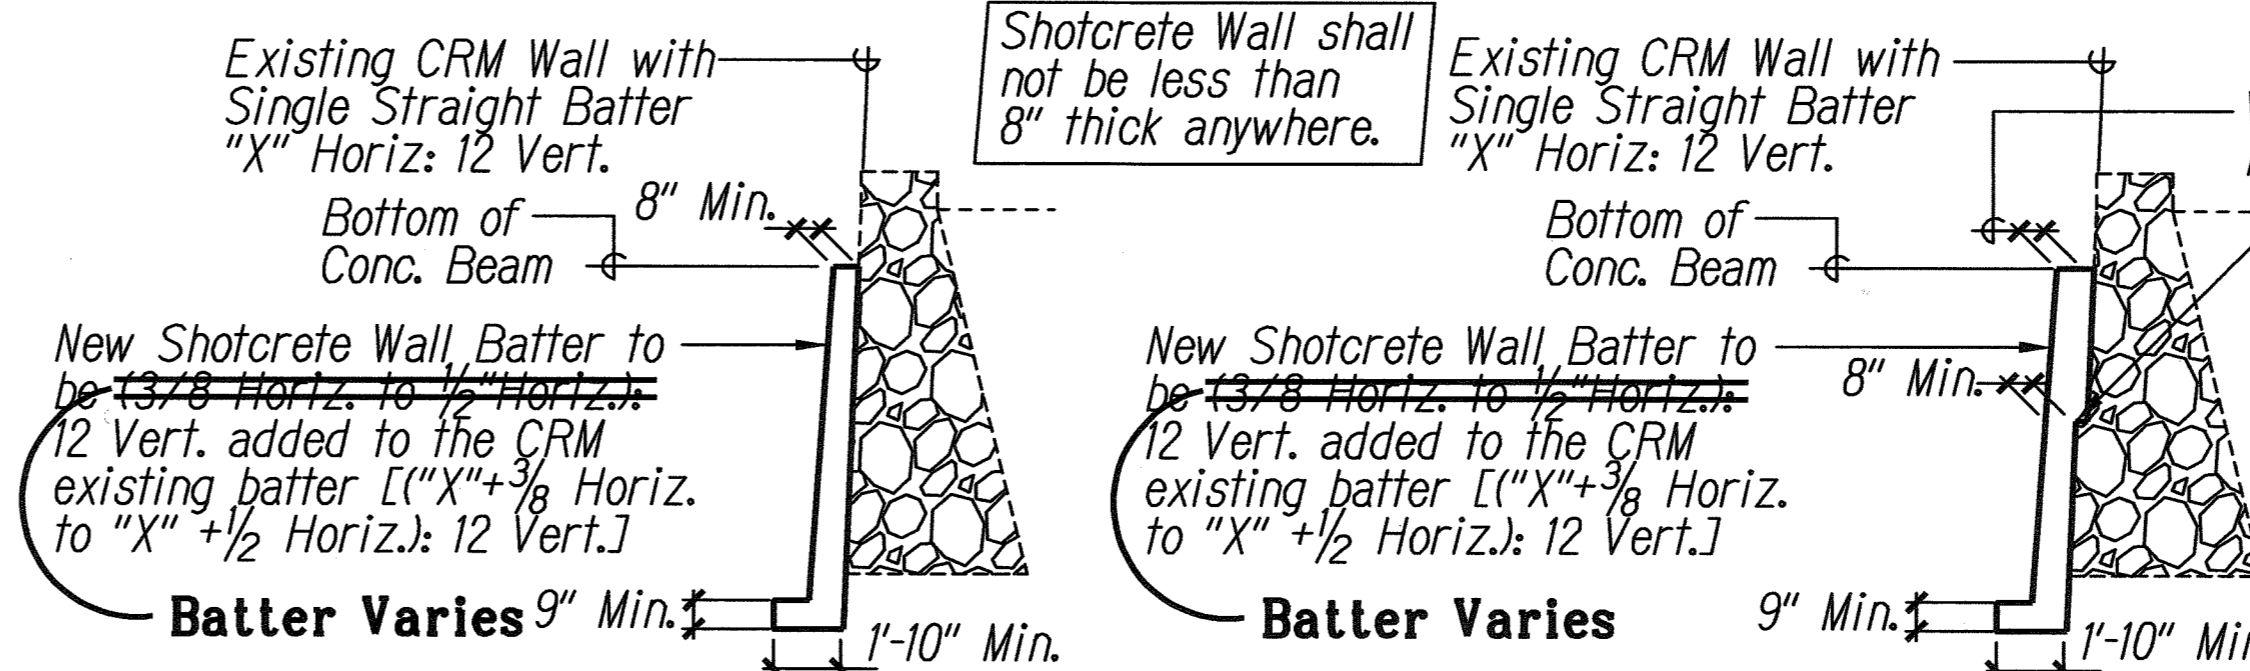

E WALL #1 OR #2 - SHOTCRETE BATTER WHERE EXIST'G CRM WALL HAS STRAIGHT SINGLE BATTER
S-3 S-3A Not to Scale

Modify Shotcrete face under Tieback Anchor Bearing to stay within Alignment Tolerance of Tieback Anchor Assembly.
Verify Shotcrete Thickness below beam still meets 8" Min. requirements.
Where the CRM Wall has a Ledge or Protrusion, the 8" Min. Dimension shall be taken from the furthest protrusion.

EXPIRATION DATE OF THE LICENSE: APRIL 30, 2010
CRISTO H. SAKAMUSI
LICENSED PROFESSIONAL ENGINEER
No. 5509-S
HAWAII, U.S.A.
THIS WORK WAS PREPARED BY ME OR UNDER MY SUPERVISION.

3/21/07	1	ADDED THIS SHEET
DATE	REVISION	
STATE OF HAWAII DEPARTMENT OF TRANSPORTATION HIGHWAYS DIVISION		
TIEBACK INSTALLATION SEQUENCE AND STRESSING; SHOTCRETE BATTER		
KUAMOO ROAD RETAINING WALL IN THE VICINITY OF M.P. 1J PROJECT NO. 580A-01-02		
Scale: As Noted	Date: September 2005	
SHEET No. S-3A OF 8 SHEETS		


FED. ROAD DIST. NO.	STATE	FED. AID PROJ. NO.	FISCAL YEAR	SHEET NO.	TOTAL SHEETS
HAWAII	HAW.	580A-01-02	2005	C.O.205-2	25

LEGEND:


- Indicates Tieback Anchor Location
- ⊙ Indicates Tieback Anchor Requiring Performance and Creep Load Test.
- ⬡ Indicates construction sequence for Top Row of Tiebacks.
- Indicates construction sequence for Bottom Row of Tiebacks.
- "a" Indicates Tieback Stressing - See Tieback Stressing Schedule

NOTES:


- For Location of Tiebacks in the Top Row, See Sht. S-2.
- Tiebacks with higher construction sequence number shall not be constructed until final grouting up to anchor plate for lower construction sequence number has set and cured 24 hours minimum.
- Construction of Tiebacks for the bottom layer shall not commence until the Tiebacks in the top layer has been fully grouted and stressed.
- Contractor may modify construction sequence upon approval from the engineer.
- For Construction Joint Details, See Def. C/S-3.

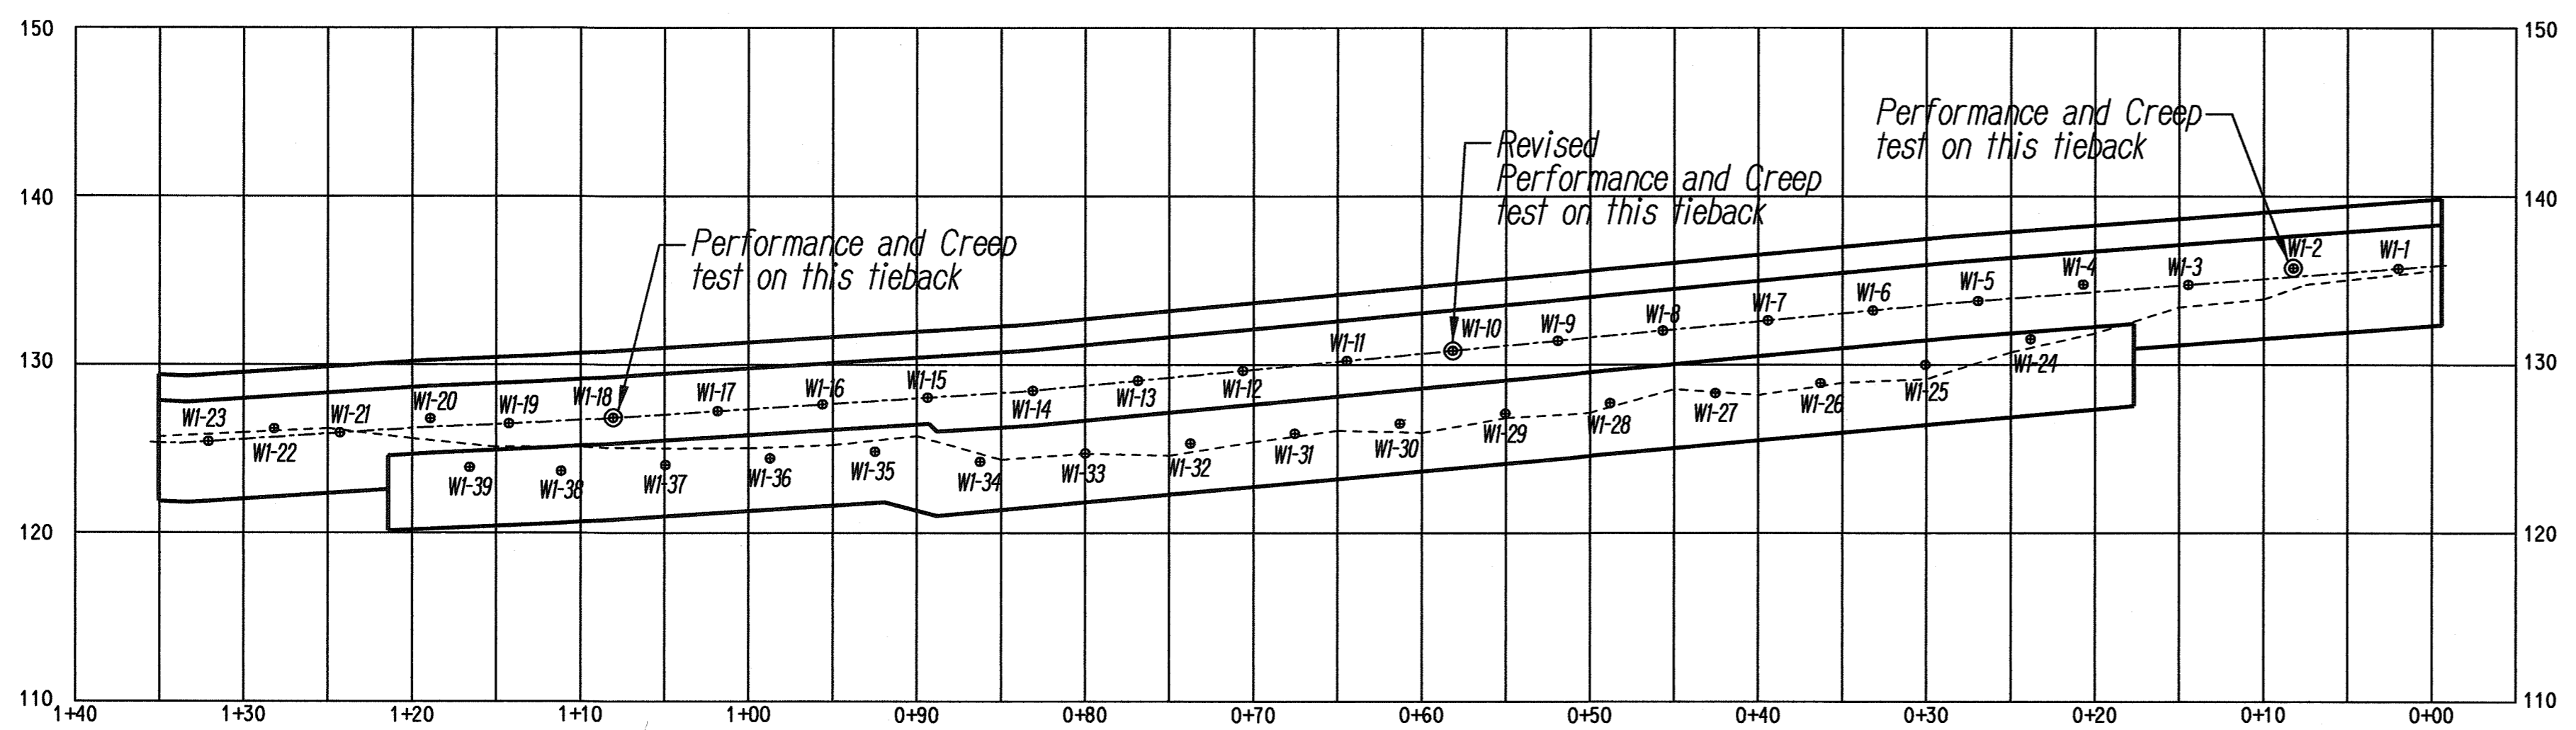

A WALL 1 TIEBACK NUMBERS AND STATIONS
S-3B S-3B Scale: 1/8" = 1'-0"

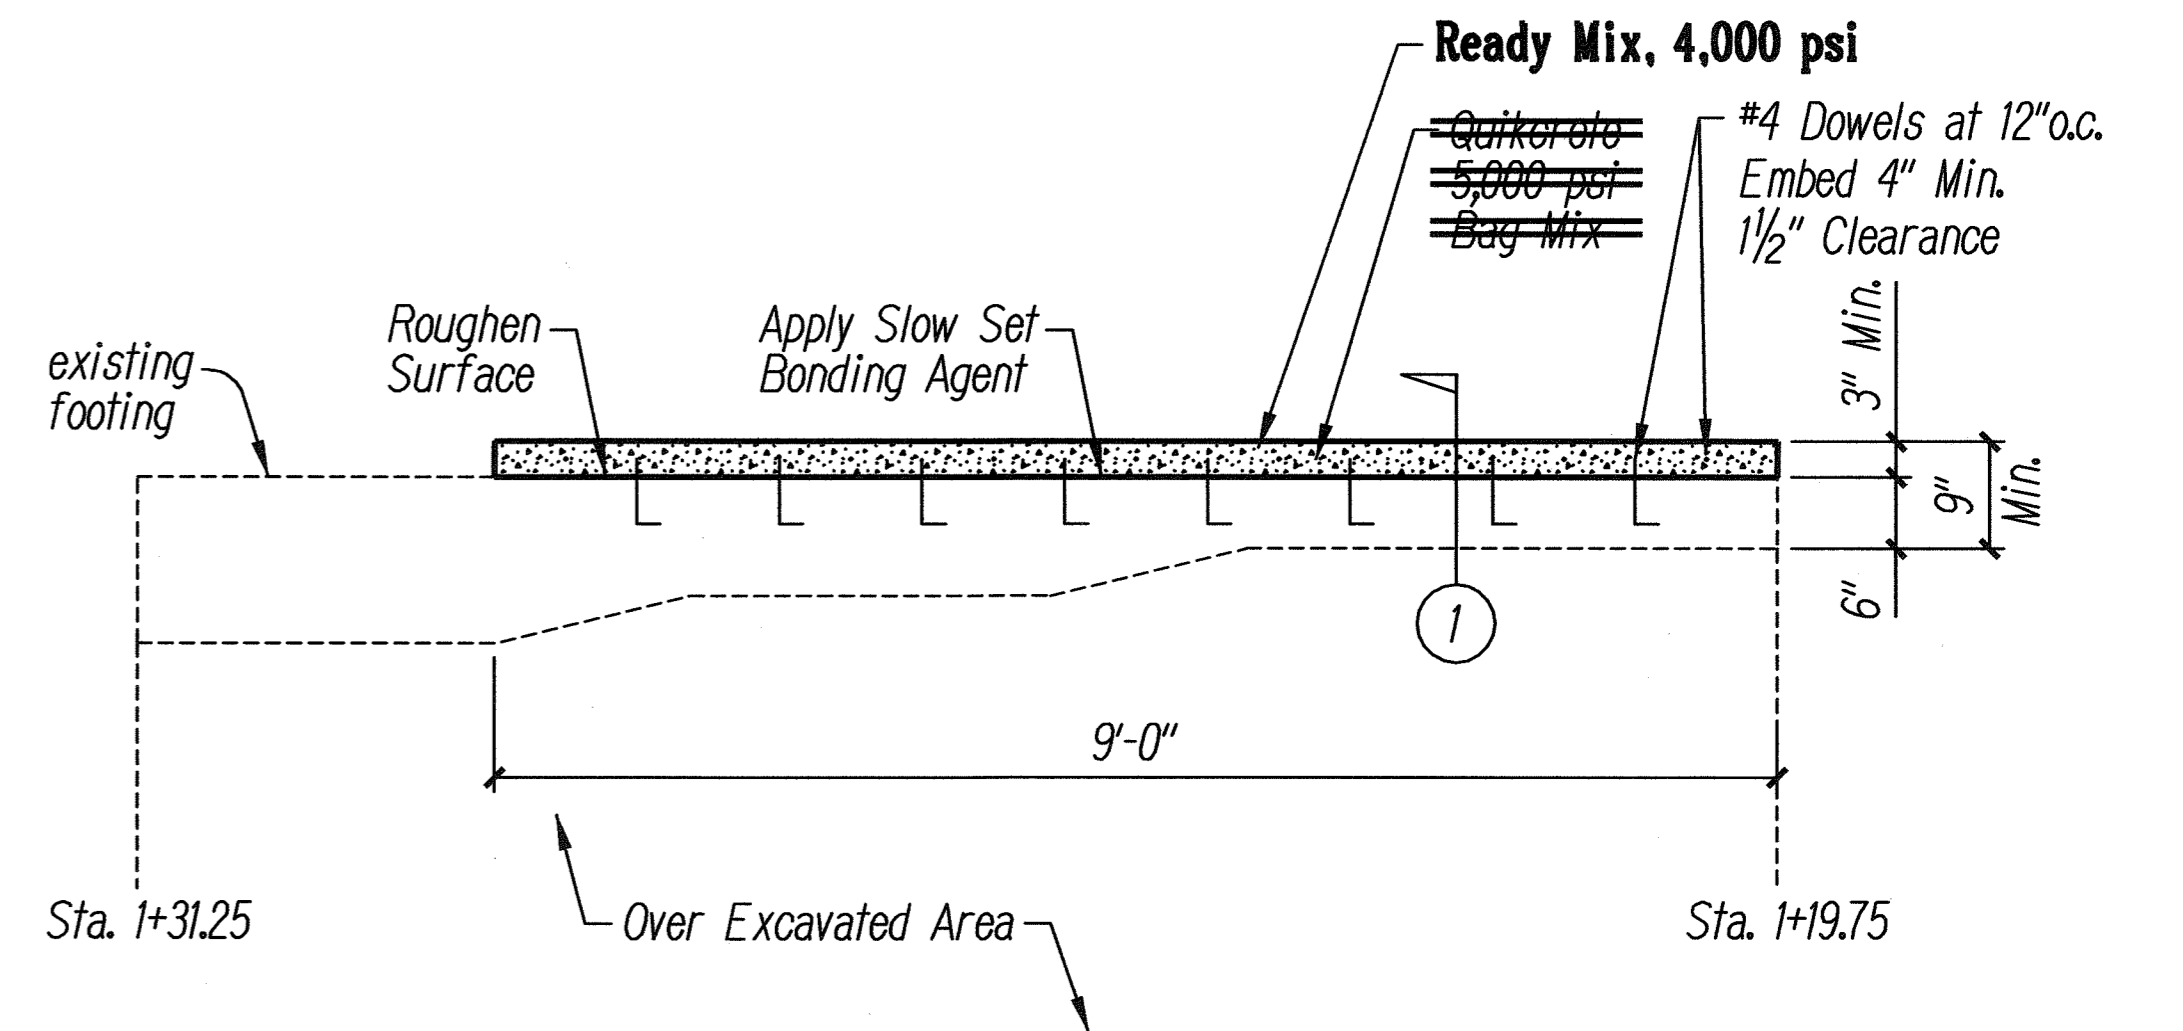

C FOOTING REPAIR DETAIL
S-3B S-3B Not to Scale

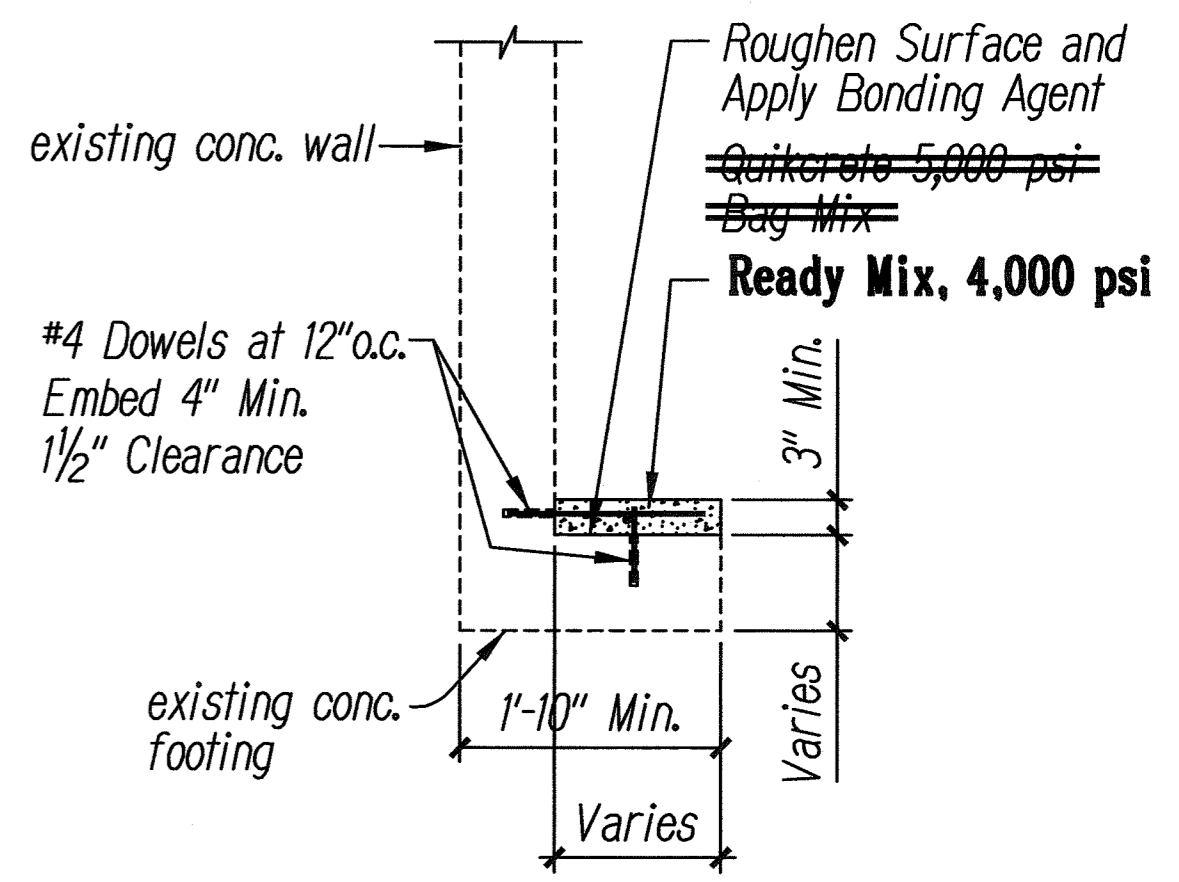

1 SECTION

TIEBACK STATION LOCATIONS


WALL #1

Tieback#	Station #	Tieback#	Station #
WI-1	0+1.5	WI-21	1+24.25
WI-2	0+7.5	WI-22	1+28.25
WI-3	0+13.75	WI-23	1+32.25
WI-4	0+20	WI-24	0+23.25
WI-5	0+26.25	WI-25	0+29.25
WI-6	0+32.5	WI-26	0+35.75
WI-7	0+38.75	WI-27	0+41.5
WI-8	0+45	WI-28	0+47.75
WI-9	0+51	WI-29	0+54.25
WI-10	0+57.5	WI-30	0+60.25
WI-11	0+63.75	WI-31	0+66.75
WI-12	0+70	WI-32	0+73.25
WI-13	0+76.25	WI-33	0+79.75
WI-14	0+82.75	WI-34	0+85.75
WI-15	0+89.25	WI-35	0+92.25
WI-16	0+95.5	WI-36	0+98.5
WI-17	1+1.75	WI-37	1+5
WI-18	1+8.25	WI-38	1+11
WI-19	1+14.25	WI-39	1+16.75
WI-20	1+18.75		

TIEBACK STATION LOCATIONS

WALL #2

Tieback#	Station #
W2-1	0+3.5
W2-2	0+7.25
W2-3	0+11.25
W2-4	0+16.5
W2-5	0+21.5
W2-6	0+27.75
W2-7	0+33.75
W2-8	0+40.25
W2-9	0+46.5
W2-10	0+52.75
W2-11	0+59.25
W2-12	0+24.75
W2-13	0+30.75
W2-14	0+37
W2-15	0+43.25
W2-16	0+49.75

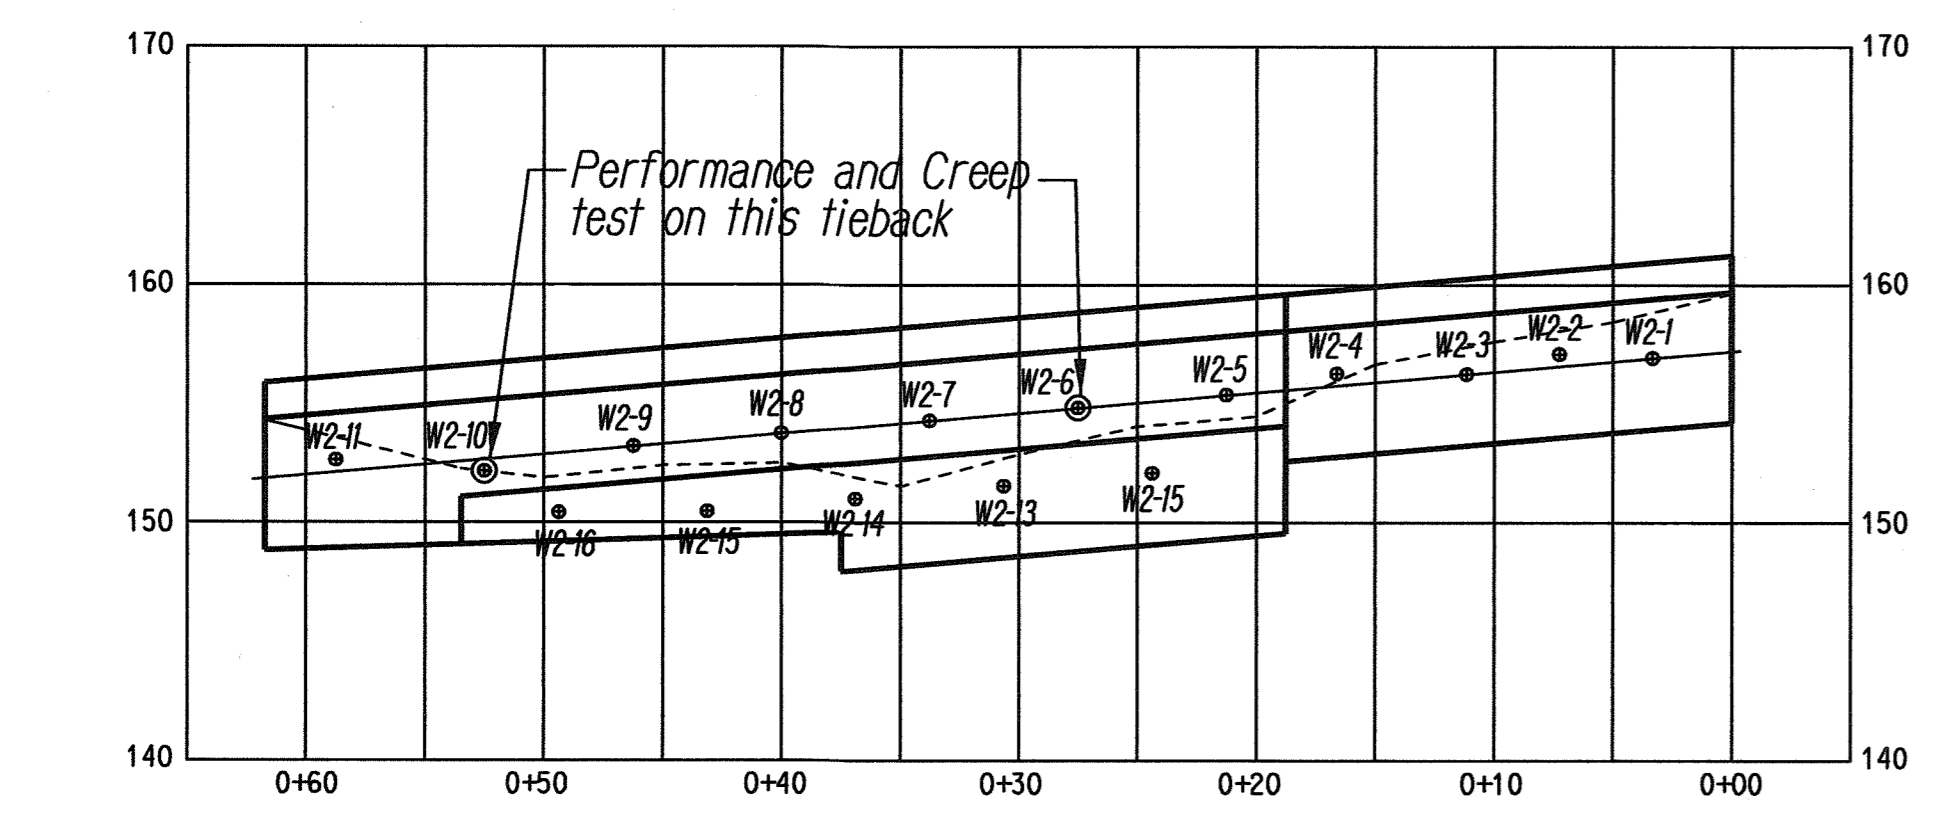

B WALL 2 TIEBACK NUMBERS AND STATIONS
S-3B S-3B Scale: 1/8" = 1'-0"

LEGEND FOR AS-BUILT POSTINGS

	Squiggly line for as-built deletion
	Double line for as-built deletion
	Text for as-built posting

DATE _____
SURVEY PLOTTED BY _____
DESIGNED BY _____
CHECKED BY _____
ORIGINAL PLAN _____
NOTE BOOK _____
ENGINNERED BY _____
QUANTITIES BY _____
NO. C.O.205-2/40

EXPIRATION DATE OF THE LICENSE: APRIL 30, 2010
OSAKI H. SAKAMOTO
LICENSED PROFESSIONAL ENGINEER
NO. 5509-S
HAWAII, U.S.A.
[Signature]
THIS WORK WAS PREPARED BY ME OR UNDER MY SUPERVISION.

DATE	REVISION

STATE OF HAWAII
DEPARTMENT OF TRANSPORTATION
HIGHWAYS DIVISION

TIEBACK NUMBERS & STATIONS

**KUAMOO ROAD RETAINING WALL
IN THE VICINITY OF M.P. 1J
PROJECT NO. 580A-01-02**

Scale: As Noted Date: September 2005
SHEET No. S-3B OF 8 SHEETS

"AS-BUILT"

C.O.205-2