



FED. ROAD DIST. NO.	STATE	FED. AID PROJ. NO.	FISCAL YEAR	SHEET NO.	TOTAL SHEETS
HAWAII	HAW.	580A-01-02	2005	10	25

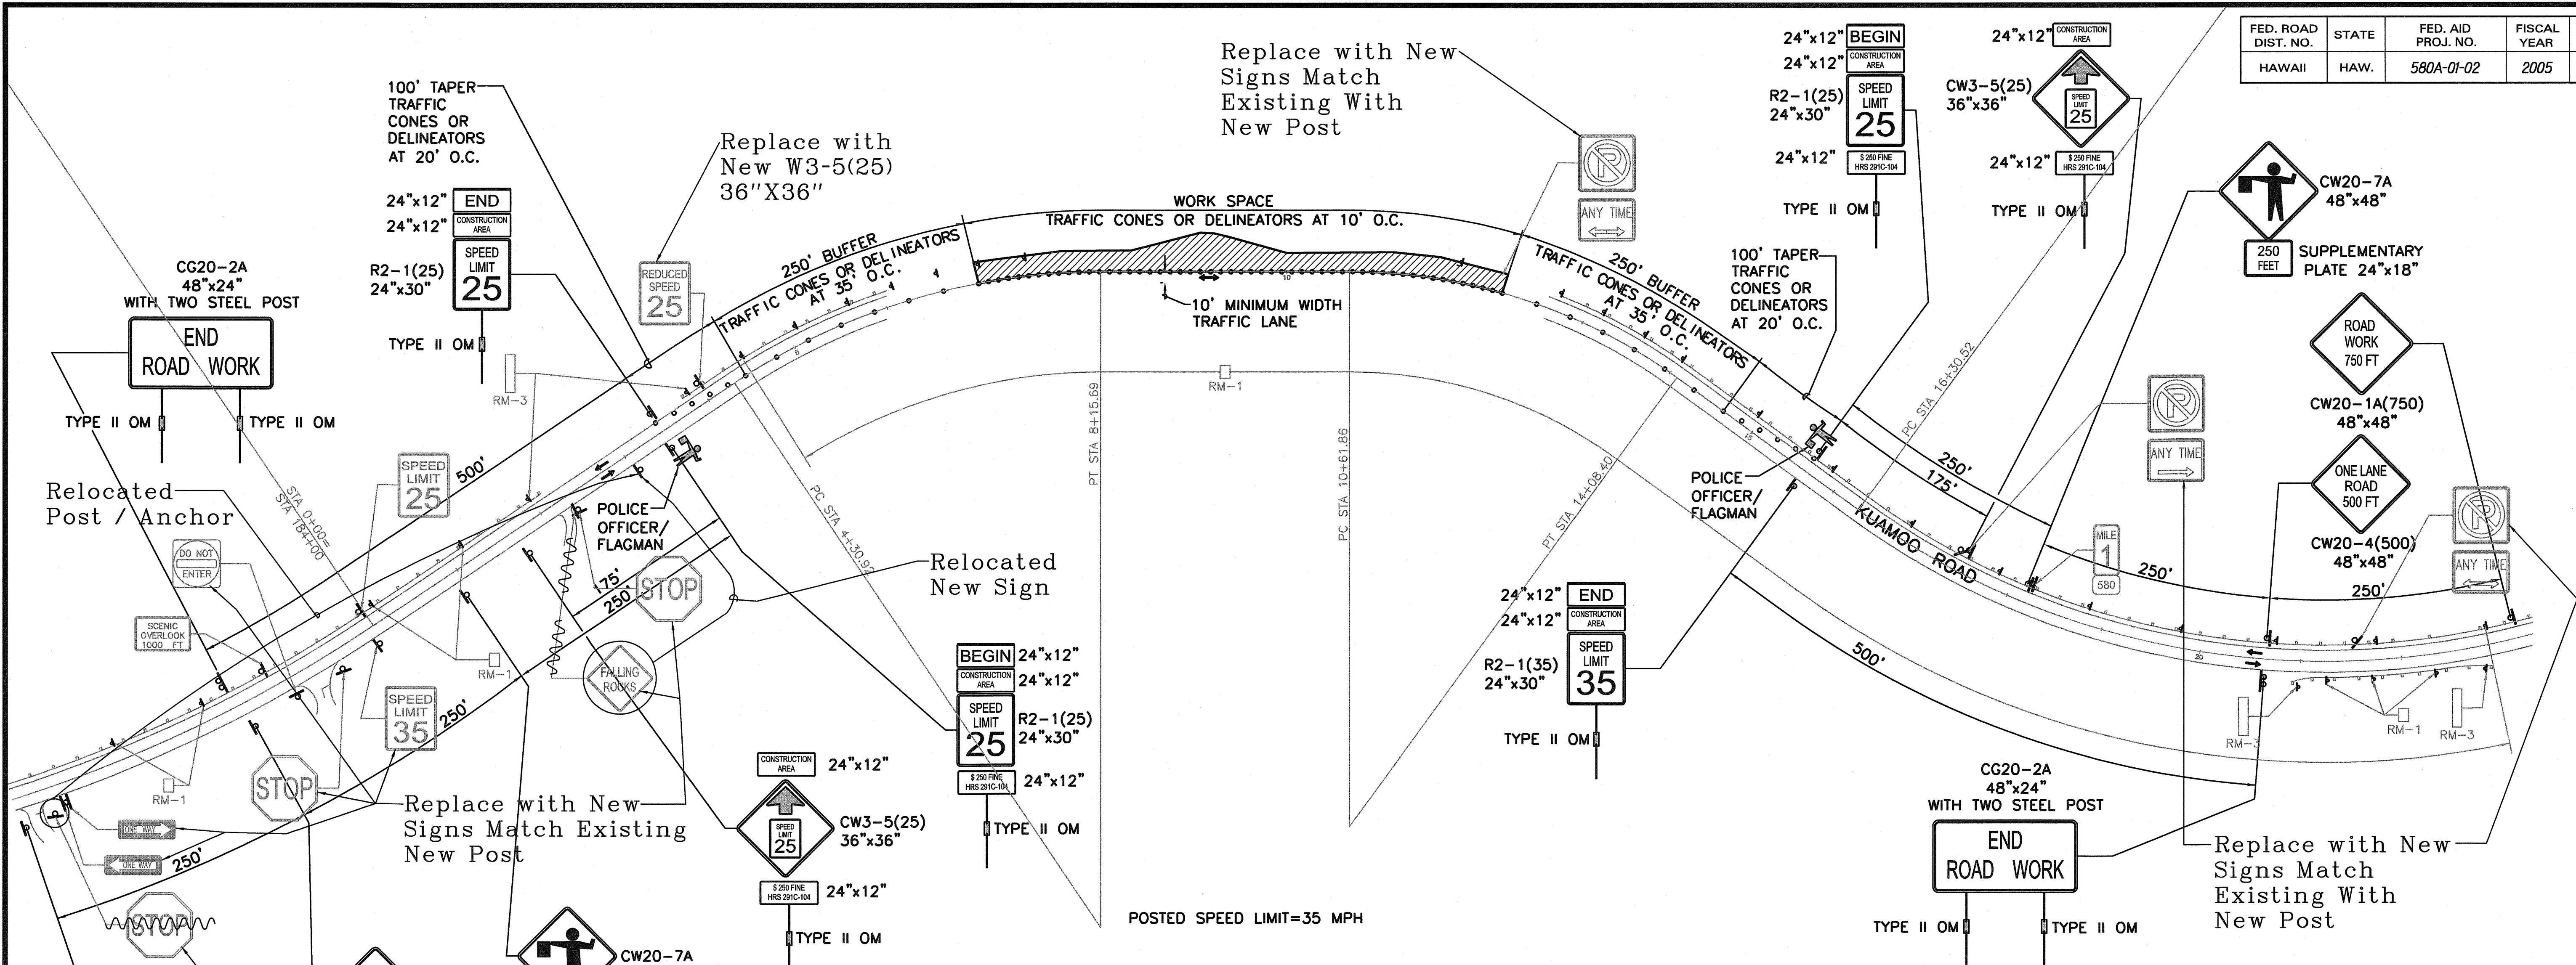

WORKING HOURS TRAFFIC CONTROL PLAN

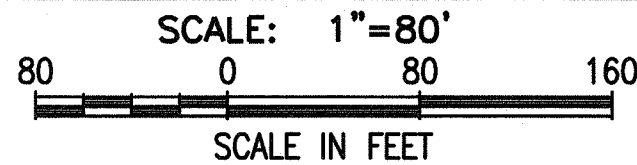

SPECIFIC NOTES FOR TRAFFIC CONTROL


- TWO (2) POLICEMEN SHALL BE PROVIDED DURING ALL ACTIVE PERIODS OF Lane Closures CONSTRUCTION ALONG KUAMOO ROAD.

LEGEND:


- SIGN
- CONE OR DELINEATOR
- DIRECTION OF TRAFFIC
- POLICE OFFICER/FLAGMAN
- WORK AREA

**LEGEND FOR
AS-BUILT POSTINGS**

~~~~~ Squiggly line for as-built deletion  
=00= Double line for as-built deletion  
Roadway Text for as-built posting

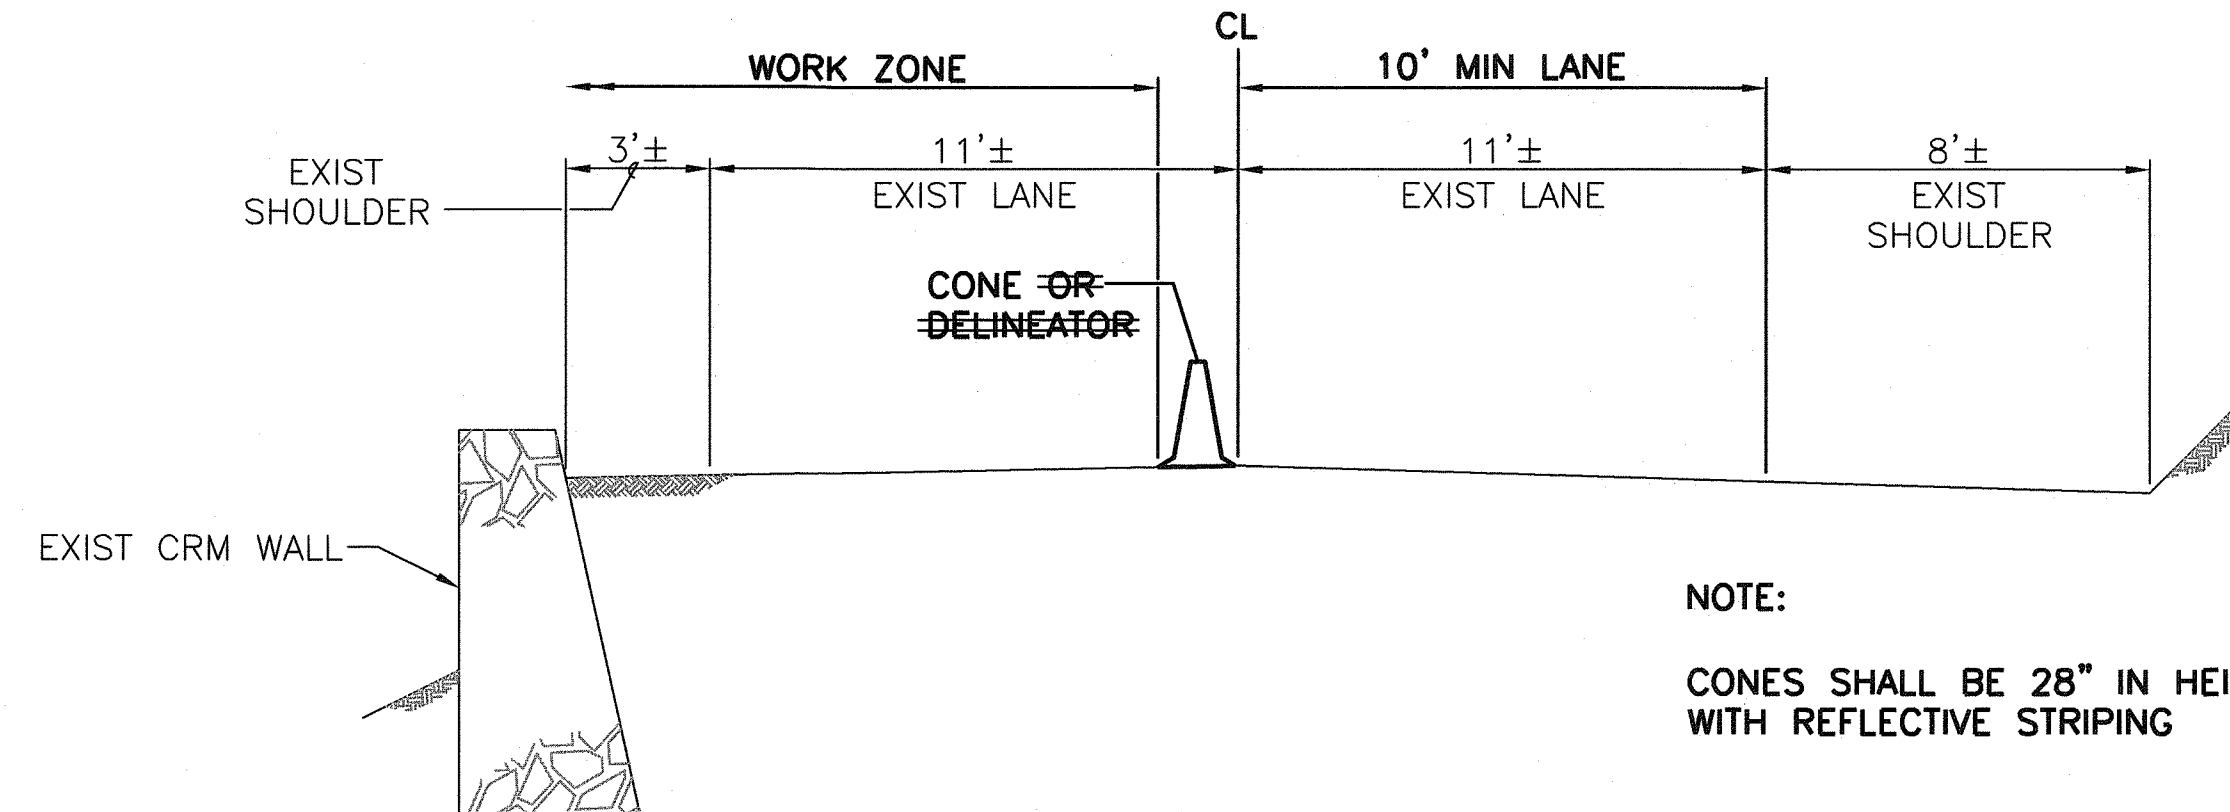


### WORKING HOURS TYPICAL WORK ZONE SECTION

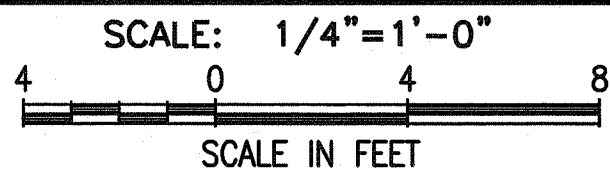

NOTE:  
CONES SHALL BE 28" IN HEIGHT  
WITH REFLECTIVE STRIPING

EXPIRATION DATE OF THE LICENSE (4/30/10)

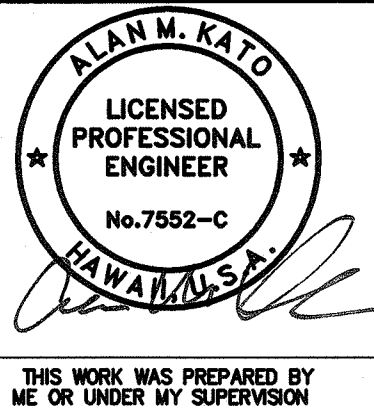

STATE OF HAWAII  
DEPARTMENT OF TRANSPORTATION  
HIGHWAYS DIVISION

### TRAFFIC CONTROL PLAN

*KUAMOO ROAD RETAINING WALL  
IN THE VICINITY OF M.P. 11  
PROJECT NO. 580A-01-02*

SCALE: AS NOTED DATE: SEPT 2005

SHEET No. 1 OF 2 SHEETS

FLU1 MAIL: 03/01/04 000 INU.: 040000

