

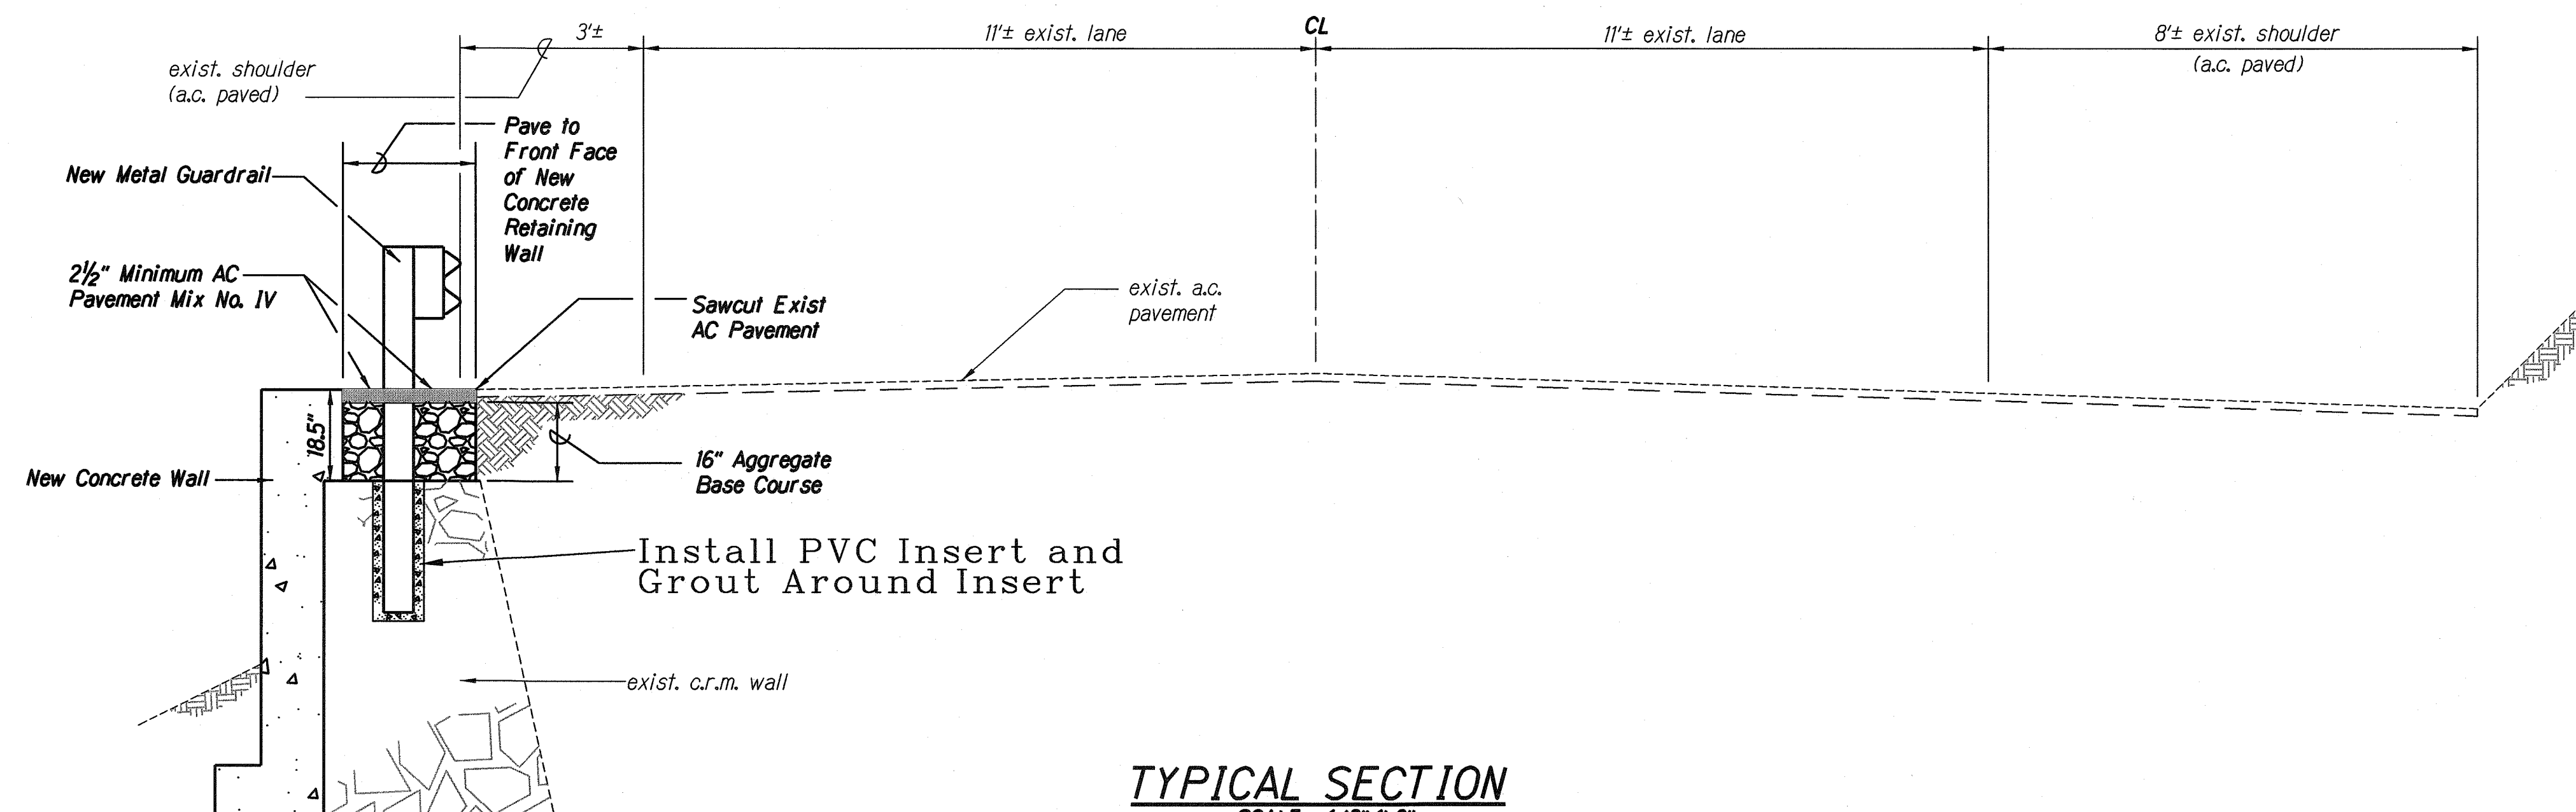
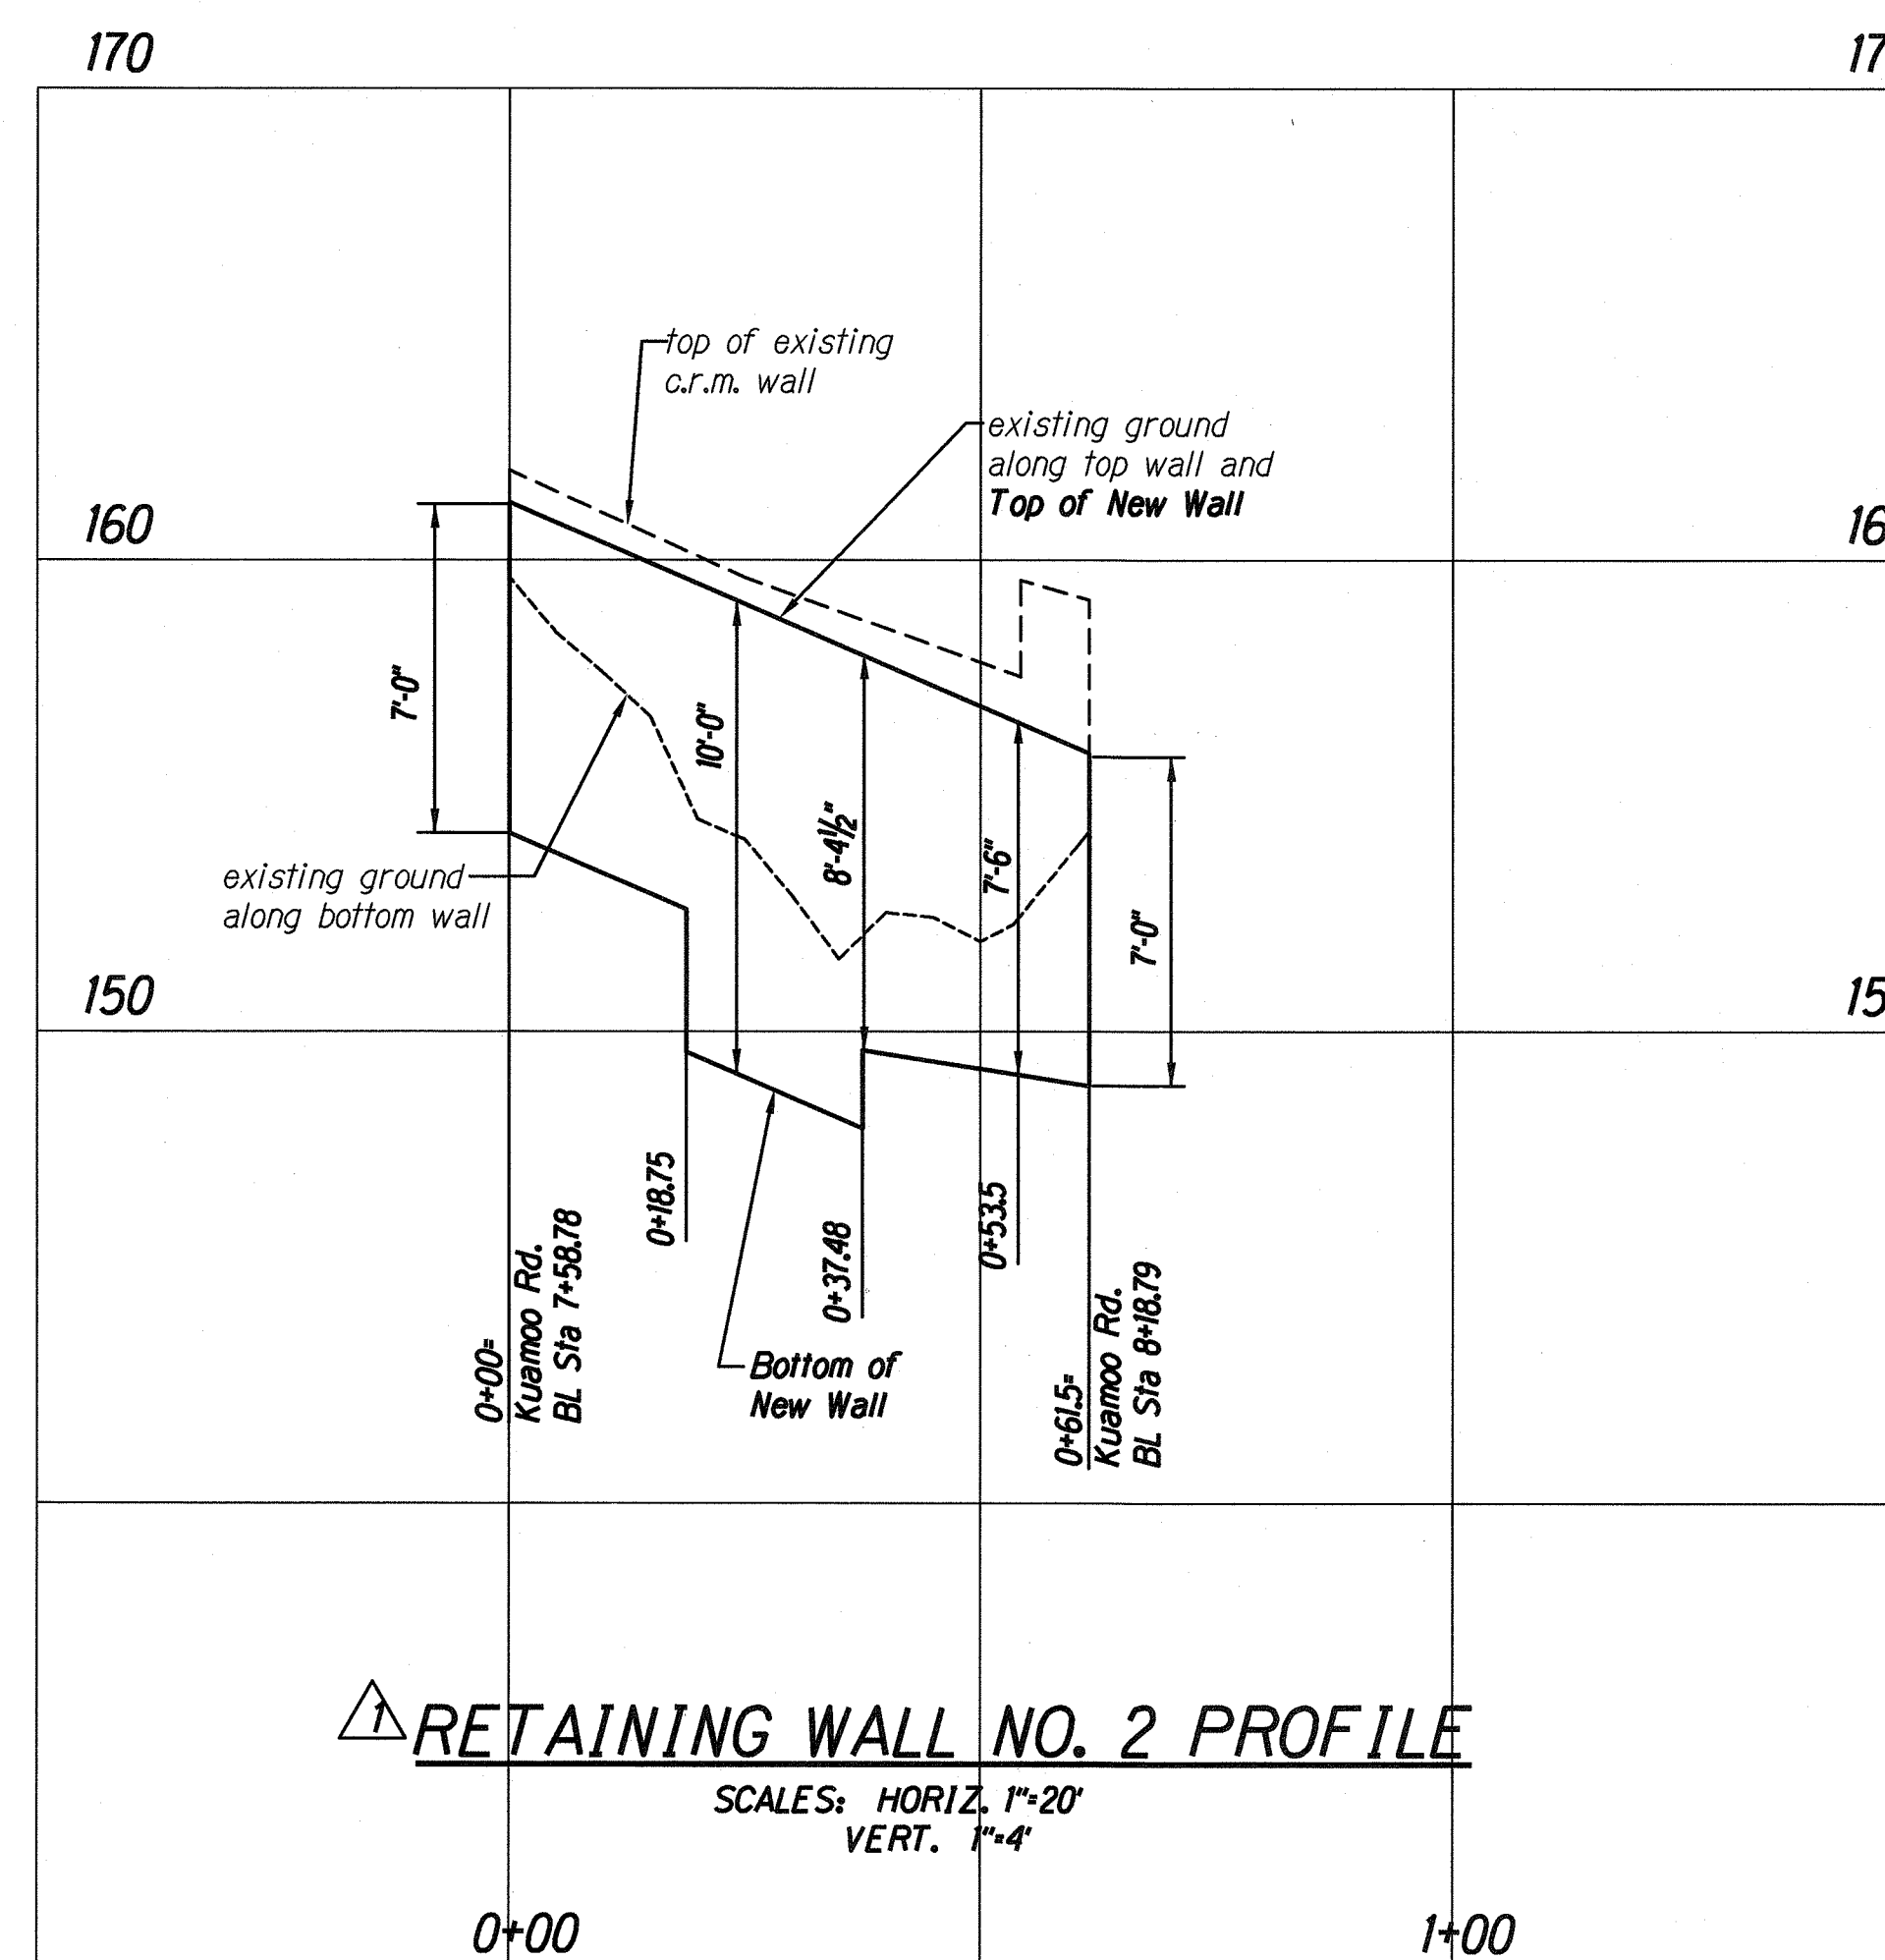


| FED. ROAD<br>DIST. NO. | STATE | FED. AID<br>PROJ. NO. | FISCAL<br>YEAR | SHEET<br>NO. | TOTAL<br>SHEETS |
|------------------------|-------|-----------------------|----------------|--------------|-----------------|
| HAWAII                 | HAW.  | 580A-01-02            | 2005           | C.08         | 25              |


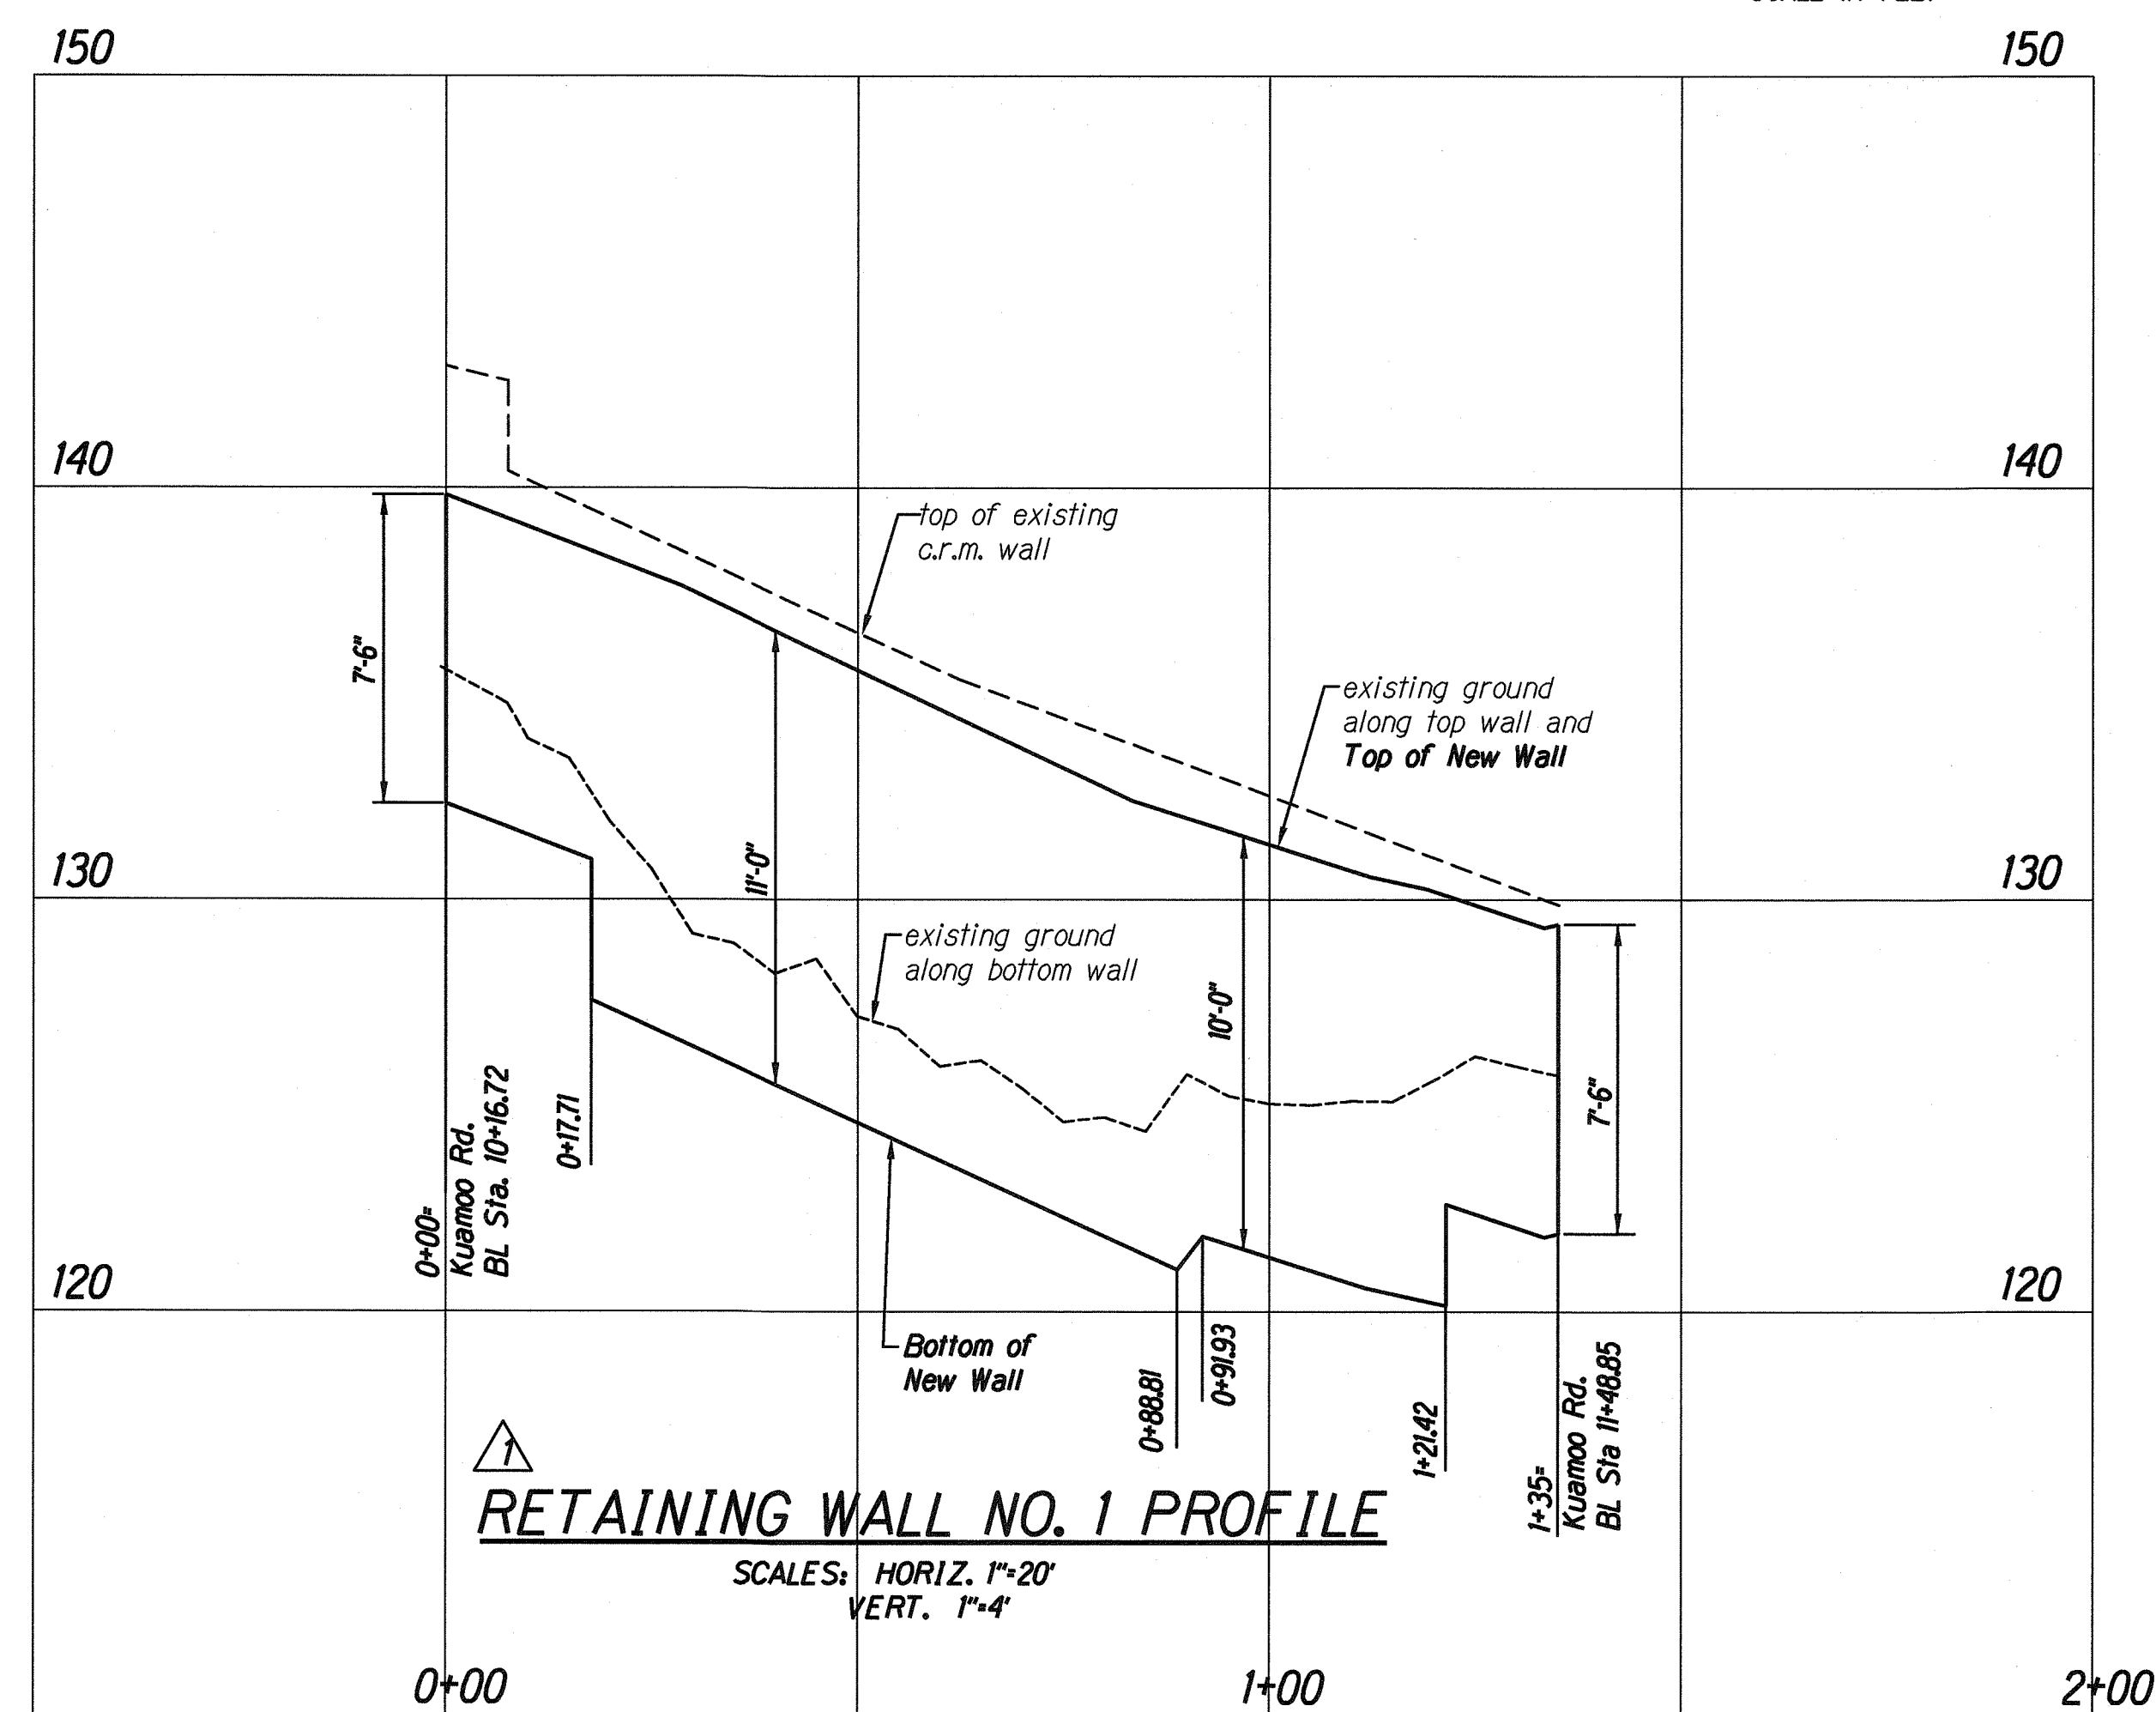


TYPICAL SECTION

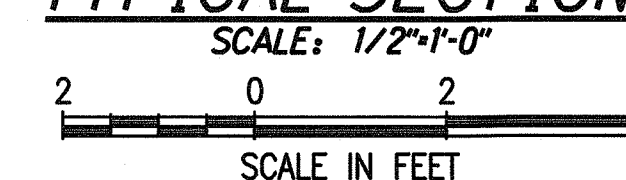

LEGEND FOR  
AS-BUILT POSTINGS

|                                                                                       |                                     |
|---------------------------------------------------------------------------------------|-------------------------------------|
|  | Squiggly line for as-built deletion |
|  | Double line for as-built deletion   |
| Roadway                                                                               | Text for as-built posting           |

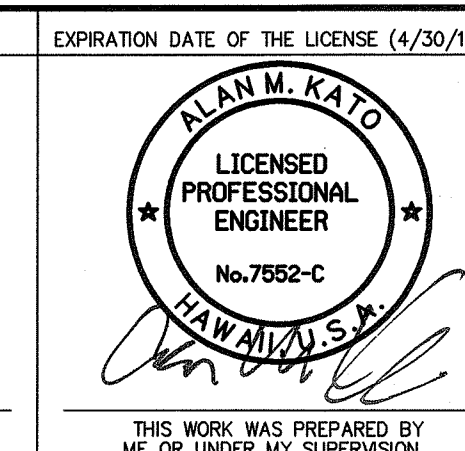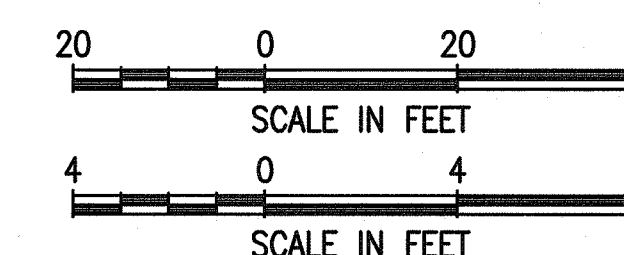

|         |   |                              |
|---------|---|------------------------------|
| 3/21/07 | 1 | Wall #1 & #2 Profile Revised |
|---------|---|------------------------------|

|      |  |          |
|------|--|----------|
| DATE |  | REVISION |
|------|--|----------|

STATE OF HAWAII  
DEPARTMENT OF TRANSPORTATION  
HIGHWAYS DIVISION

**TYPICAL SECTION AND WALL PROFILE**

KUAMOO ROAD RETAINING WALL  
IN THE VICINITY OF M.P. 11  
PROJECT NO. 580A-01-02

SCALE: DATE: SEPT 2005

SHEET No. 1 OF 1 SHEETS

## "AS-BUILT"

**C.O.8**

|                  |                         |             |
|------------------|-------------------------|-------------|
| ORIGINAL<br>PLAN | SURVEY PLOTTED BY _____ | DATE 9/2005 |
| NOTE BOOK        | DRAWN BY <i>AR</i>      | " 3/2007    |
| <i>COB.dgn</i>   | TRACED BY _____         | " "         |
|                  | DESIGNED BY <i>AK</i>   | " "         |
|                  | QUANTITIES BY _____     | " "         |
|                  | CHECKED BY <i>LA</i>    | " "         |
| to _____         |                         |             |